



646.402 DURABLE 4 INCH WHITE LINE, THERMOPLASTIC OR
 646.403 DURABLE 4 INCH WHITE LINE, EPOXY PAINT OR
 646.404 DURABLE 4 INCH WHITE LINE, POLYUREA
 (ALL LINES WILL INCLUDE EDGE LINE BREAKS AND
 RADIUS FOR TOWN HIGHWAYS)
 CASTLETON:
 STA 298+50.00 - STA 310+50.00 EDGE LINE LT & RT

646.412 DURABLE 4 INCH YELLOW LINE, THERMOPLASTIC OR
 646.413 DURABLE 4 INCH YELLOW LINE, EPOXY PAINT OR
 646.414 DURABLE 4 INCH YELLOW LINE, POLYUREA
 (ALL LINES WILL INCLUDE C/L BREAKS FOR
 TOWN HIGHWAYS) S=SOLID, D=DASHED
 CASTLETON:
 STA 298+50.00 - STA 310+50.00 LT ☐ RT
 S - S

646.602 TEMPORARY 4 INCH WHITE LINE, PAINT
 (ALL LINES WILL INCLUDE EDGE LINE BREAKS AND
 RADIUS FOR TOWN HIGHWAYS)
 CASTLETON:
 STA 298+50.00 - STA 310+50.00 EDGE LINE LT & RT

646.612 TEMPORARY 4 INCH YELLOW LINE, PAINT
 (ALL LINES WILL INCLUDE C/L BREAKS FOR
 TOWN HIGHWAYS) S=SOLID, D=DASHED
 CASTLETON:
 STA 298+50.00 - STA 310+50.00 LT ☐ RT
 S - S

675.50 REMOVING SIGNS
 AS SHOWN - 4

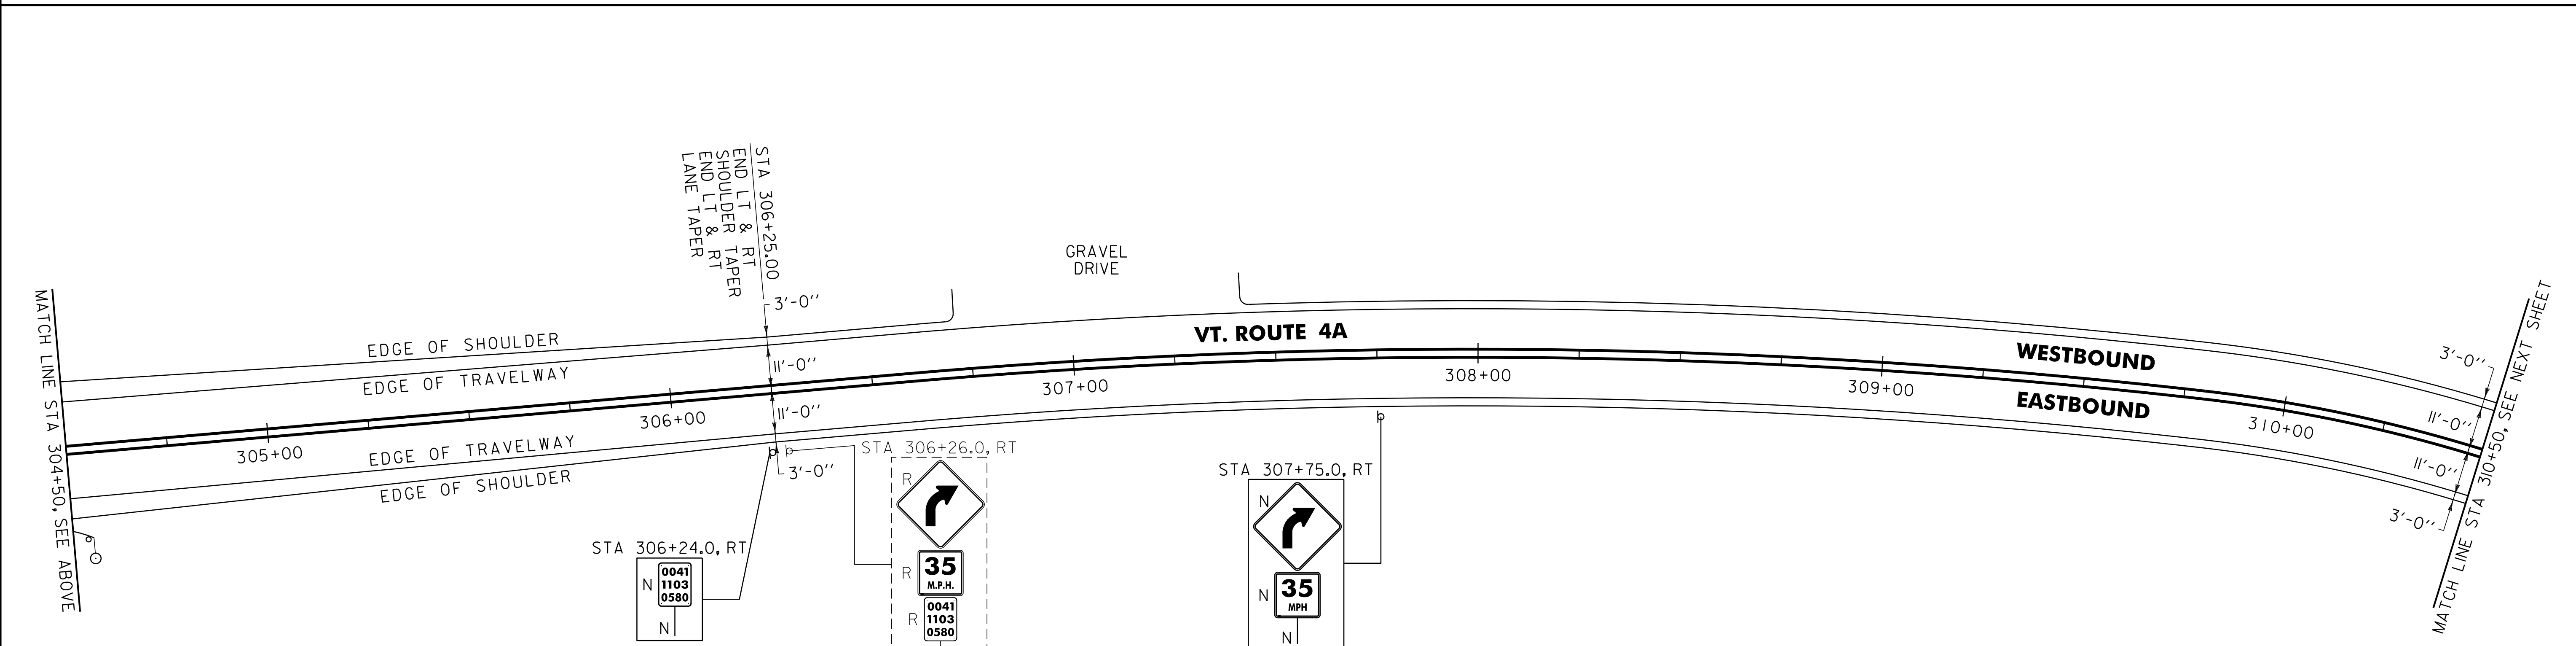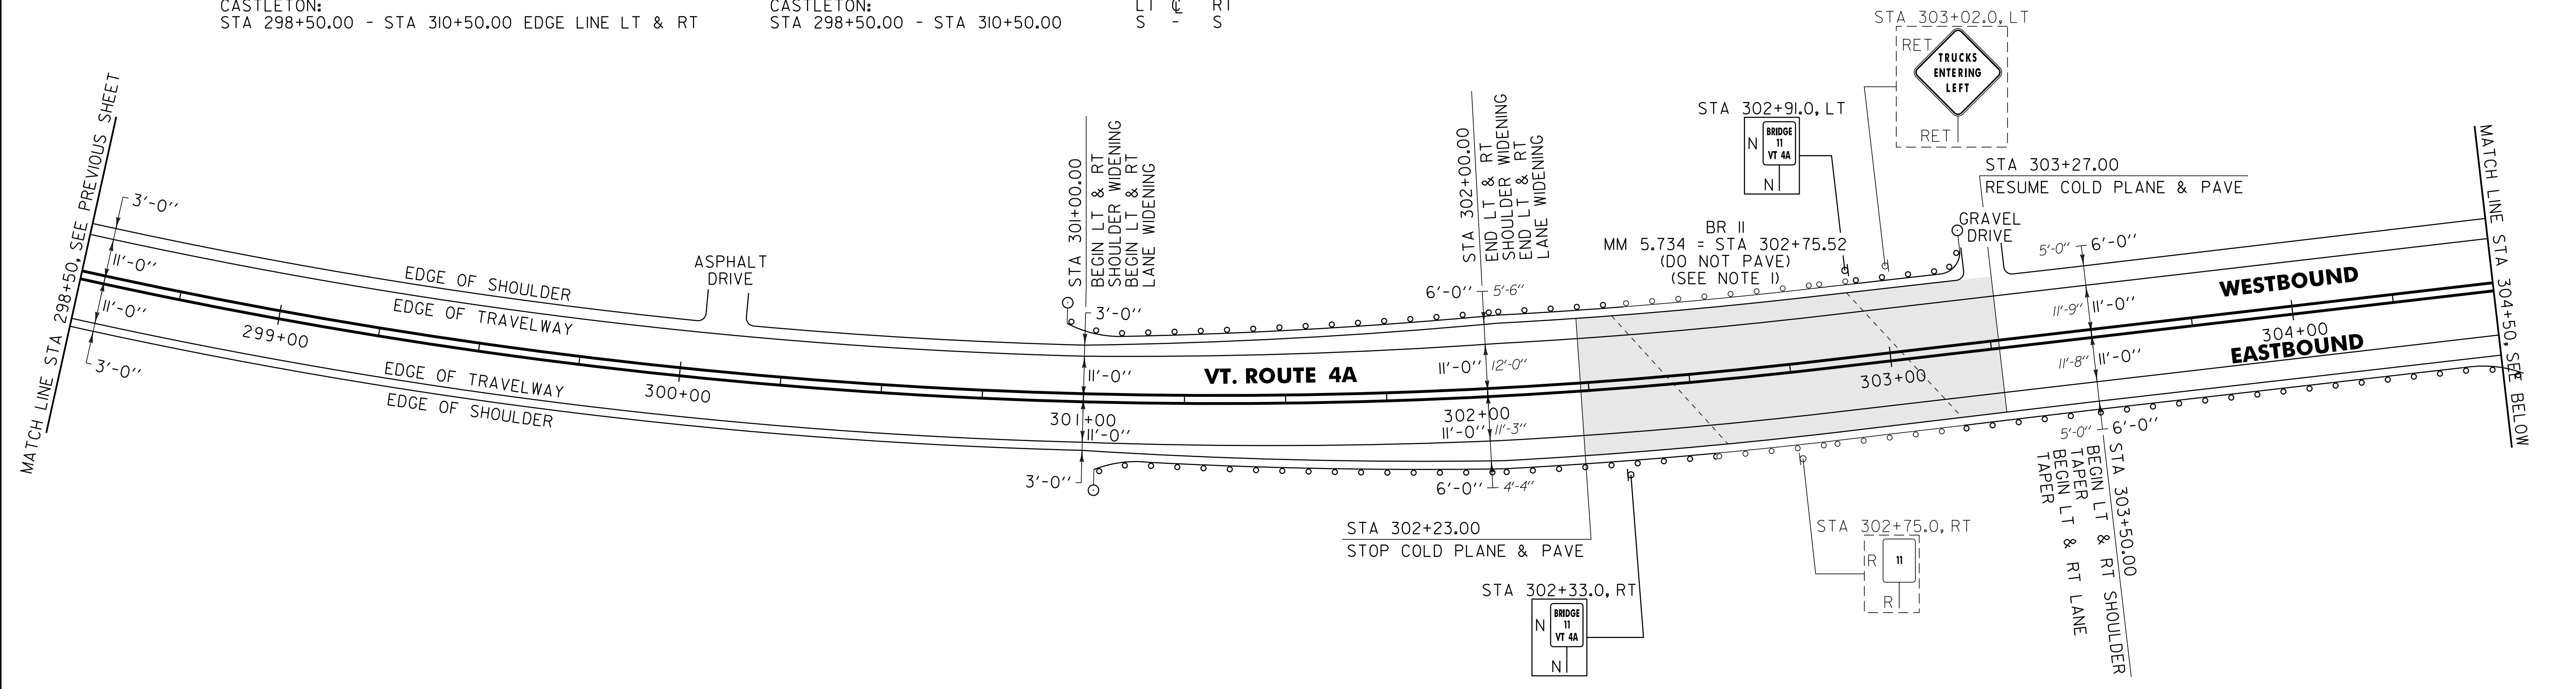

621.20 STEEL BEAM GUARDRAIL, GALVANIZED
 CASTLETON:
 STA 300+95.5 - STA 301+85.0 LT (89.5 LF)
 STA 301+03.0 - STA 302+05.0 RT (102.0 LF)
 STA 303+05.5 - STA 303+20.0 LT (14.5 LF)
 STA 303+66.0 - STA 304+55.5 RT (89.5 LF)

621.70 GUARDRAIL APPROACH SECTION, GALVANIZED TYPE I
 CASTLETON:
 STA 301+85.0 - STA 302+35.0 LT
 STA 302+05.0 - STA 302+55.0 RT
 STA 303+16.0 - STA 303+66.0 RT

621.80 REMOVAL AND DISPOSAL OF GUARDRAIL
 CASTLETON:
 STA 300+97.0 - STA 302+35.0 LT (138.0 LF)
 STA 301+03.0 - STA 302+55.0 RT (152.0 LF)
 STA 302+93.0 - STA 303+14.0 LT (21.0 LF)
 STA 303+16.0 - STA 304+45.0 RT (129.0 LF)

621.60 ANCHOR FOR STEEL BEAM RAIL
 CASTLETON:
 STA 301+02.0 LT
 STA 301+09.5 RT
 STA 303+13.5 LT
 STA 304+49.0 RT

621.71 GUARDRAIL APPROACH SECTION, GALVANIZED TYPE II
 CASTLETON:
 STA 302+93.0 - STA 303+05.5 LT

676.10 DELINEATOR WITH STEEL POST
 CASTLETON:
 STA 300+95.5 LT
 STA 301+03.0 RT
 STA 303+20.0 LT
 STA 304+55.5 RT

NO PAVING WORK TO BE PERFORMED IN THIS AREA

NOTE:
 I. SEE SHEET 83 FOR BR II DETAILS.

SIGN LEGEND
 R = REMOVE
 S = SALVAGE
 N = NEW
 RET = RETAIN
 B-B = BACK TO BACK
 EXISTING = - - - - -
 NEW = _____

PROJECT LAYOUT SHEET #10	PROJECT NAME: CASTLETON - WEST RUTLAND	
	PROJECT NUMBER: STP 2705(i)	
	FILE NAME: p07cl68.dgn	PLOT DATE: 04-JUN-2013 09:2
	PROJECT LEADER: D.E.G.	DRAWN BY: W.G.P.
	DESIGNED BY: M.J.M.	CHECKED BY: D.E.G.
	IPARM FILE: p07cl68i10.i	SHEET 31 OF 152