
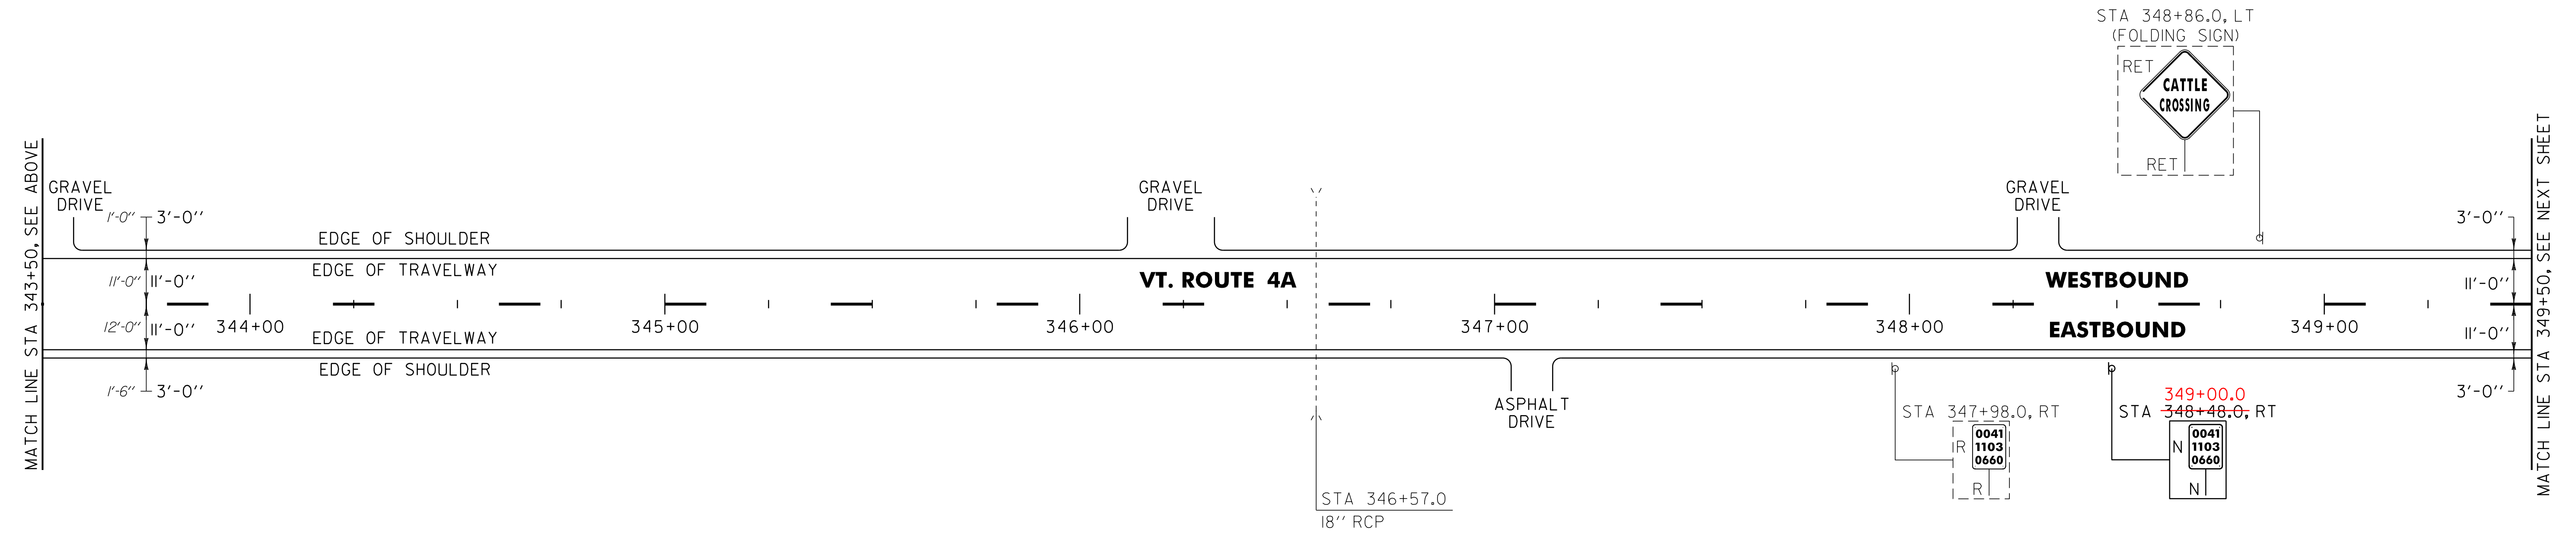


646.402 DURABLE 4 INCH WHITE LINE, THERMOPLASTIC OR  
 646.403 DURABLE 4 INCH WHITE LINE, EPOXY PAINT OR  
 646.404 DURABLE 4 INCH WHITE LINE, POLYUREA  
 (ALL LINES WILL INCLUDE EDGE LINE BREAKS AND RADIUS FOR TOWN HIGHWAYS)  
 CASTLETON:  
 STA 337+50.00 - STA 349+50.00 EDGE LINE LT & RT  
 646.412 DURABLE 4 INCH YELLOW LINE, THERMOPLASTIC OR  
 646.413 DURABLE 4 INCH YELLOW LINE, EPOXY PAINT OR  
 646.414 DURABLE 4 INCH YELLOW LINE, POLYUREA  
 (ALL LINES WILL INCLUDE C/L BREAKS FOR TOWN HIGHWAYS) S=SOLID, D=DASHED  
 CASTLETON:  
 STA 337+50.00 - STA 343+20.00 LT C RT S - D  
 STA 343+20.00 - STA 349+50.00 - D -

646.602 TEMPORARY 4 INCH WHITE LINE, PAINT  
 (ALL LINES WILL INCLUDE EDGE LINE BREAKS AND RADIUS FOR TOWN HIGHWAYS)  
 CASTLETON:  
 STA 337+50.00 - STA 343+20.00 LT C RT S - D  
 STA 343+20.00 - STA 349+50.00 - D -

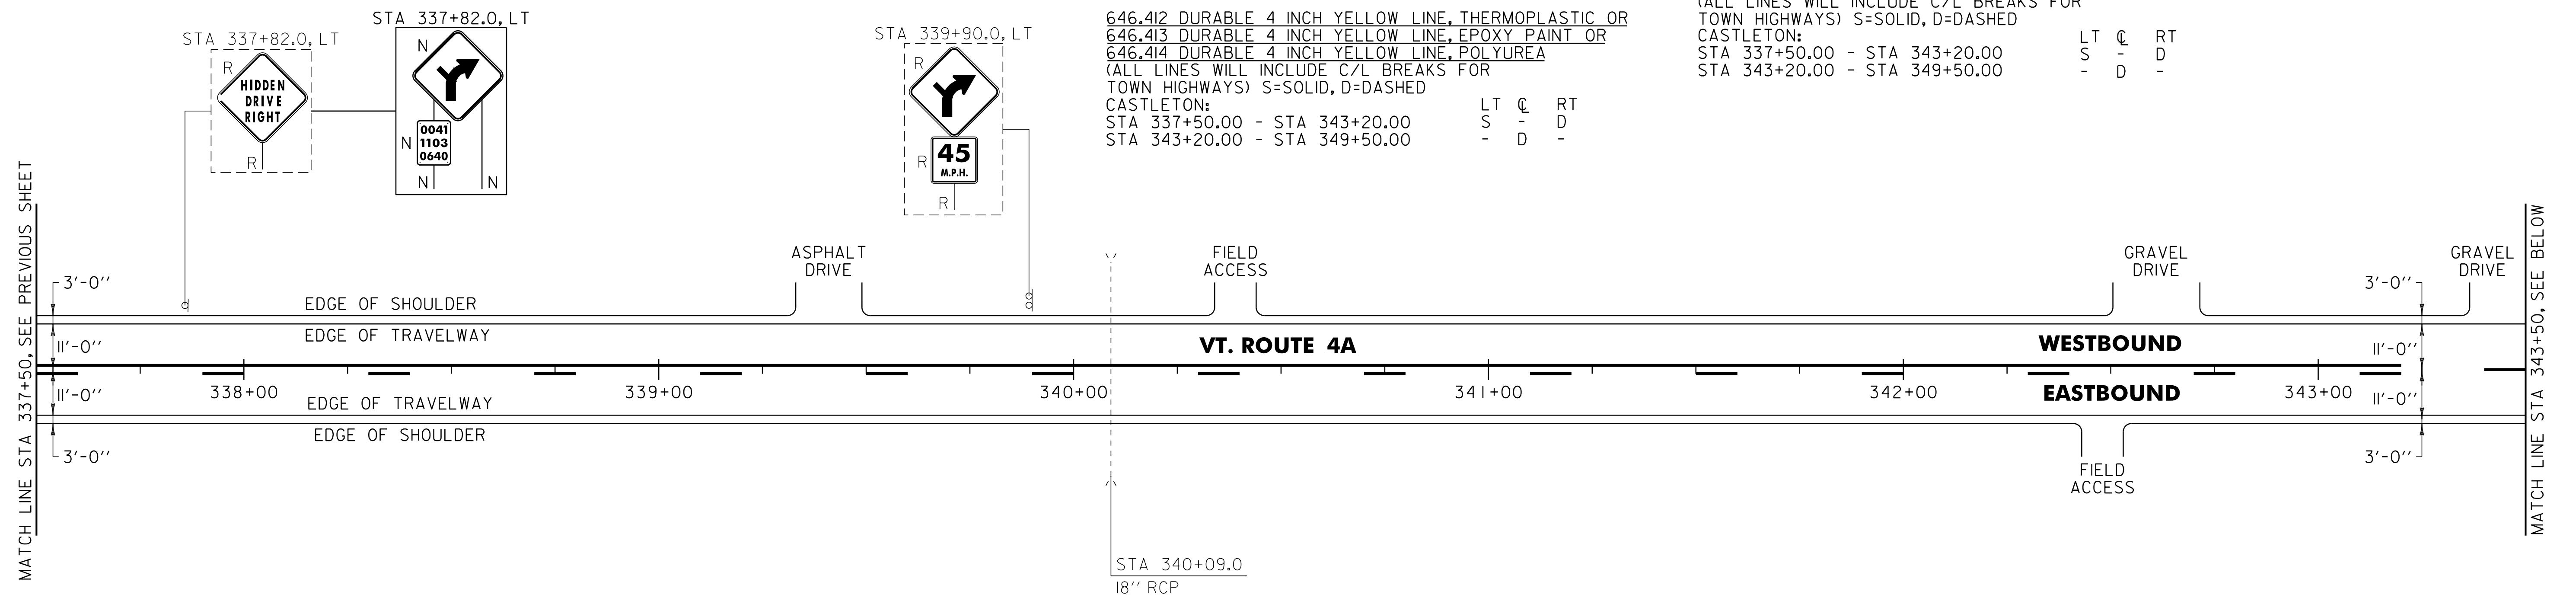

**SIGN LEGEND**  
 R = REMOVE  
 S = SALVAGE  
 N = NEW  
 RET = RETAIN  
 B-B = BACK TO BACK  
 EXISTING = - - - - -  
 NEW = \_\_\_\_\_

**NOT TO SCALE**

<b>PROJECT LAYOUT SHEET #14</b>	PROJECT NAME: CASTLETON - WEST RUTLAND
	PROJECT NUMBER: STP 2705(i)
	FILE NAME: p07cl68.dgn
	PLOT DATE: 04-JUN-2013 09:2
	PROJECT LEADER: D.E.G.
	DRAWN BY: W.G.P.
	DESIGNED BY: M.J.M.
	CHECKED BY: D.E.G.
	IPARM FILE: p07cl68i14.i
	SHEET 35 OF 152