

646.402 DURABLE 4 INCH WHITE LINE, THERMOPLASTIC OR  
 646.403 DURABLE 4 INCH WHITE LINE, EPOXY PAINT OR  
 646.404 DURABLE 4 INCH WHITE LINE, POLYUREA  
 (ALL LINES WILL INCLUDE EDGE LINE BREAKS AND  
 RADIUS FOR TOWN HIGHWAYS)  
 WEST RUTLAND:  
 STA 4+25.00 - STA 16+25.00 EDGE LINE LT & RT

646.412 DURABLE 4 INCH YELLOW LINE, THERMOPLASTIC OR  
 646.413 DURABLE 4 INCH YELLOW LINE, EPOXY PAINT OR  
 646.414 DURABLE 4 INCH YELLOW LINE, POLYUREA  
 (ALL LINES WILL INCLUDE C/L BREAKS FOR  
 TOWN HIGHWAYS) S=SOLID, D=DASHED  
 WEST RUTLAND:  
 STA 4+25.00 - STA 5+80.00 S - D  
 STA 5+80.00 - STA 13+72.00 D - S  
 STA 13+72.00 - STA 16+25.00 S - S


646.602 TEMPORARY 4 INCH WHITE LINE, PAINT  
 (ALL LINES WILL INCLUDE EDGE LINE BREAKS AND  
 RADIUS FOR TOWN HIGHWAYS)  
 WEST RUTLAND:  
 STA 4+25.00 - STA 16+25.00 EDGE LINE LT & RT

646.612 TEMPORARY 4 INCH YELLOW LINE, PAINT  
 (ALL LINES WILL INCLUDE C/L BREAKS FOR  
 TOWN HIGHWAYS) S=SOLID, D=DASHED  
 WEST RUTLAND:  
 STA 4+25.00 - STA 5+80.00 LT C RT  
 S - D  
 STA 5+80.00 - STA 13+72.00 D - S  
 STA 13+72.00 - STA 16+25.00 S - S

675.50 REMOVING SIGNS  
 AS SHOWN - 1


MATCH LINE STA 4+25, SEE PREVIOUS SHEET

MATCH LINE STA 10+25, SEE BELOW

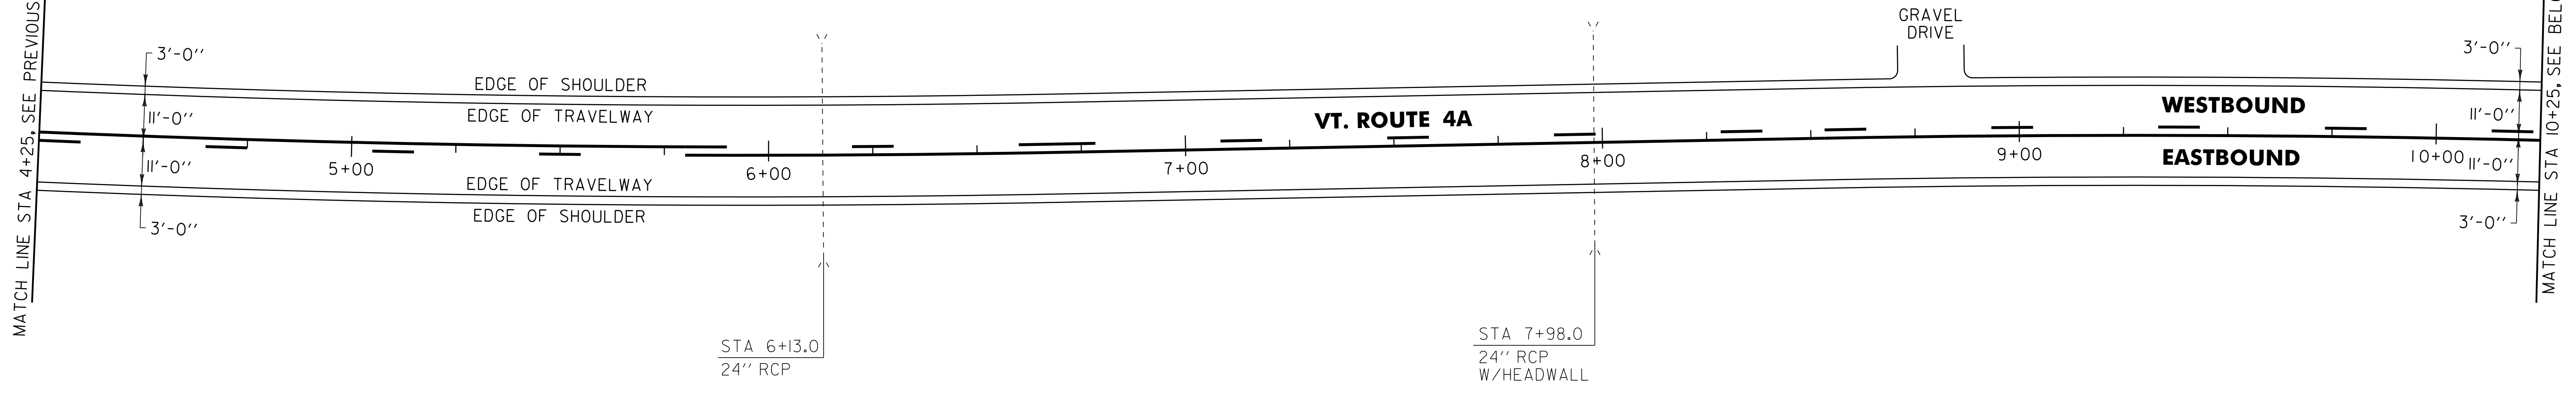

MATCH LINE STA 10+25, SEE ABOVE

MATCH LINE STA 16+25, SEE NEXT SHEET

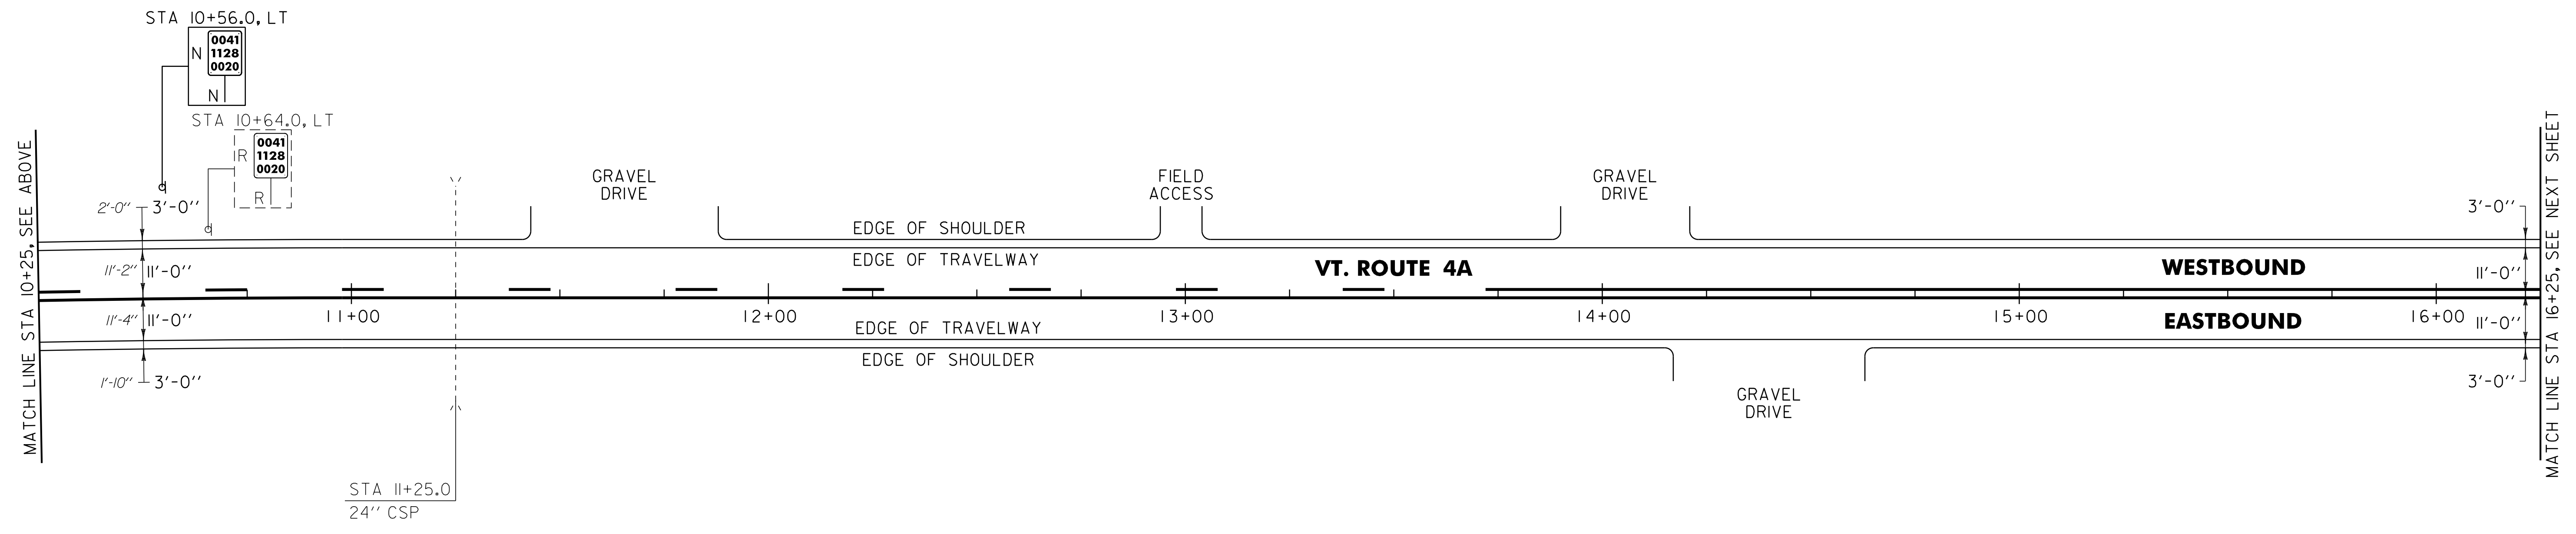

**SIGN LEGEND**  
 R = REMOVE  
 S = SALVAGE  
 N = NEW  
 RET = RETAIN  
 B-B = BACK TO BACK  
 EXISTING = - - - - -  
 NEW = \_\_\_\_\_

**NOT TO SCALE**

|                                 |  |                             |
|---------------------------------|--|-----------------------------|
| <b>PROJECT LAYOUT SHEET #23</b> | PROJECT NAME: CASTLETON - WEST RUTLAND | PLOT DATE: 04-JUN-2013 09:2 |
|                                 | PROJECT NUMBER: STP 2705(i)            | DRAWN BY: W.G.P.            |
|                                 | FILE NAME: p07cl68.dgn                 | CHECKED BY: D.E.G.          |
|                                 | DESIGNED BY: M.J.M.                    | SHEET 44 OF 152             |
|                                 | IPARM FILE: p07cl68i23.i               |                             |