

646.402 DURABLE 4 INCH WHITE LINE, THERMOPLASTIC OR  
 646.403 DURABLE 4 INCH WHITE LINE, EPOXY PAINT OR  
 646.404 DURABLE 4 INCH WHITE LINE, POLYUREA  
 (ALL LINES WILL INCLUDE EDGE LINE BREAKS AND  
 RADIUS FOR TOWN HIGHWAYS)  
 CASTLETON:  
 STA 182+75.00 - STA 188+75.00 EDGE LINE LT & RT

646.412 DURABLE 4 INCH YELLOW LINE, THERMOPLASTIC OR  
 646.413 DURABLE 4 INCH YELLOW LINE, EPOXY PAINT OR  
 646.414 DURABLE 4 INCH YELLOW LINE, POLYUREA  
 (ALL LINES WILL INCLUDE C/L BREAKS FOR  
 TOWN HIGHWAYS) S=SOLID, D=DASHED  
 CASTLETON:  
 STA 182+75.00 - STA 188+75.00

LT C RT  
 S - S

646.602 TEMPORARY 4 INCH WHITE LINE, PAINT  
 (ALL LINES WILL INCLUDE EDGE LINE BREAKS AND  
 RADIUS FOR TOWN HIGHWAYS)  
 CASTLETON:  
 STA 182+75.00 - STA 188+75.00


646.612 TEMPORARY 4 INCH YELLOW LINE, PAINT  
 (ALL LINES WILL INCLUDE C/L BREAKS FOR  
 TOWN HIGHWAYS) S=SOLID, D=DASHED  
 CASTLETON:  
 STA 182+75.00 - STA 188+75.00

LT C RT  
 S - S

646.442 DURABLE 8 INCH WHITE LINE, THERMOPLASTIC OR  
 646.443 DURABLE 8 INCH WHITE LINE, EPOXY PAINT OR  
 646.444 DURABLE 8 INCH WHITE LINE, POLYUREA  
 CASTLETON:  
 STA 185+88.0 - STA 186+00.0 FIRE HYDRANT NO PARKING ZONE RT

675.50 REMOVING SIGNS  
 AS SHOWN - 6

675.60 ERECTING SALVAGED SIGNS  
 AS SHOWN - 1

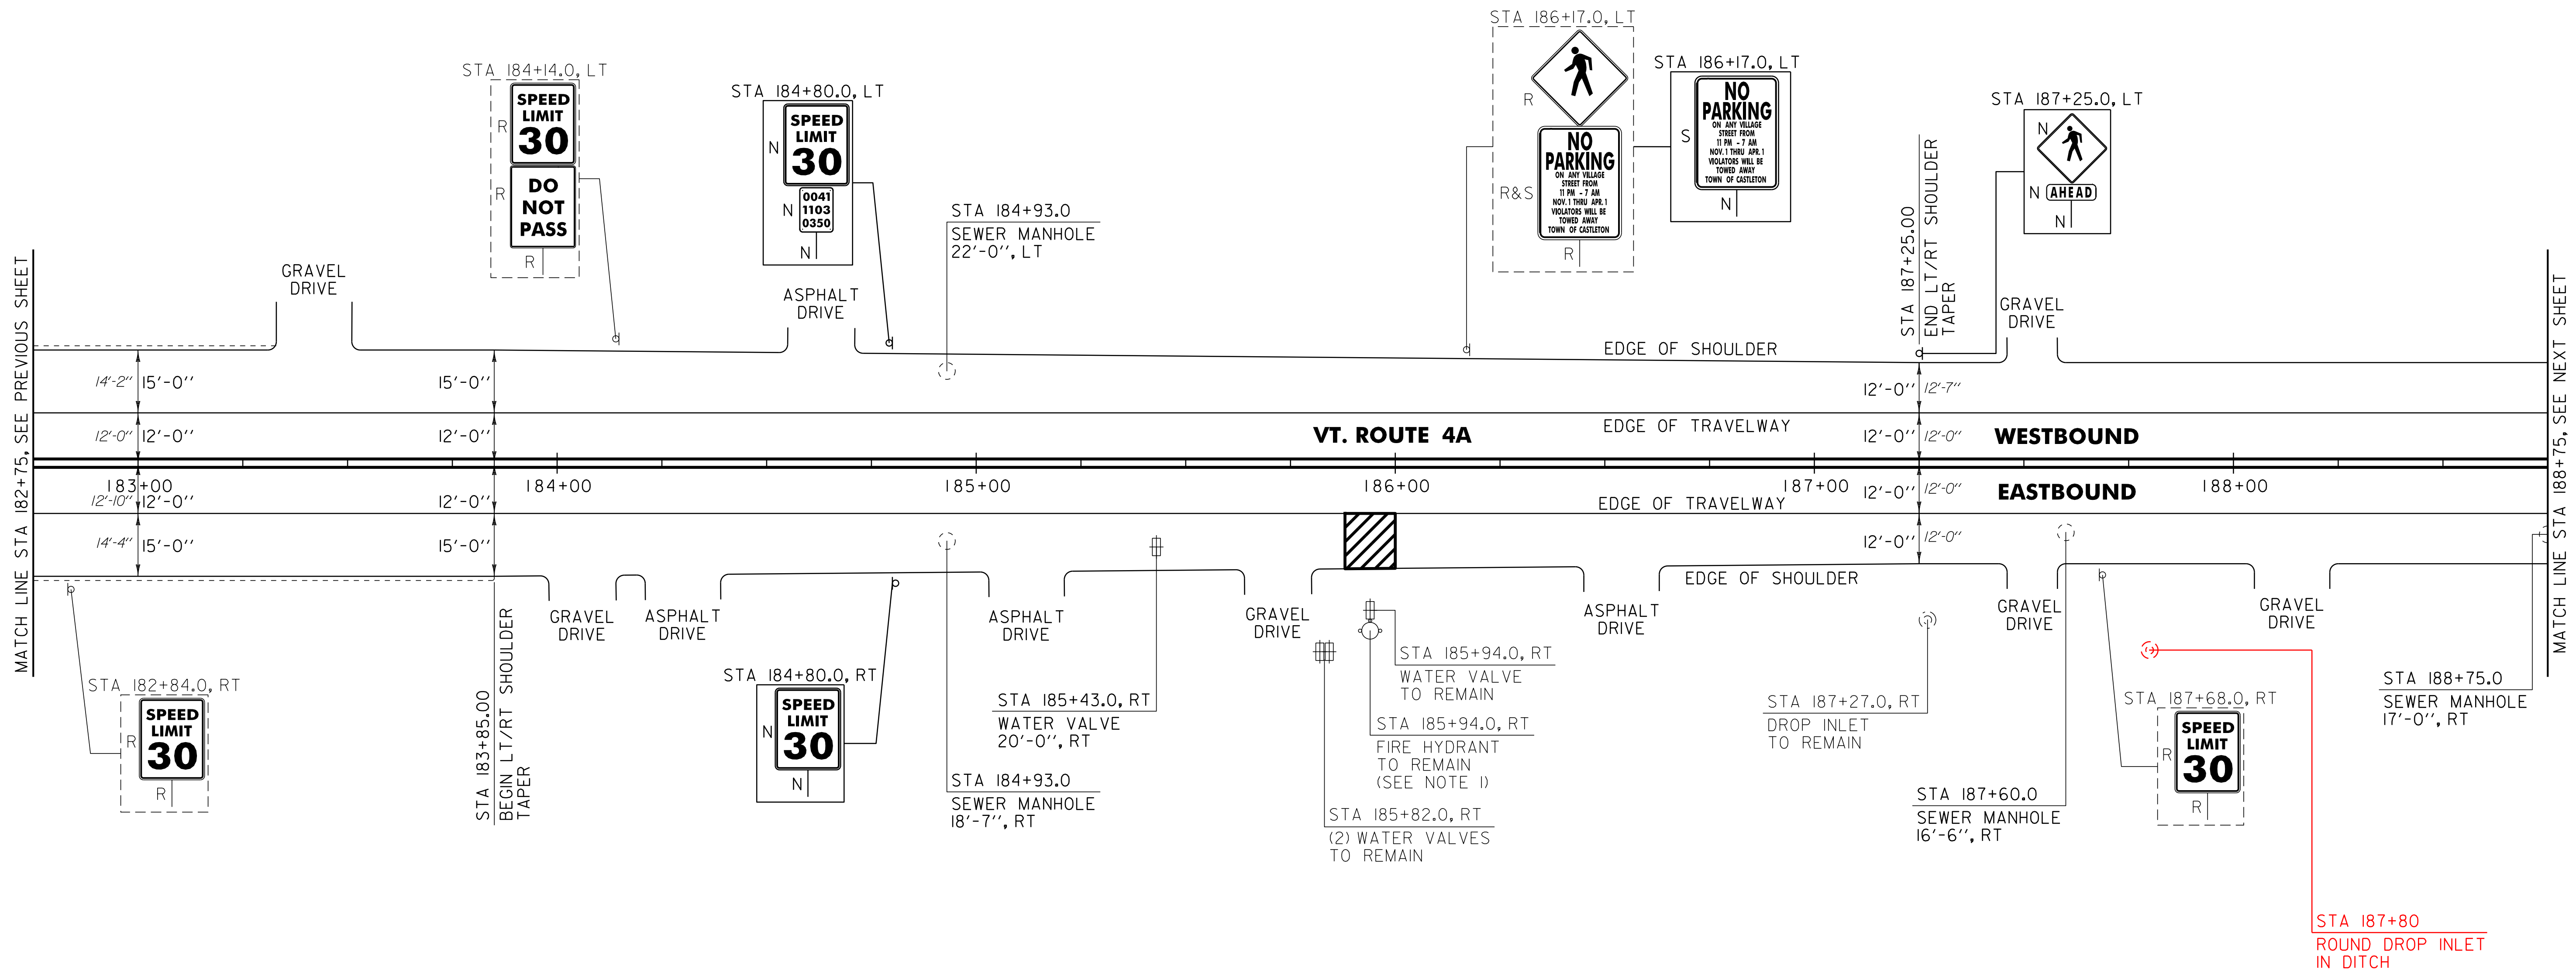

NOTE:  
 1. SEE SHEET 8 FOR FIRE HYDRANT PAVEMENT MARKING DETAIL.

604.42 CHANGING ELEVATION OF SEWER MANHOLES  
 CASTLETON:  
 STA 184+93.0 LT  
 STA 184+93.0 RT  
 STA 187+60.0 RT  
 STA 188+75.0 RT

629.20 ADJUST ELEVATION OF VALVE BOX  
 CASTLETON:  
 STA 185+43.0 RT

SIGN LEGEND  
 R = REMOVE  
 S = SALVAGE  
 N = NEW  
 RET = RETAIN  
 B-B = BACK TO BACK  
 EXISTING = - - - - -  
 NEW = \_\_\_\_\_

NOT TO SCALE

<b>PROJECT LAYOUT SHEET #7</b>	PROJECT NAME: CASTLETON	PLOT DATE: 04-JUN-2013 09:2
	PROJECT NUMBER: STP 2908(1)	DRAWN BY: W.G.P.
	FILE NAME: p10c210.dgn	CHECKED BY: D.E.G.
	PROJECT LEADER: D.E.G. DESIGNED BY: M.J.M. IPARM FILE: p10c210107.i	SHEET 104 OF 152