


646.402 DURABLE 4 INCH WHITE LINE, THERMOPLASTIC OR  
 646.403 DURABLE 4 INCH WHITE LINE, EPOXY PAINT OR  
 646.404 DURABLE 4 INCH WHITE LINE, POLYUREA  
 (ALL LINES WILL INCLUDE EDGE LINE BREAKS AND  
 RADIUS FOR TOWN HIGHWAYS)  
 CASTLETON:  
 STA 200+00.00 - STA 203+49.12 EDGE LINE LT & RT

646.412 DURABLE 4 INCH YELLOW LINE, THERMOPLASTIC OR  
 646.413 DURABLE 4 INCH YELLOW LINE, EPOXY PAINT OR  
 646.414 DURABLE 4 INCH YELLOW LINE, POLYUREA  
 (ALL LINES WILL INCLUDE C/L BREAKS FOR  
 TOWN HIGHWAYS) S=SOLID, D=DASHED  
 CASTLETON:  
 STA 200+00.00 - STA 203+49.12 LT ☐ RT  
 S - S

646.602 TEMPORARY 4 INCH WHITE LINE, PAINT  
 (ALL LINES WILL INCLUDE EDGE LINE BREAKS AND  
 RADIUS FOR TOWN HIGHWAYS)  
 CASTLETON:  
 STA 200+00.00 - STA 203+49.12 EDGE LINE LT & RT

646.612 TEMPORARY 4 INCH YELLOW LINE, PAINT  
 (ALL LINES WILL INCLUDE C/L BREAKS FOR  
 TOWN HIGHWAYS) S=SOLID, D=DASHED  
 CASTLETON:  
 STA 200+00.00 - STA 203+49.12 LT ☐ RT  
 S - S

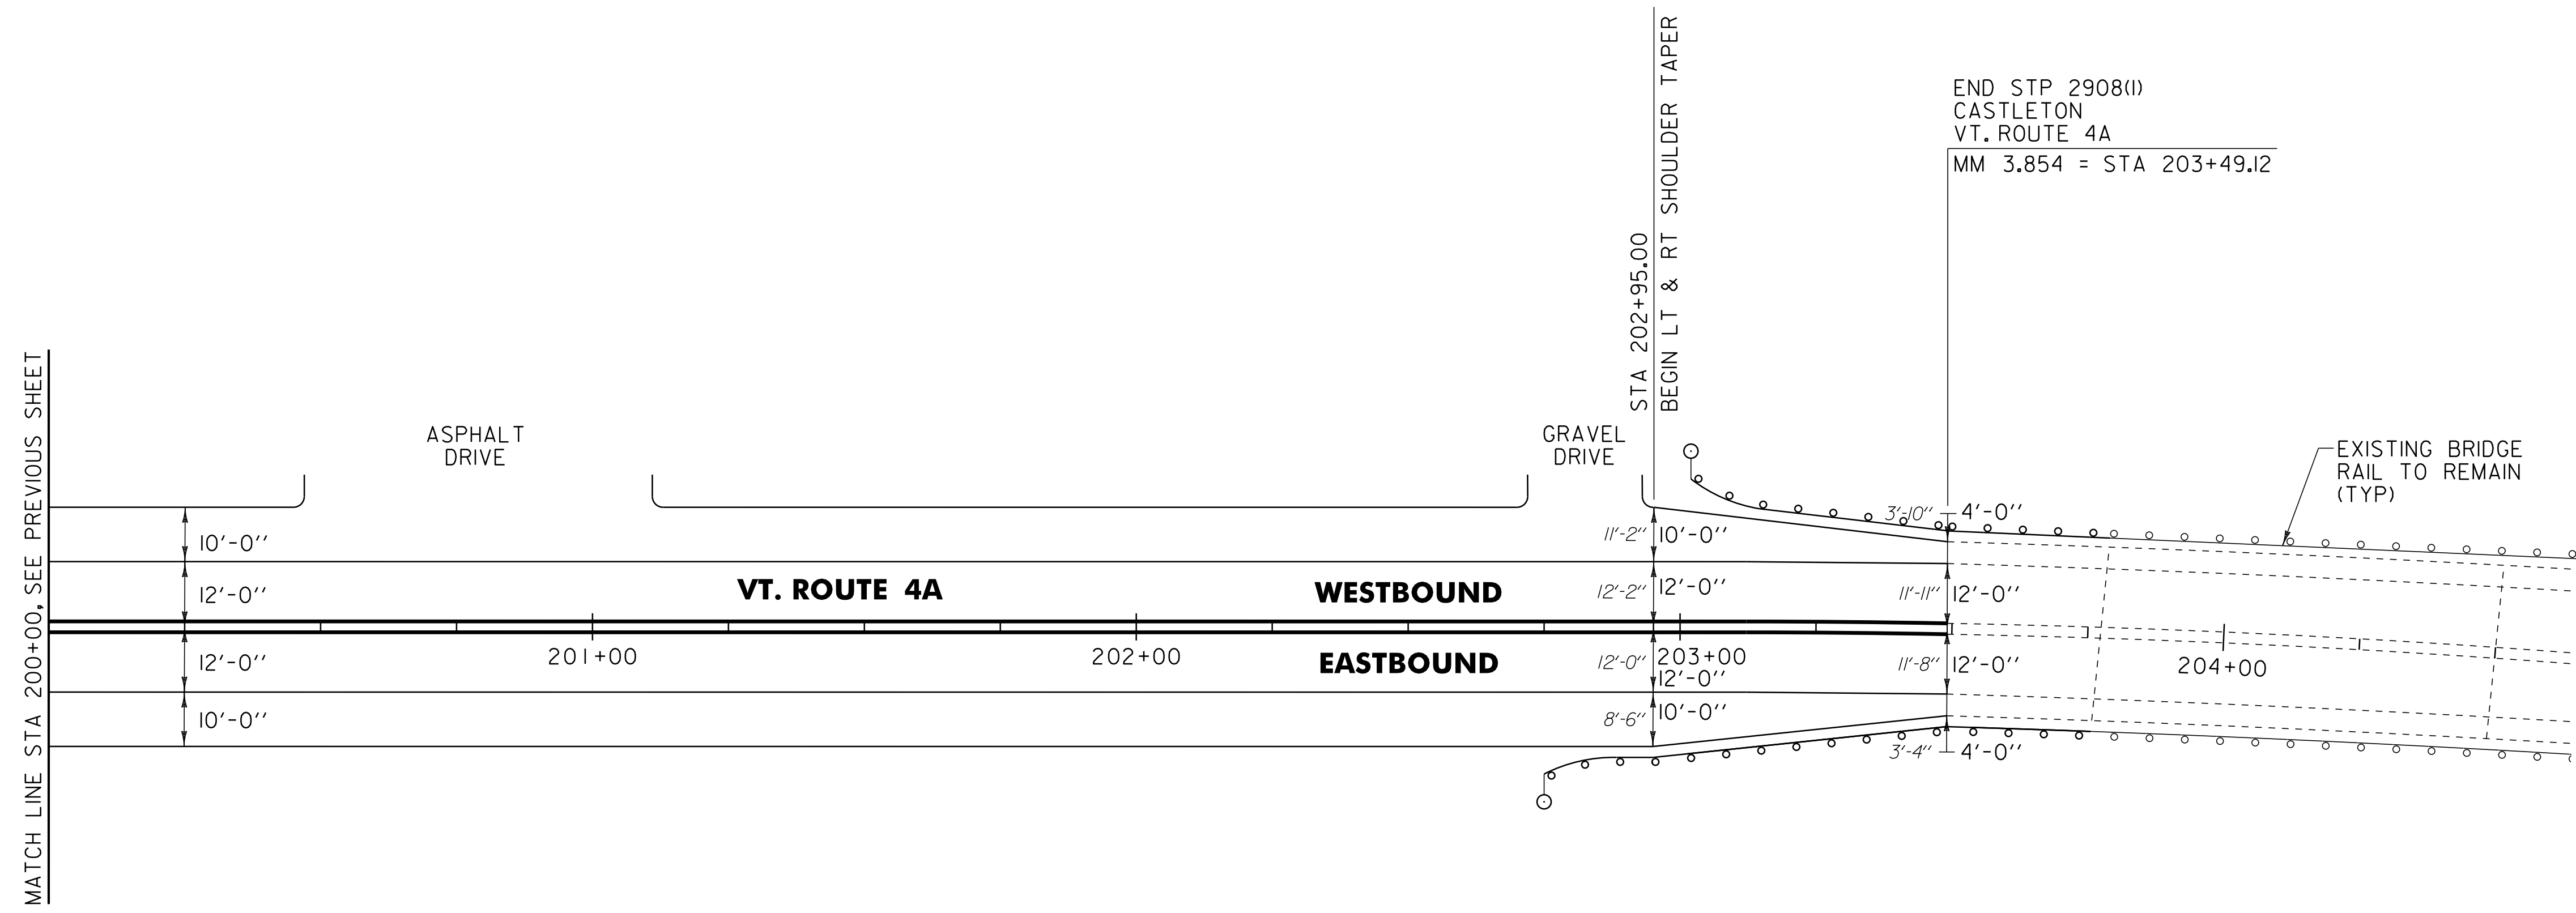

MATCH LINE STA 200+00, SEE PREVIOUS SHEET

621.20 STEEL BEAM GUARDRAIL, GALVANIZED  
 CASTLETON:  
 STA 202+75.0 - STA 203+52.0 RT (77.0 LF)  
 STA 203+00.0 - STA 203+52.0 LT (52.0 LF)

621.60 ANCHOR FOR STEEL BEAM RAIL  
 CASTLETON:  
 STA 202+81.5 RT  
 STA 203+06.5 LT

621.21 HD STEEL BEAM GUARDRAIL, GALVANIZED  
 CASTLETON:  
 STA 203+52.0 - STA 203+77.0 LT (32.5 LF)  
 STA 203+52.0 - STA 203+77.0 RT (32.5 LF)

621.80 REMOVAL AND DISPOSAL OF GUARDRAIL  
 CASTLETON:  
 STA 202+78.0 - STA 203+79.0 RT (101.0 LF)  
 STA 202+95.0 - STA 203+79.0 LT (84.0 LF)

621.53 TERMINAL CONNECTOR FOR STEEL BEAM GUARDRAIL  
 CASTLETON:  
 STA 203+77.0 - STA 203+79.0 LT  
 STA 203+77.0 - STA 203+79.0 RT

676.10 DELINEATOR WITH STEEL POST  
 CASTLETON:  
 STA 202+75.0 RT  
 STA 203+00.0 LT

**SIGN LEGEND**  
 R = REMOVE  
 S = SALVAGE  
 N = NEW  
 RET = RETAIN  
 B-B = BACK TO BACK  
 EXISTING = - - - - -  
 NEW = \_\_\_\_\_

<b>PROJECT LAYOUT SHEET #10</b>	<b>NOT TO SCALE</b>	
	PROJECT NAME: CASTLETON	PROJECT NUMBER: STP 2908(1)
	FILE NAME: p10c210.dgn	PLOT DATE: 04-JUN-2013 09:2
	PROJECT LEADER: D.E.G. DESIGNED BY: M.J.M. IPARM FILE: p10c21010.i	DRAWN BY: W.G.P. CHECKED BY: D.E.G. SHEET 107 OF 152