
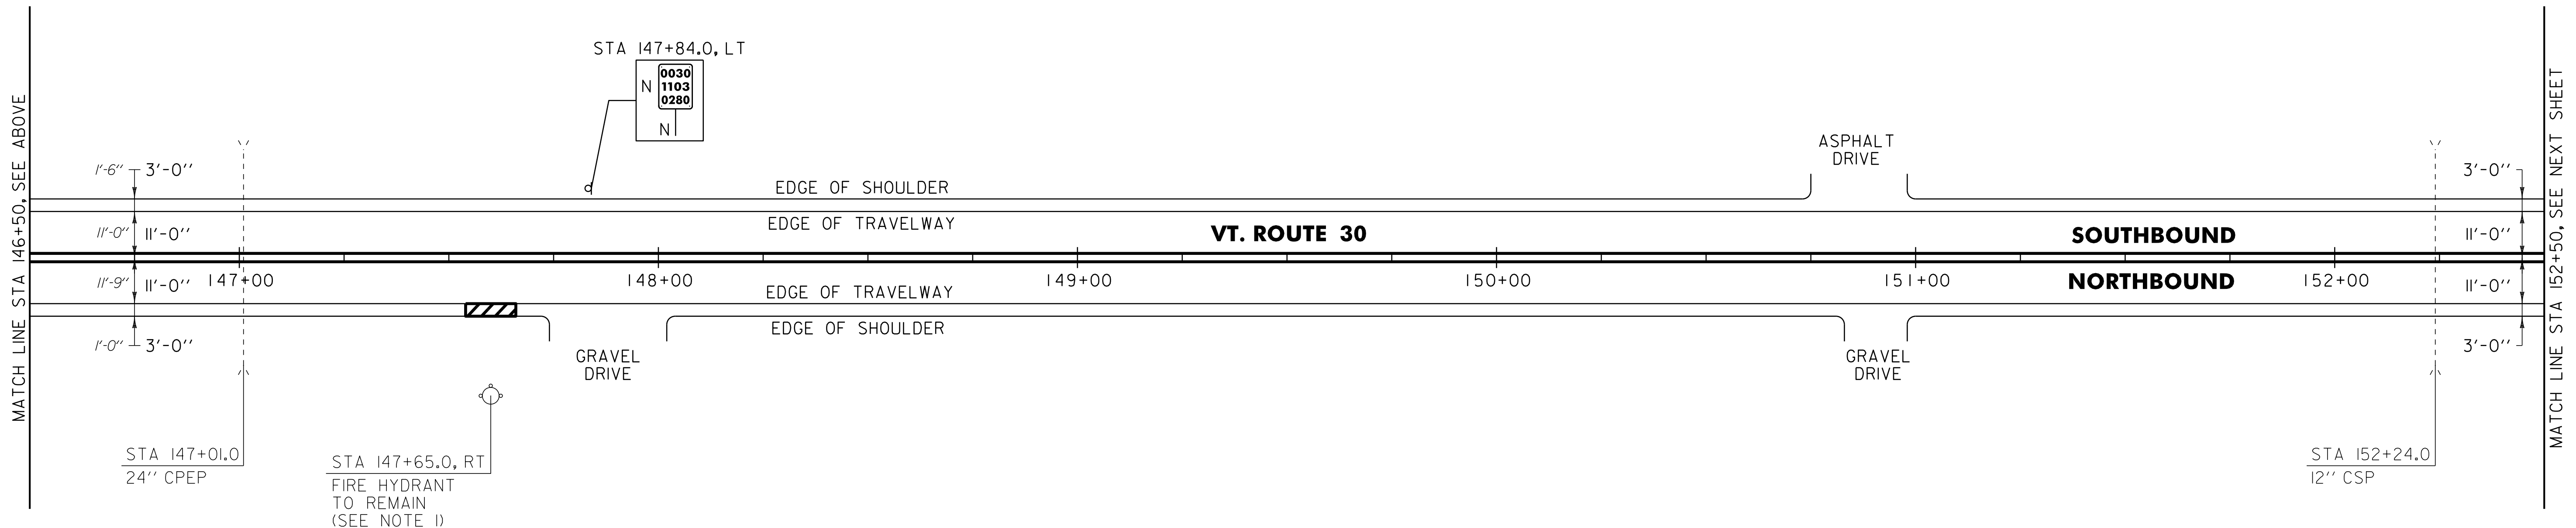


646.402 DURABLE 4 INCH WHITE LINE, THERMOPLASTIC OR  
 646.403 DURABLE 4 INCH WHITE LINE, EPOXY PAINT OR  
 646.404 DURABLE 4 INCH WHITE LINE, POLYUREA  
 (ALL LINES WILL INCLUDE EDGE LINE BREAKS AND  
 RADIUS FOR TOWN HIGHWAYS)  
 CASTLETON:  
 STA 140+50.00 - STA 152+50.00 EDGE LINE LT & RT

646.412 DURABLE 4 INCH YELLOW LINE, THERMOPLASTIC OR  
 646.413 DURABLE 4 INCH YELLOW LINE, EPOXY PAINT OR  
 646.414 DURABLE 4 INCH YELLOW LINE, POLYUREA  
 (ALL LINES WILL INCLUDE C/L BREAKS FOR  
 TOWN HIGHWAYS) S=SOLID, D=DASHED  
 CASTLETON:  
 STA 140+50.00 - STA 152+50.00 LT CL RT  
 S - S

646.602 TEMPORARY 4 INCH WHITE LINE, PAINT  
 (ALL LINES WILL INCLUDE EDGE LINE BREAKS AND  
 RADIUS FOR TOWN HIGHWAYS)  
 CASTLETON:  
 STA 140+50.00 - STA 152+50.00 LT CL RT  
 S - S

646.442 DURABLE 8 INCH WHITE LINE, THERMOPLASTIC OR  
 646.443 DURABLE 8 INCH WHITE LINE, EPOXY PAINT OR  
 646.444 DURABLE 8 INCH WHITE LINE, POLYUREA  
 CASTLETON:  
 STA 144+19.0 - STA 144+31.0 FIRE HYDRANT NO PARKING ZONE RT  
~~STA 147+59.0 - STA 147+71.0 FIRE HYDRANT NO PARKING ZONE RT~~

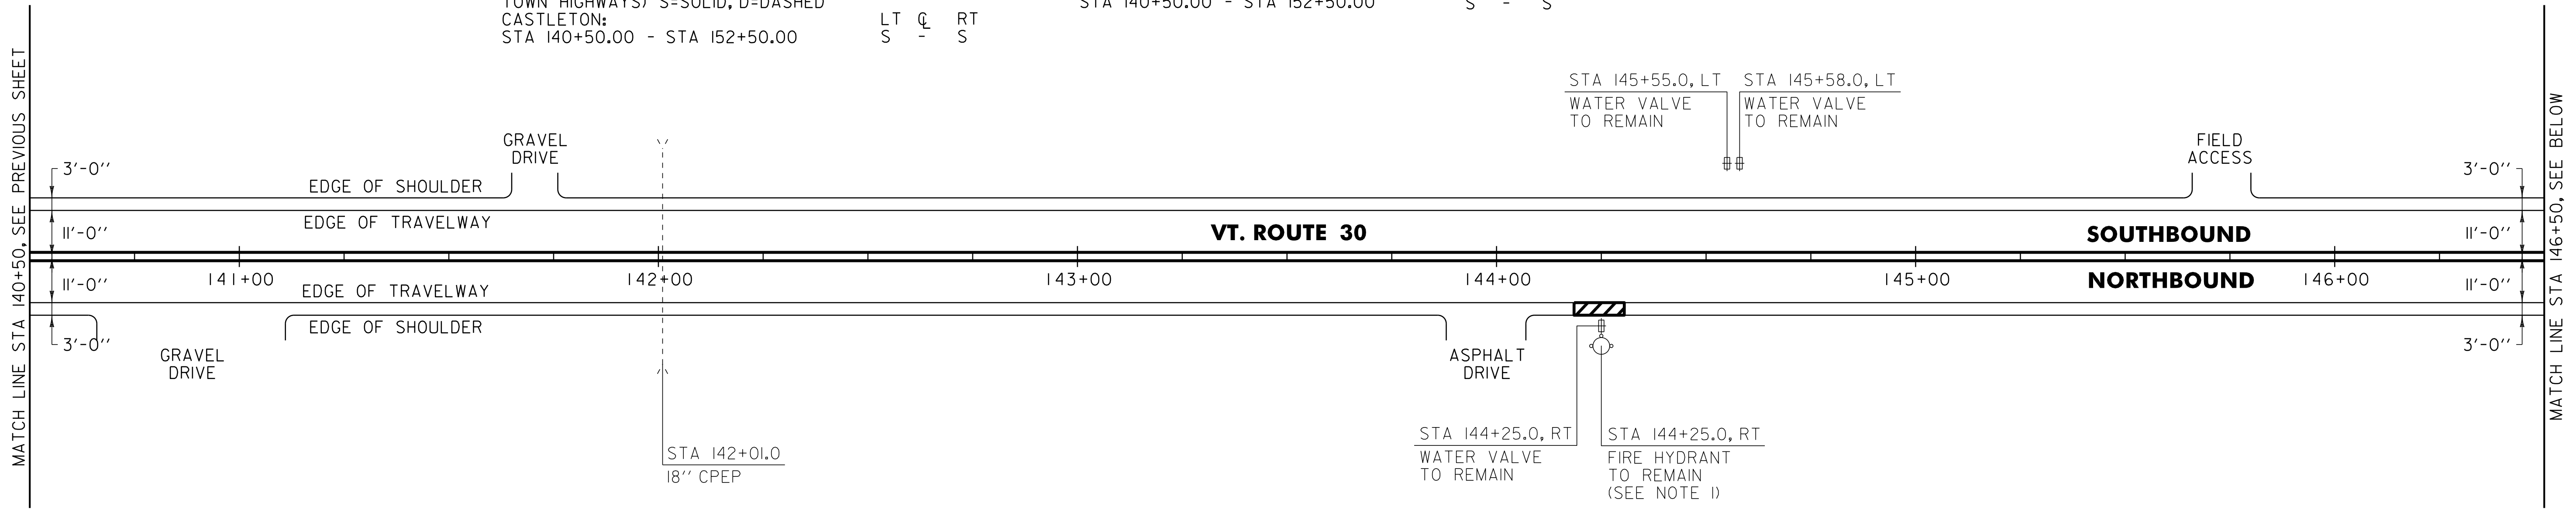

NOTE:  
 1. SEE SHEET 8 FOR FIRE HYDRANT PAVEMENT MARKING DETAIL.

**SIGN LEGEND**  
 R = REMOVE  
 S = SALVAGE  
 N = NEW  
 RET = RETAIN  
 B-B = BACK TO BACK  
 EXISTING = - - - - -  
 NEW = \_\_\_\_\_

**NOT TO SCALE**

<b>PROJECT LAYOUT SHEET #11</b>	PROJECT NAME: CASTLETON	PLOT DATE: 04-JUN-2013 09:2
	PROJECT NUMBER: STP 2909(1)	DRAWN BY: W.G.P.
	FILE NAME: p10c212.dgn	CHECKED BY: D.E.G.
	DESIGNED BY: M.J.M.	SHEET 139 OF 152