


SEE SECTIONS DRAFTED ON SECTION PAPER FOR MORE DETAILS & QUANTITIES

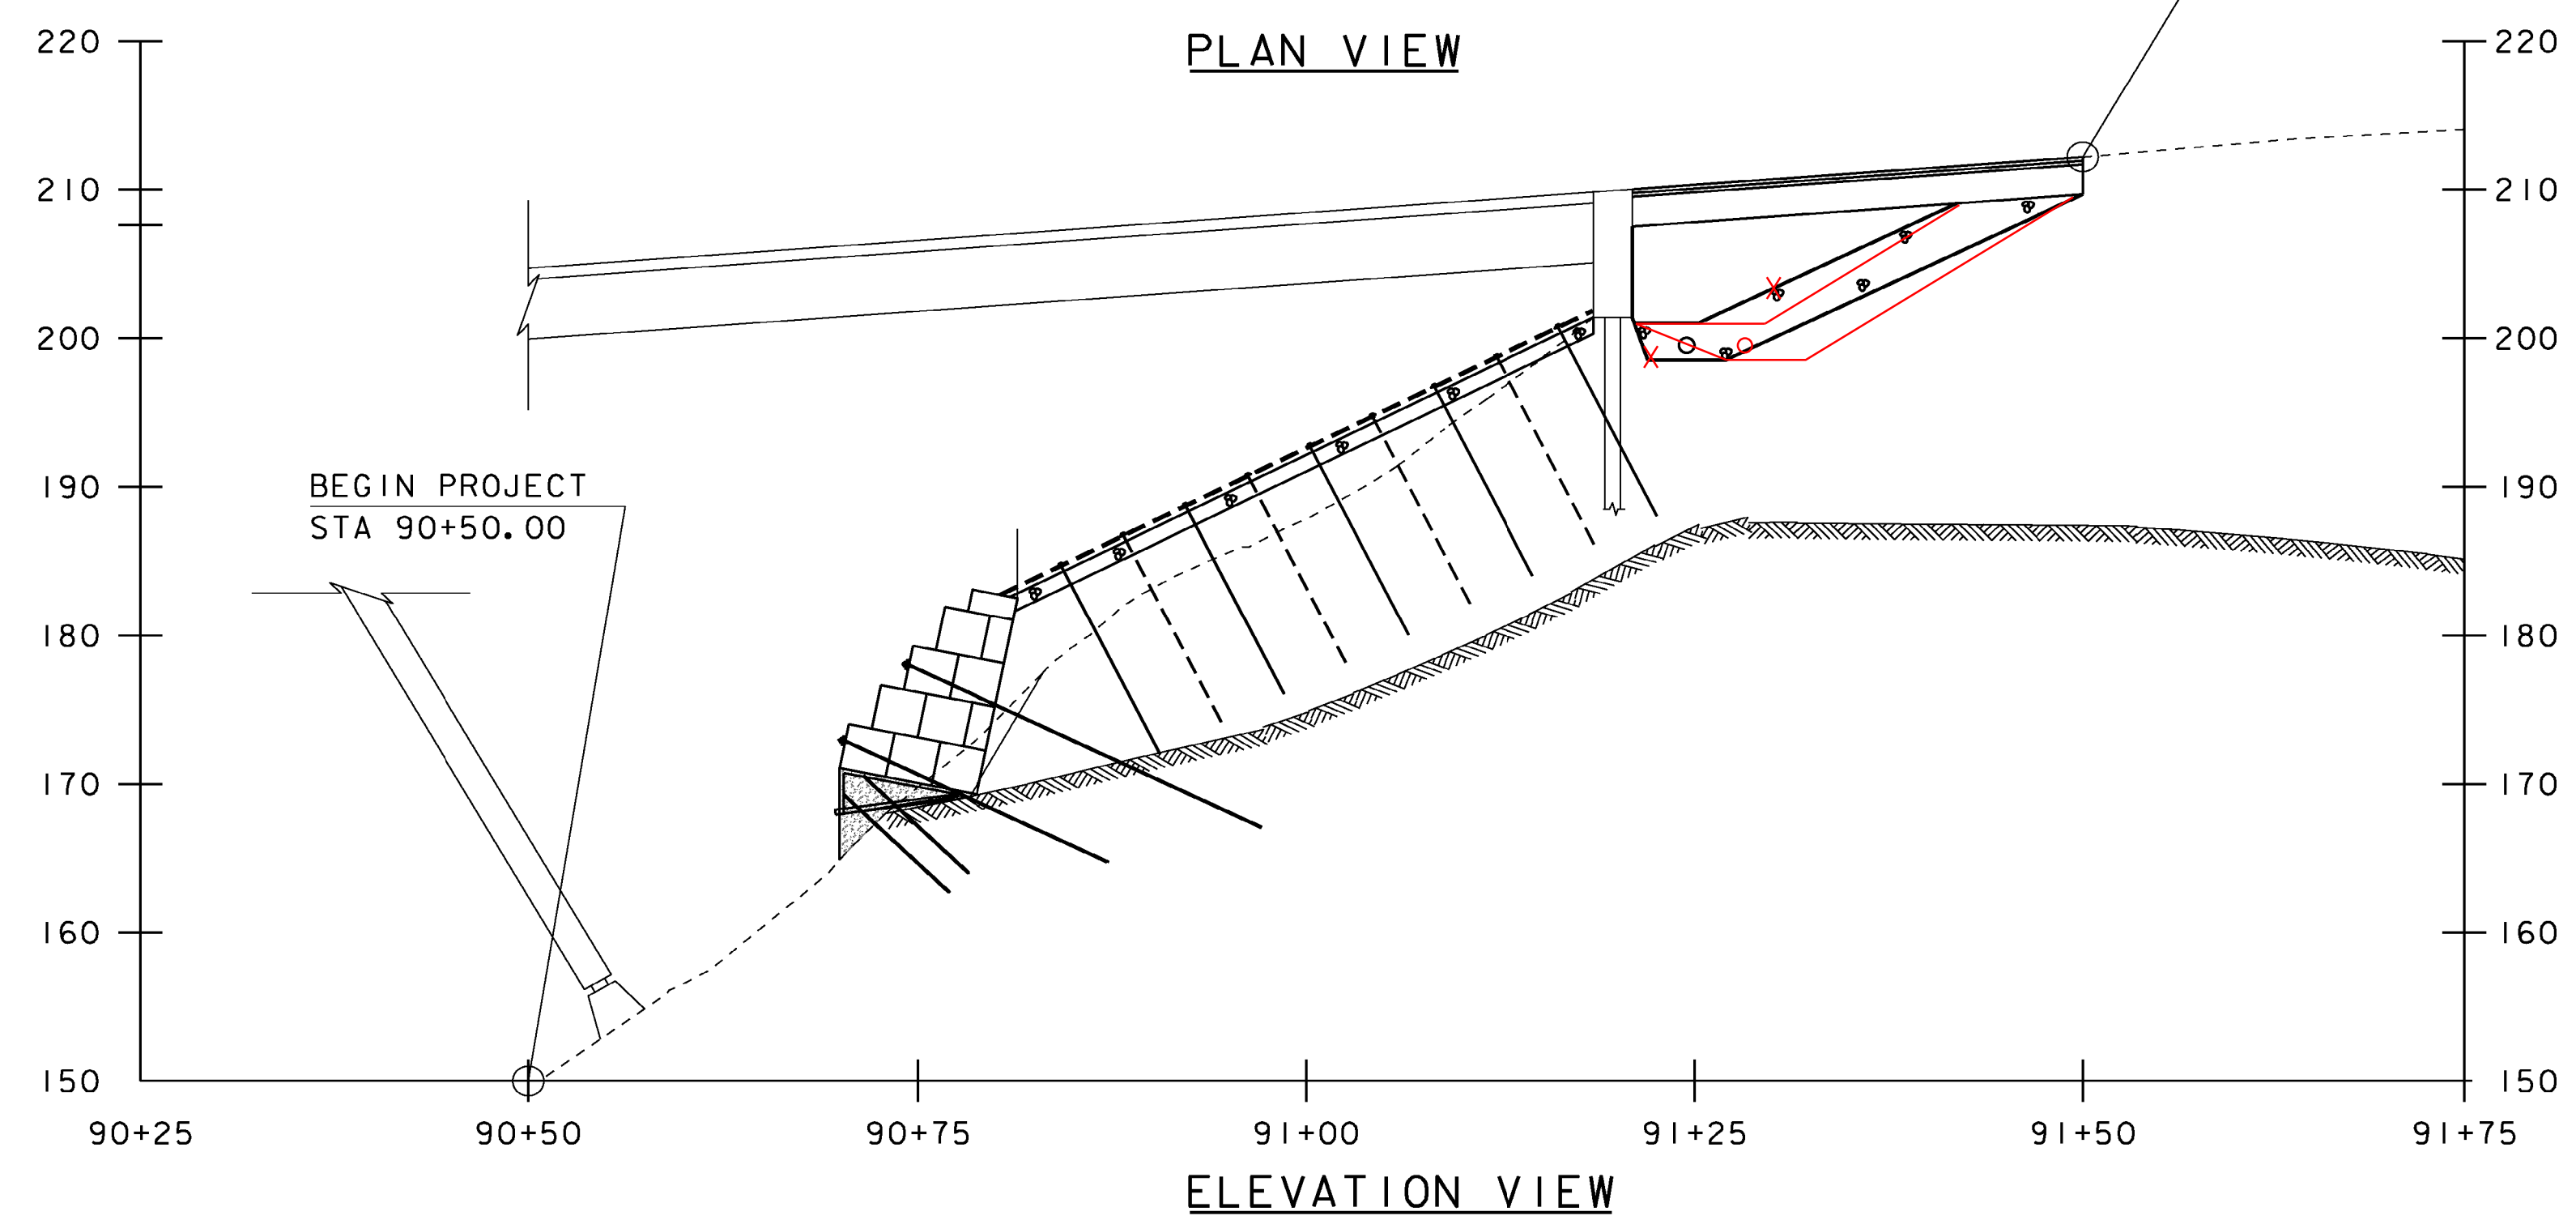

SCALE 1" = 10' - 0"

10 0 10

PROJECT NAME: HIGHGATE	PLOT DATE: 24-JAN-2013
PROJECT NUMBER: STP 0297(8)	DRAWN BY: J. SALVATORI
FILE NAME: sl0c218pe.dgn	CHECKED BY: W. LAMMER
PROJECT LEADER: K. HIGGINS	SHEET 5 OF 20
DESIGNED BY: J. SALVATORI	
PLAN & ELEVATION	