


**UNDERDRAIN TYPICAL**  
SCALE 1/2" = 1'-0"

**GABION SCHEDULE**

ROW FROM BOTTOM	WIDTH (MIN)
ROW 1	9'-0"
ROW 2	7'-6"
ROW 3	6'-0"
ROW 4	4'-6"
ROW 5	3'-0"

**NOTES:**

- AT BOTH ENDS OF THE GABION WALL, THE CONCRETE BASE AND GABION BASKETS ALIGNMENT SHALL BE FIELD ADJUSTED TO FIRMLY ABUT THE WALL INTO THE EXISTING SLOPE. ALL ADJUSTMENTS SHALL BE SUBJECT TO ENGINEER'S APPROVAL.
- ANY ADJUSTMENT TO SIZE OR LENGTH OF THE GABION BASKETS SHALL BE APPROVED BY THE ENGINEER.

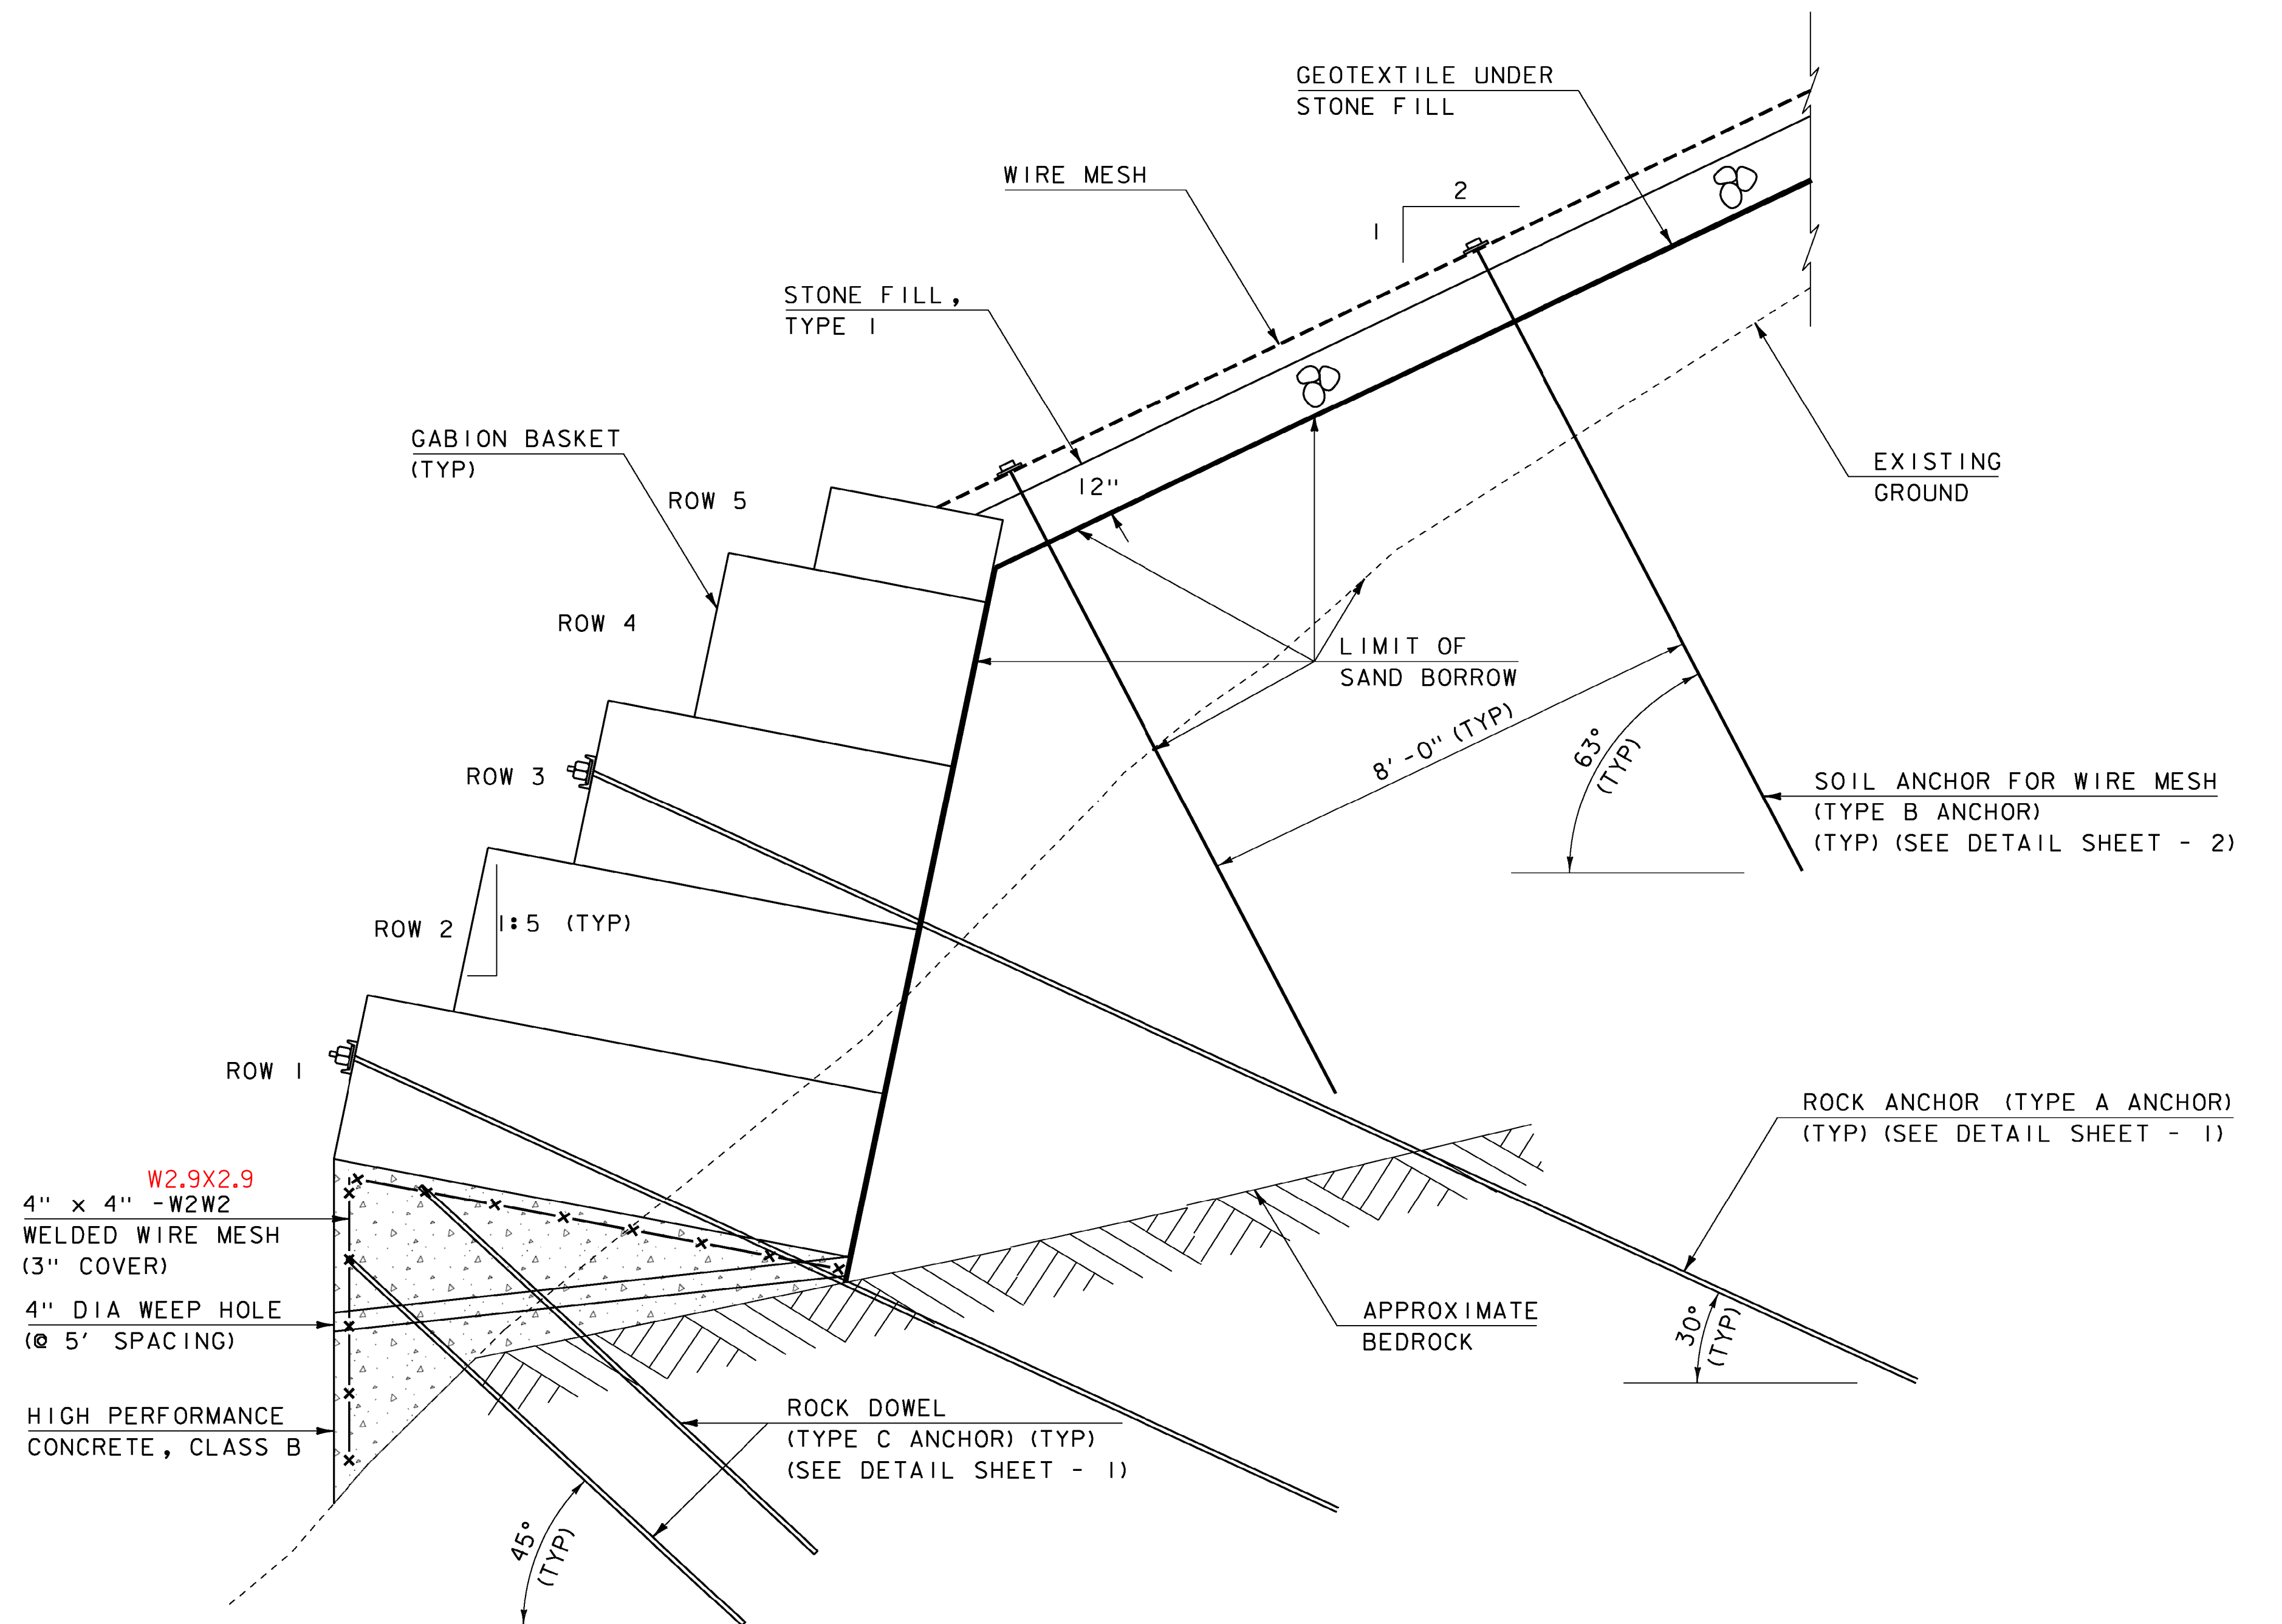

**GABION WALL TYPICAL**  
SCALE 1/2" = 1'-0"

PROJECT NAME: HIGHGATE	PLOT DATE: 24-JAN-2013
PROJECT NUMBER: STP 0297(8)	DRAWN BY: J. SALVATORI
FILE NAME: Str/s10c218typ.dgn	DESIGNED BY: J. SALVATORI
TYPICAL SECTIONS - 2	CHECKED BY: W. LAMMER
	SHEET 7 OF 20