



HD STEEL BEAM GUARDRAIL, GALVANIZED  
 STA 91+18.50 TO 91+50.00 LT/RT

REMOVAL AND DISPOSAL OF GUARDRAIL  
 STA 91+18.50 TO 91+50.00 LT/RT

4 INCH WHITE LINE  
 STA 91+21.00 TO 91+50.00 LT/RT

4 INCH YELLOW LINE (DOUBLE)  
 STA 91+18.50 TO 91+50.00

**TOWN OF HIGHGATE**

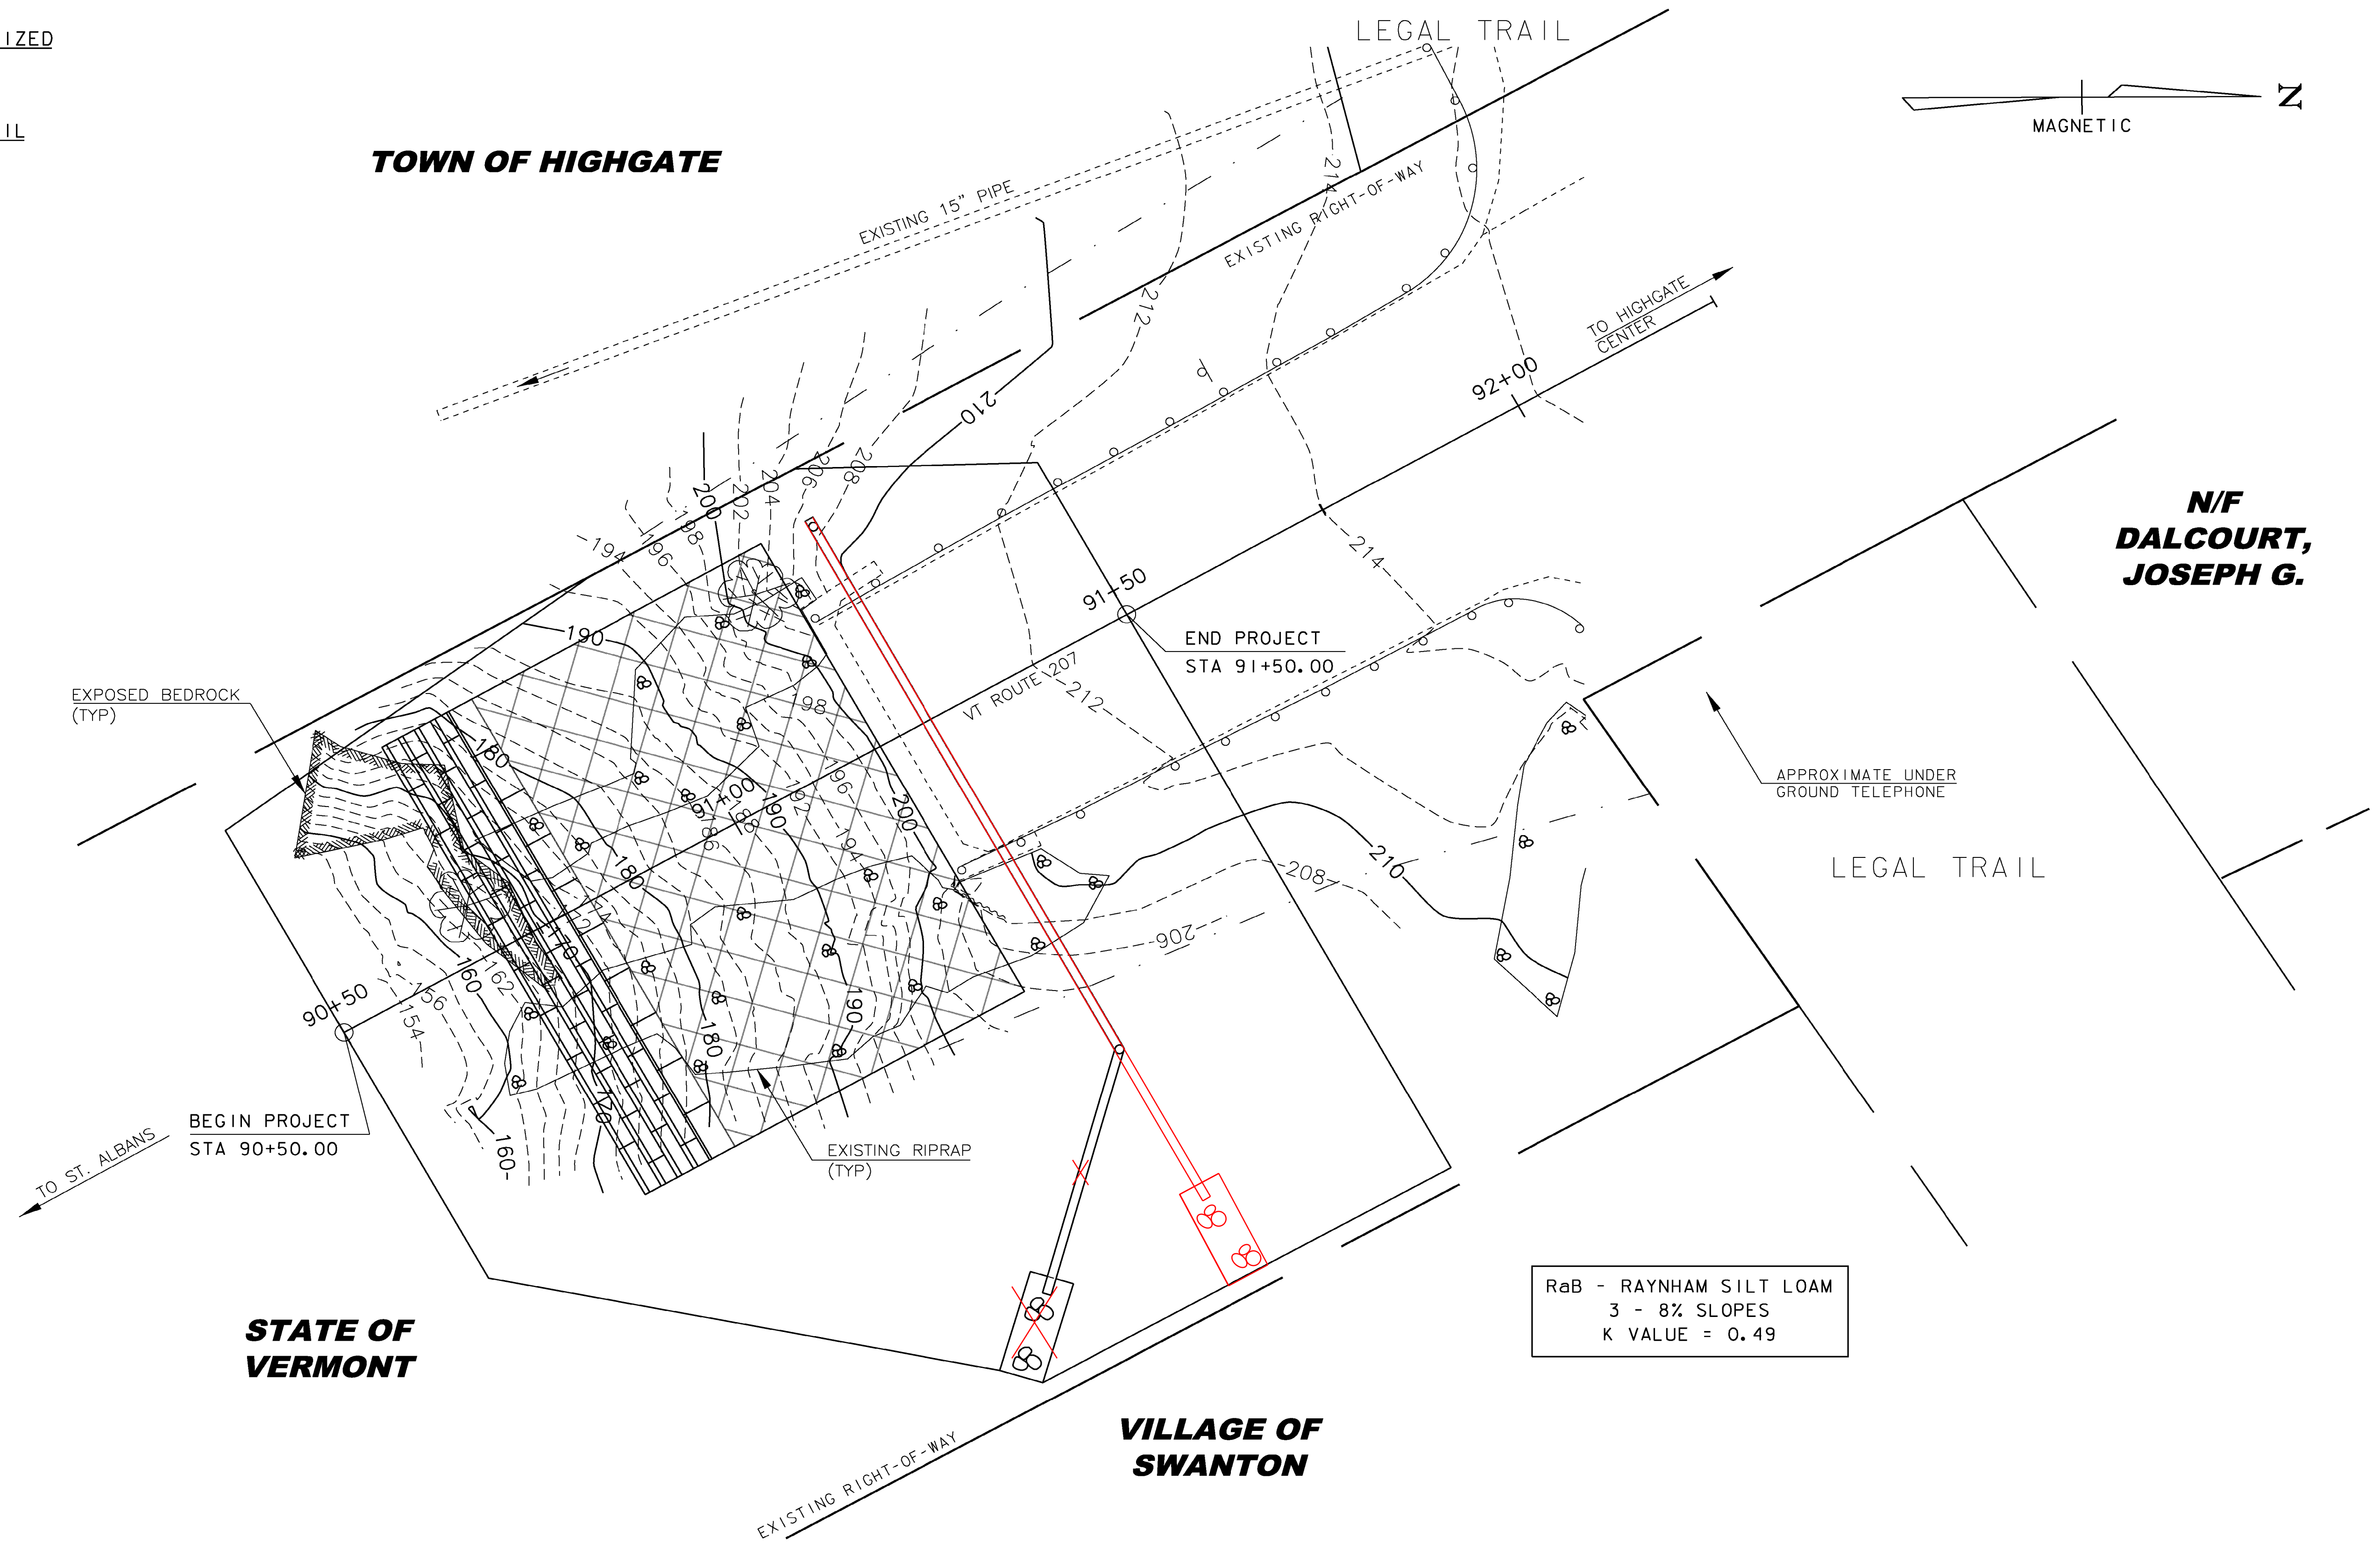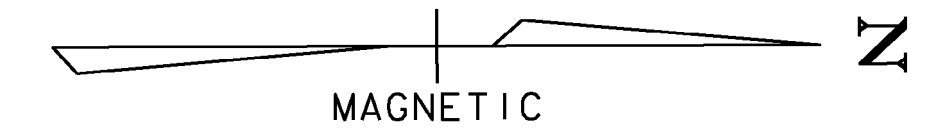

**N/F  
 DALCOURT,  
 JOSEPH G.**

**STATE OF  
 VERMONT**

**VILLAGE OF  
 SWANTON**

RaB - RAYNHAM SILT LOAM  
 3 - 8% SLOPES  
 K VALUE = 0.49

**NOTES**

1. BRIDGE SUPERSTRUCTURE IS NOT SHOWN FOR CLARITY.

**LAYOUT SHEET**

SCALE 1" = 10'-0"

PROJECT NAME: HIGHGATE  
 PROJECT NUMBER: STP 0297(8)

|                                      |                        |
|--------------------------------------|------------------------|
| FILE NAME: i0c218/str/s10cl28bdr.dgn | PLOT DATE: 24-JAN-2013 |
| PROJECT LEADER: K. HIGGINS           | DRAWN BY: J. SALVATORI |
| DESIGNED BY: J. SALVATORI            | CHECKED BY: W. LAMMER  |
| LAYOUT SHEET                         | SHEET 9 OF 20          |