
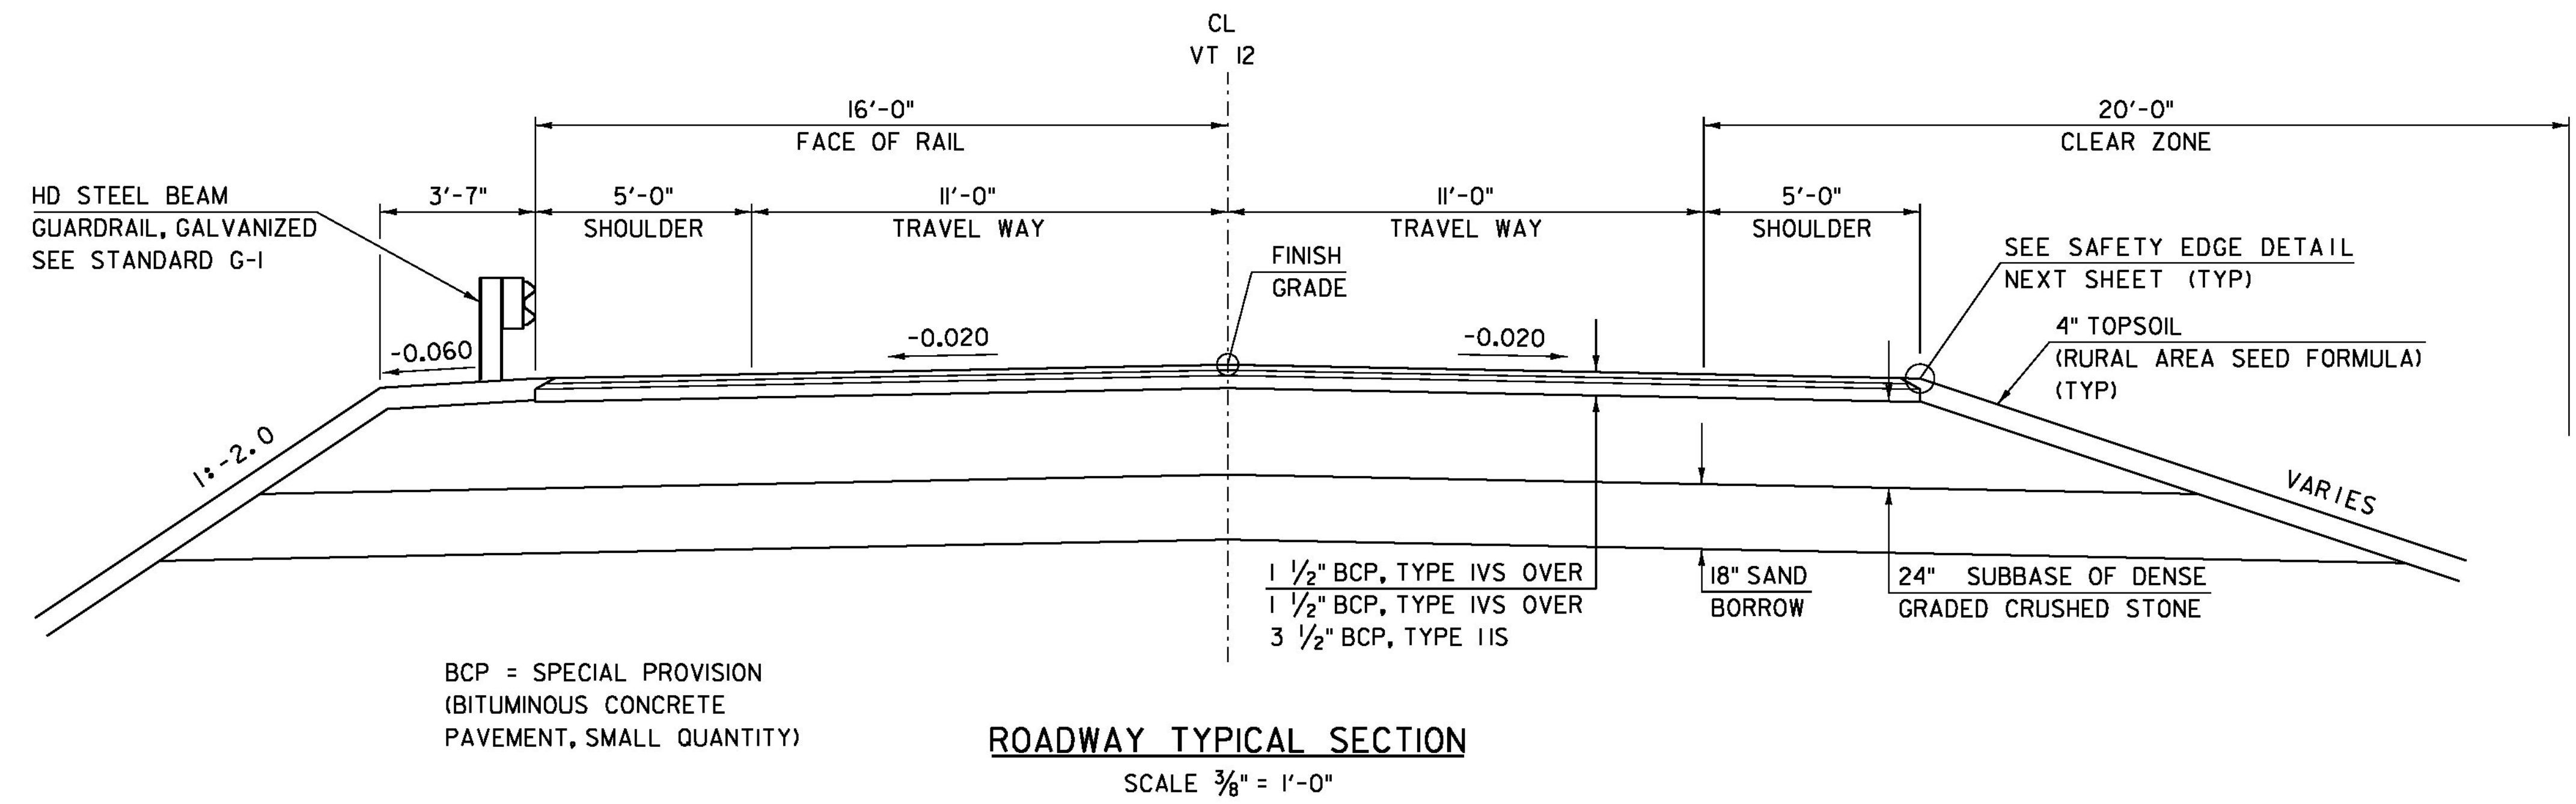


MATERIAL TOLERANCES (IF USED ON PROJECT)	
SURFACE	
- PAVEMENT (TOTAL THICKNESS)	+/- 1/4"
- AGGREGATE SURFACE COURSE	+/- 1/2"
SUBBASE	
	+/- 1"
SAND BORROW	
	+/- 1"

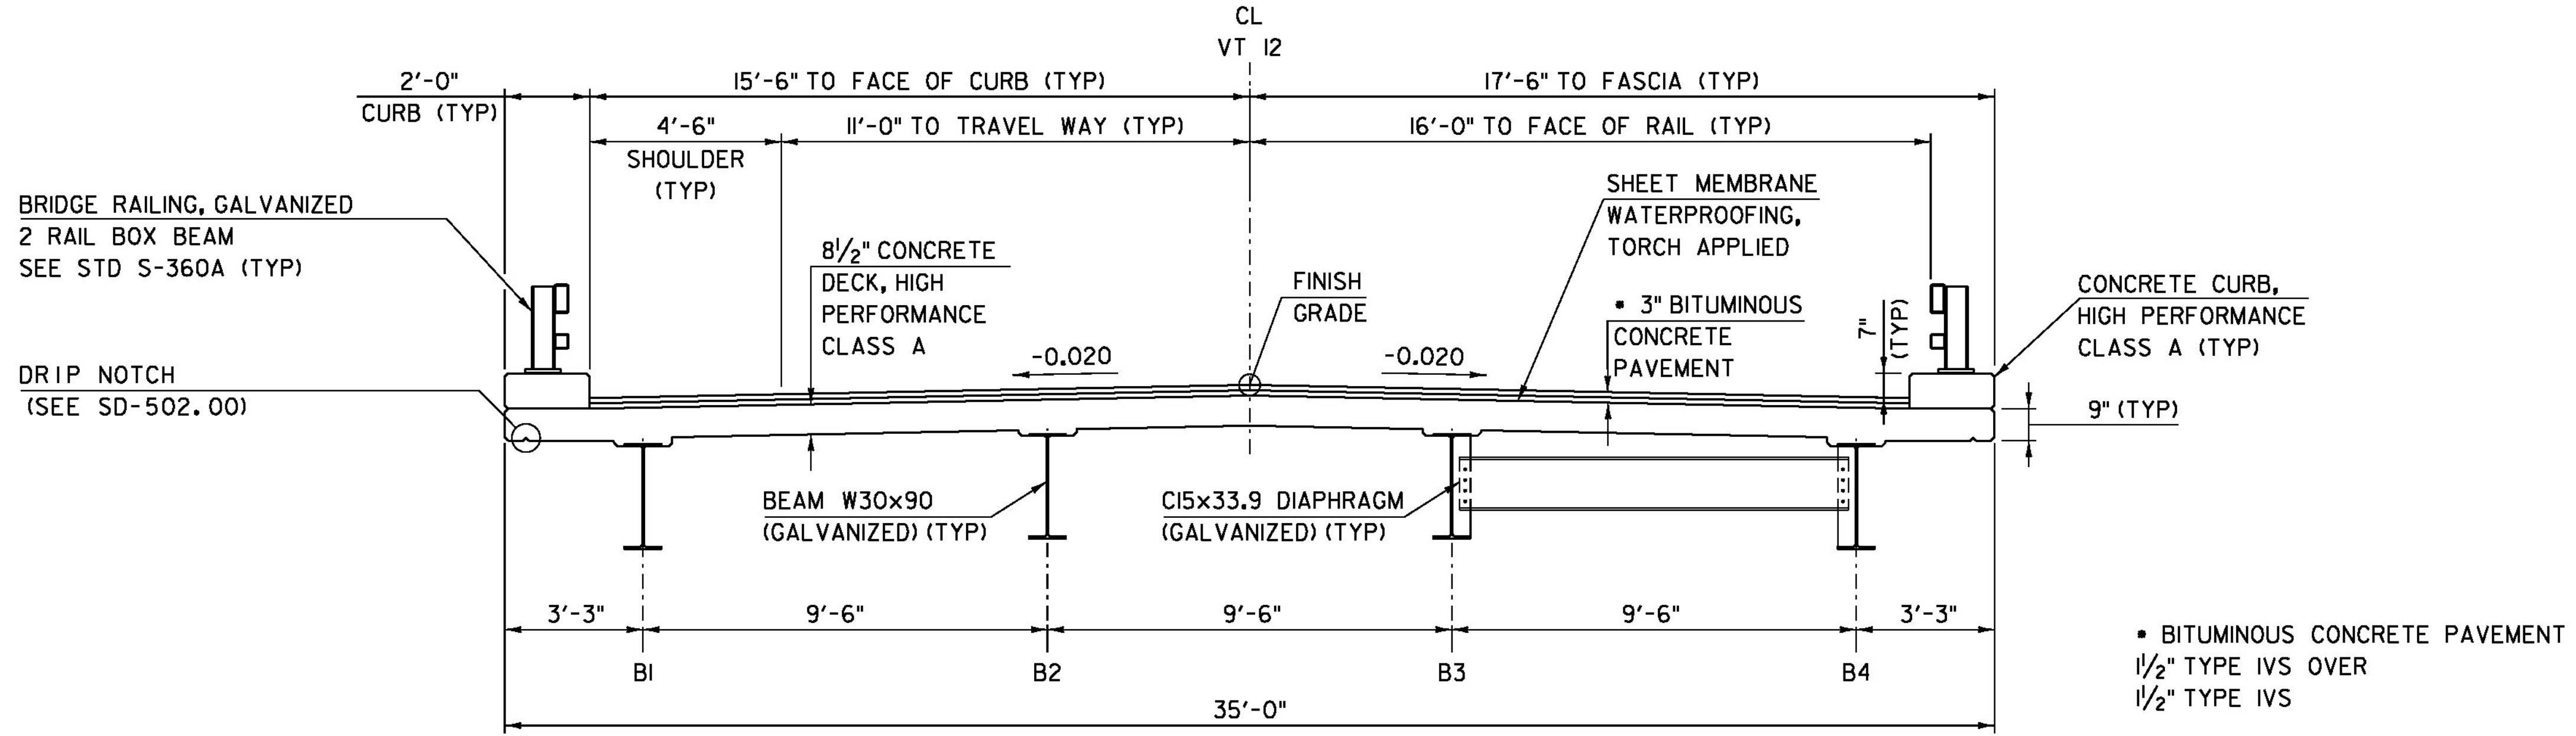

PROJECT NAME: MIDDLESEX  
PROJECT NUMBER: BRF 024-1(37)

FILE NAME: s10c220typ.dgn  
PROJECT LEADER: C. CARLSON  
DESIGNED BY: H. SALLS  
TYPICAL SECTIONS 1

PLOT DATE: 02-FEB-2015  
DRAWN BY: R. PELLETT  
CHECKED BY: H. SALLS  
SHEET 3 OF 46