


ABUTMENT NO. 1 PLAN
SCALE 1/2"=1'-0"

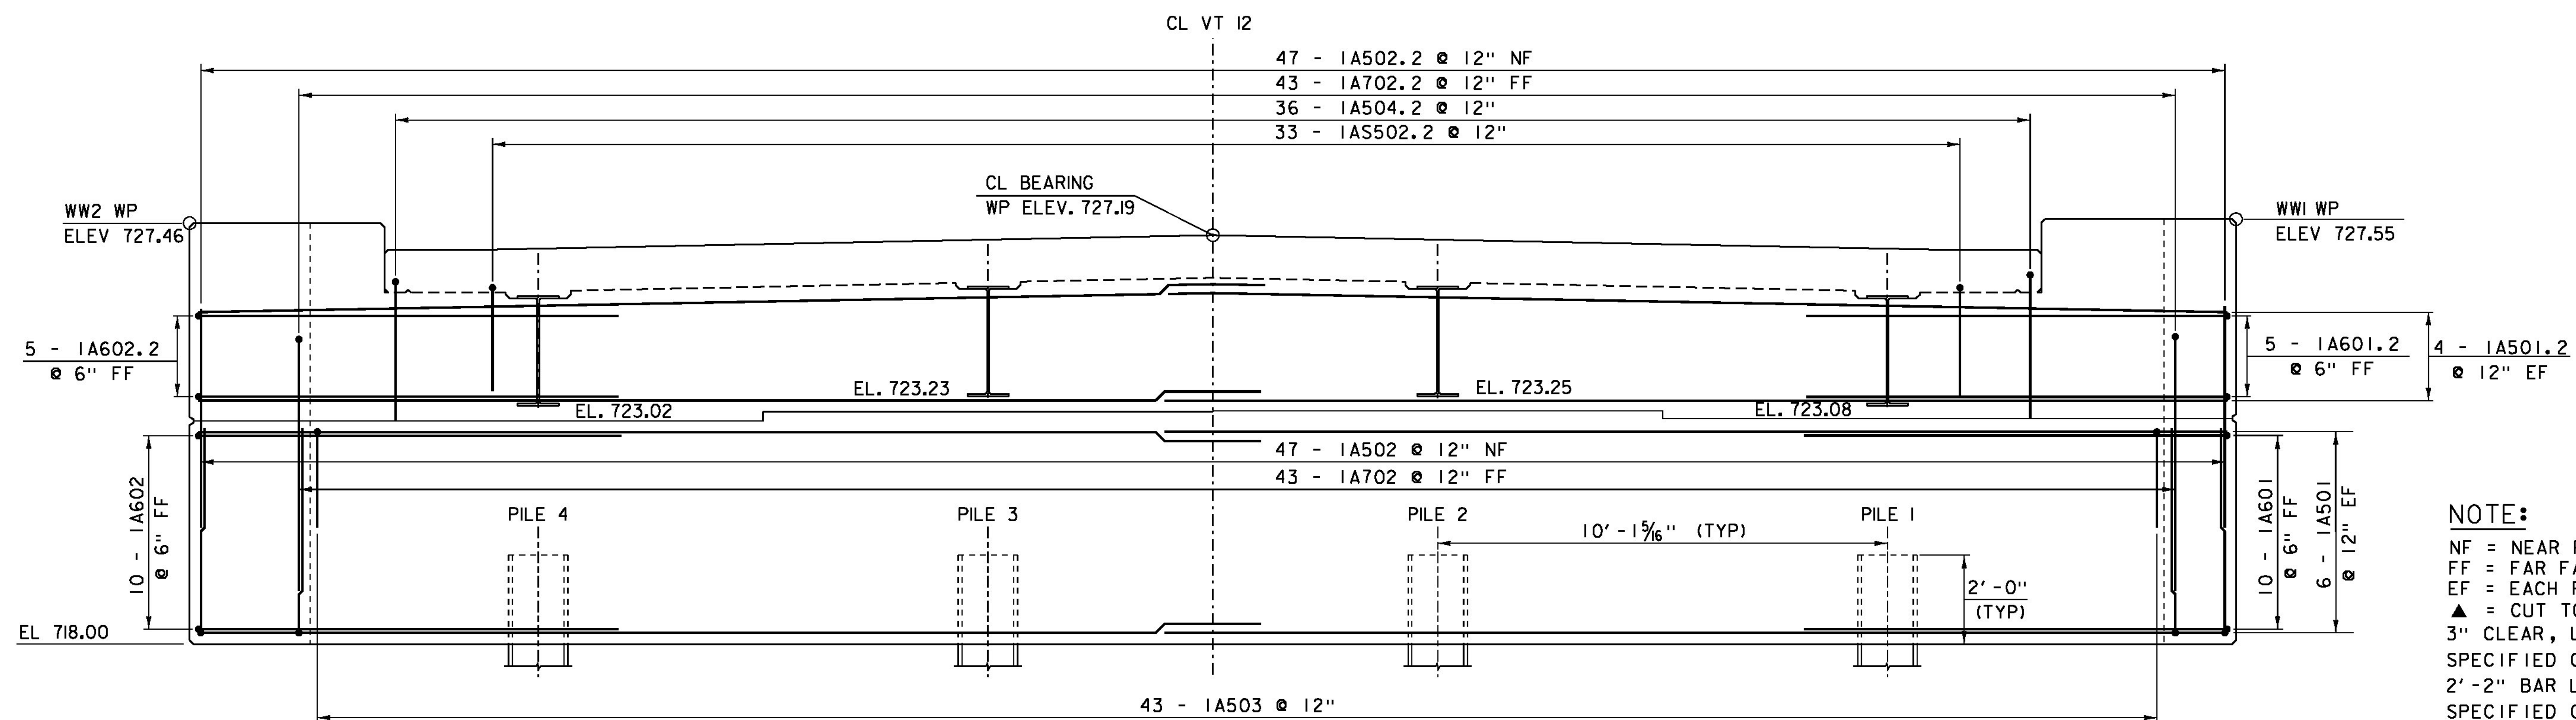

ABUTMENT NO. 1 ELEVATION
SCALE 1/2"=1'-0"

NOTE:
 NF = NEAR FACE
 FF = FAR FACE
 EF = EACH FACE
 ▲ = CUT TO FIT IN FIELD
 3" CLEAR, UNLESS OTHERWISE
 SPECIFIED ON THE PLANS.
 2'-2" BAR LAP UNLESS OTHERWISE
 SPECIFIED ON THE PLANS.

PROJECT NAME: MIDDLESEX
 PROJECT NUMBER: BRF 024-K(37)

FILE NAME: sl0c220sub.dgn
 PROJECT LEADER: C. CARLSON
 DESIGNED BY: H. SALLS
 ABUTMENT #1 PLAN AND ELEVATION

PLOT DATE: 06-FEB-2015
 DRAWN BY: C. BURRALL
 CHECKED BY: H. SALLS
 SHEET 24 OF 46