




26+75  
BEGIN APPROACH

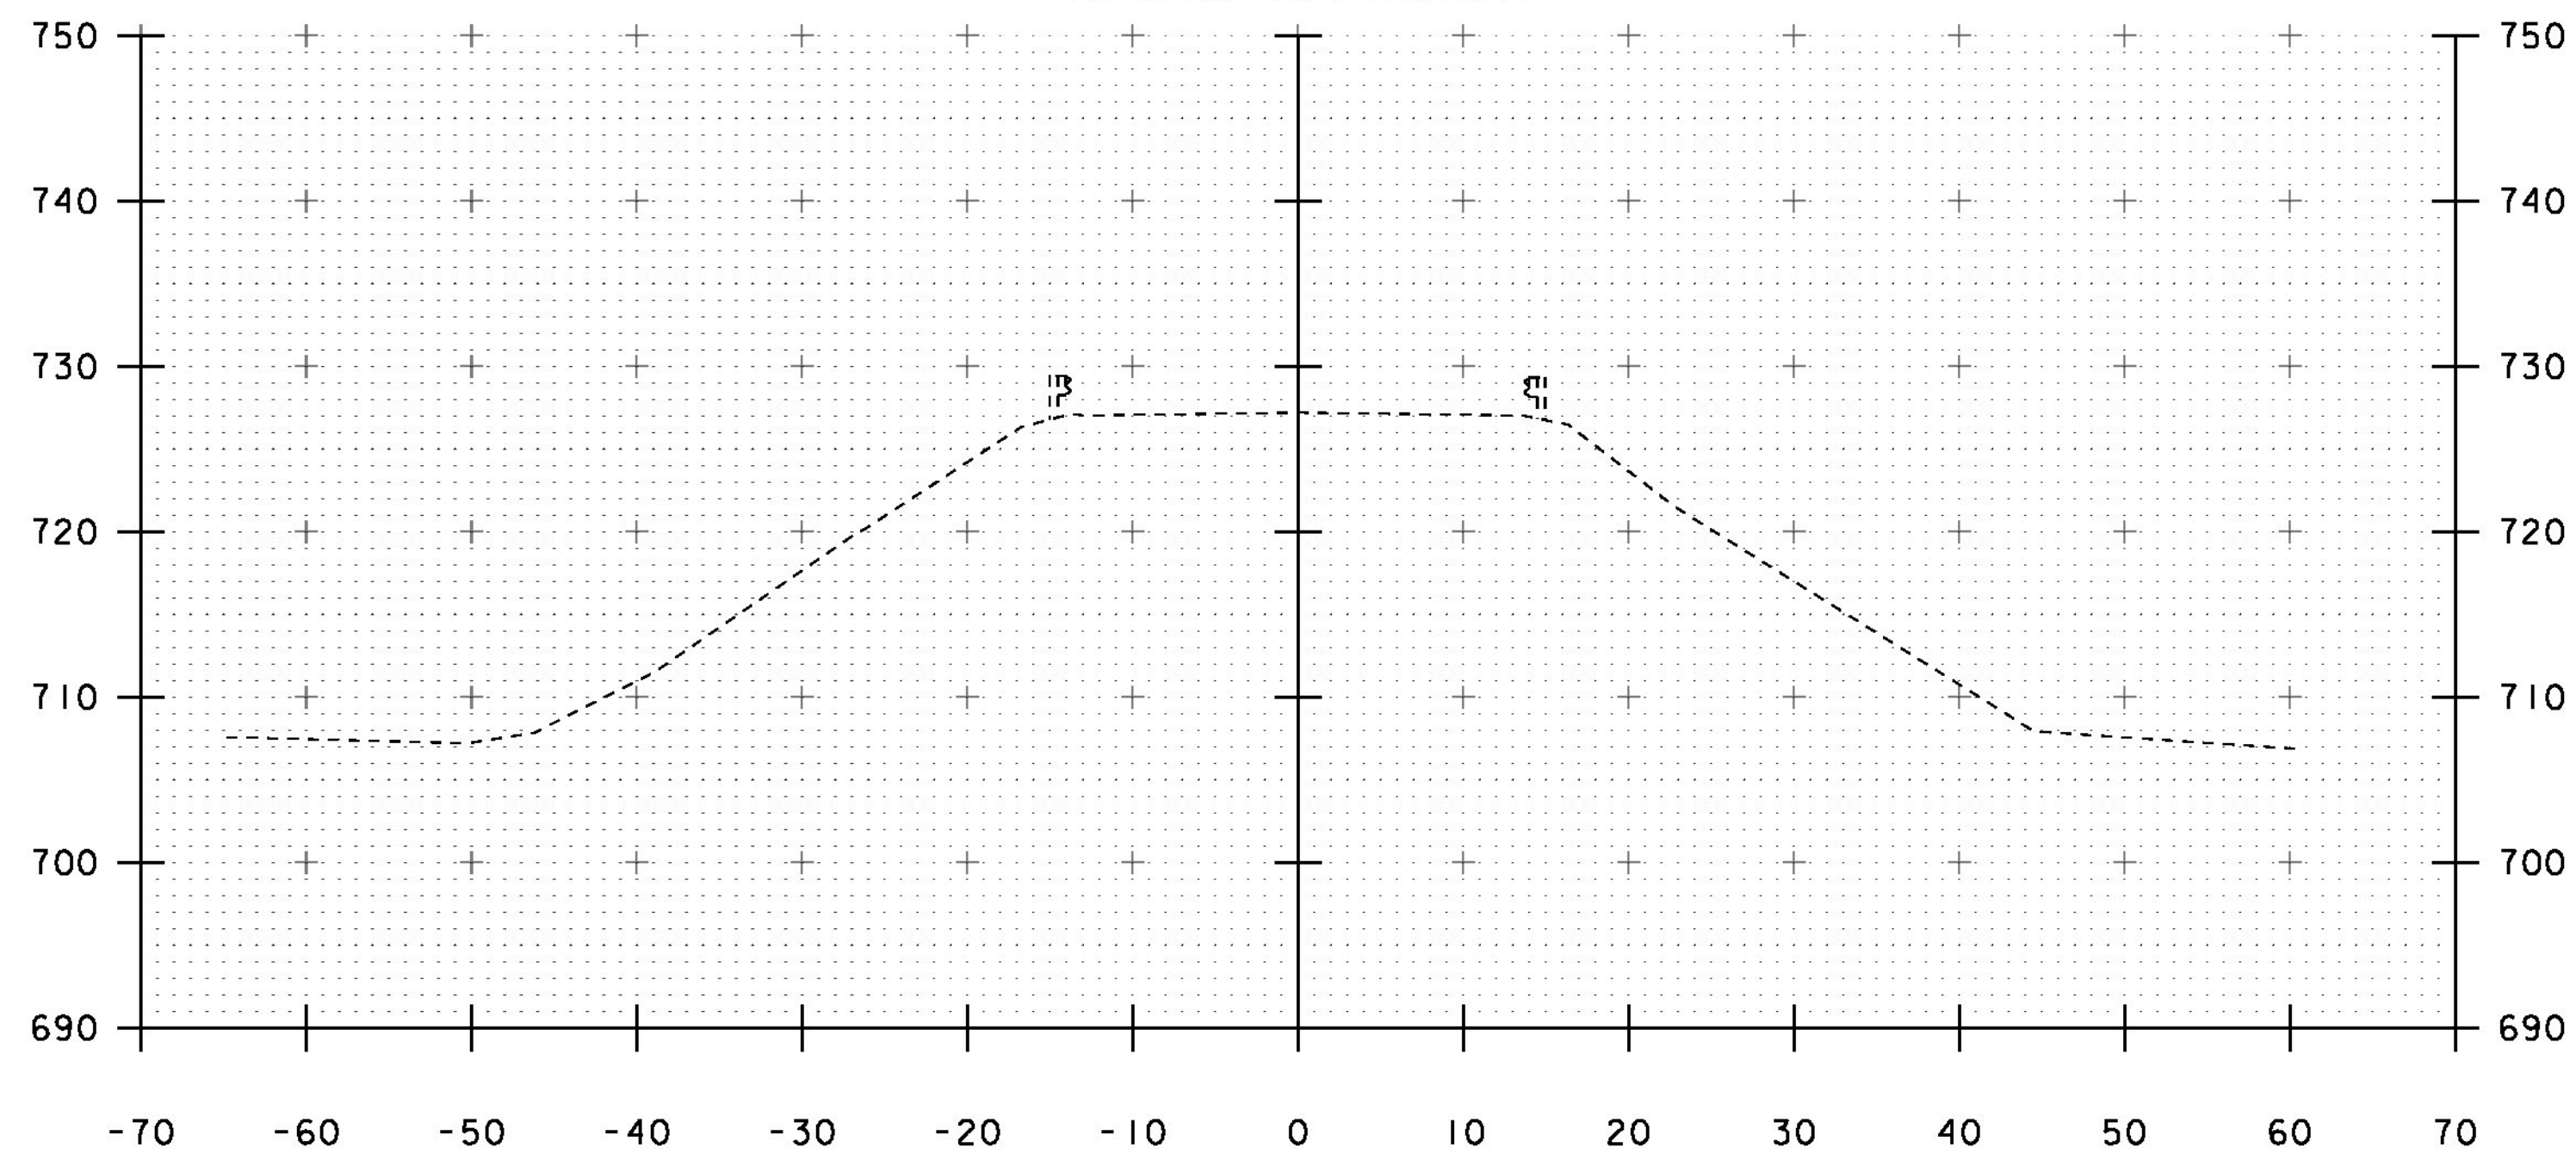

26+50

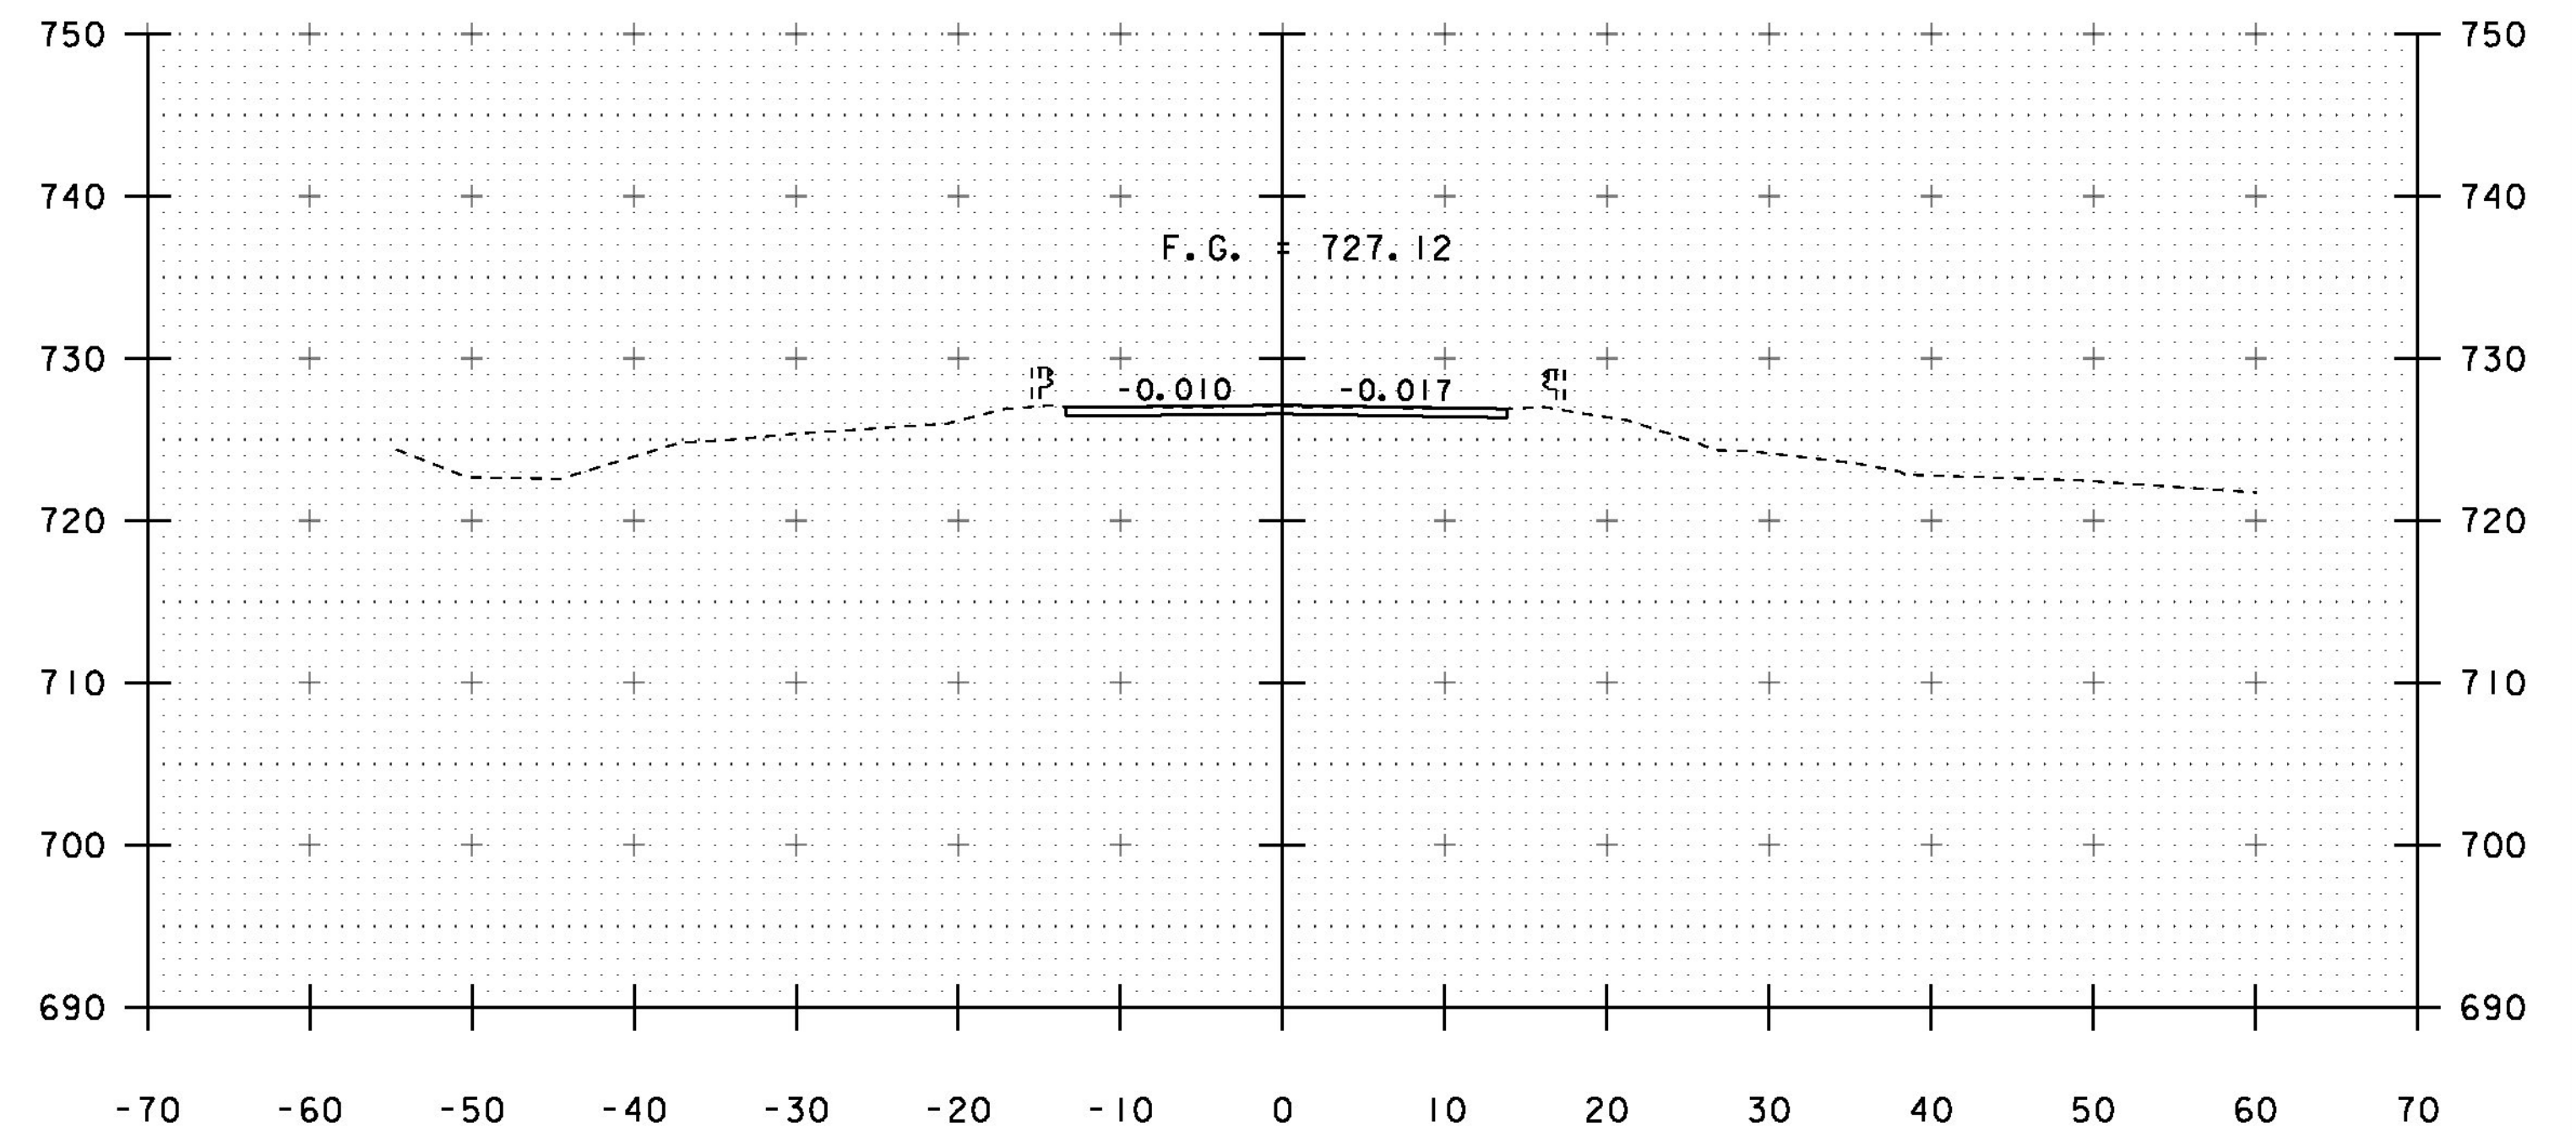

27+25

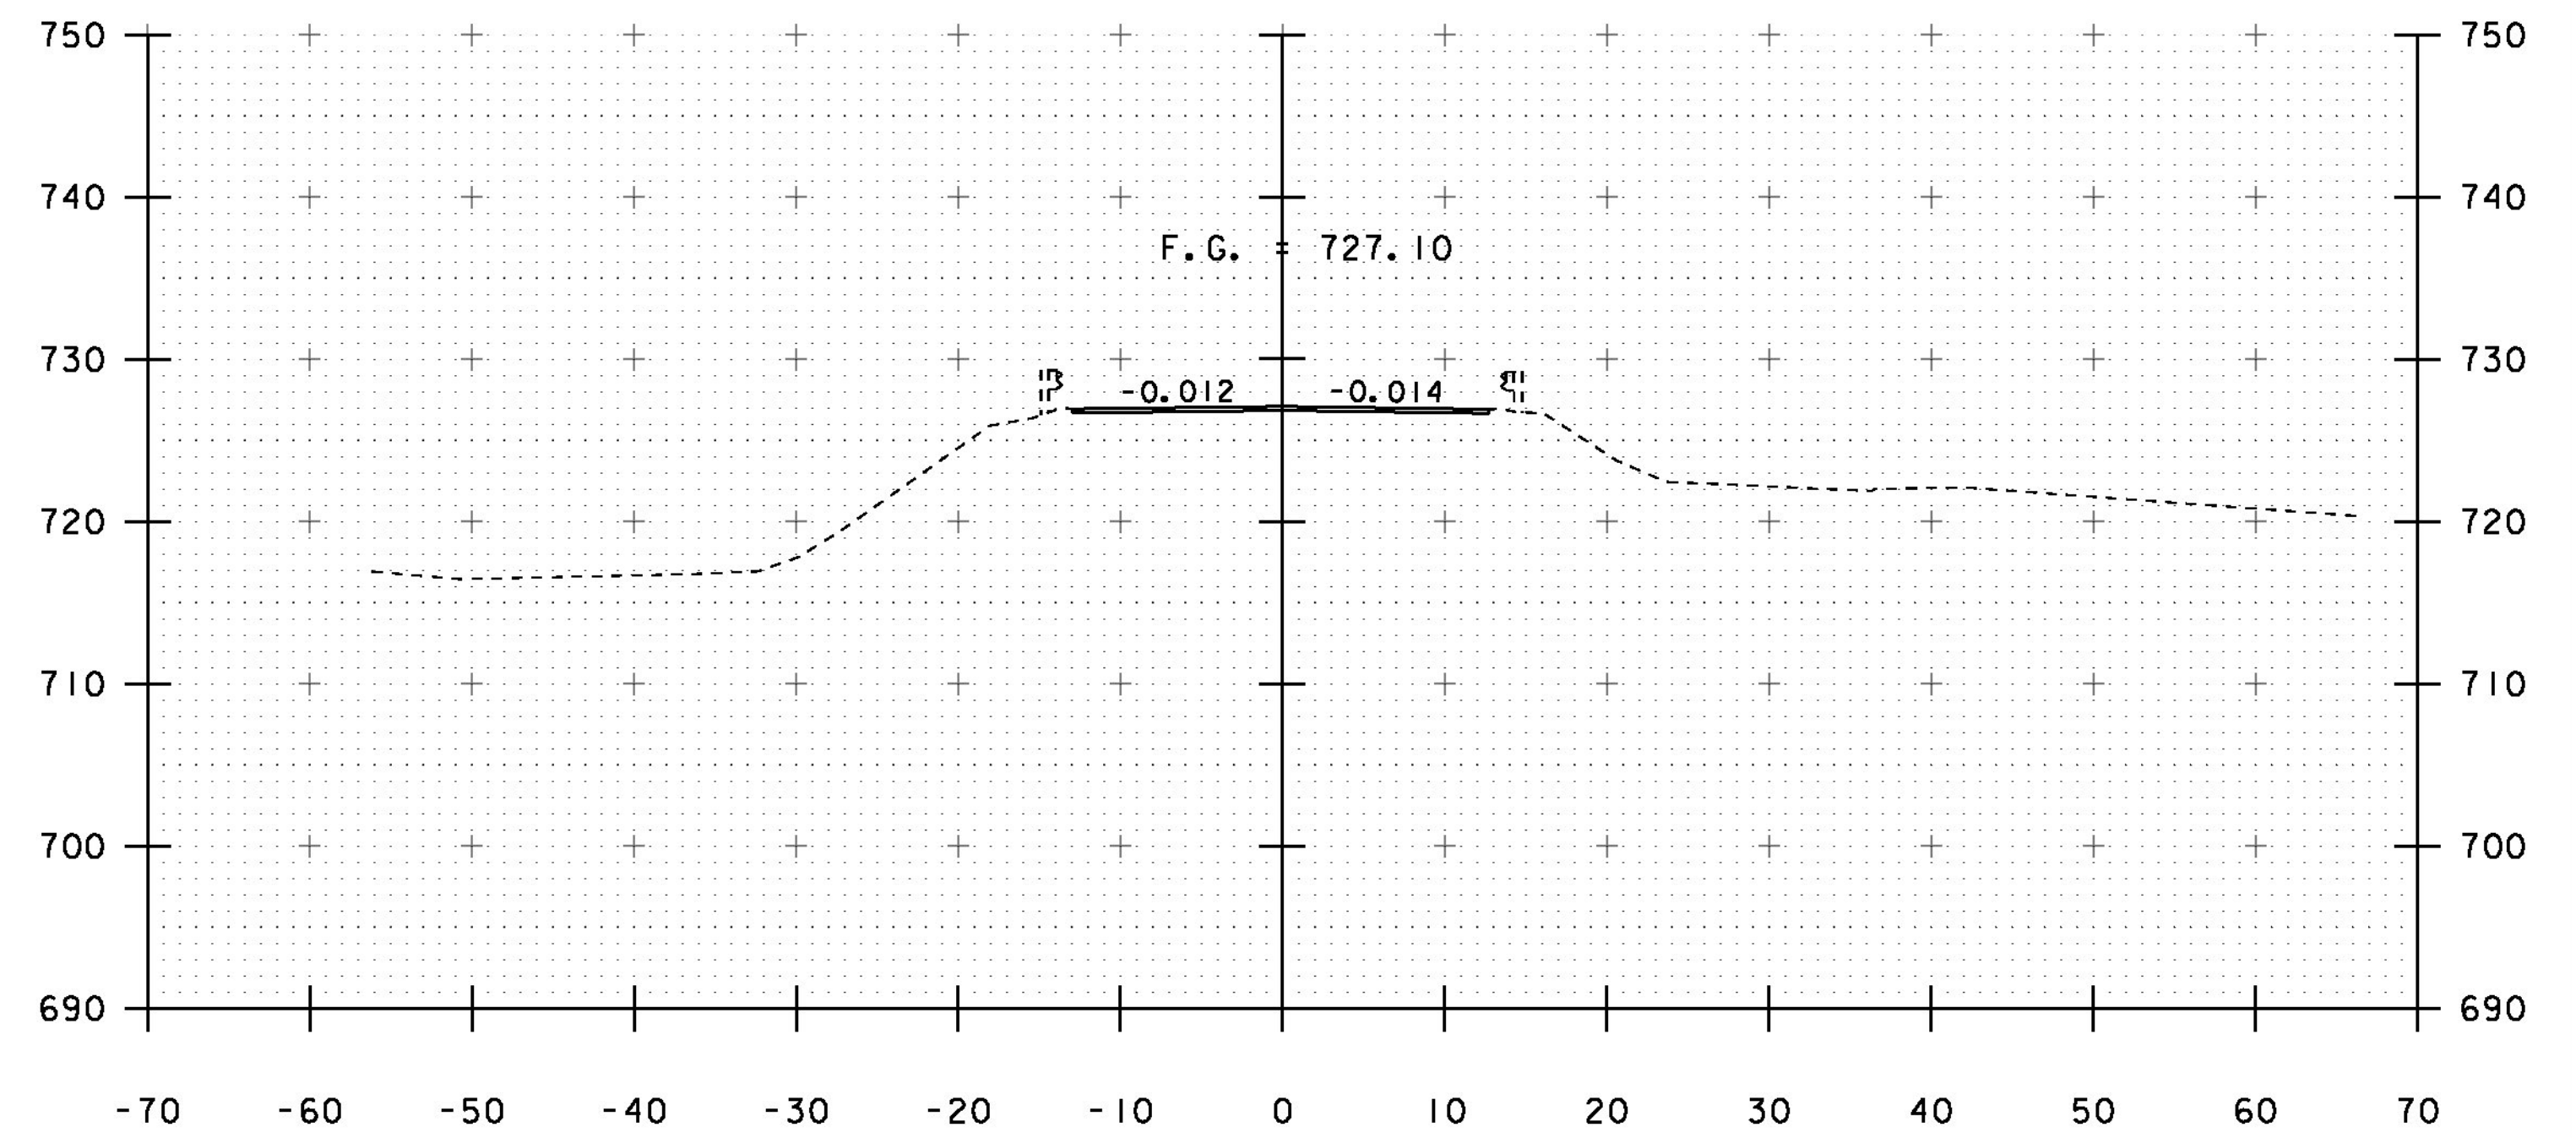

27+00

STA. 26+50 TO STA. 27+25

PROJECT NAME: MIDDLESEX  
PROJECT NUMBER: BR 024-1(37)

FILE NAME: sl0c220xs.dgn  
PROJECT LEADER: C. CARLSON  
DESIGNED BY: H. SALLS  
VT 12 CROSS SECTIONS 1

PLOT DATE: 13-JAN-2015  
DRAWN BY: R. PELLETT  
CHECKED BY: H. SALLS  
SHEET 30 OF 46