




27+75
BEGIN PROJECT

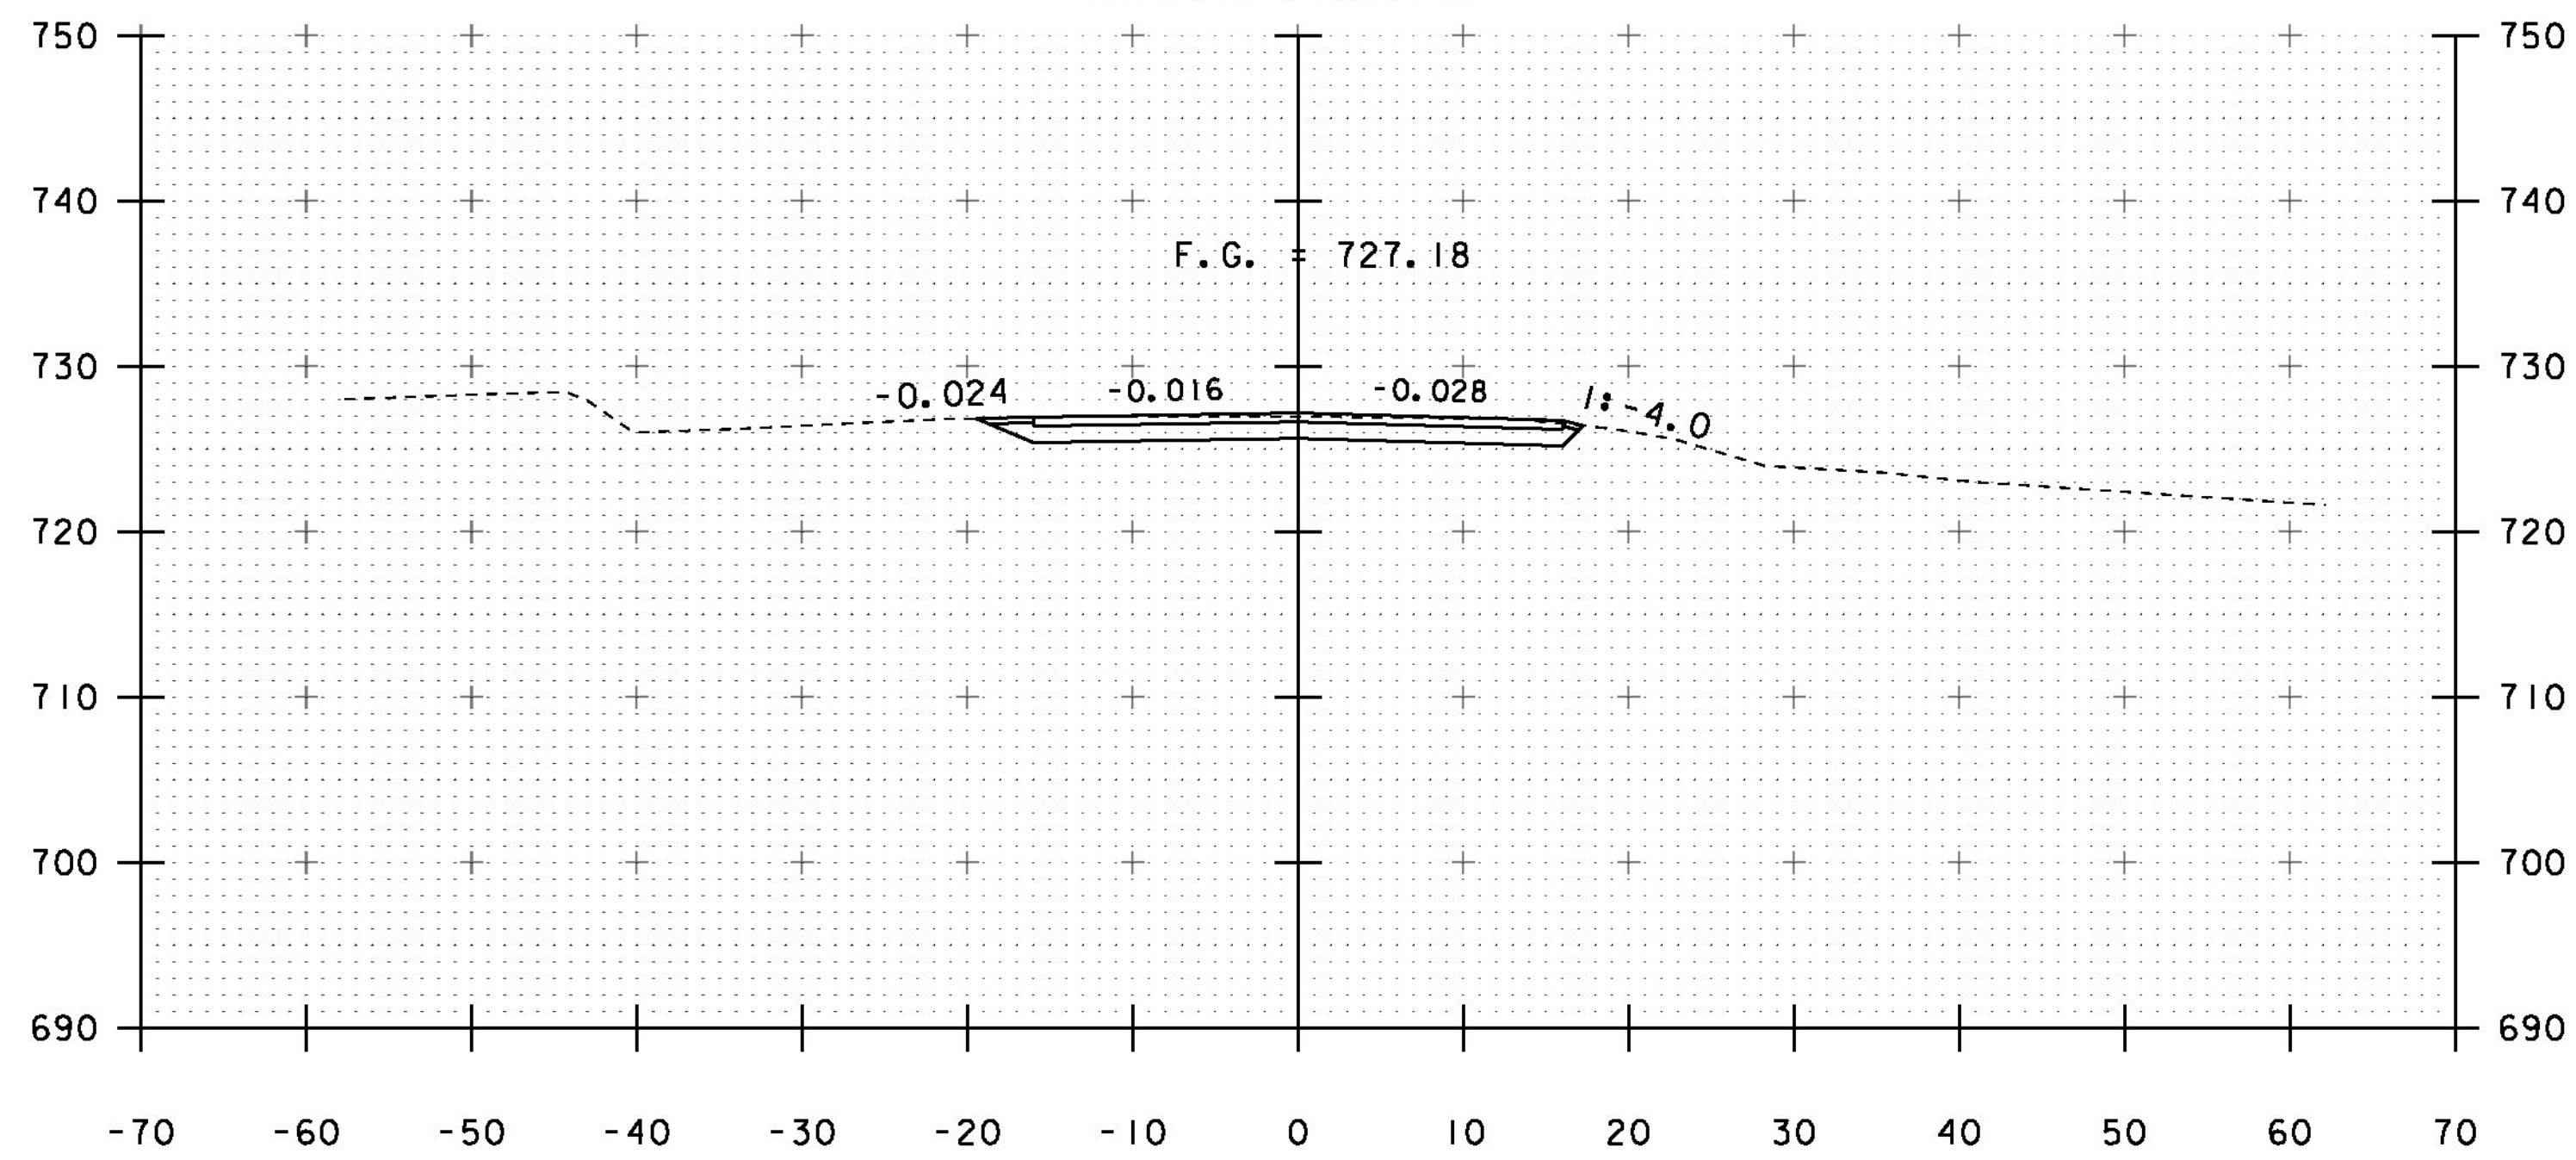

27+50

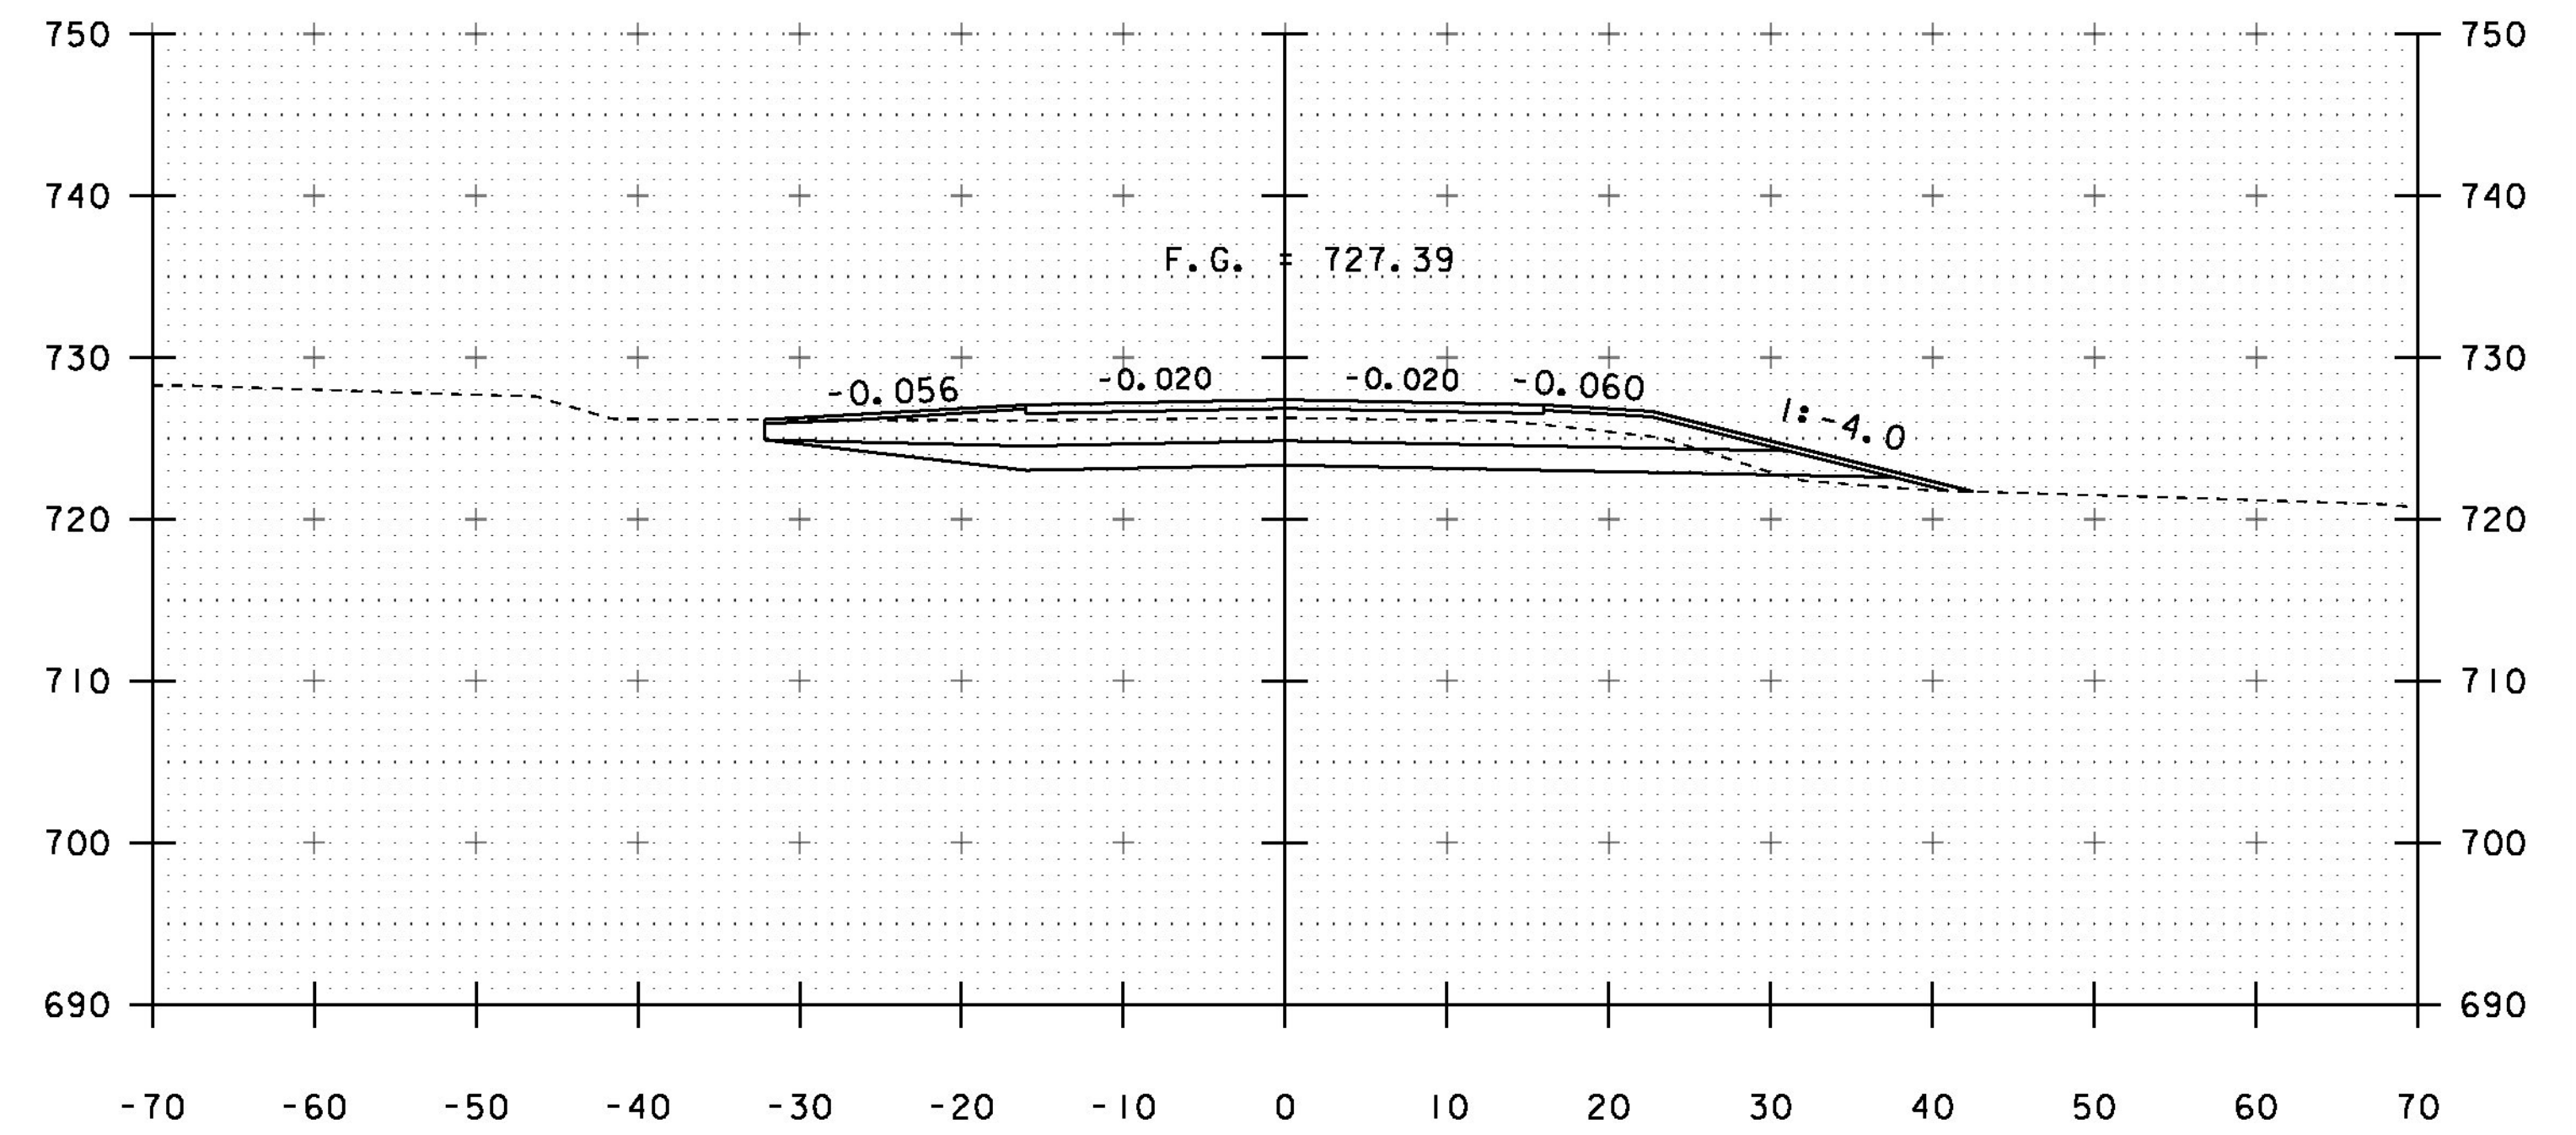

28+25

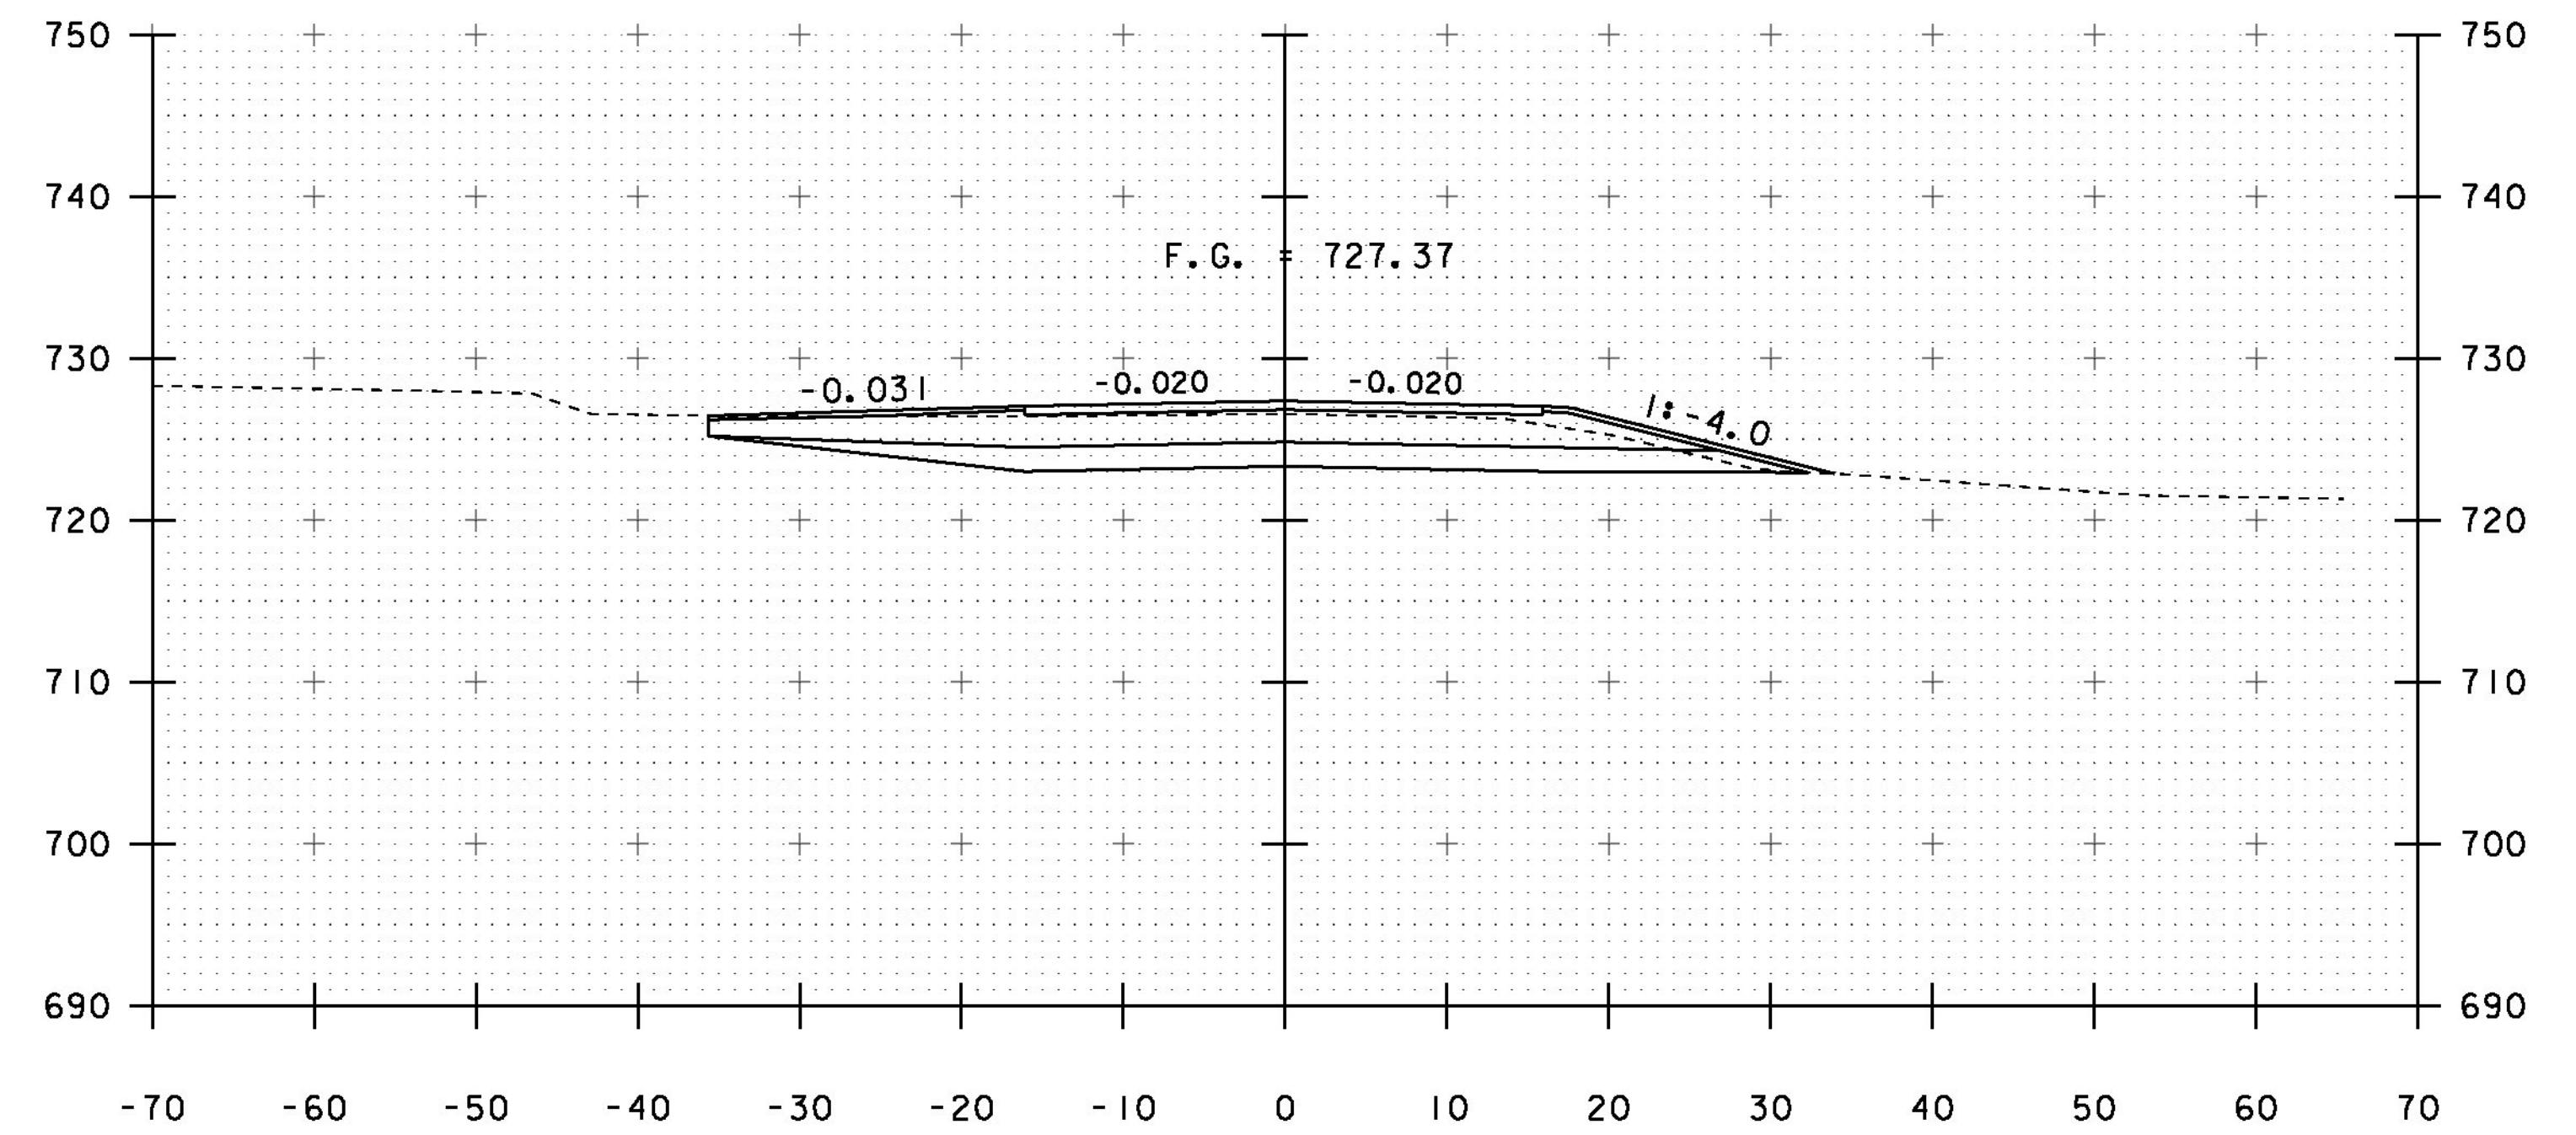

28+00

STA. 27+50 TO STA. 28+25

PROJECT NAME: MIDDLESEX
PROJECT NUMBER: BRP 024-1(37)

FILE NAME: sl0c220xs.dgn
PROJECT LEADER: C. CARLSON
DESIGNED BY: H. SALLS
VT 12 CROSS SECTIONS 2

PLOT DATE: 13-JAN-2015
DRAWN BY: R. PELLETT
CHECKED BY: H. SALLS
SHEET 31 OF 46