




29+75

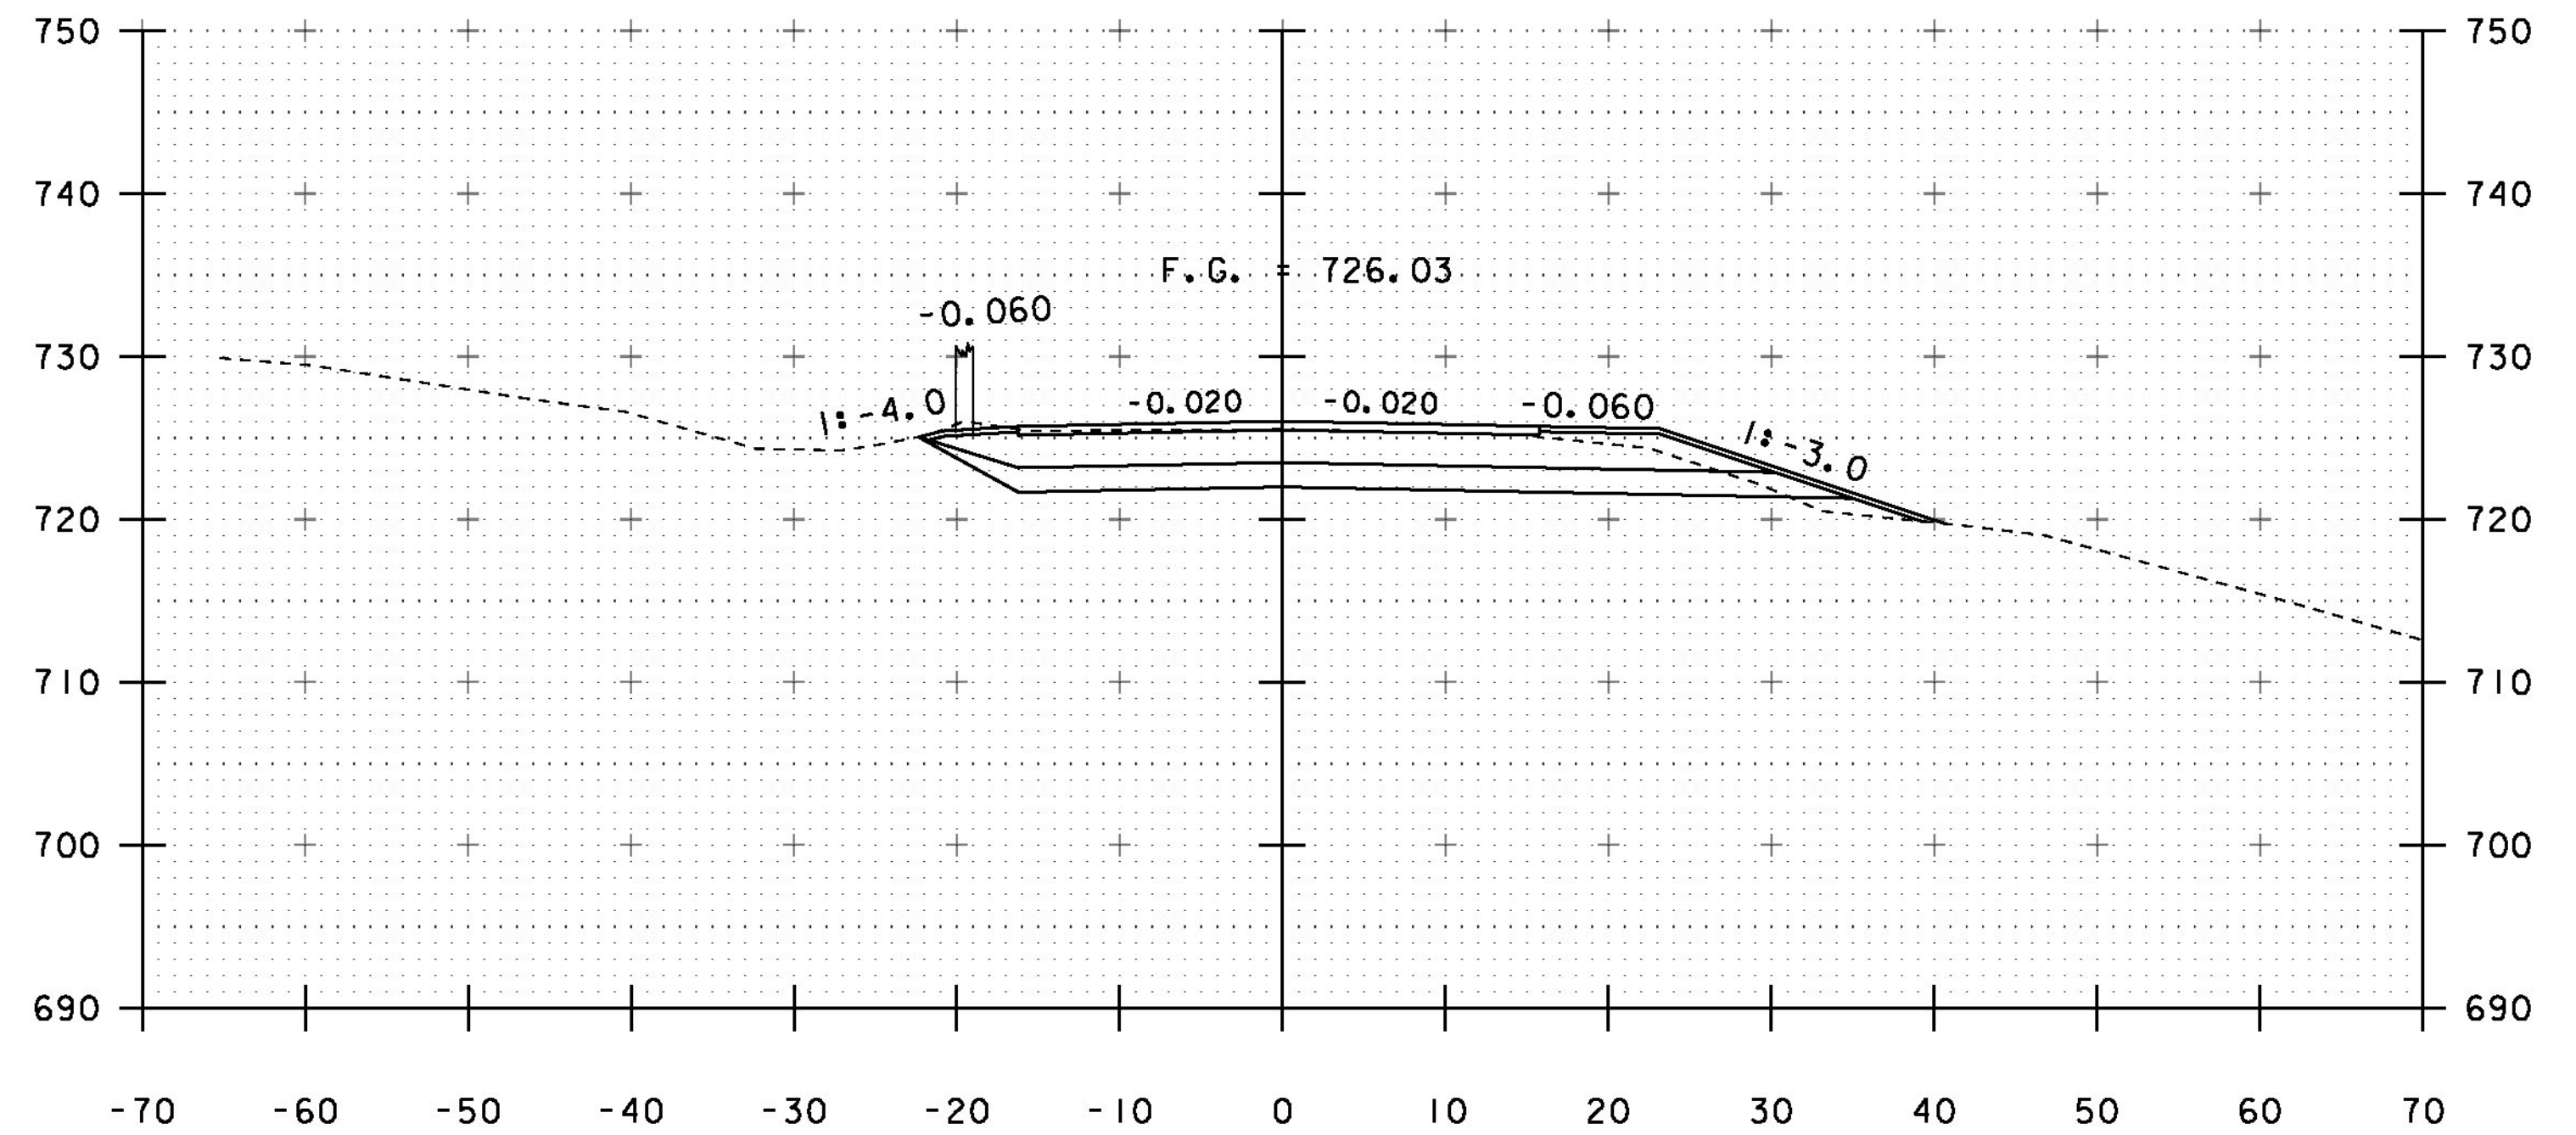

30+25

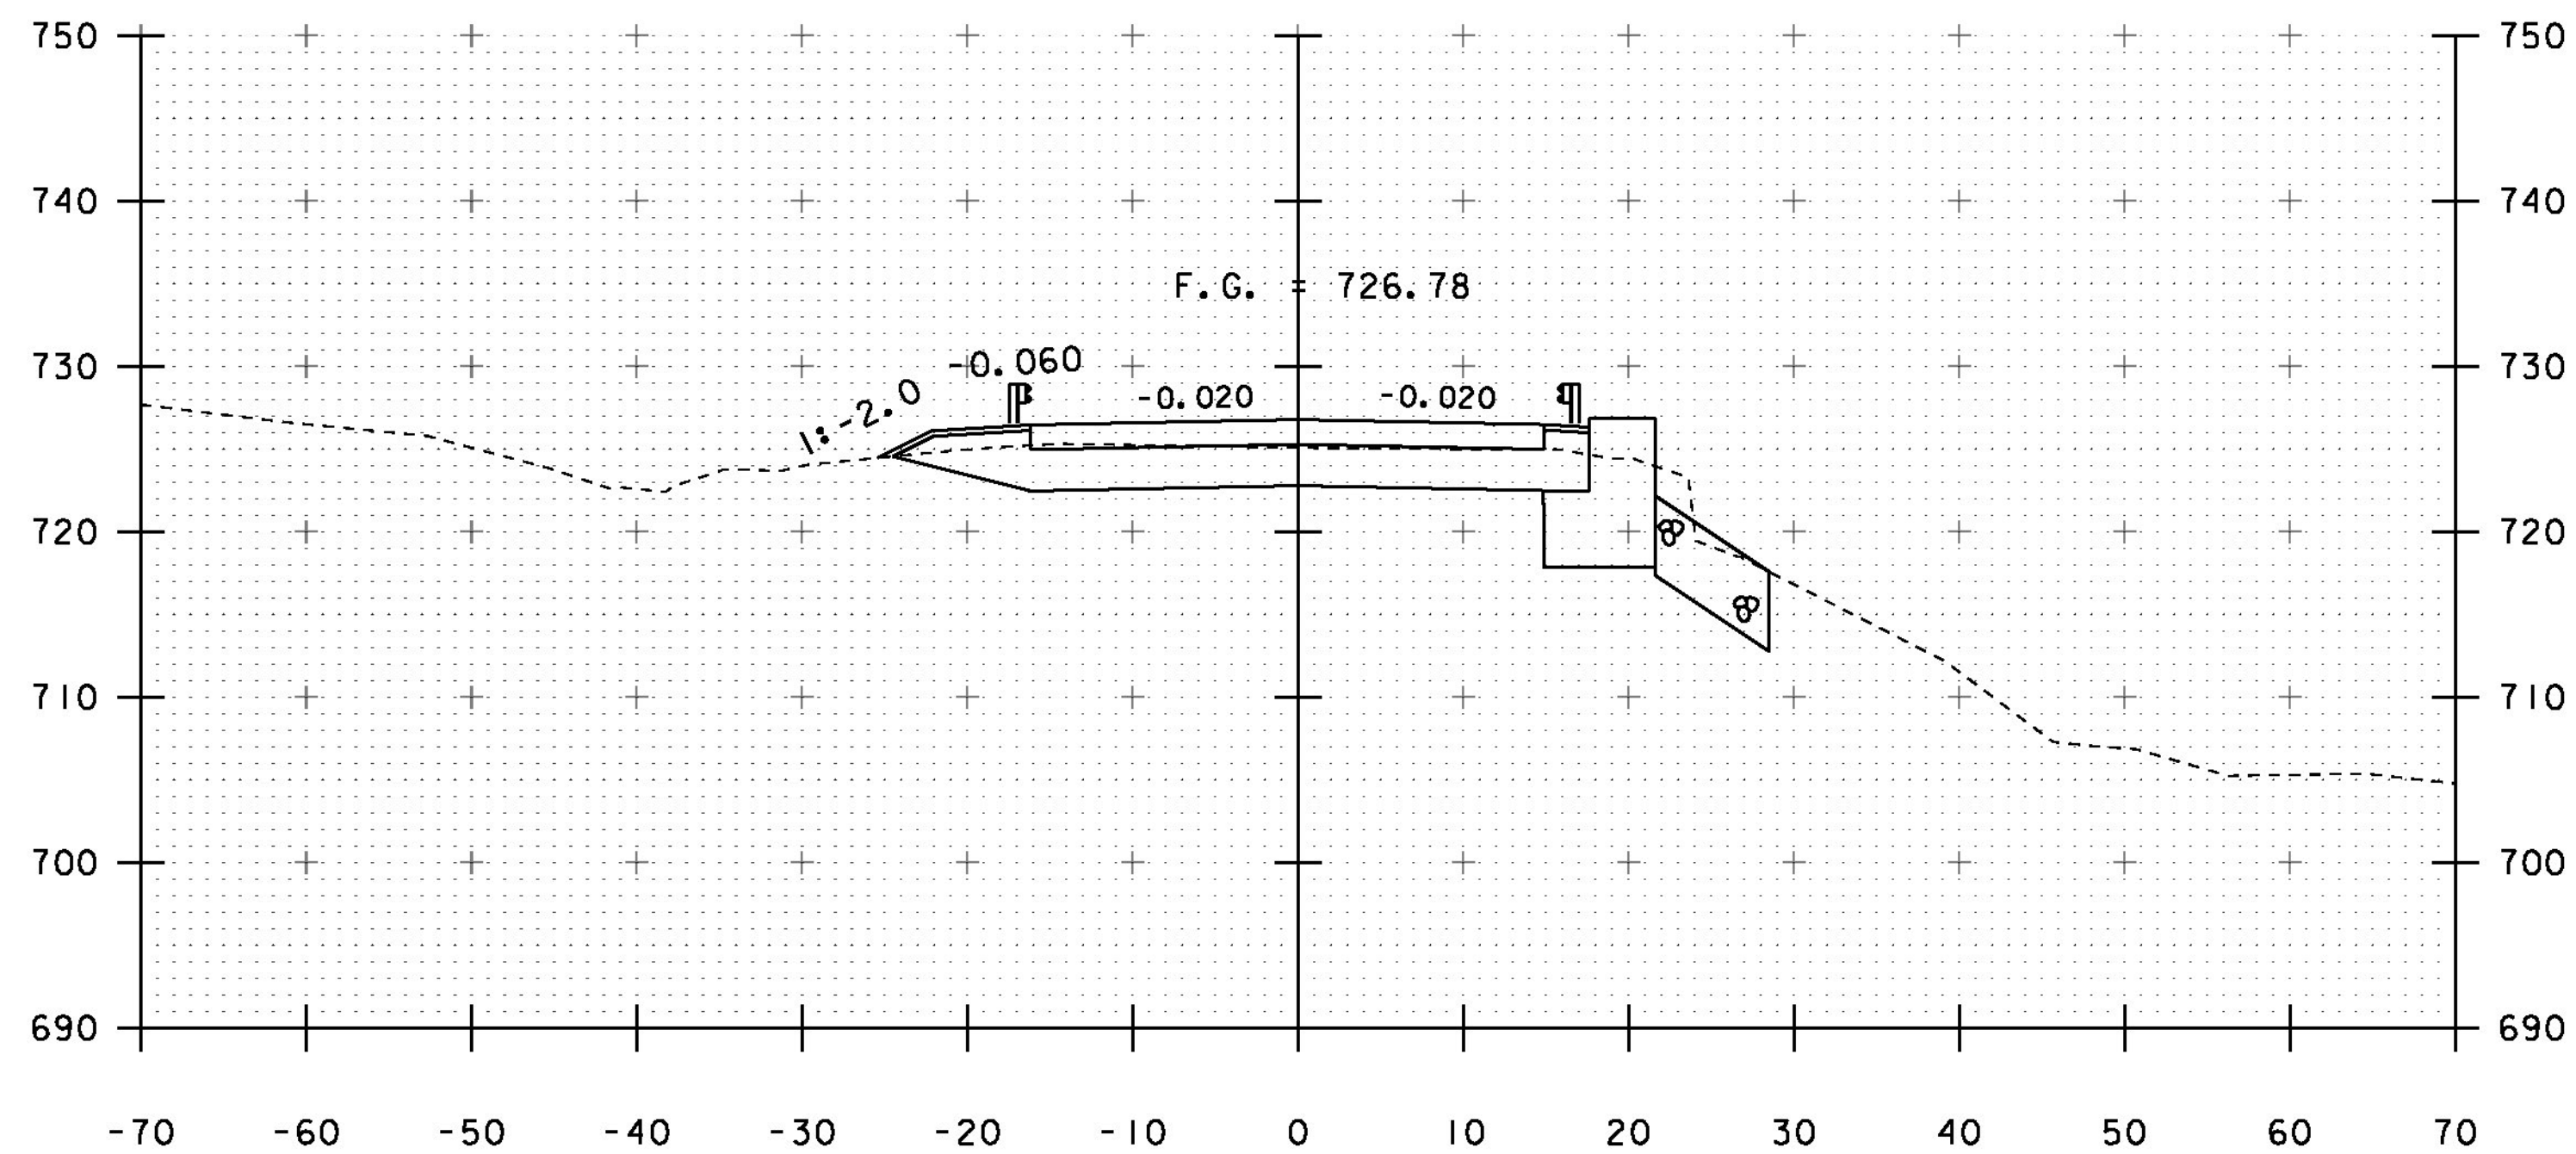

29+50
END BRIDGE STA 29+43.89

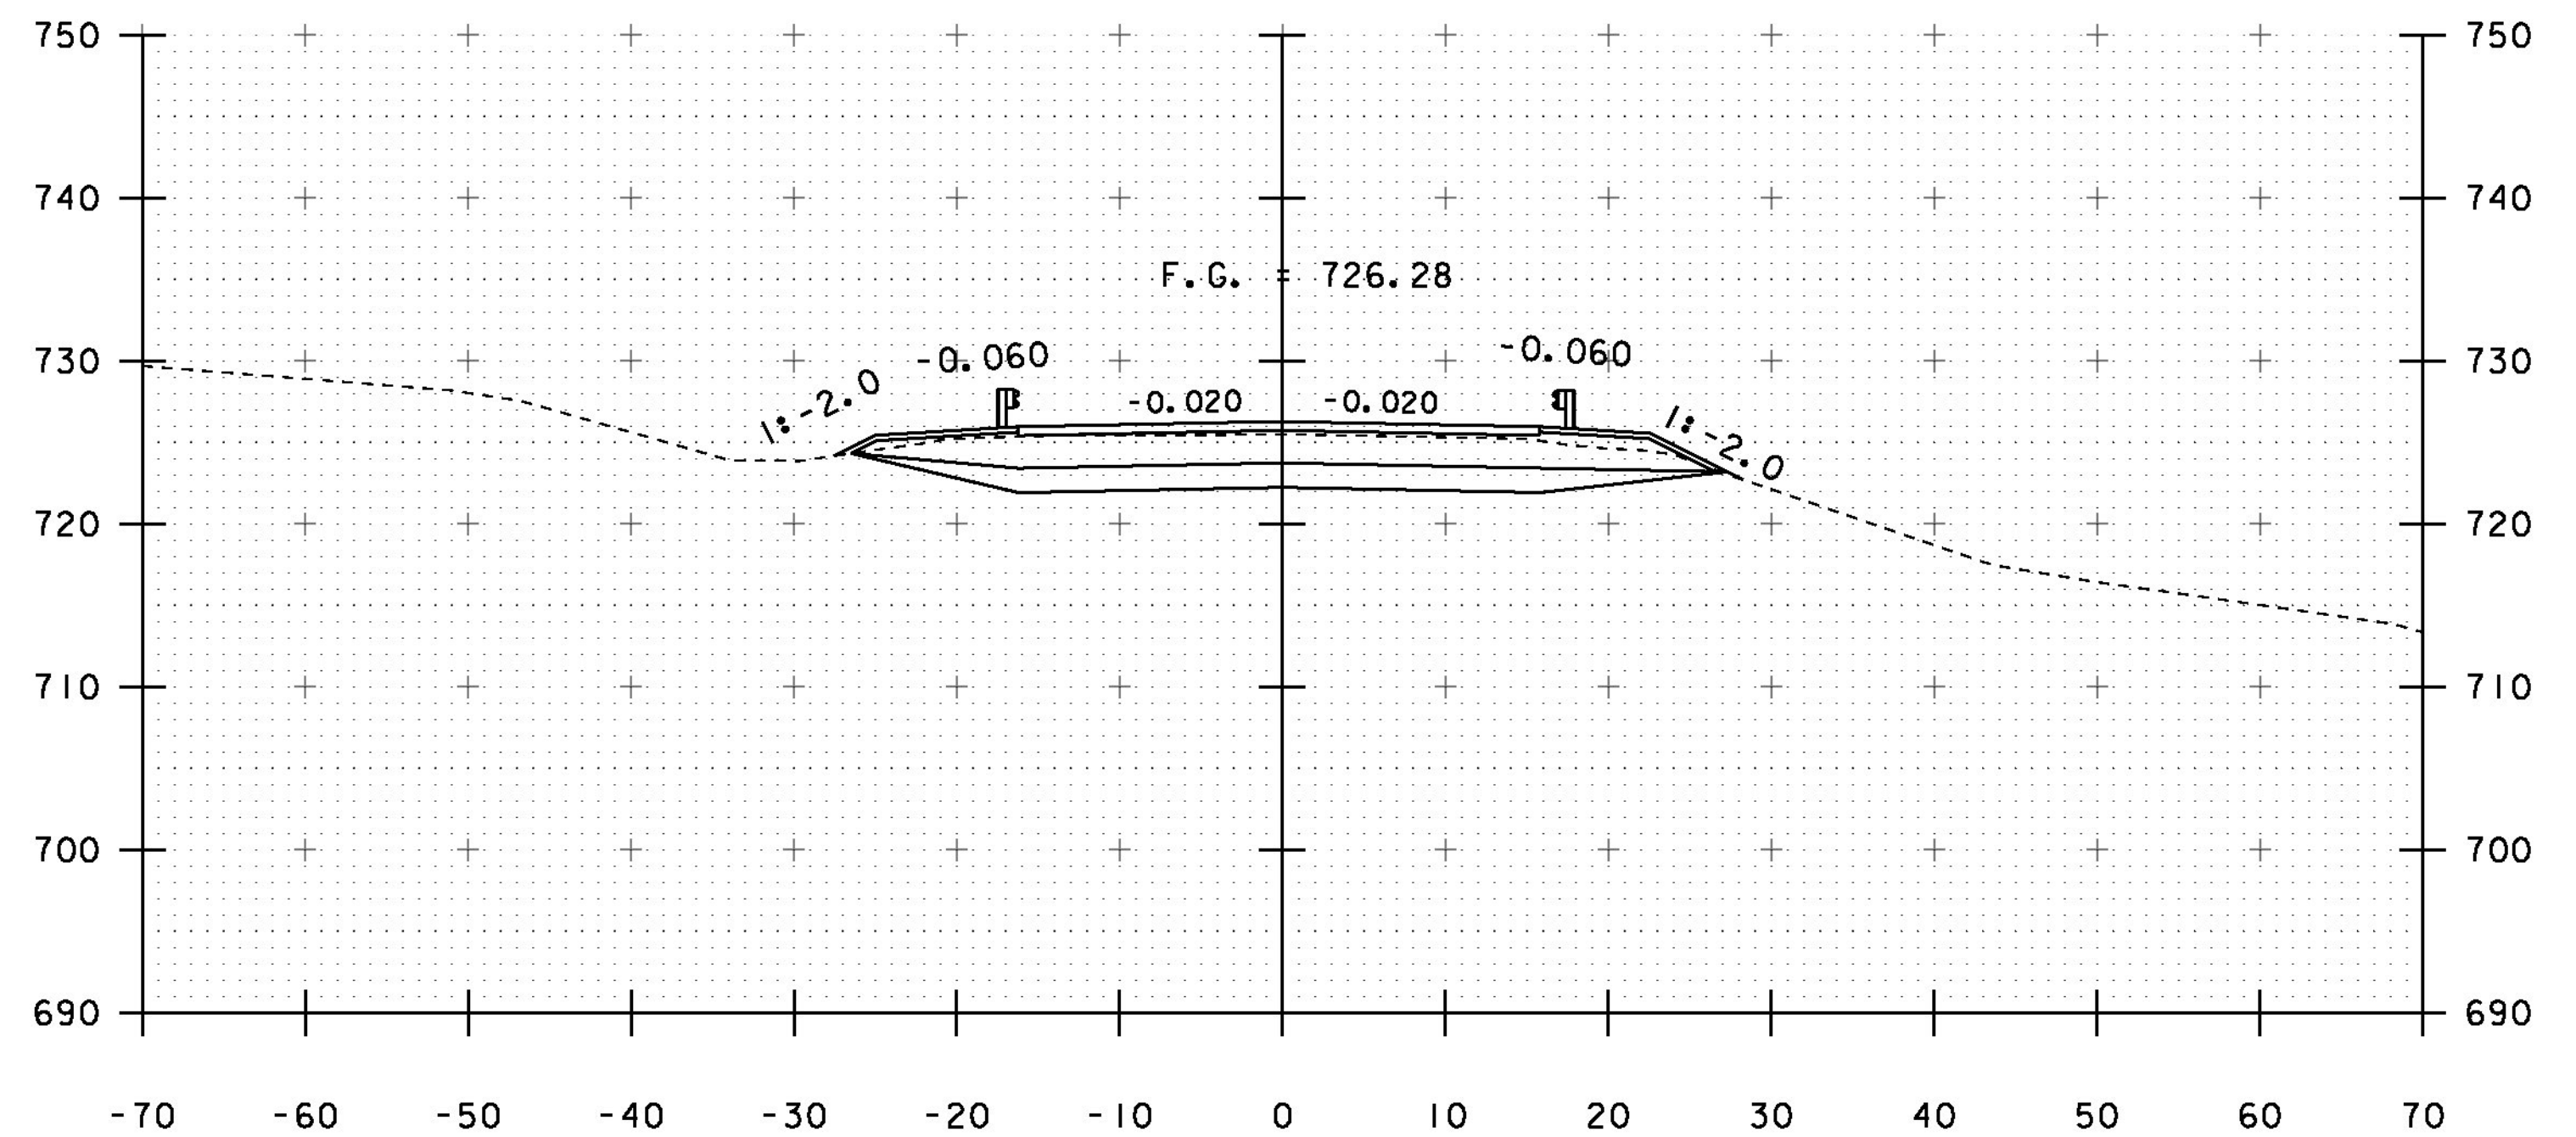

30+00

PROJECT NAME:	MIDDLESEX	PLOT DATE:	13-JAN-2015
PROJECT NUMBER:	BRF 024-I(37)	DRAWN BY:	R. PELLETT
FILE NAME:	sl0c220xs.dgn	DESIGNED BY:	H. SALLS
PROJECT LEADER:	C. CARLSON	CHECKED BY:	H. SALLS
DESIGNED BY:	H. SALLS	SHEET	33 OF 46
VT 12 CROSS SECTIONS 4			

STA. 29+50 TO STA. 30+25