




30+75
END PROJECT

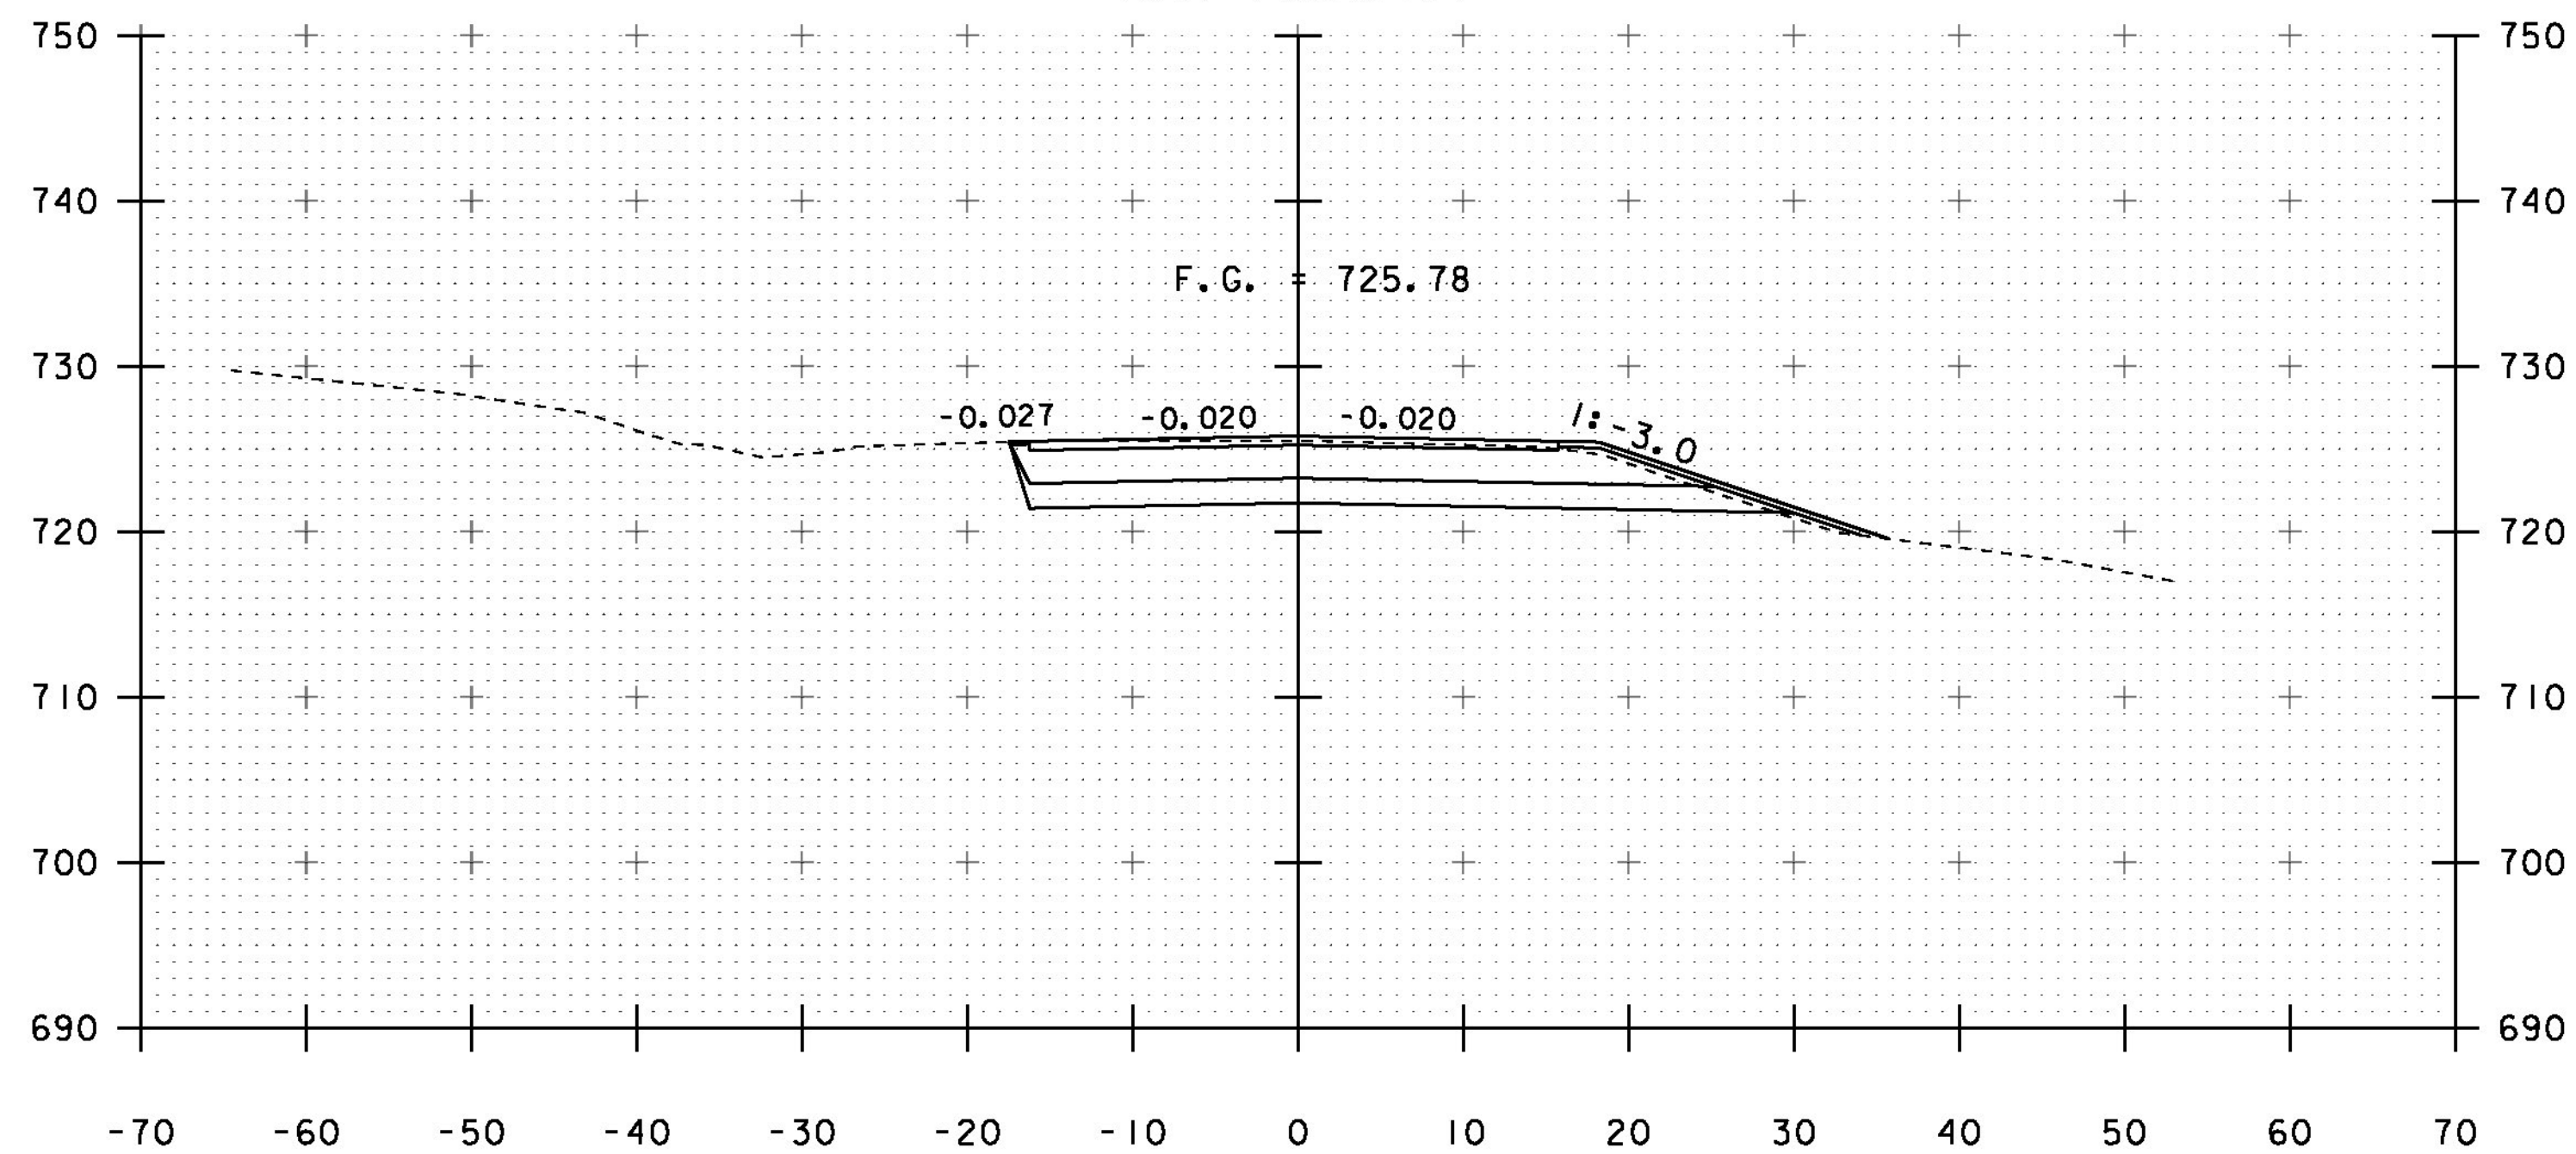

30+50

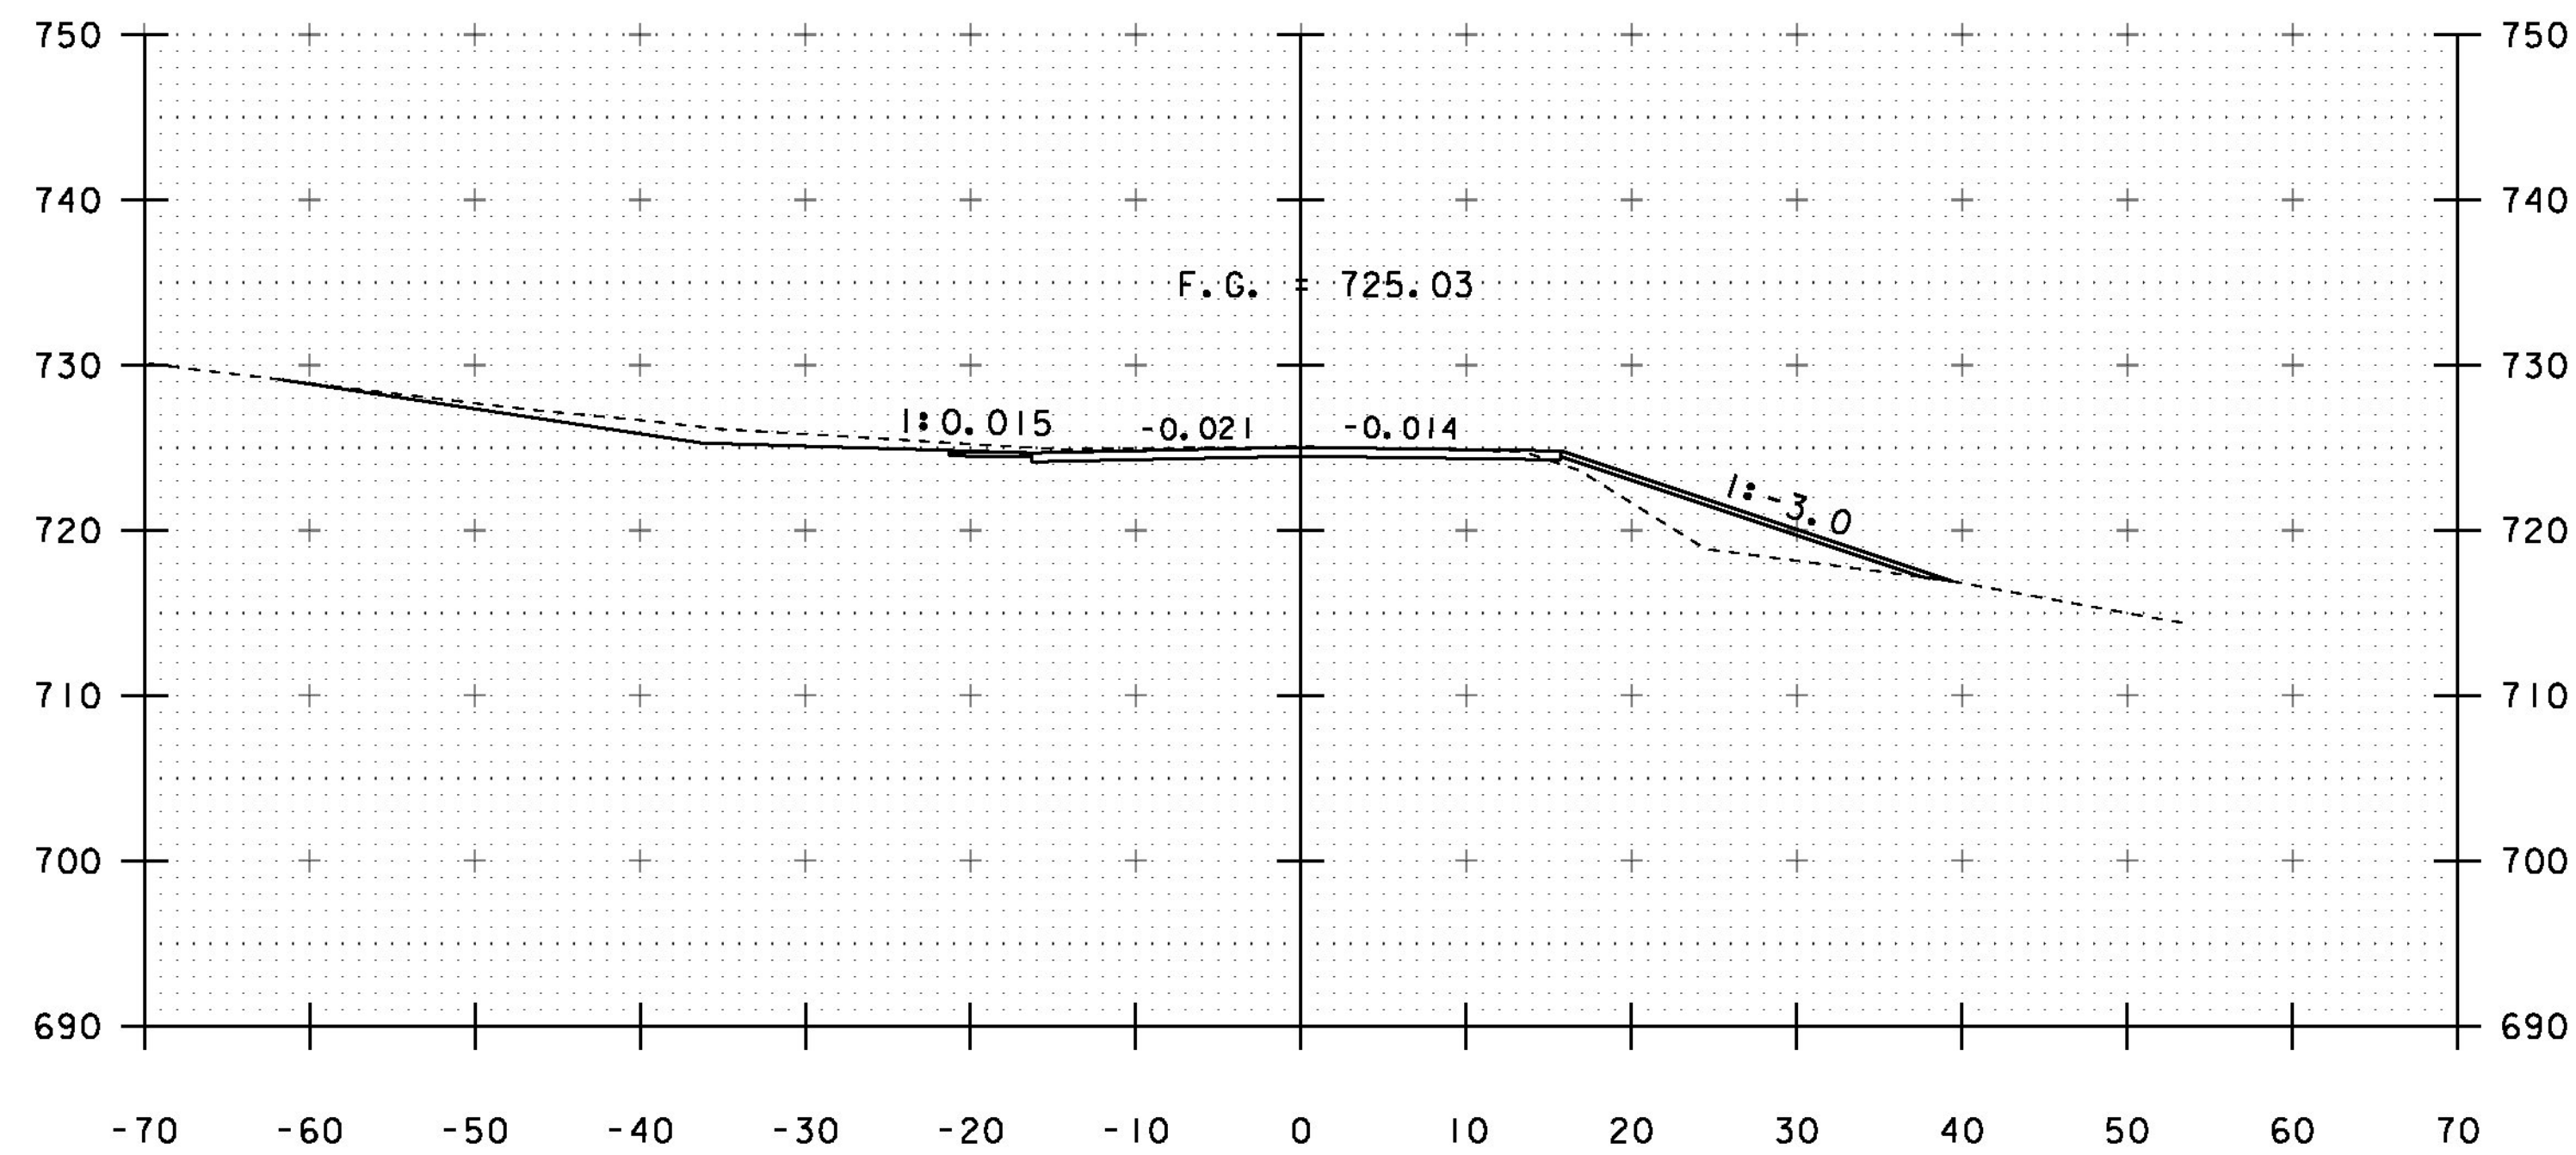

31+25

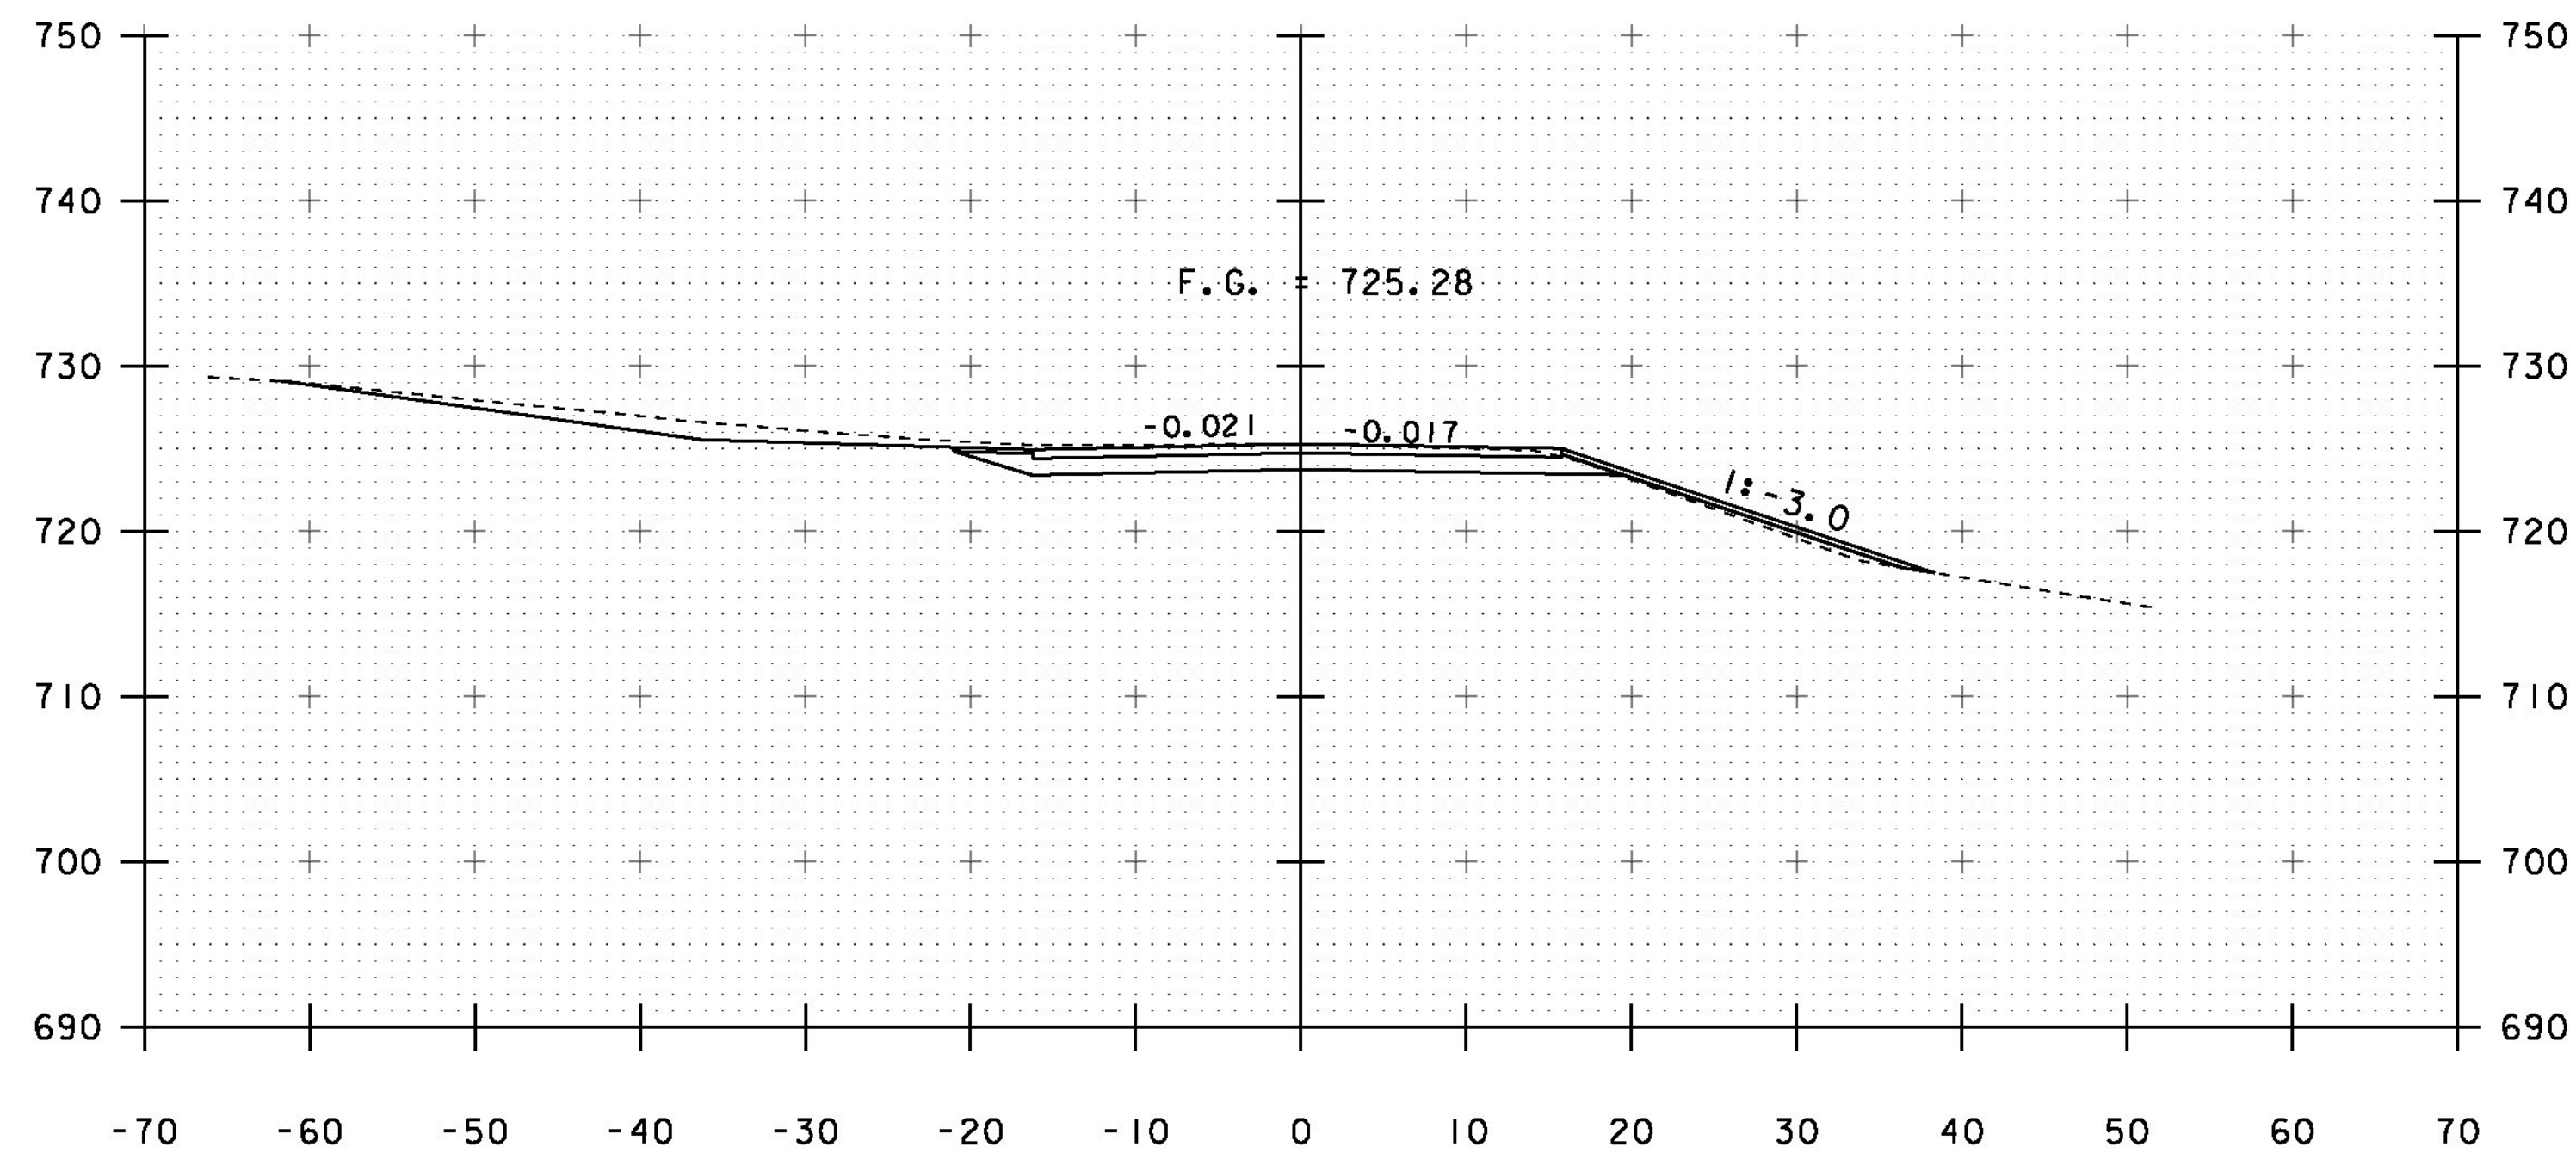

31+00

STA. 30+50 TO STA. 31+25

PROJECT NAME:	MIDDLESEX	PLOT DATE:	13-JAN-2015
PROJECT NUMBER:	BRF 024-I(37)	DRAWN BY:	R. PELLETT
FILE NAME:	sl0c220xs.dgn	DESIGNED BY:	H. SALLS
PROJECT LEADER:	C. CARLSON	CHECKED BY:	H. SALLS
VT 12 CROSS SECTIONS 5		SHEET	34 OF 46