



31+75  
END APPROACH

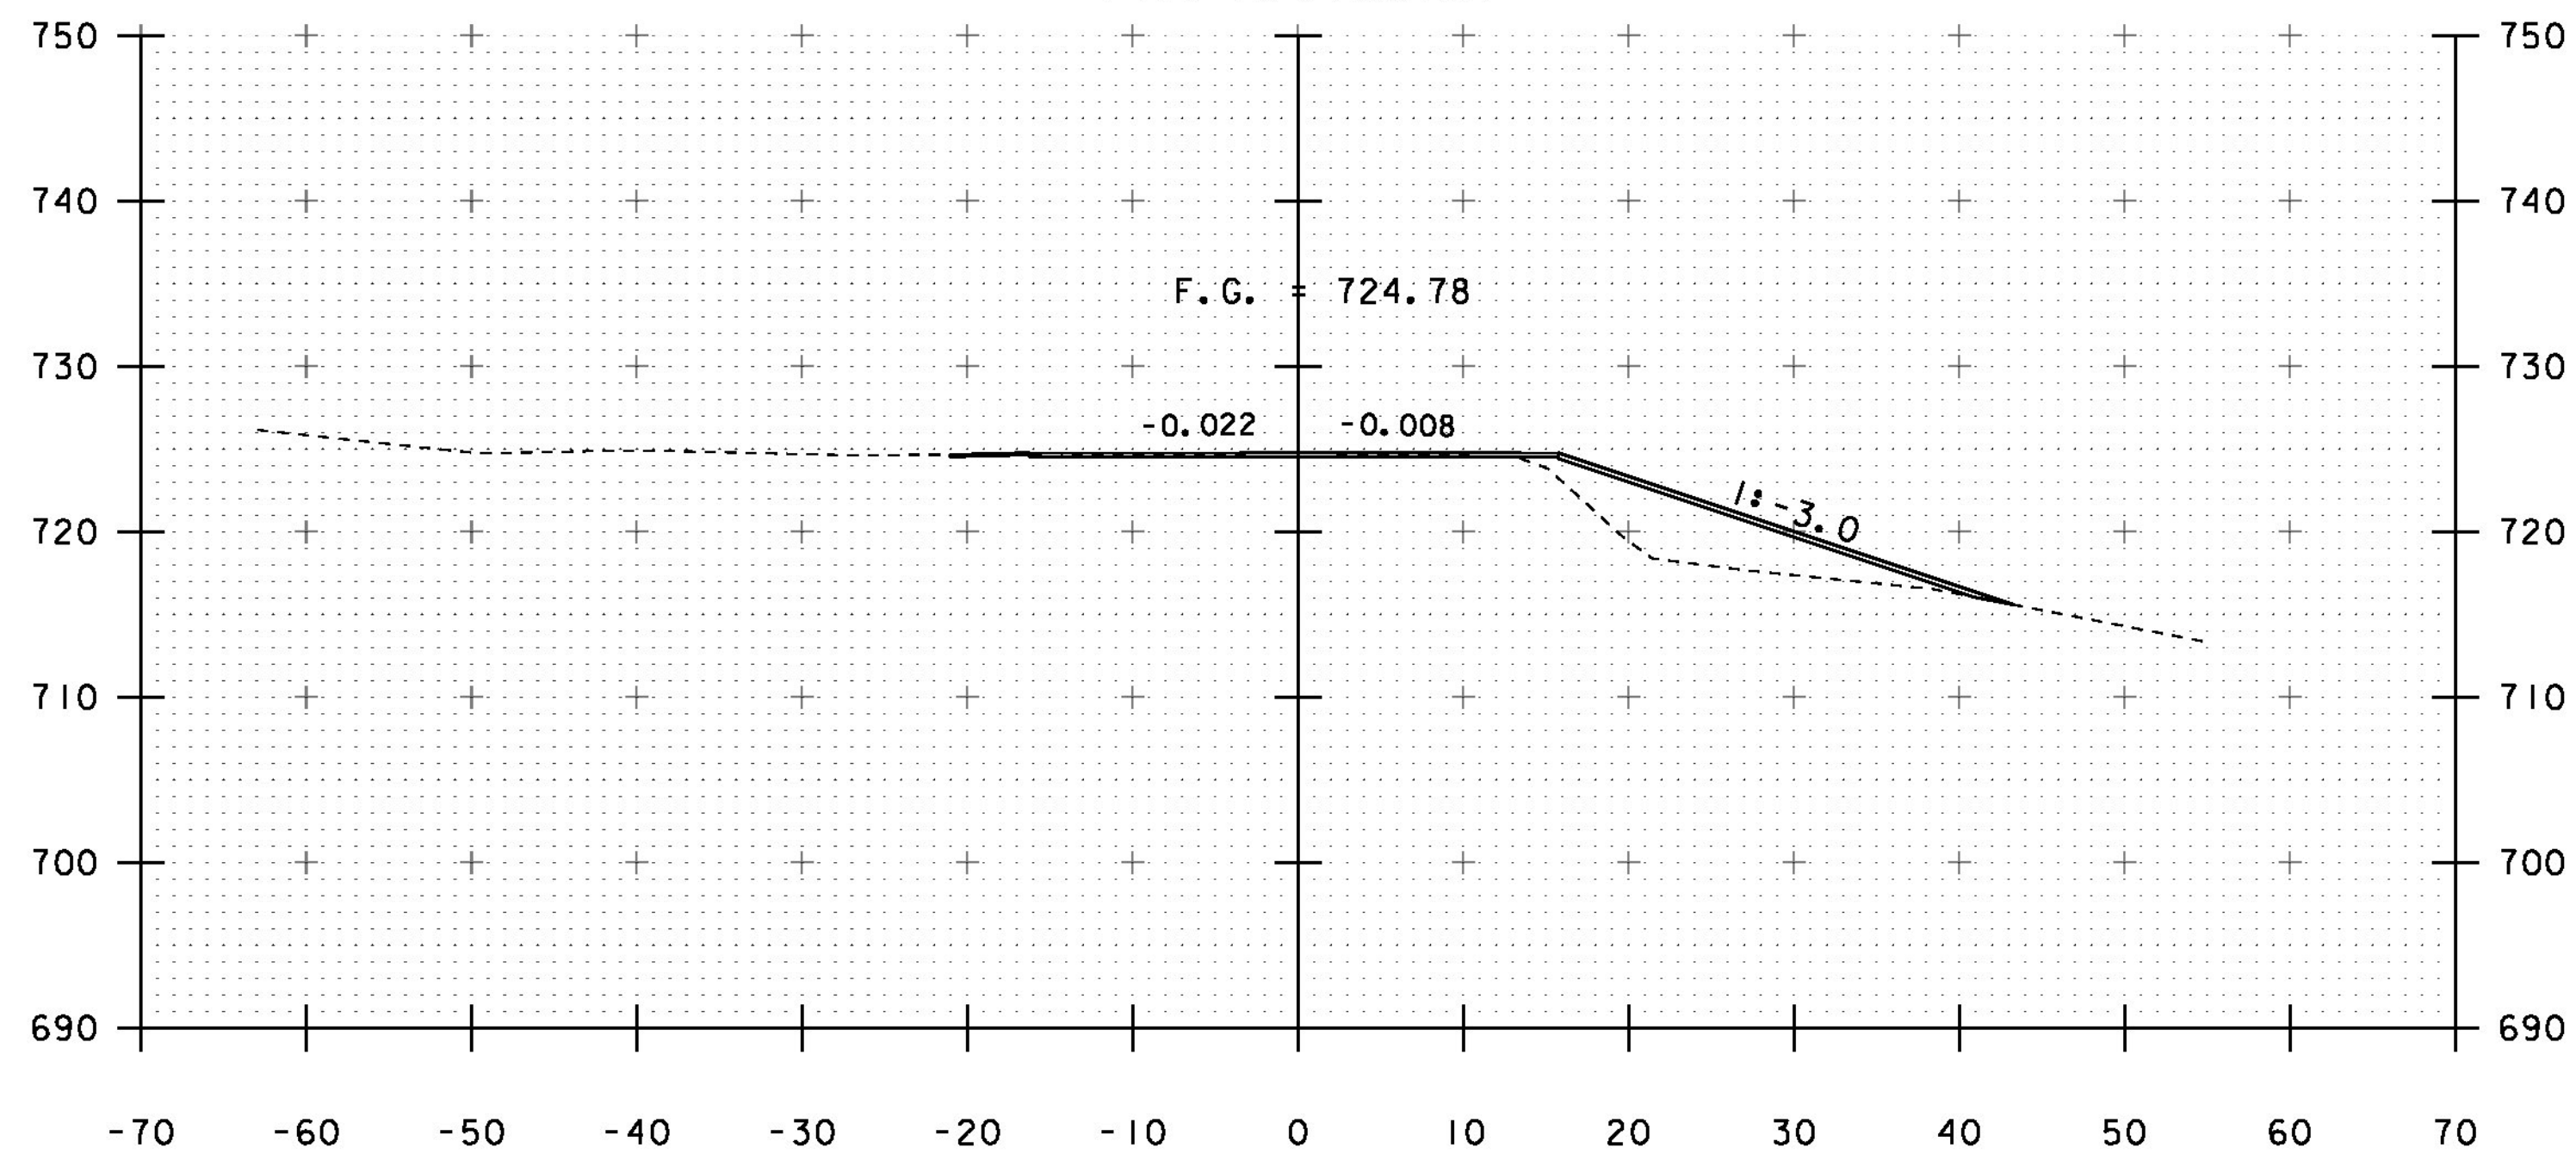

31+50

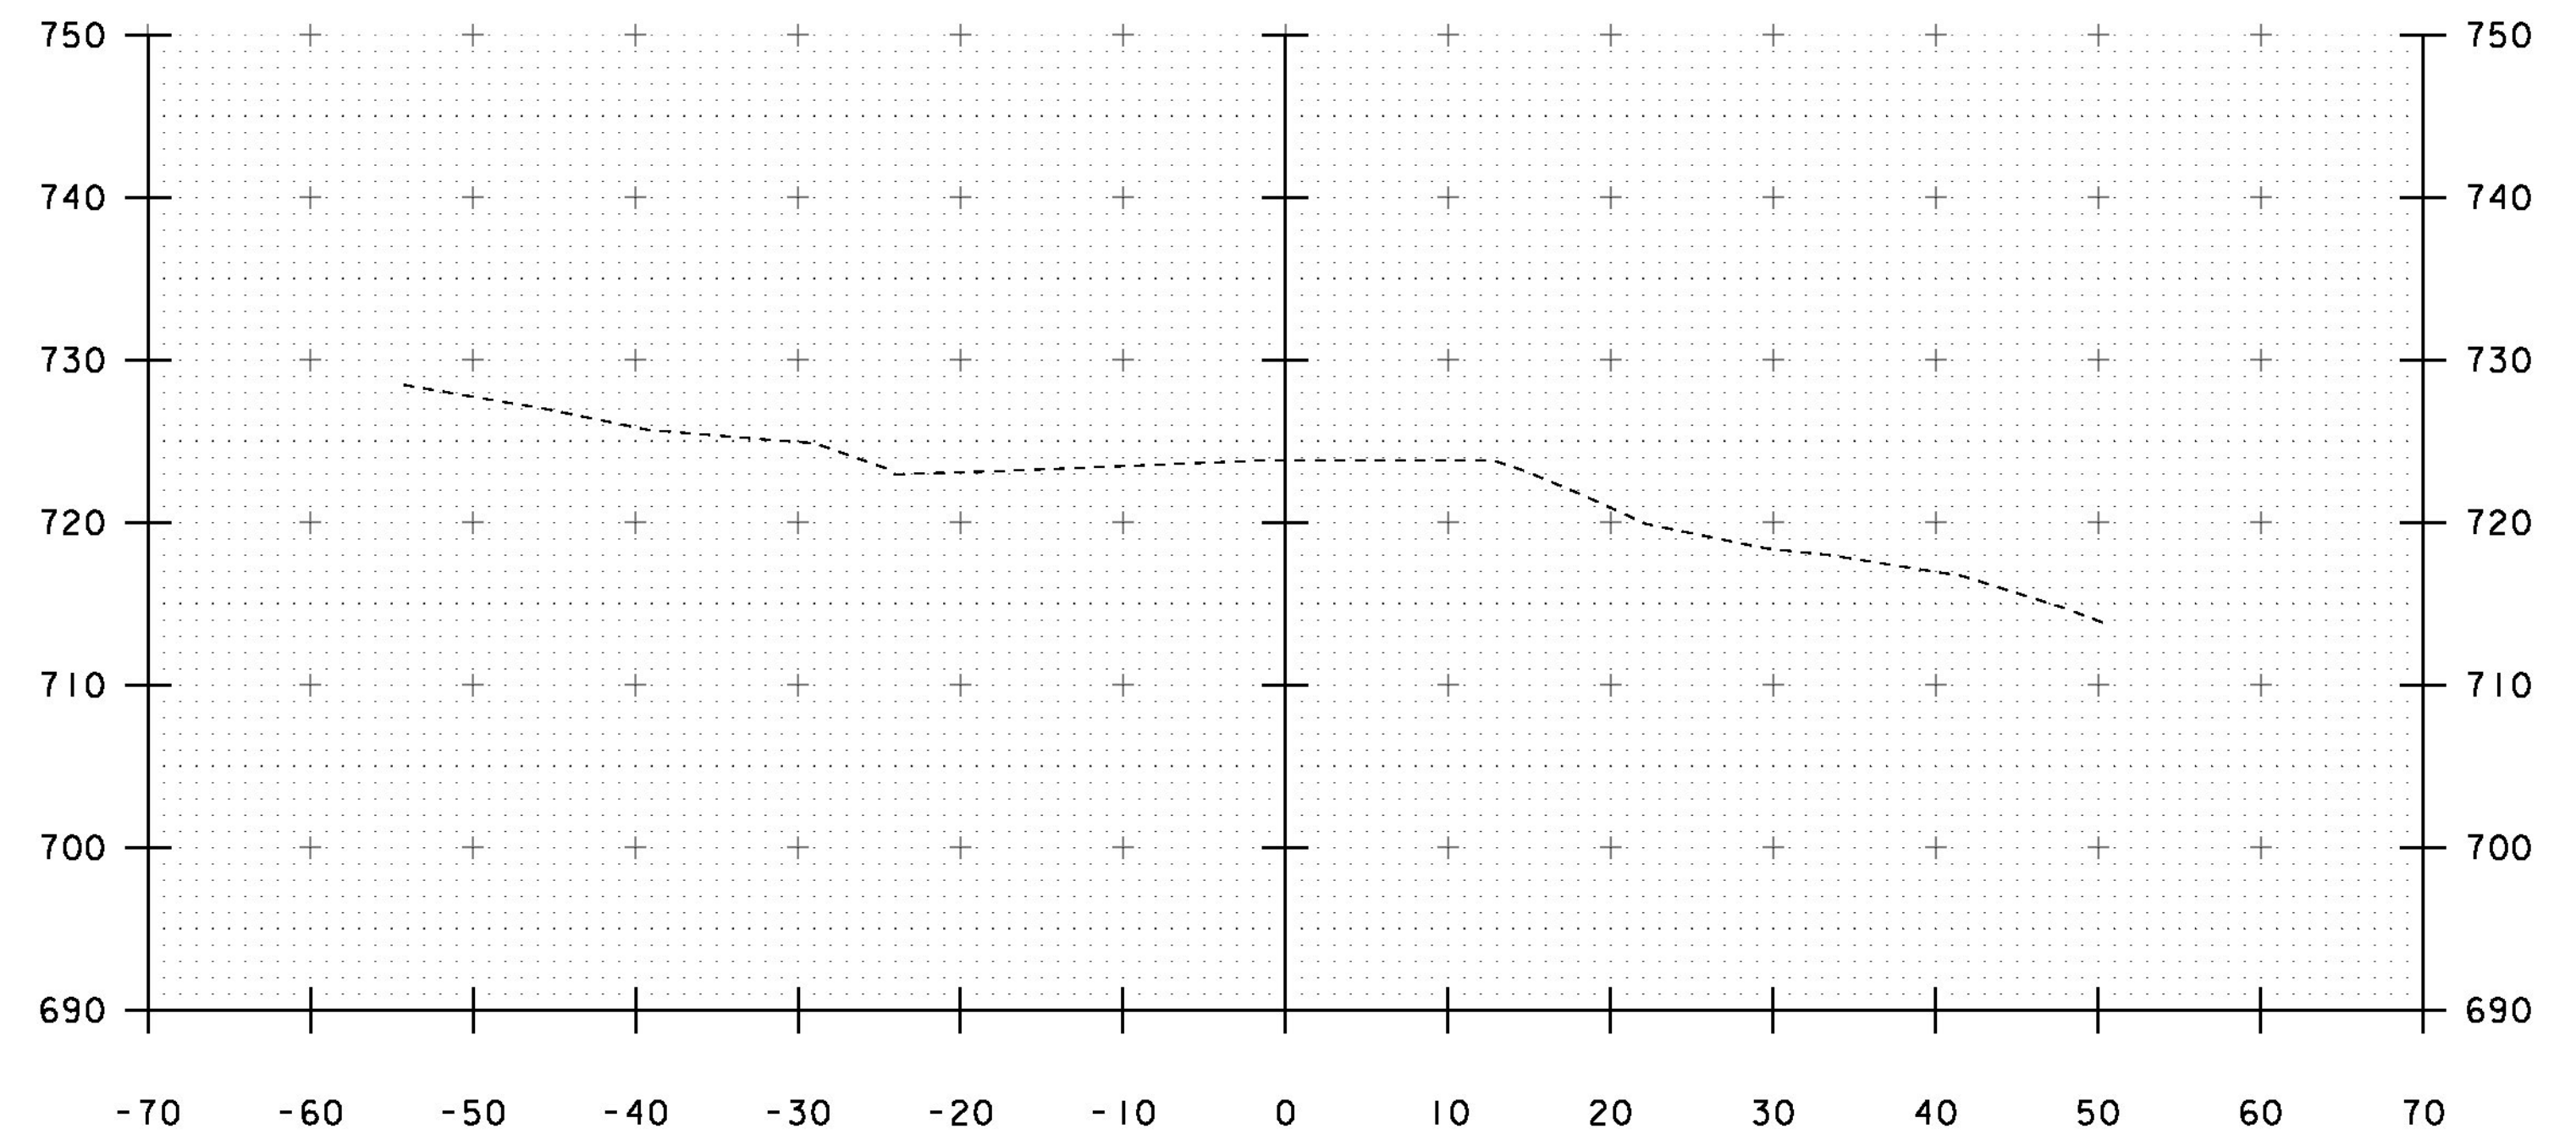

32+00

STA. 31+50 TO STA. 32+00

PROJECT NAME: MIDDLESEX	PLOT DATE: 13-JAN-2015
PROJECT NUMBER: BRP 024-1(37)	DRAWN BY: R. PELLETT
FILE NAME: sl0c220xs.dgn	CHECKED BY: H. SALLS
PROJECT LEADER: C. CARLSON	SHEET 35 OF 46
DESIGNED BY: H. SALLS	VT 12 CROSS SECTIONS 6