




100+50

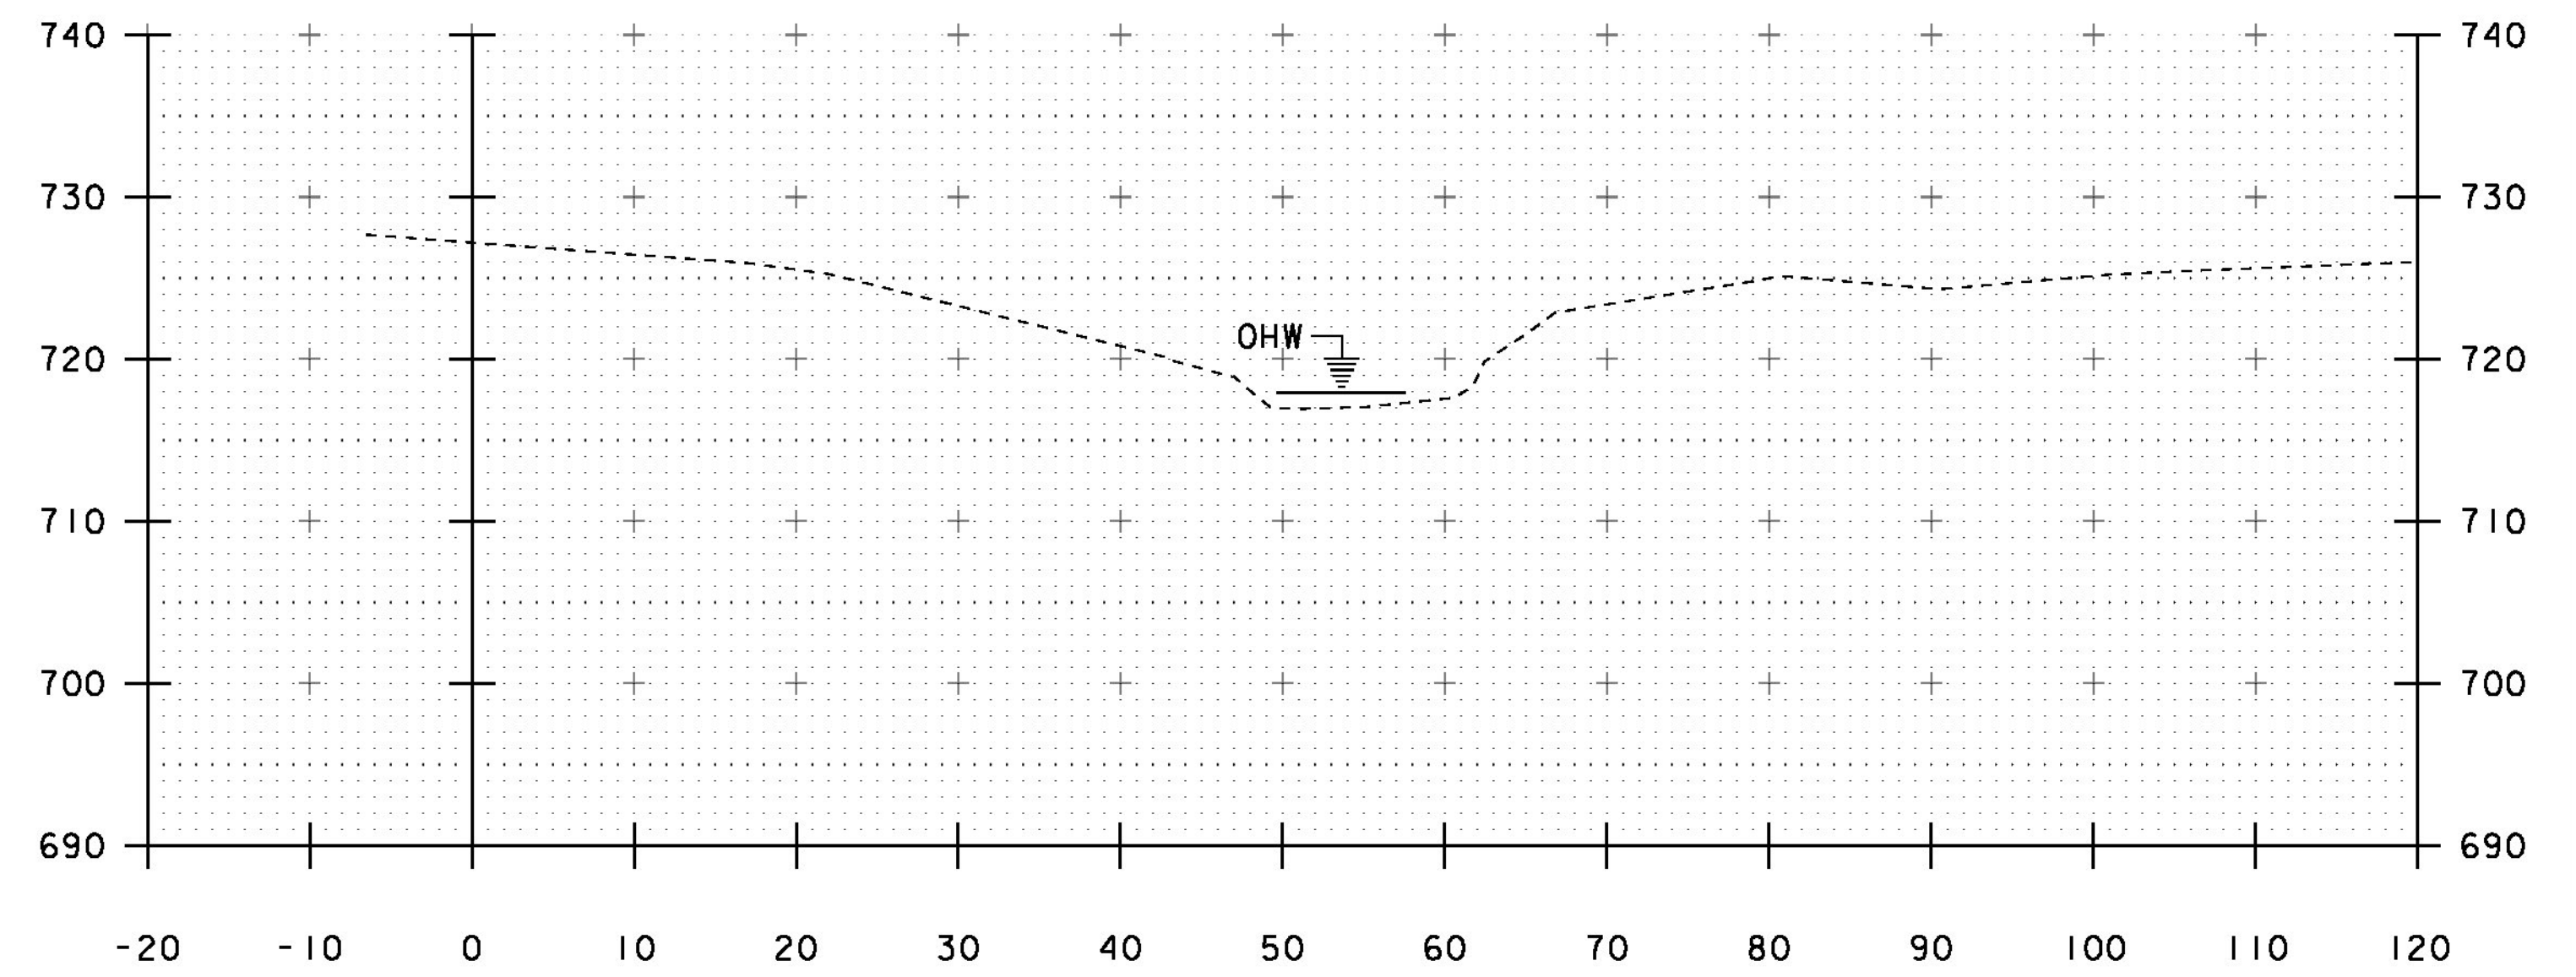

100+80

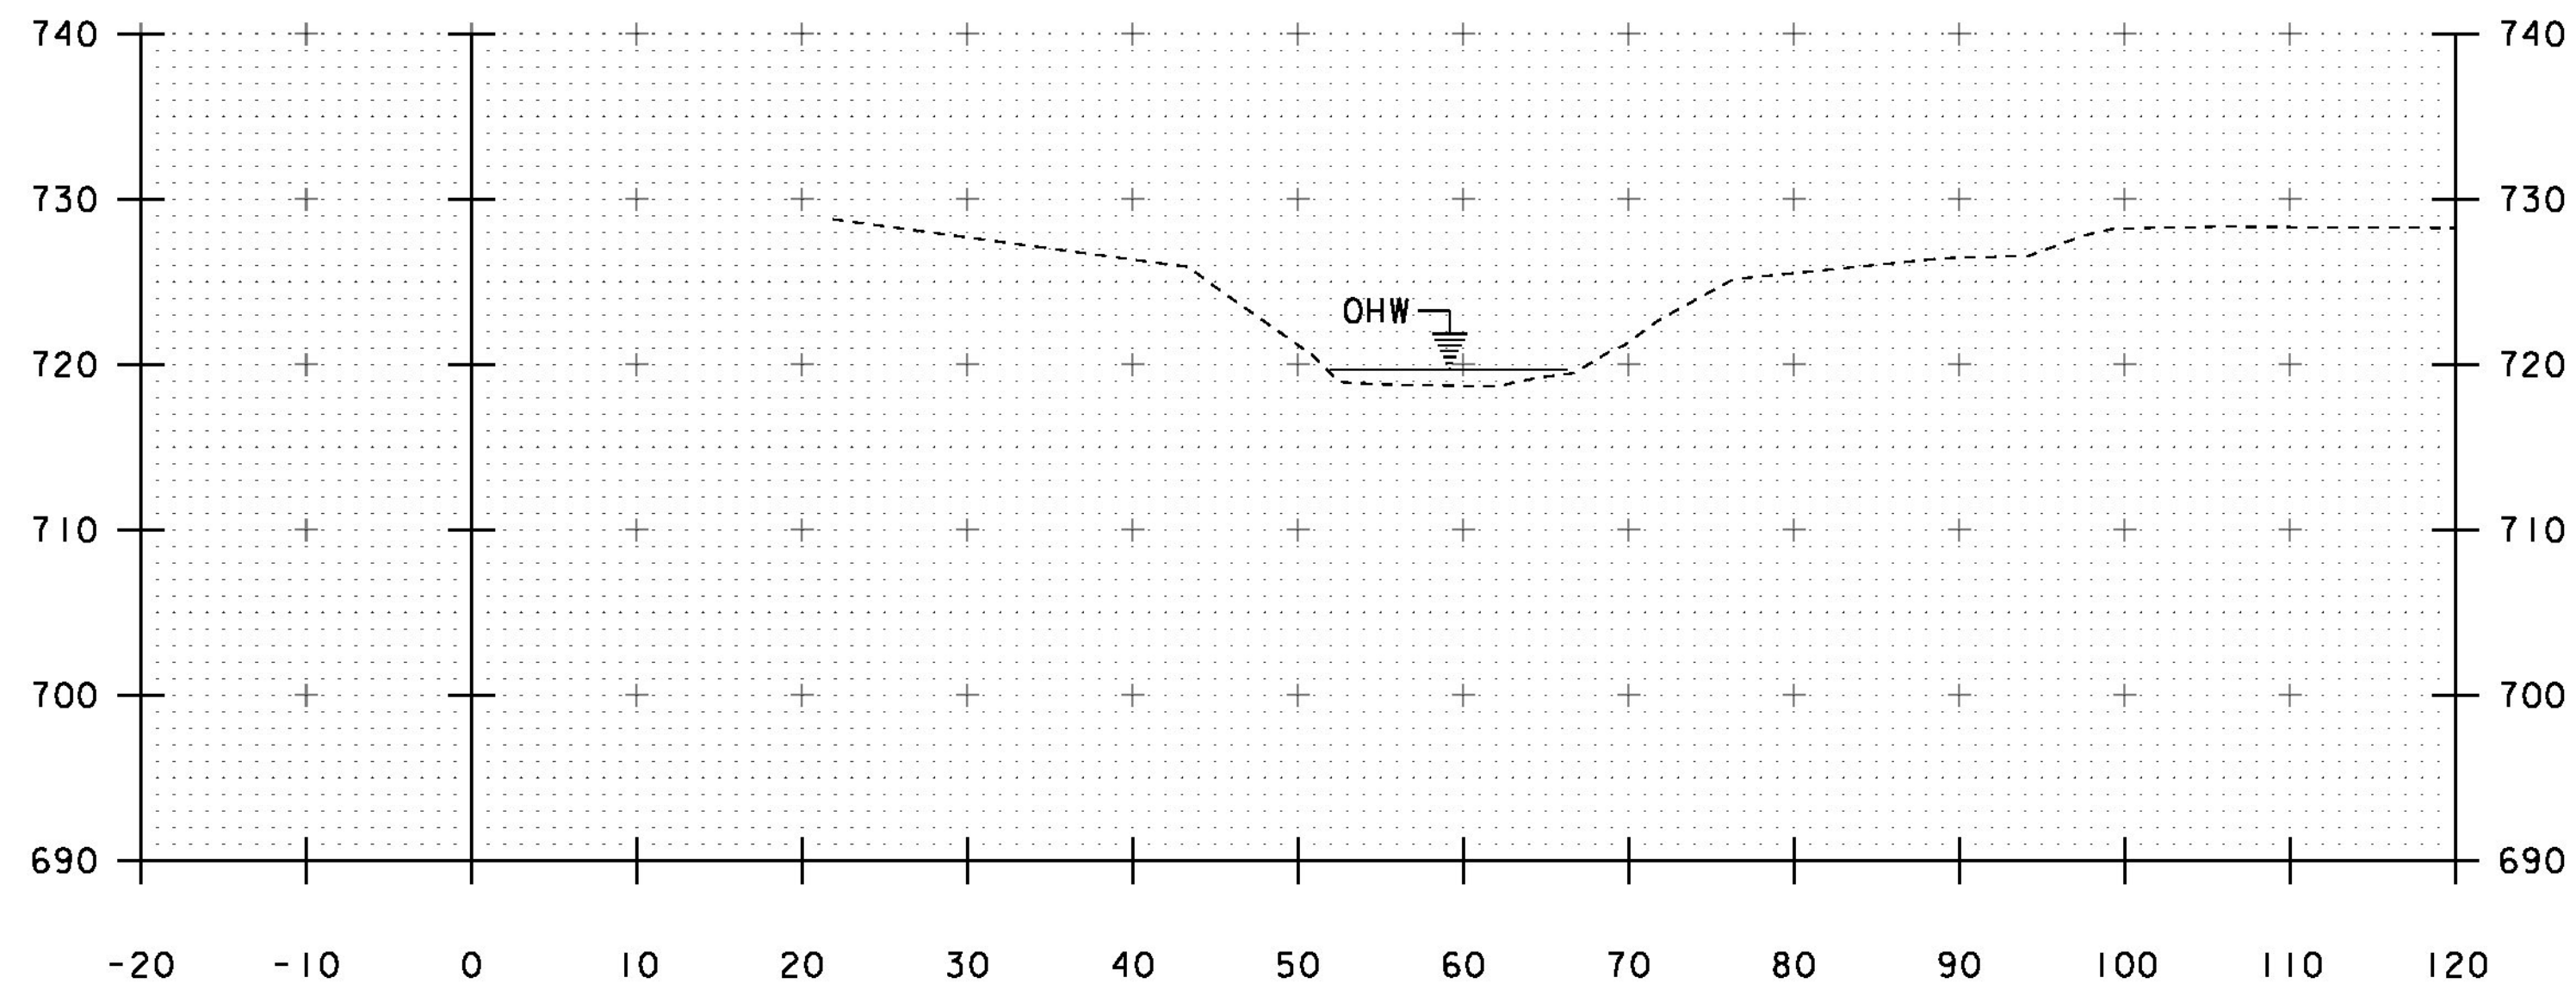

100+25

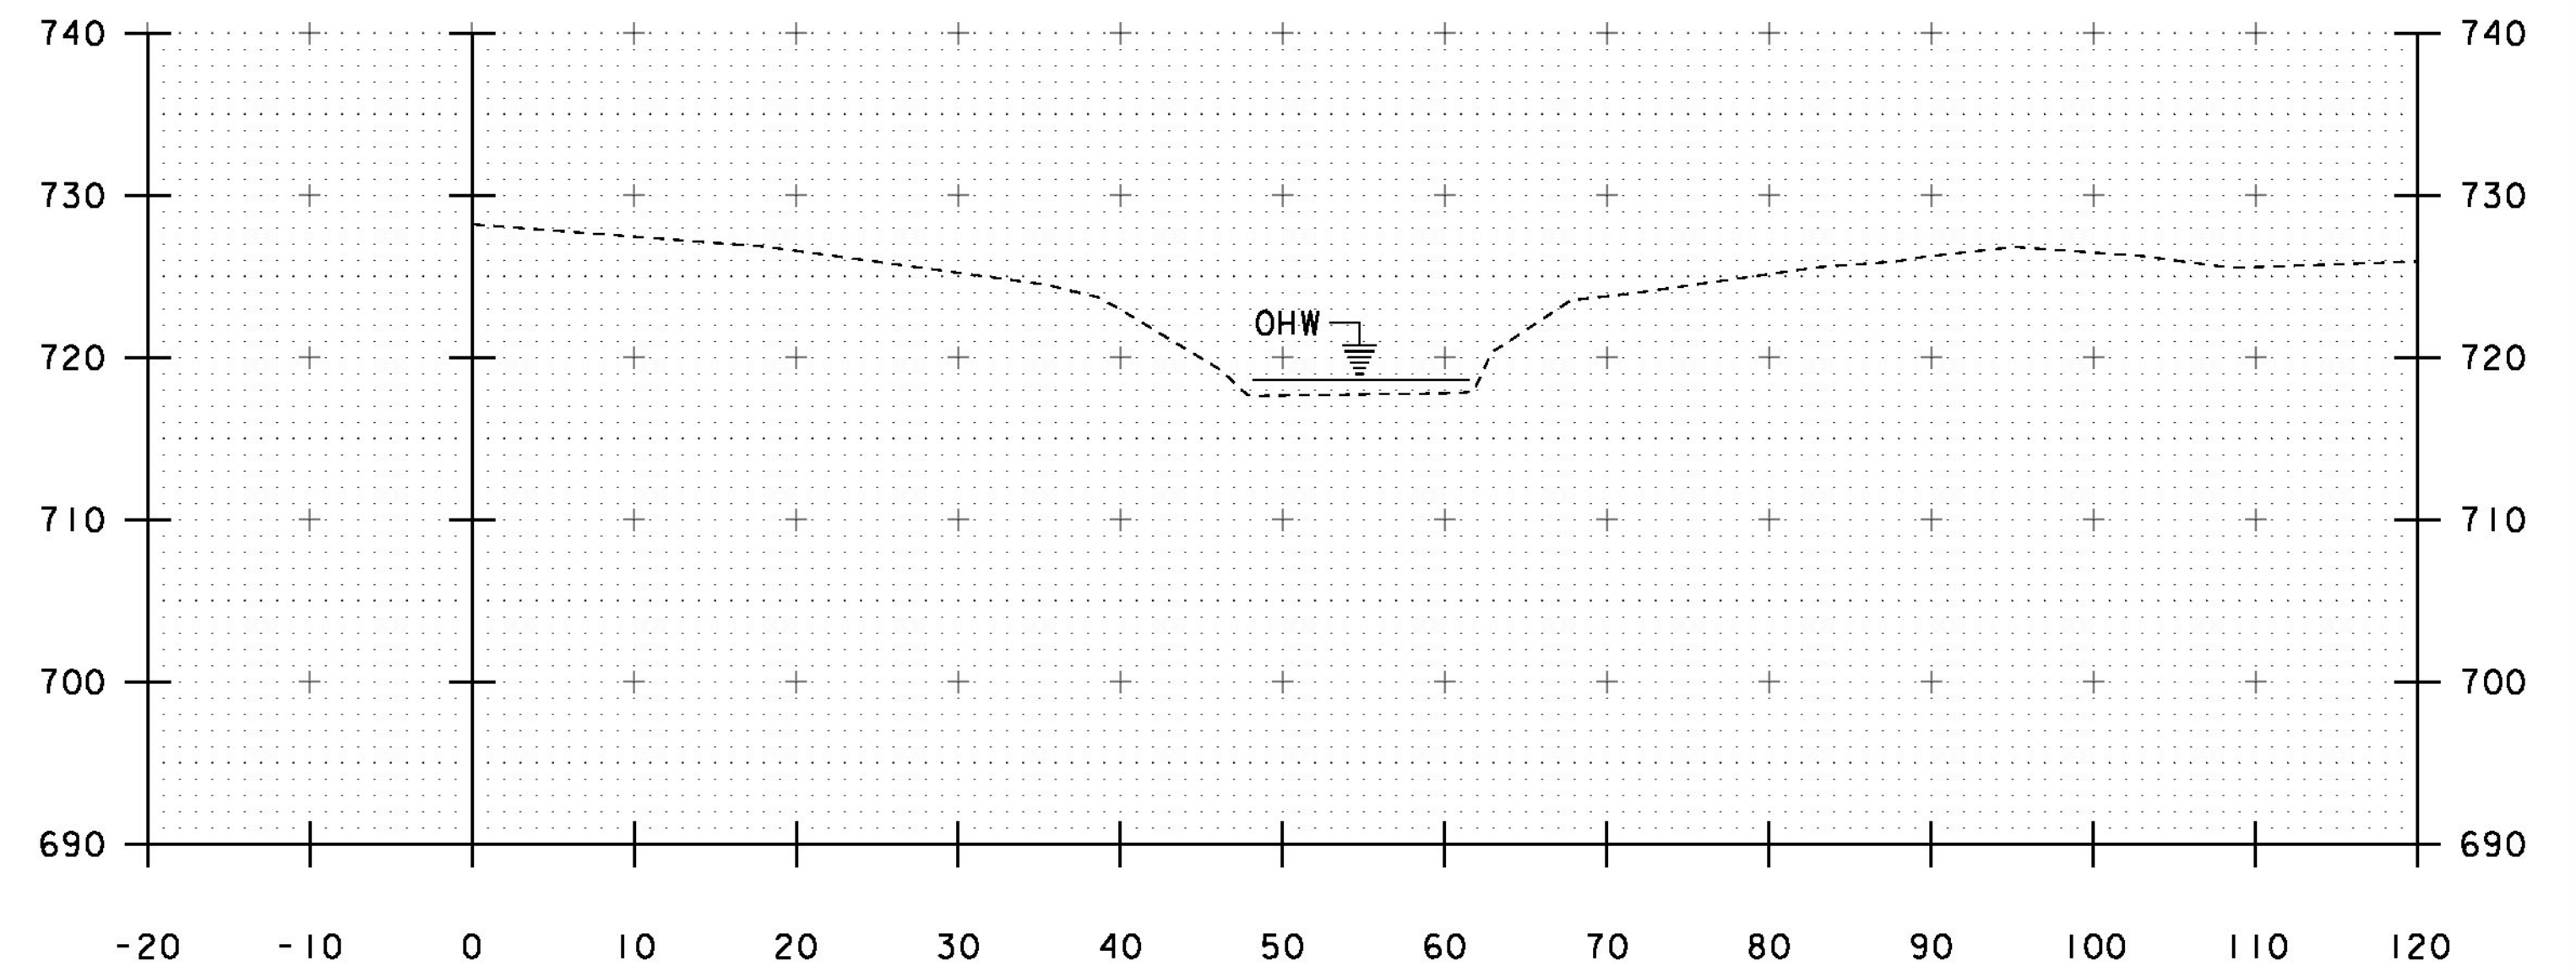

100+70

STA. 100+25 TO STA. 100+80

PROJECT NAME:	MIDDLESEX	PLOT DATE:	13-JAN-2015
PROJECT NUMBER:	BRF 024-I(37)	DRAWN BY:	R. PELLETT
FILE NAME:	sl0c220xs.dgn	DESIGNED BY:	H. SALLS
PROJECT LEADER:	C. CARLSON	CHECKED BY:	H. SALLS
CHANNEL CROSS SECTIONS I		SHEET	37 OF 46