




101+40

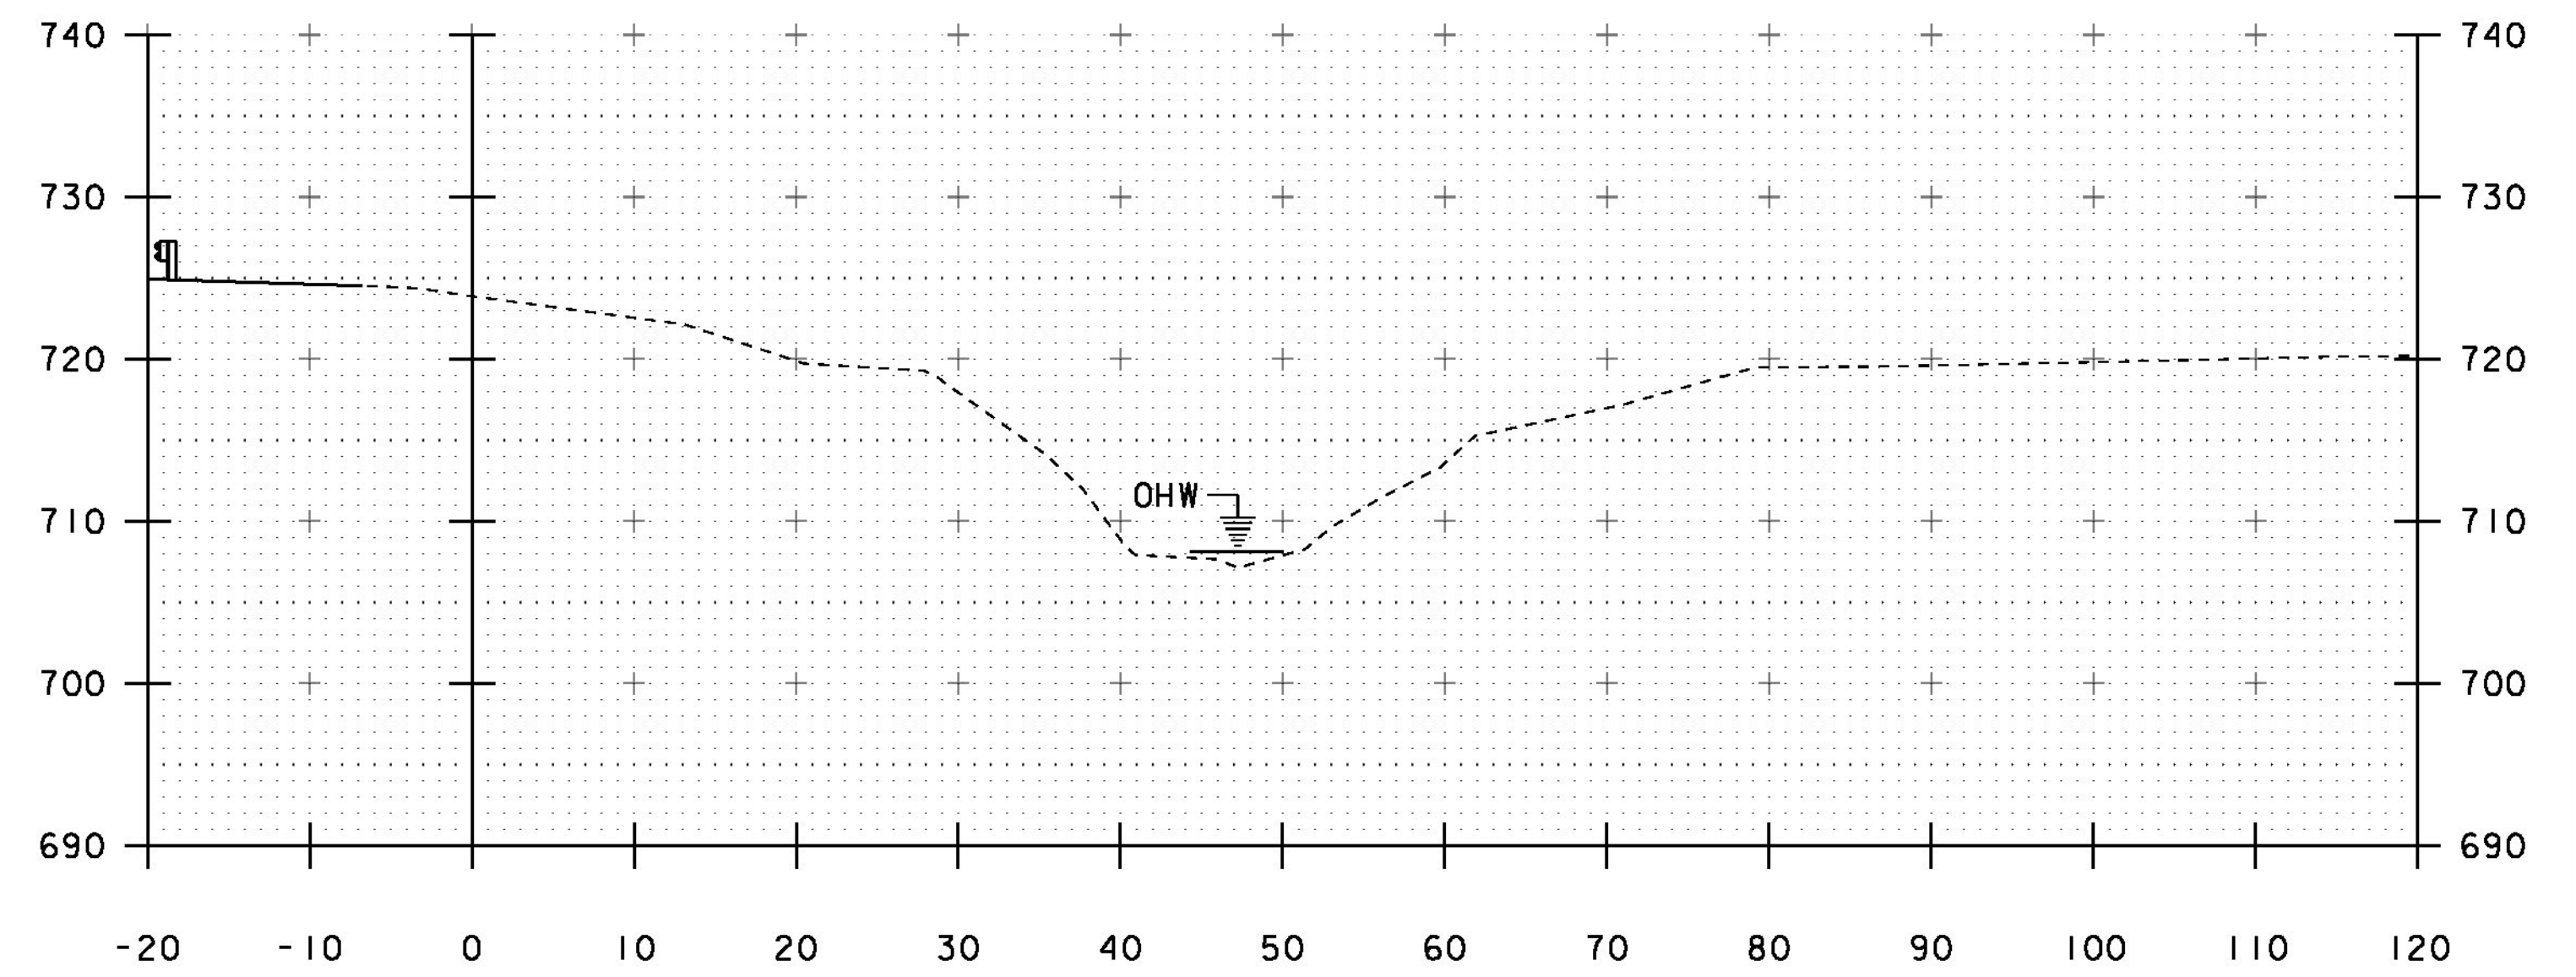

101+75

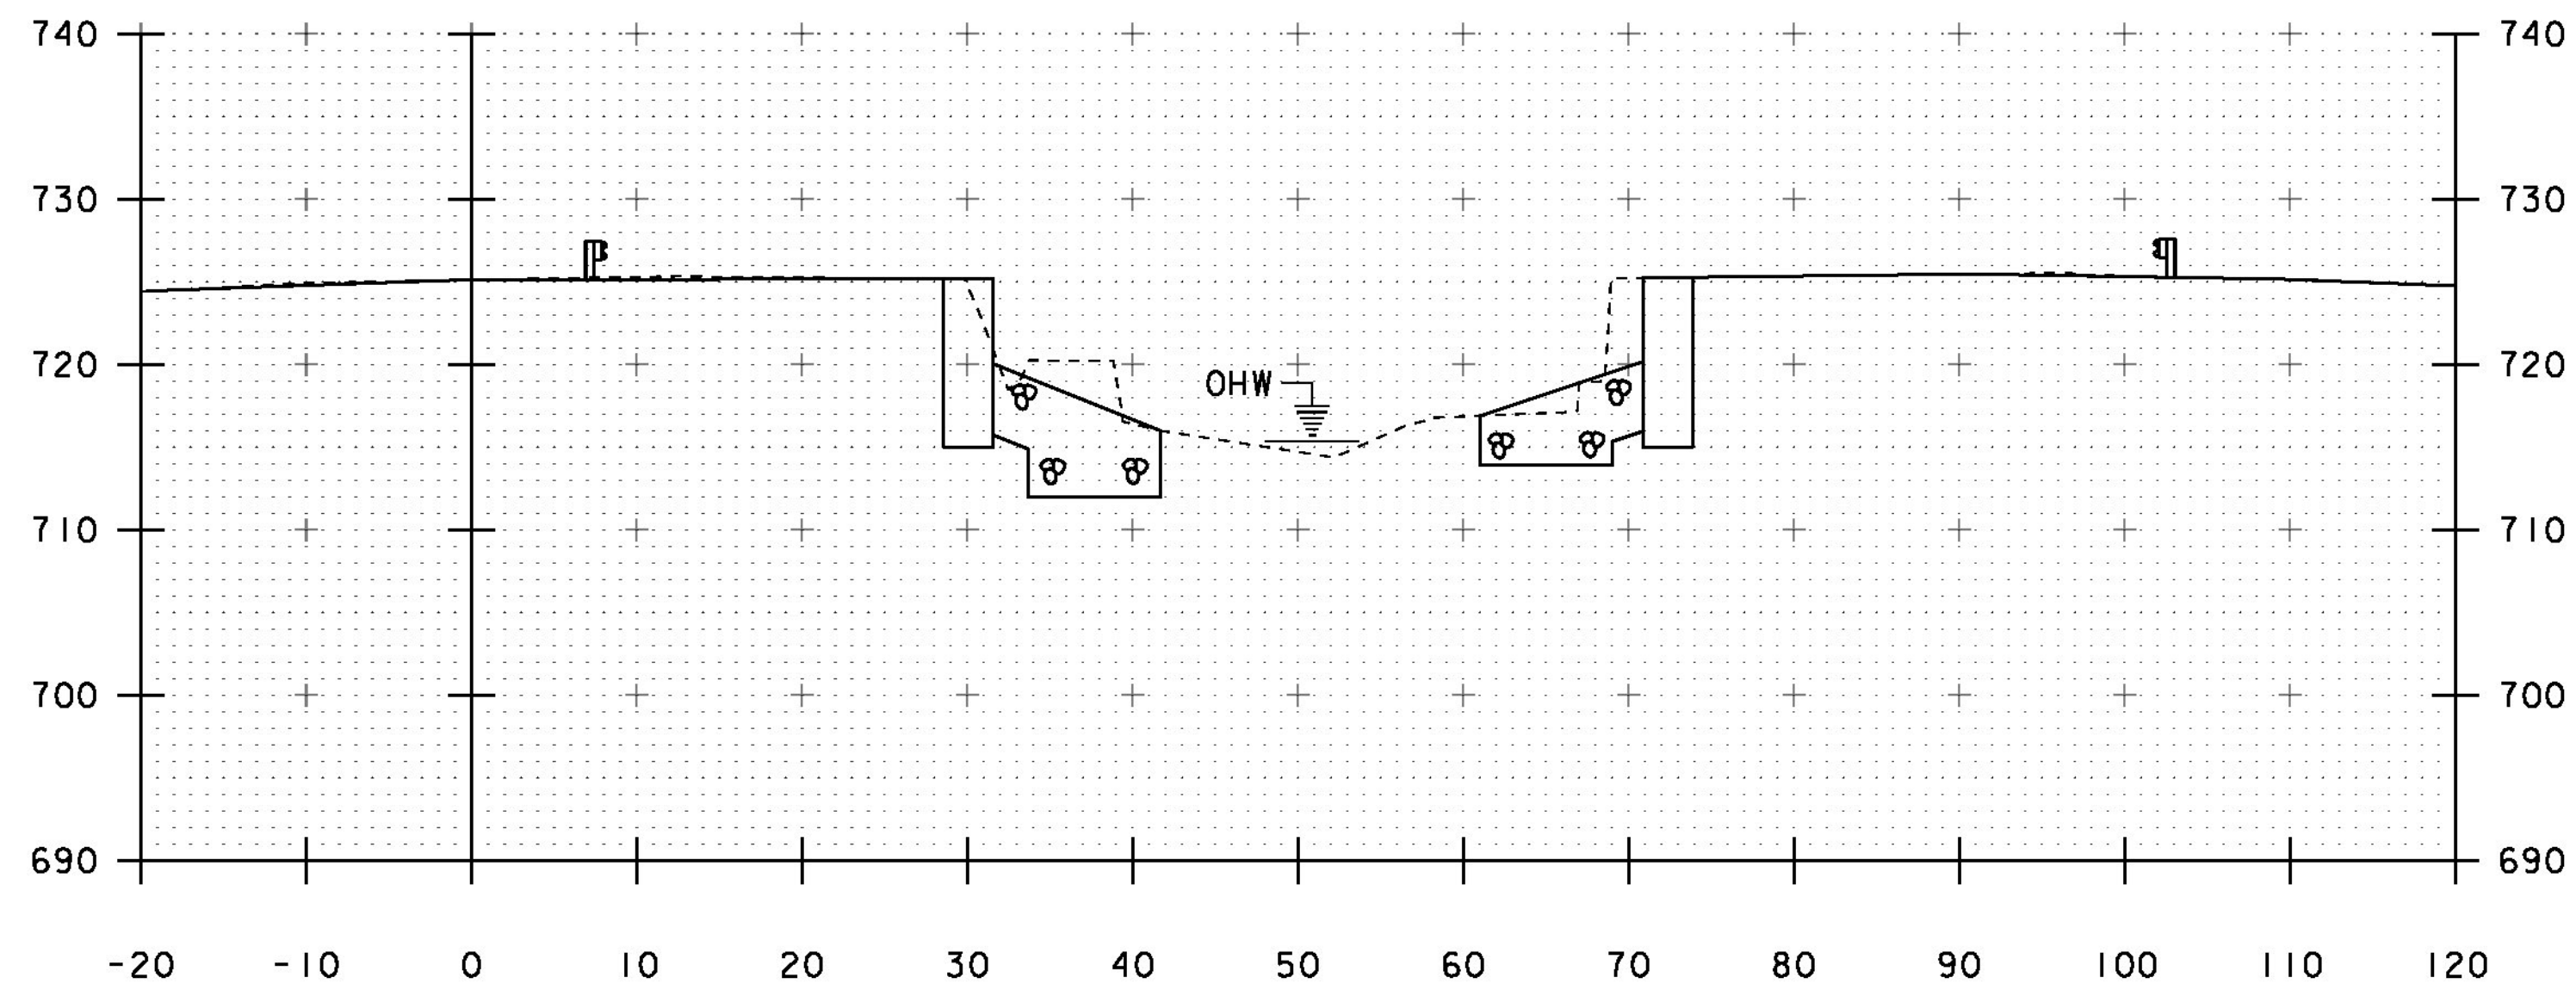

101+30

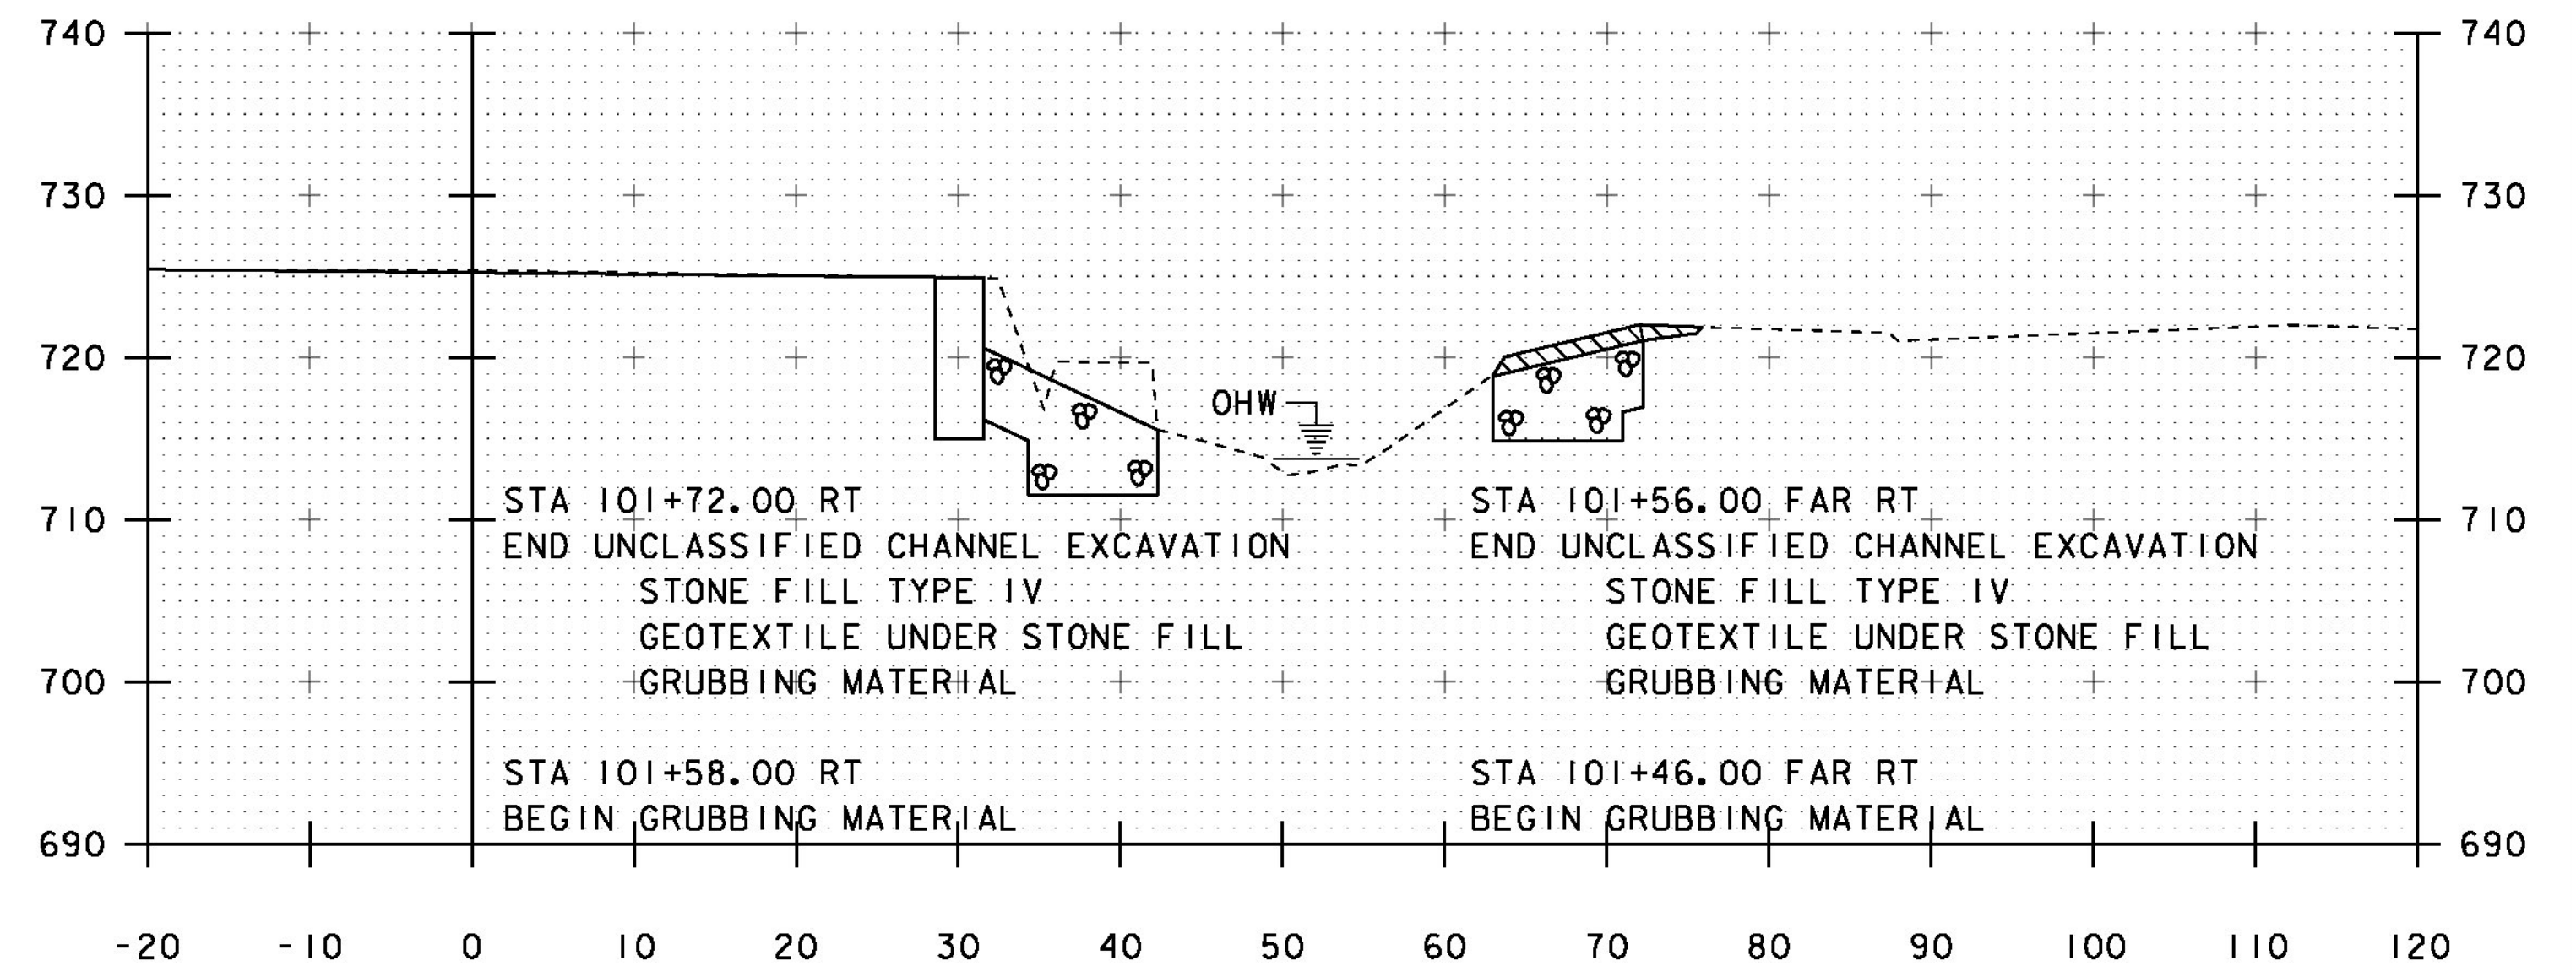

101+50

STA 101+72.00 RT
 END UNCLASSIFIED CHANNEL EXCAVATION
 STONE FILL TYPE IV
 GEOTEXTILE UNDER STONE FILL
 GRUBBING MATERIAL

STA 101+56.00 FAR RT
 END UNCLASSIFIED CHANNEL EXCAVATION
 STONE FILL TYPE IV
 GEOTEXTILE UNDER STONE FILL
 GRUBBING MATERIAL

STA 101+58.00 RT
 BEGIN GRUBBING MATERIAL

STA 101+46.00 FAR RT
 BEGIN GRUBBING MATERIAL

STA. 101+30 TO STA. 101+75

PROJECT NAME: MIDDLESEX
 PROJECT NUMBER: BRF 024-(K37)

FILE NAME: sl0c220xs.dgn
 PROJECT LEADER: C. CARLSON
 DESIGNED BY: H. SALLS
 CHANNEL CROSS SECTIONS 3

PLOT DATE: 13-JAN-2015
 DRAWN BY: R. PELLETT
 CHECKED BY: H. SALLS
 SHEET 39 OF 46