

39C - COLTON GRAVELLY SAND
WITH 8% TO 15% SLOPES
"K FACTOR" = 0.17

19C - COLONEL FINE SANDY LOAM
WITH 8% TO 15% SLOPES
"K FACTOR" = 0.20

41E - BUXON SILT LOAM
WITH 25% TO 45% SLOPES
"K FACTOR" = 0.32

BEGIN APPROACH
STA 26+75.00



BEGIN PROJECT
STA 27+75.00

BEGIN BRIDGE
STA 28+97.11

END BRIDGE
STA 29+43.89

END PROJECT
STA 30+75.00

END APPROACH
STA 31+75.00

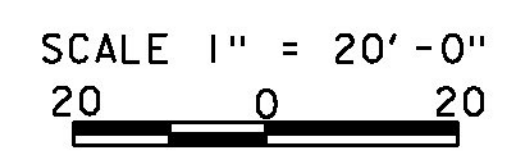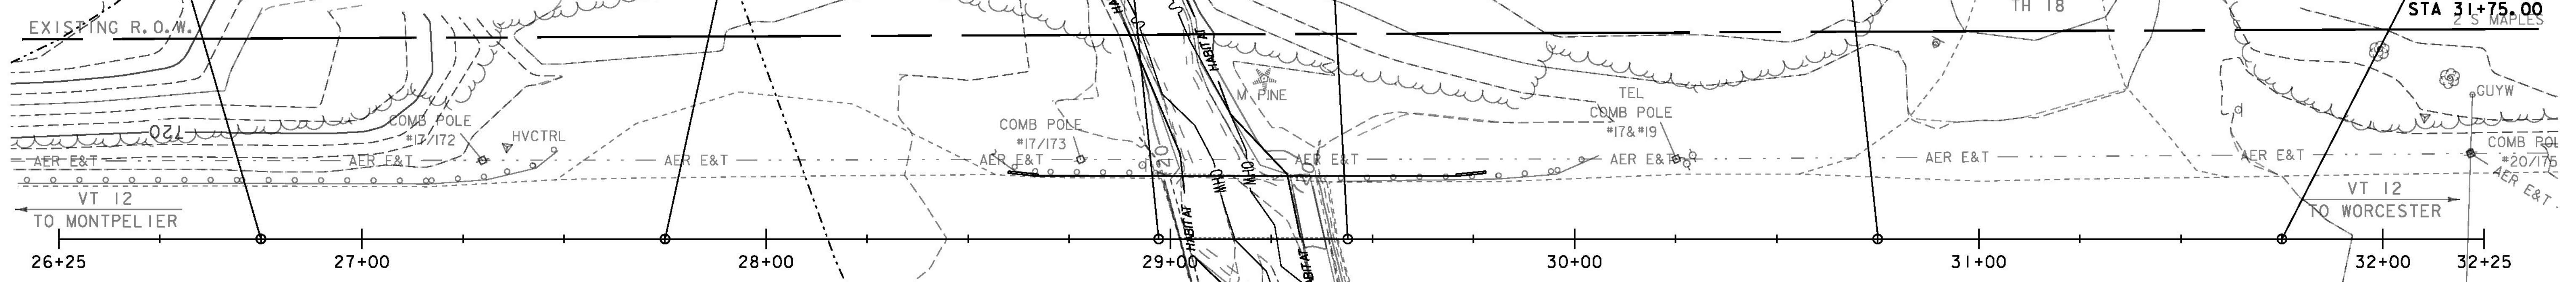

PROJECT NAME: MIDDLESEX	PLOT DATE: 13-JAN-2015
PROJECT NUMBER: BRF 024-K(37)	DRAWN BY: R. PELLETT
FILE NAME: sl0c220bdrero.dgn	CHECKED BY: H. SALLS
PROJECT LEADER: C. CARLSON	SHEET 41 OF 46
DESIGNED BY: H. SALLS	
EPSC EXISTING LAYOUT	