


STATE OF VERMONT AGENCY OF TRANSPORTATION

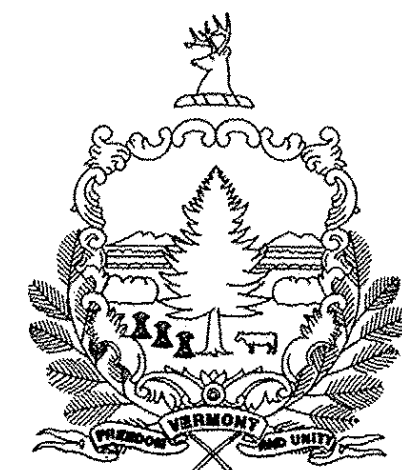

PROPOSED IMPROVEMENT BRIDGE PROJECT


TOWN OF MIDDLESEX
COUNTY OF WASHINGTON

ROUTE NO : VT 12 (RURAL MAJOR COLLECTOR) BRIDGE NO : 77


PROJECT LOCATION : ON VT 12, BEGINNING AT A POINT 0.53 MILES NORTH OF THE MONTPELIER-MIDDLESEX TOWN LINE AND EXTENDING APPROXIMATELY 0.06 MILES IN A NORTHERLY DIRECTION

PROJECT DESCRIPTION : THE PROJECT WILL CONSIST OF THE REPLACEMENT OF THE EXISTING STRUCTURE WITH RELATED APPROACH AND CHANNEL WORK.

LENGTH OF STRUCTURE : 46.78 FEET.
LENGTH OF ROADWAY : 253.22 FEET.
LENGTH OF PROJECT : 300.00 FEET.


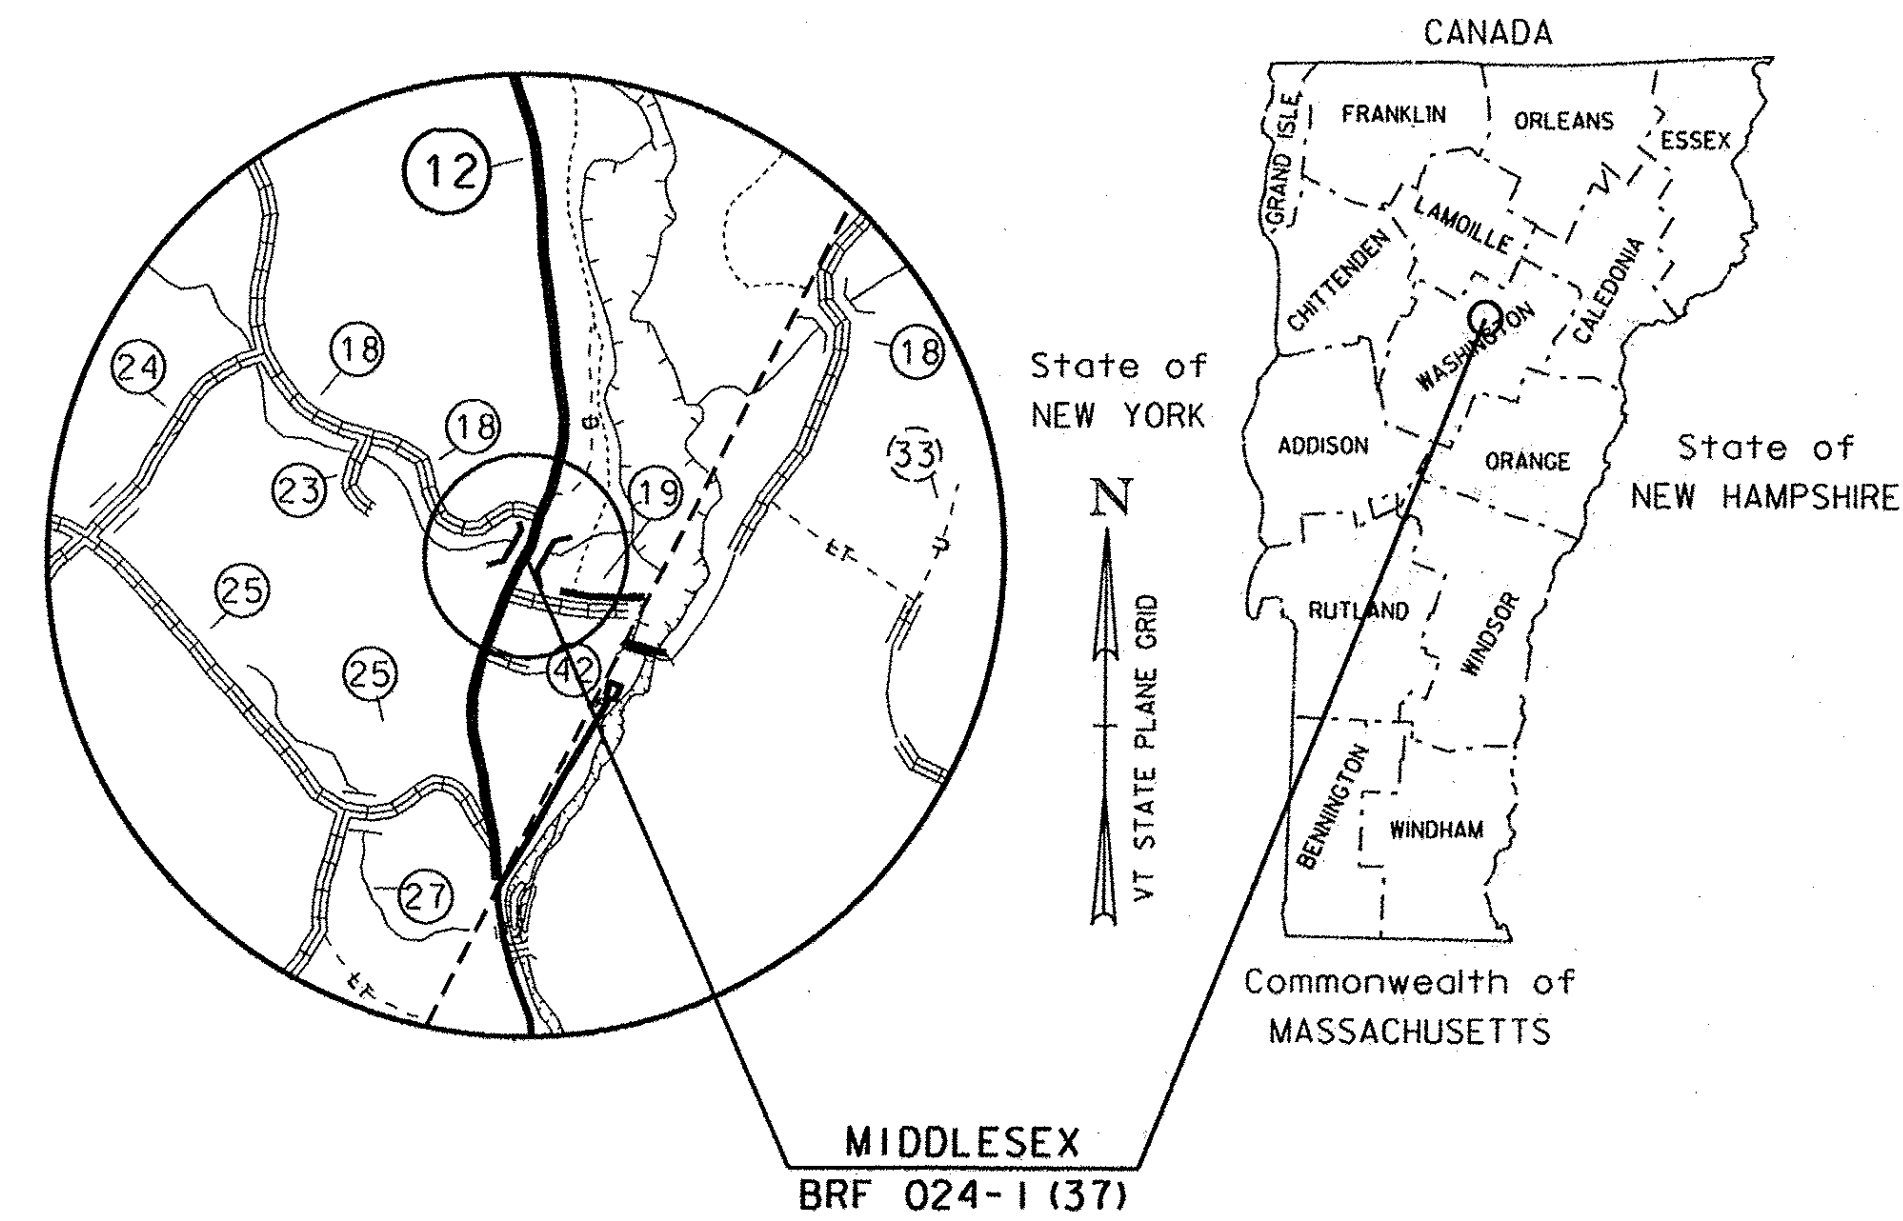


RECORD PLANS	
CONTRACTOR:	A.L. ST. ONGE CONTRACTOR, INC. - MONTGOMERY, VT.
RESIDENT ENGINEER:	ROBERT SUCKERT
CONSTRUCTION BEGAN:	JUNE 26, 2015
CONSTRUCTION COMPLETE:	NOVEMBER 16, 2015
RECORD PLANS BY:	ROBERT SUCKERT & JESSE IVES
I HEREBY CERTIFY THAT ALL THE CONSTRUCTION REQUIRED BY THIS SET OF DRAWINGS HAS BEEN ACCOMPLISHED AS INDICATED HEREIN.	
BY	RESIDENT ENGINEER
DATE	5-17-17
NOTE: Any further information concerning final quantities, amounts or other details relative to this project may be found at Central Files in the electronic archives.	

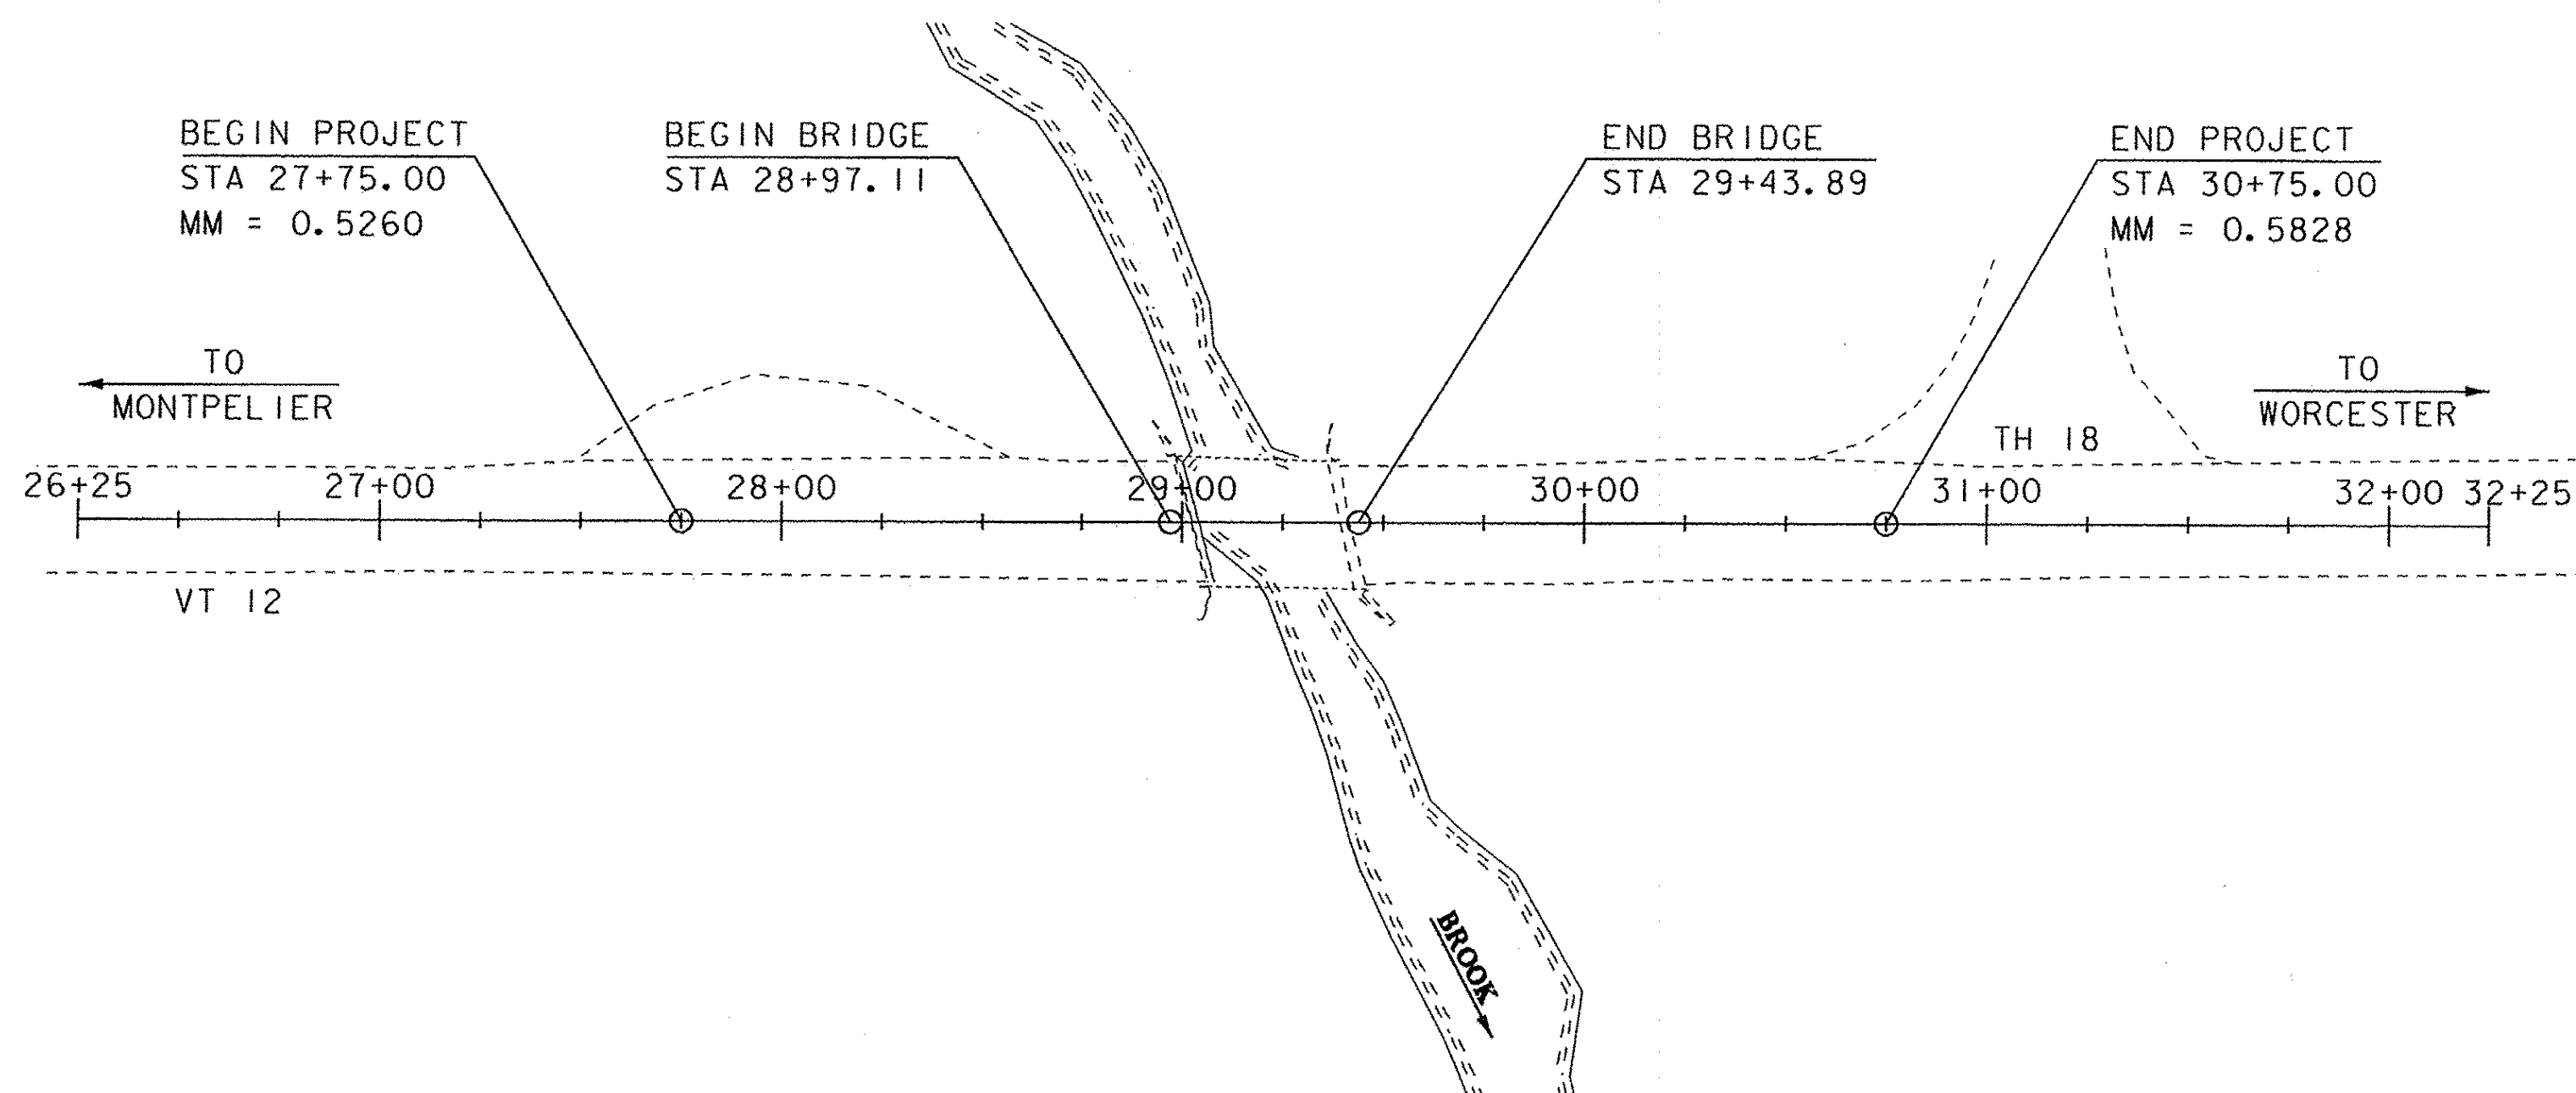

CONSTRUCTION IS TO BE CARRIED ON IN ACCORDANCE WITH THESE PLANS AND THE STANDARD SPECIFICATIONS FOR CONSTRUCTION DATED 2011, AS APPROVED BY THE FEDERAL HIGHWAY ADMINISTRATION ON JULY 20, 2011 FOR USE ON THIS PROJECT, INCLUDING ALL SUBSEQUENT REVISIONS AND SUCH REVISED SPECIFICATIONS AND SPECIAL PROVISIONS AS ARE INCORPORATED IN THESE PLANS.

QUALITY ASSURANCE PROGRAM : LEVEL 2	
SURVEYED BY :	R. GILMAN
SURVEYED DATE :	01/10/2011
DATUM	
VERTICAL	NAVD 88
HORIZONTAL	NAD-83 (07)

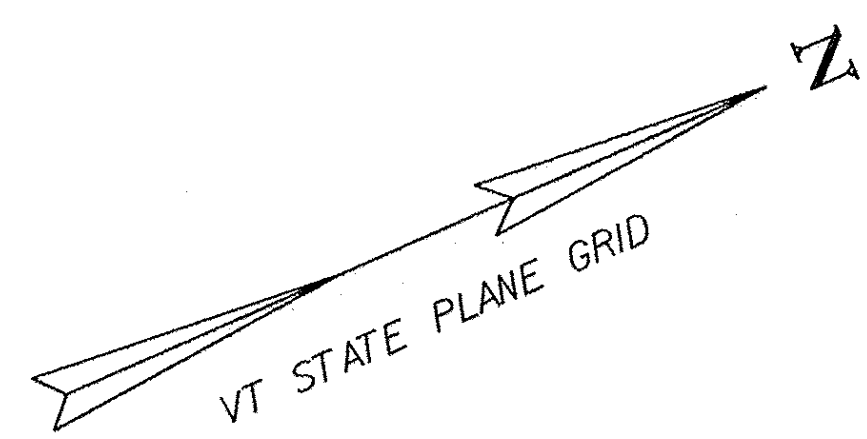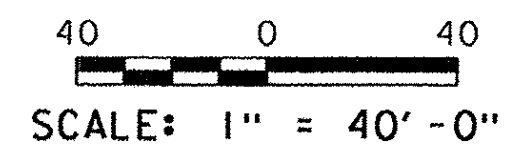

DIRECTOR OF PROJECT DELIVERY	
APPROVED	DATE 1/9/2015
PROJECT MANAGER :	CAROLYN CARLSON, P. E.
PROJECT NAME :	MIDDLESEX
PROJECT NUMBER :	BRF 024-1 (37)
SHEET 1 OF 46 SHEETS	

PRELIMINARY INFORMATION SHEET (BRIDGE)

LRFD

INDEX OF SHEETS

FINAL HYDRAULIC REPORT

PLAN SHEETS

1	TITLE SHEET
2	PRELIMINARY INFORMATION
3 - 4	TYPICAL SECTIONS 1-2
5	PROJECT NOTES
6 - 7	QUANTITY SHEETS
8	BRIDGE QUANTITY SHEET
9	CONVENTIONAL SYMBOLOLOGY LEGEND
10	TIE SHEET
11	LAYOUT
12	VT 12 PROFILE
13	UTILITY LAYOUT
14	TRAFFIC SIGNS & PAVEMENT MARKINGS
15	TRAFFIC SIGN SUMMARY
16	BORING INFORMATION
17	BORING LOGS
18	PLAN & ELEVATION
19	DECK REINFORCING SECTION
20	DECK REINFORCING PLAN
21	FRAMING PLAN
22	BEARING DETAILS
23	APPROACH SLAB DETAILS
24	ABUTMENT # 1 PLAN AND ELEVATION
25	ABUTMENT # 2 PLAN AND ELEVATION
26	ABUTMENT TYPICAL
27	WINGWALL DETAILS
28	WINGWALL ELEVATIONS
29	REINFORCING STEEL SCHEDULE
30 - 35	VT 12 CROSS SECTIONS 1-6
36	BANKING & MATERIAL TRANSITION
37 - 39	CHANNEL CROSS SECTIONS 1-3
40	EPSC NARRATIVE
41	EPSC EXSTING LAYOUT
42	EPSC CONSTRUCTION LAYOUT
43	EPSC FINAL LAYOUT
44 - 45	EPSC DETAILS 1-2
46	R.O.W. INFORMATION SHEET

STANDARDS LIST

C-10	CURBING	02-11-2008
E-141	REGULATORY SIGN DETAILS	09-20-1995
E-142	REGULATORY SIGN DETAILS	09-20-1995
E-143	REGULATORY SIGN DETAILS	06-15-2004
E-151	WARNING SIGN DETAILS	05-01-2004
E-153	WARNING SIGN DETAILS	05-01-2004
E-155	WARNING SIGN DETAILS	05-01-2004
E-191	PAVEMENT MARKING DETAILS	02-01-1999
E-193	PAVEMENT MARKING DETAILS	08-18-1995
G-1	STEEL BEAM GUARDRAIL DETAILS (POST, DELINEATOR, TYPICALS)	02-10-2014
G-1D	STEEL BEAM GUARDRAIL DETAILS (END TERMINAL, ANCHOR, MEDIAN)	02-10-2014
G-19	GENERIC GRADING PLANS FOR GUARDRAIL END TERMINALS	11-15-2002
S-360A	BRIDGE RAILING, GALVANIZED 2 RAIL BOX BEAM	04-23-2012
S-360B	GUARDRAIL APPROACH SECTION, GALVANIZED 2 RAIL BOX BEAM	04-23-2012
S-363	THRIE BEAM TO STANDARD STEEL BEAM TRANSITION SECTION	04-23-2012
T-1	TRAFFIC CONTROL GENERAL NOTES	08-06-2012
T-10	CONVENTIONAL ROADS CONSTRUCTION APPROACH SIGNING	08-06-2012
T-17	TRAFFIC CONTROL MISCELLANEOUS DETAILS	08-06-2012
T-28	CONSTRUCTION SIGN DETAILS	08-06-2012
T-30	CONSTRUCTION SIGN DETAILS	08-06-2012
T-35	CONSTRUCTION ZONE LONGITUDINAL DROP-OFFS	08-06-2012
T-36	CONSTRUCTION ZONE LONGITUDINAL DROP-OFFS FOR PAVING	08-06-2012
T-40	DELINEATORS AND MILEPOSTS	01-02-2013
T-42	BRIDGE NUMBER PLAQUE	04-09-2014
T-44	MILEMARKER DETAILS STATE AND TOWN HIGHWAYS	04-09-2014
T-45	SQUARE TUBE SIGN POST AND ANCHOR	01-02-2013

HYDROLOGIC DATA

Date: June 2014

DRAINAGE AREA : 1.0 sq. mi.
 CHARACTER OF TERRAIN : Hilly to mountainous, forested, rural
 STREAM CHARACTERISTICS : Steep, alluvial
 NATURE OF STREAMBED : Coarse gravel, cobbles, boulders

PEAK FLOW DATA

Q 2.33 =	60 cfs	Q 50 =	240 cfs
Q 10 =	140 cfs	Q 100 =	290 cfs
Q 25 =	200 cfs	Q 500 =	410 cfs

DATE OF FLOOD OF RECORD : Unknown
 ESTIMATED DISCHARGE : Unknown
 WATER SURFACE ELEV. : Unknown
 NATURAL STREAM VELOCITY : @ Q50= 17.7 fps
 ICE CONDITIONS : Moderate
 DEBRIS : Moderate
 DOES THE STREAM REACH MAXIMUM HIGHWATER ELEV. RAPIDLY? Yes
 IS ORDINARY RISE RAPID? Yes
 IS STAGE AFFECTED BY UPSTREAM OR DOWNSTREAM CONDITIONS? No
 IF YES, DESCRIBE: _____

WATERSHED STORAGE: <1% HEADWATERS: _____
 UNIFORM: X
 IMMEDIATELY ABOVE SITE: _____

EXISTING STRUCTURE INFORMATION

STRUCTURE TYPE: Single span rolled beam bridge
 YEAR BUILT: 1919, Reconstructed in 1981
 CLEAR SPAN(NORMAL TO STREAM): 34'
 VERTICAL CLEARANCE ABOVE STREAMBED: -5'
 WATERWAY OF FULL OPENING: 92 sq. ft.
 DISPOSITION OF STRUCTURE: Replace
 TYPE OF MATERIAL UNDER SUBSTRUCTURE: See borings

WATER SURFACE ELEVATIONS AT:

Q2.33 =	718.8'	VELOCITY =	9.9 fps
Q10 =	719.5'	"	12.4 fps
Q25 =	719.9'	"	13.4 fps
Q50 =	720.2'	"	13.9 fps
Q100 =	720.5'	"	14.5 fps

LONG TERM STREAMBED CHANGES: None noted

IS THE ROADWAY OVERTOPPED BELOW Q100: No
 FREQUENCY: N/A
 RELIEF ELEVATION: 725.1'
 DISCHARGE OVER ROAD @Q100: N/A

UPSTREAM STRUCTURE

TOWN: Middlesex DISTANCE: 2250'
 HIGHWAY #: TH 23 STRUCTURE #: _____
 CLEAR SPAN: _____ CLEAR HEIGHT: _____
 YEAR BUILT: _____ FULL WATERWAY: _____
 STRUCTURE TYPE: 8' x 6' CMPA


DOWNSTREAM STRUCTURE

TOWN: Middlesex DISTANCE: 700'
 HIGHWAY #: _____ STRUCTURE #: _____
 CLEAR SPAN: _____ CLEAR HEIGHT: _____
 YEAR BUILT: _____ FULL WATERWAY: _____
 STRUCTURE TYPE: Wrightsville Reservoir

LRFR LOAD RATING FACTORS

LOADING LEVELS	TRUCK						
	H-20	HL-93	3S2	6 AXLE	3A STR.	4A STR.	5A SEM
TONNAGE	20	36	36	66	30	34.5	38
INVENTORY	1.98	1.19					
POSTING							
OPERATING	2.58	1.55	2.73	1.43	1.9	1.73	2.18
COMMENTS:							

AS BUILT "REBAR" DETAIL		
LEVEL I	LEVEL II	LEVEL III
TYPE: _____	TYPE: _____	TYPE: _____
GRADE: _____	GRADE: _____	GRADE: _____

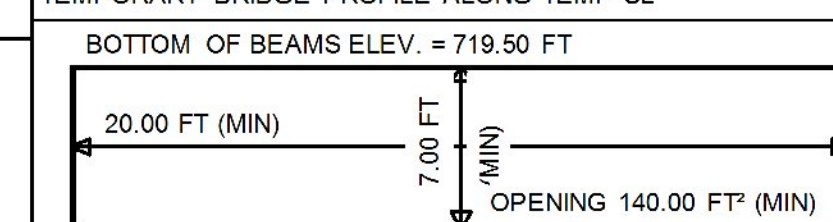

TRAFFIC DATA

YEAR	ADT	DHV	% D	% T	ADTT
2016	3400	420	59	4.4	170
2036	3700	450	59	6.7	280

20 year ESAL for flexible pavement from 2016 to 2036 : 605000
 40 year ESAL for flexible pavement from 2016 to 2056 : 1428000
 Design Speed : 50 mph

PROPOSED STRUCTURE

STRUCTURE TYPE: Single Span Rolled Beam Bridge
 CLEAR SPAN(NORMAL TO STREAM): 44'
 VERTICAL CLEARANCE ABOVE STREAMBED: ~7'
 WATERWAY OF FULL OPENING: 175 sq. ft.

WATER SURFACE ELEVATIONS AT:

Q2.33 =	718.8'	VELOCITY=	9.5 fps
Q10 =	719.5'	"	12.1 fps
Q25 =	720.0'	"	13.1 fps
Q50 =	720.2'	"	13.5 fps
Q100 =	720.5'	"	14.0 fps

IS THE ROADWAY OVERTOPPED BELOW Q100: No
 FREQUENCY: N/A
 RELIEF ELEVATION: 726.6'
 DISCHARGE OVER ROAD @Q100: N/A

AVERAGE LOW ELEVATION OF SUPERSTRUCTURE: 723.4'
 VERTICAL CLEARANCE: @ Q50 = 3.2'

SCOUR: 1' contraction scour at Q100 and Q500

REQUIRED CHANNEL PROTECTION: Stone Fill, Type IV

PERMIT INFORMATION

AVERAGE DAILY FLOW: 2 cfs DEPTH OR ELEVATION: _____
 ORDINARY LOW WATER: 1 cfs <0.5'
 ORDINARY HIGH WATER: 30 cfs 1'

TEMPORARY BRIDGE REQUIREMENTS

STRUCTURE TYPE: Steel Beam
 CLEAR SPAN (NORMAL TO STREAM): 20'
 VERTICAL CLEARANCE ABOVE STREAMBED: El. 719.5' minimum
 WATERWAY AREA OF FULL OPENING: ~140 sq. ft.

ADDITIONAL INFORMATION

TRAFFIC MAINTENANCE NOTES

1. MAINTAIN TWO-WAY TRAFFIC ON A TEMPORARY BRIDGE.
2. TRAFFIC SIGNALS ARE NOT NECESSARY.
3. SIDEWALKS ARE NOT REQUIRED.
4. THE APPROACHES FOR THE TEMPORARY BRIDGE SHALL BE PAVED.

DESIGN VALUES



1. DESIGN LIVE LOAD	HL-93
2. FUTURE PAVEMENT	<u>---</u>
3. DESIGN SPAN	<u>L: 45.00 FT</u>
4. MIN. MID-SPAN POS. CAMBER @ RELEASE (PRESTRESSED UNITS)	<u>Δ: ---</u>
5. PRESTRESSING STRAND	<u>f_y: ---</u>
6. PRESTRESSED CONCRETE STRENGTH	<u>f'_c: ---</u>
7. PRESTRESSED CONCRETE RELEASE STRENGTH	<u>f'_{cr}: ---</u>
8. CONCRETE, HIGH PERFORMANCE CLASS AA	<u>f'_c: ---</u>
9. CONCRETE, HIGH PERFORMANCE CLASS A	<u>f'_c: 4.0 KSI</u>
10. CONCRETE, HIGH PERFORMANCE CLASS B	<u>f'_c: 3.5 KSI</u>
11. CONCRETE, CLASS C	<u>f'_c: ---</u>
12. REINFORCING STEEL	<u>f_y: 60 KSI</u>
13. STRUCTURAL STEEL AASHTO M270 (GALVANIZED)	<u>f_y: 50 KSI</u>
14. SOIL UNIT WEIGHT	<u>γ: 0.140 KCF</u>
15. NOMINAL BEARING RESISTANCE OF SOIL	<u>q_n: 4.0 KSF</u>
16. SOIL BEARING RESISTANCE FACTOR (REFER TO AASHTO LRFD)	<u>φ: 0.45</u>
17. NOMINAL BEARING RESISTANCE OF ROCK	<u>q_n: ---</u>
18. ROCK BEARING RESISTANCE FACTOR (REFER TO AASHTO LRFD)	<u>φ: ---</u>
19. NOMINAL AXIAL PILE RESISTANCE	<u>q_p: 432.0 KIPS</u>
20. PILE YIELD STRENGTH ASTM A572	<u>f_y: 50 KSI</u>
21. PILE SIZE	<u>HP 12X 84</u>
22. EST. PILE LENGTH ABUTMENT # 1	<u>L_p: 30 FT</u>
23. EST. PILE LENGTH ABUTMENT # 2	<u>L_p: 55 FT</u>
24. PILE RESISTANCE FACTOR	<u>φ: 0.65</u>
25. LATERAL PILE DEFLECTION	<u>Δ: ---</u>
26. BASIC WIND SPEED	<u>V_{3s}: ---</u>
27. MINIMUM GROUND SNOW LOAD	<u>p_g: ---</u>
28. SEISMIC DATA	<u>PGA: 15 %g</u>
	<u>S_s: ---</u>
	<u>S₁: ---</u>

PROJECT NAME: **MIDDLESEX**


PROJECT NUMBER: **BRF 024-1(37)**

FILE NAME: 10c220pl.dgn PLOT DATE: 2/6/2015
 PROJECT LEADER: C. CARLSON DRAWN BY: C. BURRALL
 DESIGNED BY: H. SALLS CHECKED BY: H. SALLS
 PRELIMINARY INFORMATION SHEET 2 OF 46


MATERIAL TOLERANCES (IF USED ON PROJECT)	
SURFACE	
- PAVEMENT (TOTAL THICKNESS)	+/- 1/4"
- AGGREGATE SURFACE COURSE	+/- 1/2"
SUBBASE	
	+/- 1"
SAND BORROW	
	+/- 1"

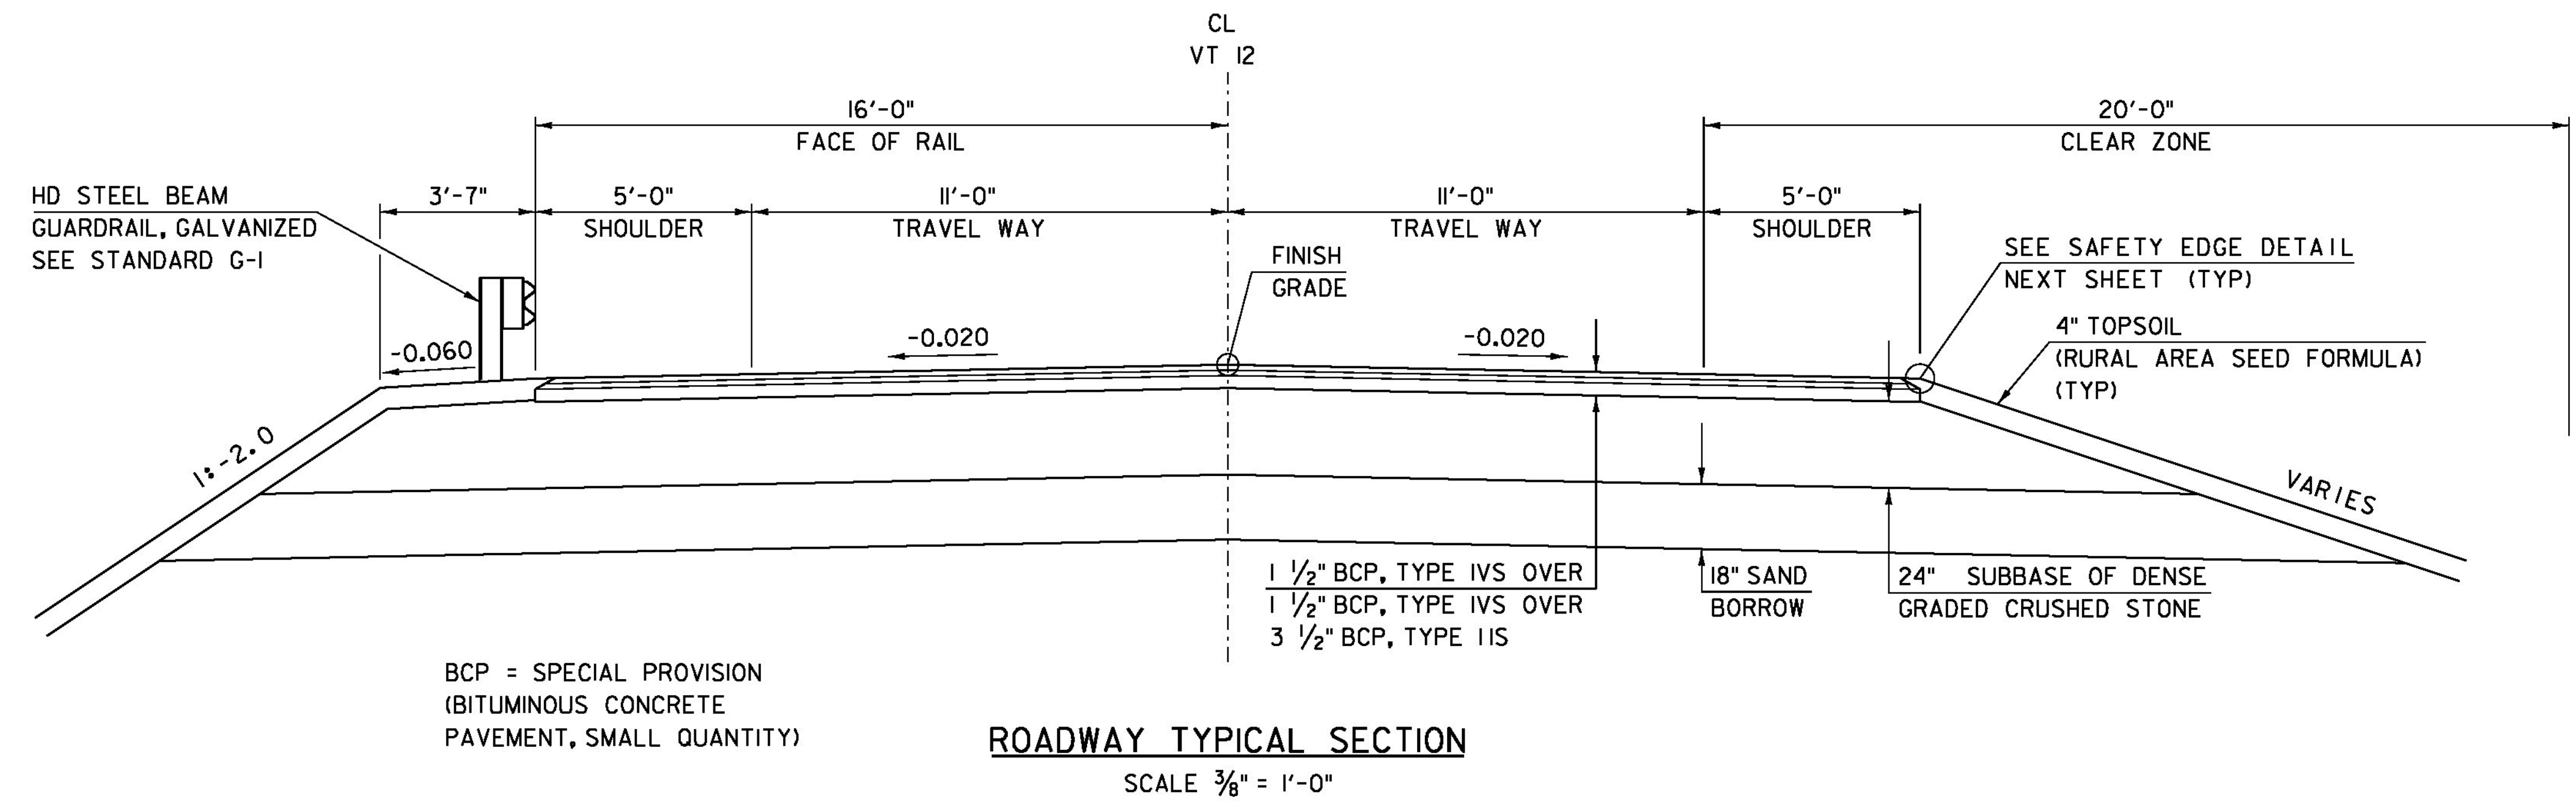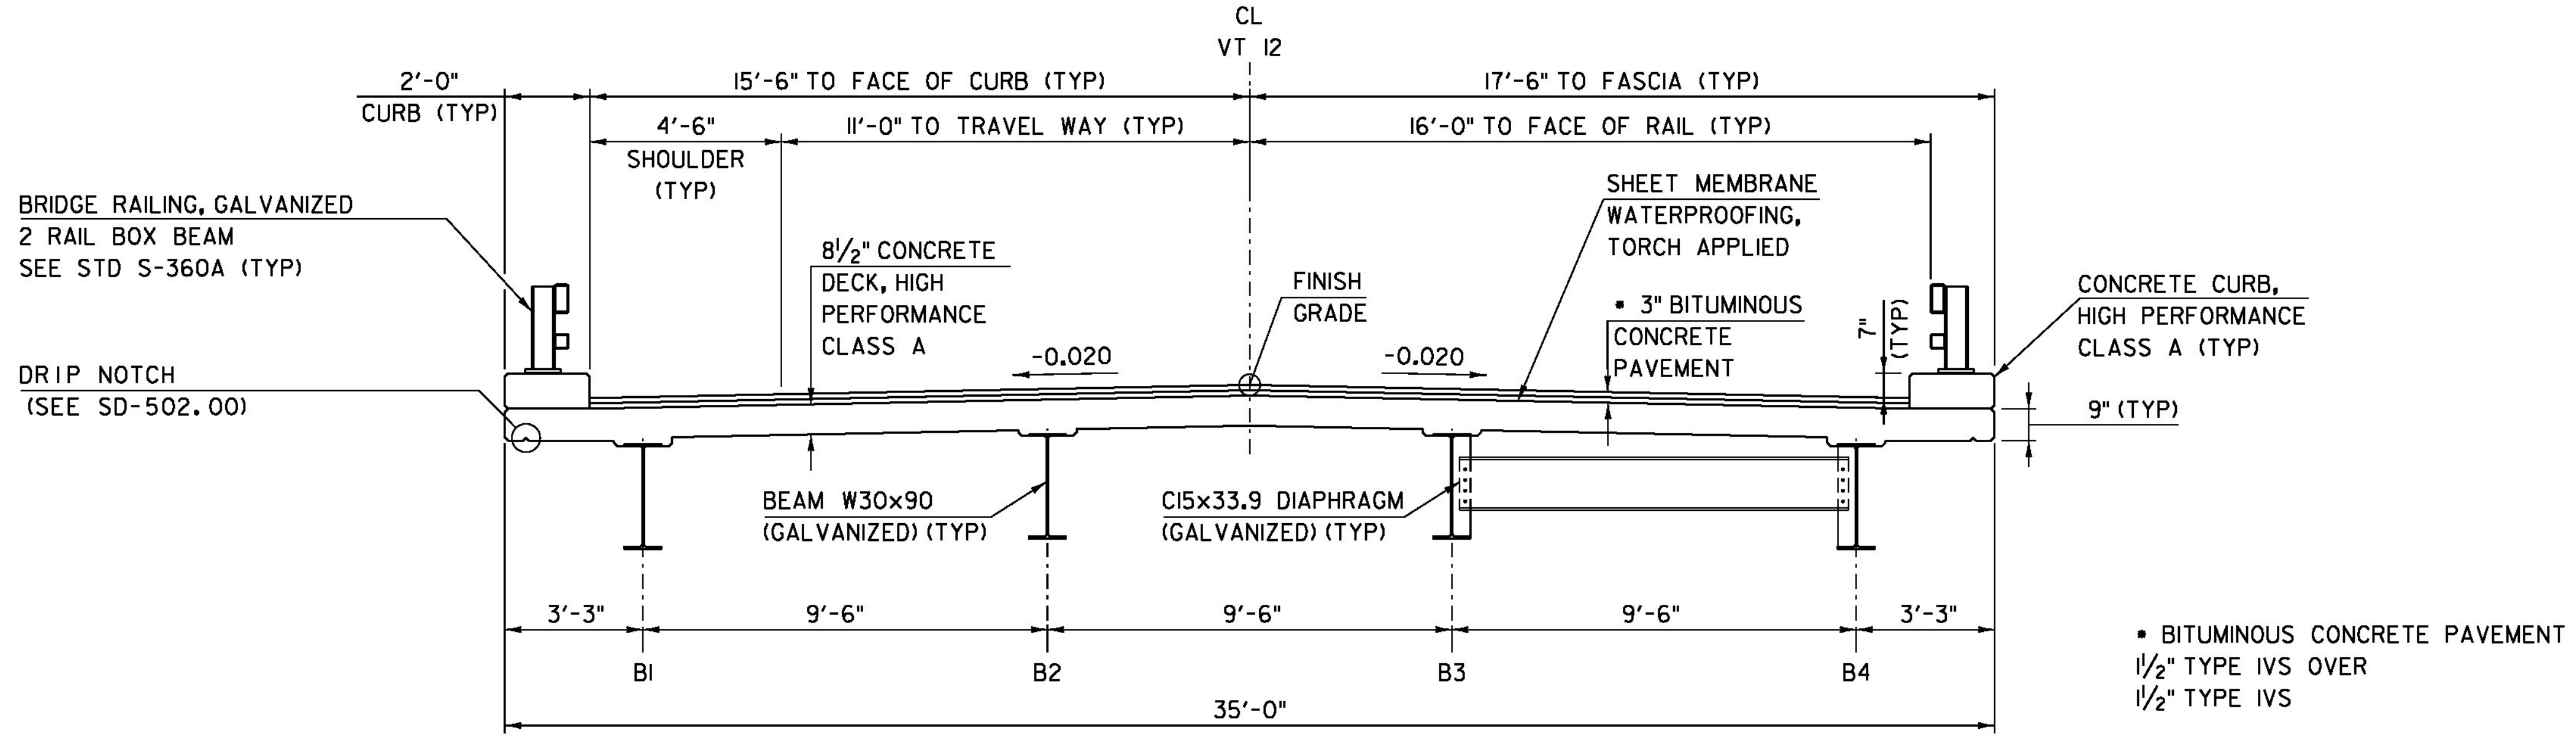

PROJECT NAME: MIDDLESEX	PLOT DATE: 02-FEB-2015
PROJECT NUMBER: BRF 024-1(37)	DRAWN BY: R. PELLETT
FILE NAME: s10c220typ.dgn	CHECKED BY: H. SALLS
PROJECT LEADER: C. CARLSON	SHEET 3 OF 46
DESIGNED BY: H. SALLS	TYPICAL SECTIONS 1

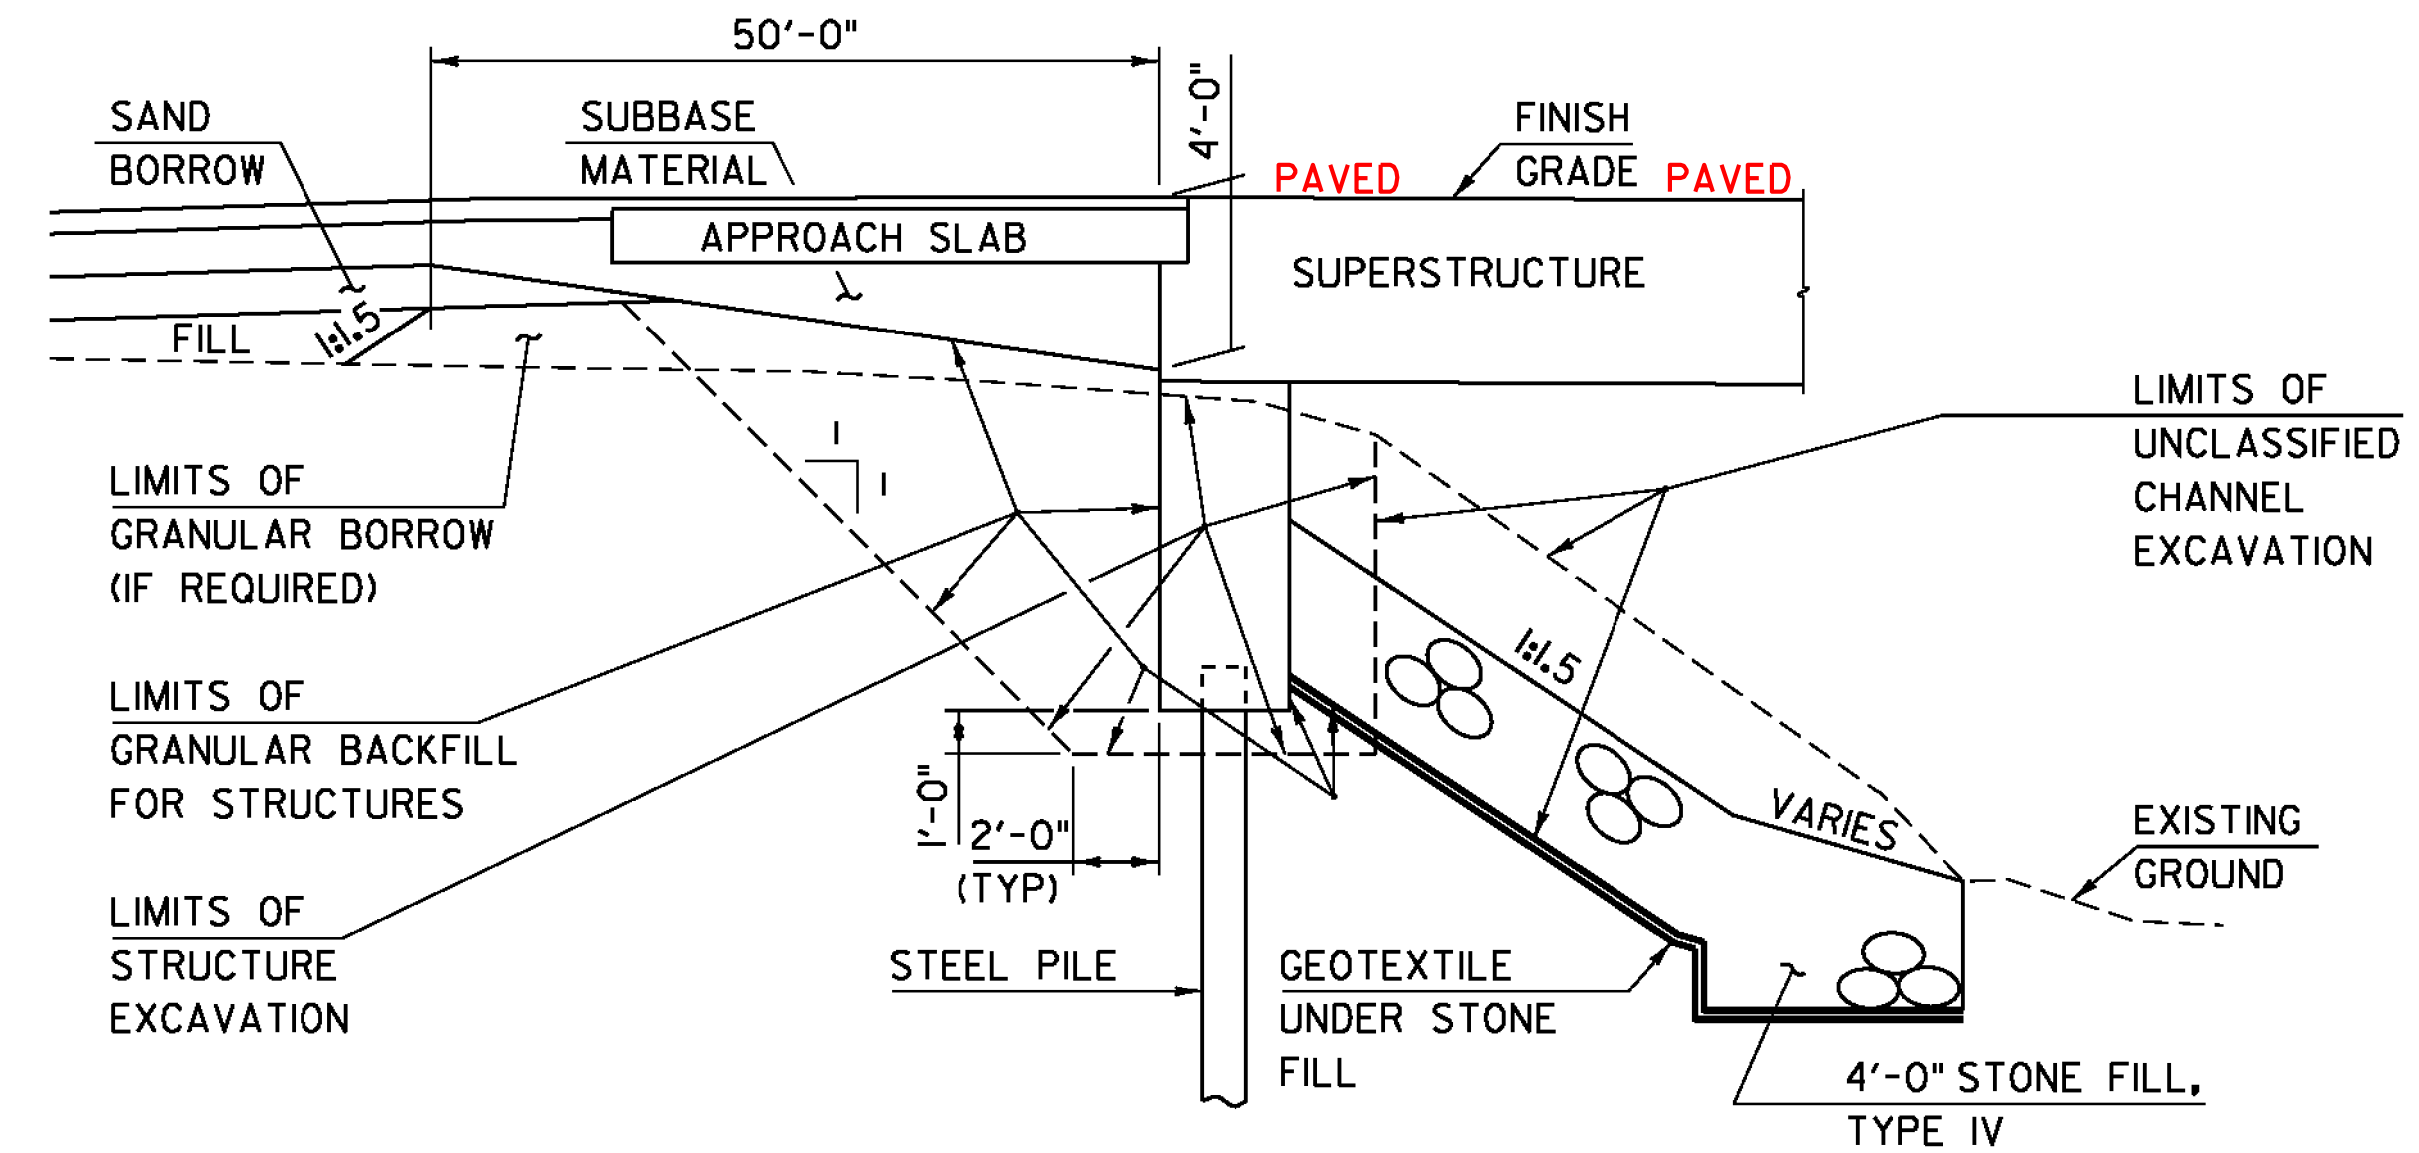


ABUTMENT EARTHWORK TYPICAL SECTION
NOT TO SCALE

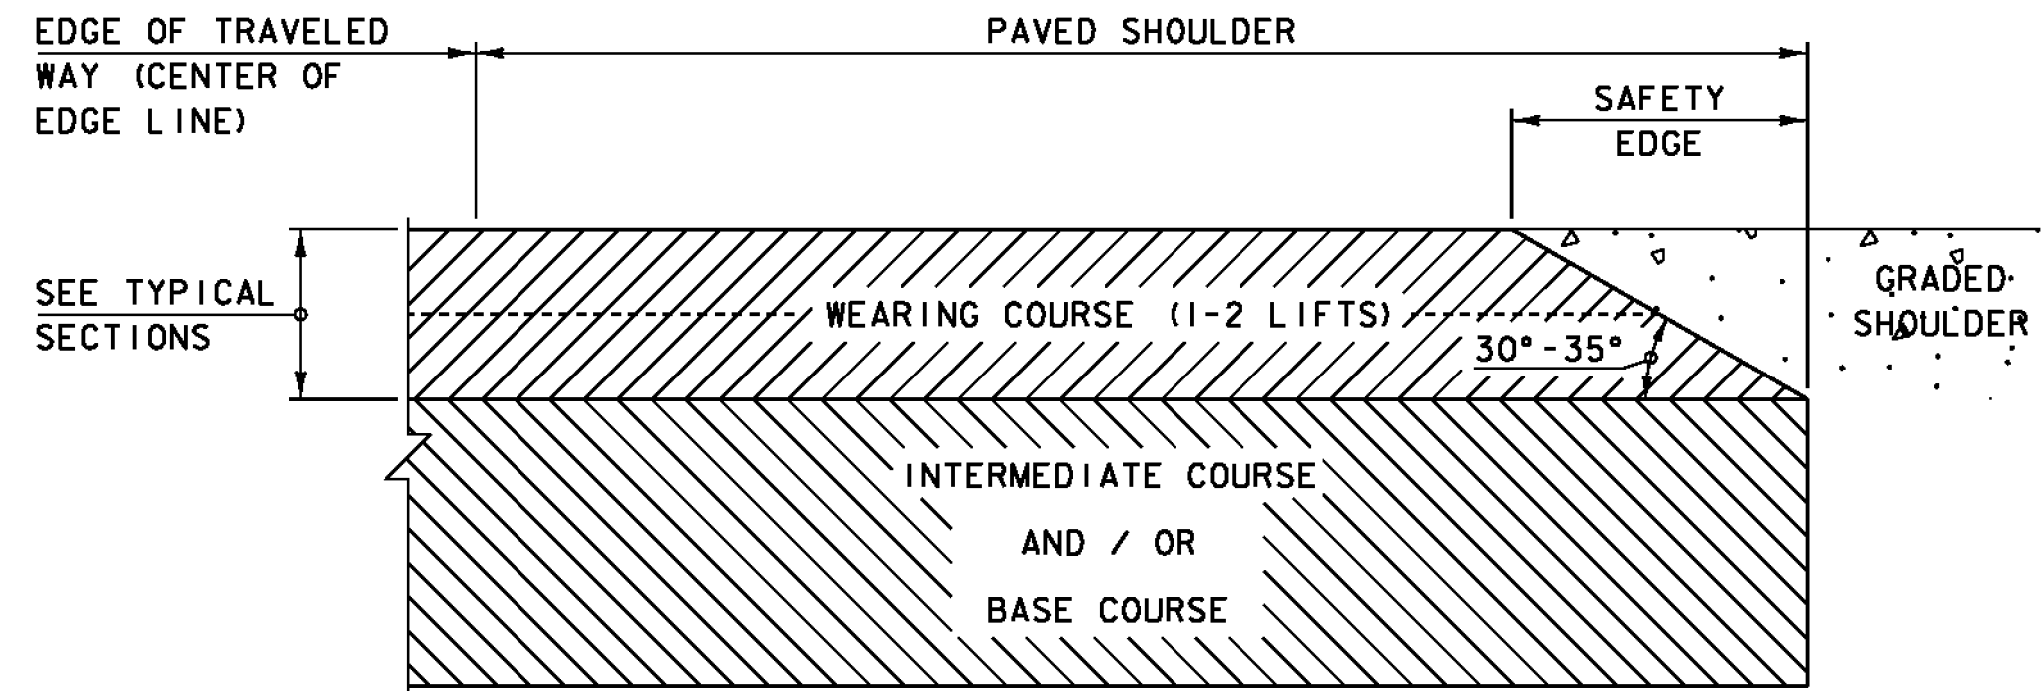

SAFETY EDGE DETAIL
NOT TO SCALE

1. THE EDGE OF PAVEMENT SHALL BE FORMED IN SUCH A WAY THAT THE BITUMINOUS CONCRETE PAVEMENT IS EXTRUDED OR COMPRESSED TO FORM THE 30 TO 35 DEGREE ANGLE. DEVICES THAT SIMPLY STRIKE-OFF THE MIX WITHOUT PROVIDING ANY COMPACTION EFFORT WILL NOT BE ALLOWED.
2. THE PAVED SHOULDER EXTENDS FROM THE EDGE OF TRAVELED WAY TO THE EDGE OF THE WEARING COURSE, INCLUDING THE "SAFETY EDGE".

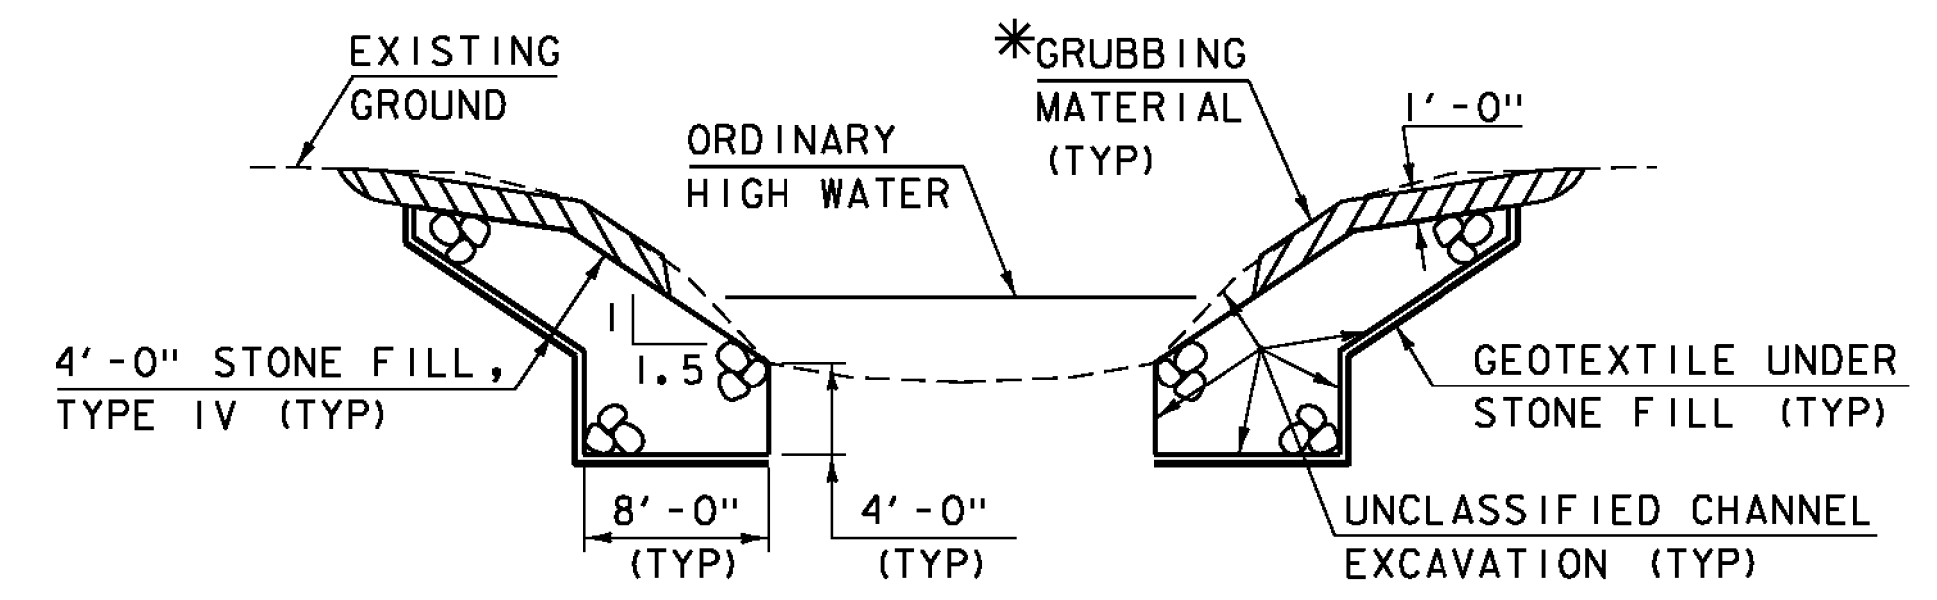

TYPICAL CHANNEL SECTION
NOT TO SCALE

*WHENEVER CHANNEL SLOPE INTERSECTS ROADWAY SUBBASE, GRUBBING MATERIAL SHALL BEGIN AT THE BOTTOM OF SUBBASE.

PROJECT NAME:	MIDDLESEX
PROJECT NUMBER:	BRF 024-1(37)
FILE NAME:	s10c220+typ.dgn
PROJECT LEADER:	C. CARLSON
DESIGNED BY:	H. SALLS
TYPICAL SECTIONS 2	
PLOT DATE:	02-FEB-2015
DRAWN BY:	R. PELLETT
CHECKED BY:	H. SALLS
SHEET	4 OF 46

GENERAL

1. ALL MATERIALS AND CONSTRUCTION SHALL CONFORM TO THE VERMONT AGENCY OF TRANSPORTATION 2011 STANDARD SPECIFICATIONS FOR CONSTRUCTION, THE 2012 AASHTO LRFD BRIDGE DESIGN SPECIFICATIONS, AND THEIR LATEST REVISIONS.
2. THE BRIDGE IS DESIGNED FOR HL-93 LIVE LOADING.
3. ALL DIMENSIONS ARE HORIZONTAL OR VERTICAL, AND ARE GIVEN AT 68 DEGREES FAHRENHEIT, UNLESS NOTED OTHERWISE.
4. ITEM 653.50 "BARRIER FENCE" SHALL BE USED TO ESTABLISH A BARRIER AROUND HISTORIC FLOOD PLAQUE AND BOULDER LOCATED AT STA 27+19.87 OFFSET 29.88 FEET RIGHT FROM THE VT12 MAINLINE.
5. THE EXISTING STRUCTURAL STEEL IS PAINTED WITH A MATERIAL THAT MAY CONTAIN LEAD. THE CONTRACTOR SHALL FOLLOW ALL APPLICABLE REGULATIONS WHEN HANDLING AND WORKING WITH THIS STEEL. THE REMOVED STRUCTURAL STEEL IS THE PROPERTY OF THE CONTRACTOR. THE CONTRACTOR SHALL INDEMNIFY AND HOLD THE STATE, ITS OFFICERS, AND EMPLOYEES HARMLESS CONCERNING THE CONTRACTOR'S USE OR DISPOSITION OF THE REMOVED EXISTING STRUCTURAL STEEL.
6. DUE TO STABILITY CONCERNS AT THE ABUTMENTS DURING THE ERECTION OF THE SUPERSTRUCTURE, THE CONTRACTOR SHALL SUBMIT THE ERECTION PLAN A MINIMUM OF 30 WORKING DAYS PRIOR TO ERECTING THE SUPERSTRUCTURE.

EARTHWORK

7. REMOVAL OF THE EXISTING STRUCTURE SHALL BE PAID UNDER ITEM 529.15, "REMOVAL OF STRUCTURE". THIS WORK SHALL INCLUDE REMOVAL OF ANY PORTIONS OF THE EXISTING STRUCTURE THAT FALL OUTSIDE THE LIMITS OF ANY OF THE EXCAVATION ITEMS.
8. EXCAVATION OF SOILS TO THE LIMITS SHOWN ON THE TYPICAL ABUTMENT SECTION SHALL BE PAID FOR UNDER ITEM 204.25, "STRUCTURE EXCAVATION" AND ITEM 203.27, "UNCLASSIFIED CHANNEL EXCAVATION". ANY EXCAVATION OUTSIDE THESE LIMITS, WHICH IS NOT REMOVAL OF STRUCTURE, WILL BE AT THE CONTRACTOR'S EXPENSE.
9. "STONE FILL, TYPE IV" UNDER THE BRIDGE AS SHOWN IN THE PLANS SHALL BE PLACED BEFORE THE SUPERSTRUCTURE IS SET.
10. BACKFILL BEHIND THE ABUTMENTS SHALL NOT BE PLACED HIGHER THAN THE BRIDGE SEATS UNTIL THE ABUTMENTS AND DECK CONSTRUCTION ARE COMPLETED. THE DIFFERENCE IN ELEVATION OF FILL BEHIND THE ABUTMENTS AT ANY TIME DURING BACKFILLING OPERATIONS SHALL NOT EXCEED 2 FEET.
11. THE AREA DISTURBED BY THE TWO-WAY TEMPORARY BRIDGE SHALL BE SEEDED AND MULCHED AFTER ALL THE FILL IS REMOVED TO THE ORIGINAL GROUND SURFACE. THE COST OF THE SEED, FERTILIZER, ETC. WILL BE PAID FOR UNDER THEIR RESPECTIVE BID ITEMS.

CONCRETE AND REINFORCING STEEL

12. ALL EXPOSED EDGES OF CONCRETE SHALL BE CHAMFERED 1 INCH BY 1 INCH, UNLESS OTHERWISE NOTED.
13. JOINTS AND SCORE MARKS IN CONCRETE SHALL BE CONSTRUCTED AS INDICATED ON THE PLANS OR AS DIRECTED BY THE ENGINEER.
14. ITEM 501.33, "HIGH PERFORMANCE CONCRETE, CLASS A" SHALL BE USED FOR THE DECK, CURBS AND INTEGRAL ABUTMENT CURTAIN WALL AND WING WALLS ABOVE THE PILE CAP CONSTRUCTION JOINT.
15. ITEM 501.34, "HIGH PERFORMANCE CONCRETE, CLASS B" SHALL BE USED FOR APPROACH SLABS AND ALL SUBSTRUCTURE BELOW THE PILE CAP CONSTRUCTION JOINT.
16. ITEM 514.10, "WATER REPELLENT, SILANE", SHALL BE APPLIED TO ALL EXPOSED CONCRETE ON THE BRIDGE SUPERSTRUCTURE, INCLUDING THE CURBS, AND SUBSTRUCTURE, WITH THE EXCEPTION OF THE BOTTOM OF THE DECK BETWEEN THE DRIP NOTCHES.
17. THE TOP SURFACE OF THE PILE CAP SHALL BE GIVEN A FLOAT FINISH TO GRADE. THE CONCRETE WITHIN THE REINFORCING CAGE SHALL BE ROUGHENED BY RAKING PARALLEL TO THE FACE OF THE ABUTMENT TO AN AMPLITUDE OF 1/2 INCH. THE CONCRETE OUTSIDE THE REINFORCING CAGE SHALL REMAIN SMOOTH.
18. ALL REINFORCING STEEL IN THE DECK, CURBS, AND SUBSTRUCTURE ABOVE THE PILE CAP CONSTRUCTION JOINT, INCLUDING WINGWALLS, SHALL MEET THE REQUIREMENTS FOR LEVEL II CORROSION RESISTANCE IN ACCORDANCE WITH SECTION 507. ALL OTHER REINFORCING STEEL SHALL MEET THE REQUIREMENTS FOR LEVEL I CORROSION RESISTANCE. PAYMENT WILL BE MADE UNDER THE APPROPRIATE SECTION 507 CONTRACT ITEM.
19. REINFORCING STEEL PLACEMENT TOLERANCES SHALL BE:
SPACING: +/- 1 INCH
CLEARANCE: +/- 1/4 INCH

STRUCTURAL STEEL

20. ALL NEW STRUCTURAL STEEL SHALL CONFORM TO AASHTO M 270/M 270, GRADE 50 AND SHALL BE PAID FOR UNDER ITEM 506.50 "STRUCTURAL STEEL, ROLLED BEAM (GALVANIZED)".
21. STRUCTURAL STEEL MEMBERS DESIGNATED "CVN" IN THE PLANS SHALL BE CHARPY V-NOTCH TESTED IN ACCORDANCE WITH SUBSECTION 714.01 OF THE STANDARD SPECIFICATIONS.
22. ALL WELDING SHALL CONFORM TO THE PROVISIONS OF SUBSECTION 506.10.
23. BEAM WEBS AND DIAPHRAGMS SHALL BE PLUMB IN FINAL POSITION.
24. CONNECTIONS NOT SHOWN IN THE PLANS SHALL BE DETAILED BY THE FABRICATOR IN THE FABRICATION DRAWINGS.
25. ALL STRUCTURAL STEEL SHALL BE GALVANIZED IN ACCORDANCE WITH SUBSECTION 726.08.
26. AFTER THE SUPERSTRUCTURE STEEL HAS BEEN ERECTED, ELEVATIONS ALONG THE TOP OF BEAMS SHALL BE TAKEN FOR USE IN DETERMINING THE FINAL GRADE AND HAUNCH DEPTHS.
27. FLEMING BRACKETS OR SIMILAR FALSE WORK, AS REQUIRED BY DESIGN, SHALL HAVE A MAXIMUM SPACING OF 4'-0". THE BRACKETS SHALL BEAR NEAR THE BOTTOM FLANGE AND IN NO CASE SHALL THEY BEAR ABOVE THE BOTTOM QUARTER OF THE WEB. THE DESIGN OF FALSEWORK SHALL BE THE RESPONSIBILITY OF THE CONTRACTOR.
28. FILL ANY BOLT HOLES IN THE WEBS OF THE BEAMS NOT OTHERWISE FILLED WITH BUTTON HEAD OR HEX HEAD BOLTS MEETING AASHTO M164 TYPE I. TIGHTEN THE BOLTS IN ACCORDANCE WITH SUBSECTION 506.19.

H-PILES

29. TO PREVENT DAMAGE TO THE PILES, PILE SHOES ARE REQUIRED AND SHALL CONFORM TO SUBSECTION 505.04 (f).
30. A MINIMUM OF ONE DYNAMIC PILE TEST, ITEM 505.45 "DYNAMIC PILE LOADING TEST", SHALL BE CONDUCTED PER ABUTMENT. THE NOMINAL PILE DRIVING RESISTANCE FOR EACH PILE IS 432 KIPS. A PILE RESISTANCE FACTOR OF 0.65 WAS USED BASED ON THE DYNAMIC TESTING REQUIREMENT.
31. THE TOPS OF THE PILES AFTER DRIVING SHALL NOT VARY FROM THE POSITION SHOWN ON THE PLANS BY MORE THAN 3 INCHES. THE PILE ORIENTATION SHALL NOT VARY BY MORE THAN 5 DEGREES. THE CONTRACTOR SHALL DEMONSTRATE TO THE SATISFACTION OF THE ENGINEER HOW THE TOLERANCES WILL BE MET. THESE MEASURES SHALL BE DEMONSTRATED IN A SUBMITTAL TO BE ACCEPTED BEFORE PILE DRIVING COMMENCES.
32. FOR ESTIMATING PURPOSES, THE PILE TIP ELEVATIONS WERE ASSUMED AND ARE SHOWN ON THE BORING LOGS. THE ACTUAL IN PLACE LENGTHS MAY VARY. PILES SHALL HAVE A MINIMUM EMBEDMENT OF 30 FT MEASURED FROM THE BOTTOM OF THE PILE CAP OR BE DRIVEN TO BEDROCK.
33. THE DAM SAFETY ENGINEER OF THE AGENCY OF NATURAL RESOURCES SHALL BE NOTIFIED AT LEAST 5 DAYS PRIOR TO ANY PILE DRIVING ACTIVITY.
STEVE BUSHMAN: SECTION CHIEF- DAM SAFETY ENGINEER
(802)-490-6229

TRAFFIC CONTROL

34. TRAFFIC SHALL BE MAINTAINED ON A TWO-WAY TEMPORARY BRIDGE PLACED DOWNSTREAM OF THE EXISTING BRIDGE.
35. THE TEMPORARY BRIDGE APPROACHES SHALL BE PAVED.
36. FULL ACCESS TO ALL SIDE ROADS AND DRIVES WITHIN THE PROJECT LIMITS SHALL BE MAINTAINED AT ALL TIMES. THIS WORK SHALL BE CONSIDERED INCIDENTAL TO ITEM 641.10 "TRAFFIC CONTROL."
37. ALL SIGNING SHALL BE IN ACCORDANCE WITH THE LATEST EDITION OF THE MUTCD. WHERE CONFLICTS EXIST BETWEEN THE MUTCD AND THE PLANS, THE MUTCD SHALL GOVERN. FOR ADDITIONAL SIGNING DETAILS AND REQUIREMENTS SEE THE T SERIES OF THE CONTRACT STANDARD DRAWINGS.

PROJECT NAME: MIDDLESEX
PROJECT NUMBER: BRF 024-1(37)

FILE NAME: sl0c220gen.dgn	PLOT DATE: 06-FEB-2015
PROJECT LEADER: C. CARLSON	DRAWN BY: C. BURRALL
DESIGNED BY: H. SALLS	CHECKED BY: H. SALLS
PROJECT NOTES	SHEET 5 OF 46

QUANTITY SHEET 1

SUMMARY OF ESTIMATED QUANTITIES										TOTALS		DESCRIPTIONS				DETAILED SUMMARY OF QUANTITIES			
							ROADWAY	EROSION CONTROL	BRIDGE	FULL C.E. ITEMS	GRAND TOTAL	FINAL	UNIT	ITEMS	ITEM NUMBER	ROUND	QUANTITIES	UNIT	ITEMS
							1				1		LS	CLEARING AND GRUBBING, INCLUDING INDIVIDUAL TREES AND STUMPS	201.10				
							1580				1580		CY	COMMON EXCAVATION	203.15				
									250		250		CY	UNCLASSIFIED CHANNEL EXCAVATION	203.27				
							600				600		CY	SAND BORROW	203.31				
							1				1		CY	TRENCH EXCAVATION OF EARTH, EXPLORATORY (N.A.B.I.)	204.22				
									580		580		CY	STRUCTURE EXCAVATION	204.25				
									380		380		CY	GRANULAR BACKFILL FOR STRUCTURES	204.30				
							530				530		SY	COLD PLANING, BITUMINOUS PAVEMENT	210.10				
							1070				1070		CY	SUBBASE OF DENSE GRADED CRUSHED STONE	301.35				
							20				20		CY	AGGREGATE SURFACE COURSE	401.10				
							9				9		CWT	EMULSIFIED ASPHALT	404.65				
							1				1		LU	PRICE ADJUSTMENT, ASPHALT CEMENT (N.A.B.I.)	406.50				
									94		94		CY	CONCRETE, HIGH PERFORMANCE CLASS A	501.33				
									119		119		CY	CONCRETE, HIGH PERFORMANCE CLASS B	501.34				
									1		1		LS	FURNISHING EQUIPMENT FOR DRIVING PILING	504.10				
									340		340		LF	STEEL PILING, HP 12 X 84	505.165				
									2		2		EACH	DYNAMIC PILE LOADING TEST	505.45				
									21800		21800		LB	STRUCTURAL STEEL, ROLLED BEAM (GALVANIZED)	506.50				
									12951		12951		LB	REINFORCING STEEL, LEVEL I	507.11				
									20943		20943		LB	REINFORCING STEEL, LEVEL II	507.12				
									1		1		LS	SHEAR CONNECTORS (352 - 7/8" X 7")	508.15				
									19		19		GAL	WATER REPELLENT, SILANE	514.10				
									68		68		LF	BRIDGE EXPANSION JOINT, ASPHALTIC PLUG	516.10				
									162		162		SY	SHEET MEMBRANE WATERPROOFING, TORCH APPLIED	519.20				
									68		68		LF	JOINT SEALER, HOT POURED	524.11				
									94		94		LF	BRIDGE RAILING, GALVANIZED 2 RAIL BOX BEAM	525.33				
							1				1		LS	TWO-WAY TEMPORARY BRIDGE (480 SF - EST.)	528.11				
									1		1		EACH	REMOVAL OF STRUCTURE (1408 SF - EST.)	529.15				
									8		8		EACH	BEARING DEVICE ASSEMBLY, STEEL REINFORCED ELASTOMERIC PAD	531.17				
							1				1		TON	DUST AND ICE CONTROL WITH CALCIUM CHLORIDE	609.15				
									230		230		CY	STONE FILL, TYPE IV	613.13				
							160				160		LF	CAST-IN-PLACE CONCRETE CURB, TYPE B	616.28				
							66				66		LF	HD STEEL BEAM GUARDRAIL, GALVANIZED	621.21				
							3				3		EACH	MANUFACTURED TERMINAL SECTION, FLARED	621.50				
							1				1		EACH	ANCHOR FOR STEEL BEAM RAIL	621.60				
							4				4		EACH	GUARDRAIL APPROACH SECTION, GALVANIZED 2 RAIL BOX BEAM	621.72				
							245				245		LF	REMOVAL AND DISPOSAL OF GUARDRAIL	621.80				
							100				100		HR	UNIFORMED TRAFFIC OFFICERS	630.10				
							800				800		HR	FLAGGERS	630.15				
										1	1		LS	FIELD OFFICE, ENGINEERS	631.10				

PROJECT NAME: MIDDLESEX
PROJECT NUMBER: BRF 024-1(37)
FILE NAME: sl0c220qs.dgn
PROJECT LEADER: C. CARLSON
DESIGNED BY: H. SALLS
QUANTITY SHEET 1
PLOT DATE: 13-JAN-2015
DRAWN BY: C. BURRALL
CHECKED BY: H. SALLS
SHEET 6 OF 46

QUANTITY SHEET 2

SUMMARY OF ESTIMATED QUANTITIES										TOTALS		DESCRIPTIONS				DETAILED SUMMARY OF QUANTITIES			
							ROADWAY	EROSION CONTROL	BRIDGE	FULL C.E. ITEMS	GRAND TOTAL	FINAL	UNIT	ITEMS	ITEM NUMBER	ROUND	QUANTITIES	UNIT	ITEMS
										1	1		LS	TESTING EQUIPMENT, CONCRETE	631.16				
										1	1		LS	TESTING EQUIPMENT, BITUMINOUS	631.17				
										3000	3000		DL	FIELD OFFICE TELEPHONE (N.A.B.I.)	631.26				
							1				1		LS	MOBILIZATION/DEMobilIZATION	635.11				
							1				1		LS	TRAFFIC CONTROL	641.10				
							940				940		LF	4 INCH WHITE LINE	646.20				
							910				910		LF	4 INCH YELLOW LINE	646.21				
									210		210		SY	GEOTEXTILE UNDER STONE FILL	649.31				
								175			175		SY	GEOTEXTILE FOR SILT FENCE, WOVEN WIRE REINFORCED	649.515				
								84			84		SY	GEOTEXTILE FOR FILTER CURTAIN	649.61				
								40			40		LB	SEED	651.15				
								30			30		LB	SEED, WINTER RYE	651.17				
								200			200		LB	FERTILIZER	651.18				
								1			1		TON	AGRICULTURAL LIMESTONE	651.20				
								1			1		TON	HAY MULCH	651.25				
								210			210		CY	TOPSOIL	651.35				
								60			60		SY	GRUBBING MATERIAL	651.40				
								1			1		LS	EPSC PLAN	652.10				
								10			10		HR	MONITORING EPSC PLAN	652.20				
								1			1		LU	MAINTENANCE OF EPSC PLAN (N.A.B.I.)	652.30				
								1280			1280		SY	TEMPORARY EROSION MATTING	653.20				
								30			30		CY	VEHICLE TRACKING PAD	653.35				
								24			24		LF	BARRIER FENCE	653.50				
								950			950		LF	PROJECT DEMARCATION FENCE	653.55				
							22				22		SF	TRAFFIC SIGNS, TYPE A	675.20				
							50				50		LF	SQUARE TUBE SIGN POST AND ANCHOR	675.341				
							4				4		EACH	REMOVING SIGNS	675.50				
							1				1		LU	PRICE ADJUSTMENT, FUEL (N.A.B.I.)	690.50				
							7				7		EACH	SPECIAL PROVISION (CPM SCHEDULE)	900.620				
							1				1		LU	SPECIAL PROVISION (MAT DENSITY PAY ADJUSTMENT, SMALL QUANTITY)(N.A.B.I.)	900.650				
							1				1		LU	SPECIAL PROVISION (MIXTURE PAY ADJUSTMENT)(N.A.B.I.)	900.650				
							550				550		TON	SPECIAL PROVISION (BITUMINOUS CONCRETE PAVEMENT, SMALL QUANTITY)	900.680				

PROJECT NAME: MIDDLESEX
PROJECT NUMBER: BRP 024-1(37)

FILE NAME: sl0c220qs.dgn
PROJECT LEADER: C. CARLSON
DESIGNED BY: H. SALLS
QUANTITY SHEET 2

PLOT DATE: 13-JAN-2015
DRAWN BY: C. BURRALL
CHECKED BY: H. SALLS
SHEET 7 OF 46

BRIDGE QUANTITY SHEET 1

SUMMARY OF BRIDGE QUANTITIES										TOTALS		DESCRIPTIONS			DETAILED SUMMARY OF QUANTITIES		
					SUPERSTRUCTURE	APPROACH SLAB 1	APPROACH SLAB 2	ABUTMENT 1	ABUTMENT 2	BRIDGE TOTAL	UNIT	ITEMS	ITEM NUMBER	QUANTITIES	UNIT	ITEMS	
								108	142	250	CY	UNCLASSIFIED CHANNEL EXCAVATION	203.27				
								270	310	580	CY	STRUCTURE EXCAVATION	204.25				
								177	203	380	CY	GRANULAR BACKFILL FOR STRUCTURES	204.30				
					50			22	22	94	CY	CONCRETE, HIGH PERFORMANCE CLASS A	501.33				
						29.5	29.5	30	30	119	CY	CONCRETE, HIGH PERFORMANCE CLASS B	501.34				
								0.5	0.5	1	LS	FURNISHING EQUIPMENT FOR DRIVING PILING	504.10				
								120	220	340	LF	STEEL PILING, HP 12 X 84	505.165				
								1	1	2	EACH	DYNAMIC PILE LOADING TEST	505.45				
					21800					21800	LB	STRUCTURAL STEEL, ROLLED BEAM (GALVANIZED)	506.50				
						3661	3556	2890	2844	12951	LB	REINFORCING STEEL, LEVEL I	507.11				
					14839	137	130	2927	2910	20943	LB	REINFORCING STEEL, LEVEL II	507.12				
					1					1	LS	SHEAR CONNECTORS (352 - 7/8" X 7")	508.15				
					7			6	6	19	GAL	WATER REPELLENT, SILANE	514.10				
								34	34	68	LF	BRIDGE EXPANSION JOINT, ASPHALTIC PLUG	516.10				
								81	81	162	SY	SHEET MEMBRANE WATERPROOFING, TORCH APPLIED	519.20				
								34	34	68	LF	JOINT SEALER, HOT POURED	524.11				
					94					94	LF	BRIDGE RAILING, GALVANIZED 2 RAIL BOX BEAM	525.33				
					1					1	EACH	REMOVAL OF STRUCTURE (1408 SF - EST.)	529.15				
								4	4	8	EACH	BEARING DEVICE ASSEMBLY, STEEL REINFORCED ELASTOMERIC PAD	531.17				
								115	115	230	CY	STONE FILL, TYPE IV	613.13				
								107	103	210	SY	GEOTEXTILE UNDER STONE FILL	649.31				

PROJECT NAME:	MIDDLESEX	PLOT DATE:	13-JAN-2015
PROJECT NUMBER:	BRF 024-1(37)	DRAWN BY:	C. BURRALL
FILE NAME:	sl0c220qs.dgn	CHECKED BY:	H. SALLS
PROJECT LEADER:	C. CARLSON	SHEET	8 OF 46
DESIGNED BY:	H. SALLS	BRIDGE QUANTITY SHEET	

GENERAL INFORMATION

SYMBOLY LEGEND NOTE

THE SYMBOLY ON THIS SHEET IS INTENDED TO COVER STANDARD CONVENTIONAL SYMBOLY. THE SYMBOLY IS USED FOR EXISTING & PROPOSED FEATURES WITH HEAVIER LINEWEIGHT, IN COMBINATION WITH PROJECT ANNOTATION, AS NOTED ON PROJECT PLAN SHEETS. THIS LEGEND SHEET COVERS THE BASICS. SYMBOLY ON PLANS MAY VARY, PLAN ANNOTATIONS AND NOTES SHOULD BE USED TO CLARIFY AS NEEDED.

R. O. W. ABBREVIATIONS (CODES) & SYMBOLS

POINT CODE	DESCRIPTION
CH	CHANNEL EASEMENT
CONST	CONSTRUCTION EASEMENT
CUL	CULVERT EASEMENT
D&C	DISCONNECT & CONNECT
DIT	DITCH EASEMENT
DR	DRAINAGE EASEMENT
DRIVE	DRIVEWAY EASEMENT
EC	EROSION CONTROL
HWY	HIGHWAY EASEMENT
I&M	INSTALL & MAINTAIN EASEMENT
LAND	LANDSCAPE EASEMENT
R&RES	REMOVE & RESET
R&REP	REMOVE & REPLACE
SR	SLOPE RIGHT
UE	UTILITY EASEMENT
(P)	PERMANENT EASEMENT
(T)	TEMPORARY EASEMENT
■	BNDNS BOUND SET
▣	BNDNS BOUND TO BE SET
●	IPNS IRON PIN SET
⊙	IPNS IRON PIN TO BE SET
⊗	CALC EXISTING ROW POINT
○	PROW PROPOSED ROW POINT
[LENGTH]	LENGTH CARRIED ON NEXT SHEET

COMMON TOPOGRAPHIC POINT SYMBOLS

POINT CODE	DESCRIPTION
⊛	APL BOUND APPARENT LOCATION
○	BM BENCHMARK
□	BND BOUND
⊞	CB CATCH BASIN
⊕	COMB COMBINATION POLE
⊞	DITHR DROP INLET THROATED DNC
⊕	EL ELECTRIC POWER POLE
⊙	FPOLE FLAGPOLE
○	GASFIL GAS FILLER
○	GP GUIDE POST
⊗	GSO GAS SHUT OFF
⊙	GUY GUY POLE
⊙	GUYW GUY WIRE
⊗	GV GATE VALVE
⊕	H TREE HARDWOOD
△	HCTRL CONTROL HORIZONTAL
▲	HVCTRL CONTROL HORIZ. & VERTICAL
◇	HYD HYDRANT
⊙	IP IRON PIN
⊙	IPIPE IRON PIPE
⊕	LI LIGHT - STREET OR YARD
⊕	MB MAILBOX
○	MH MANHOLE (MH)
□	MM MILE MARKER
⊙	PM PARKING METER
□	PMK PROJECT MARKER
⊙	POST POST STONE/WOOD
⊕	RRSIG RAILROAD SIGNAL
⊕	RRSL RAILROAD SWITCH LEVER
⊕	S TREE SOFTWOOD
⊕	SAT SATELLITE DISH
⊕	SHRUB SHRUB
⊕	SIGN SIGN
⊕	STUMP STUMP
⊕	TEL TELEPHONE POLE
⊙	TIE TIE
⊕	TSIGN SIGN W/DOUBLE POST
⊕	VCTRL CONTROL VERTICAL
⊙	WELL WELL
⊗	WSO WATER SHUT OFF

THESE ARE COMMON VAOT SURVEY POINT SYMBOLS FOR EXISTING FEATURES, ALSO USED FOR PROPOSED FEATURES WITH HEAVIER LINEWEIGHT, IN COMBINATION WITH PROPOSED ANNOTATION.

PROPOSED GEOMETRY CODES

CODE	DESCRIPTION
PC	POINT OF CURVATURE
PI	POINT OF INTERSECTION
CC	CENTER OF CURVE
PT	POINT OF TANGENCY
PCC	POINT OF COMPOUND CURVE
PRC	POINT OF REVERSE CURVE
POB	POINT OF BEGINNING
POE	POINT OF ENDING
STA	STATION PREFIX
AH	AHEAD STATION SUFFIX
BK	BACK STATION SUFFIX
D	CURVE DEGREE OF (100FT)
R	CURVE RADUIS OF
T	CURVE TANGENT LENGTH
L	CURVE LENGTH OF
E	CURVE EXTERNAL DISTANCE

UTILITY SYMBOLY

UNDERGROUND UTILITIES

— UGU —	UTILITY (GENERIC-UNKNOWN)
— UT —	TELEPHONE
— UE —	ELECTRIC
— UC —	CABLE (TV)
— UEC —	ELECTRIC+CABLE
— UET —	ELECTRIC+TELEPHONE
— UCT —	CABLE+TELEPHONE
— UECT —	ELECTRIC+CABLE+TELEP.
— G —	GAS LINE
— W —	WATER LINE
— S —	SANITARY SEWER (SEPTIC)

ABOVE GROUND UTILITIES (AERIAL)

— AGU —	UTILITY (GENERIC-UNKNOWN)
— T —	TELEPHONE
— E —	ELECTRIC
— C —	CABLE (TV)
— EC —	ELECTRIC+CABLE
— ET —	ELECTRIC+TELEPHONE
— AER E&T —	ELECTRIC+TELEPHONE
— CT —	CABLE+TELEPHONE
— ECT —	ELECTRIC+CABLE+TELEP.
—	UTILITY POLE GUY WIRE

PROJECT CONSTRUCTION SYMBOLY

PROJECT DESIGN & LAYOUT SYMBOLY

— — — CZ — — —	CLEAR ZONE
— — — — —	PLAN LAYOUT MATCHLINE

PROJECT CONSTRUCTION FEATURES

▲ — — — — —	TOP OF CUT SLOPE
○ — — — — —	TOE OF FILL SLOPE
⊕ — — — — —	STONE FILL
⊕ — — — — —	BOTTOM OF DITCH
— — — — —	CULVERT PROPOSED
— — — — —	STRUCTURE SUBSURFACE
PDF — — — — —	PROJECT DEMARCATION FENCE
BF — — — — —	BARRIER FENCE
⊗ — — — — —	TREE PROTECTION ZONE (TPZ)
/// — — — — —	STRIPING LINE REMOVAL
~ ~ ~ ~ ~	SHEET PILES

CONVENTIONAL BOUNDARY SYMBOLY

BOUNDARY LINES

— — — — —	TOWN BOUNDARY LINE
— — — — —	COUNTY BOUNDARY LINE
— — — — —	STATE BOUNDARY LINE
— — — — —	PROPOSED STATE R.O.W. (LIMITED ACCESS)
— — — — —	PROPOSED STATE R.O.W.
— — — — —	STATE ROW (LIMITED ACCESS)
— — — — —	STATE ROW
— — — — —	TOWN ROW
— — — — —	PERMANENT EASEMENT LINE (P)
— — — — —	TEMPORARY EASEMENT LINE (T)
— — — — —	SURVEY LINE
— P — — — — —	PROPERTY LINE (P/L)
— SR — — — — —	SLOPE RIGHTS
6f — — — — —	6F PROPERTY BOUNDARY
4f — — — — —	4F PROPERTY BOUNDARY
HAZ — — — — —	HAZARDOUS WASTE

EPSC LAYOUT PLAN SYMBOLY

EPSC MEASURES

ONNOONNOONNO	FILTER CURTAIN
— — — — —	SILT FENCE
— — — — —	SILT FENCE WOVEN WIRE
— — — — —	CHECK DAM
— — — — —	DISTURBED AREAS REQUIRING RE-VEGETATION
— — — — —	EROSION MATTING

SEE EPSC DETAIL SHEETS FOR ADDITIONAL SYMBOLY

ENVIRONMENTAL RESOURCES

— — — — —	WETLAND BOUNDARY
— — — — —	RIPARIAN BUFFER ZONE
— — — — —	WETLAND BUFFER ZONE
— — — — —	SOIL TYPE BOUNDARY
— T&E — — — — —	THREATENED & ENDANGERED SPECIES
— HAZ — — — — —	HAZARDOUS WASTE AREA
— AG — — — — —	AGRICULTURAL LAND
— HABITAT — — — — —	FISH & WILDLIFE HABITAT
— FLOOD PLAIN — — — — —	FLOOD PLAIN
— OHW — — — — —	ORDINARY HIGH WATER (OHW)
— — — — —	STORM WATER
— — — — —	USDA FOREST SERVICE LANDS
— — — — —	WILDLIFE HABITAT SUIT/CONN

ARCHEOLOGICAL & HISTORIC

— ARCH — — — — —	ARCHEOLOGICAL BOUNDARY
— HISTORIC DIST — — — — —	HISTORIC DISTRICT BOUNDARY
— HISTORIC — — — — —	HISTORIC AREA
(H)	HISTORIC STRUCTURE

CONVENTIONAL TOPOGRAPHIC SYMBOLY

EXISTING FEATURES

— — — — —	ROAD EDGE PAVEMENT
— — — — —	ROAD EDGE GRAVEL
— — — — —	DRIVEWAY EDGE
— — — — —	DITCH
— — — — —	FOUNDATION
— — — — —	FENCE (EXISTING)
— — — — —	FENCE WOOD POST
— — — — —	FENCE STEEL POST
— — — — —	GARDEN
— — — — —	ROAD GUARDRAIL
— — — — —	RAILROAD TRACKS
— — — — —	CULVERT (EXISTING)
— — — — —	STONE WALL
— — — — —	WALL
— — — — —	WOOD LINE
— — — — —	BRUSH LINE
— — — — —	HEDGE
— — — — —	BODY OF WATER EDGE
— — — — —	LEDGE EXPOSED

PROJECT NAME: MIDDLESEX
PROJECT NUMBER: BRF 024-1(37)

FILE NAME: s10c220legend.dgn PLOT DATE: 13-JAN-2015
PROJECT LEADER: C. CARLSON DRAWN BY: R. PELLETT
DESIGNED BY: H. SALLS CHECKED BY: H. SALLS
CONVENTIONAL SYMBOLY LEGEND SHEET 9 OF 46

GPS CONTROL POINTS

HVCTRL #1

DAM AZ MK
 NORTH = 659959.426
 EAST = 1621056.096
 ELEV. = 714.466

GENERAL LOCATION, MIDDLESEX, VT.

TO REACH FROM THE INTERSECTION OF US ROUTE 2 (MEMORIAL DRIVE) AND VT ROUTE 12 (MAIN STREET) IN MONTPELIER, GO NORTHEAST ALONG MAIN STREET FOR 0.5 MI (0.8 KM) TO THE INTERSECTION OF SPRING STREET LEFT AT A ROTARY INTERSECTION. TURN LEFT AND GO NORTHWEST ALONG SPRING STREET FOR 0.05 MI (0.1 KM) TO ITS INTERSECTION WITH ELM STREET (VT ROUTE 12). TURN RIGHT AND GO NORTHEAST ALONG VT ROUTE 12 FOR 3.6 MI (5.8 KM) TO THE INTERSECTION OF HORN OF THE MOON ROAD RIGHT. TURN RIGHT AND GO EAST ALONG HORN OF THE MOON ROAD FOR 0.25 MI (0.4 KM) TO THE Y-INTERSECTION OF A DRIVE RIGHT CONTINUING ALONG THE HEIGHT OF THE DAM. BEAR RIGHT AND GO EAST ALONG THE DRIVE FOR ABOUT 40 M (131.2 FT) TO THE SITE OF THE MARK ON THE LEFT, ABOUT 50 M (164.0 FT) WEST OF A CHAIN-LINK FENCE LINE AT THE WEST EDGE OF THE SPILLWAY. THE MARK IS SET FLUSH WITH THE GROUND SURFACE IN THE TOP OF A 0.7 M (2.3 FT) X 0.4 M (1.3 FT) BOULDER. IT IS 4.5 M (14.8 FT) NORTH OF AND ABOUT 0.3 M (1.0 FT) LOWER THAN THE CENTERLINE OF THE DRIVE, 13.4 M (44.0 FT) SOUTH OF THE CENTERLINE OF HORN OF THE MOON ROAD, 5.5 M (18.0 FT) NORTHWEST OF POLE NO L87/R1, 10.5 M (34.4 FT) NORTHEAST OF A STRAIN POLE, 18.2 M (59.7 FT) EAST OF THE WEST END OF A CABLE GUARD RAIL AND 1.2 M (3.9 FT) NORTH OF THE GUARD RAIL.

HVCTRL #2

WRIGHT
 NORTH = 664651.890
 EAST = 1620232.433
 ELEV. = 647.270

GENERAL LOCATION, MIDDLESEX, VT.

TO REACH FROM THE INTERSECTION OF US ROUTE 2 (MEMORIAL DRIVE) AND VT ROUTE 12 (MAIN STREET) IN MONTPELIER, GO NORTHEAST ALONG MAIN STREET FOR 0.5 MI (0.8 KM) TO THE INTERSECTION OF SPRING STREET LEFT AT A ROTARY INTERSECTION. TURN LEFT AND GO NORTHWEST ALONG SPRING STREET FOR 0.05 MI (0.1 KM) TO ITS INTERSECTION WITH ELM STREET (VT ROUTE 12). TURN RIGHT AND GO NORTHEAST ALONG VT ROUTE 12 FOR 4.3 MI (6.9 KM) TO THE INTERSECTION OF THE GATED ENTRANCE DRIVE TO THE WRIGHTSVILLE DAM BOAT LAUNCH RIGHT. TURN RIGHT AND FOLLOW THE DRIVE FOR ABOUT 0.2 MI (0.3 KM) TO THE BOAT LAUNCH RAMP ON THE RIGHT. CONTINUE STRAIGHT AHEAD AND GO NORTH ALONG THE DRIVE (NOW THE ROADBED FOR THE FORMER VT ROUTE 12) FOR ABOUT 75 M (246.1 FT) TO A PARKING AREA AND THE ENTRANCE TO A DIM TRAIL RIGHT. PARK VEHICLE AND WALK EASTERLY ALONG THE TRAIL FOR ABOUT 30 M (98.4 FT) AND THEN SOUTHERLY FOR ANOTHER 30 M (98.4 FT) TO THE SITE OF THE MARK. THE MARK IS SET 15 CM (6 INCHES) BELOW GROUND SURFACE IN THE TOP OF A FENO STYLE MONUMENT. IT IS 31.3 M (102.7 FT) EAST OF AND ABOUT 0.5 M (1.6 FT) LOWER THAN THE CENTERLINE OF THE DRIVE, 27.0 M (88.6 FT) SOUTH OF A 10 CM (4 INCH) WHITE BIRCH WITH TRIANGULAR BLAZE, 18.7 M (61.4 FT) SOUTH-SOUTHWEST OF A 15 CM (6 INCH) SWAMP MAPLE WITH TRIANGULAR BLAZE IN A CLUMP OF FOUR, 15.6 M (51.2 FT) NORTHWEST OF A 50 CM (20 INCH) TWIN-TRUNKED MAPLE NEAR THE WATERS EDGE, 16.2 M (53.1 FT) SOUTH-SOUTHEAST OF A 15 CM (6 INCH) TWIN-TRUNKED APPLE WITH TRIANGULAR BLAZE AND 0.2 M (0.7 FT) WEST OF A FIBERGLASS WITNESS POST.

TRAVERSE TIES


HVCTRL #3

NORTH = 660343.699
 EAST = 1619763.487
 ELEV. = 728.389

NOT TIED


HVCTRL #4

NORTH = 661038.506
 EAST = 1620017.348
 ELEV. = 725.663

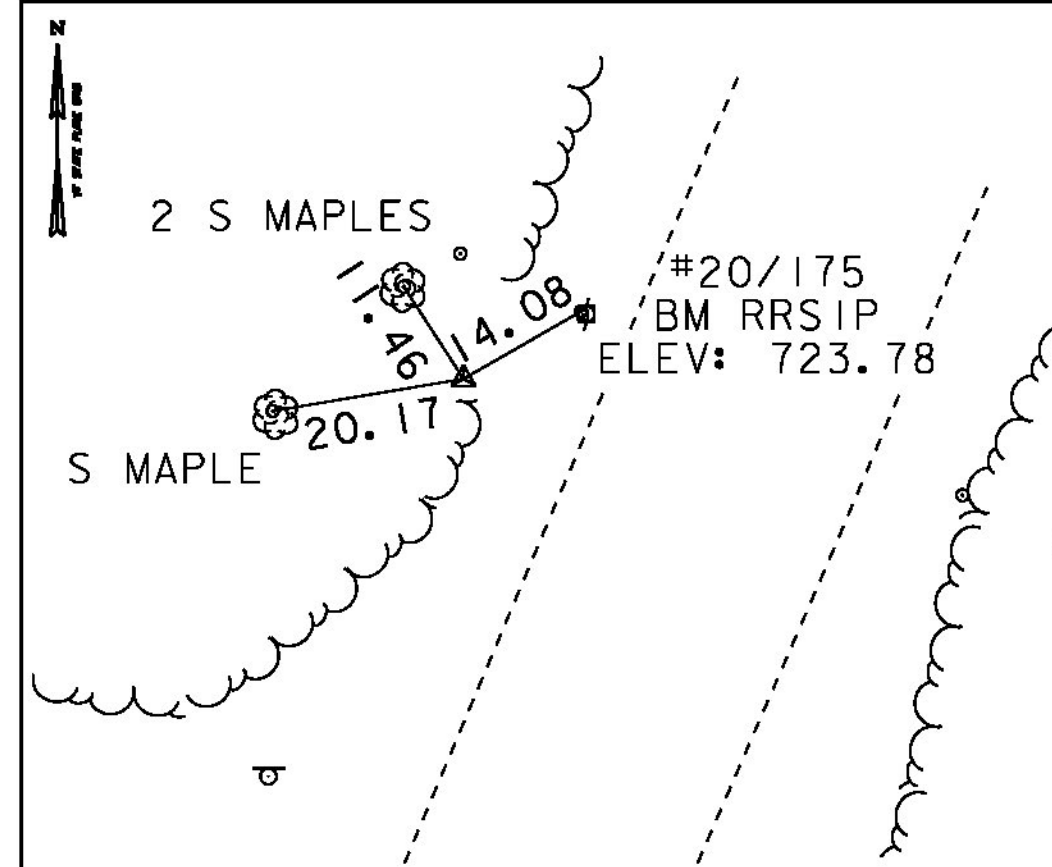

HVCTRL #5

NORTH = 660565.676
 EAST = 1619873.812
 ELEV. = 724.019

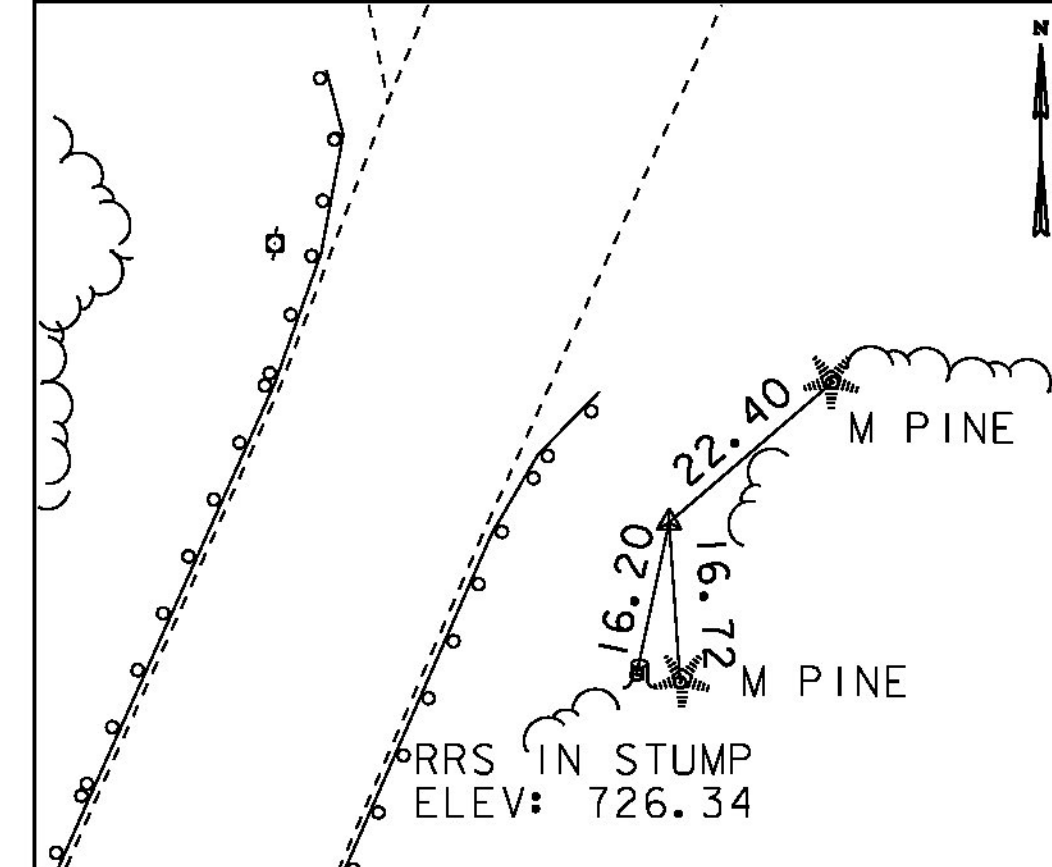

* MAIN TRAVERSE COMPLETED 1/10/2011 BY R. GILMAN P.C. & P. WINTERS


ALIGNMENT TIES

ALIGNMENT NAME: VT12PROP


POINT	STATION	NORTHING	EASTING
POB	26+25.00	660490.99	1619808.12
POE	32+25.00	661039.73	1620050.78

DATUM	
VERTICAL	NAVD 88
HORIZONTAL	NAD 83 (07)
ADJUSTMENT	COMPASS

PROJECT NAME:	MIDDLESEX
PROJECT NUMBER:	BRF 024-(K37)
FILE NAME:	sl0c220tie.dgn
PROJECT LEADER:	C. CARLSON
DESIGNED BY:	H. SALLS
TIE SHEET	
PLOT DATE:	13-JAN-2015
DRAWN BY:	R. BULLOCK
CHECKED BY:	H. SALLS
SHEET	10 OF 46

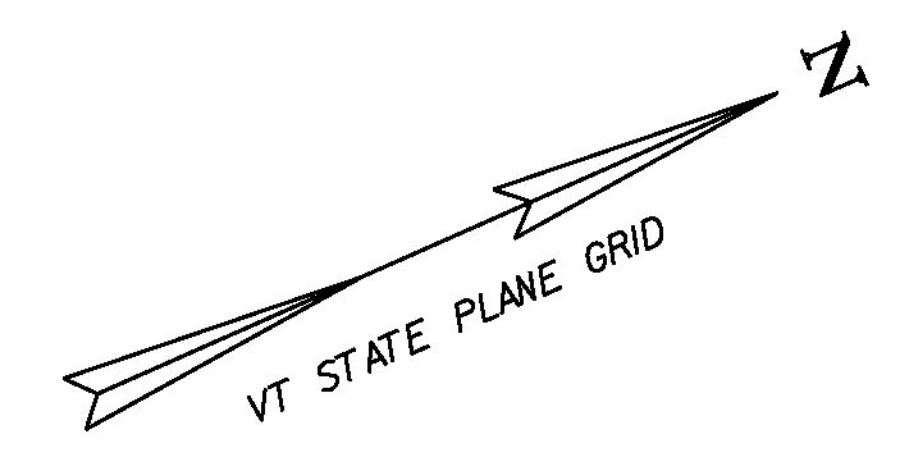

- CAST-IN-PLACE CONCRETE CURB, TYPE B**
 STA 28+60.00 - STA 29+00.00 LT
 STA 28+63.00 - STA 29+03.00 RT
 STA 29+38.00 - STA 29+78.00 LT
 STA 29+50.00 - STA 29+90.00 RT
- REMOVAL AND DISPOSAL OF GUARDRAIL**
 STA 28+37.79 - STA 29+05.13 RT
 STA 28+55.75 - STA 28+96.94 LT
 STA 29+41.53 - STA 30+06.03 LT
 STA 29+46.89 - STA 30+14.07 RT
- MANUFACTURED TERMINAL SECTION, FLARED**
 STA 28+34.75 - STA 28+73.84 RT
 STA 30+17.15 - STA 30+56.28 LT
 STA 29+79.01 - STA 30+18.14 RT
- GUARDRAIL APPROACH SECTION, GALVANIZED 2 RAIL BOX BEAM**
 STA 28+61.96 - STA 28+91.29 LT
 STA 28+73.84 - STA 29+02.94 RT
 STA 29+38.06 - STA 29+67.15 LT
 STA 29+49.71 - STA 29+79.01 RT
- BRIDGE RAIL, GALVANIZED 2 RAIL BOX BEAM**
 STA 28+91.29 - STA 29+38.06 LT
 STA 29+02.94 - STA 29+49.71 RT
- PAVED APRON**
 STA 30+70.75 - 31+50.00 LT
- HD STEEL BEAM GUARDRAIL, GALVANIZED**
 STA 28+49.62 - STA 28+61.96 LT
 STA 29+67.15 - STA 30+17.15 LT
- ANCHOR FOR STEEL BEAM RAIL**
 STA 28+56.80 LT

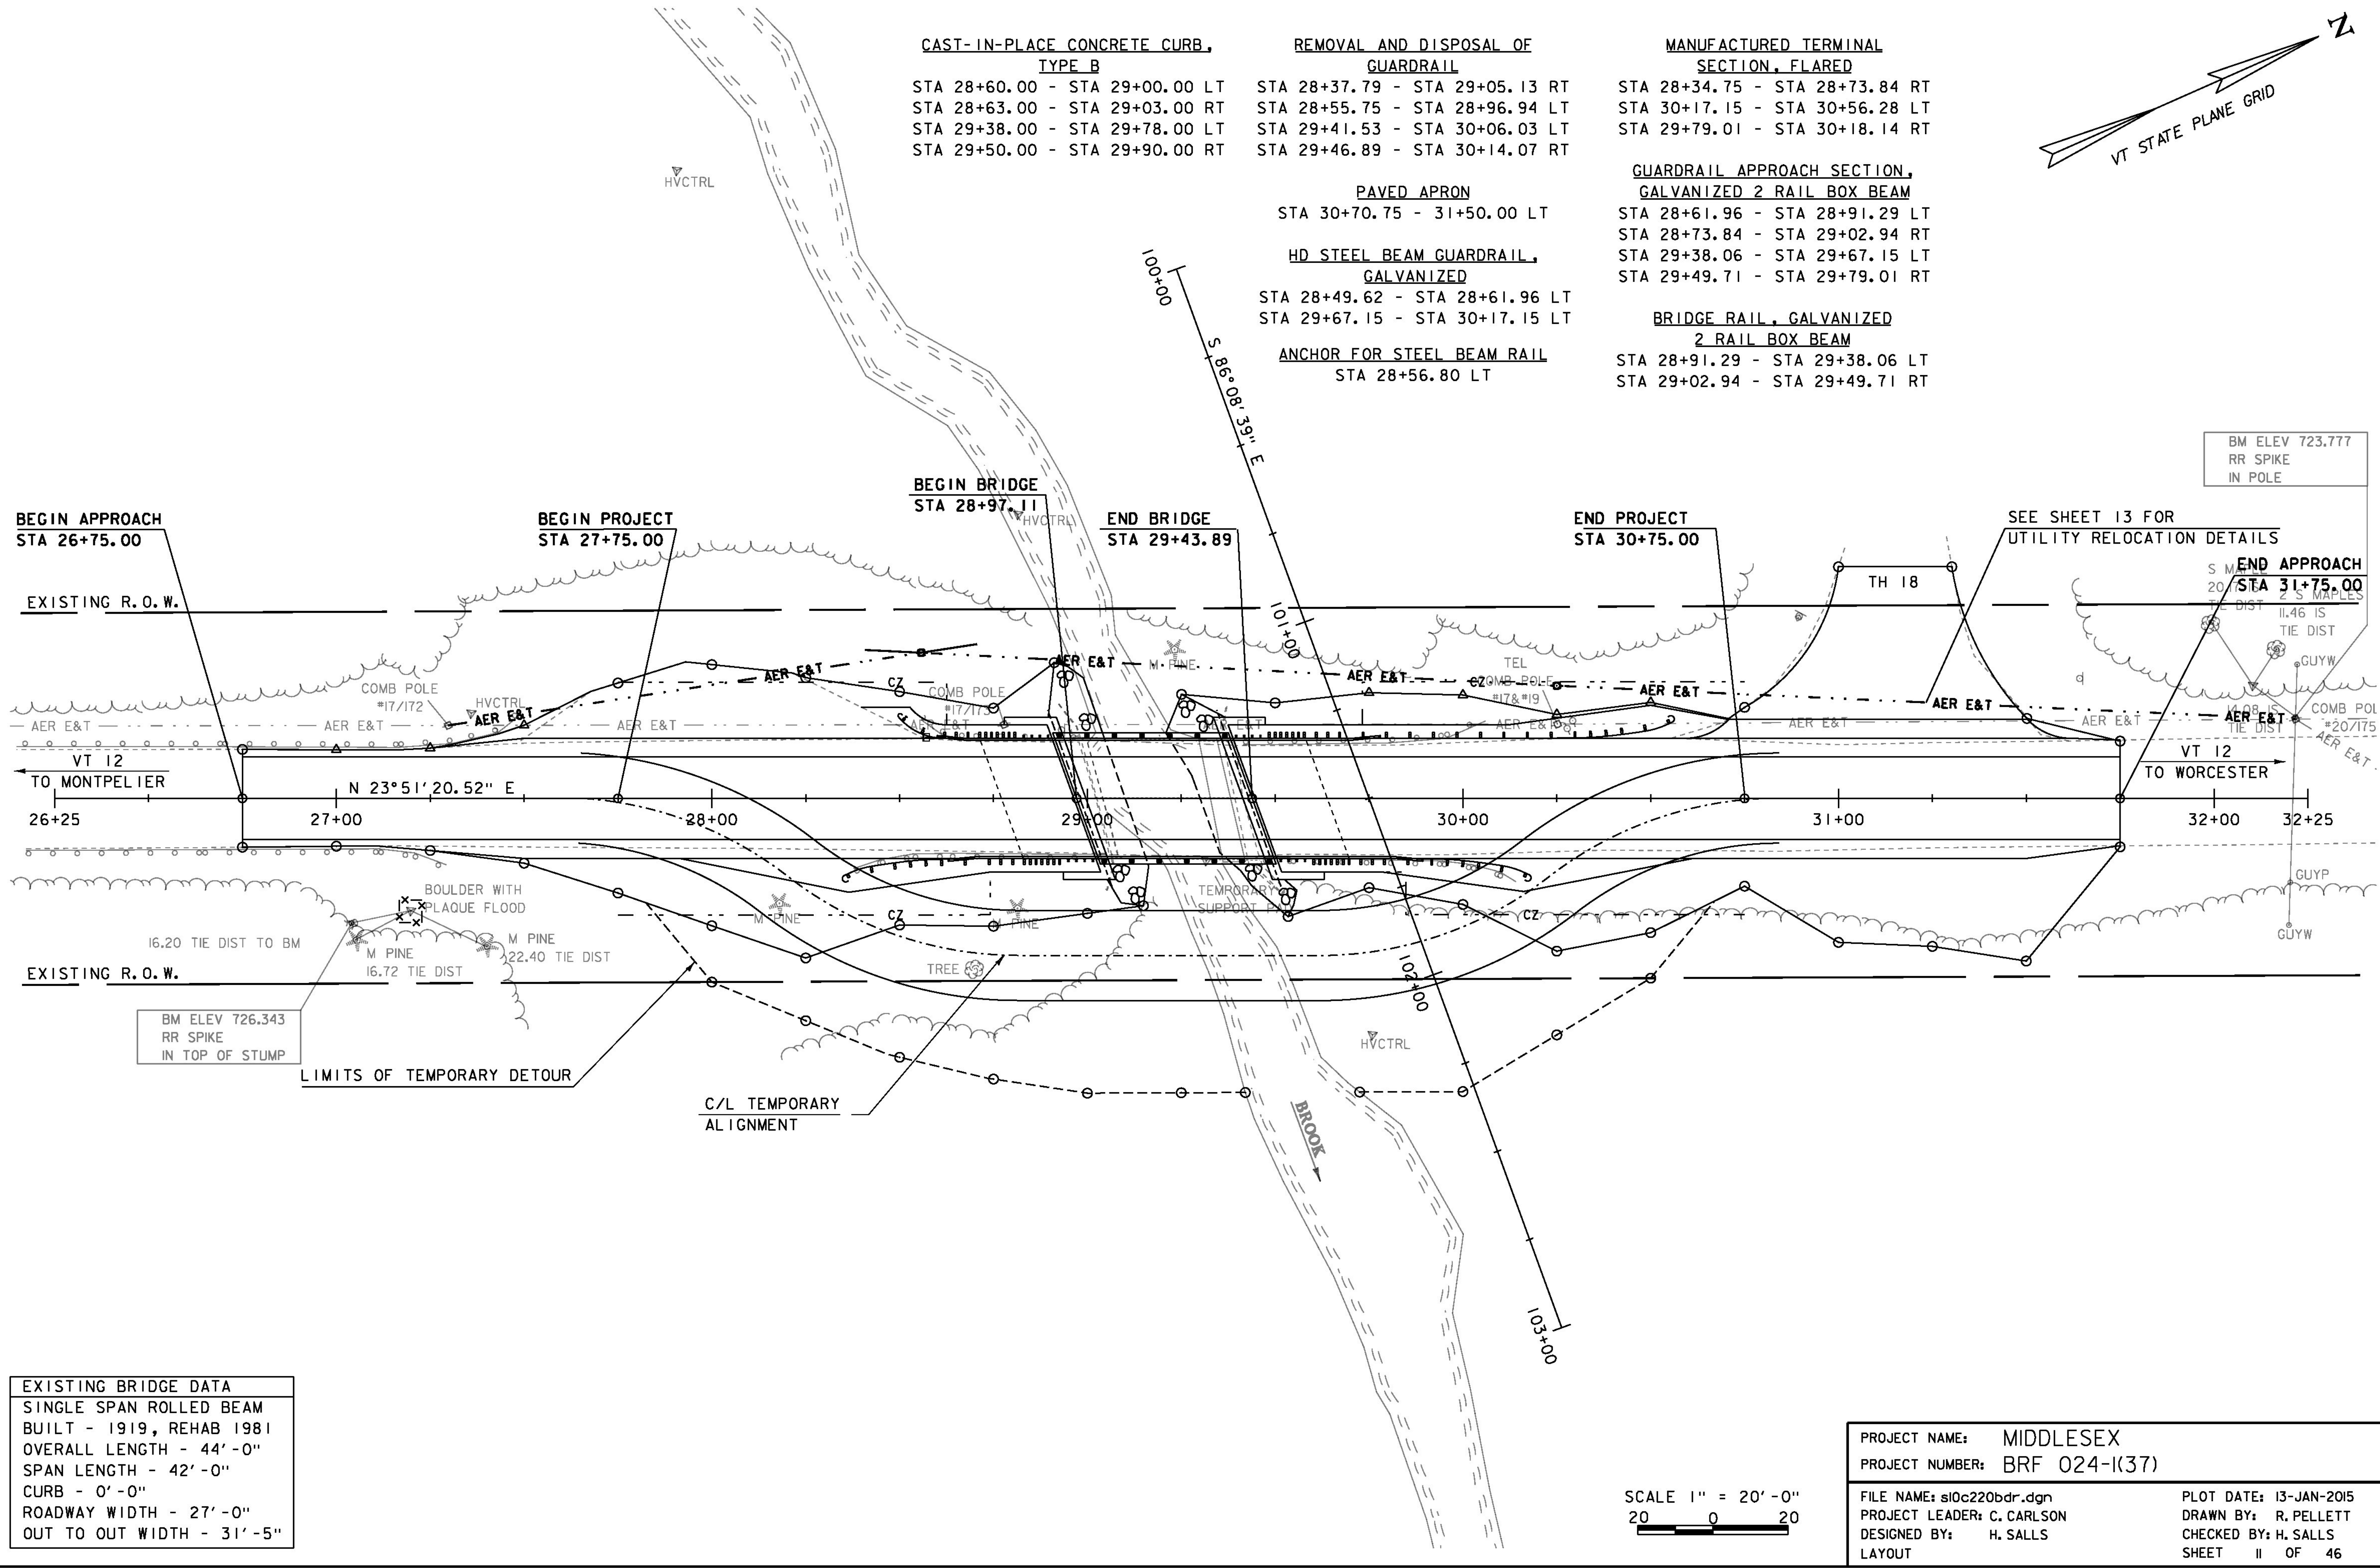

BEGIN APPROACH
STA 26+75.00

BEGIN PROJECT
STA 27+75.00

BEGIN BRIDGE
STA 28+97.11

END BRIDGE
STA 29+43.89

END PROJECT
STA 30+75.00

SEE SHEET 13 FOR
UTILITY RELOCATION DETAILS
END APPROACH
STA 31+75.00

TO MONTPELIER

TO WORCESTER

BM ELEV 726.343
RR SPIKE
IN TOP OF STUMP

BM ELEV 723.777
RR SPIKE
IN POLE

EXISTING BRIDGE DATA
 SINGLE SPAN ROLLED BEAM
 BUILT - 1919, REHAB 1981
 OVERALL LENGTH - 44'-0"
 SPAN LENGTH - 42'-0"
 CURB - 0'-0"
 ROADWAY WIDTH - 27'-0"
 OUT TO OUT WIDTH - 31'-5"

PROJECT NAME: MIDDLESEX
 PROJECT NUMBER: BRF 024-K(37)
 FILE NAME: sl0c220bdr.dgn
 PROJECT LEADER: C. CARLSON
 DESIGNED BY: H. SALLS
 LAYOUT
 PLOT DATE: 13-JAN-2015
 DRAWN BY: R. PELLETT
 CHECKED BY: H. SALLS
 SHEET 11 OF 46

SCALE 1" = 20'-0"
 20 0 20

BEGIN APPROACH
STA 26+75.00
MATCH EXISTING


BEGIN PROJECT
STA 27+75.00
FG = 727.29

BEGIN BRIDGE
STA 28+97.11
FG = 727.19

END BRIDGE
STA 29+43.89
FG = 726.84

END PROJECT
STA 30+75.00
FG = 725.53

END APPROACH
STA 31+75.00
MATCH EXISTING


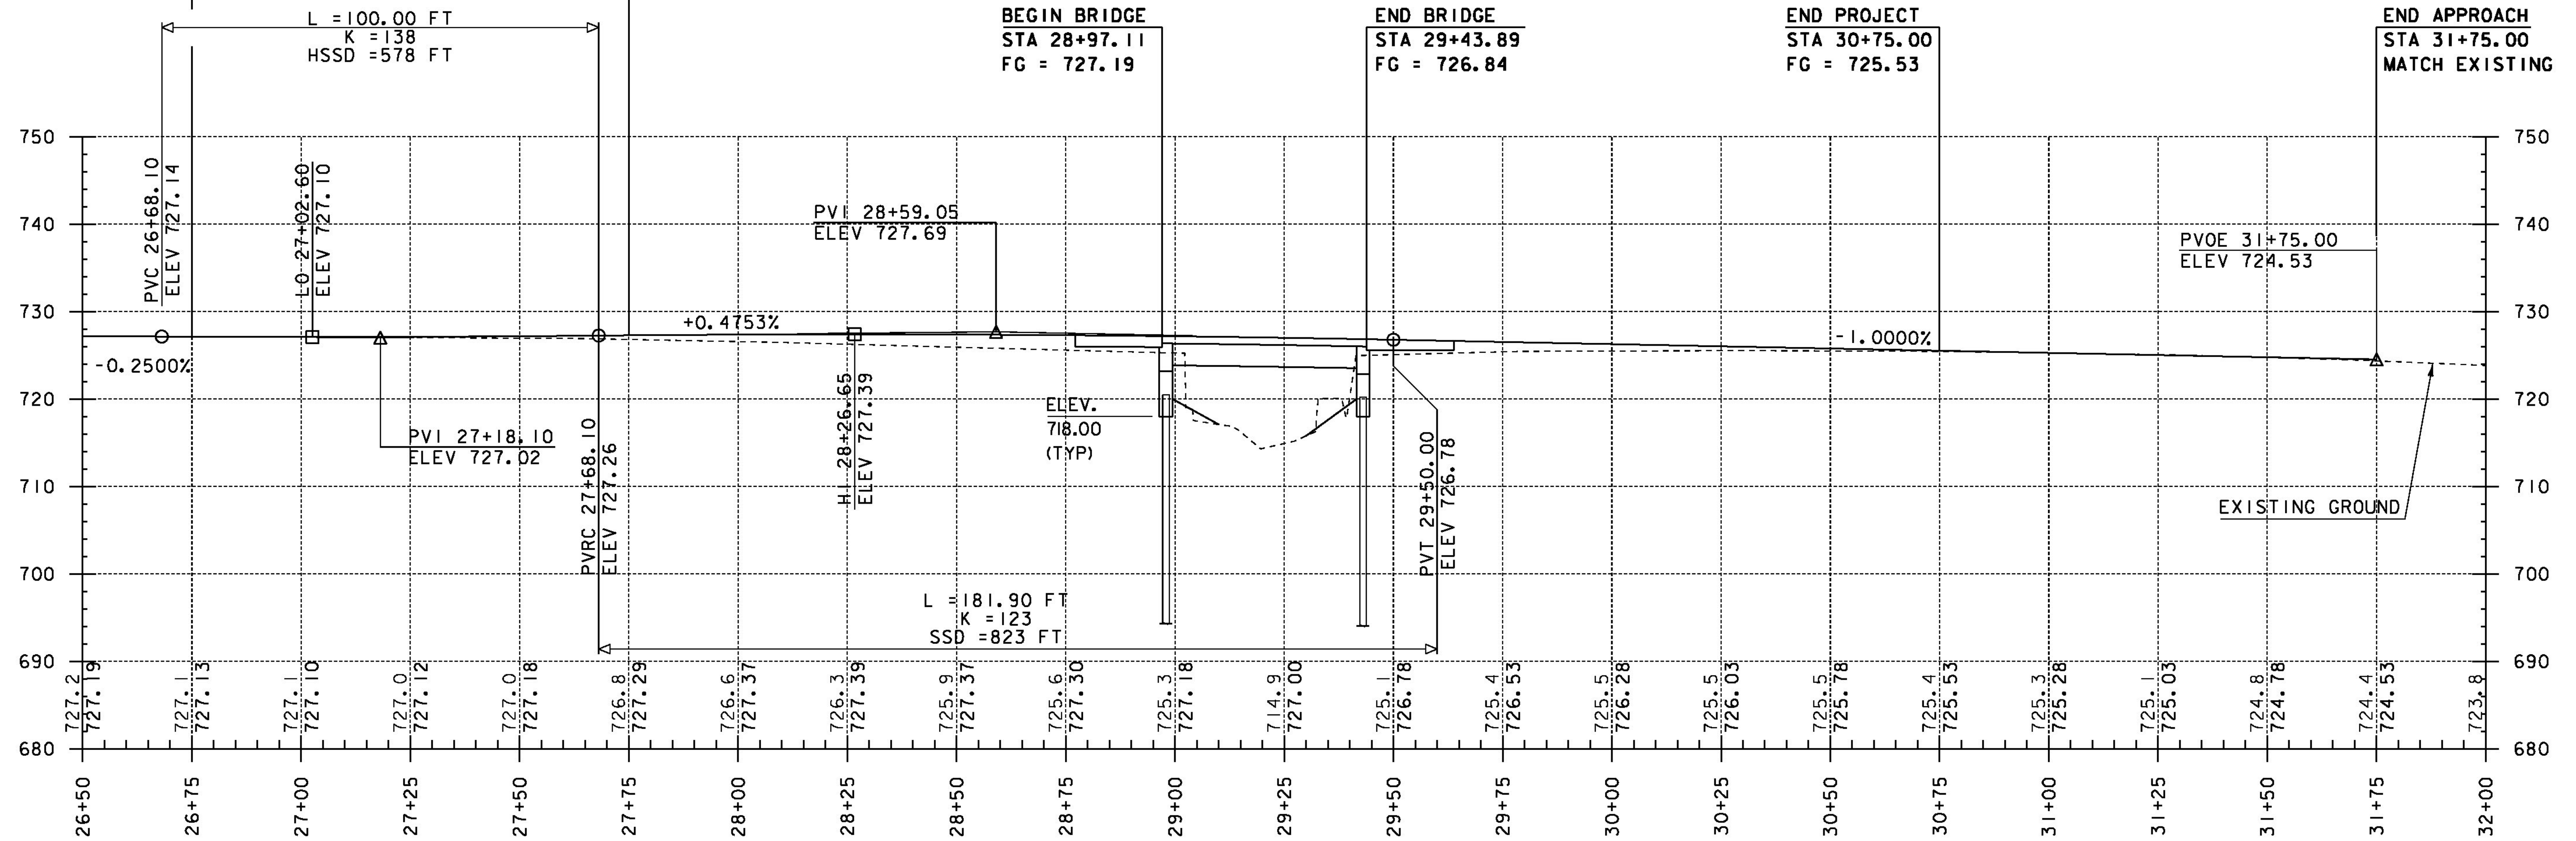


VT 12 PROFILE
HORIZONTAL SCALE 1" = 20' -0"
VERTICAL SCALE 1" = 10' -0"

THE GRADES SHOWN TO THE NEAREST TENTH ARE THE ORIGINAL
GROUND ELEVATIONS ALONG THE PROPOSED ALIGNMENT.

THE GRADES SHOWN TO THE NEAREST HUNDREDTH ARE THE FINISH
GRADES ALONG THE PROPOSED ALIGNMENT.

PROJECT NAME:	MIDDLESEX	PLOT DATE:	13-JAN-2015
PROJECT NUMBER:	BRF 024-I(37)	DRAWN BY:	R. PELLETT
FILE NAME:	sl0c220pro.dgn	CHECKED BY:	H. SALLS
PROJECT LEADER:	C. CARLSON	SHEET	12 OF 46
DESIGNED BY:	H. SALLS		
VT 12 PROFILE			

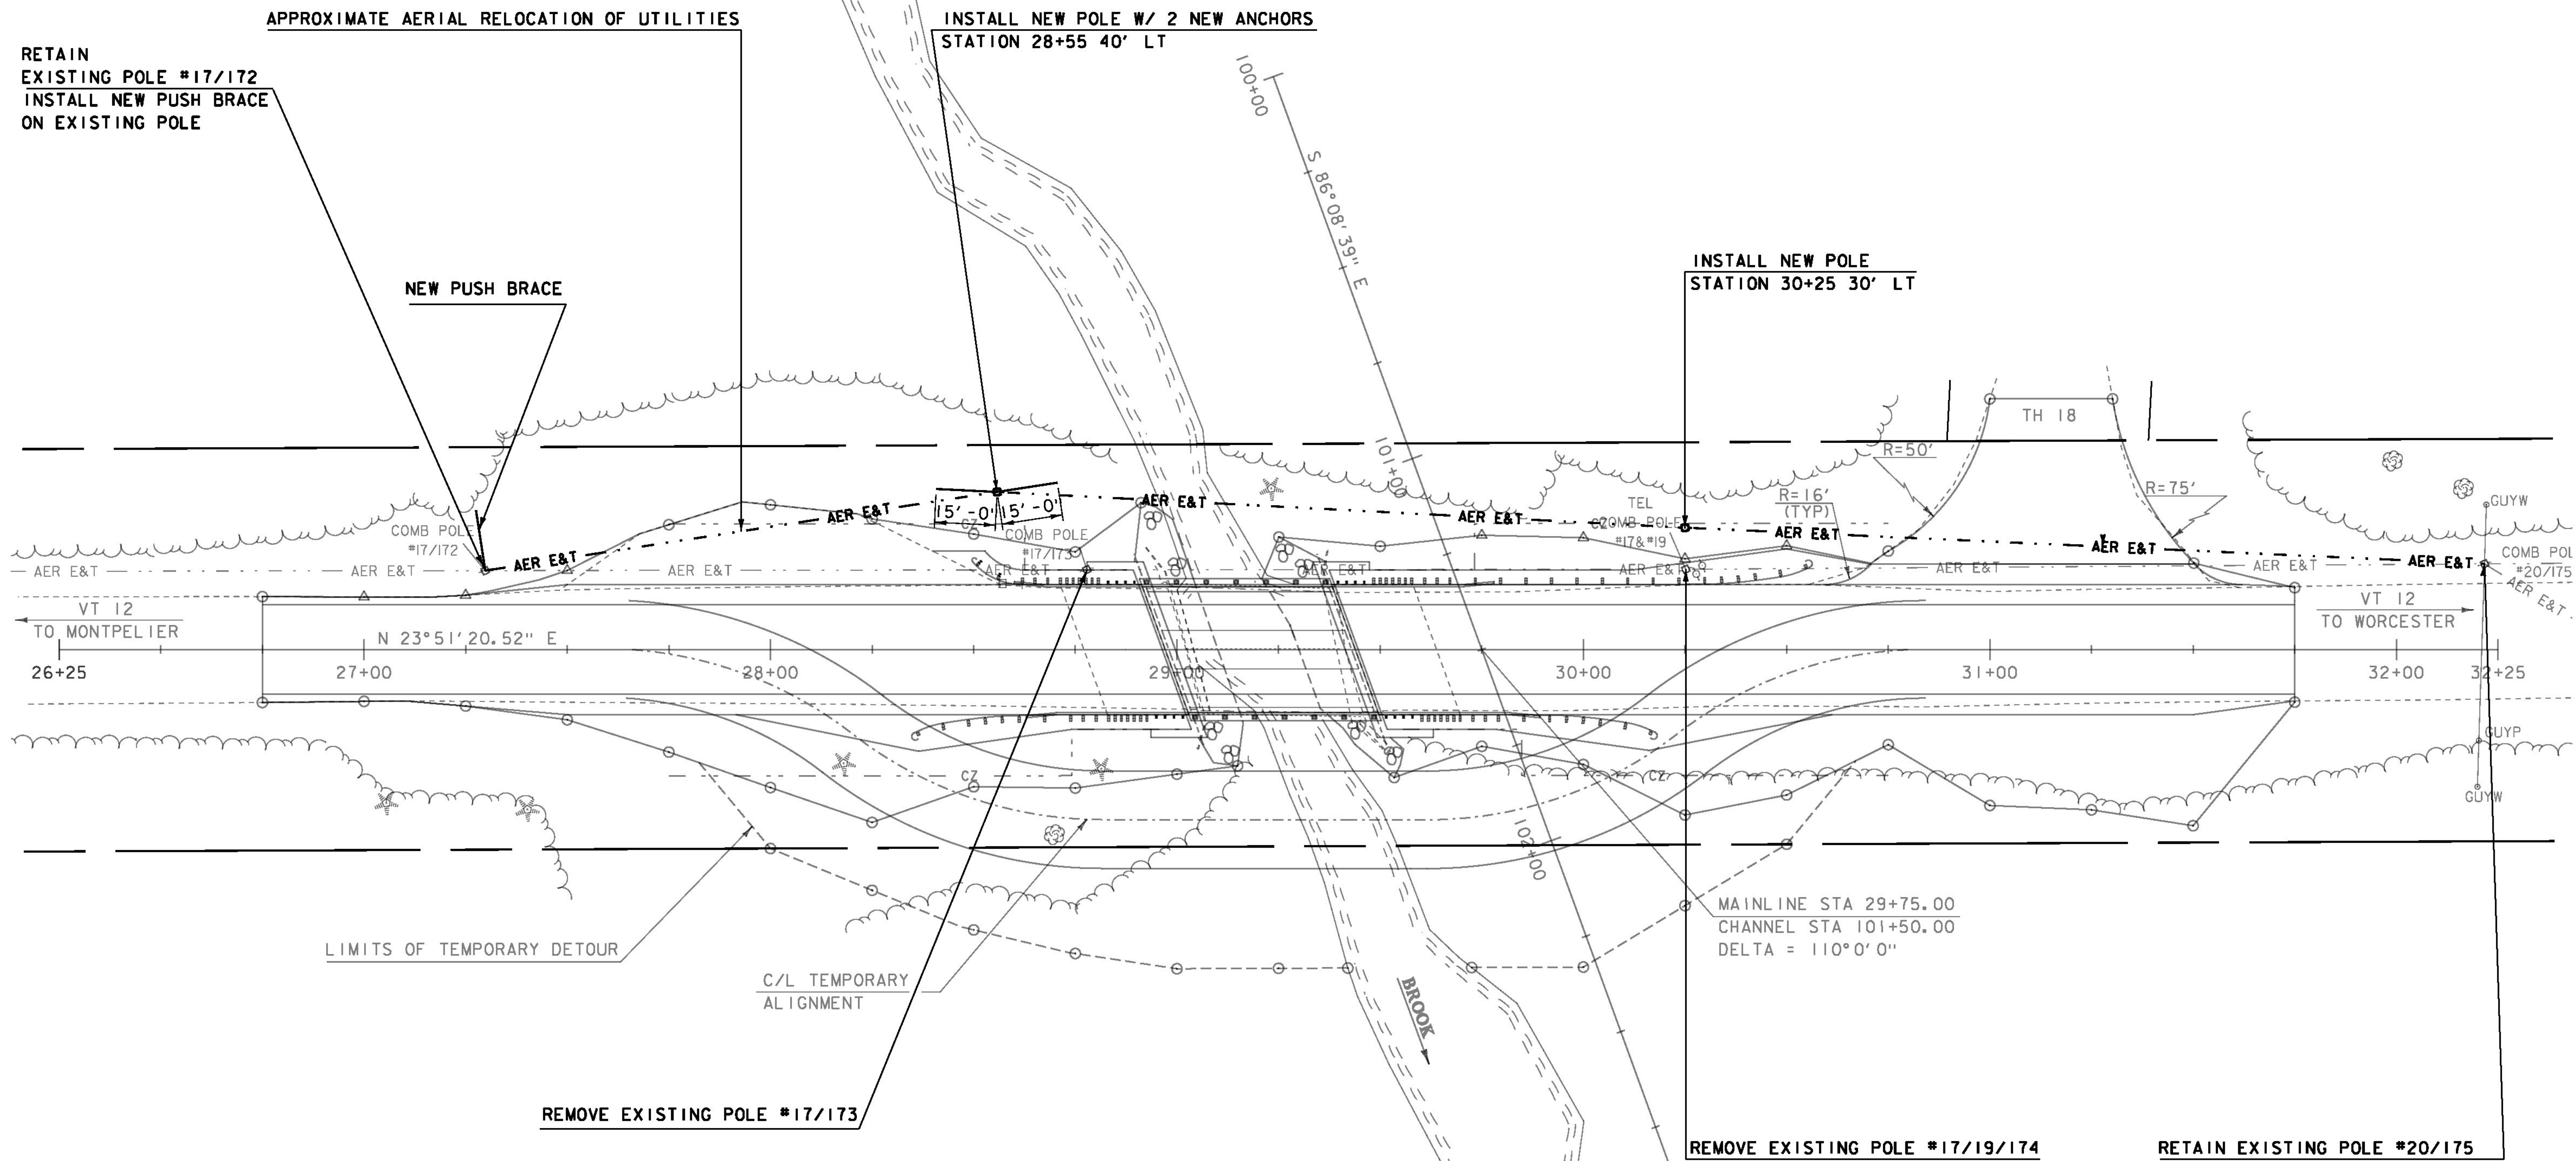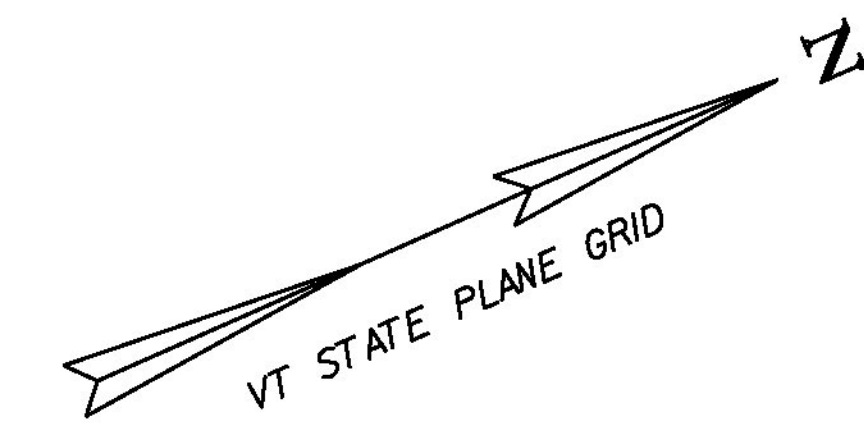

RETAIN
EXISTING POLE #17/172
INSTALL NEW PUSH BRACE
ON EXISTING POLE

APPROXIMATE AERIAL RELOCATION OF UTILITIES

INSTALL NEW POLE W/ 2 NEW ANCHORS
STATION 28+55 40' LT

INSTALL NEW POLE
STATION 30+25 30' LT

NEW PUSH BRACE

LIMITS OF TEMPORARY DETOUR

REMOVE EXISTING POLE #17/173

REMOVE EXISTING POLE #17/19/174

RETAIN EXISTING POLE #20/175

C/L TEMPORARY
ALIGNMENT









MAINLINE STA 29+75.00
CHANNEL STA 101+50.00
DELTA = 110° 0' 0"

NOTE: UTILITY WORK TO BE DONE BY OTHERS

AERIAL RELOCATION ROUTE VT ROUTE 12 MM 0.553 BRIDGE #77

SCALE 1" = 20'-0"
20 0 20

PROJECT NAME: MIDDLESEX	FILE NAME: sl0c220ut11.dgn	PLOT DATE: 13-JAN-2015
PROJECT NUMBER: BRF 024-K(37)	PROJECT LEADER: C. CARLSON	DRAWN BY: R. PELLETT
	DESIGNED BY: H. SALLS	CHECKED BY: H. SALLS
	UTILITY LAYOUT	SHEET 13 OF 46

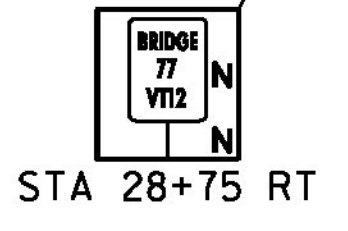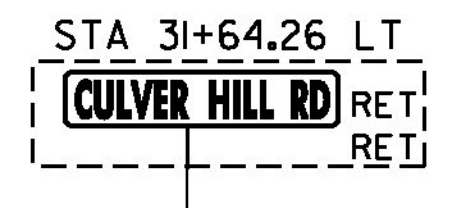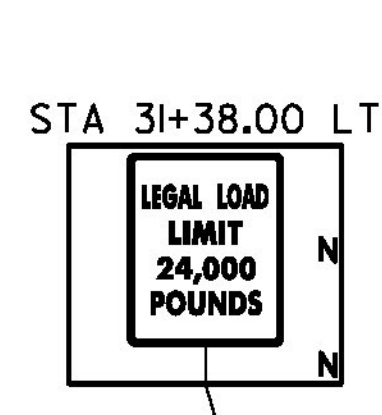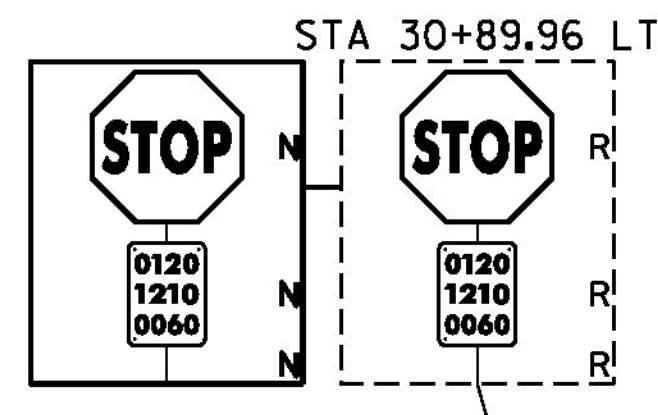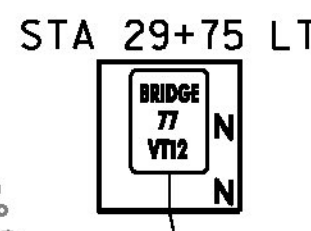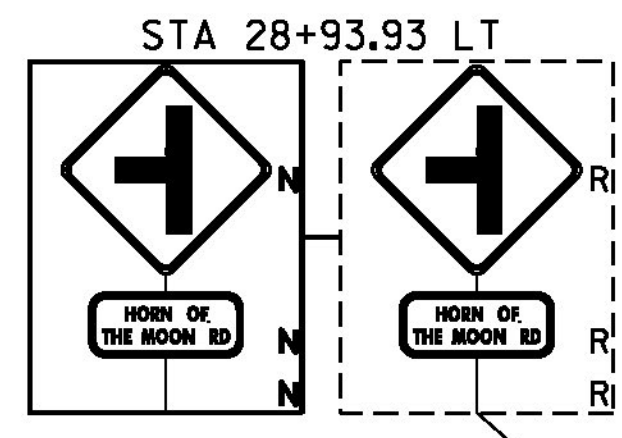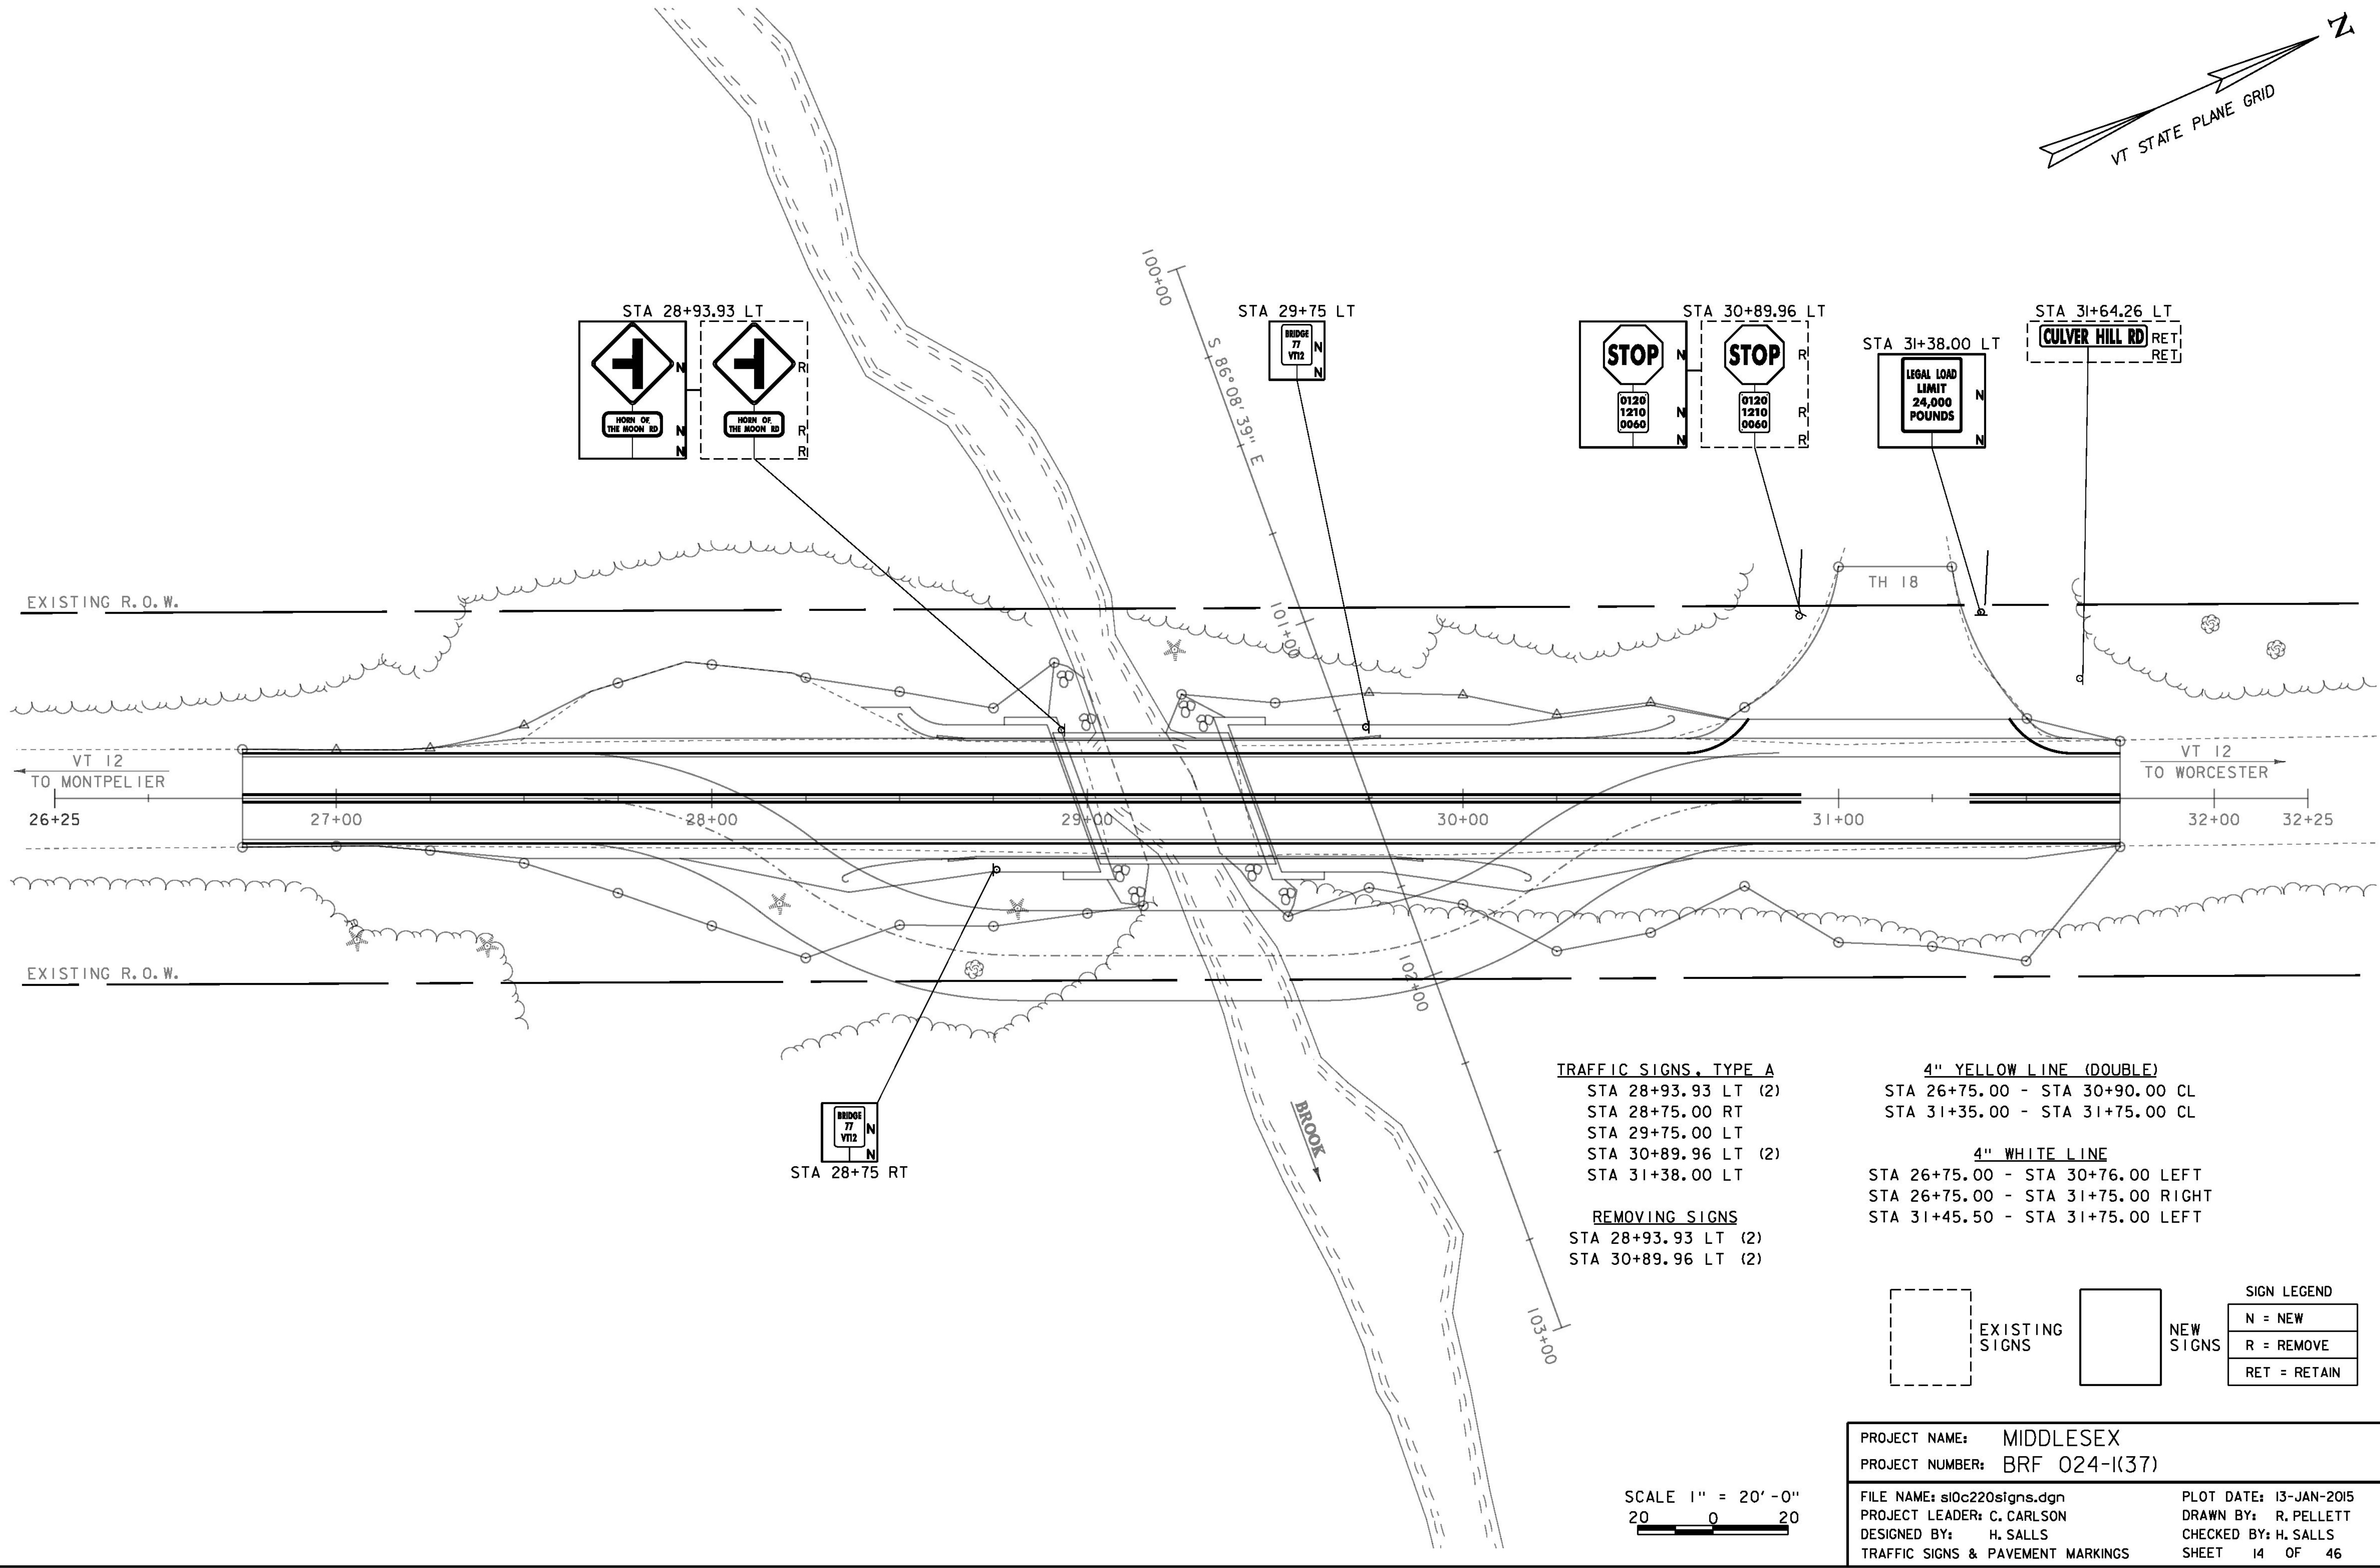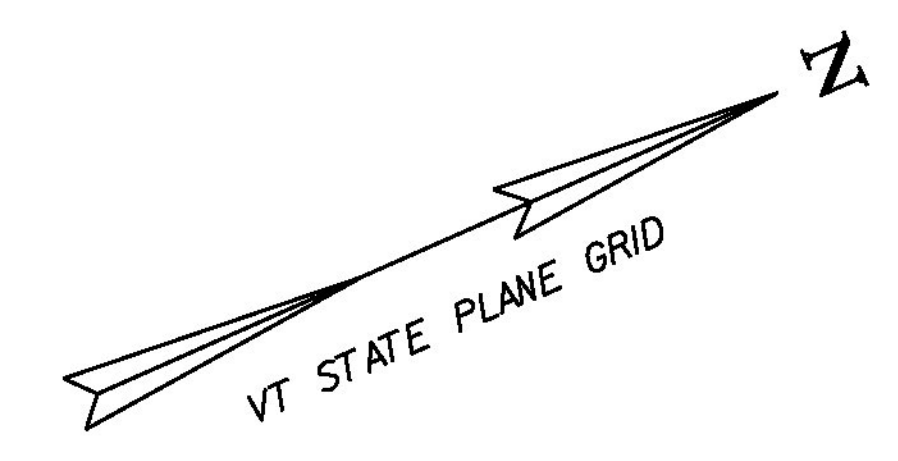

- TRAFFIC SIGNS, TYPE A**
 STA 28+93.93 LT (2)
 STA 28+75.00 RT
 STA 29+75.00 LT
 STA 30+89.96 LT (2)
 STA 31+38.00 LT
- REMOVING SIGNS**
 STA 28+93.93 LT (2)
 STA 30+89.96 LT (2)

- 4" YELLOW LINE (DOUBLE)**
 STA 26+75.00 - STA 30+90.00 CL
 STA 31+35.00 - STA 31+75.00 CL


- 4" WHITE LINE**
 STA 26+75.00 - STA 30+76.00 LEFT
 STA 26+75.00 - STA 31+75.00 RIGHT
 STA 31+45.50 - STA 31+75.00 LEFT

SIGN LEGEND	
	EXISTING SIGNS
	NEW SIGNS
N	= NEW
R	= REMOVE
RET	= RETAIN

PROJECT NAME: MIDDLESEX
 PROJECT NUMBER: BRP 024-K(37)

FILE NAME: sl0c220signs.dgn
 PROJECT LEADER: C. CARLSON
 DESIGNED BY: H. SALLS
 TRAFFIC SIGNS & PAVEMENT MARKINGS

PLOT DATE: 13-JAN-2015
 DRAWN BY: R. PELLETT
 CHECKED BY: H. SALLS
 SHEET 14 OF 46

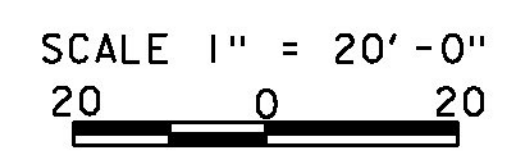

SOIL CLASSIFICATION

AASHTO

A1	Gravel and Sand
A3	Fine Sand
A2	Silty or Clayey Gravel and Sand
A4	Silty Soil - Low Compressibility
A5	Silty Soil - Highly Compressible
A6	Clayey Soil - Low Compressibility
A7	Clayey Soil - Highly Compressible

ROCK QUALITY DESIGNATION

R.Q.D. (%)	ROCK DESCRIPTION
<25	Very Poor
25 to 50	Poor
51 to 75	Fair
76 to 90	Good
>90	Excellent

SHEAR STRENGTH

UNDRAINED SHEAR STRENGTH IN P.S.F.	CONSISTENCY
<250	Very Soft
250-500	Soft
500-1000	Med. Stiff
1000-2000	Stiff
2000-4000	Very Stiff
>4000	Hard

CORRELATION GUIDE OF "N" TO DENSITY/CONSISTENCY

DENSITY (GRANULAR SOILS)		CONSISTENCY (COHESIVE SOILS)	
N	DESCRIPTIVE TERM	N	DESCRIPTIVE TERM
<5	Very Loose	<2	Very Soft
5-10	Loose	2-4	Soft
11-24	Med. Dense	5-8	Med. Stiff
25-50	Dense	9-15	Stiff
>50	Very Dense	16-30	Very Stiff
		31-60	Hard
		>60	Very Hard

COMMONLY USED SYMBOLS


- ▼ Water Elevation
- ⊙ Standard Penetration Boring
- ⊕ Auger Boring
- ⊖ Rod Sounding
- Sample
- S Standard Penetration Test
- N Blow Count Per Foot For:
2" O.D. Sampler
1 1/2" I.D. Sampler
Hammer Weight Of 140 Lbs.
Hammer Fall Of 30"
- VS Field Vane Shear Test
- US Undisturbed Soil Sample
- B Blast
- DC Diamond Core
- MD Mud Drill
- WA Wash Ahead
- HSA Hollow Stem Auger
- AX Core Size 1 1/8"
- BX Core Size 1 5/8"
- NX Core Size 2 1/8"
- M Double Tube Core Barrel Used
- LL Liquid Limit
- PL Plastic Limit
- PI Plasticity Index
- NP Non Plastic
- w Moisture Content (Dry Wgt. Basis)
- D Dry
- M Moist
- MTW Moist To Wet
- W Wet
- Sat Saturated
- Bo Boulder
- Gr Gravel
- Sa Sand
- SI Silt
- Cl Clay
- HP Hardpan
- Le Ledge
- NLTD No Ledge To Depth
- CNPF Can Not Penetrate Further
- TLOB Top of Ledge Or Boulder
- NR No Recovery
- Rec. Recovery
- %Rec. Percent Recovery
- RQD Rock Quality Designation
- CBR California Bearing Ratio
- < Less Than
- > Greater Than
- R Refusal (N > 100)
- VTSPG NAD83 - See Note 7

COLOR

- | | | | |
|-----|--------|------|--------------|
| bik | Black | pnk | Pink |
| bl | Blue | pu | Purple |
| brn | Brown | rd | Red |
| dk | Dark | tn | Tan |
| gry | Gray | wh | White |
| gn | Green | yel | Yellow |
| lt | Light | mltc | Multicolored |
| or | Orange | | |

DEFINITIONS (AASHTO)

- BEDROCK (LEDGE)** - Rock in its native location of indefinite thickness.
- BOULDER** - A rock fragment with an average dimension > 12 inches.
- COBBLE** - Rock fragments with an average dimension between 3 and 12 inches.
- GRAVEL** - Rounded particles of rock < 3" and > 0.075" (#10 sieve).
- SAND** - Particles of rock < 0.075" (#10 sieve) and > 0.0025" (#200 sieve).
- SILT** - Soil < 0.0025" (#200 sieve), non or slightly plastic and exhibits no strength when air-dried.
- CLAY** - Fine grained soil, exhibits plasticity when moist and considerable strength when air-dried.
- VARVED** - Alternate layers of silt and clay.
- HARDPAN** - Extremely dense soil, cemented layer, not softened when wet.
- MUCK** - Soft organic soil (containing > 10% organic material).
- MOISTURE CONTENT** - Weight of water divided by dry weight of soil.
- FLOWING SAND** - Granular soil so saturated (loose) that it flows into drill casing during extraction of wash rod.
- STRIKE** - Angle from magnetic north to line of intersection of bed with a horizontal plane.
- DIP** - Inclination of bed with a horizontal plane.

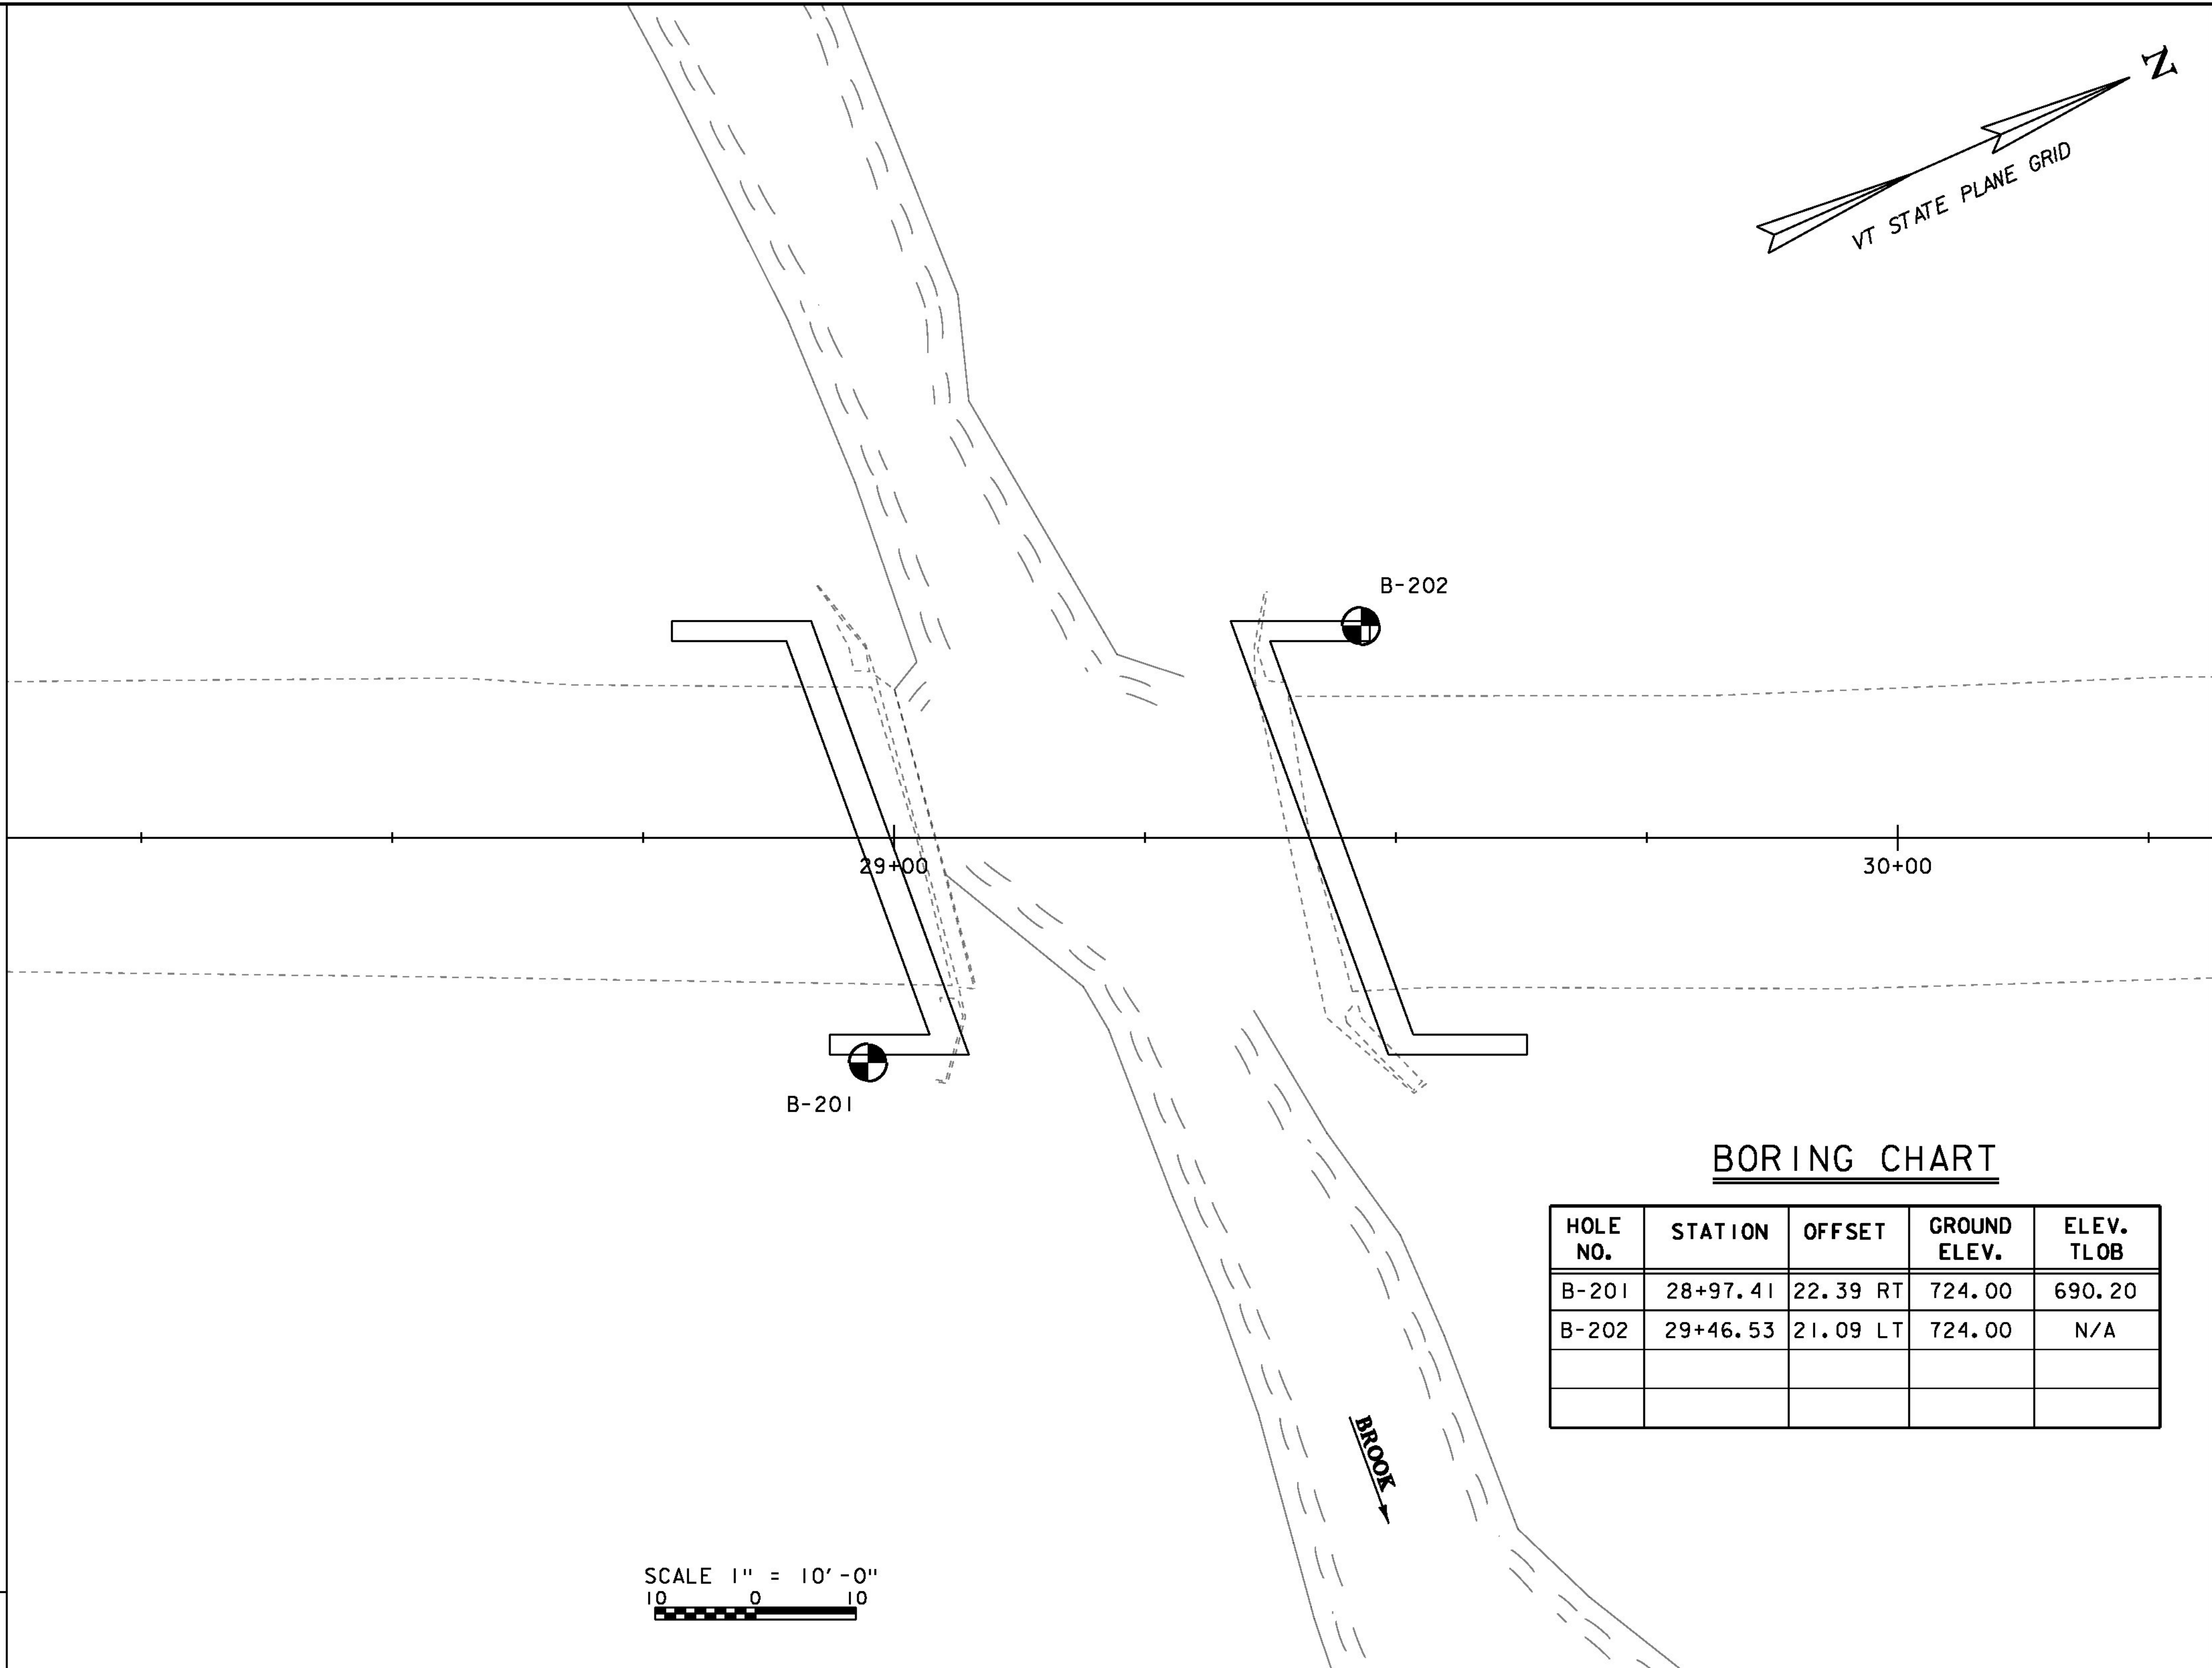

BORING CHART

HOLE NO.	STATION	OFFSET	GROUND ELEV.	ELEV. TLOB
B-201	28+97.41	22.39 RT	724.00	690.20
B-202	29+46.53	21.09 LT	724.00	N/A

GENERAL NOTES

1. The subsurface explorations shown herein were made between 01/18/12 and 01/31/12 by the Agency.
2. Soil and rock classifications, properties and descriptions are based on engineering interpretation from available subsurface information by the Agency and may not necessarily reflect actual variations in subsurface conditions that may be encountered between individual boring or sample locations.
3. Observed water levels and/or conditions indicated are as recorded at the time of exploration and may vary according to the prevailing rainfall, methods of exploration and other factors.
4. Engineering judgment was exercised in preparing the subsurface information presented herein. Analysis and interpretation of subsurface data was performed and interpreted for Agency design and estimating purposes. Presentation of the information in the Contract is intended to provide the Contractor access to the same data available to the Agency. The subsurface information is presented in good faith and is not intended as a substitute for personal investigation, independent interpretation, independent analysis or judgment by the Contractor.
5. Pictorial structure details shown on the boring plan layout or soils profile are for illustrative purposes only and may not accurately portray final contract details.
6. Terminology used on boring logs to describe the hardness, degree of weathering, and spacing of fractures, joints and other discontinuities in the bedrock is defined in the AASHTO Manual on Subsurface Investigations, 1988.
7. Northing and Easting coordinates are shown in Vermont State Plane Grid North American Datum 1983 in meters and survey feet.

PROJECT NAME: MIDDLESEX
PROJECT NUMBER: BRF 024-(K37)

FILE NAME: sl0c220bor.dgn
PROJECT LEADER: C. CARLSON
DESIGNED BY: H. SALLS
BORING INFORMATION

PLOT DATE: 13-JAN-2015
DRAWN BY: R. PELLETT
CHECKED BY: H. SALLS
SHEET 16 OF 46

STATE OF VERMONT AGENCY OF TRANSPORTATION MATERIALS & RESEARCH SECTION SUBSURFACE INFORMATION		BORING LOG		Boring No.: B-201					
MIDDLESEX BRF 024-1(37) VT-12 BR-77		Page No.: 1 of 1		Pin No.: 10C220					
Checked By: NSM		Casing		Sampler					
Groundwater Observations		Date		Depth (ft)					
Notes		Date		Depth (ft)					
Boring Crew: GARROW, SALISBURY, PORTER		Type: WB		SS					
Date Started: 1/18/12 Date Finished: 1/25/12		I.D.: 4 in		1.5 in					
VTSPG NAD83: N 660731.08 ft E 1619938.77 ft		Hammer Wt: N.A.		140 lb.					
Station: 28+97.41 Offset: 22.39		Hammer Fall: N.A.		30 in.					
Ground Elevation: 724.0 ft		Hammer/Rod Type: Auto/AWJ		Rig: CME 45C TRACK C = 1.34					
Depth (ft)	Strata (1)	Run (Dip deg.)	Core Rec. % (ROD %)	Drill Rate (minutes/ft)	Blows/6" (N Value)	Moisture Content %	Gravel %	Sand %	Fines %
5	A-2-4, GrSa, brn, Moist, Rec. = 0.8 ft Field Note: NXDC, Cobbles Field Note: No Recovery. Stone in sampler				WH-2-3-R (5) 8-5-2-2 (7)	16.8	26.8	55.1	18.1
10	Field Note: NXDC, Cobbles A-2-4, GrSiSa, brn, Moist, Rec. = 1.5 ft				9-16-19-22 (35)	13.9	27.8	38.7	33.5
15	Field Note: NXDC, Cobbles A-1-b, SiSaGr, brn, Moist, Rec. = 0.6 ft				10-27-52-41 (79)	8.0	53.5	26.3	20.2
20	Field Note: NXDC, Boulder A-1-b, SiGrSa, brn, MTW, Rec. = 1.1 ft				4-10-18-17 (28)	10.8	38.5	38.9	22.6
25	Visual Classification, SiGrSa, brn, MTW, Rec. = 0.5 ft, Similar material as 19-21 ft. Field Note: NXDC, Boulder				R@6.0"	11.0			
30	A-1-b, SiGrSa, brn, MTW, Rec. = 1.2 ft				13-23-25-22 (48)	10.8	35.9	39.5	24.6
35	A-1-b, GrSa, brn, MTW, Rec. = 0.3 ft 33.8 ft - 35.2 ft, Grayish green, Chlorite-plagioclase-quartz-muscovite Schist, Moderately hard, Unweathered, Good rock, NXMDC, RMR = 79 35.2 ft - 38.8 ft, Grayish green, Chlorite-plagioclase-quartz-muscovite Schist, Moderately hard, Unweathered, Good rock, NXMDC, RMR = 79	1 (75)	100 (100)	6 (100)					
40	38.8 ft - 43.8 ft, Grayish green, Chlorite-plagioclase-quartz-muscovite Schist, Moderately hard, Unweathered, Good rock, NXMDC, RMR = 76	3 (75)	92 (74)	9 (74)					
45	Hole stopped @ 43.8 ft								

BOTTOM OF PILE CAP
ELEV. 718.00

ESTIMATED PILE
TIP ELEV. 690.00

BORING LOG 2 MIDDLESEX BRF 024-1(37).GPJ VERMONT AOT.GDT 10/28/14

Notes:
1. Stratification lines represent approximate boundary between material types. Transition may be gradual.
2. N Values have not been corrected for hammer energy. C is the hammer energy correction factor.
3. Water level readings have been made at times and under conditions stated. Fluctuations may occur due to other factors than those present at the time measurements were made.

STATE OF VERMONT AGENCY OF TRANSPORTATION MATERIALS & RESEARCH SECTION SUBSURFACE INFORMATION		BORING LOG		Boring No.: B-202				
MIDDLESEX BRF 024-1(37) VT-12 BR-77		Page No.: 1 of 1		Pin No.: 10C220				
Checked By: NSM		Casing		Sampler				
Groundwater Observations		Date		Depth (ft)				
Notes		Date		Depth (ft)				
Boring Crew: GARROW, SALISBURY, PORTER		Type: WB		SS				
Date Started: 1/26/12 Date Finished: 1/31/12		I.D.: 4 in		1.5 in				
VTSPG NAD83: N 660793.58 ft E 1619918.87 ft		Hammer Wt: N.A.		140 lb.				
Station: 29+46.53 Offset: -21.09		Hammer Fall: N.A.		30 in.				
Ground Elevation: 724.0 ft		Hammer/Rod Type: Auto/AWJ		Rig: CME 45C TRACK C = 1.34				
Depth (ft)	Strata (1)	Blows/6" (N Value)	Moisture Content %	Gravel %	Sand %	Fines %	LL %	PI %
5	Field Note: NXDC, Sand, No Recovery. A-1-b, SaGr, brn, Moist, Rec. = 1.2 ft	1-3-5-4 (8)	15.4	41.4	39.7	18.9		
10	Field Note: NXDC, Gravel, No Recovery. A-1-b, GrSa, brn, Moist, Rec. = 1.5 ft	12-20-19-17 (39)	16.0	36.9	45.4	17.7		
15	Field Note: NXDC, Cobbles A-4, Si, gry, Moist, Rec. = 1.5 ft	3-3-2-3 (5)	40.4	0.3	2.2	97.5	38	6
20	A-4, GrSaSi, brn, Moist, Rec. = 1.5 ft Field Note: NXDC, Gravel, No Recovery.	10-11-14-16 (25) 16-19-17-15 (36)	13.3	23.8	35.5	40.7		
30	Field Note: NXDC, Cobbles A-1-b, SiGrSa, gry, Moist, Rec. = 1.0 ft, Broken rock was within sample. Field Note: NXDC, Cobbles	8-16-22-R@2.5"	7.5	38.7	39.9	21.4		
35	Field Note: NXDC, Cobbles A-2-4, GrSiSa, brn, Moist, Rec. = 0.9 ft	5-5-6-8 (11)	13.1	20.1	46.0	33.9		
40	Field Note: NXDC, Cobbles							
45	A-2-4, SaSiGr (HP), gry, MTD, Rec. = 1.2 ft Field Note: NXDC, Gravel, No Recovery. A-4, GrSaSi (HP), gry, MTD, Rec. = 0.5 ft	32-40-30-R@0.0" R@6.0"	8.5	36.9	27.8	35.3		
50	Hole stopped @ 48.5 ft No Ledge to Depth.							


BOTTOM OF PILE CAP
ELEV. 718.00

ESTIMATED PILE
TIP ELEV. 665.00


BORING LOG 2 MIDDLESEX BRF 024-1(37).GPJ VERMONT AOT.GDT 10/28/14

Notes:
1. Stratification lines represent approximate boundary between material types. Transition may be gradual.
2. N Values have not been corrected for hammer energy. C is the hammer energy correction factor.
3. Water level readings have been made at times and under conditions stated. Fluctuations may occur due to other factors than those present at the time measurements were made.

PROJECT NAME: MIDDLESEX
PROJECT NUMBER: BRF 024-1(37)
FILE NAME: si0c220bor.dgn PLOT DATE: 13-JAN-2015
PROJECT LEADER: C. CARLSON DRAWN BY: C. BURRALL
DESIGNED BY: MATERIALS & RESEARCH CHECKED BY: H. SALLS
BORING LOGS SHEET 17 OF 46

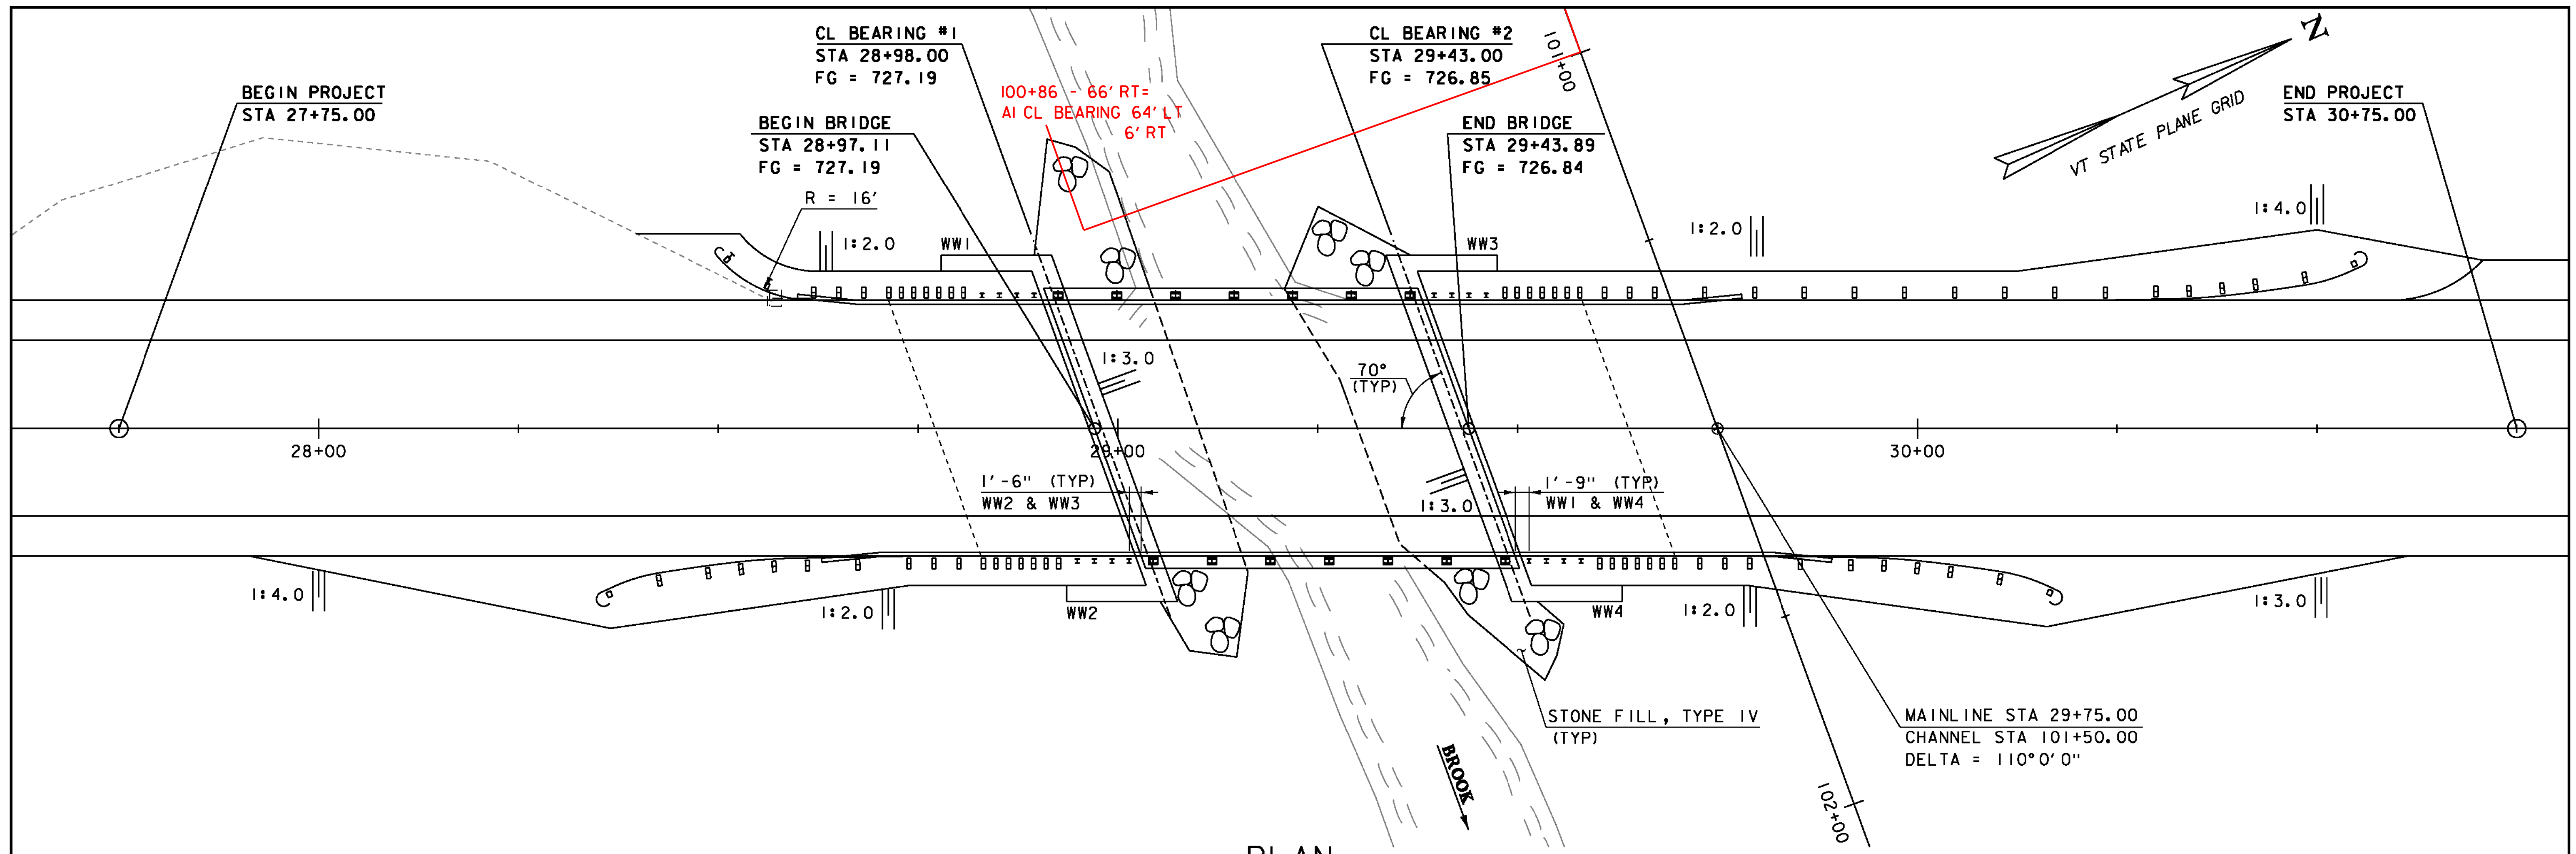


PLAN

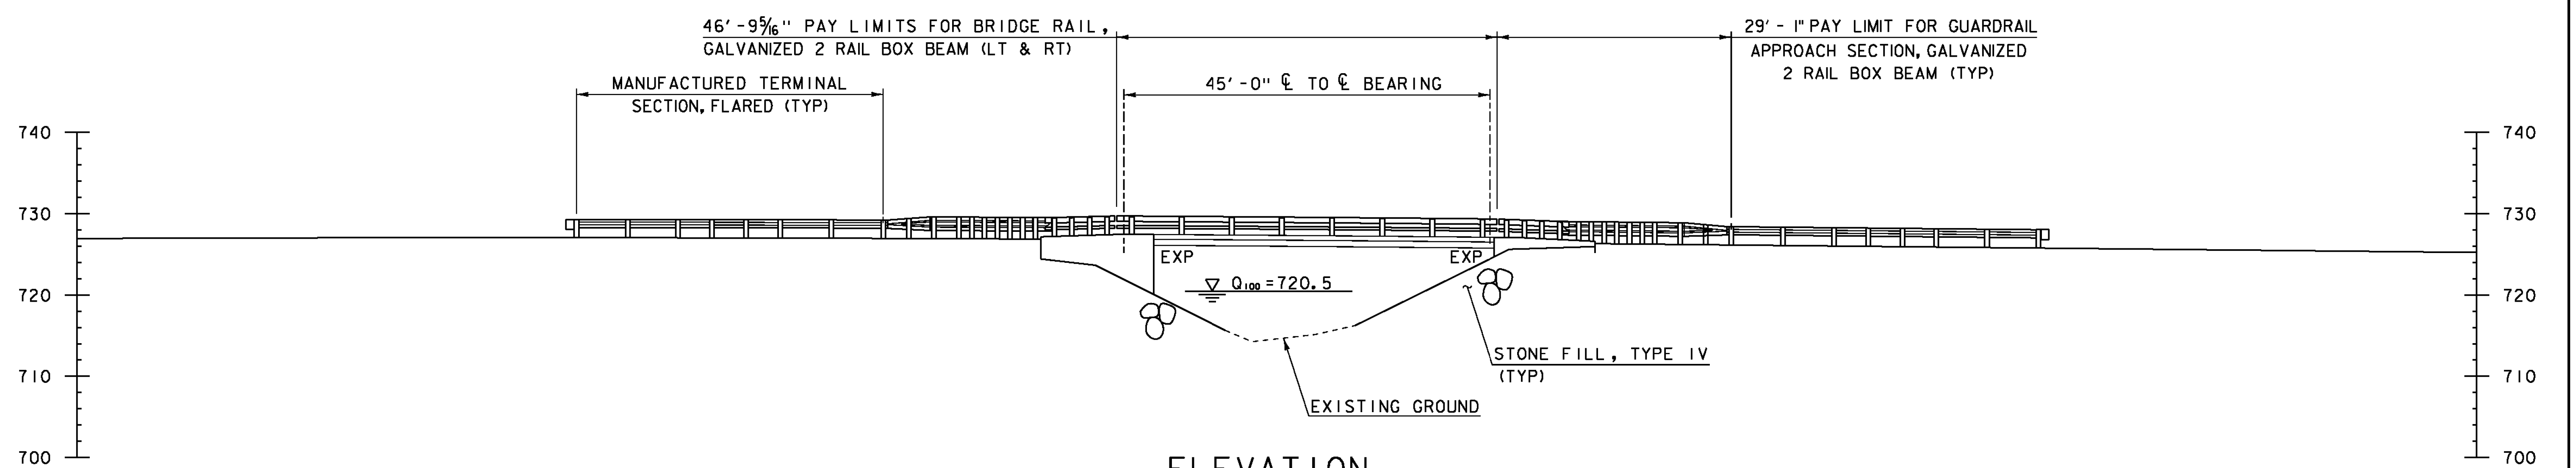

ELEVATION


SCALE 1" = 10' - 0"

PROJECT NAME: MIDDLESEX	PLOT DATE: 13-JAN-2015
PROJECT NUMBER: BRF 024-1(37)	DRAWN BY: R. PELLETT
FILE NAME: s10c220pe.dgn	CHECKED BY: H. SALLS
PROJECT LEADER: C. CARLSON	SHEET 18 OF 46
DESIGNED BY: H. SALLS	
PLAN & ELEVATION	

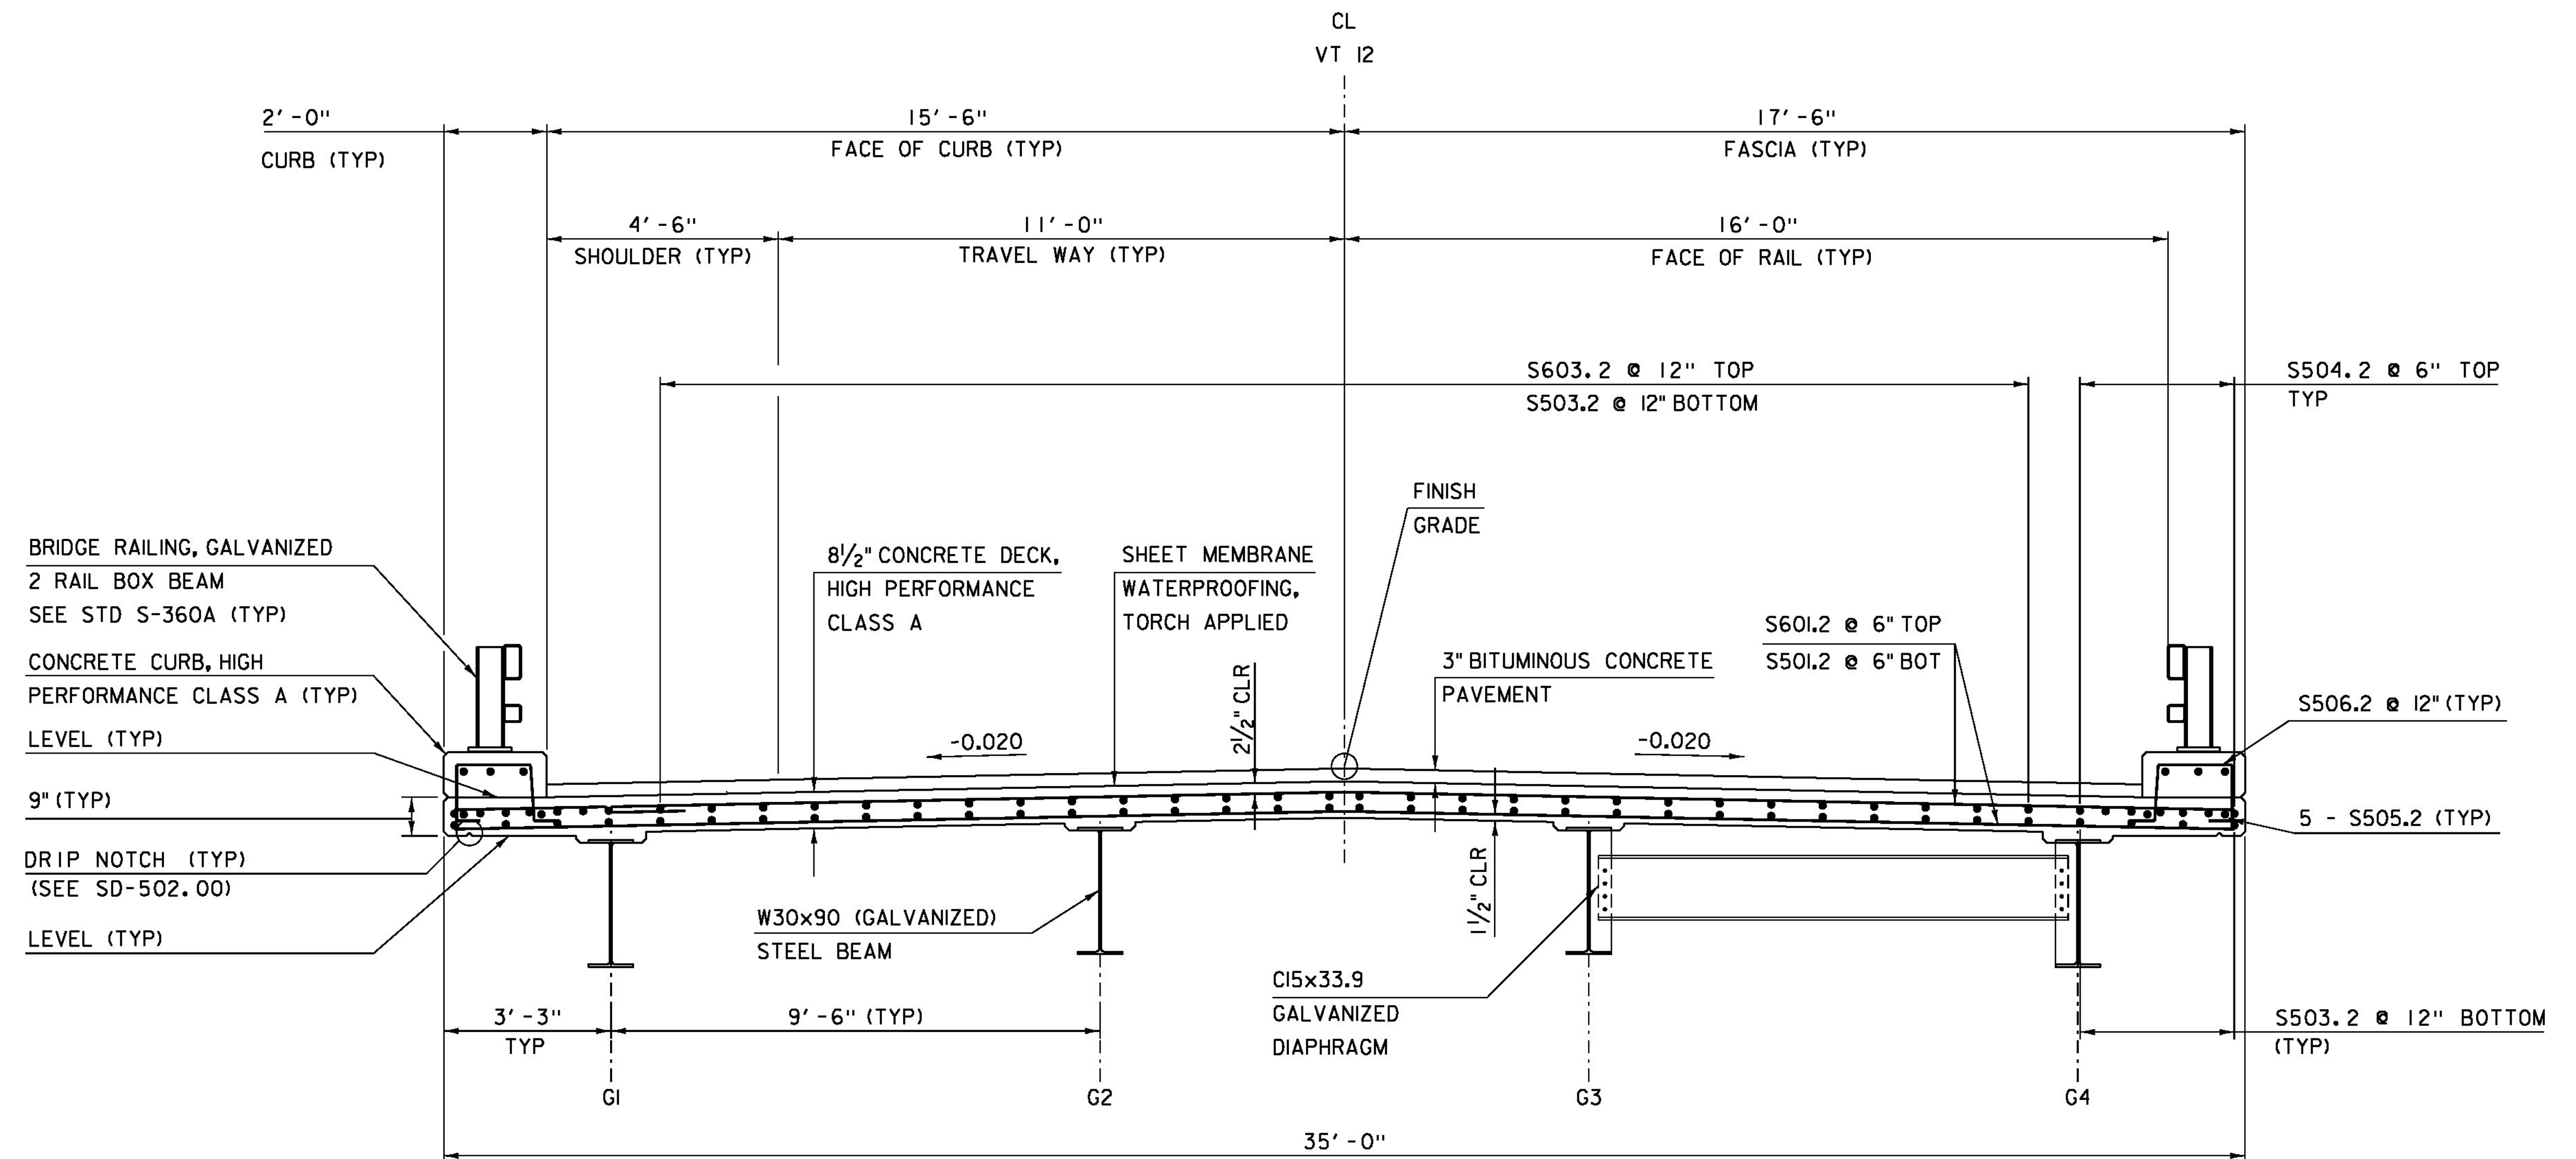

DECK REINFORCING SECTION
SCALE 1/2" = 1'-0"

PROJECT NAME:	MIDDLESEX
PROJECT NUMBER:	BRF 024-1(37)
FILE NAME:	sl0c220sup.dgn
PROJECT LEADER:	C. CARLSON
DESIGNED BY:	H. SALLS
DECK REINFORCING SECTION	
PLOT DATE:	13-JAN-2015
DRAWN BY:	C. BURRALL
CHECKED BY:	H. SALLS
SHEET	19 OF 46

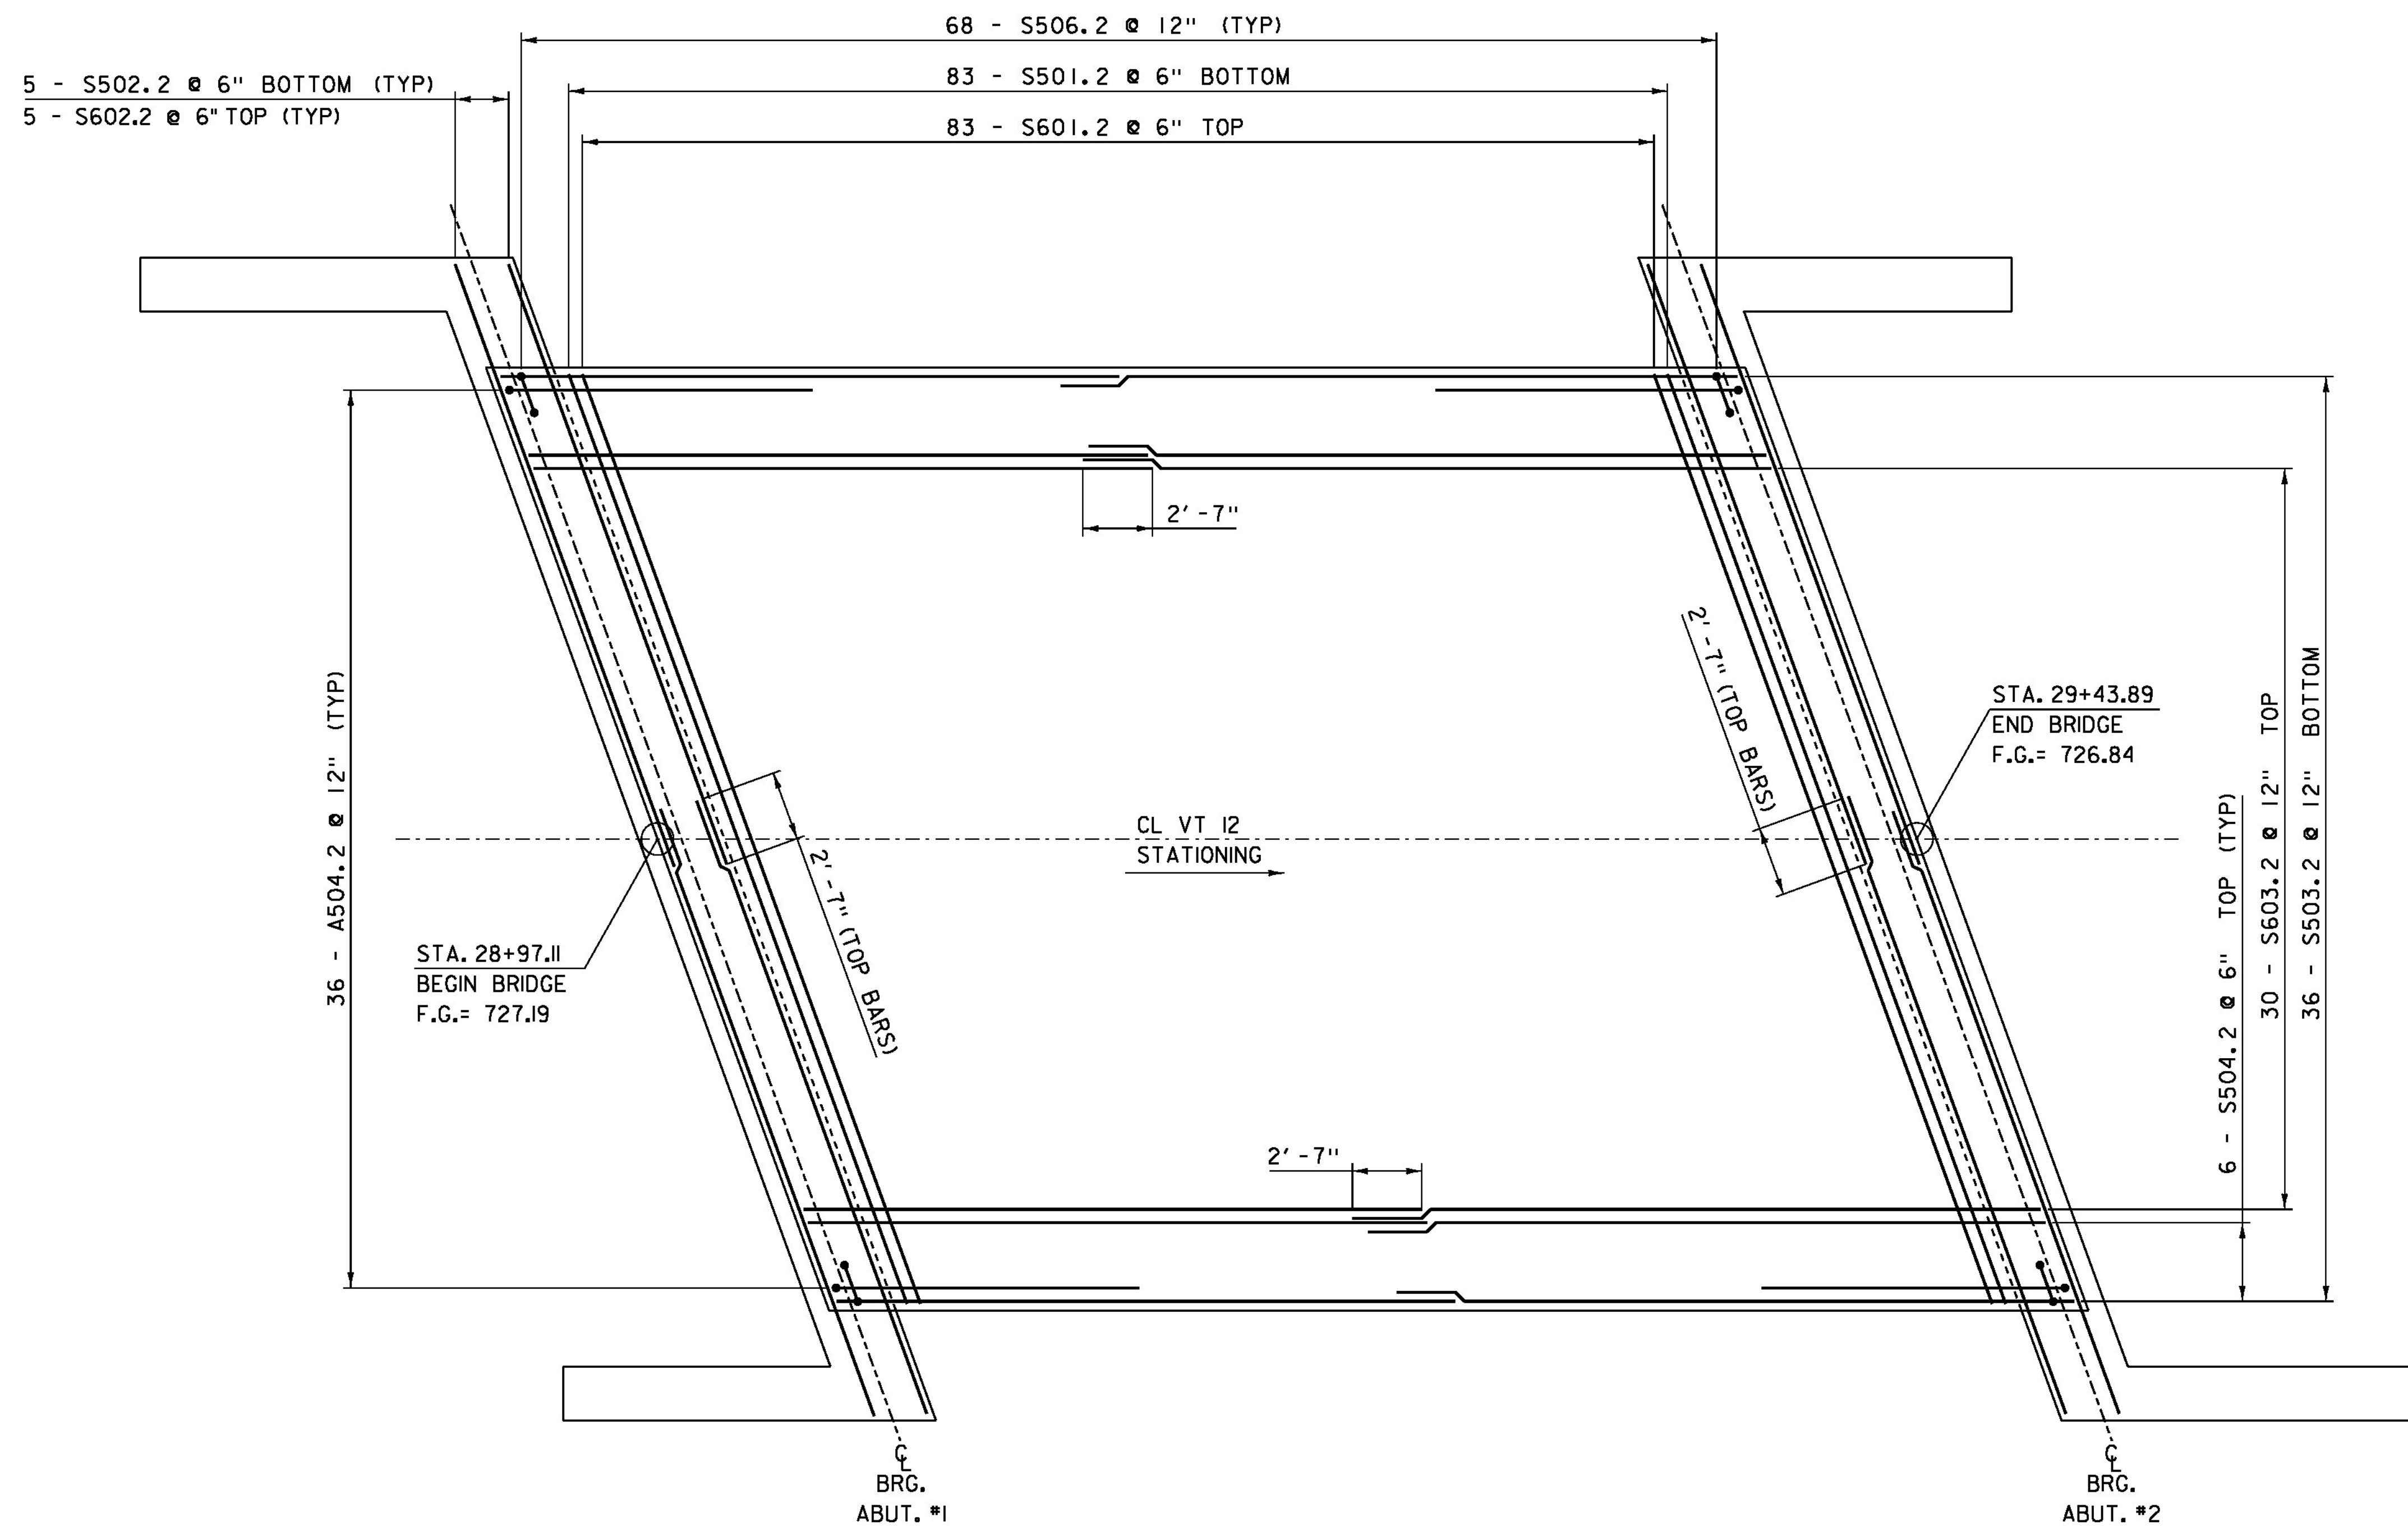

DECK REINFORCING PLAN


SCALE 1/4" = 1' - 0"

NOTES:


- NF = NEAR FACE
- FF = FAR FACE
- EF = EACH FACE
- ▲ = CUT TO FIT IN FIELD
- 3" CLEAR, UNLESS OTHERWISE SPECIFIED ON THE PLANS.
- 2'-2" BAR LAP UNLESS OTHERWISE SPECIFIED ON THE PLANS.

ALL REINFORCEMENT FOR BRIDGE RAIL NOT SHOWN FOR CLARITY SEE STD S-360A.

PROJECT NAME:	MIDDLESEX
PROJECT NUMBER:	BRF 024-1(37)
FILE NAME:	sl0c220sup.dgn
PROJECT LEADER:	C. CARLSON
DESIGNED BY:	H. SALLS
DECK REINFORCING PLAN	
PLOT DATE:	13-JAN-2015
DRAWN BY:	C. BURRALL
CHECKED BY:	H. SALLS
SHEET	20 OF 46

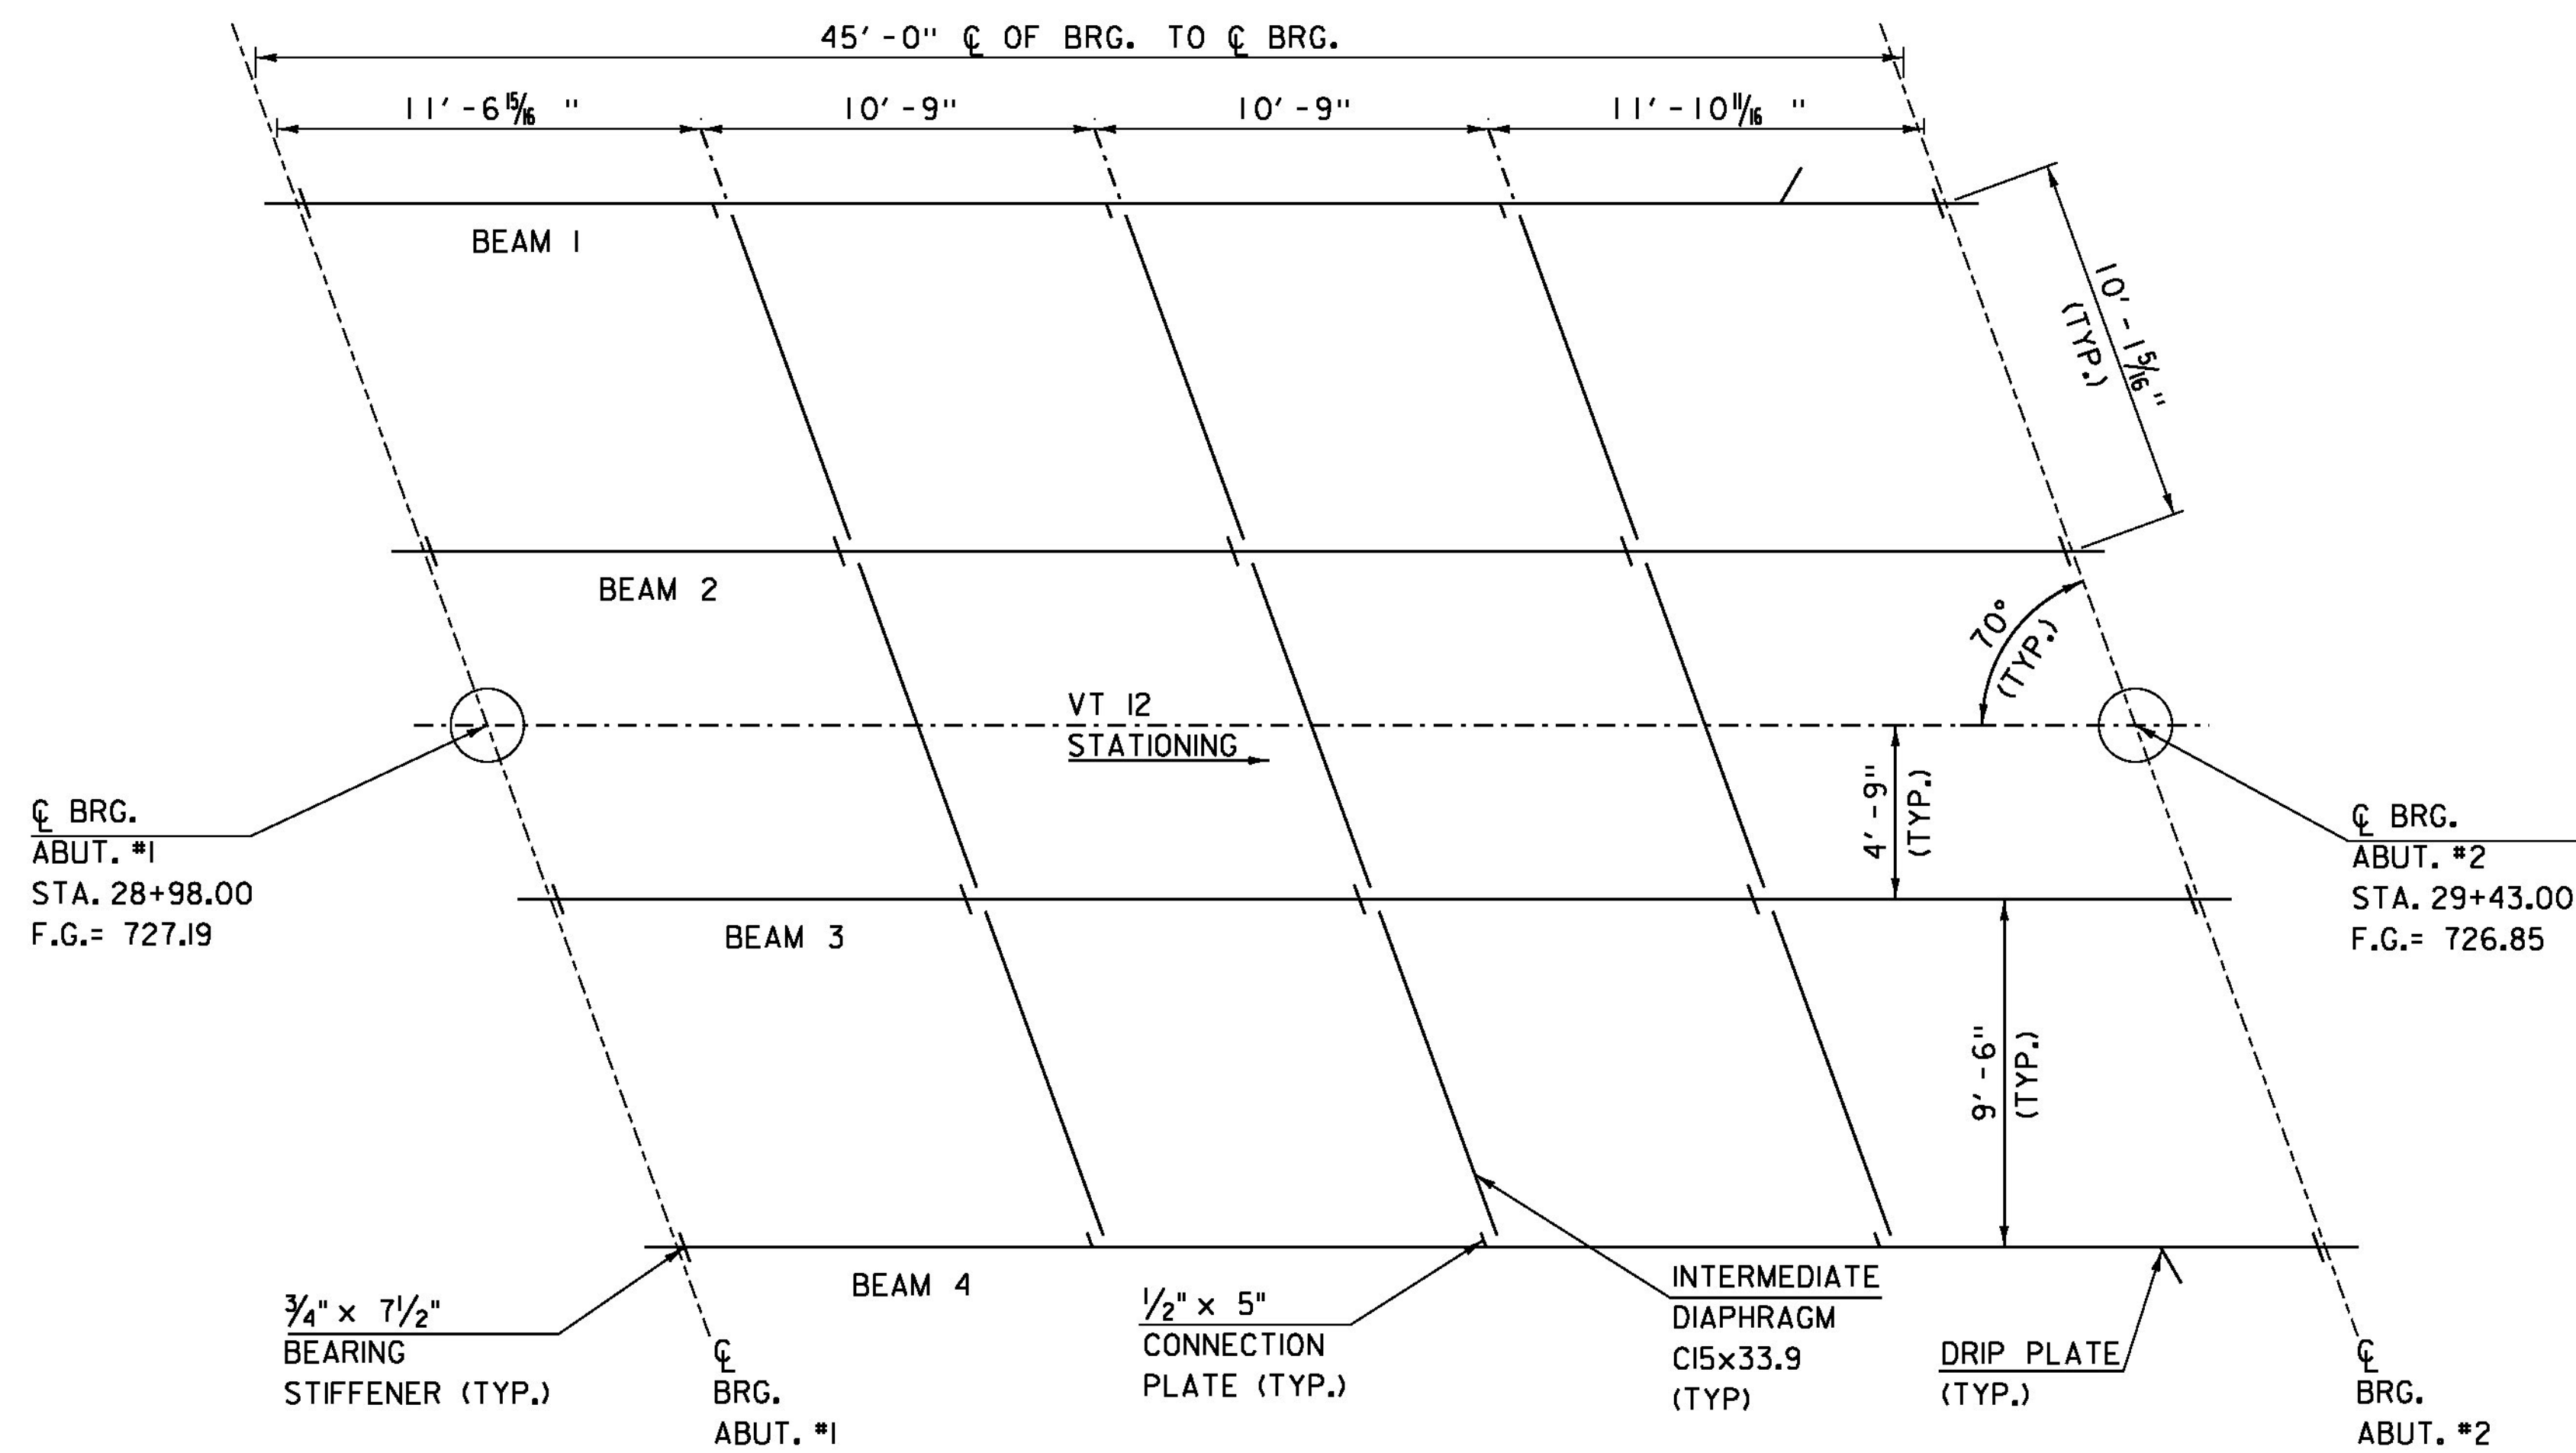

FRAMING PLAN
SCALE $\frac{1}{4}$ " = 1' - 0"

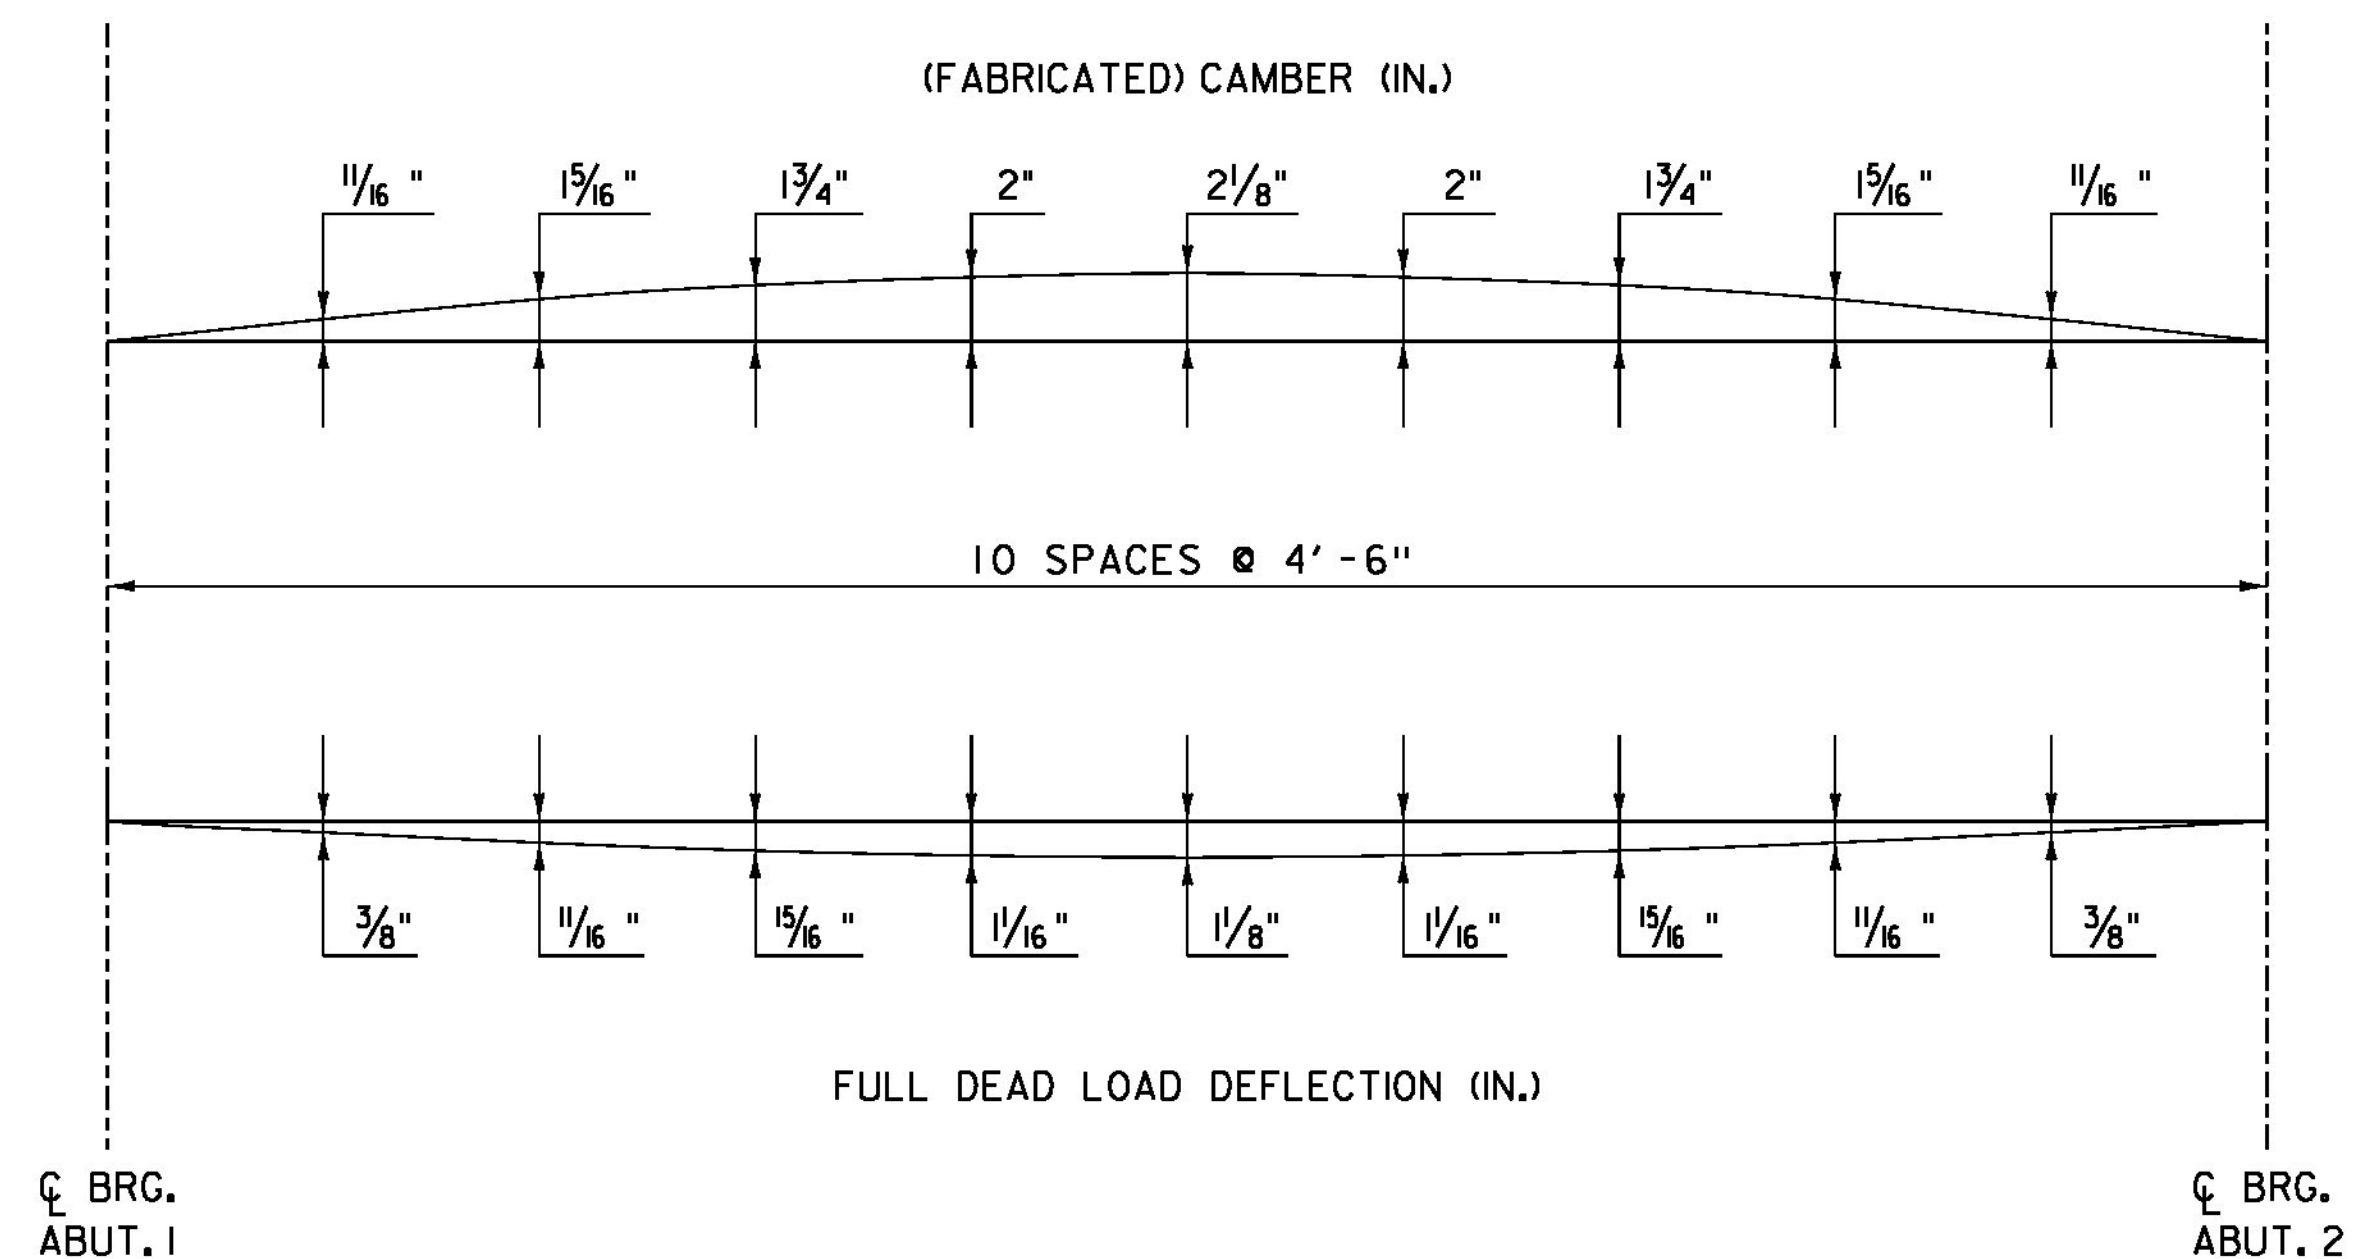


CAMBER AND DEAD LOAD DEFLECTION

HORIZONTAL SCALE $\frac{1}{4}$ " = 1' - 0"
VERTICAL SCALE 2" = 1' - 0"

NOTES:

1. SEE STRUCTURES DETAIL SHEET SD-601 FOR DRIP PLATE DETAILS.
2. SEE STRUCTURES DETAIL SHEET SD-602 FOR DIAPHRAGM, CONNECTION PLATE, AND STIFFENER DETAILS.
3. DEAD LOAD DEFLECTION INCLUDES: BEAM, DIAPHRAGMS, DECK & BRIDGE RAIL.
4. CVN - SHALL MEET CHARPY V-NOTCH REQUIREMENTS FOR MAIN MEMBERS AS SPECIFIED IN SECTION 714.



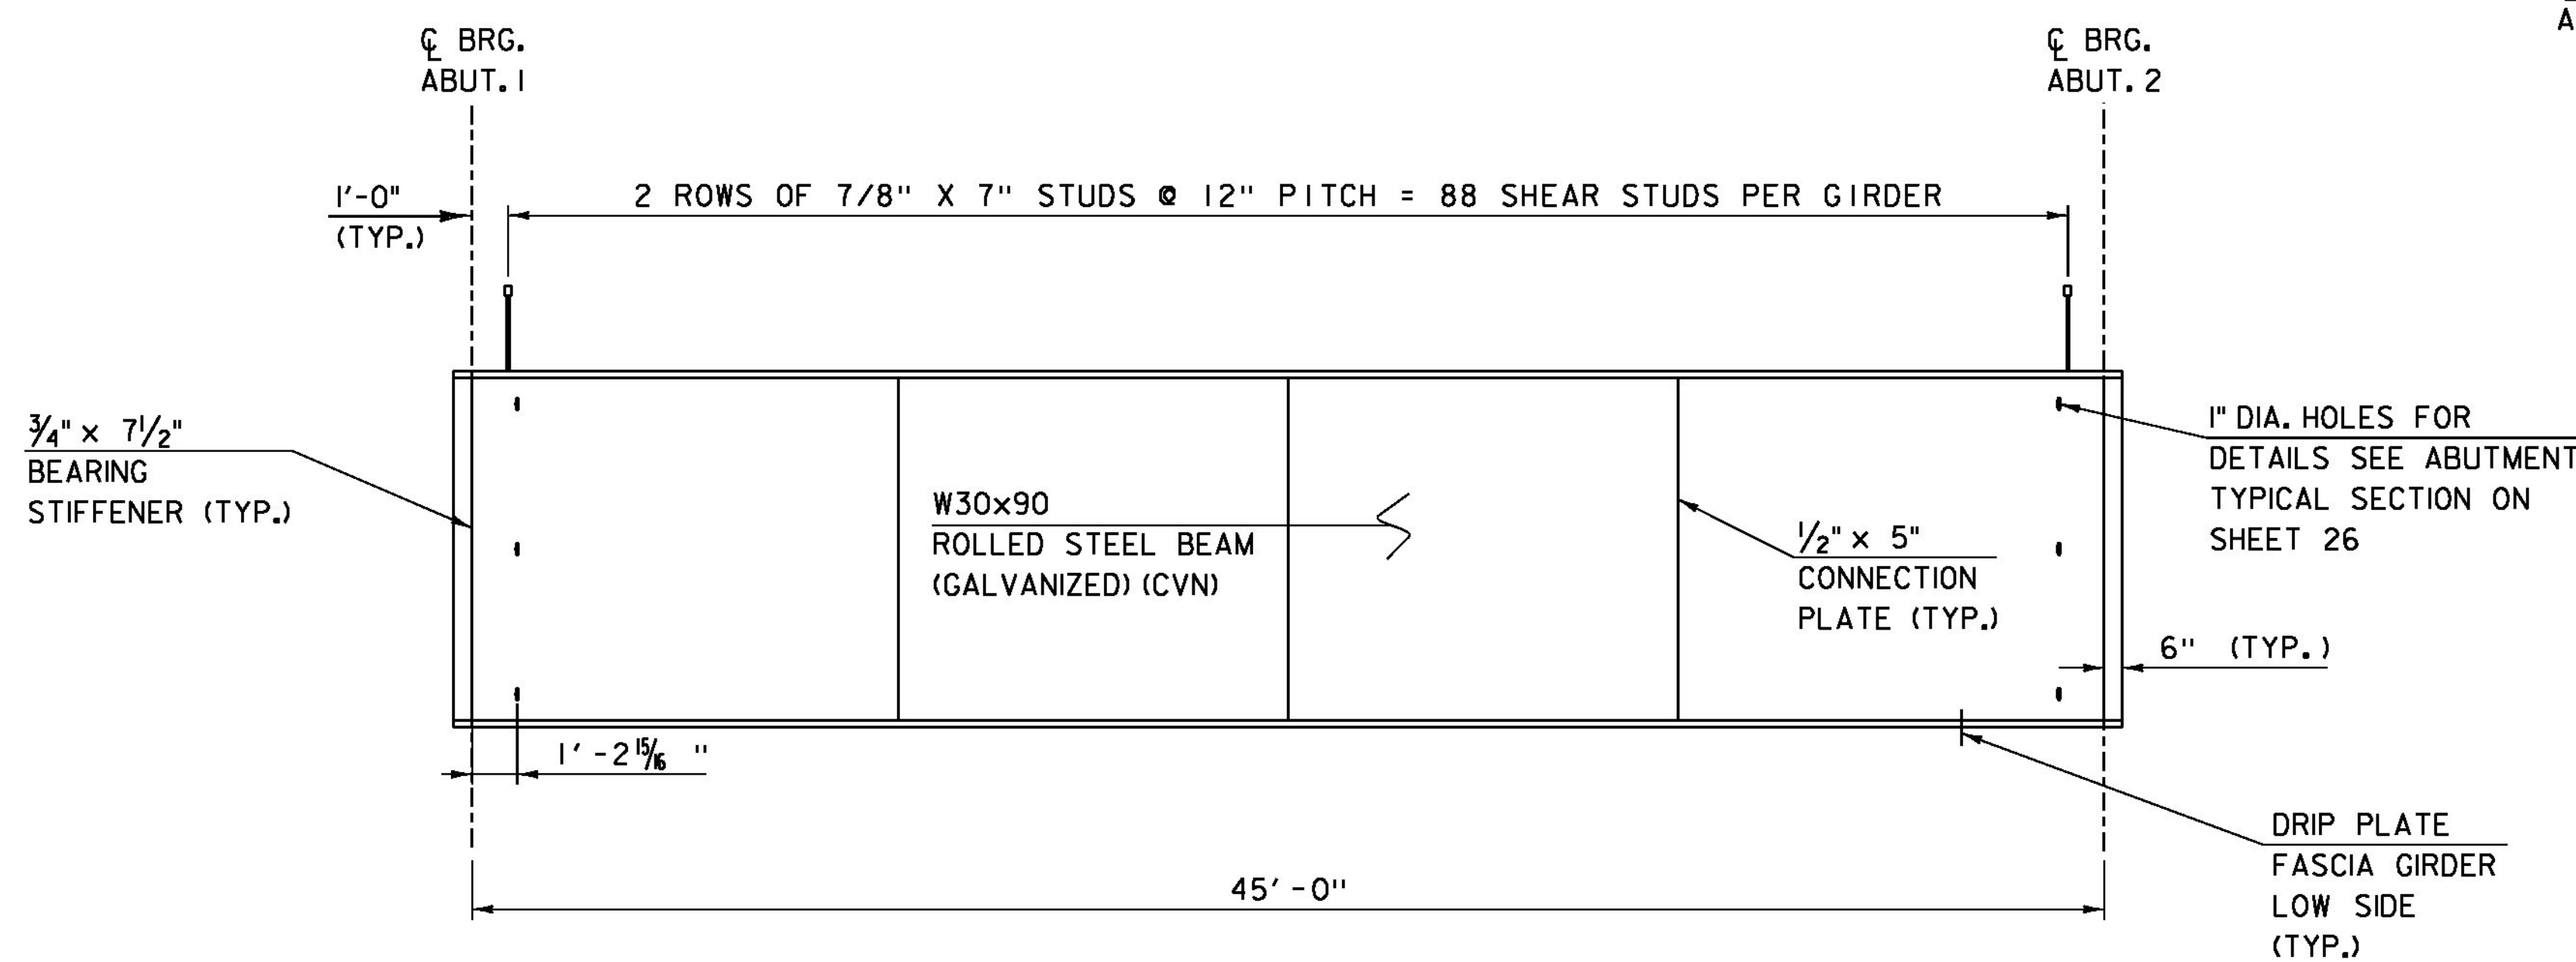


GIRDER ELEVATION
HORIZONTAL SCALE $\frac{1}{4}$ " = 1' - 0"
VERTICAL SCALE 1" = 1' - 0"

PROJECT NAME: MIDDLESEX
PROJECT NUMBER: BRP 024-1(37)

FILE NAME: sl0c220sup.dgn
PROJECT LEADER: C. CARLSON
DESIGNED BY: H. SALLS
FRAMING PLAN




PLOT DATE: 13-JAN-2015
DRAWN BY: C. BURRALL
CHECKED BY: H. SALLS
SHEET 21 OF 46

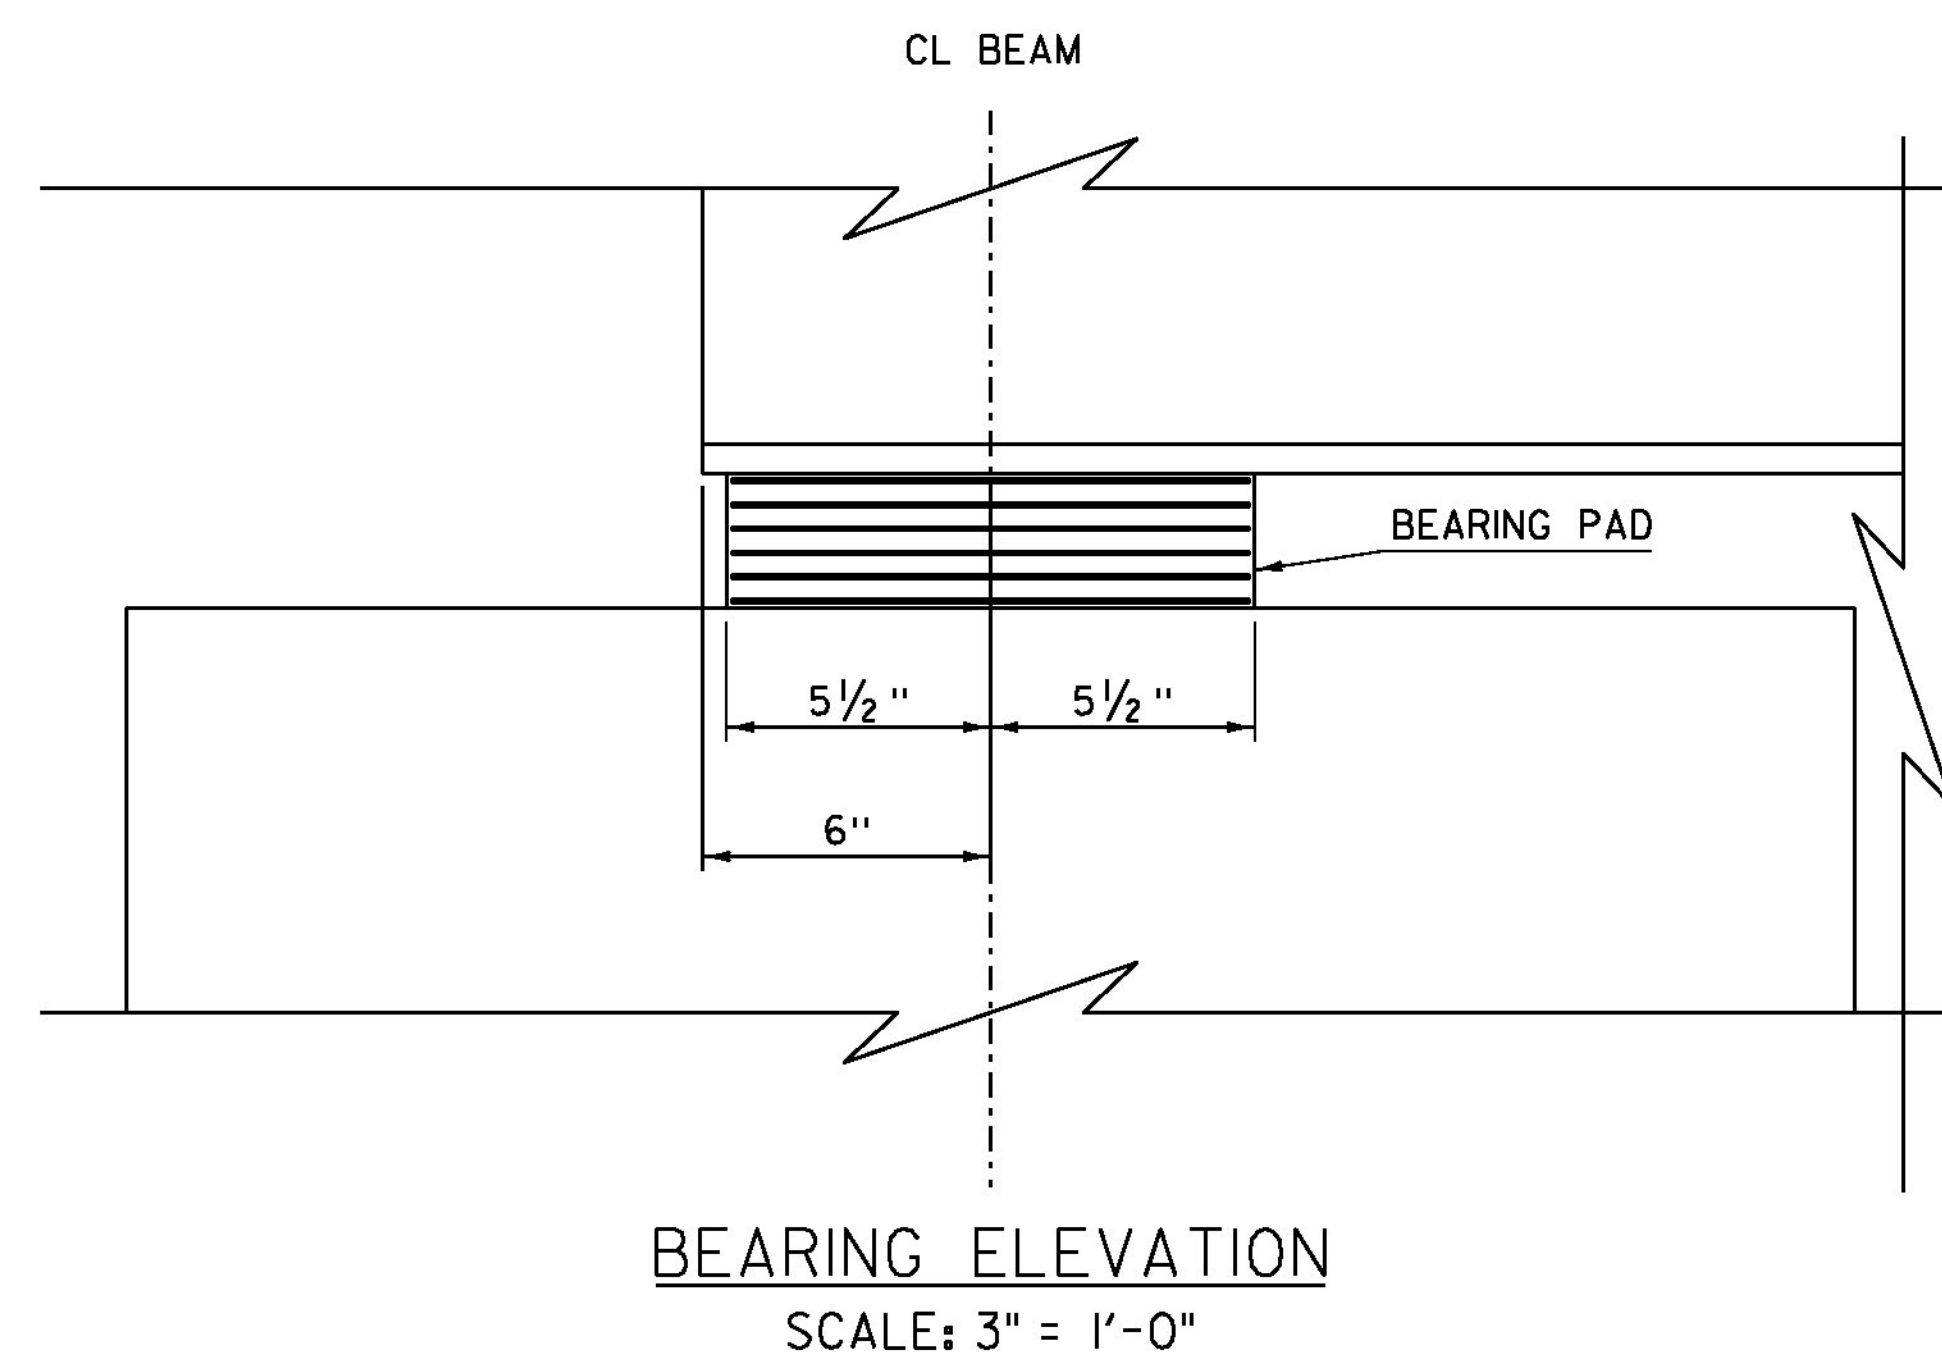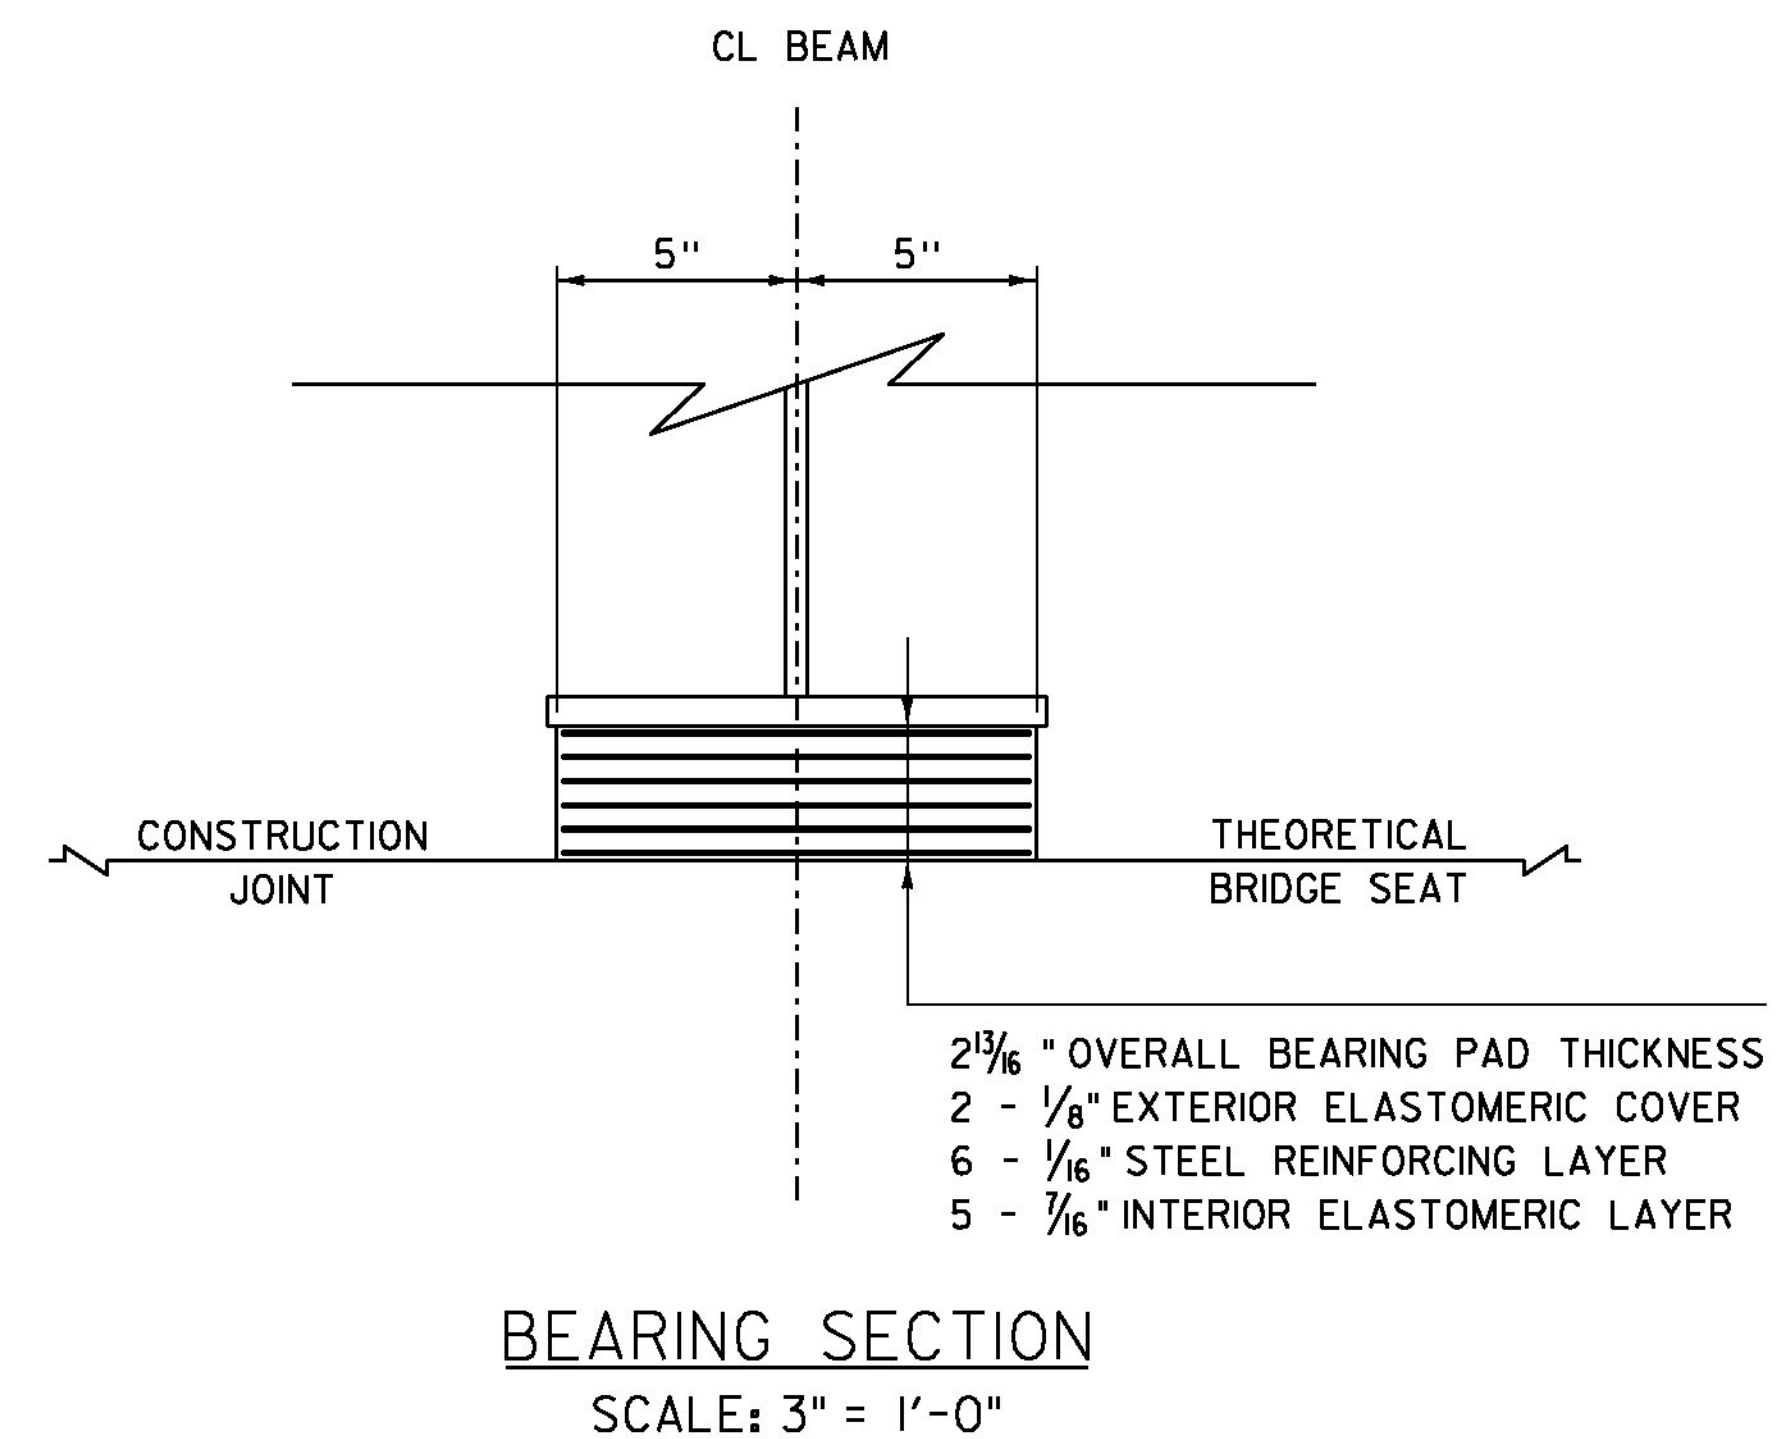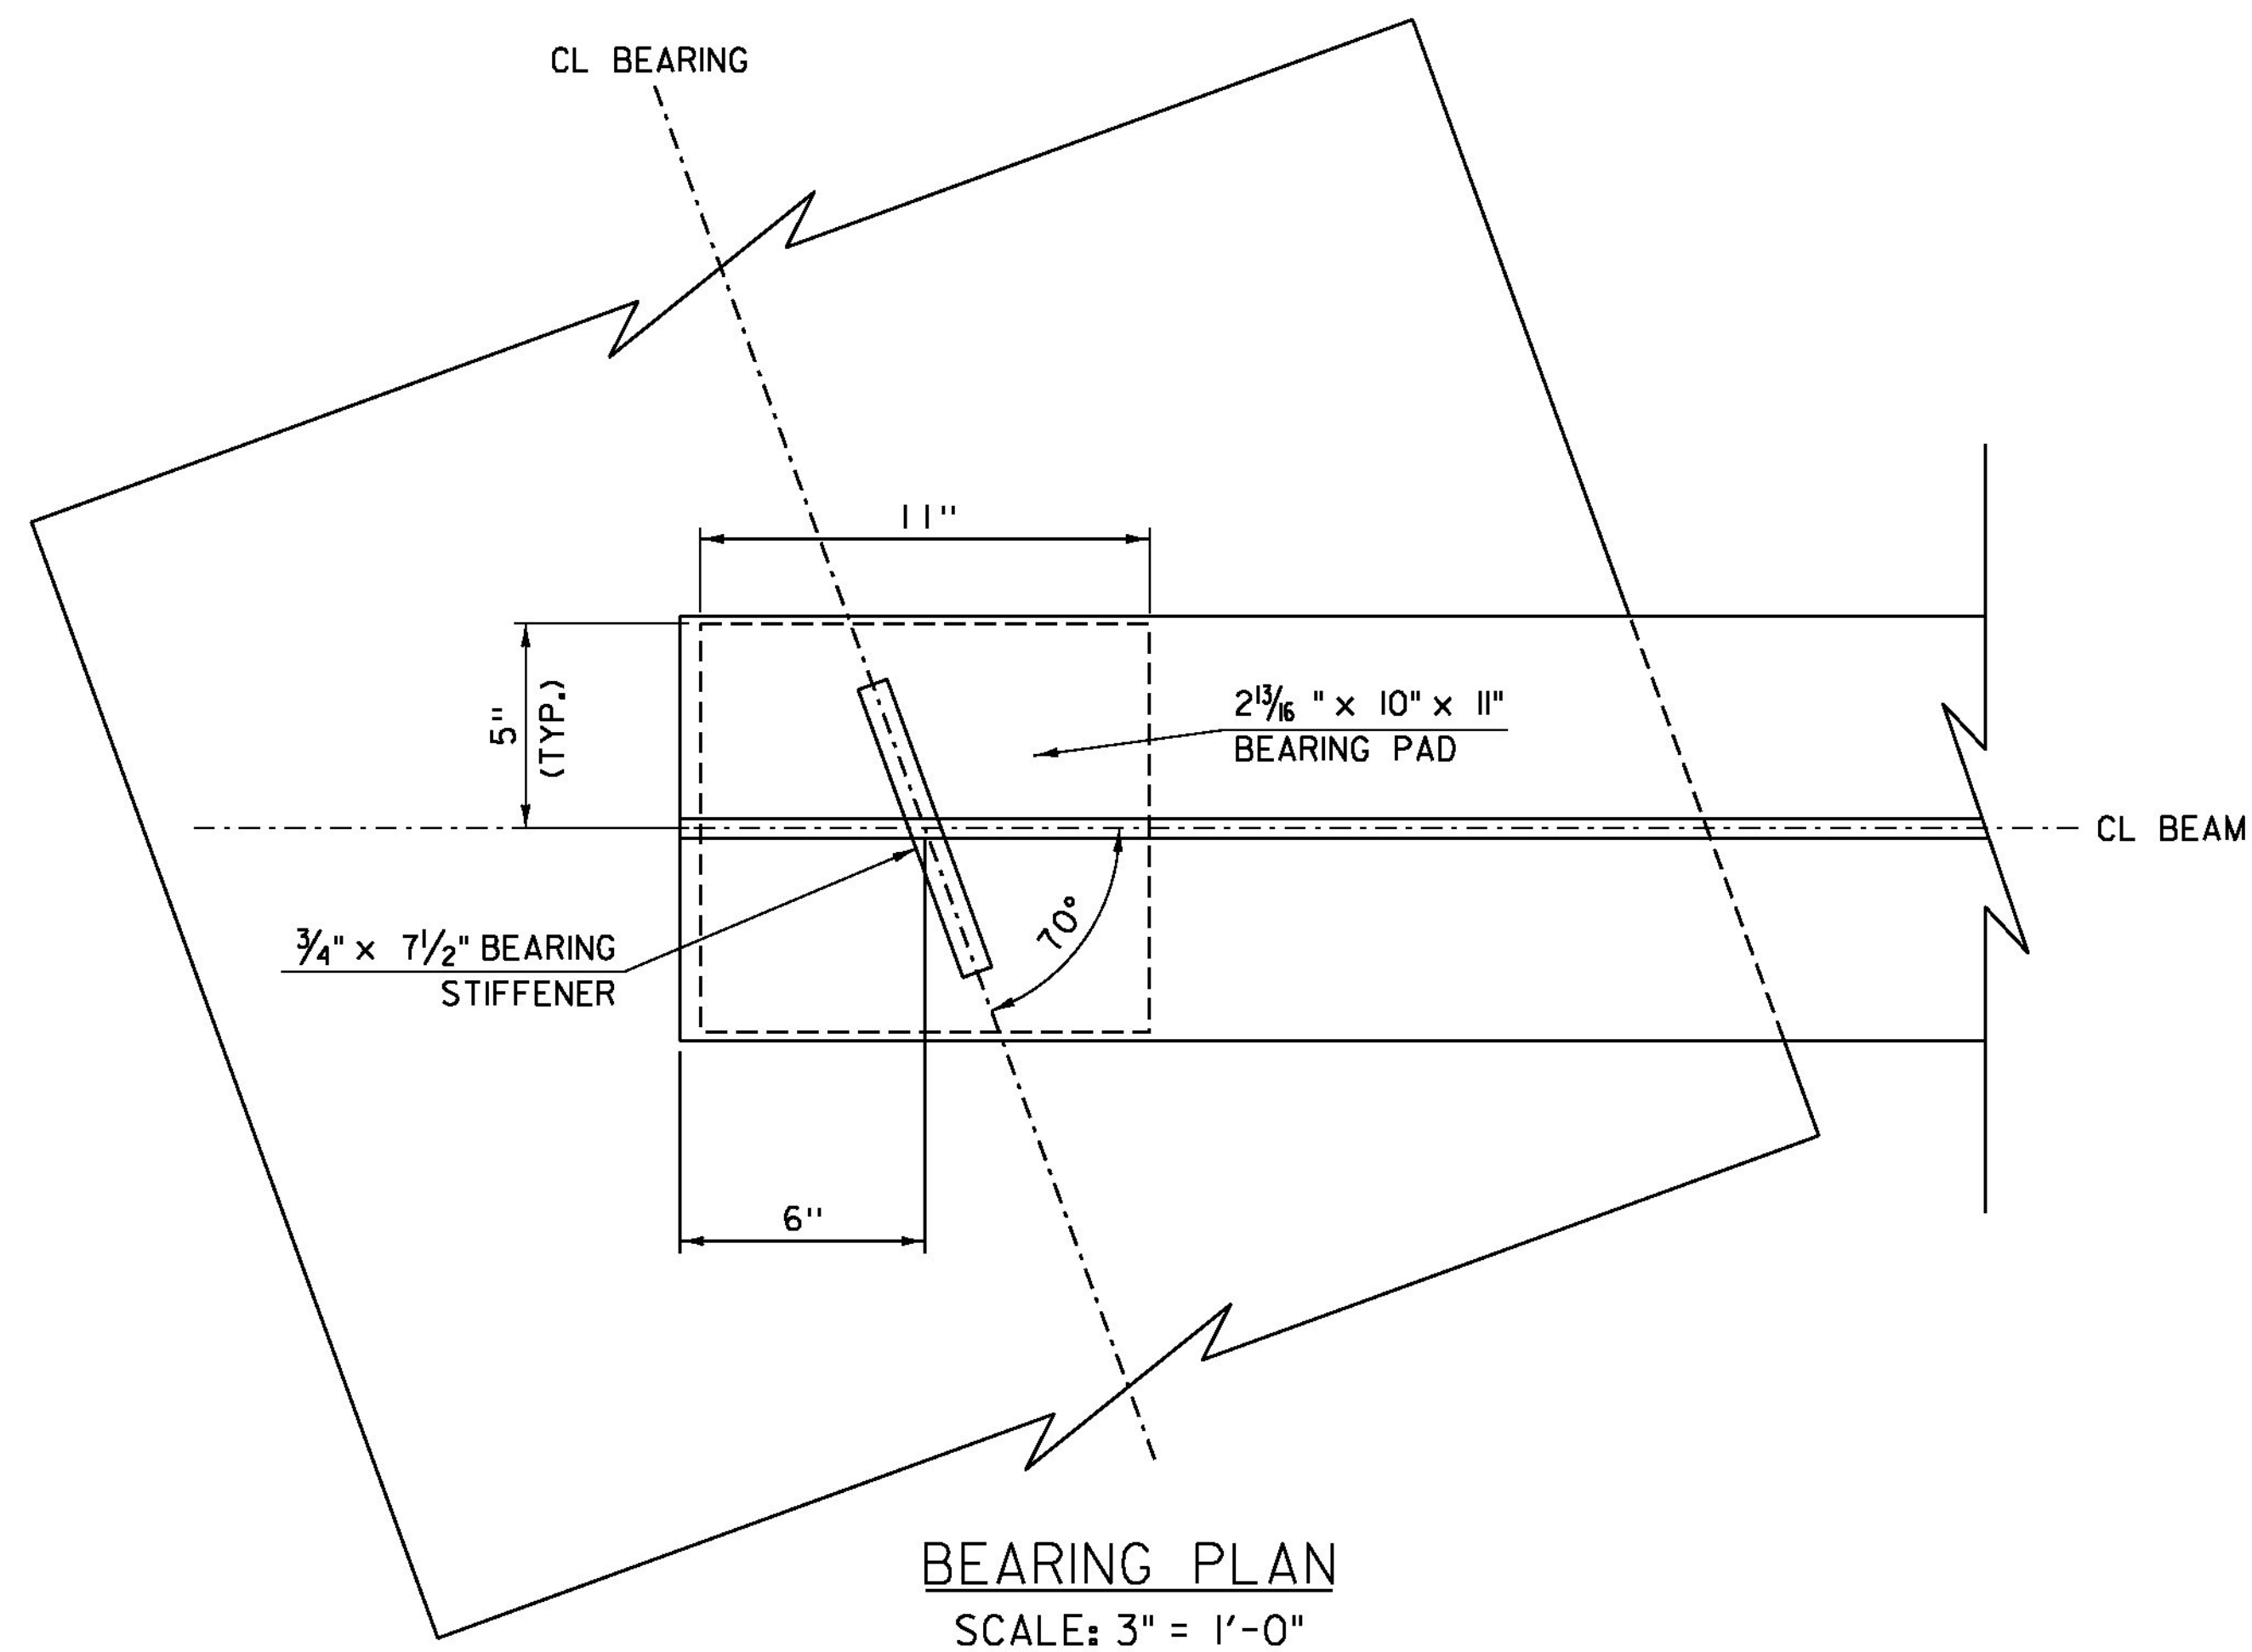

BEARING DEVICE NOTES

1. BEARINGS SHALL BE PAID FOR UNDER ITEM 531.17 "BEARING DEVICE ASSEMBLY, STEEL REINFORCED ELASTOMERIC PAD" AND SHALL CONFORM TO APPLICABLE SUBSECTIONS OF SECTIONS 531 AND 731.
2. ALL REINFORCEMENT BETWEEN LAYERS OF ELASTOMERIC SHALL BE STEEL MEETING ASTM A36. ALL INTERNAL STEEL PLATES SHALL BE SAND BLASTED AND FREE OF COATINGS, RUST, AND MILL SCALE. THE PLATES SHALL BE FREE OF SHARP EDGES AND BURRS.
3. STEEL REINFORCED ELASTOMERIC PAD BEARINGS SHALL HAVE A MINIMUM OF 1/8" EDGE SEAL OF ELASTOMER INTEGRAL WITH THE BEARING OVER ALL INTERNAL PLATES.


PROJECT NAME: MIDDLESEX	PLOT DATE: 13-JAN-2015
PROJECT NUMBER: BRF 024-1(37)	DRAWN BY: C. BURRALL
FILE NAME: sl0c220sup.dgn	CHECKED BY: H. SALLS
PROJECT LEADER: C. CARLSON	SHEET 22 OF 46
DESIGNED BY: H. SALLS	
BEARING DETAILS	

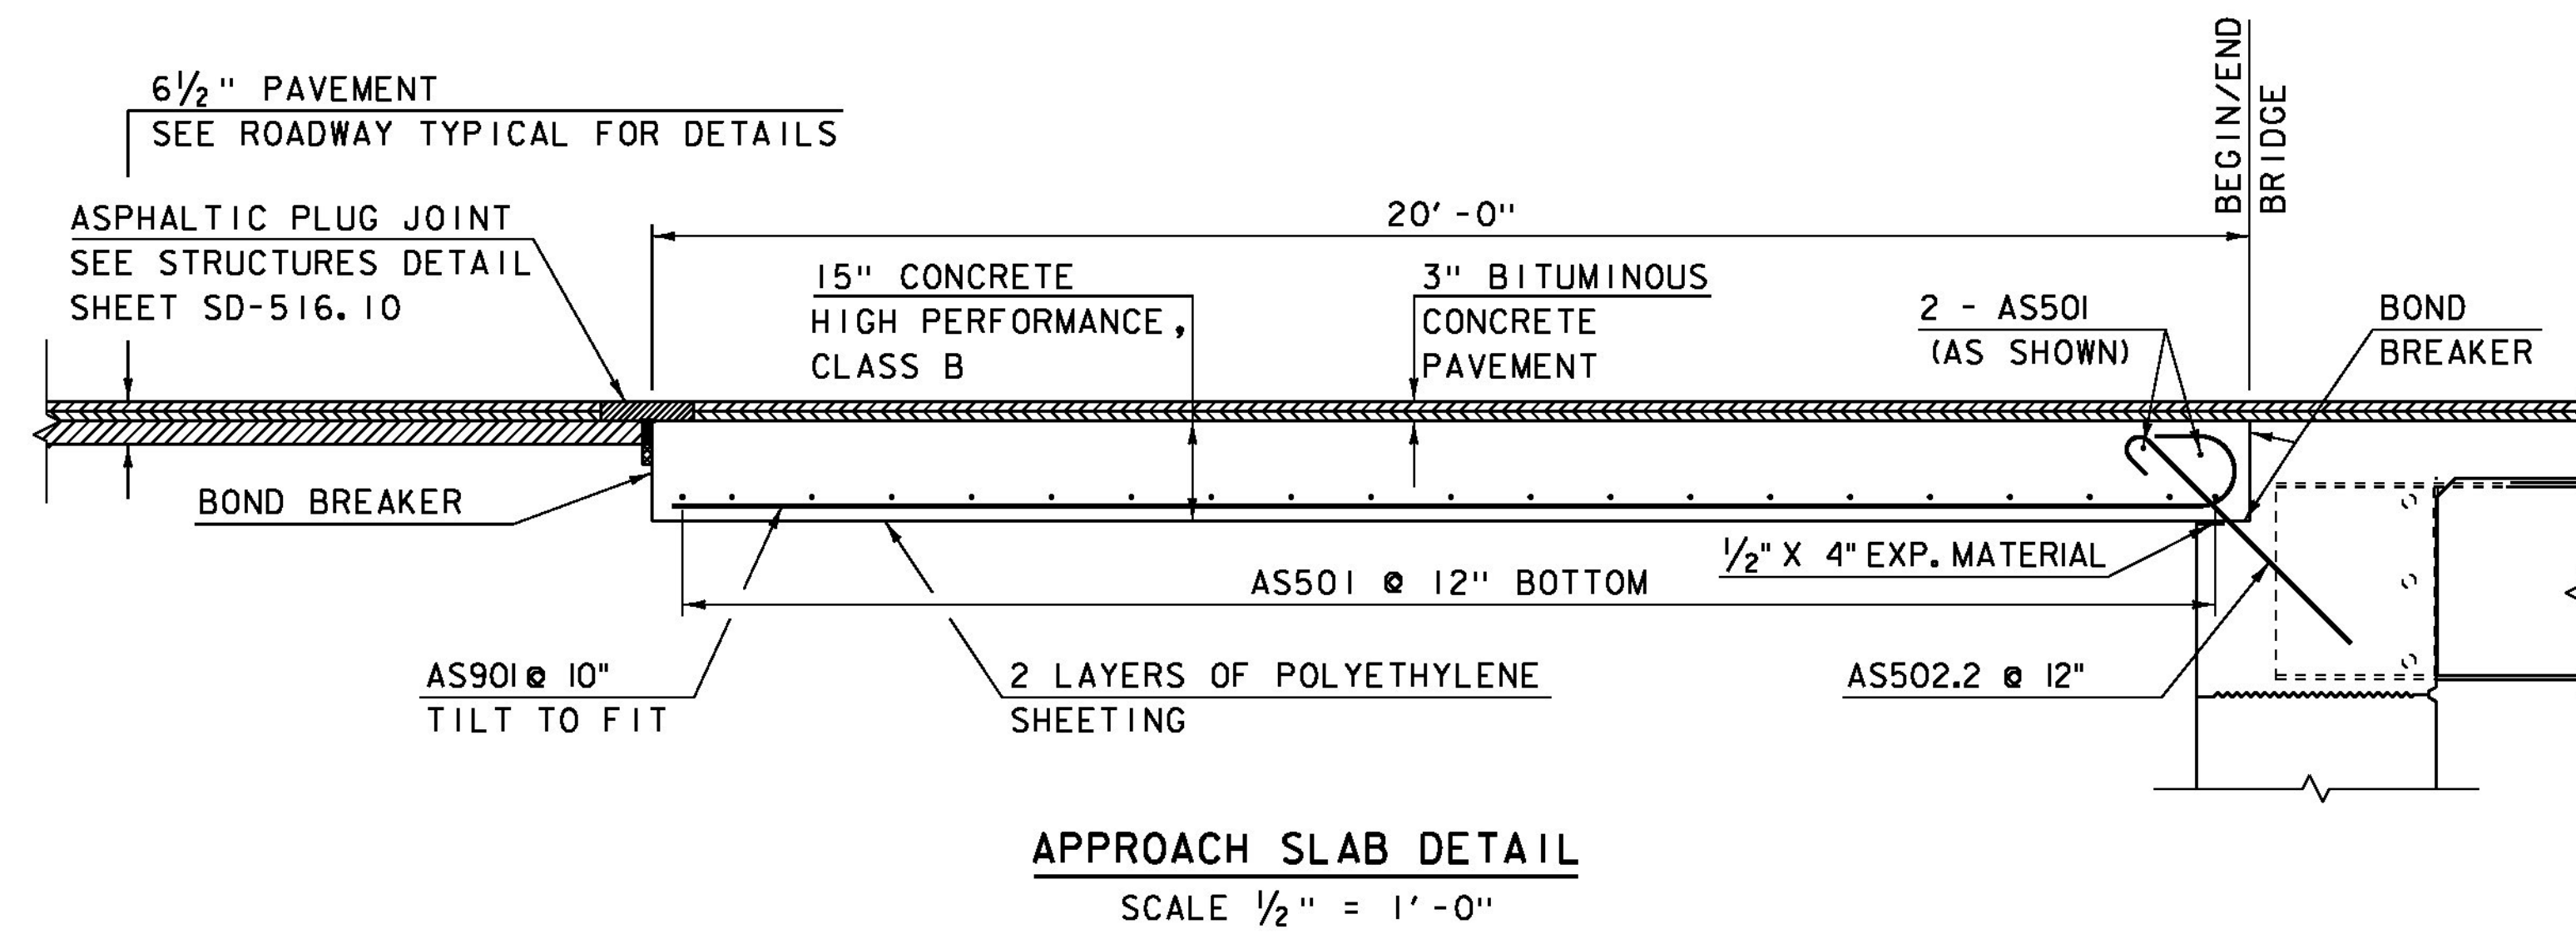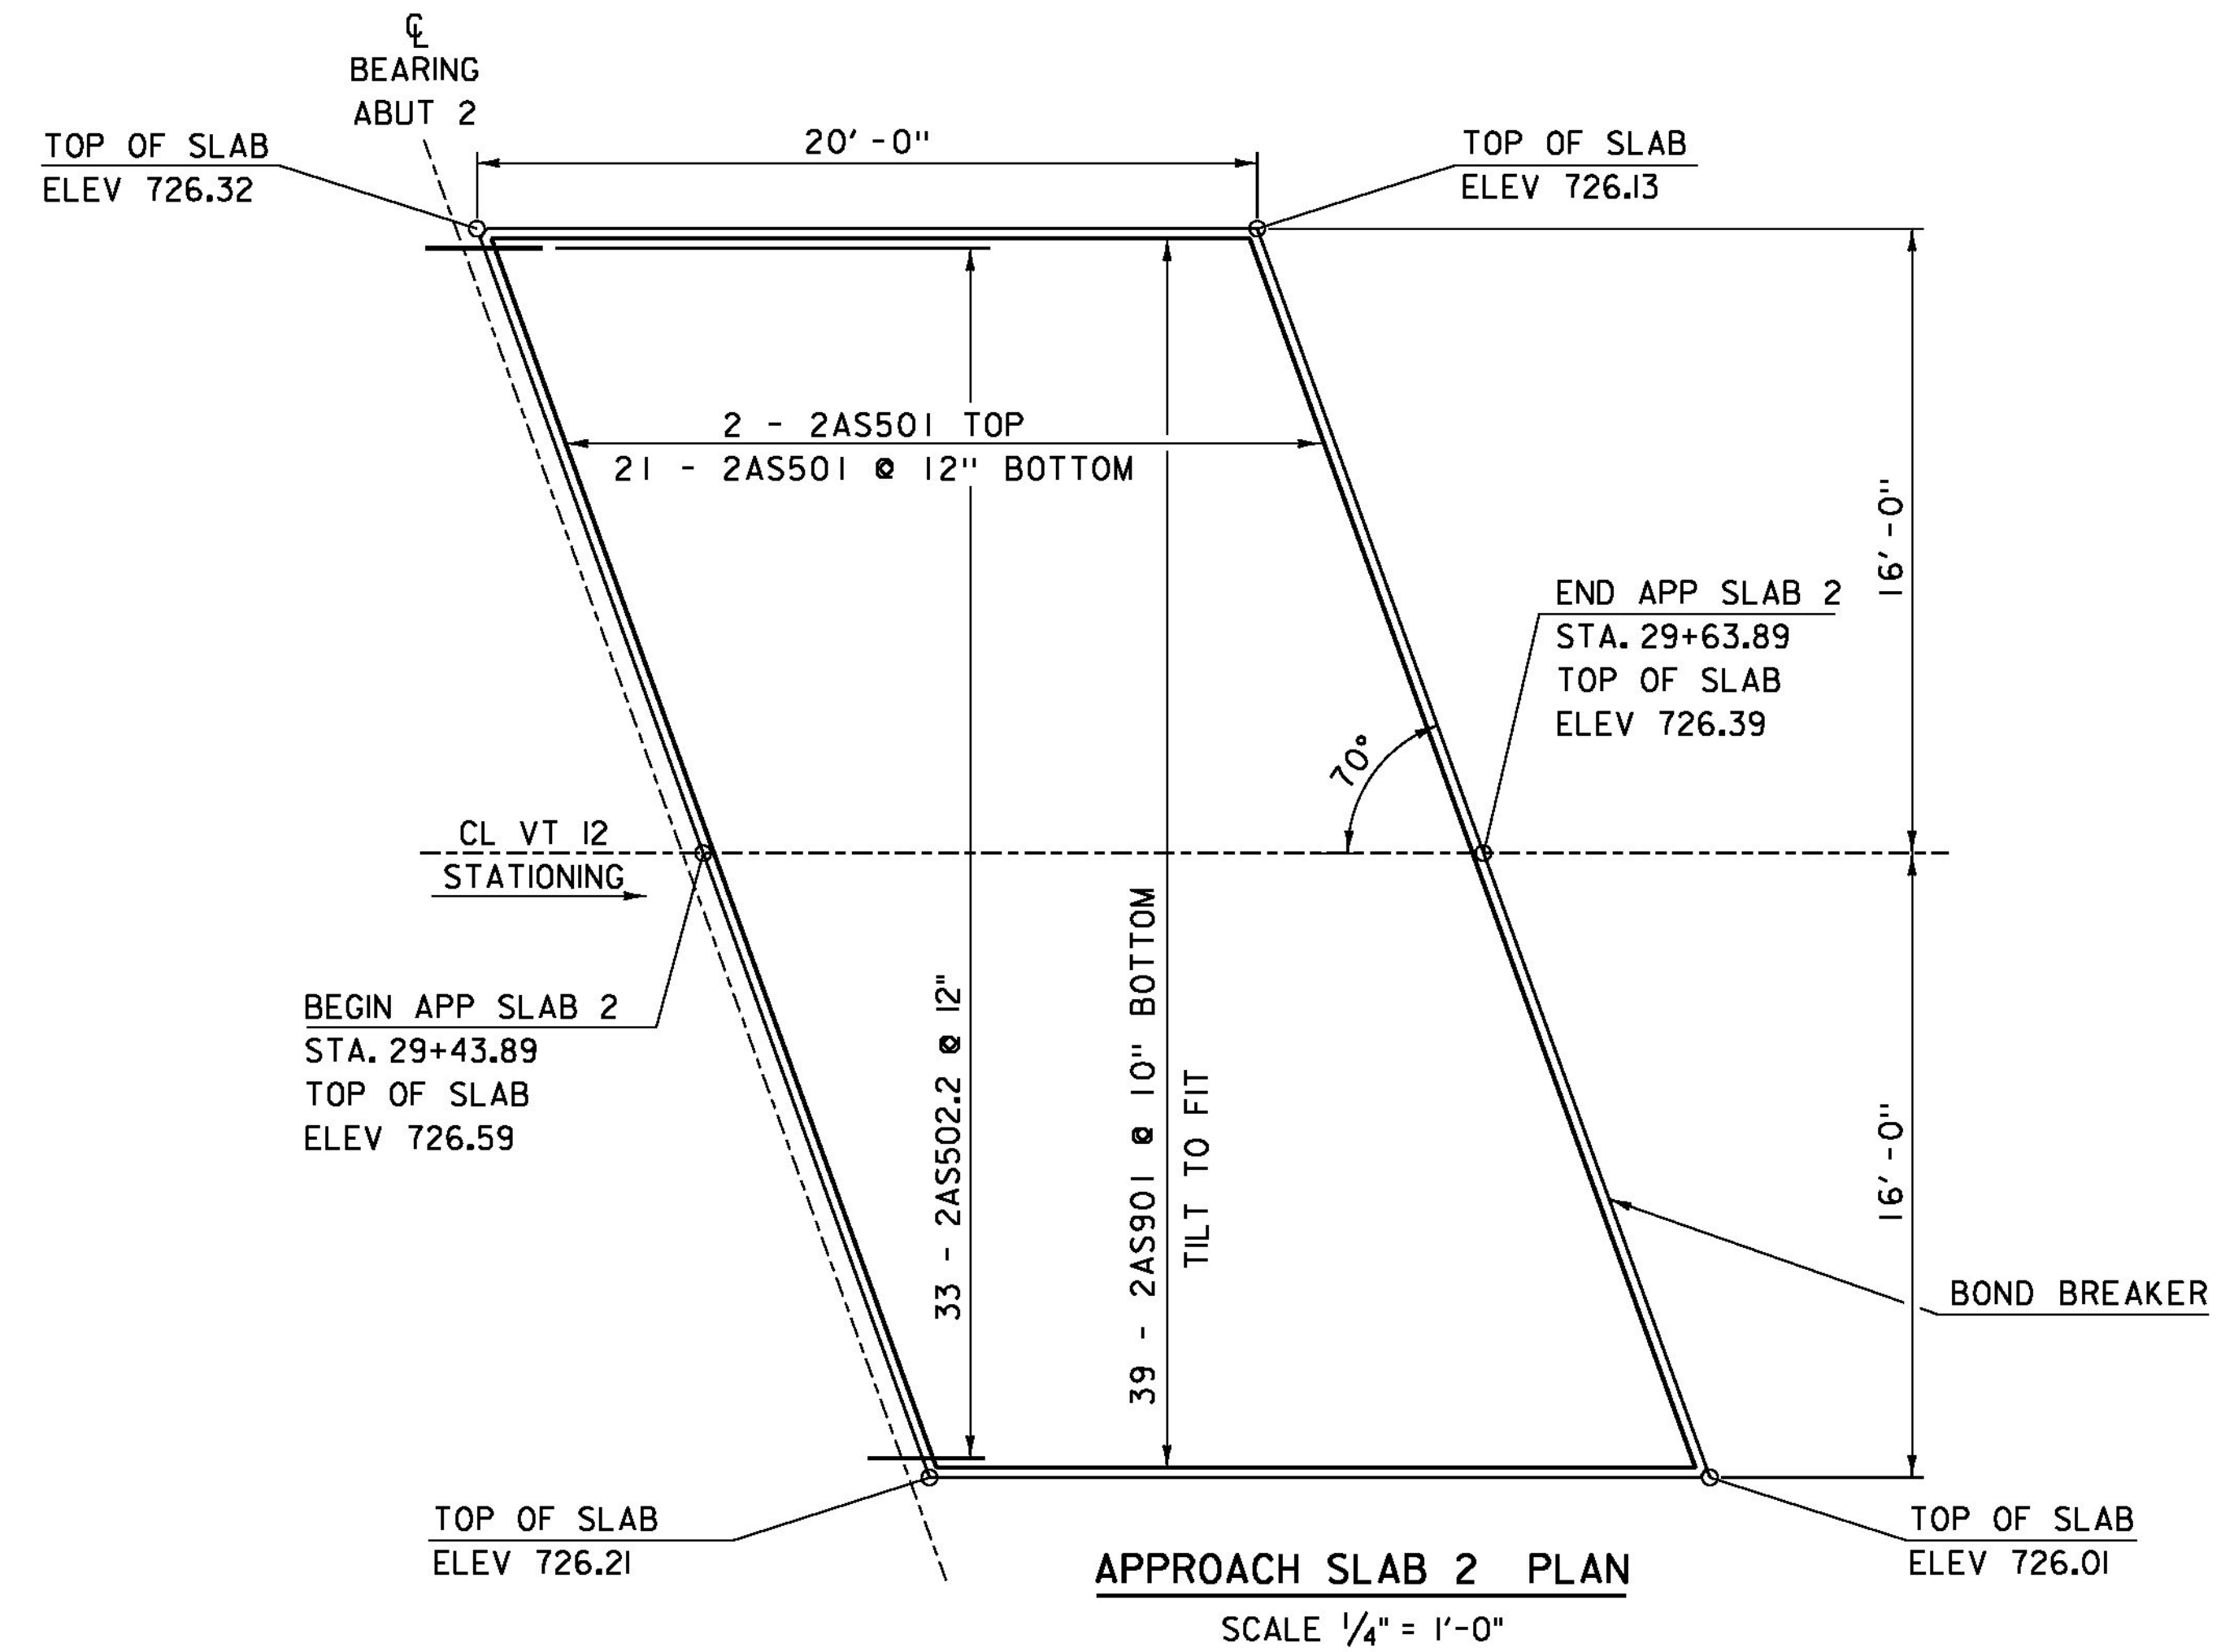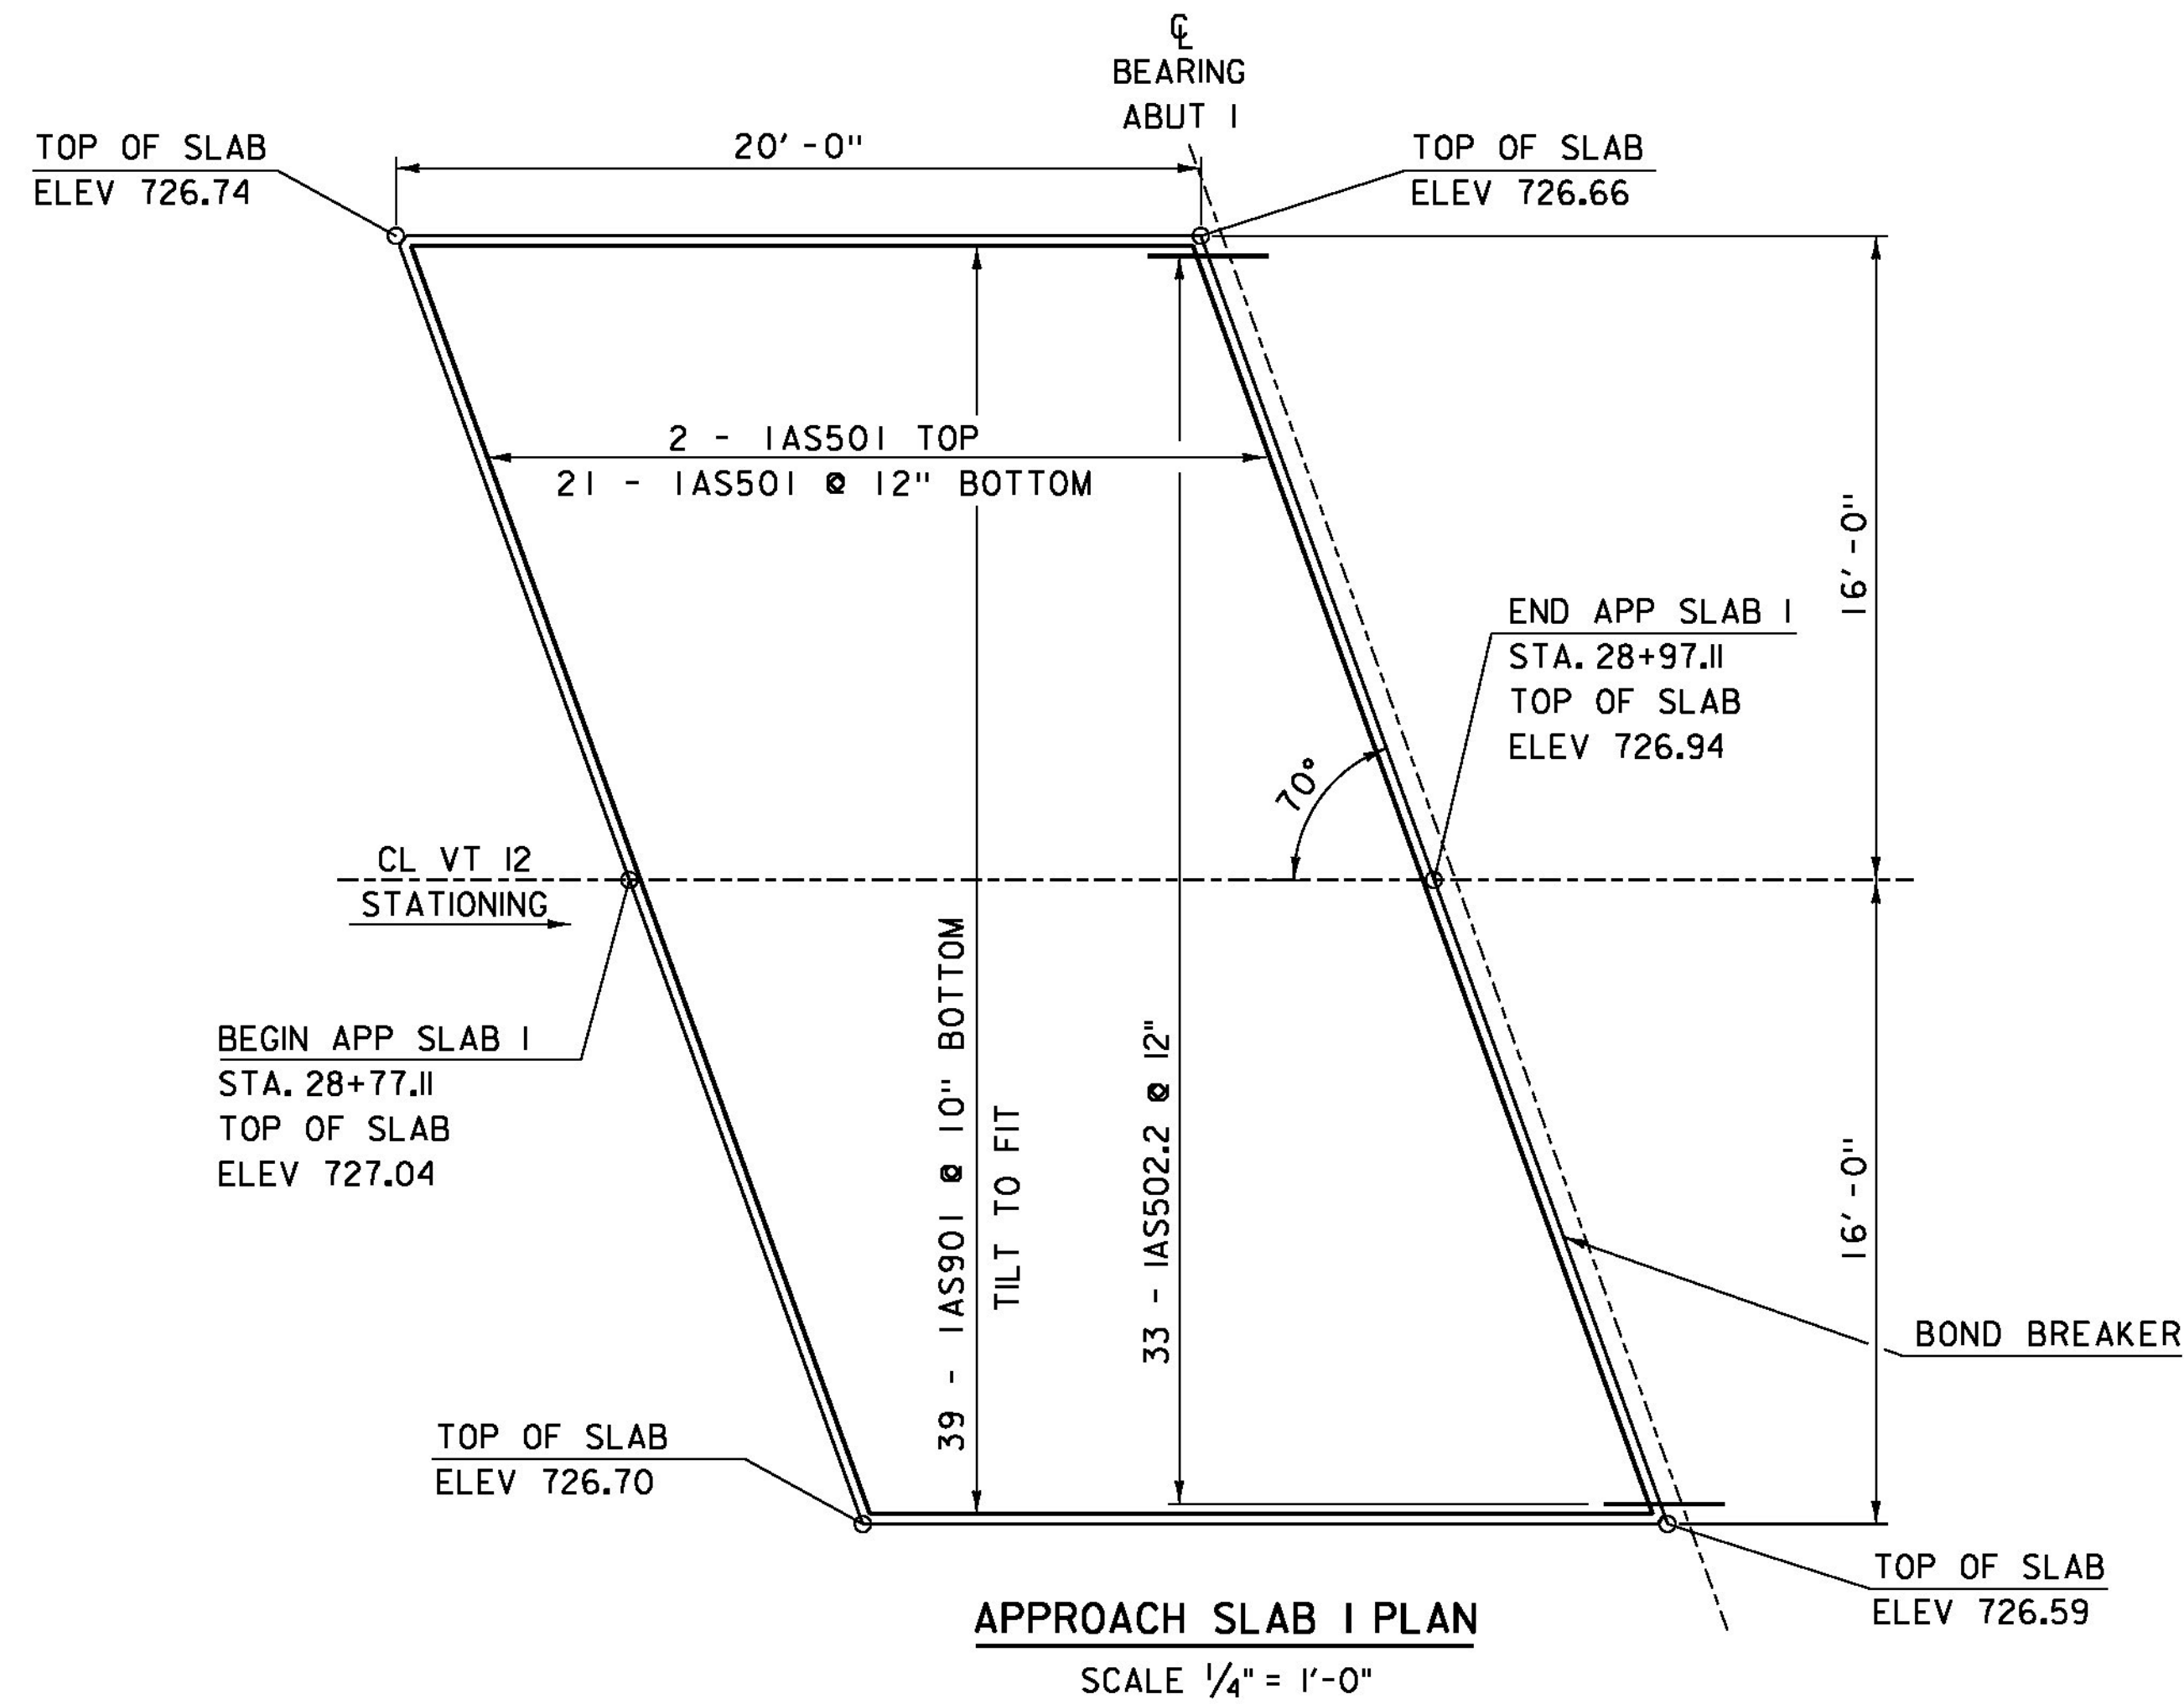


NOTES:

1. COMPACT THE SUBBASE IN THE AREA UNDER THE APPROACH SLAB TO A SMOOTH SURFACE.
2. MATERIAL FOR POLYETHYLENE SHEETING SHALL MEET THE REQUIREMENTS OF SUBSECTION 725.01(c) OF THE STANDARD SPECIFICATIONS. PLACE THE SHEETING ON TOP OF THE FINISHED SUBBASE FOR THE FULL LENGTH AND WIDTH OF THE APPROACH SLAB, AS SHOWN IN THE APPROACH SLAB DETAIL. LAP SHEETING AT LEAST 24 INCHES. PAYMENT INCIDENTAL TO ITEM 501.34 "CONCRETE, HIGH PERFORMANCE CLASS B".
3. POUR APPROACH SLAB CONCRETE IN THE EARLY MORNING BEFORE THE SUPERSTRUCTURE EXPANDS.
4. APPLY 2 COATS TAR EMULSION. PAYMENT INCIDENTAL TO ITEM 501.34 "CONCRETE, HIGH PERFORMANCE CLASS B".

PROJECT NAME: MIDDLESEX	PLOT DATE: 13-JAN-2015
PROJECT NUMBER: BRF 024-(K37)	DRAWN BY: C. BURRALL
FILE NAME: s10c220sup.dgn	CHECKED BY: H. SALLS
PROJECT LEADER: C. CARLSON	SHEET 23 OF 46
DESIGNED BY: H. SALLS	
APPROACH SLAB DETAILS	

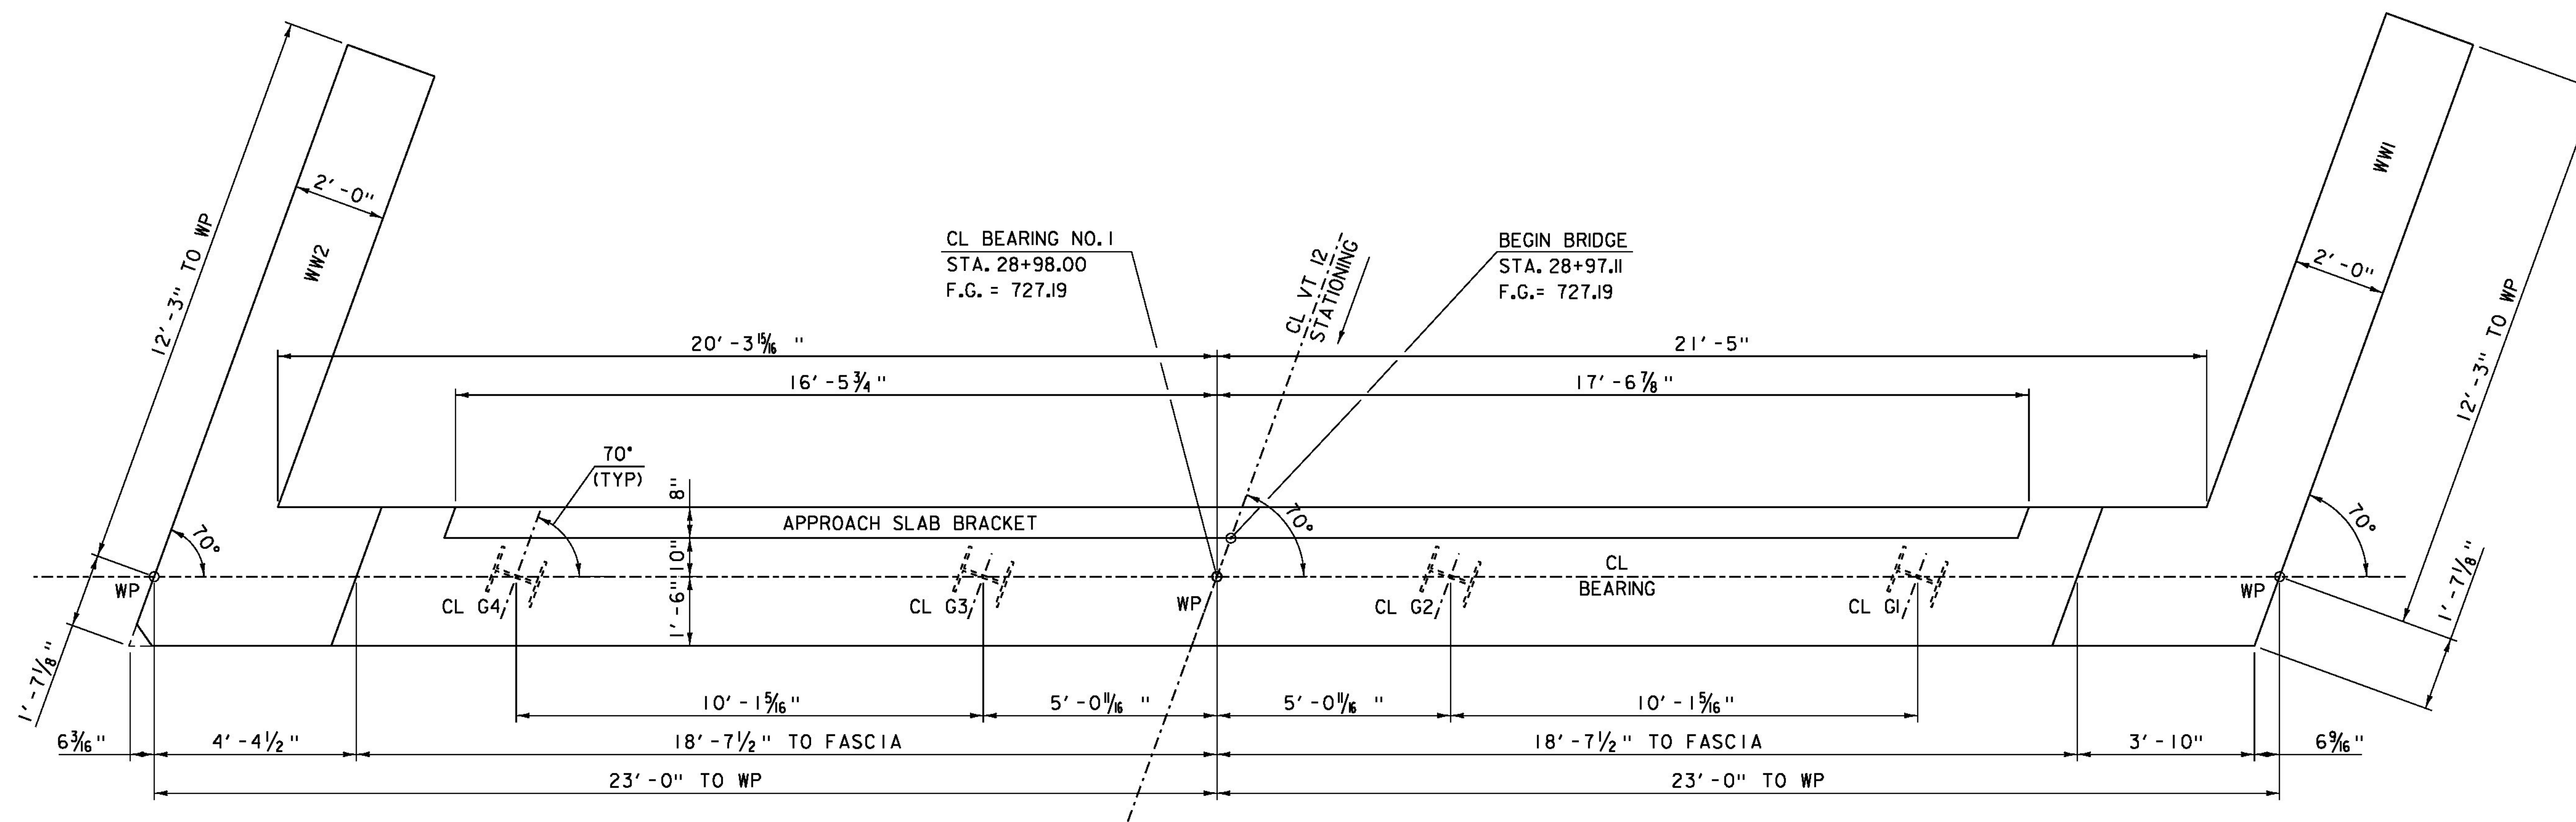

ABUTMENT NO. 1 PLAN
SCALE 1/2"=1'-0"

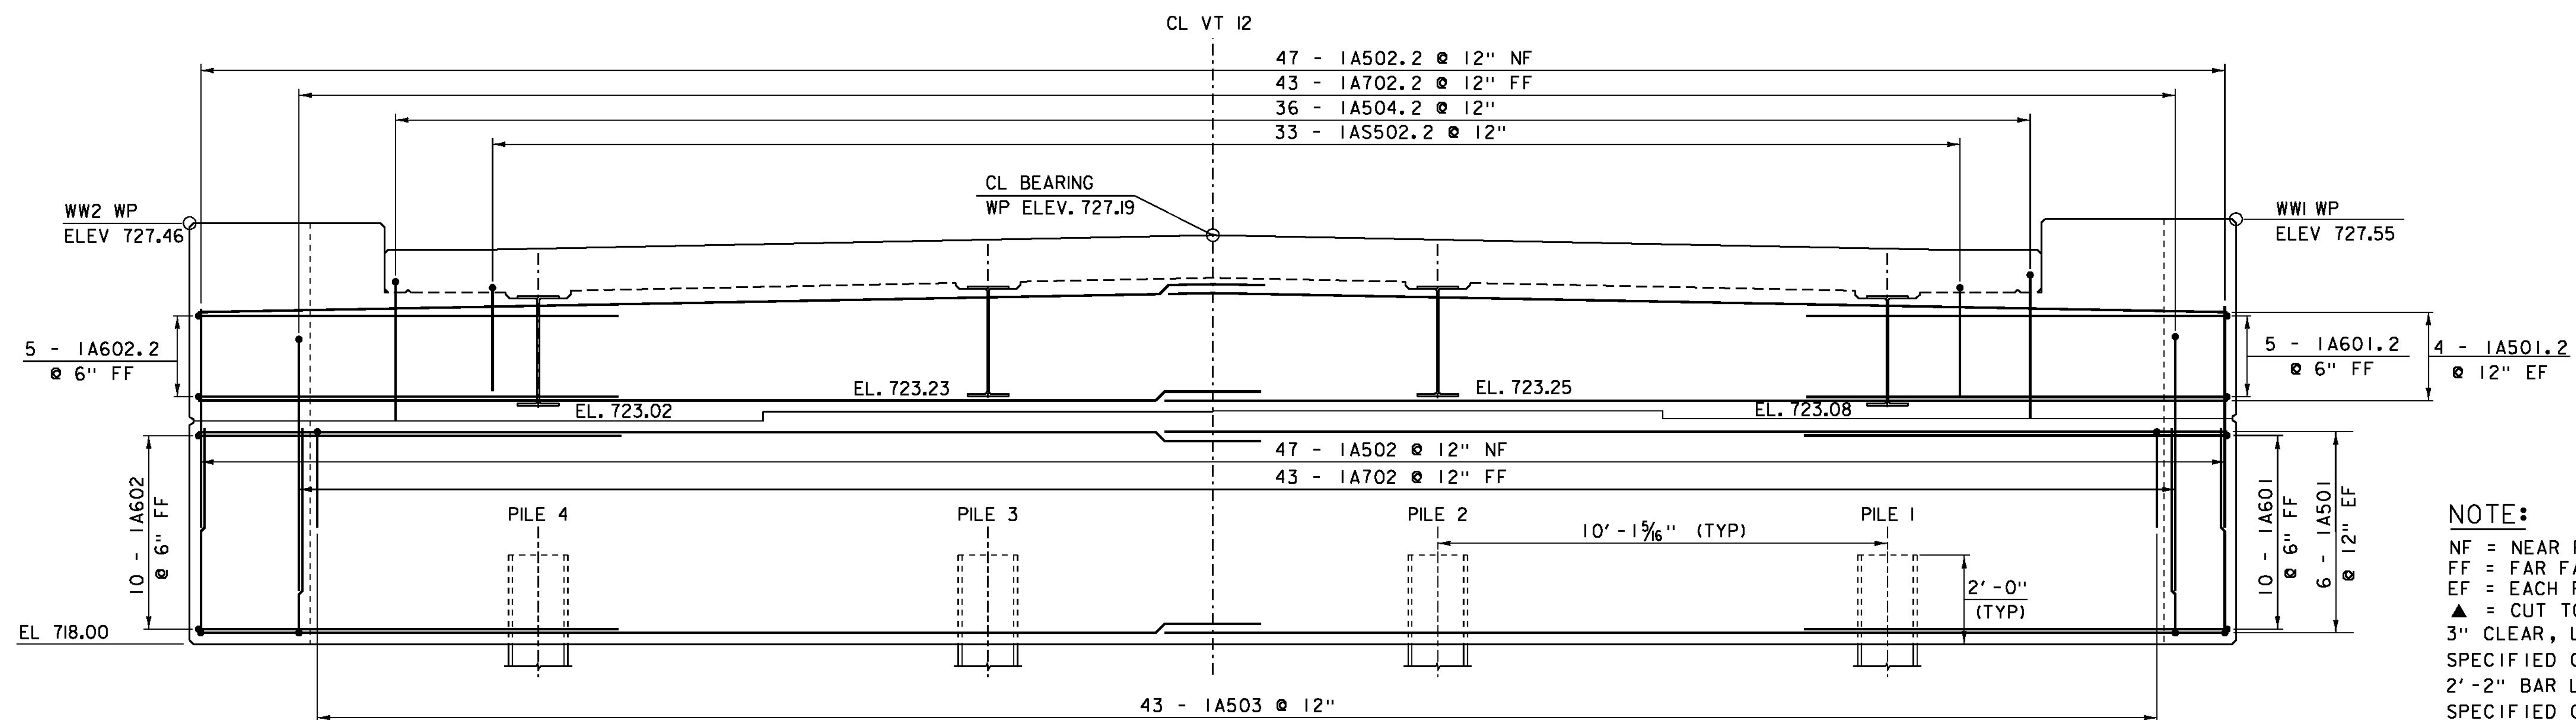


ABUTMENT NO. 1 ELEVATION
SCALE 1/2"=1'-0"

NOTE:
 NF = NEAR FACE
 FF = FAR FACE
 EF = EACH FACE
 ▲ = CUT TO FIT IN FIELD
 3" CLEAR, UNLESS OTHERWISE
 SPECIFIED ON THE PLANS.
 2'-2" BAR LAP UNLESS OTHERWISE
 SPECIFIED ON THE PLANS.


PROJECT NAME: MIDDLESEX
 PROJECT NUMBER: BRF 024-K(37)

FILE NAME: sl0c220sub.dgn
 PROJECT LEADER: C. CARLSON
 DESIGNED BY: H. SALLS
 ABUTMENT #1 PLAN AND ELEVATION

PLOT DATE: 06-FEB-2015
 DRAWN BY: C. BURRALL
 CHECKED BY: H. SALLS
 SHEET 24 OF 46

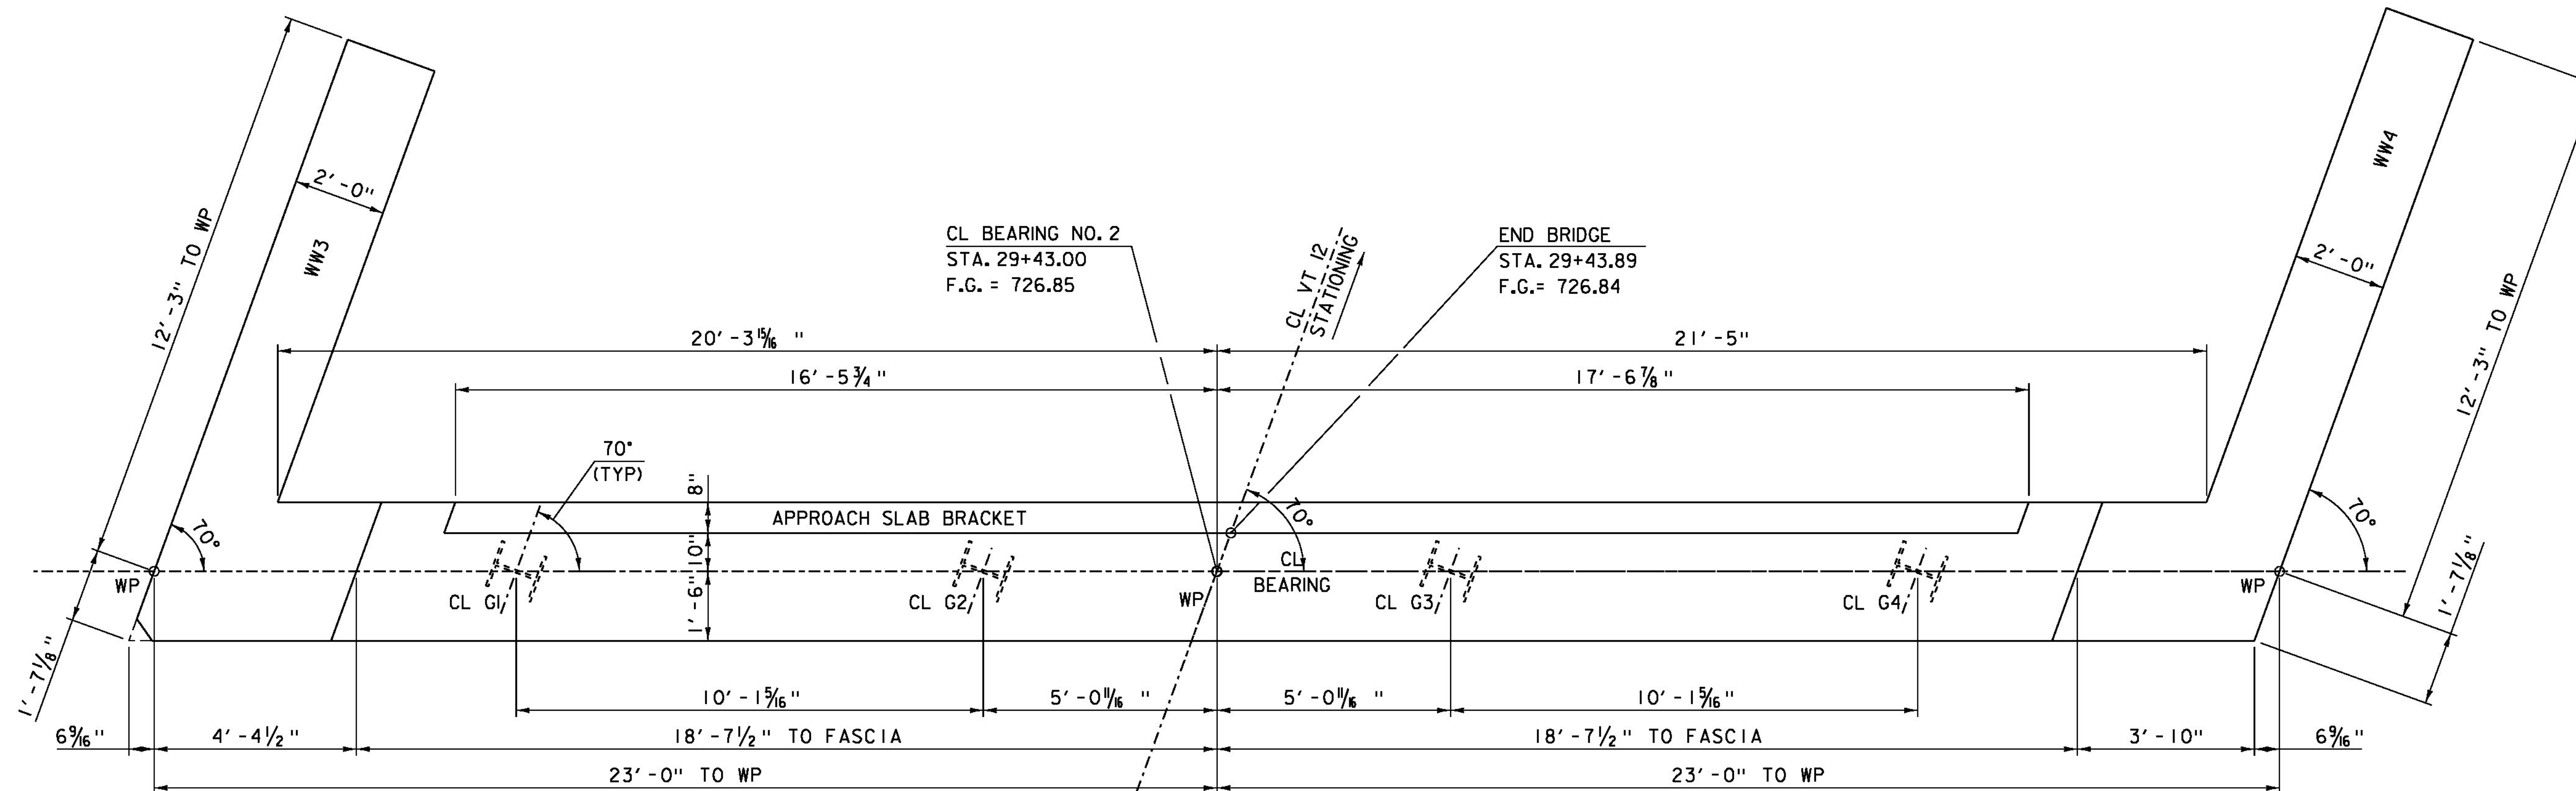


ABUTMENT NO. 2 PLAN
SCALE 1/2"=1'-0"

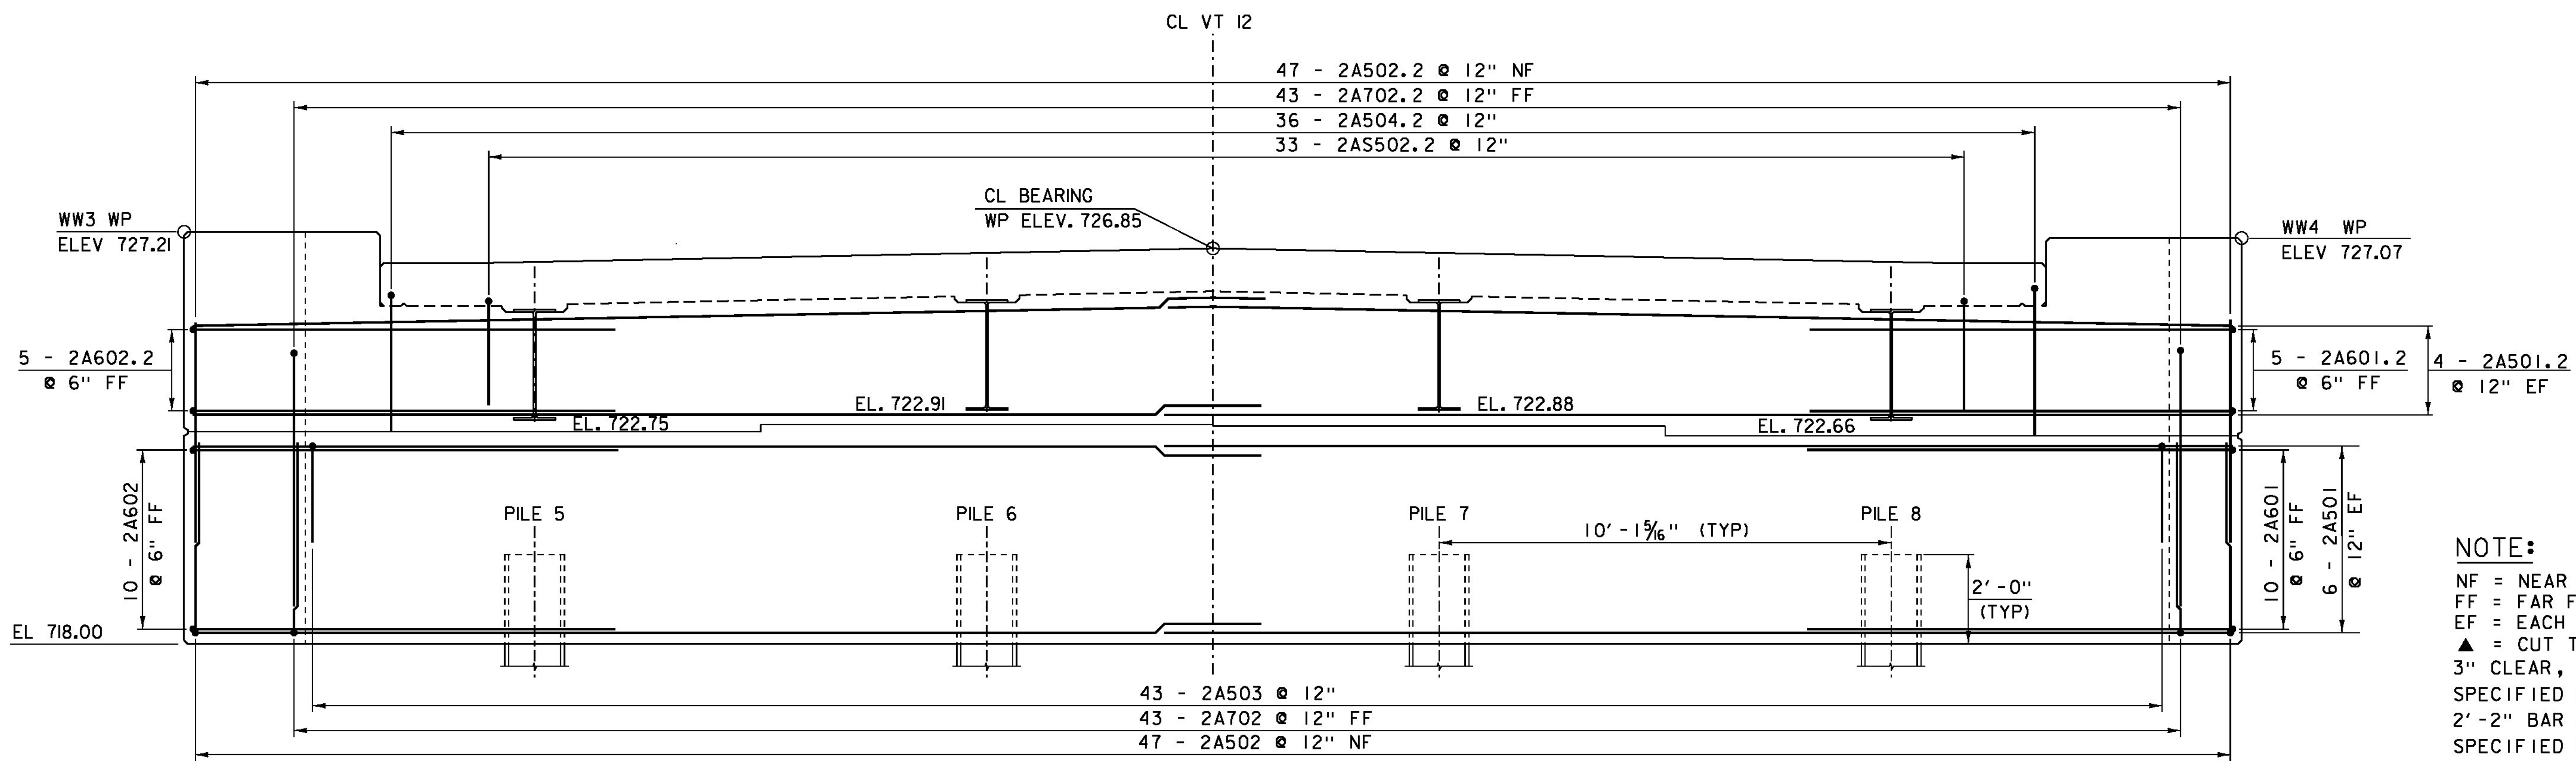

ABUTMENT NO. 2 ELEVATION
SCALE 1/2"=1'-0"


NOTE:
 NF = NEAR FACE
 FF = FAR FACE
 EF = EACH FACE
 ▲ = CUT TO FIT IN FIELD
 3" CLEAR, UNLESS OTHERWISE
 SPECIFIED ON THE PLANS.
 2'-2" BAR LAP UNLESS OTHERWISE
 SPECIFIED ON THE PLANS.

PROJECT NAME:	MIDDLESEX	PLOT DATE:	06-FEB-2015
PROJECT NUMBER:	BRF 024-(K37)	DRAWN BY:	C. BURRALL
FILE NAME:	sl0c220sub.dgn	DESIGNED BY:	H. SALLS
PROJECT LEADER:	C. CARLSON	CHECKED BY:	H. SALLS
ABUTMENT #2 PLAN AND ELEVATION			SHEET 25 OF 46

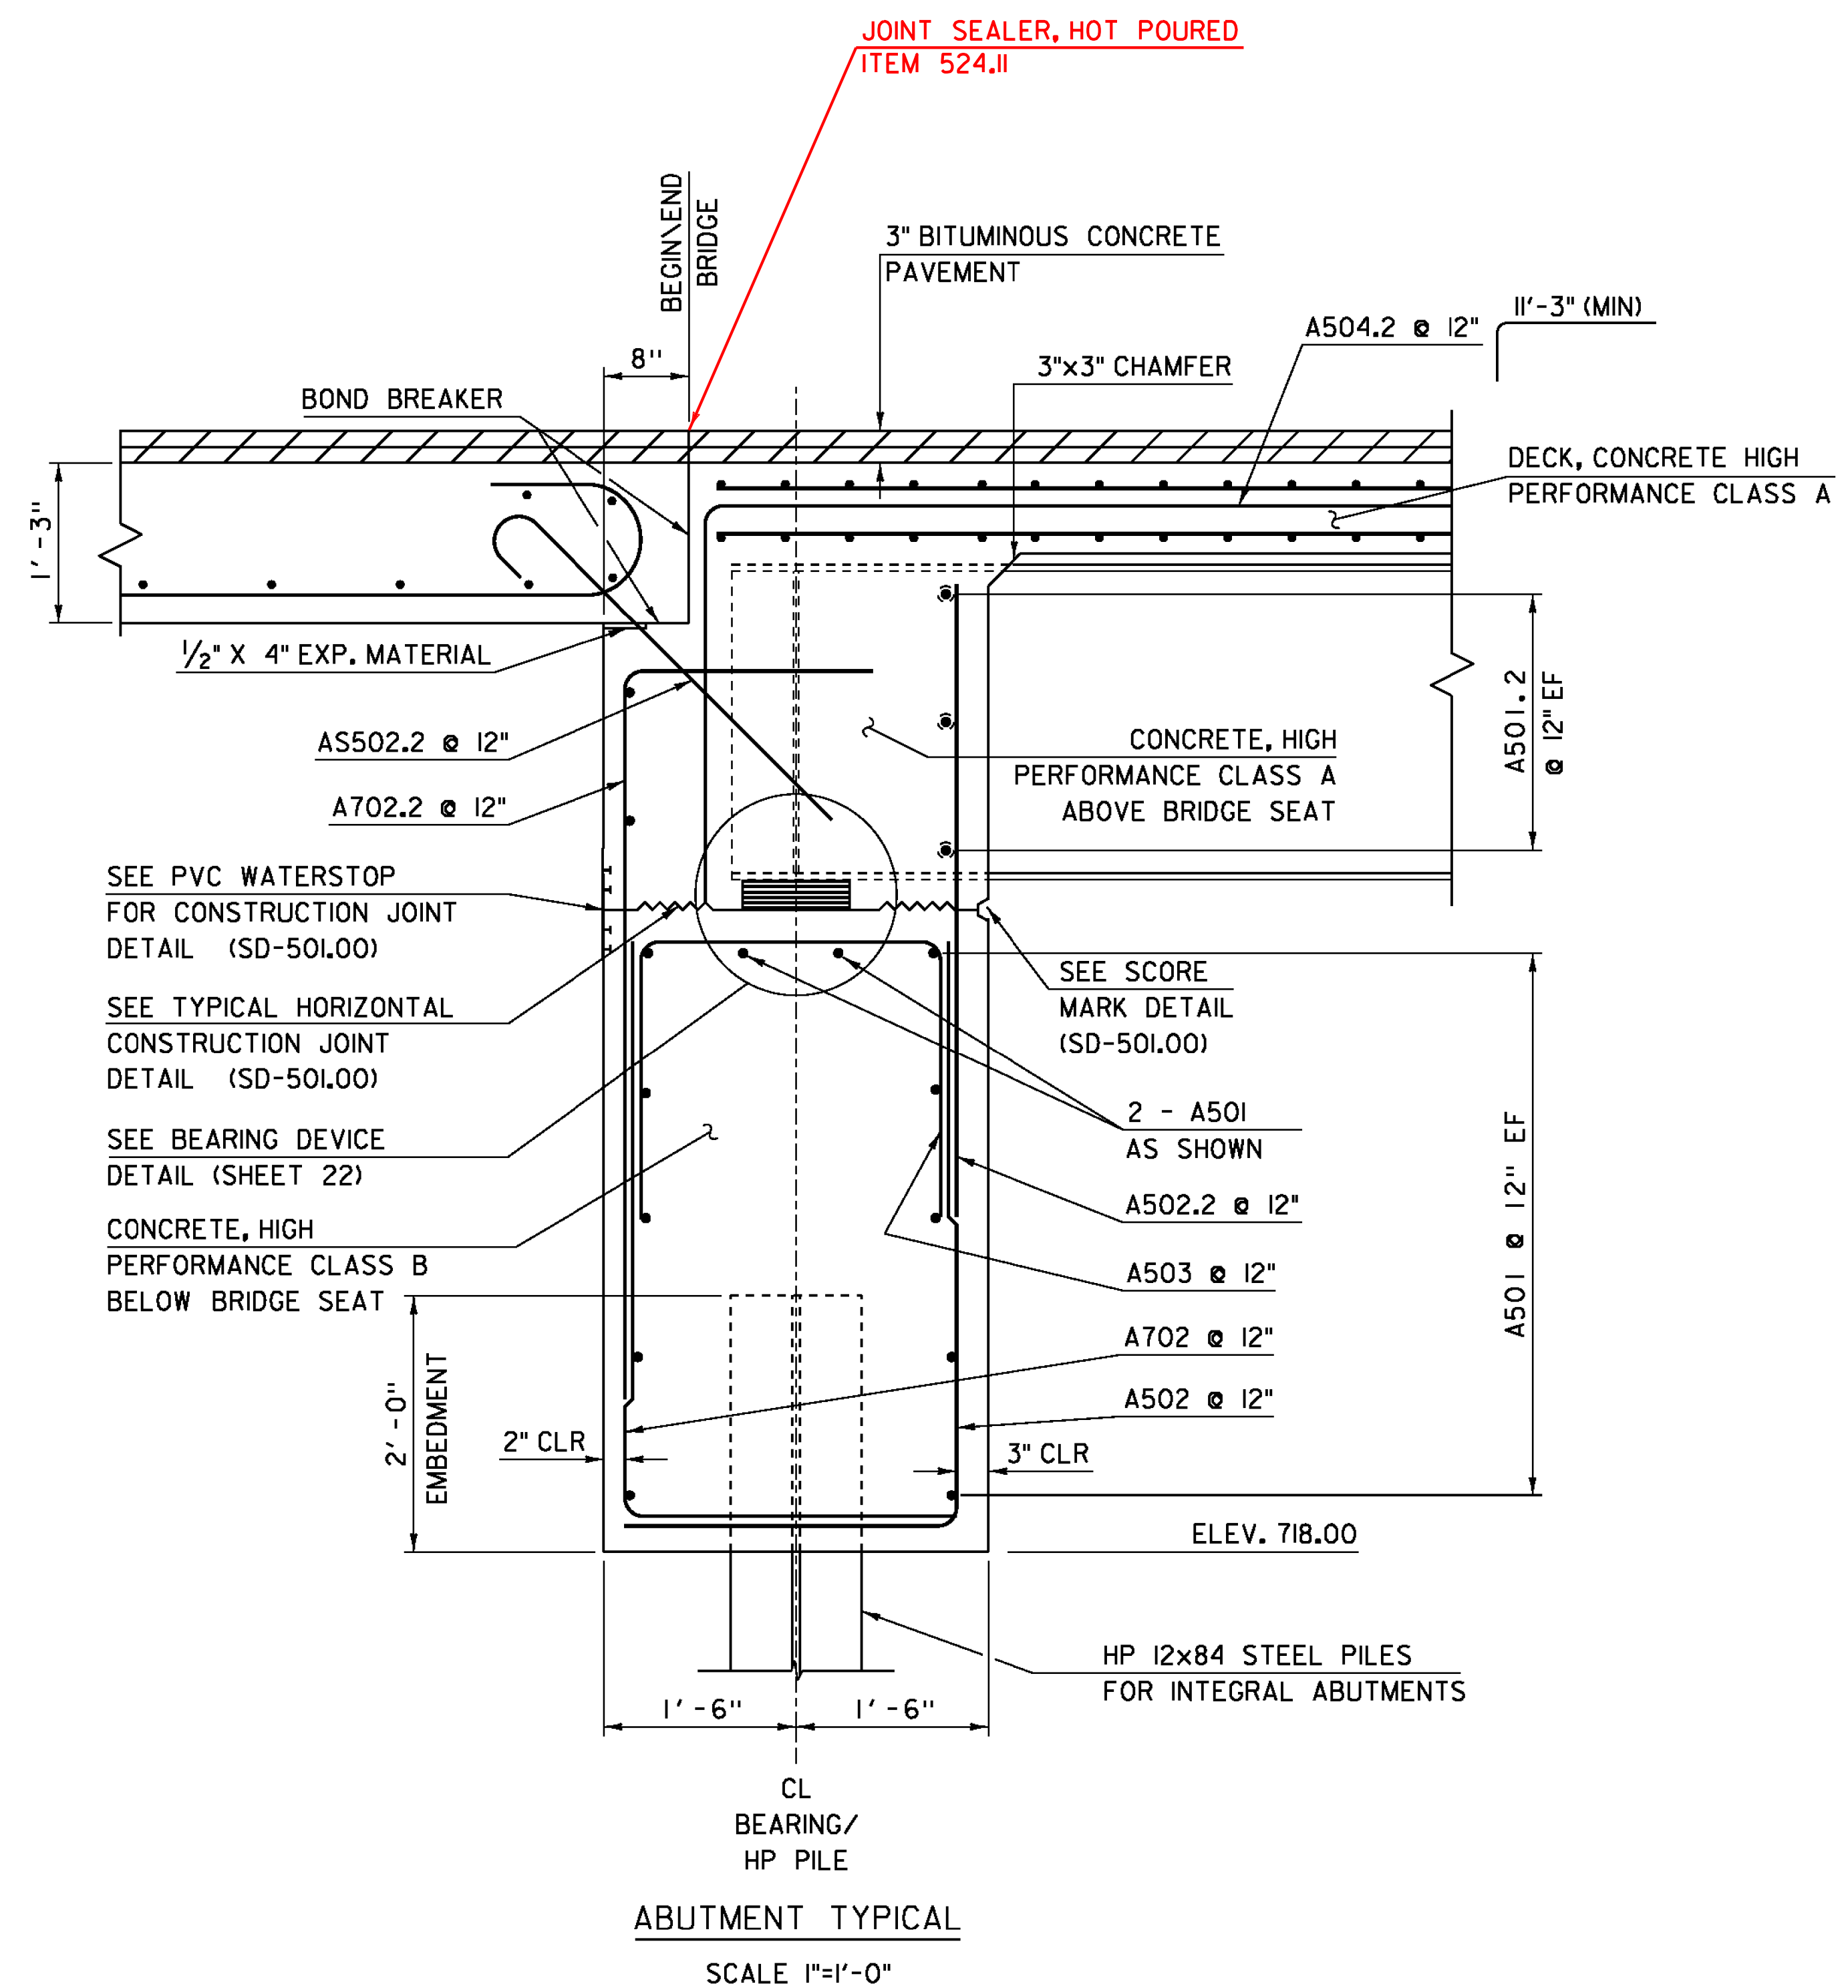


NOTE:
 NF = NEAR FACE
 FF = FAR FACE
 EF = EACH FACE
 ▲ = CUT TO FIT IN FIELD
 3" CLEAR, UNLESS OTHERWISE SPECIFIED ON THE PLANS.
 2'-2" BAR LAP UNLESS OTHERWISE SPECIFIED ON THE PLANS.


PROJECT NAME: MIDDLESEX	PLOT DATE: 06-FEB-2015
PROJECT NUMBER: BRF 024-1(37)	DRAWN BY: C. BURRALL
FILE NAME: s10c220sub.dgn	CHECKED BY: H. SALLS
DESIGNED BY: H. SALLS	SHEET 26 OF 46
ABUTMENT TYPICAL	

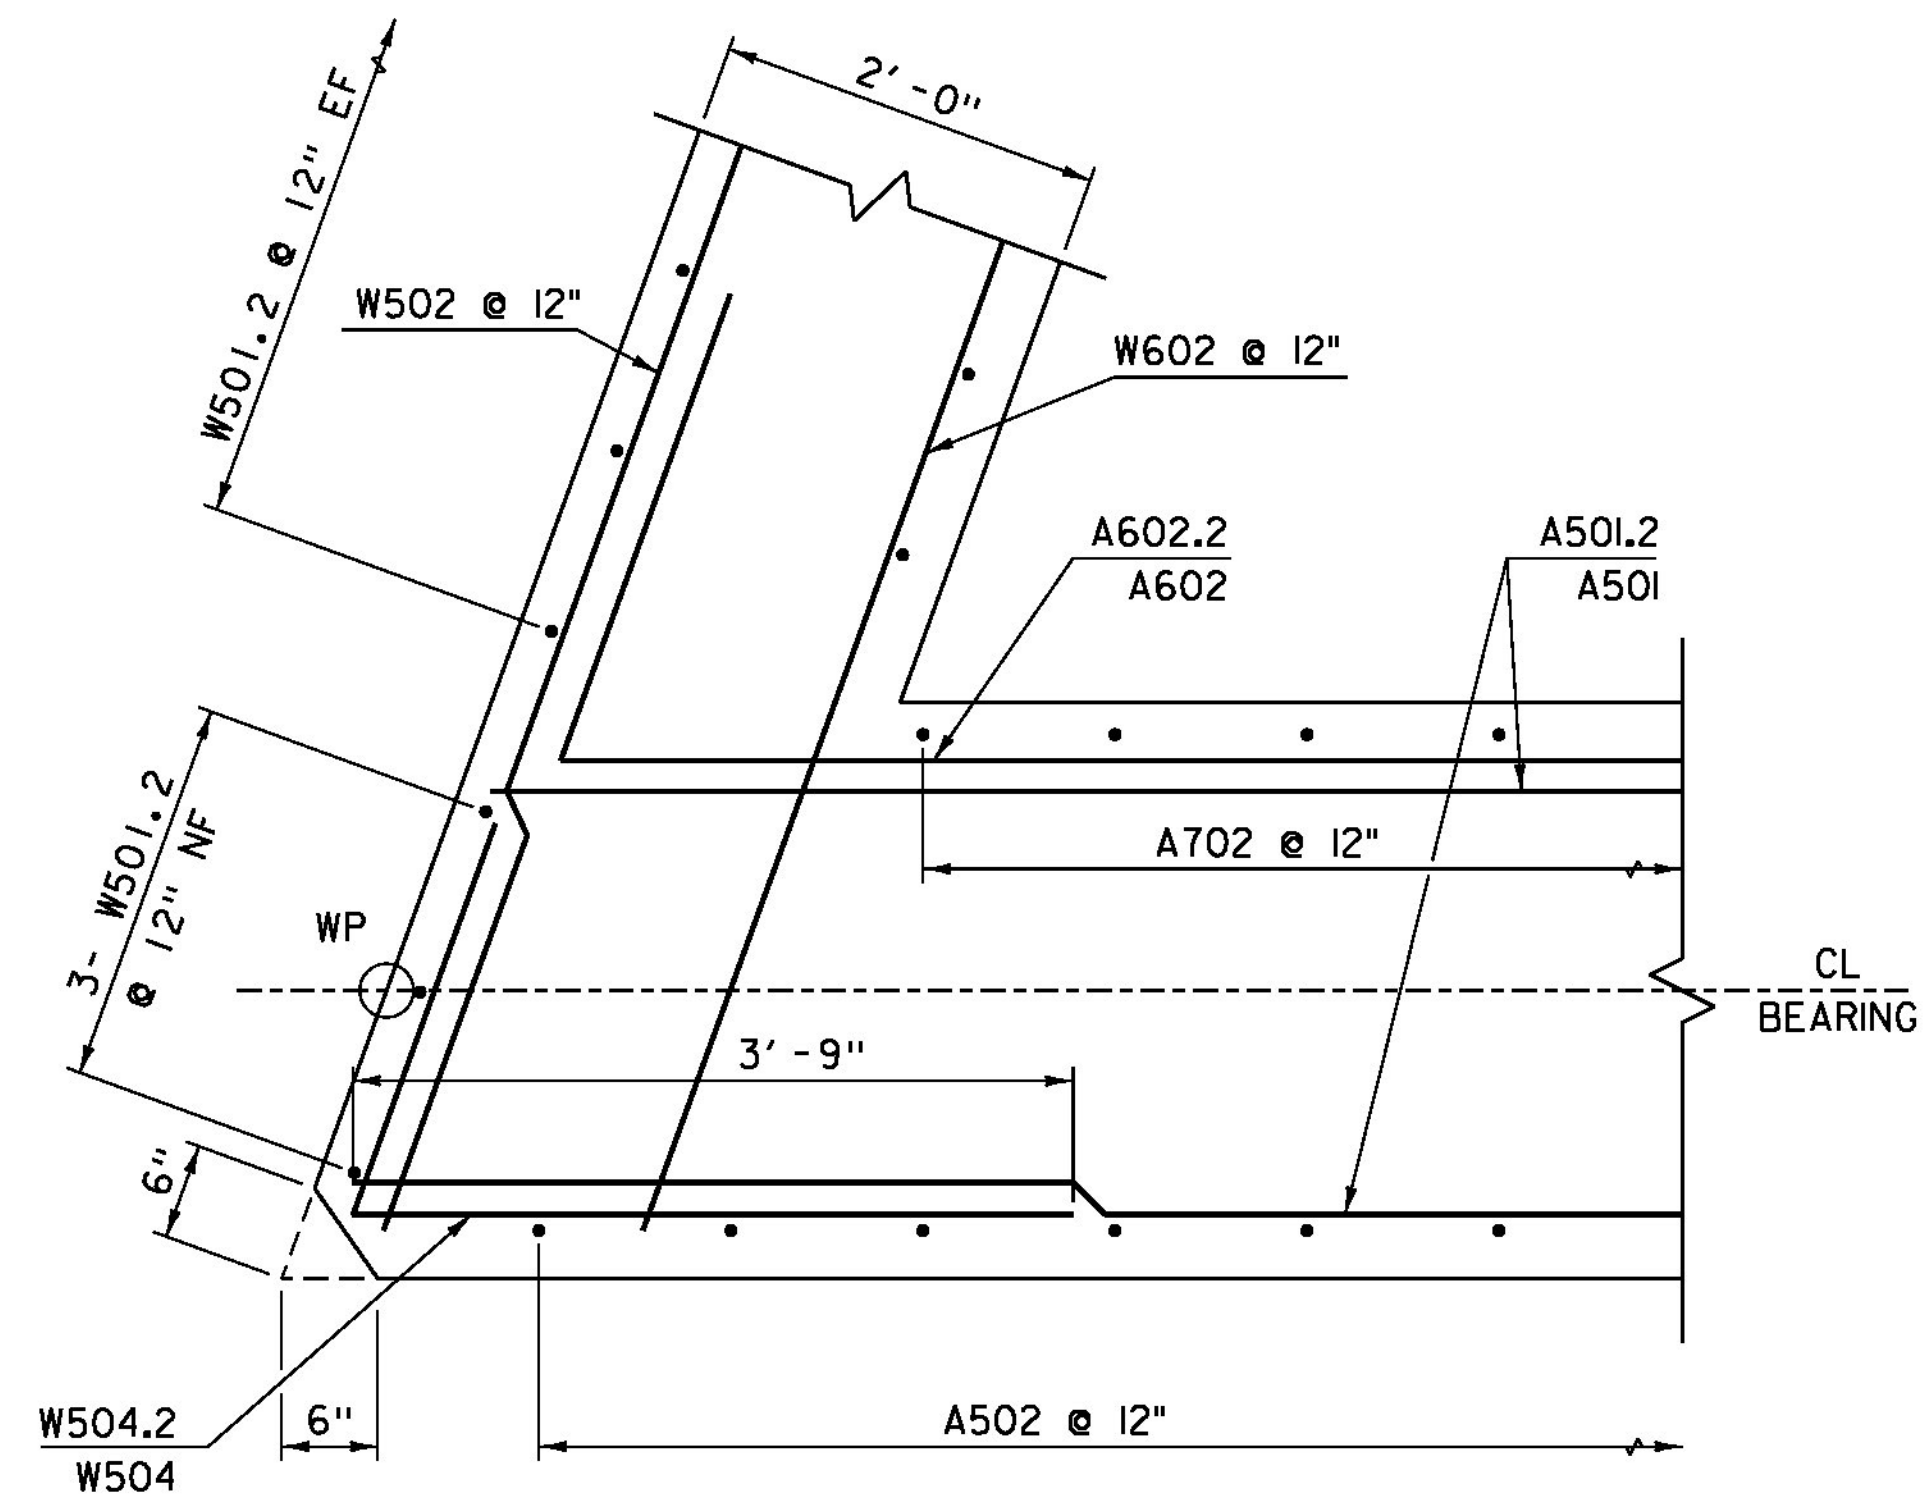

WINGWALLS 2 AND 3 CORNER DETAIL
SCALE 1"=1'-0"

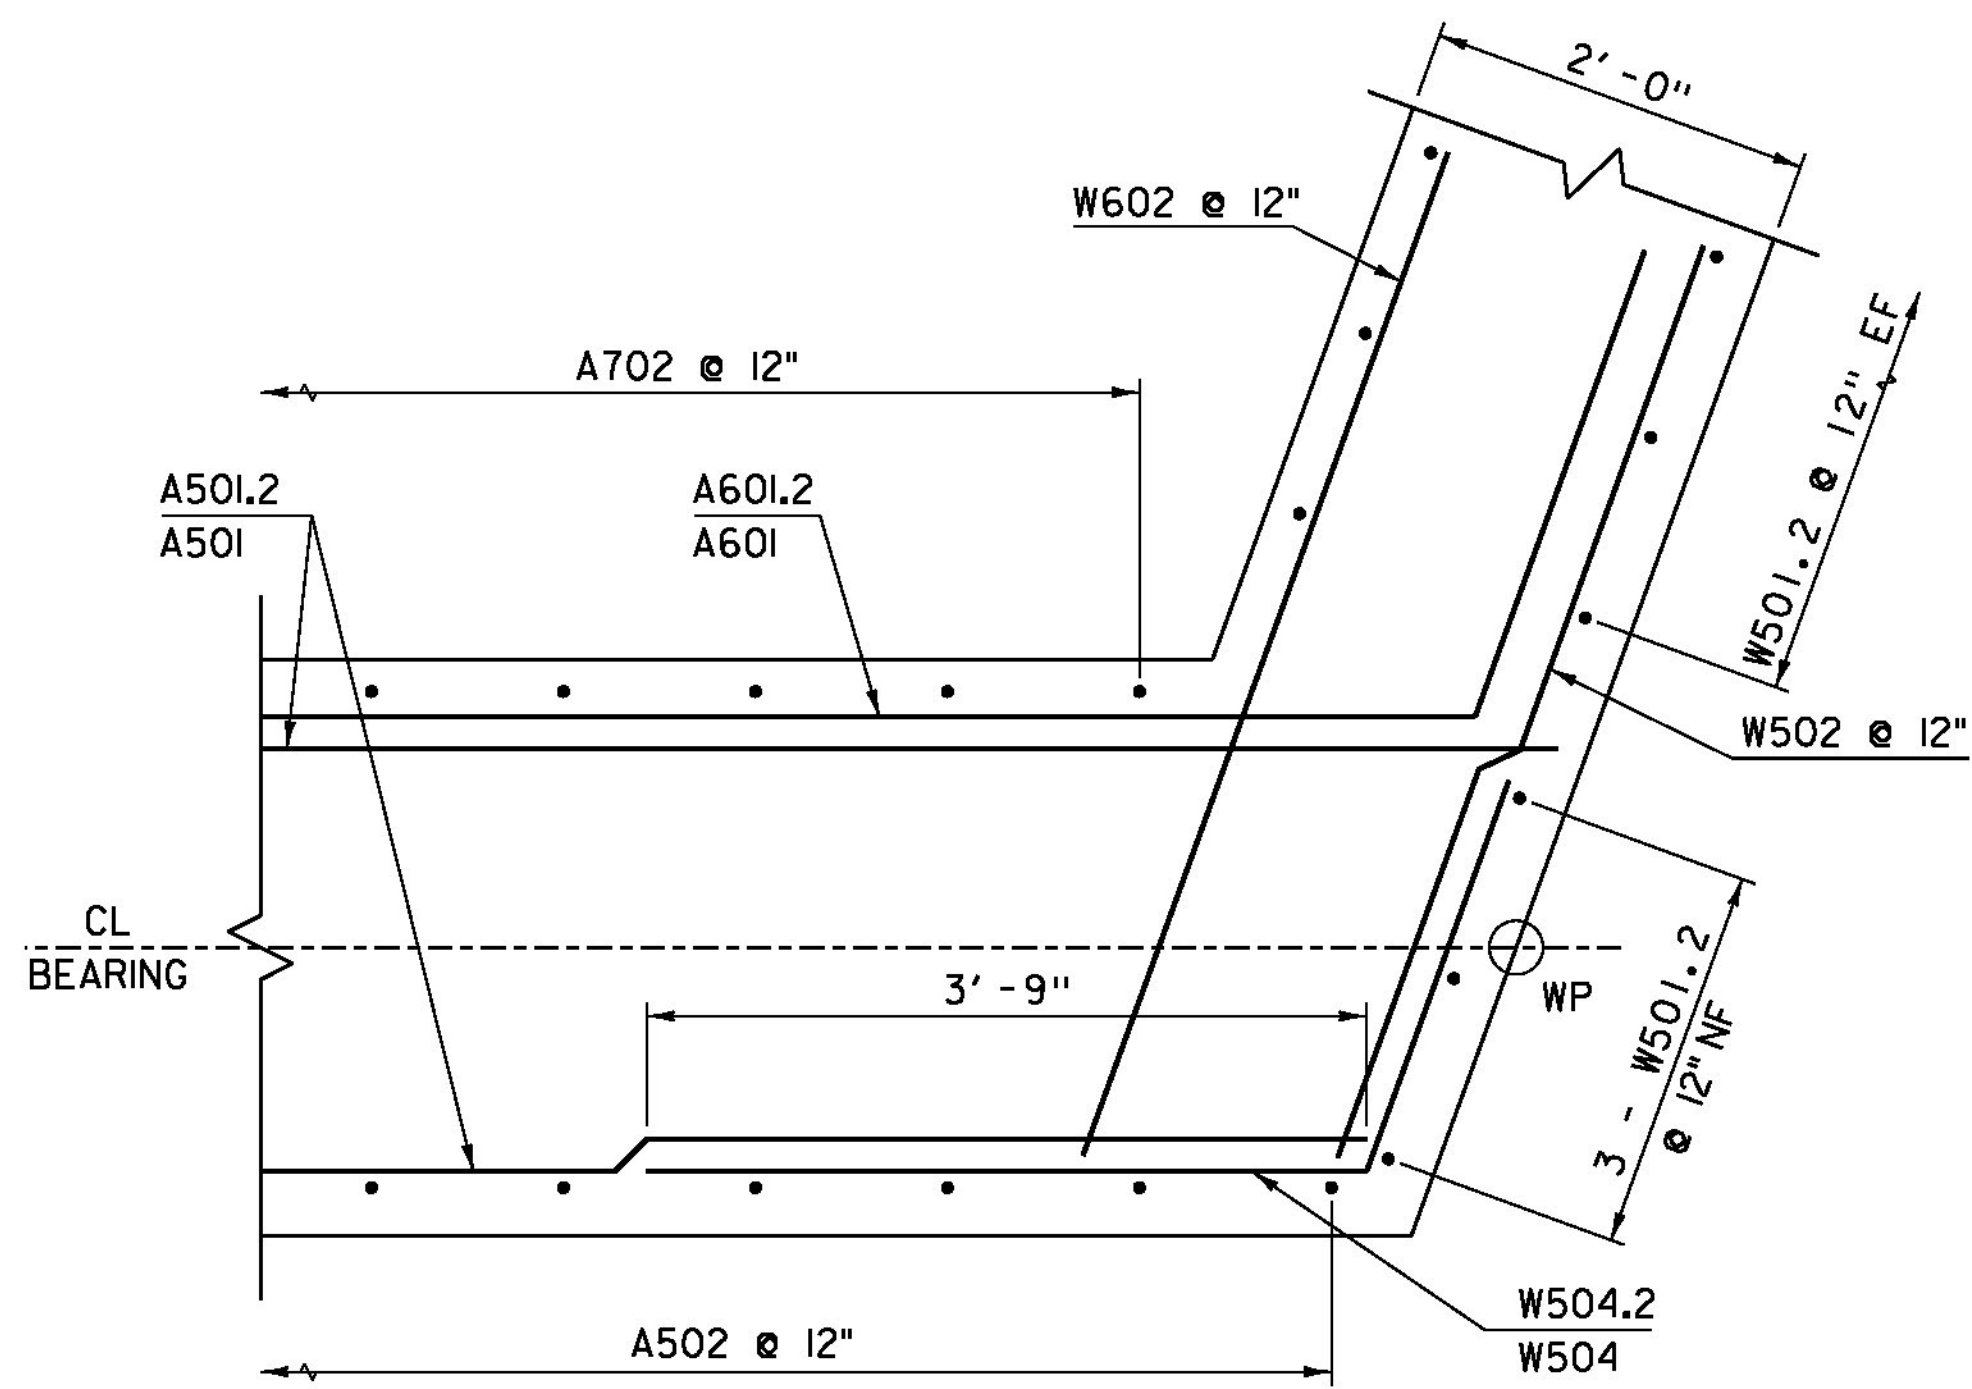

WINGWALLS 1 AND 4 CORNER DETAIL
SCALE 1"=1'-0"

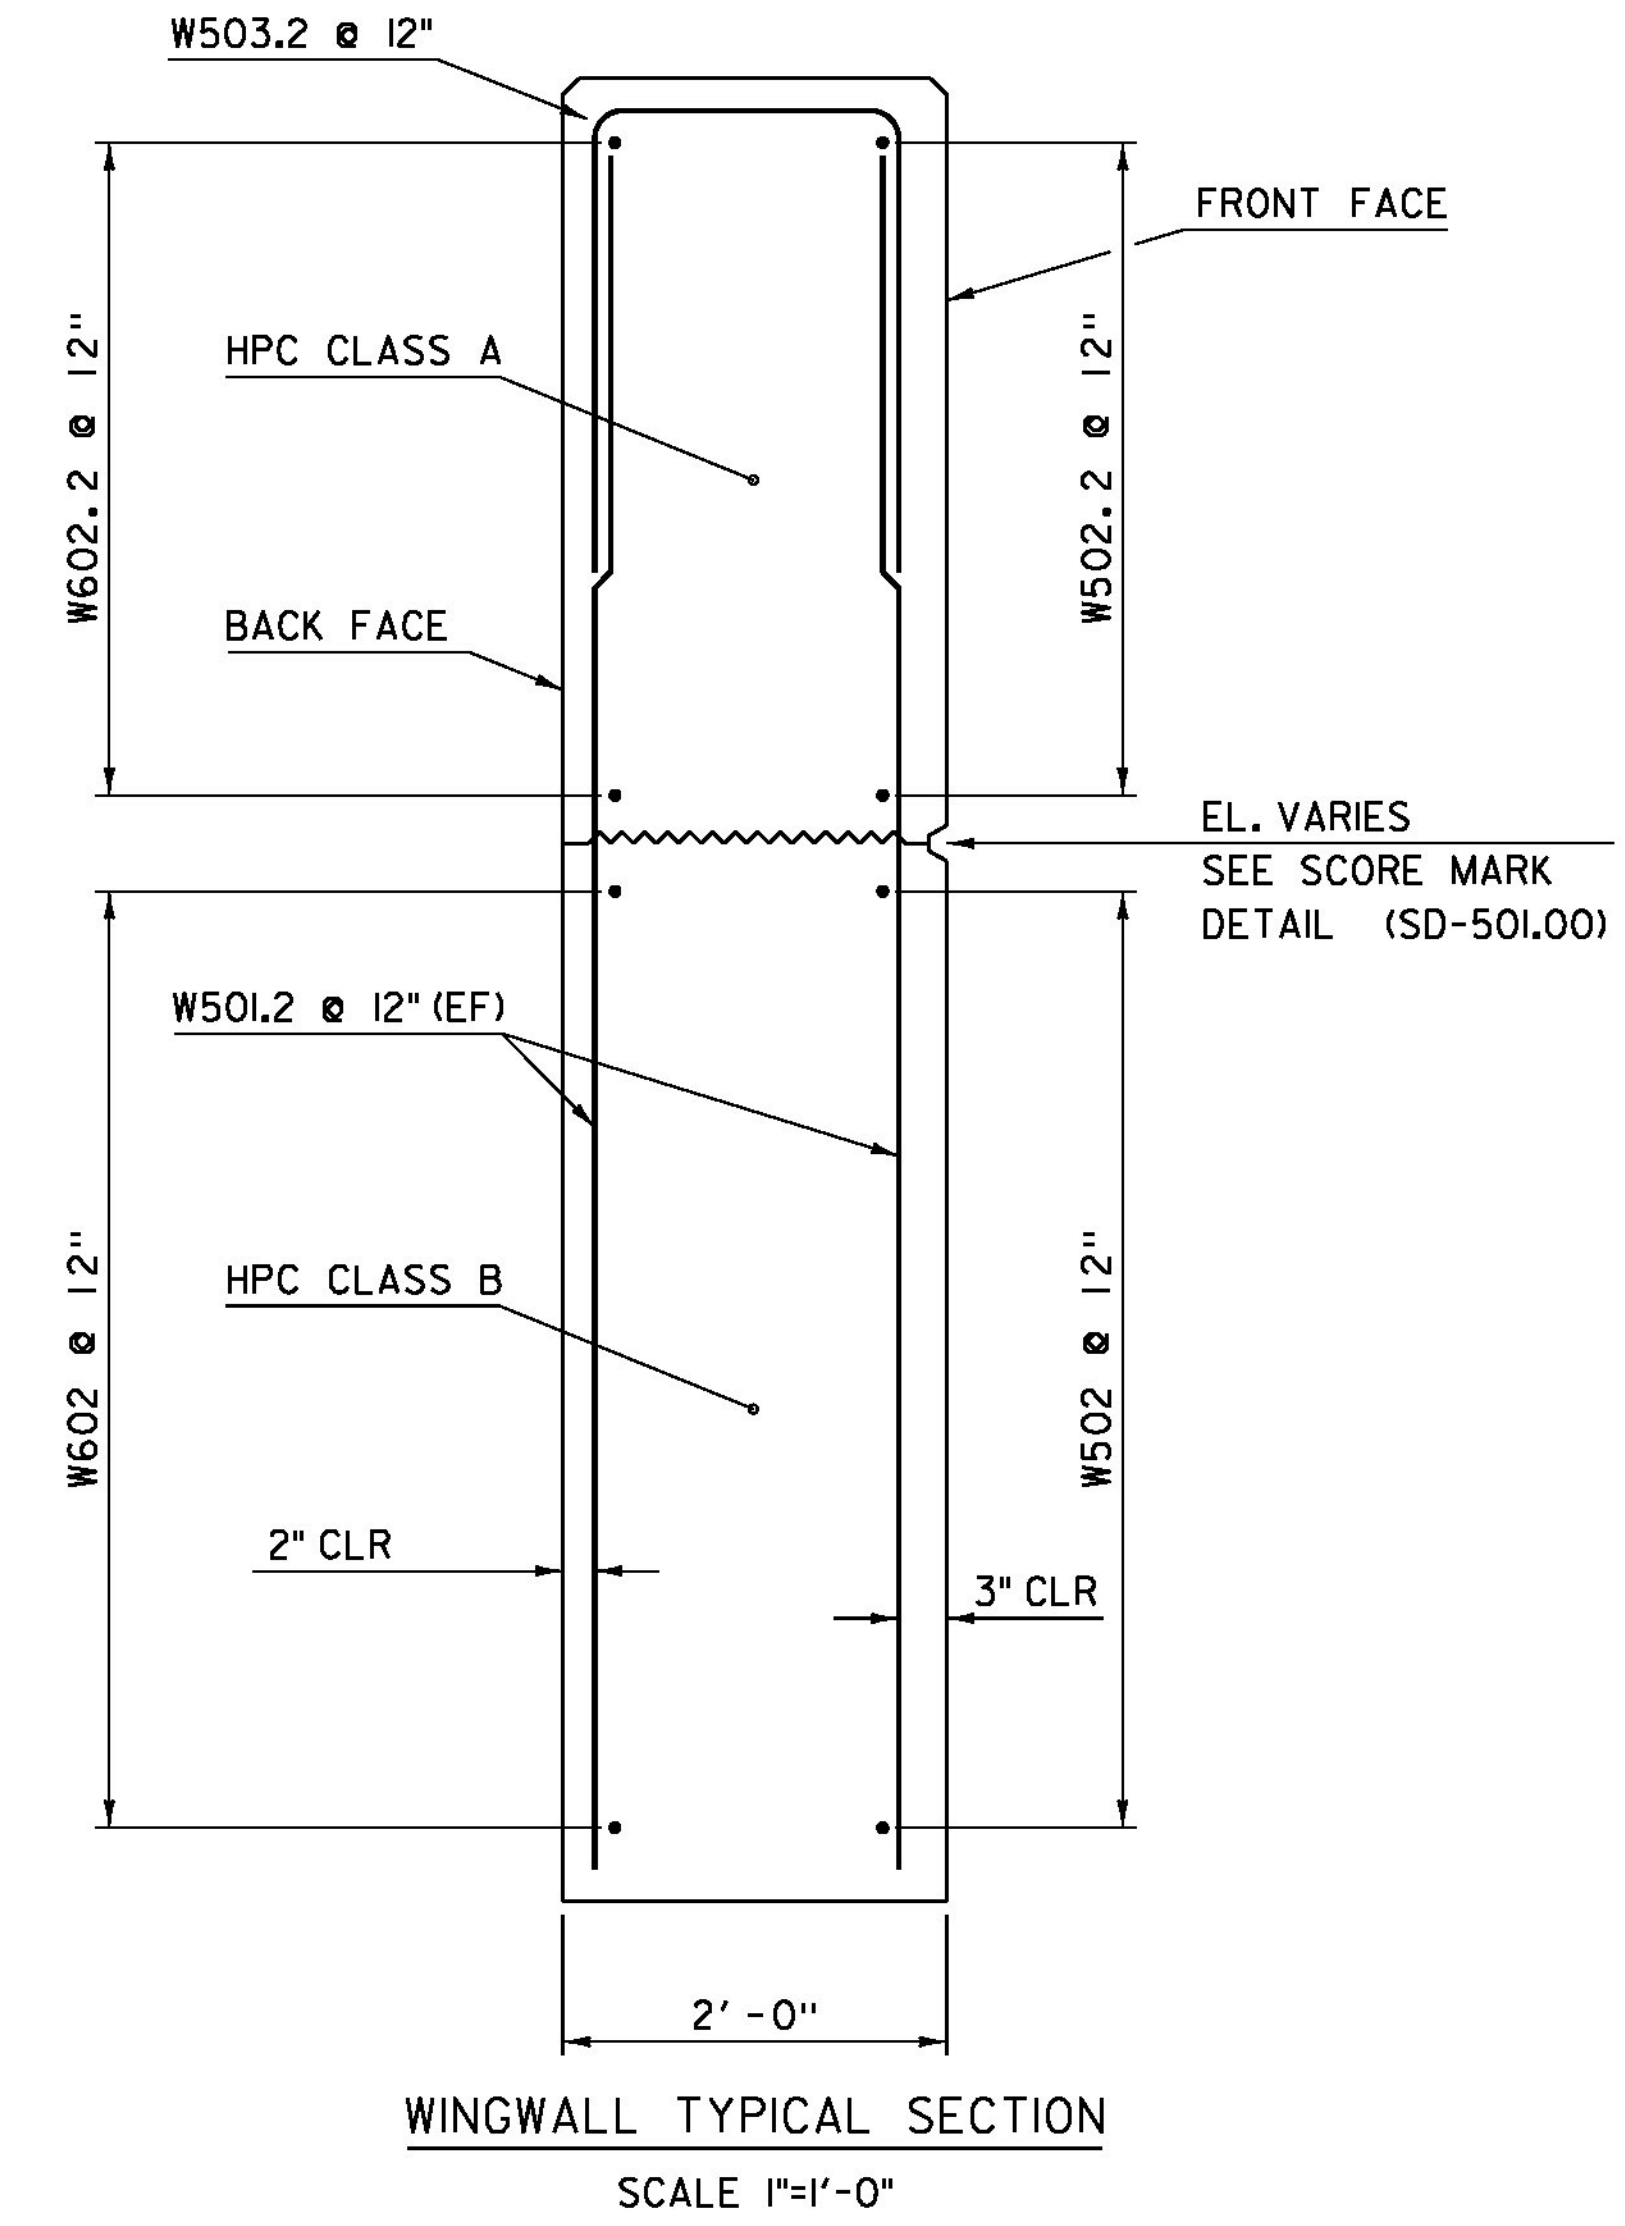

WINGWALL TYPICAL SECTION
SCALE 1"=1'-0"


NOTE:

- NF = NEAR FACE
- FF = FAR FACE
- EF = EACH FACE
- ▲ = CUT TO FIT IN FIELD
- 3" CLEAR, UNLESS OTHERWISE SPECIFIED ON THE PLANS.
- 2'-2" BAR LAP UNLESS OTHERWISE SPECIFIED ON THE PLANS.


PROJECT NAME: MIDDLESEX
PROJECT NUMBER: BRP 024-1(37)

FILE NAME: sl0c220sub.dgn
PROJECT LEADER: C. CARLSON
DESIGNED BY: H. SALLS
WINGWALL DETAILS


PLOT DATE: 06-FEB-2015
DRAWN BY: C. BURRALL
CHECKED BY: H. SALLS
SHEET 27 OF 46

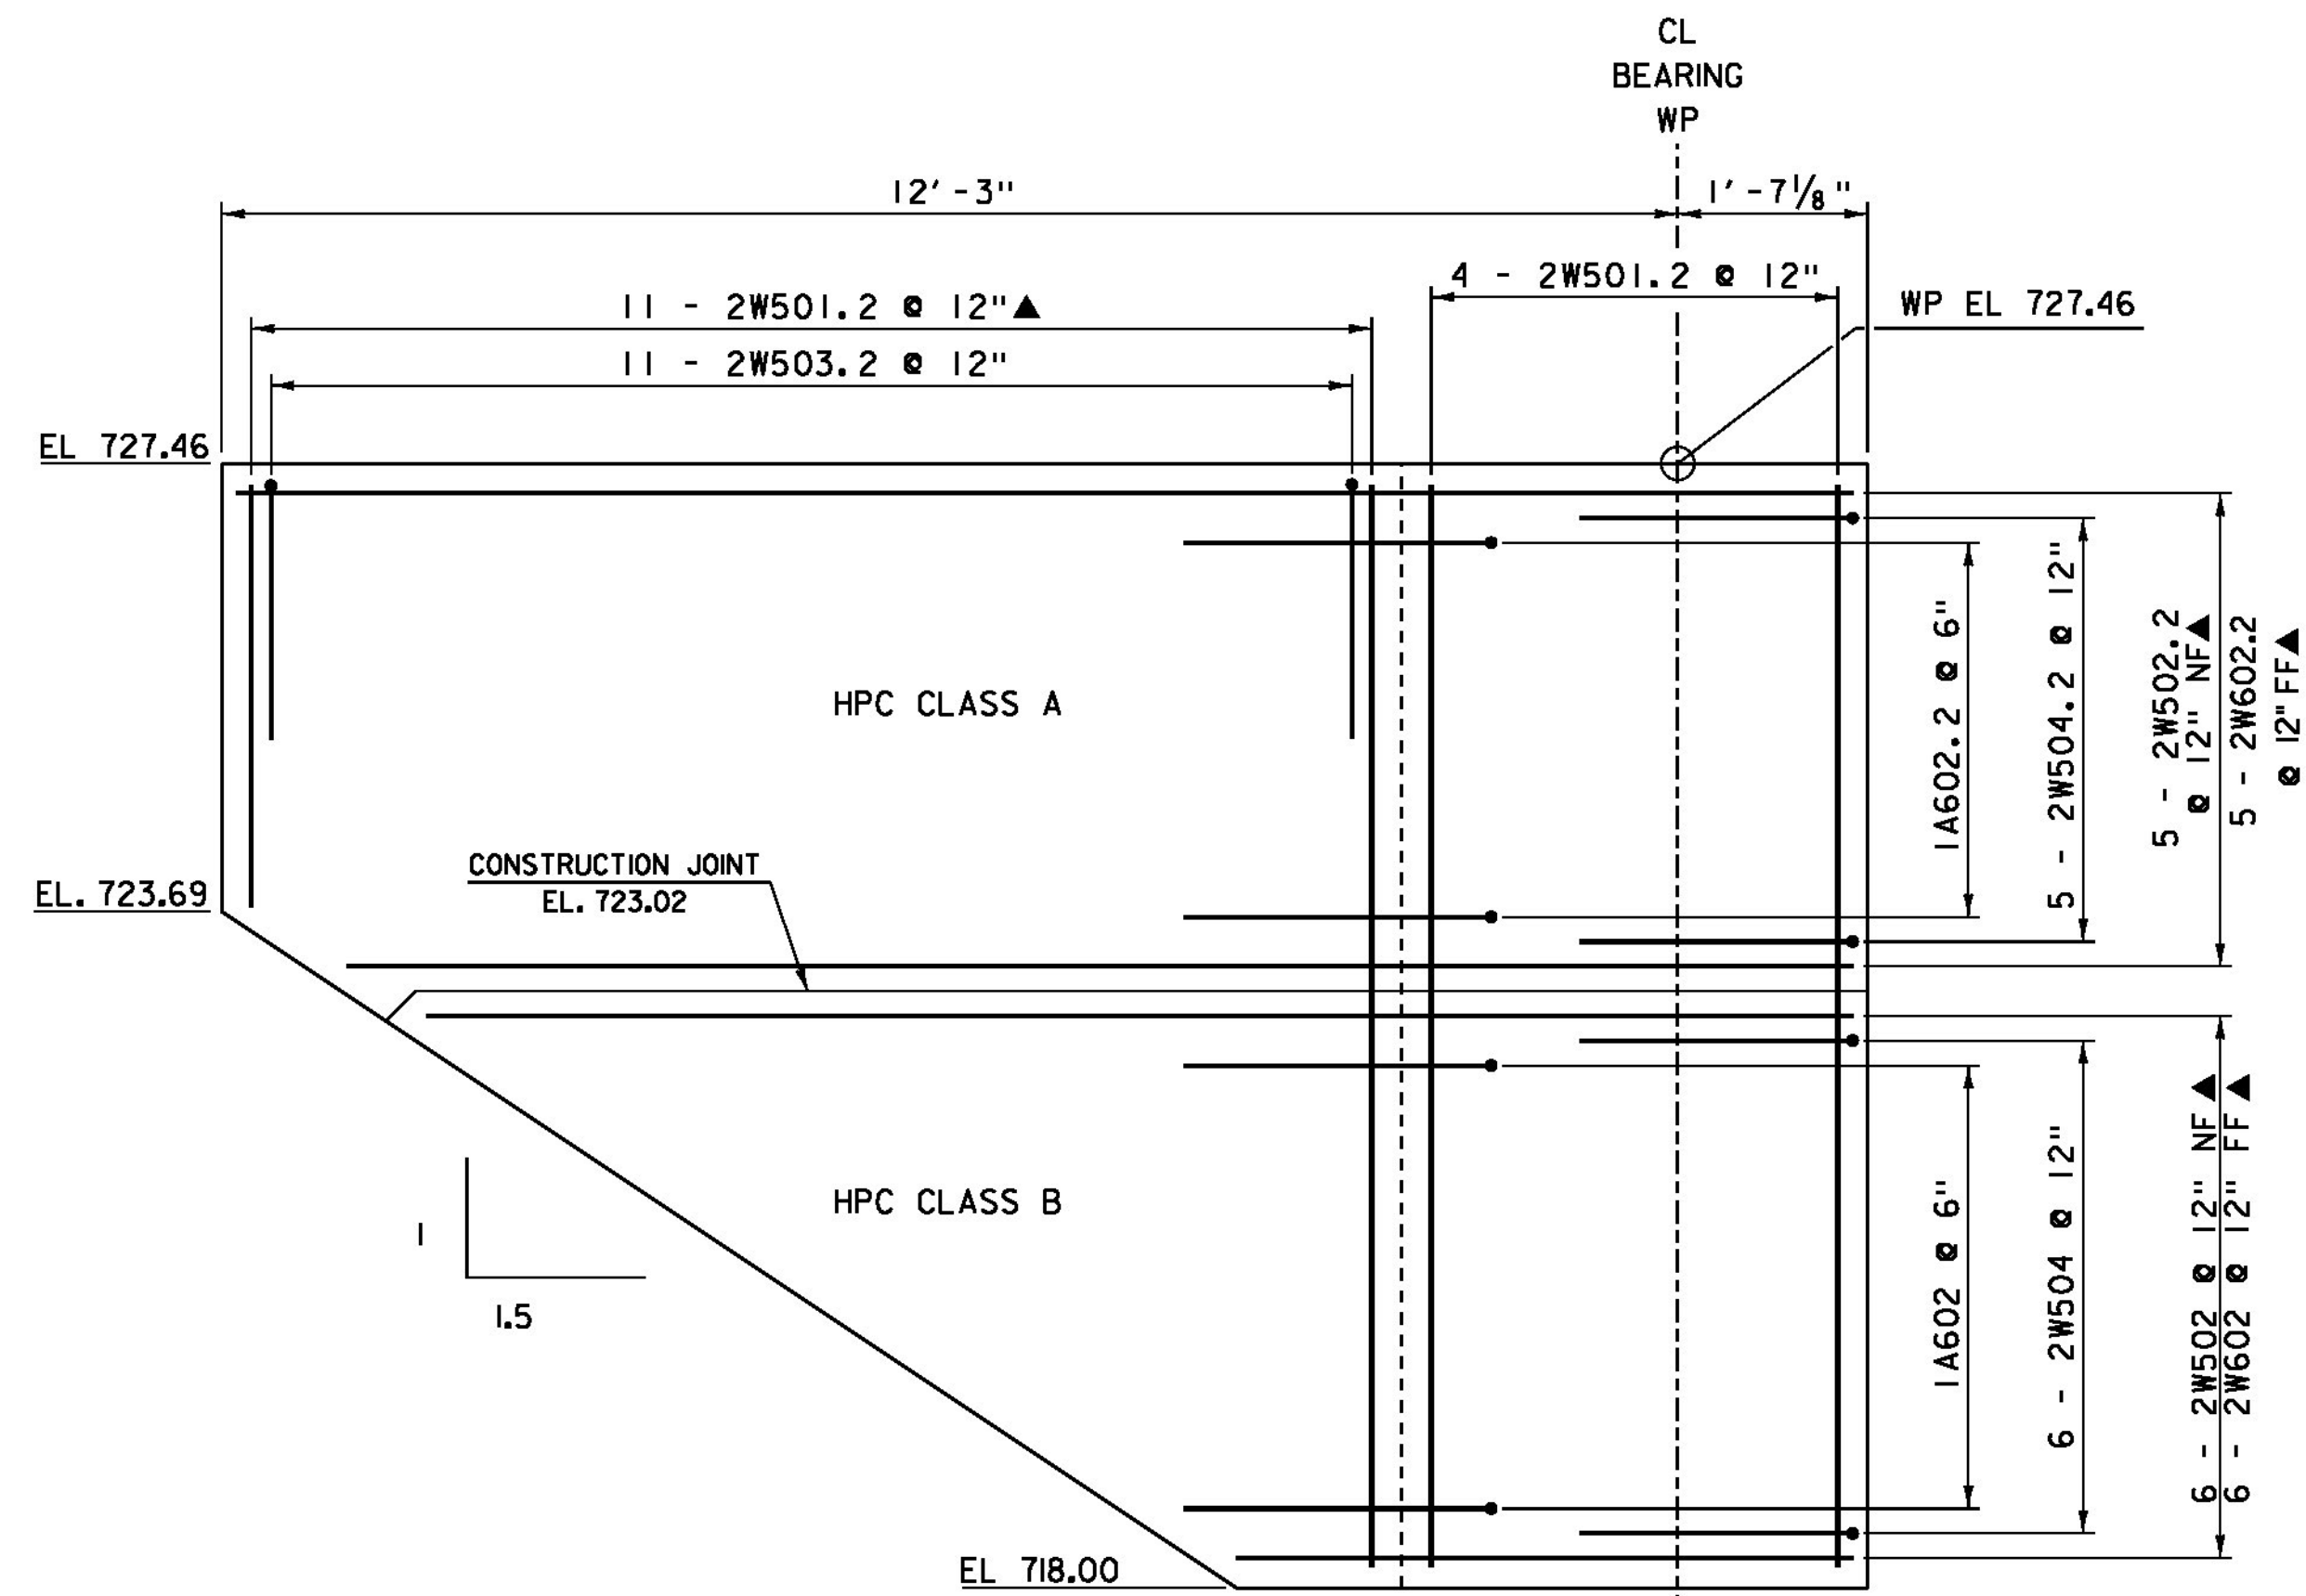


WINGWALL 2 ELEVATION
SCALE 3/4" = 1'-0"

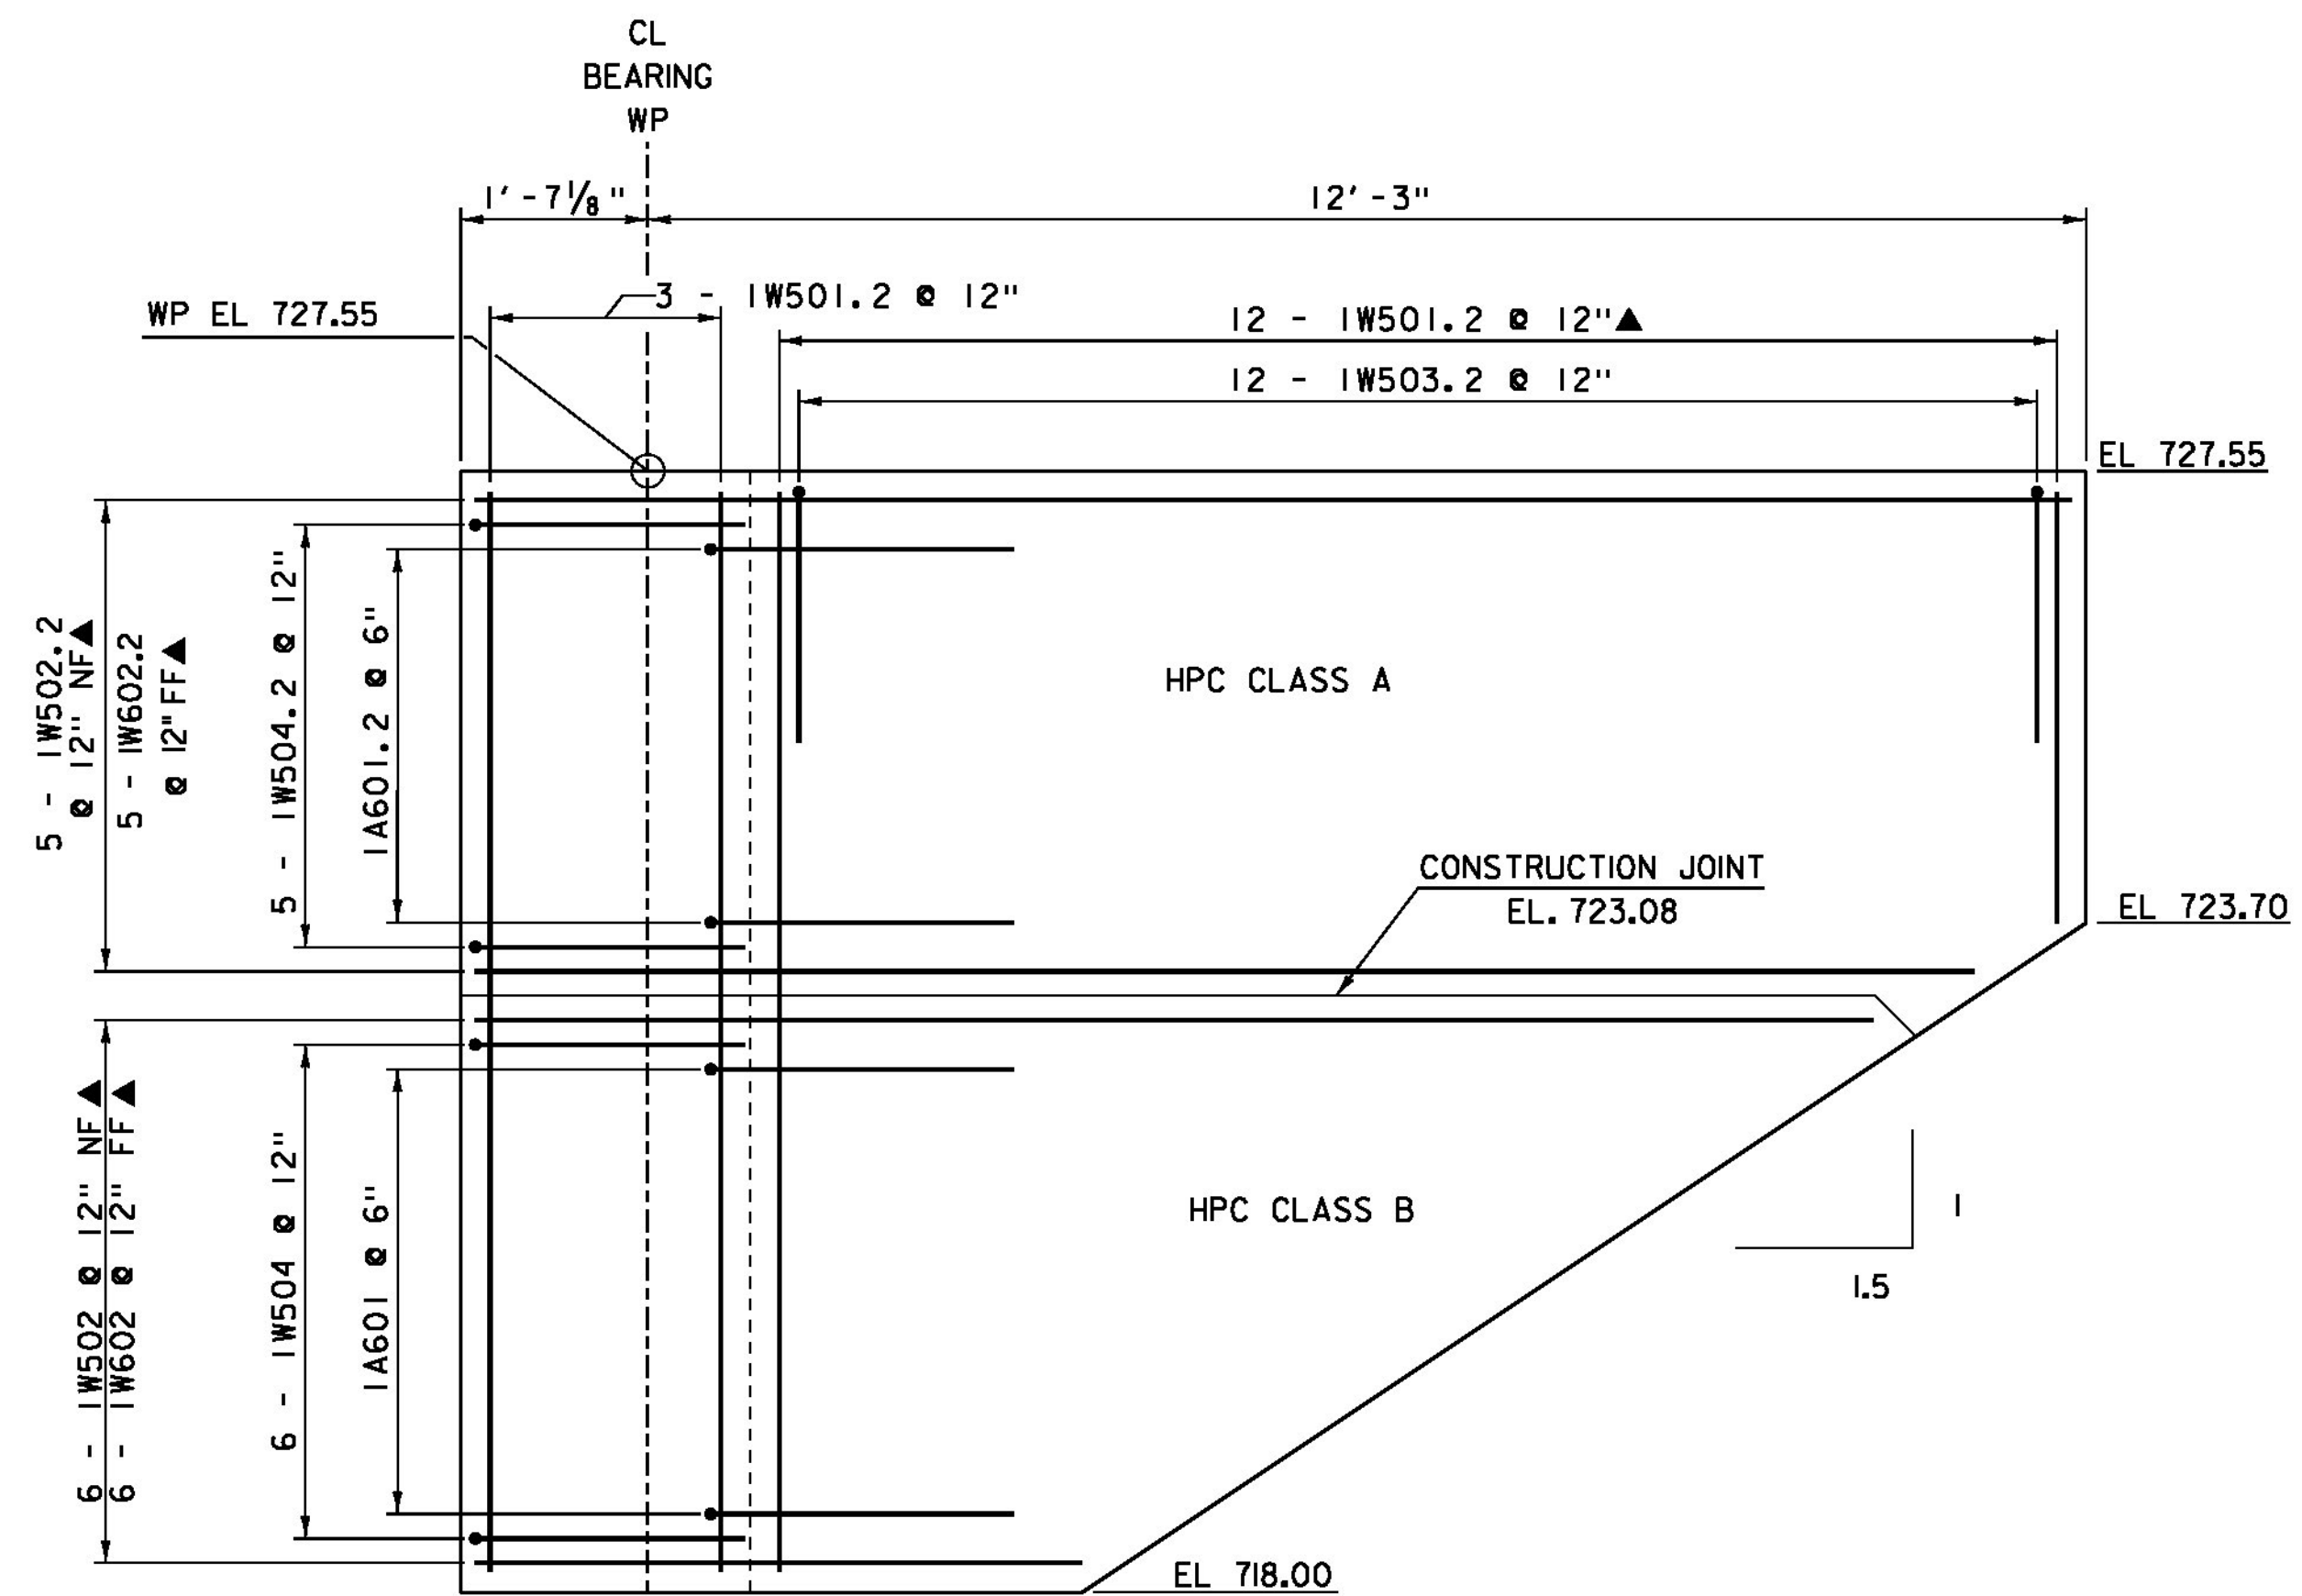

WINGWALL 1 ELEVATION
SCALE 3/4" = 1'-0"

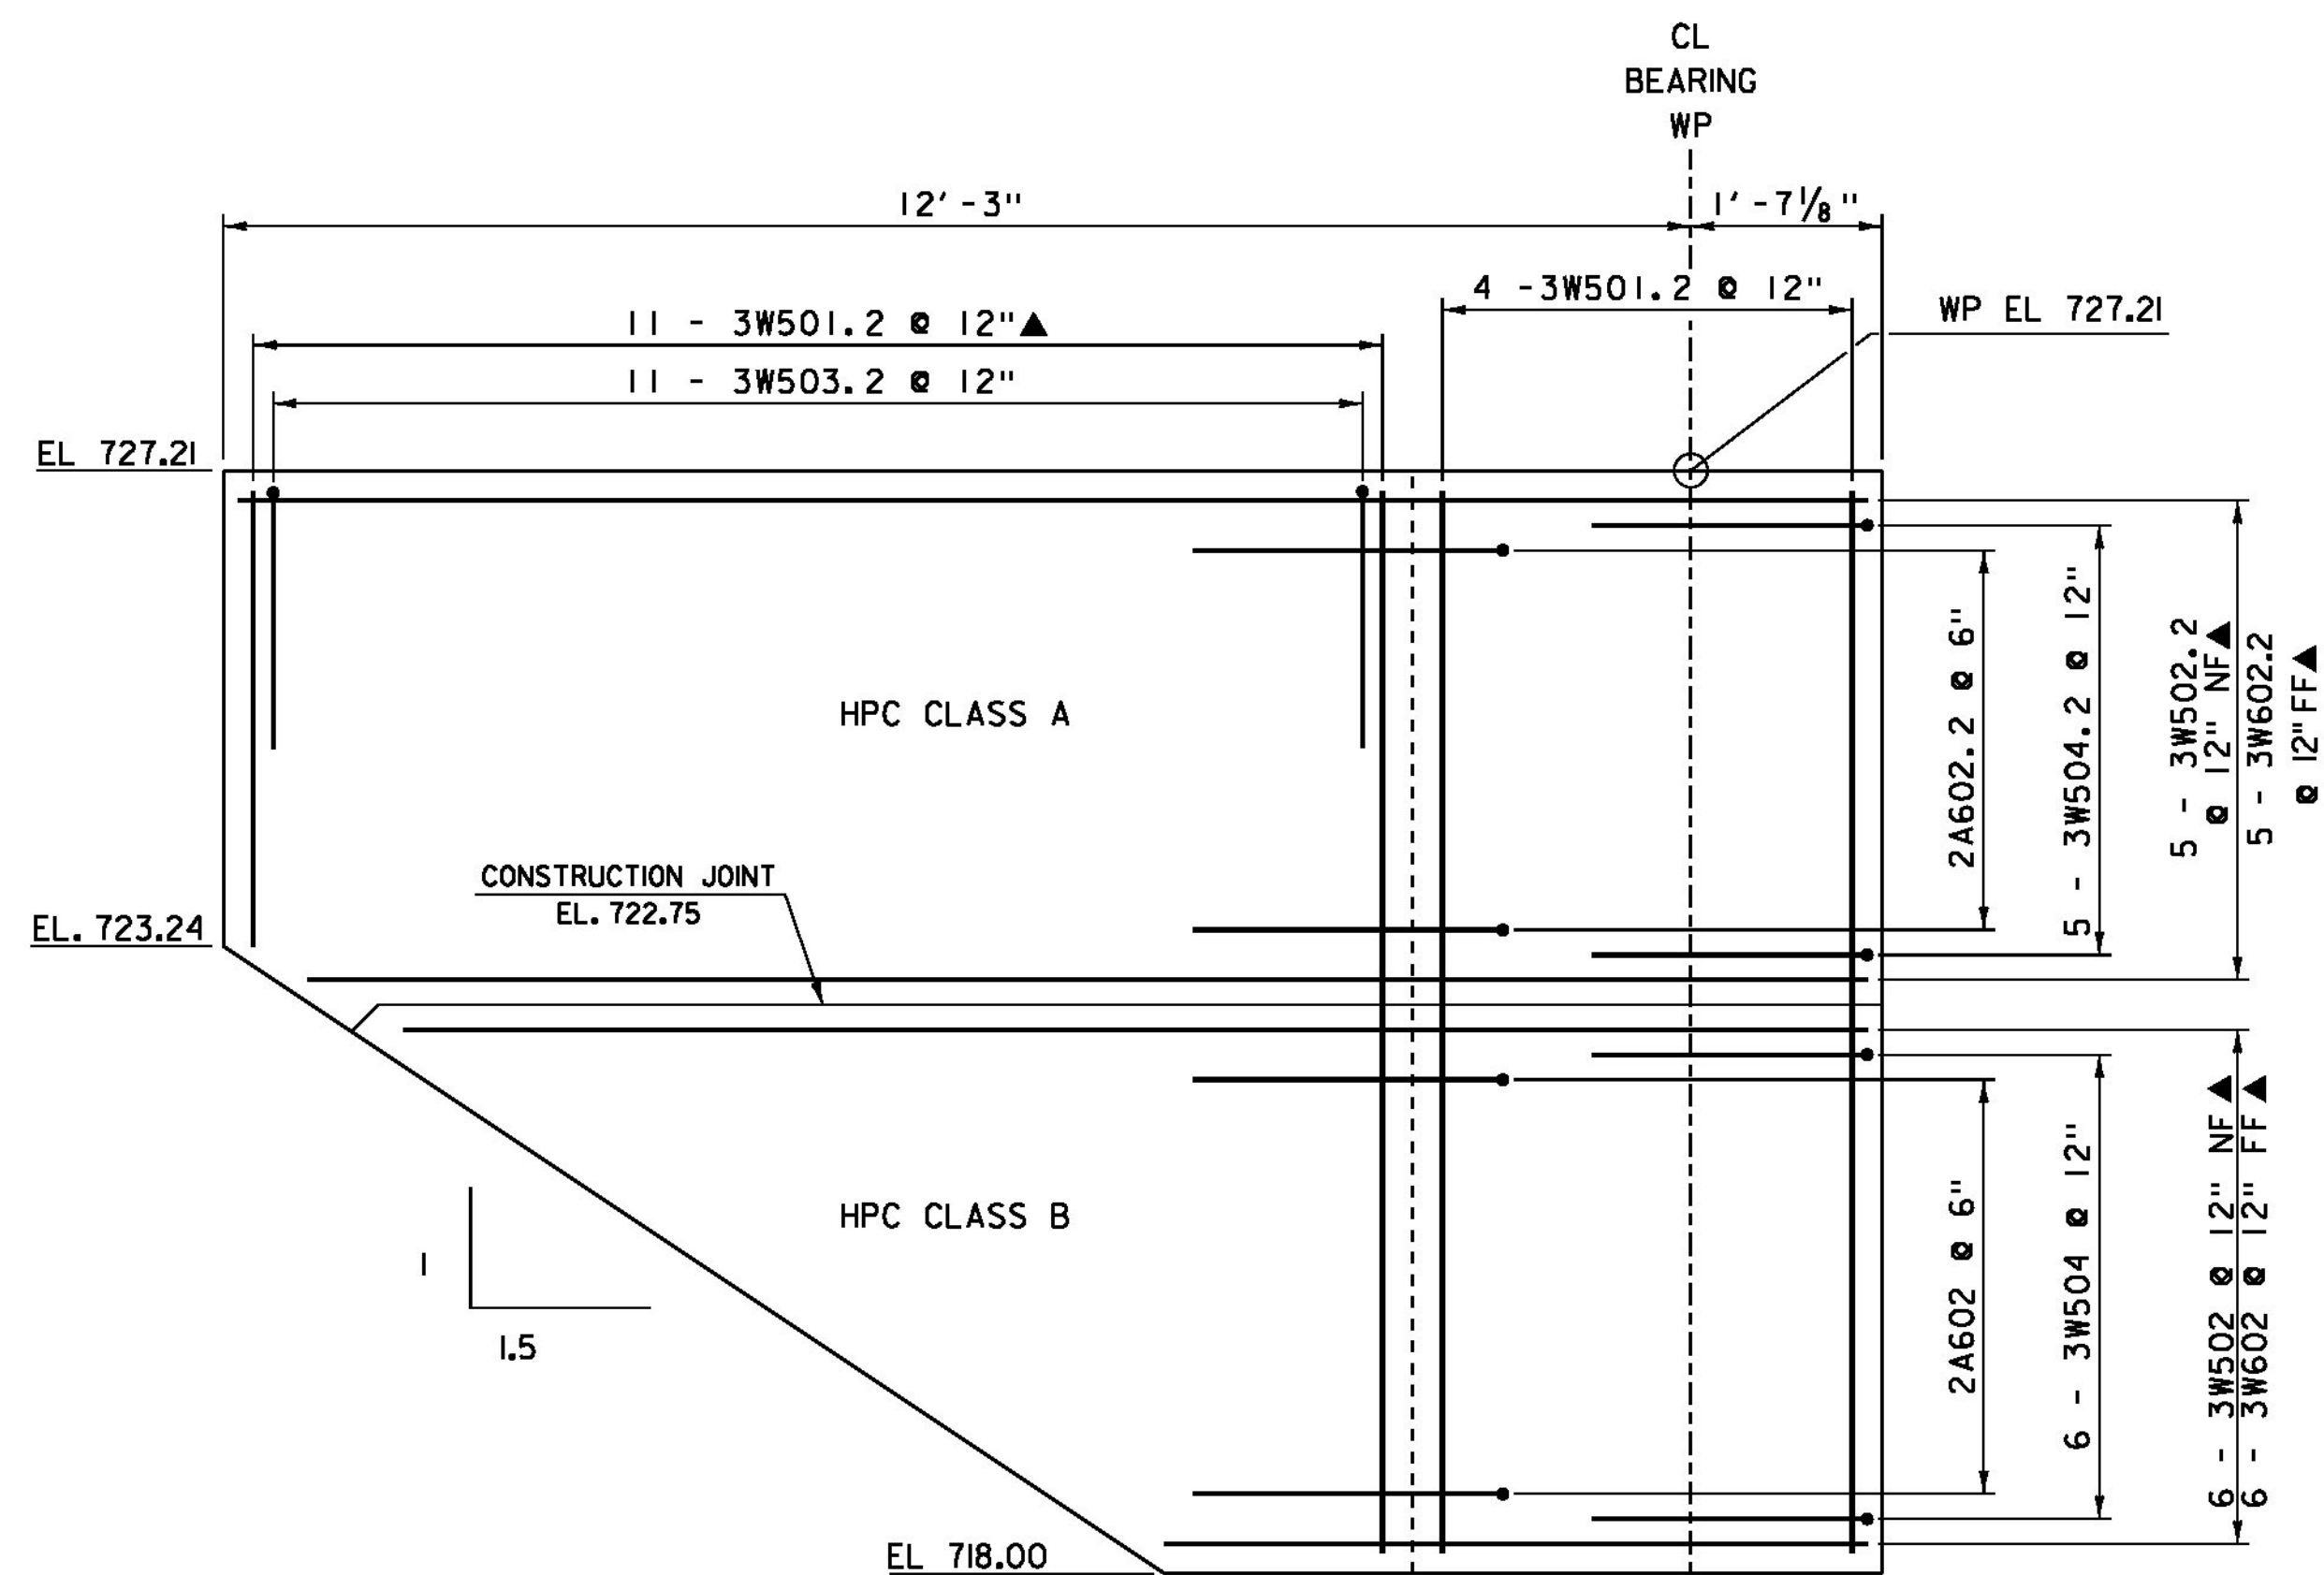


WINGWALL 3 ELEVATION
SCALE 3/4" = 1'-0"

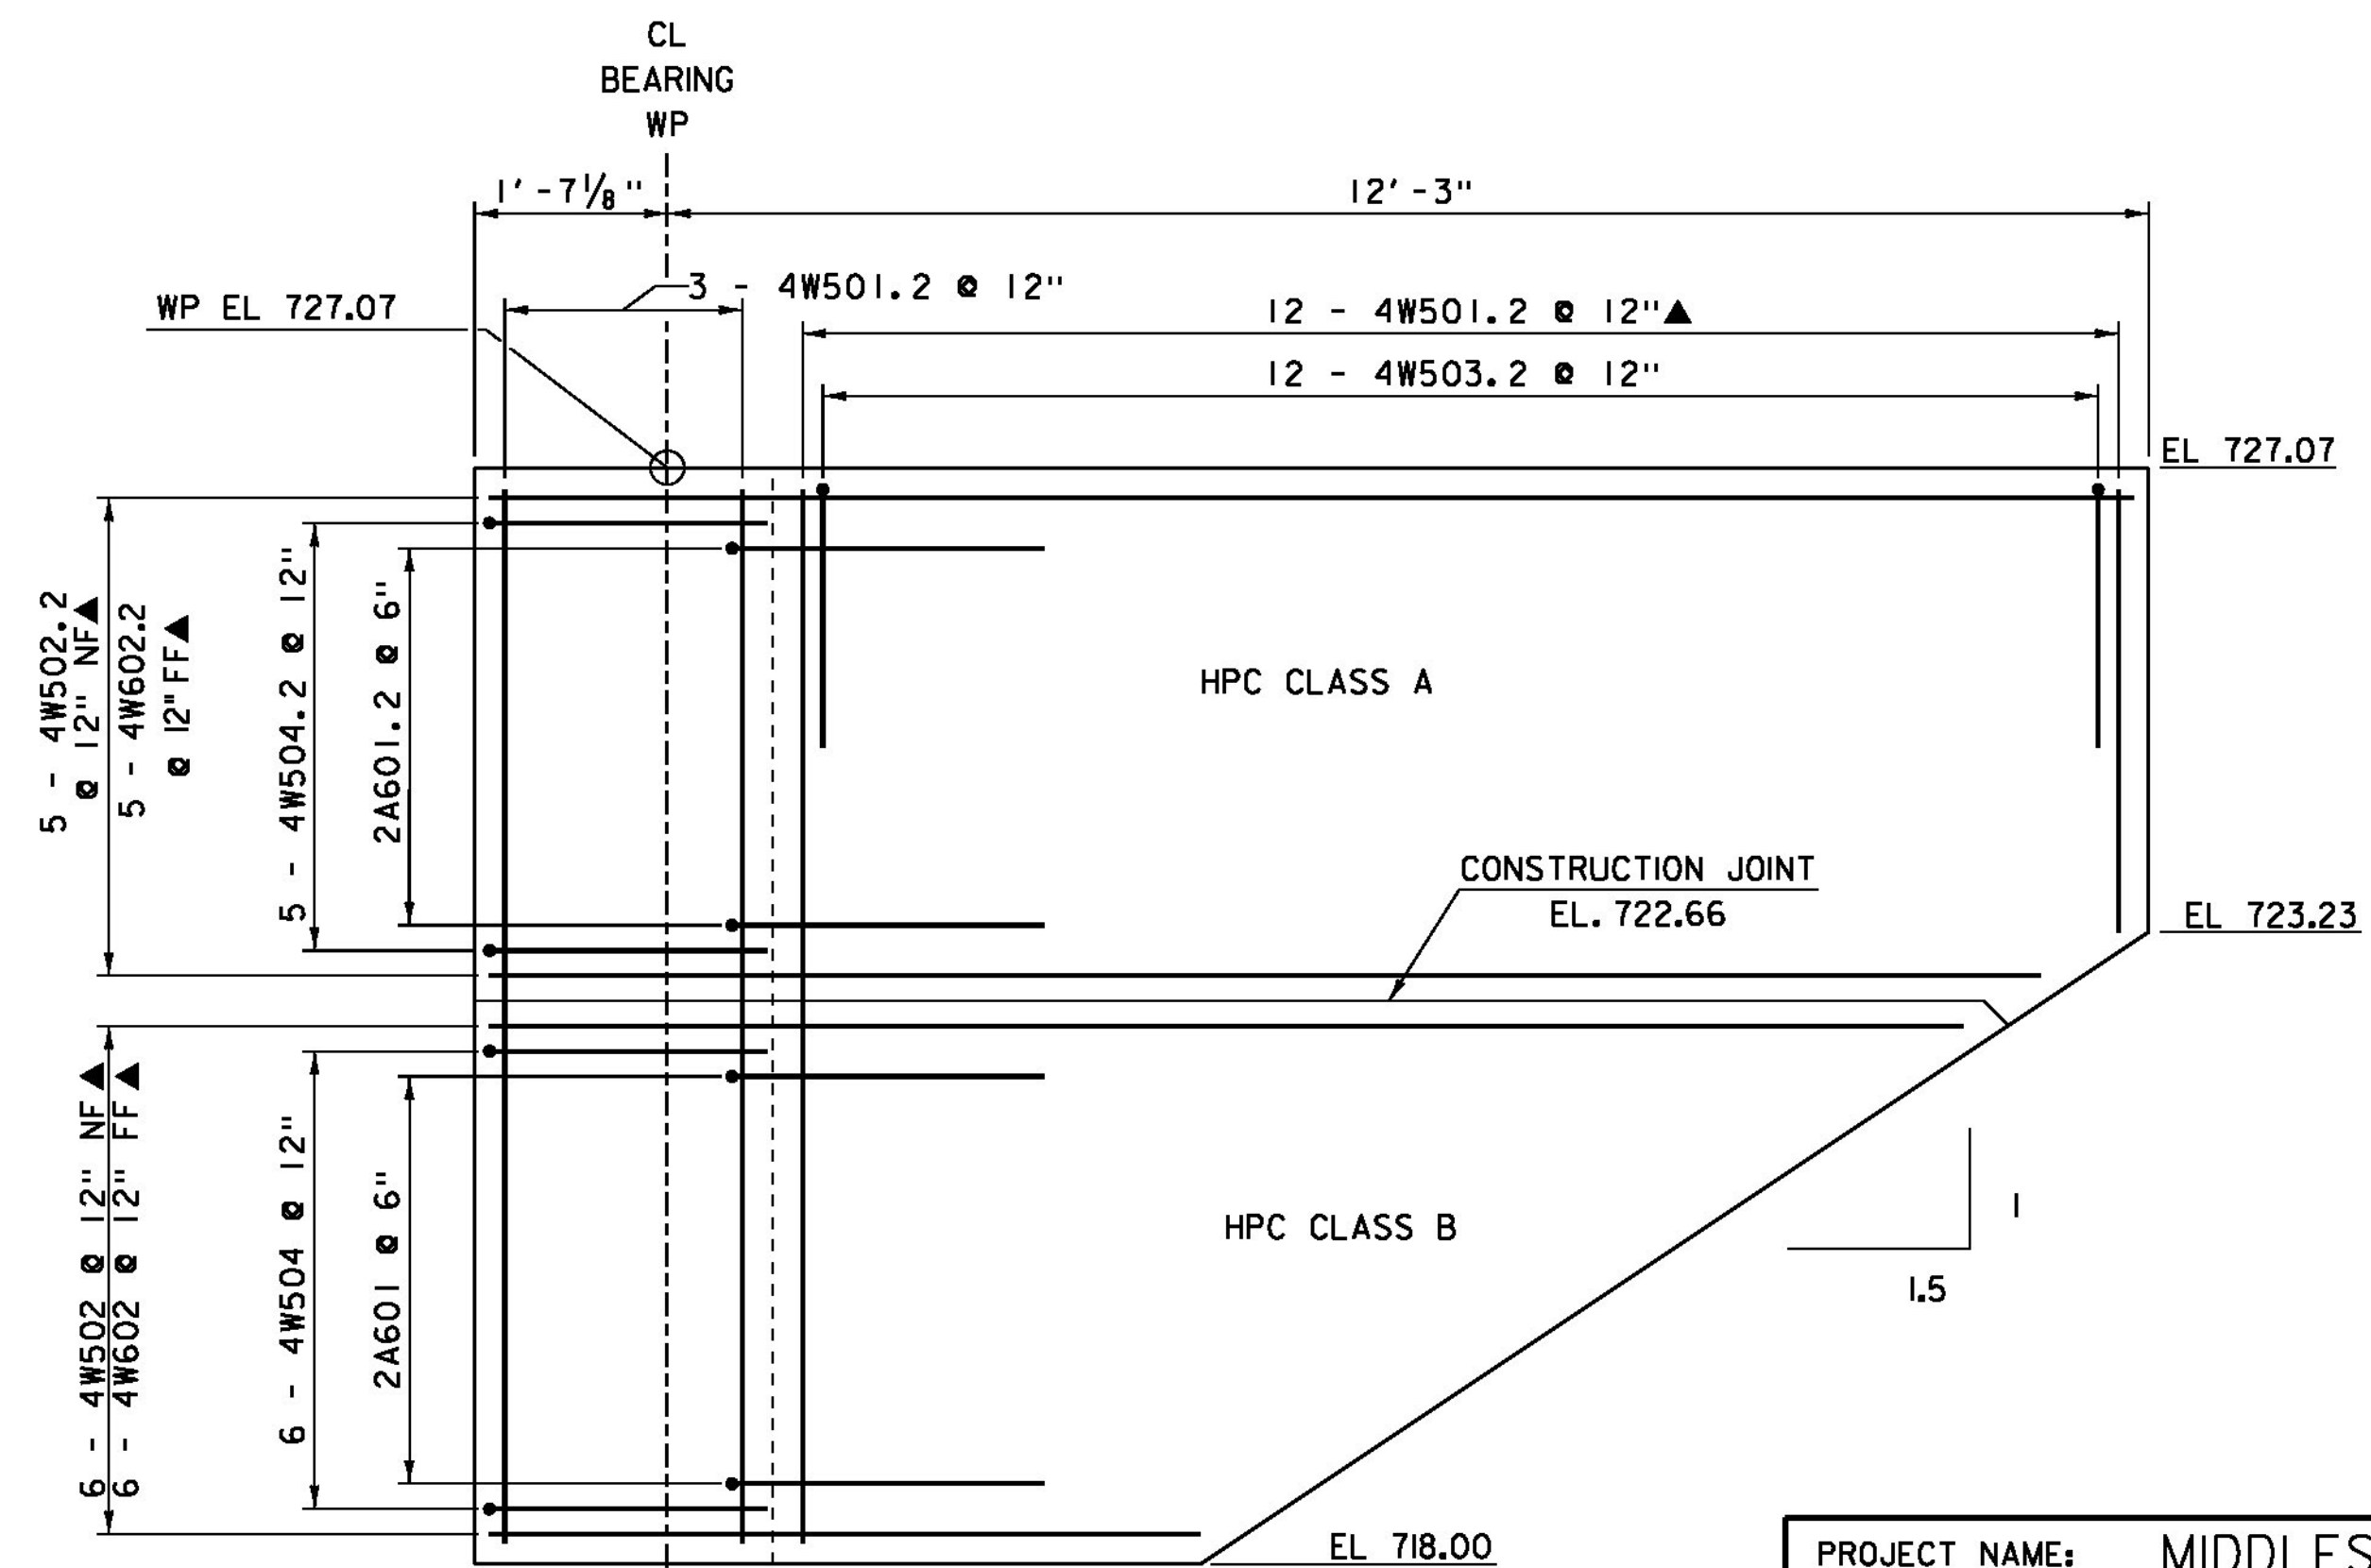


WINGWALL 4 ELEVATION
SCALE 3/4" = 1'-0"

NOTE:
 NF = NEAR FACE
 FF = FAR FACE
 EF = EACH FACE
 ▲ = CUT TO FIT IN FIELD
 3" CLEAR, UNLESS OTHERWISE SPECIFIED ON THE PLANS.
 2'-2" BAR LAP UNLESS OTHERWISE SPECIFIED ON THE PLANS.


PROJECT NAME:	MIDDLESEX	PLOT DATE:	06-FEB-2015
PROJECT NUMBER:	BRF 024-(K37)	DRAWN BY:	C. BURRALL
FILE NAME:	sl0c220sub.dgn	DESIGNED BY:	H. SALLS
PROJECT LEADER:	C. CARLSON	WINGWALL ELEVATIONS	CHECKED BY: H. SALLS
			SHEET 28 OF 46

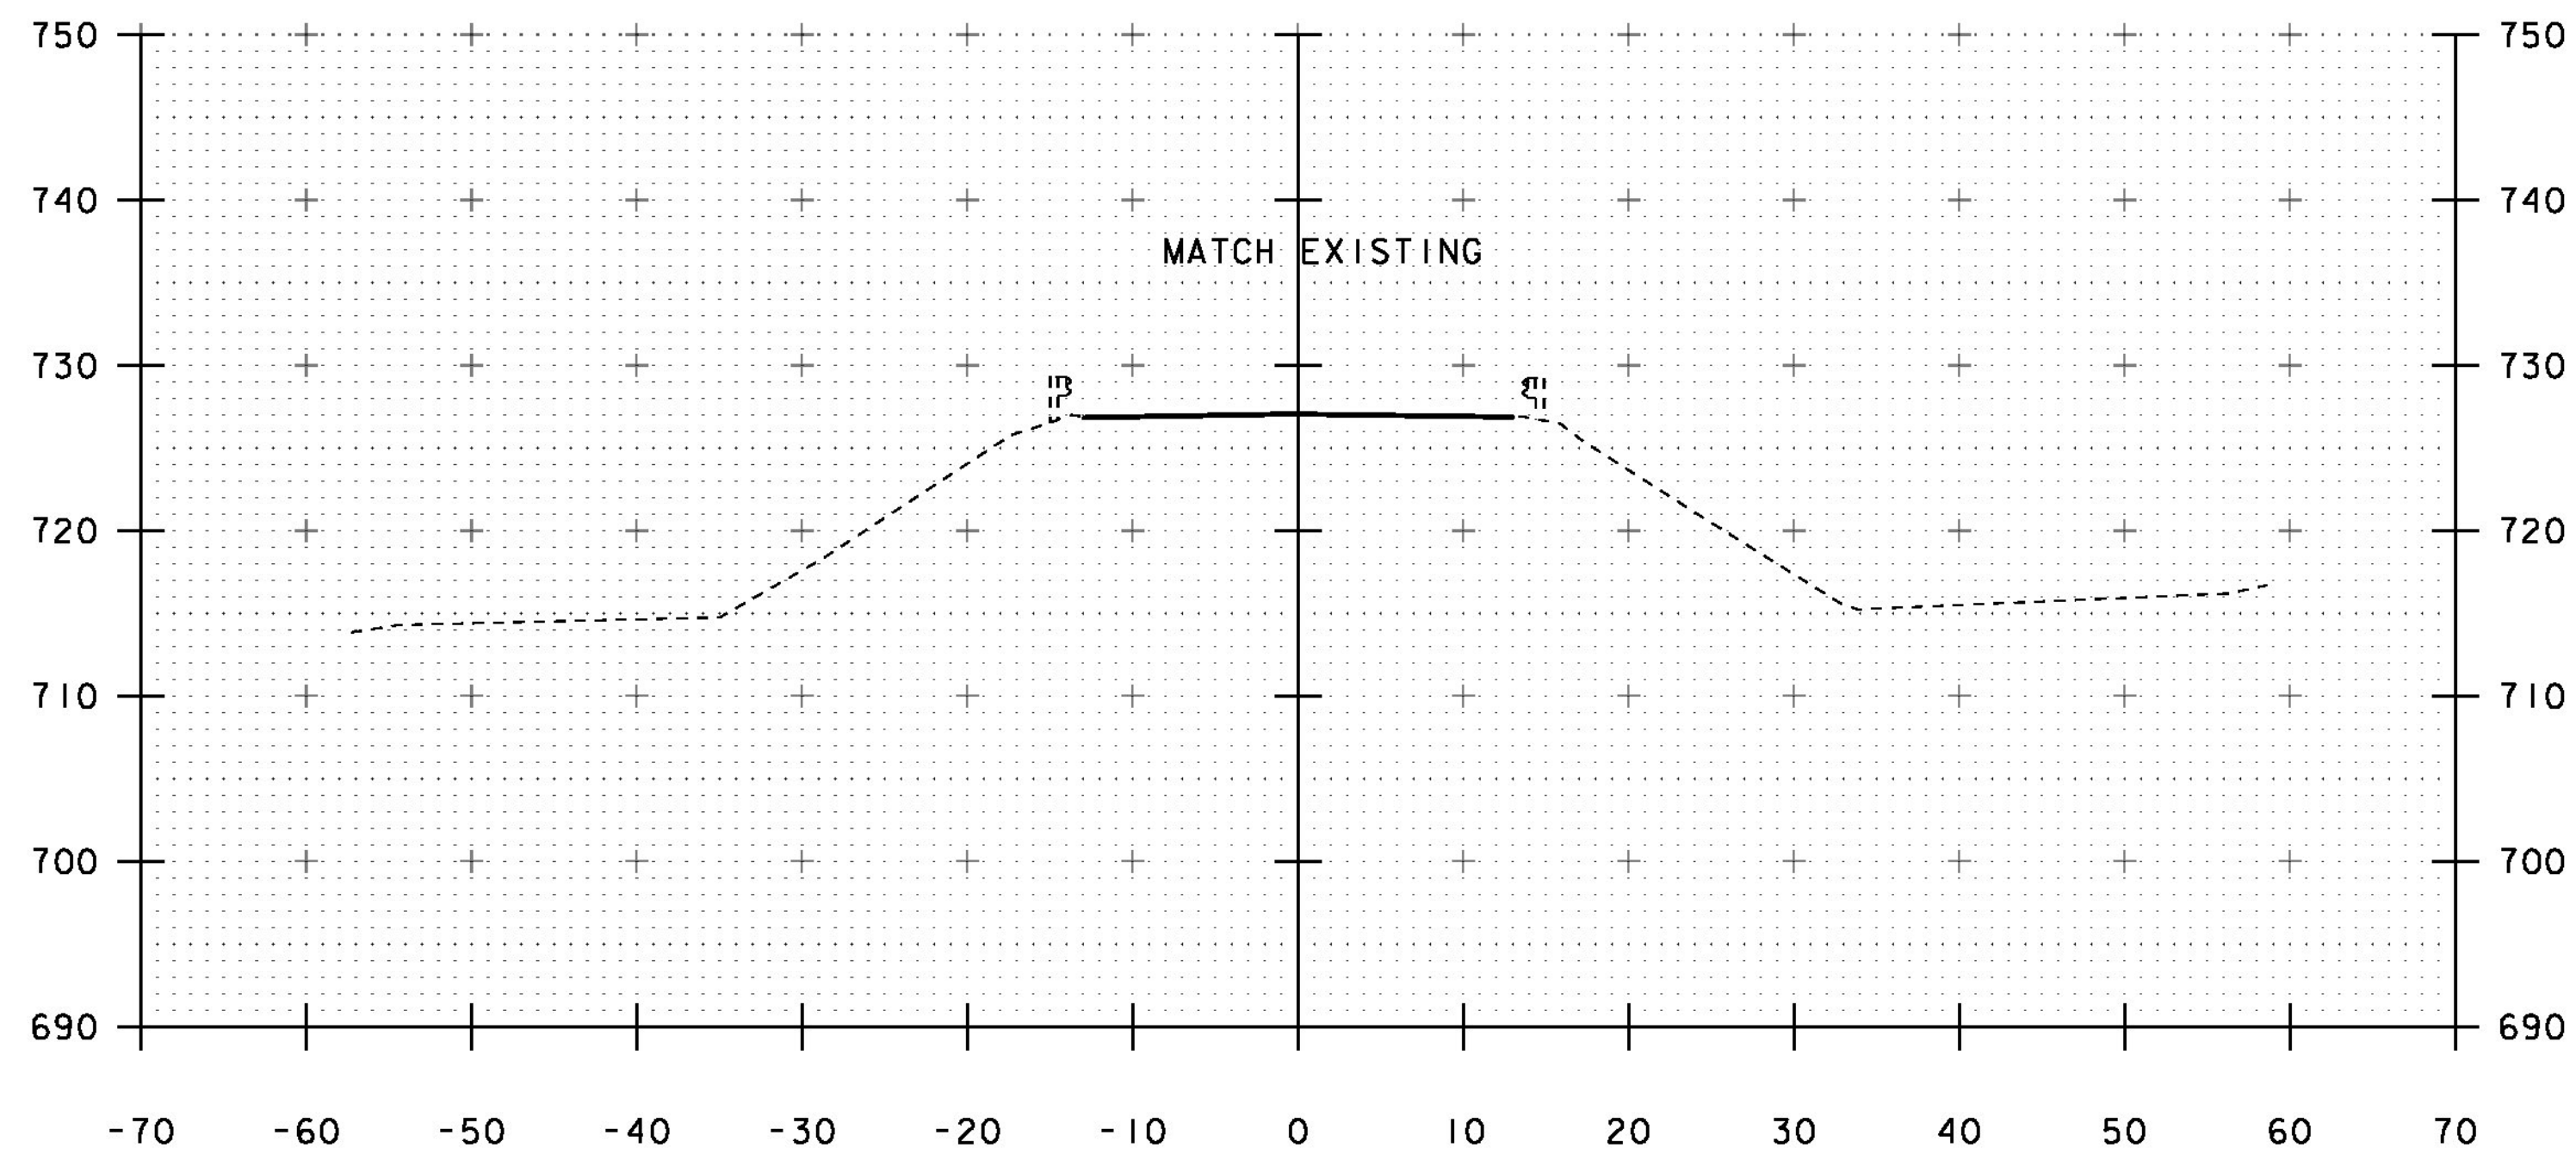


26+75
BEGIN APPROACH

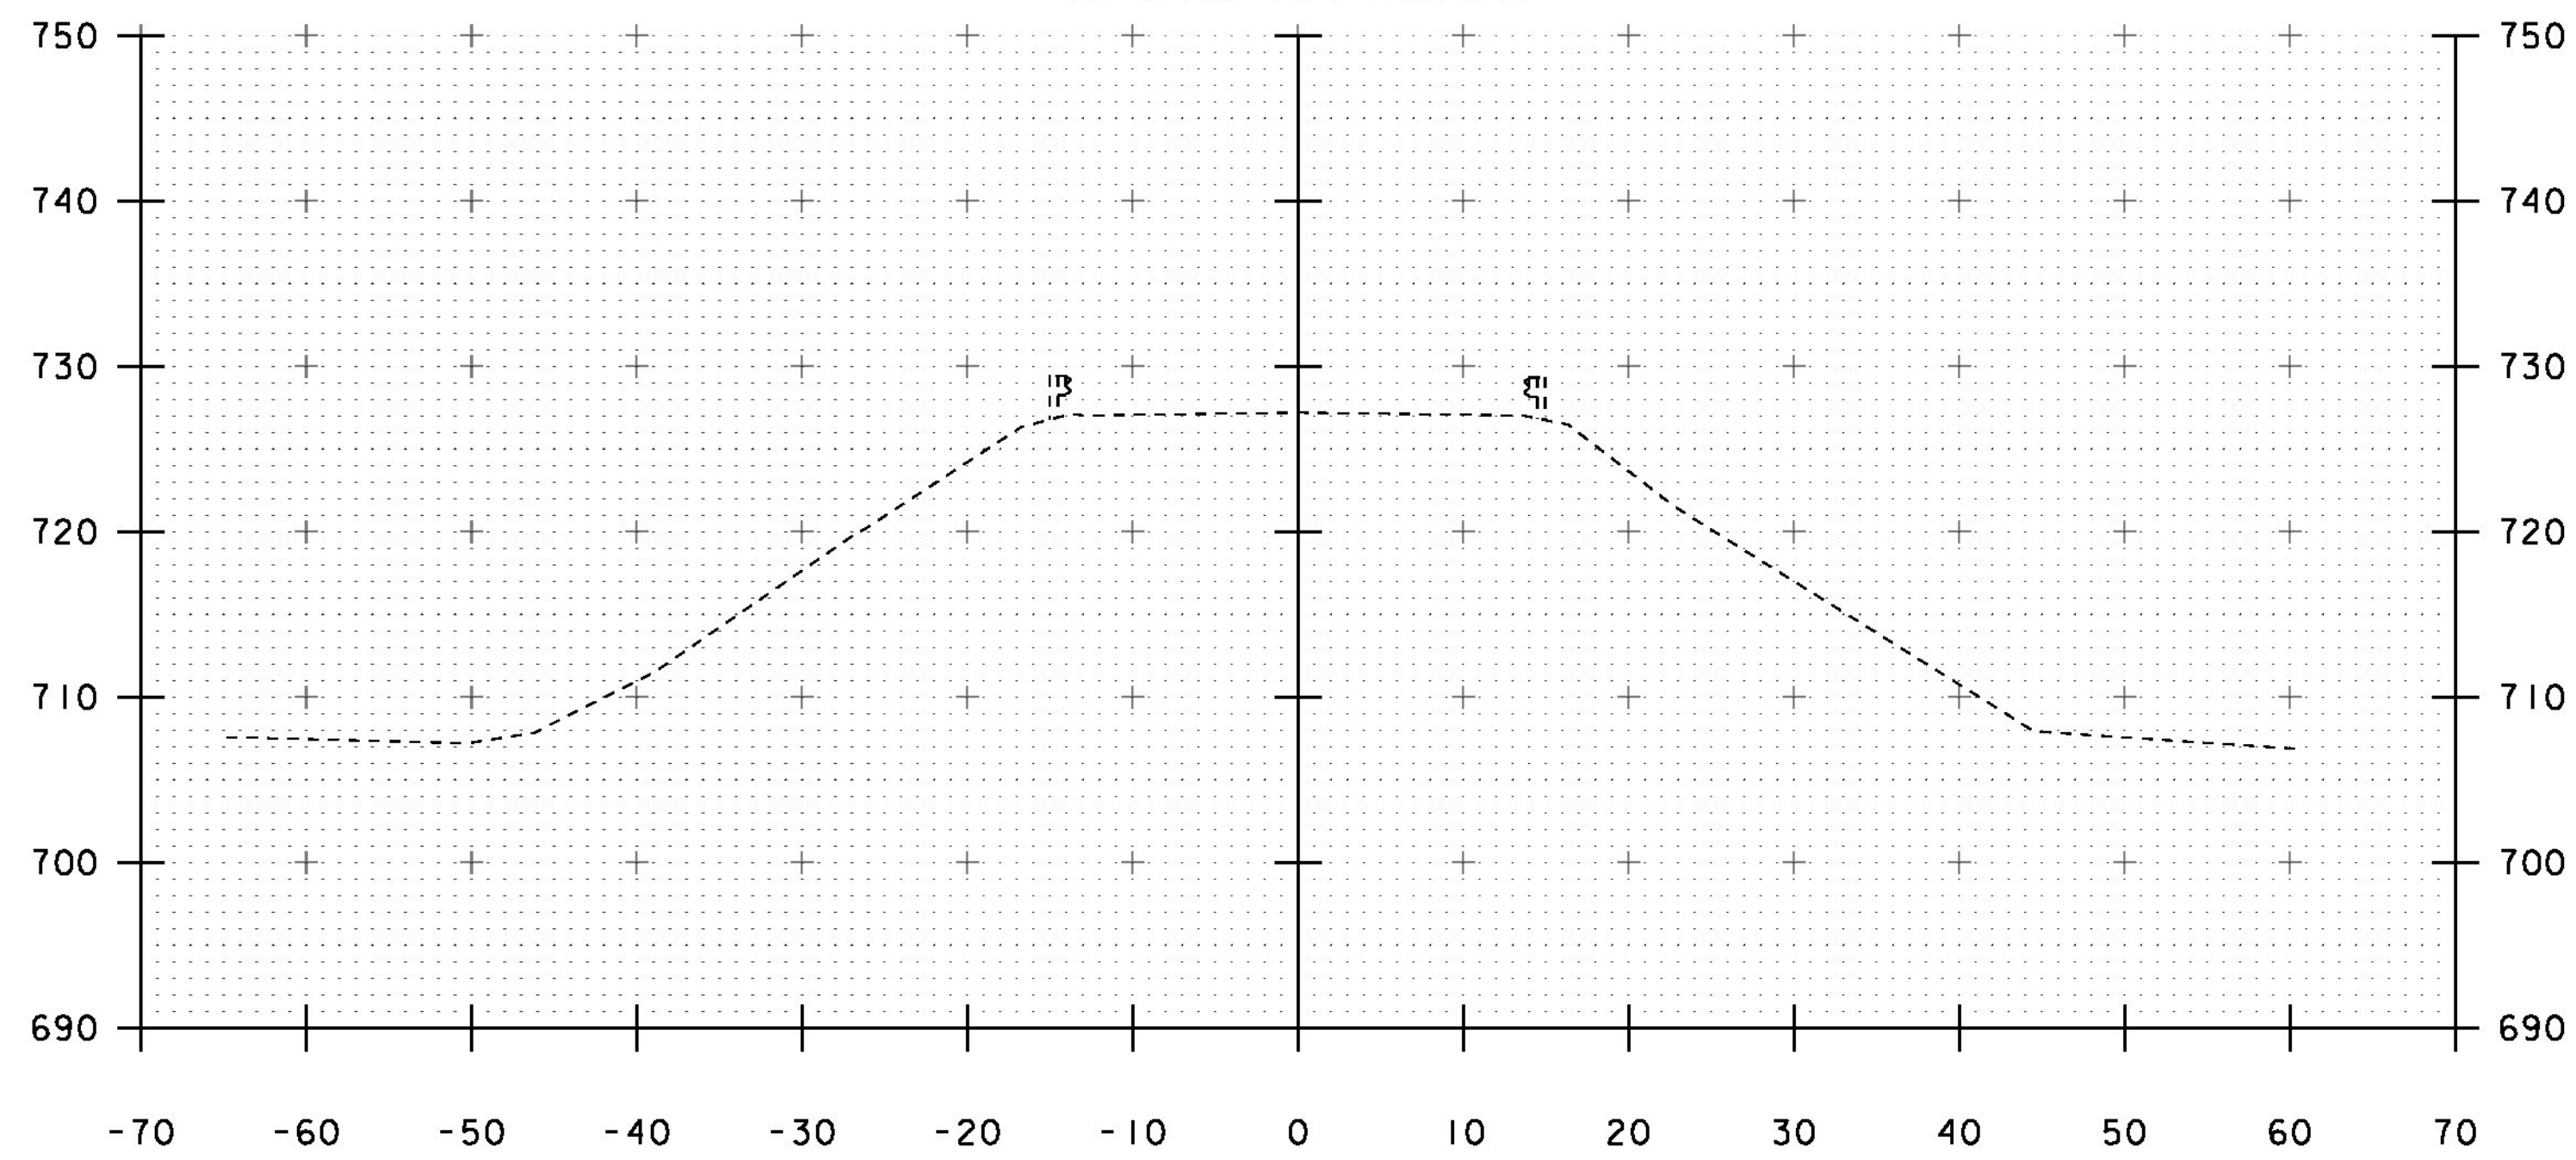

26+50

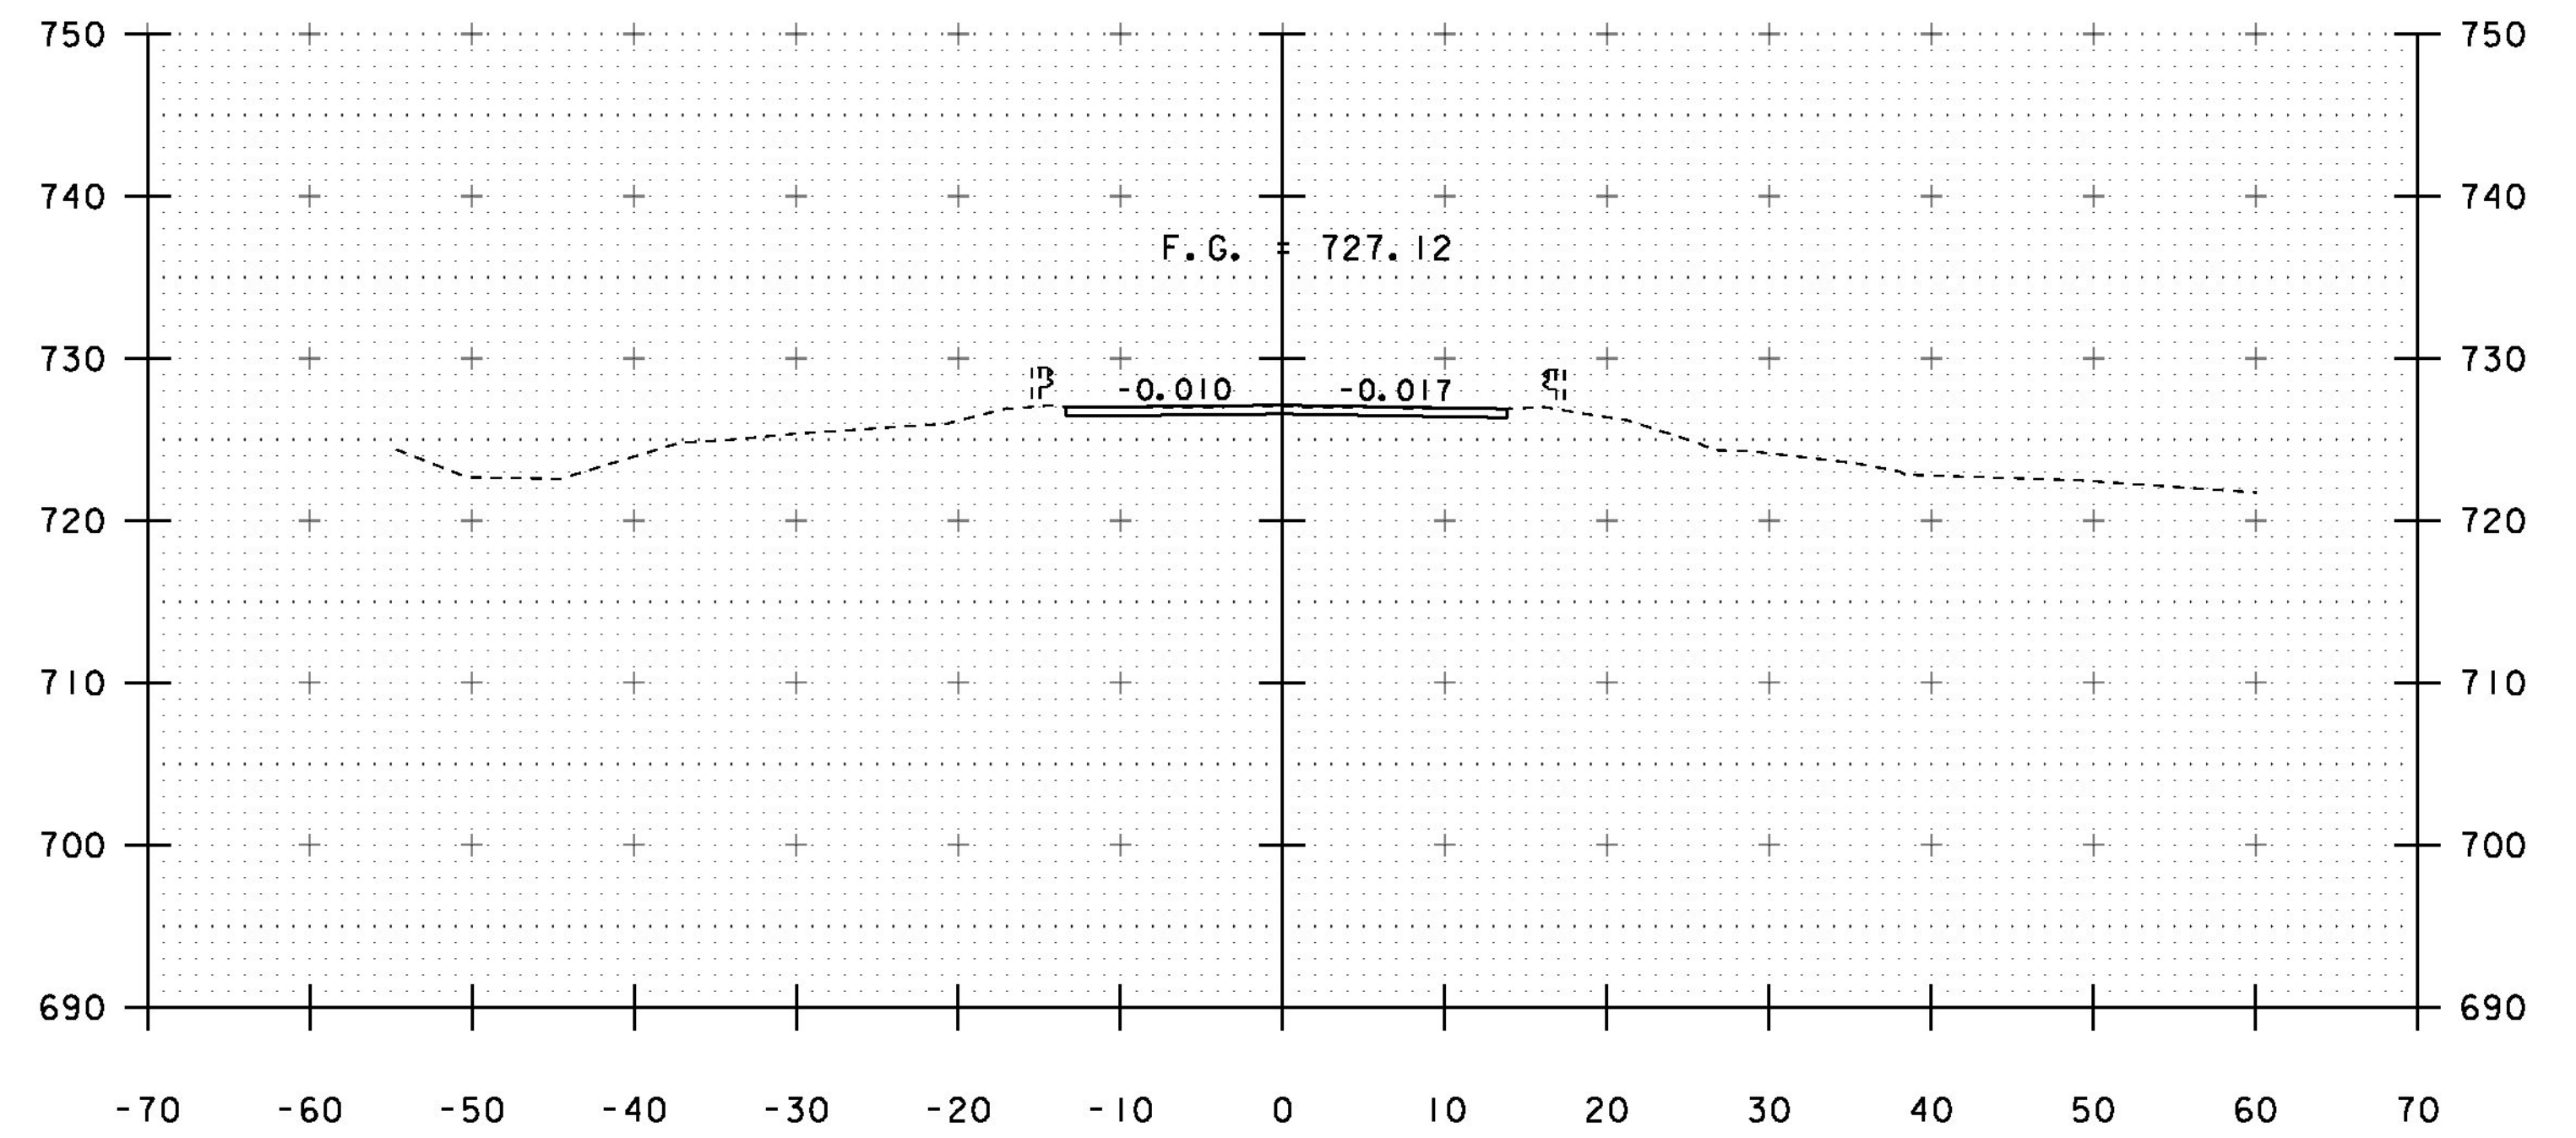

27+25

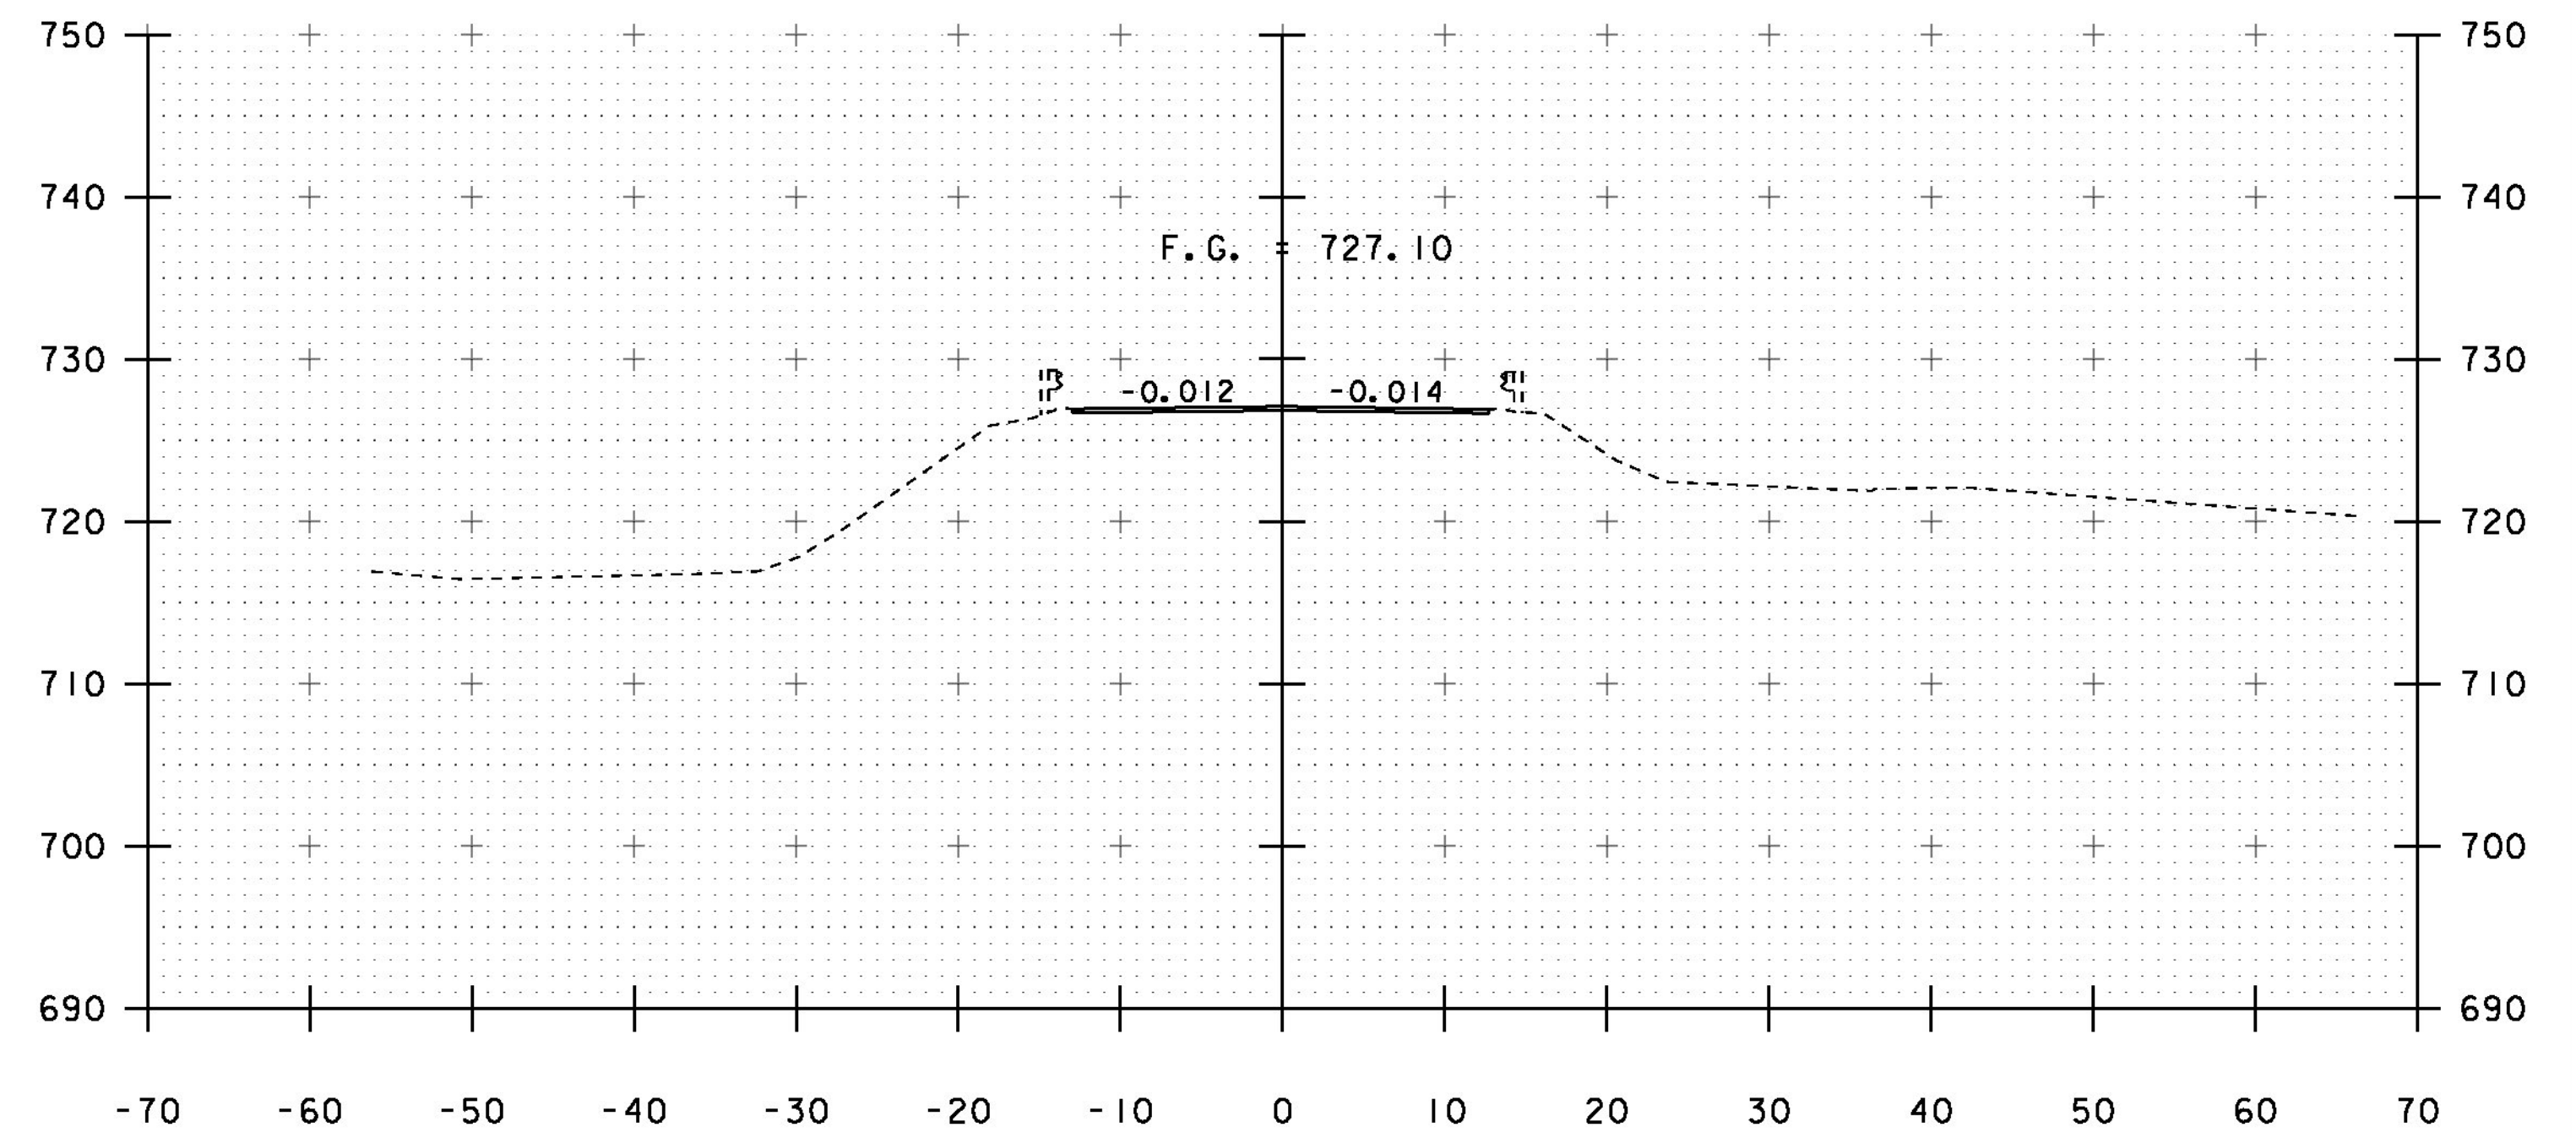


27+00

STA. 26+50 TO STA. 27+25


PROJECT NAME: MIDDLESEX
PROJECT NUMBER: BR 024-1(37)

FILE NAME: sl0c220xs.dgn
PROJECT LEADER: C. CARLSON
DESIGNED BY: H. SALLS
VT 12 CROSS SECTIONS 1


PLOT DATE: 13-JAN-2015
DRAWN BY: R. PELLETT
CHECKED BY: H. SALLS
SHEET 30 OF 46

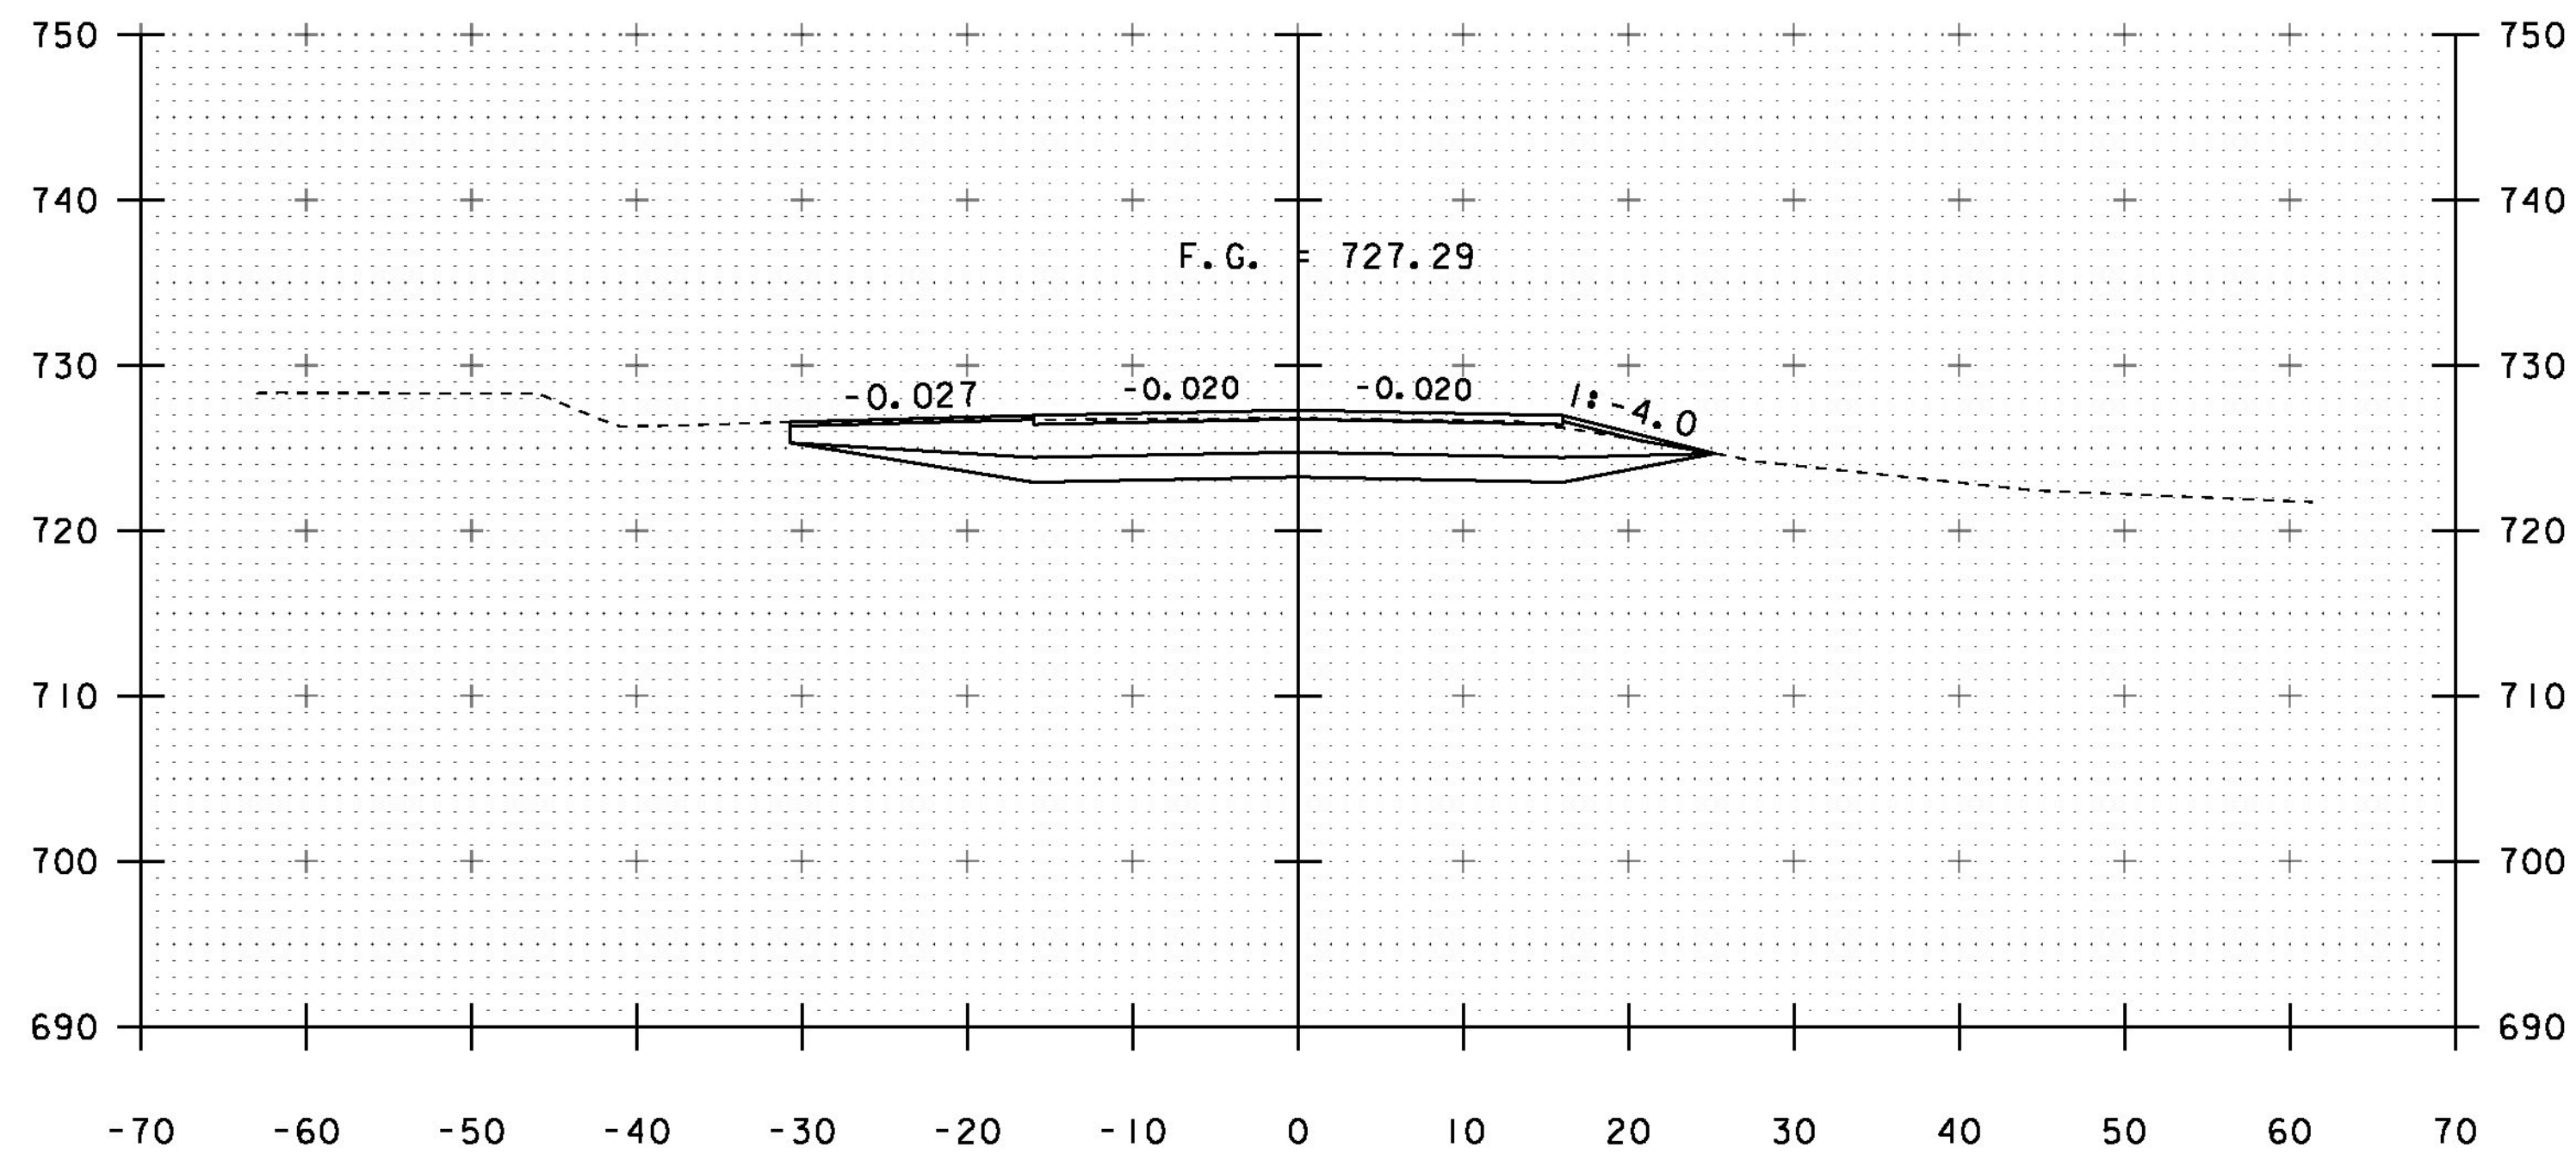


27+75
BEGIN PROJECT

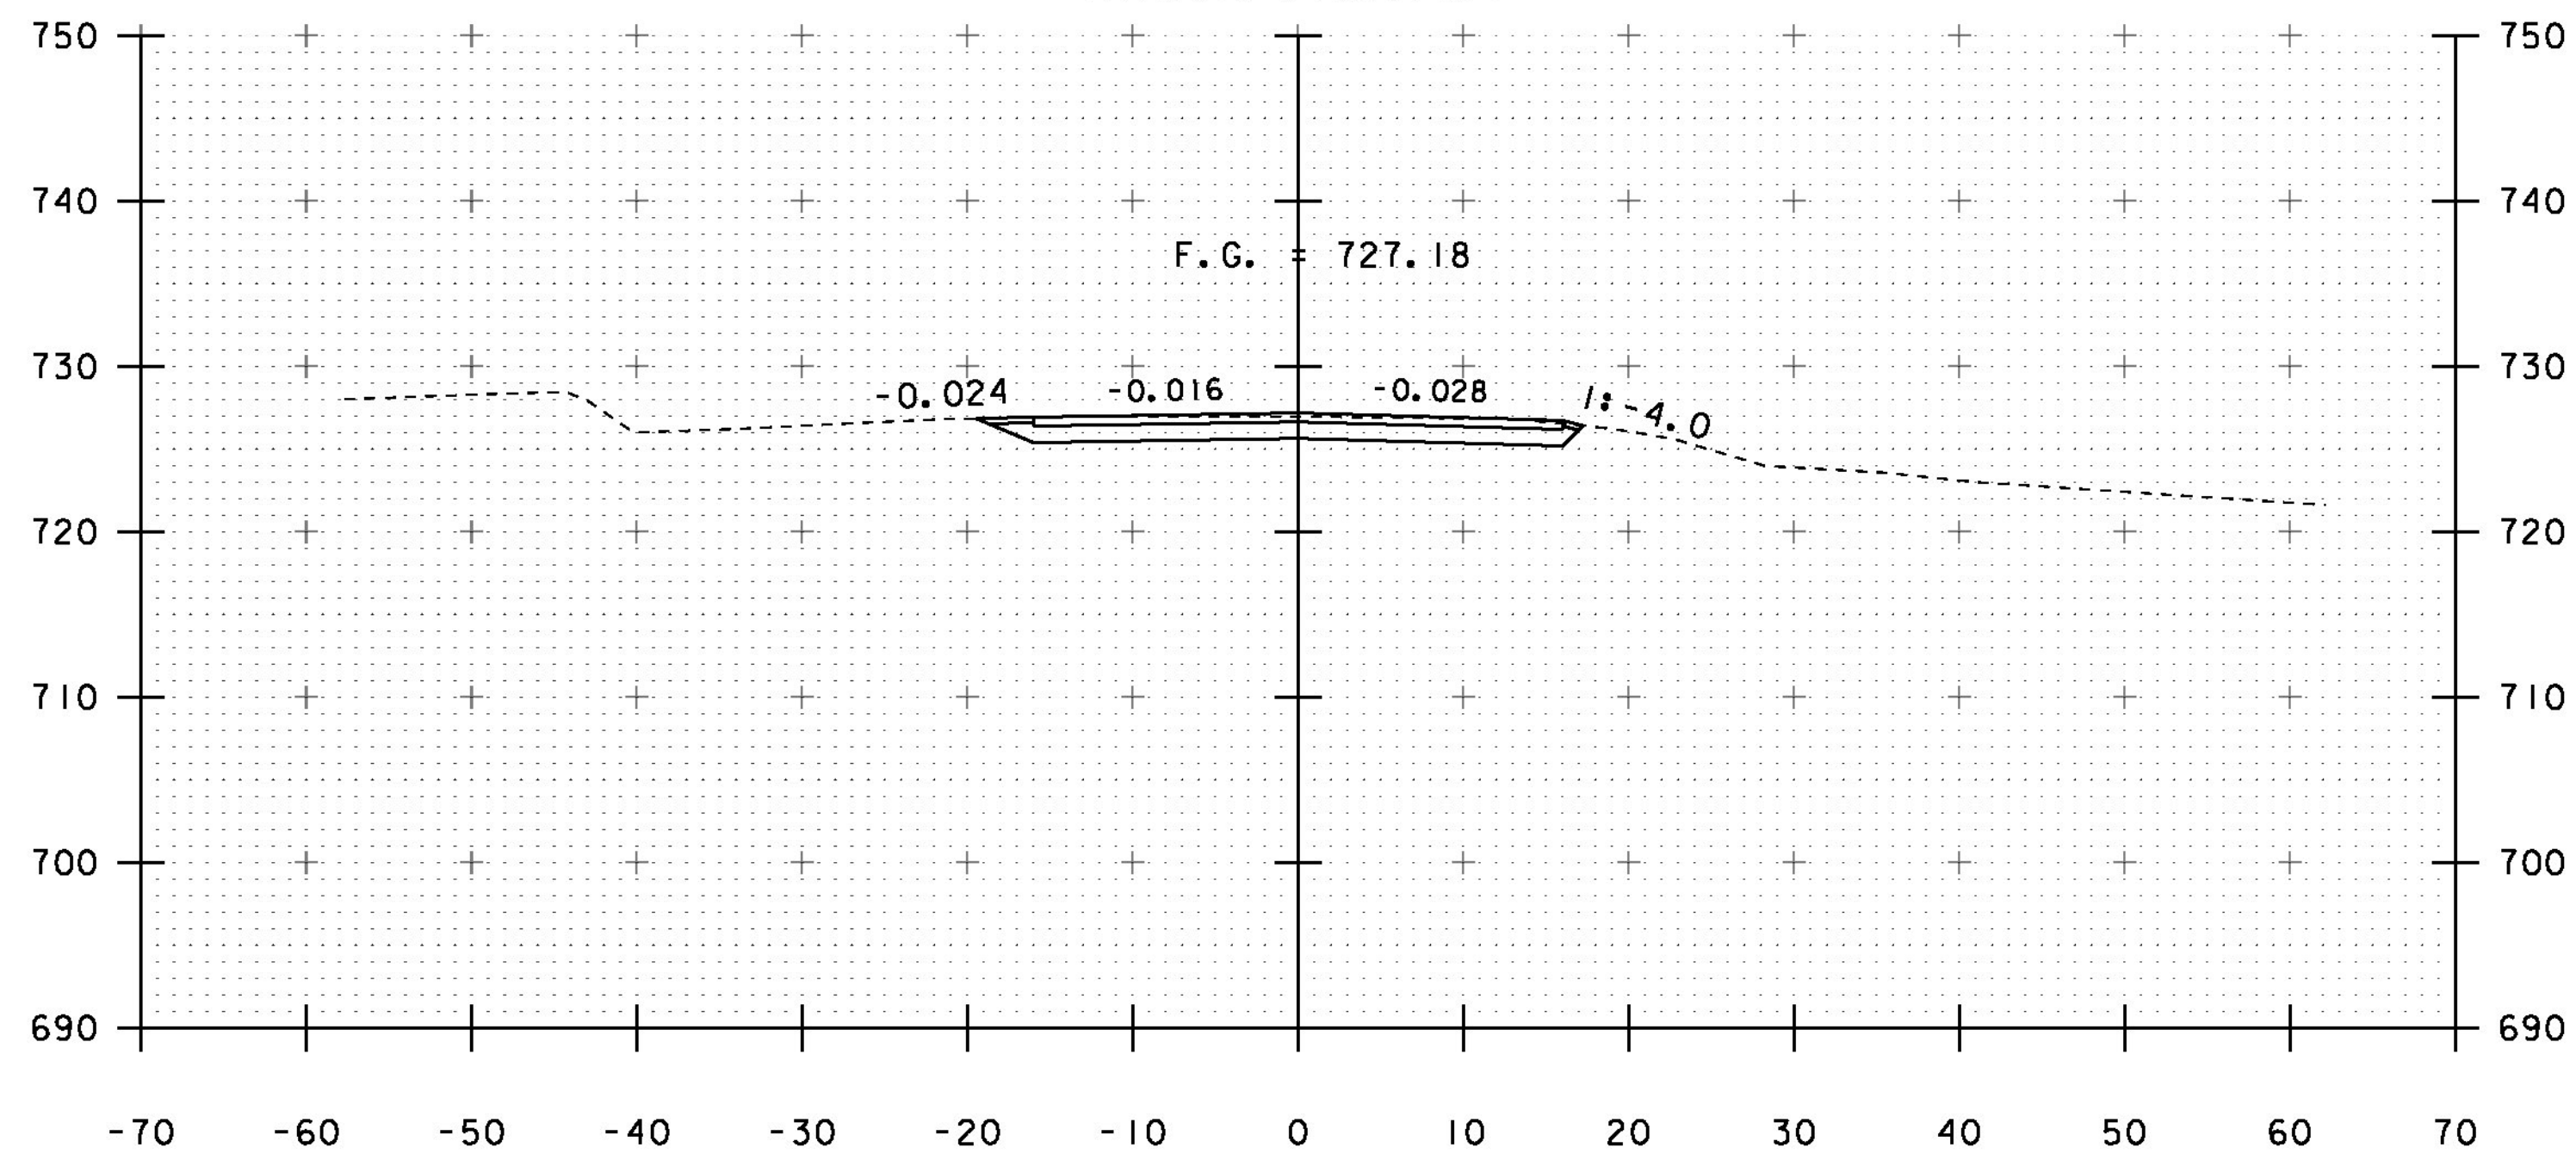

27+50

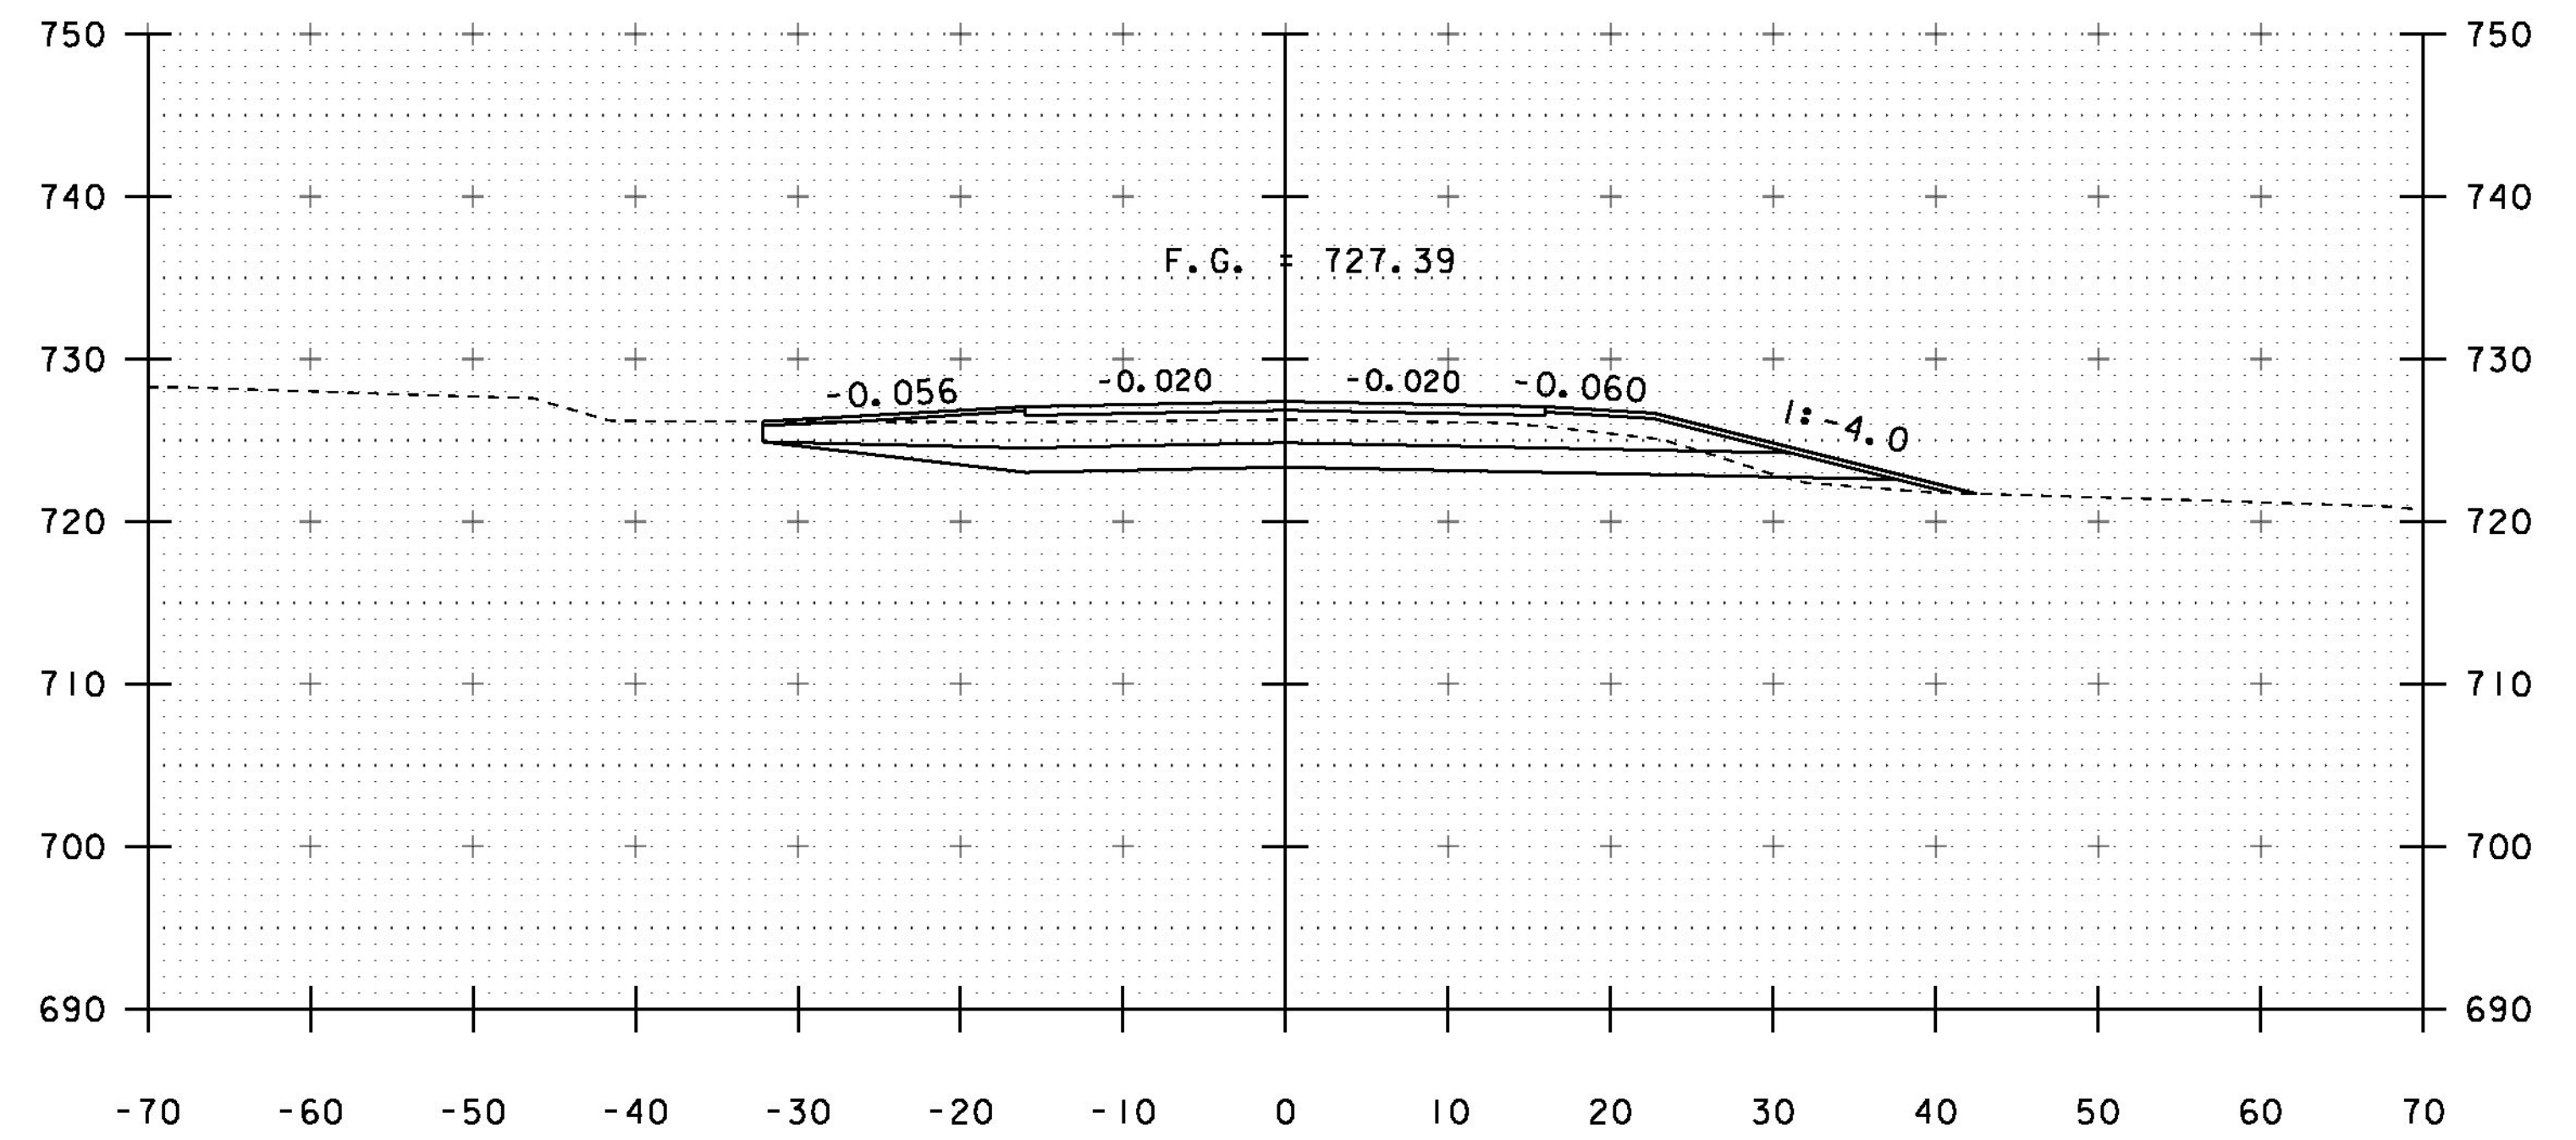

28+25

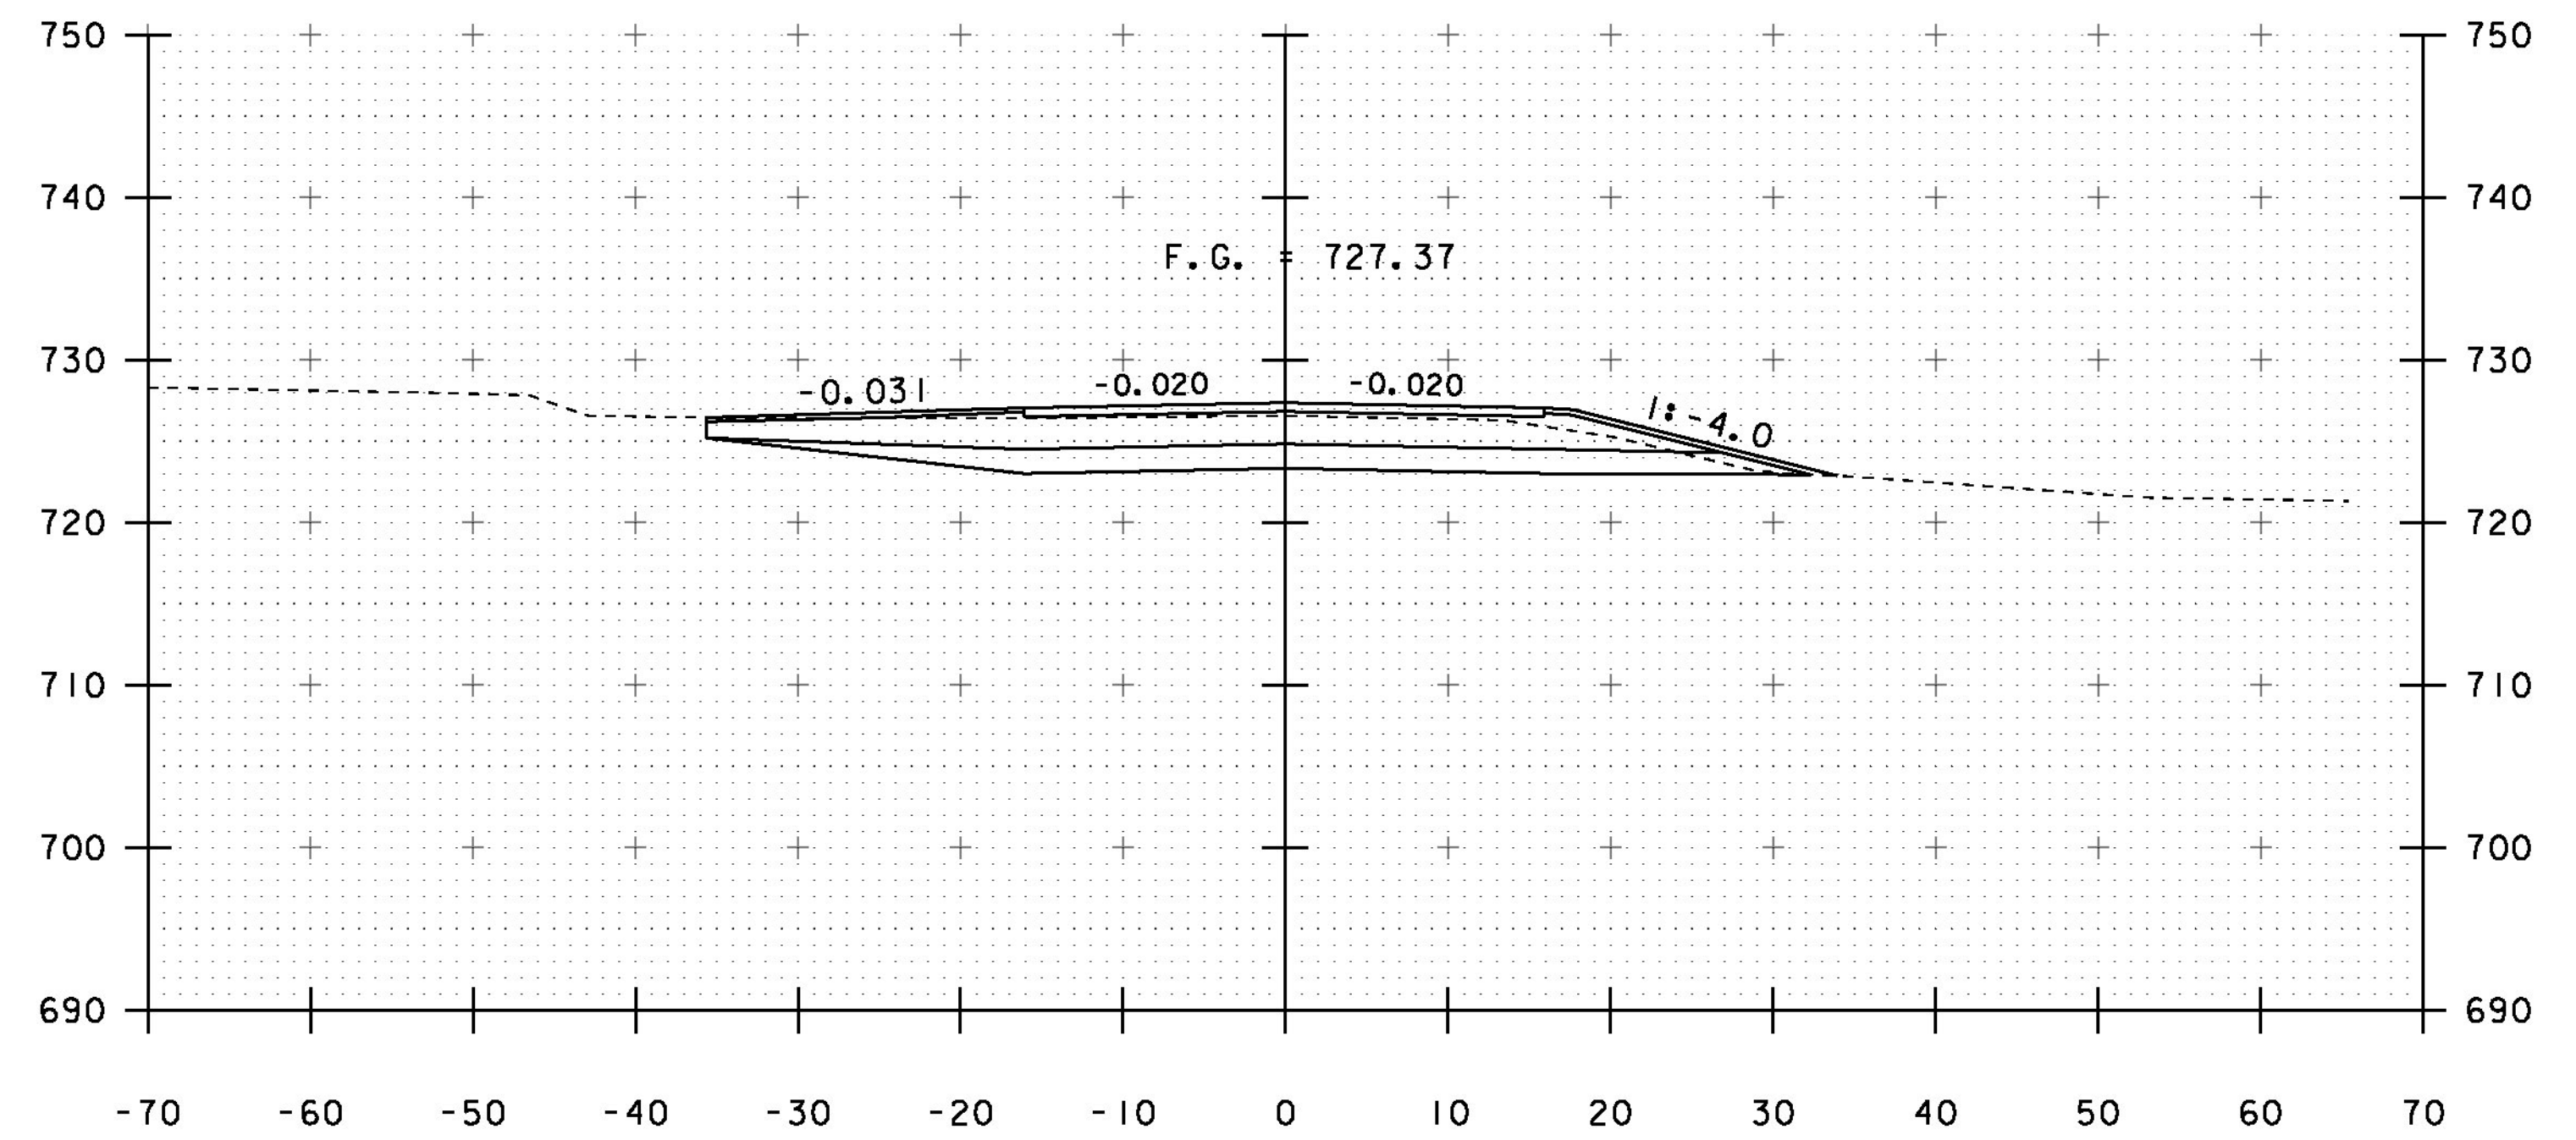


28+00

STA. 27+50 TO STA. 28+25


PROJECT NAME: MIDDLESEX
PROJECT NUMBER: BRP 024-1(37)

FILE NAME: sl0c220xs.dgn
PROJECT LEADER: C. CARLSON
DESIGNED BY: H. SALLS
VT 12 CROSS SECTIONS 2


PLOT DATE: 13-JAN-2015
DRAWN BY: R. PELLETT
CHECKED BY: H. SALLS
SHEET 31 OF 46

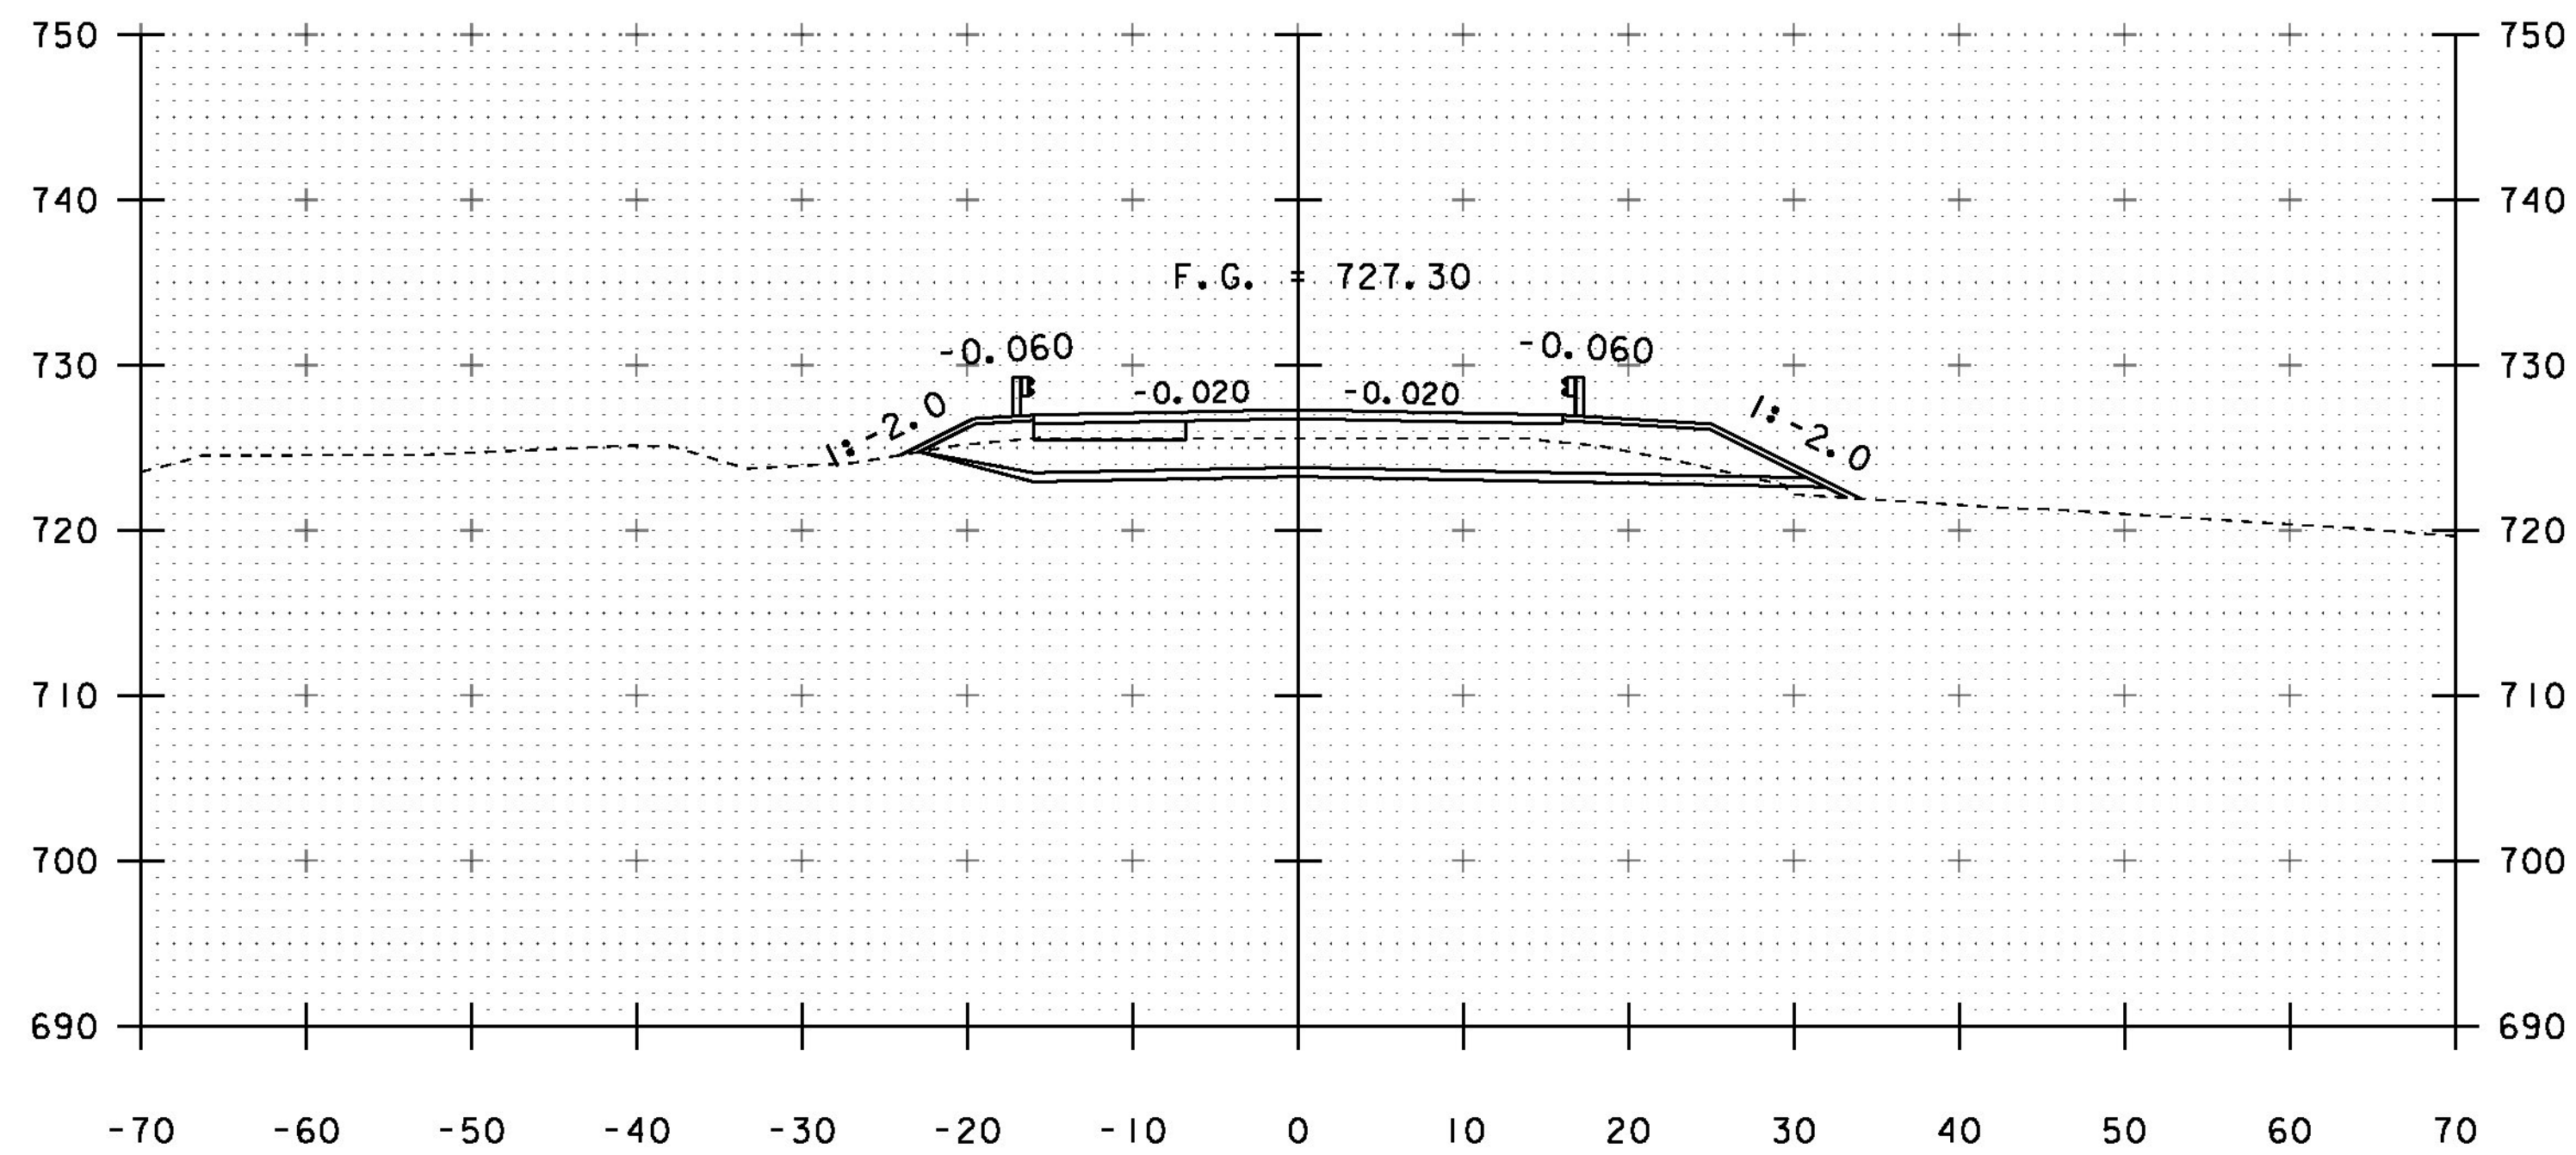


28+75

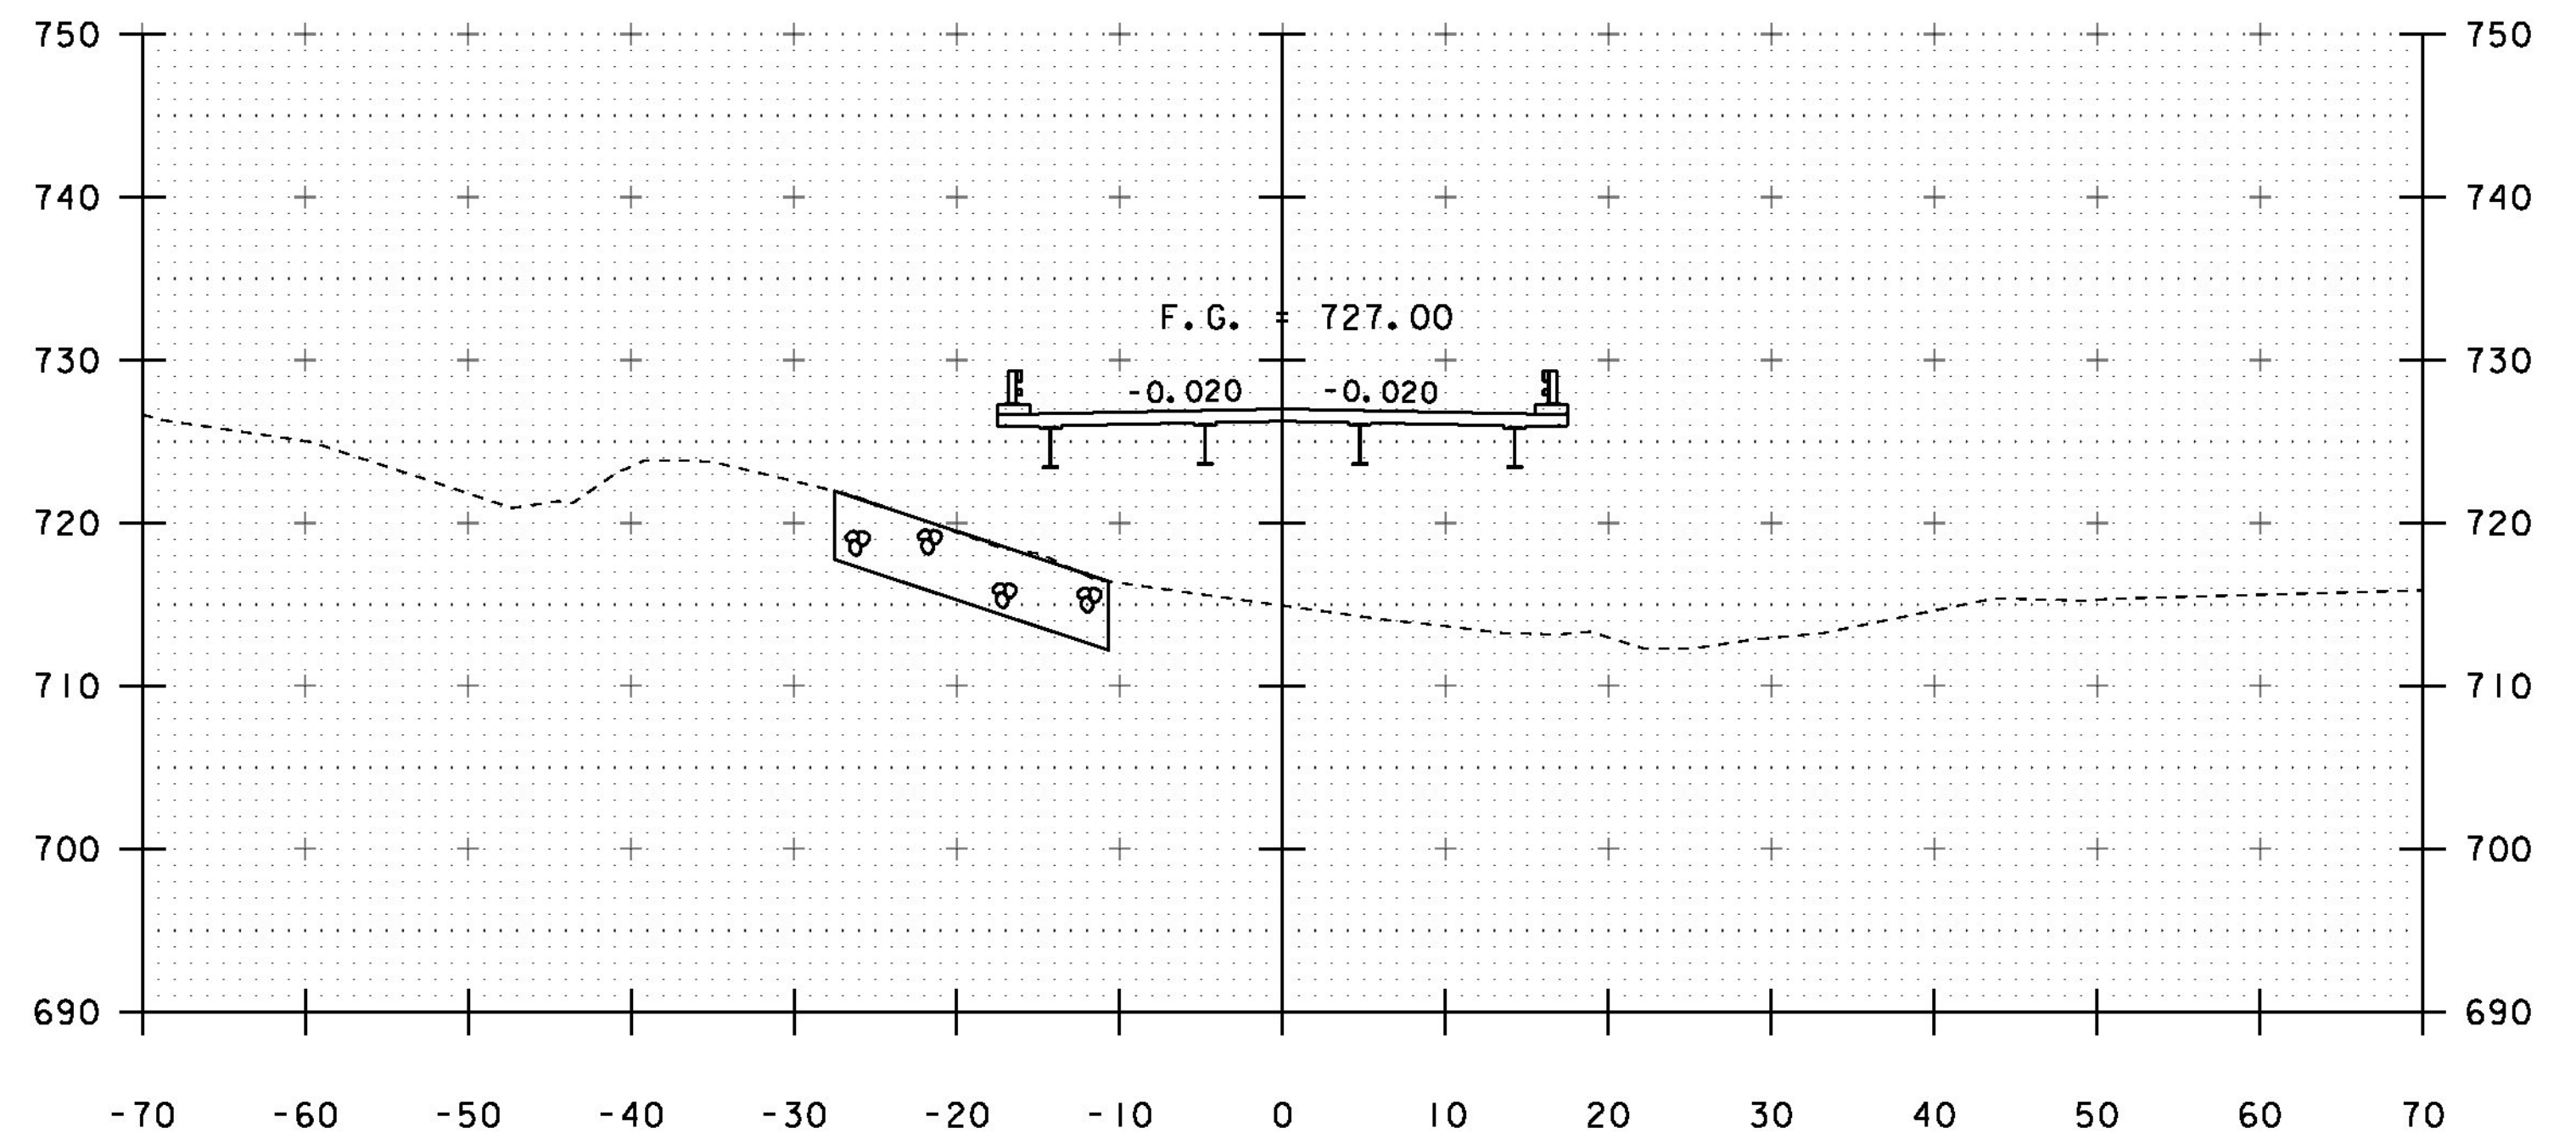

29+25

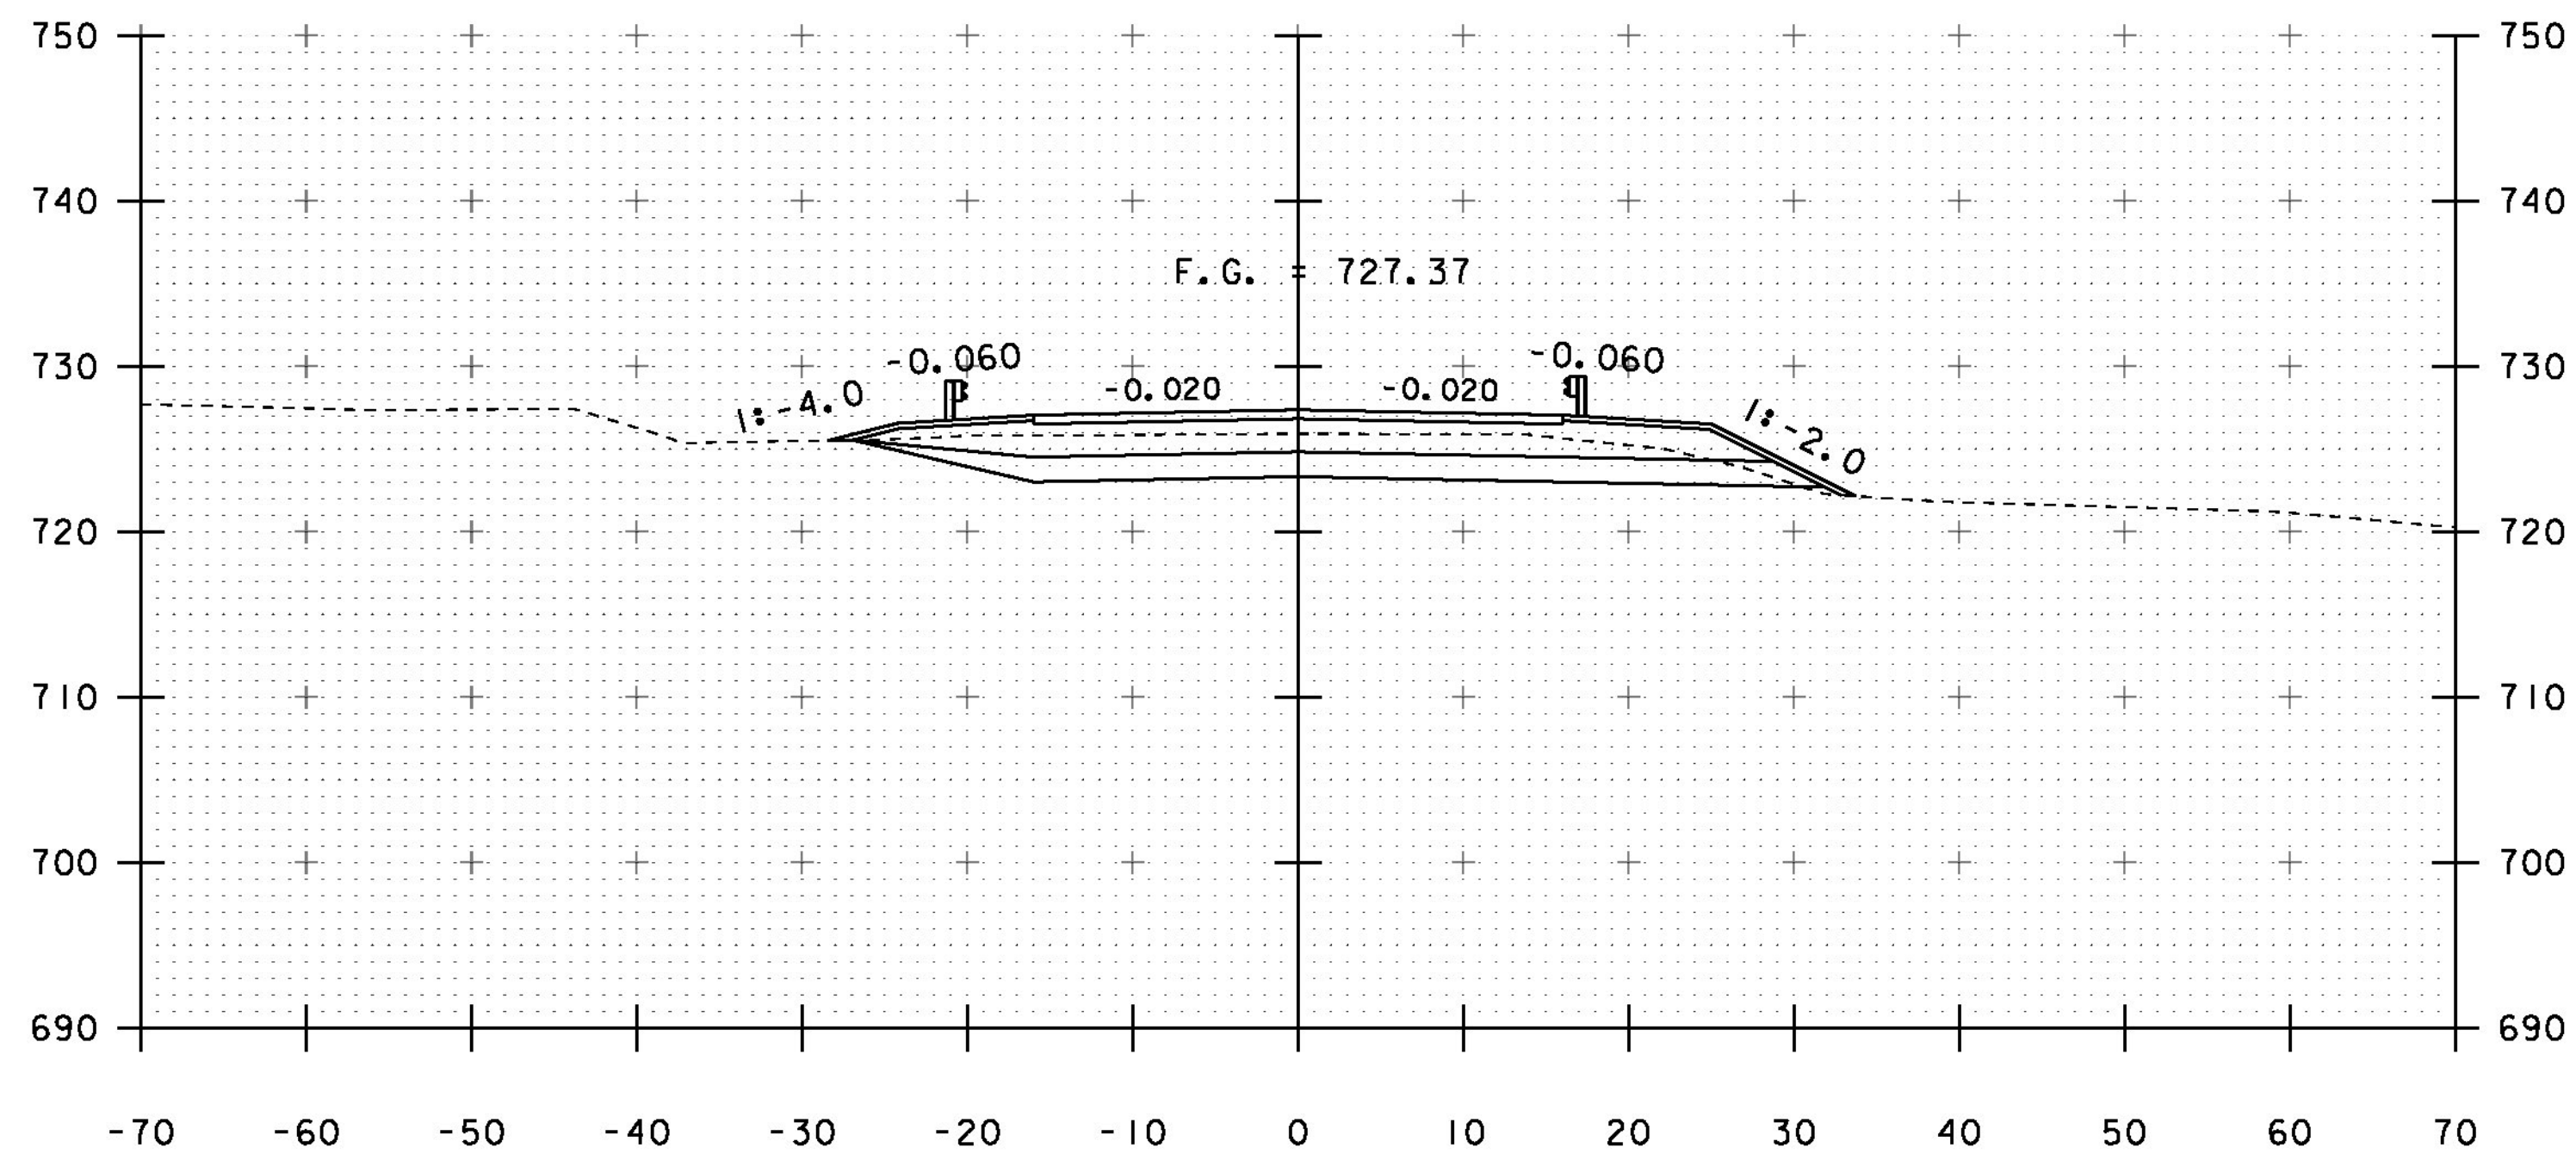

28+50

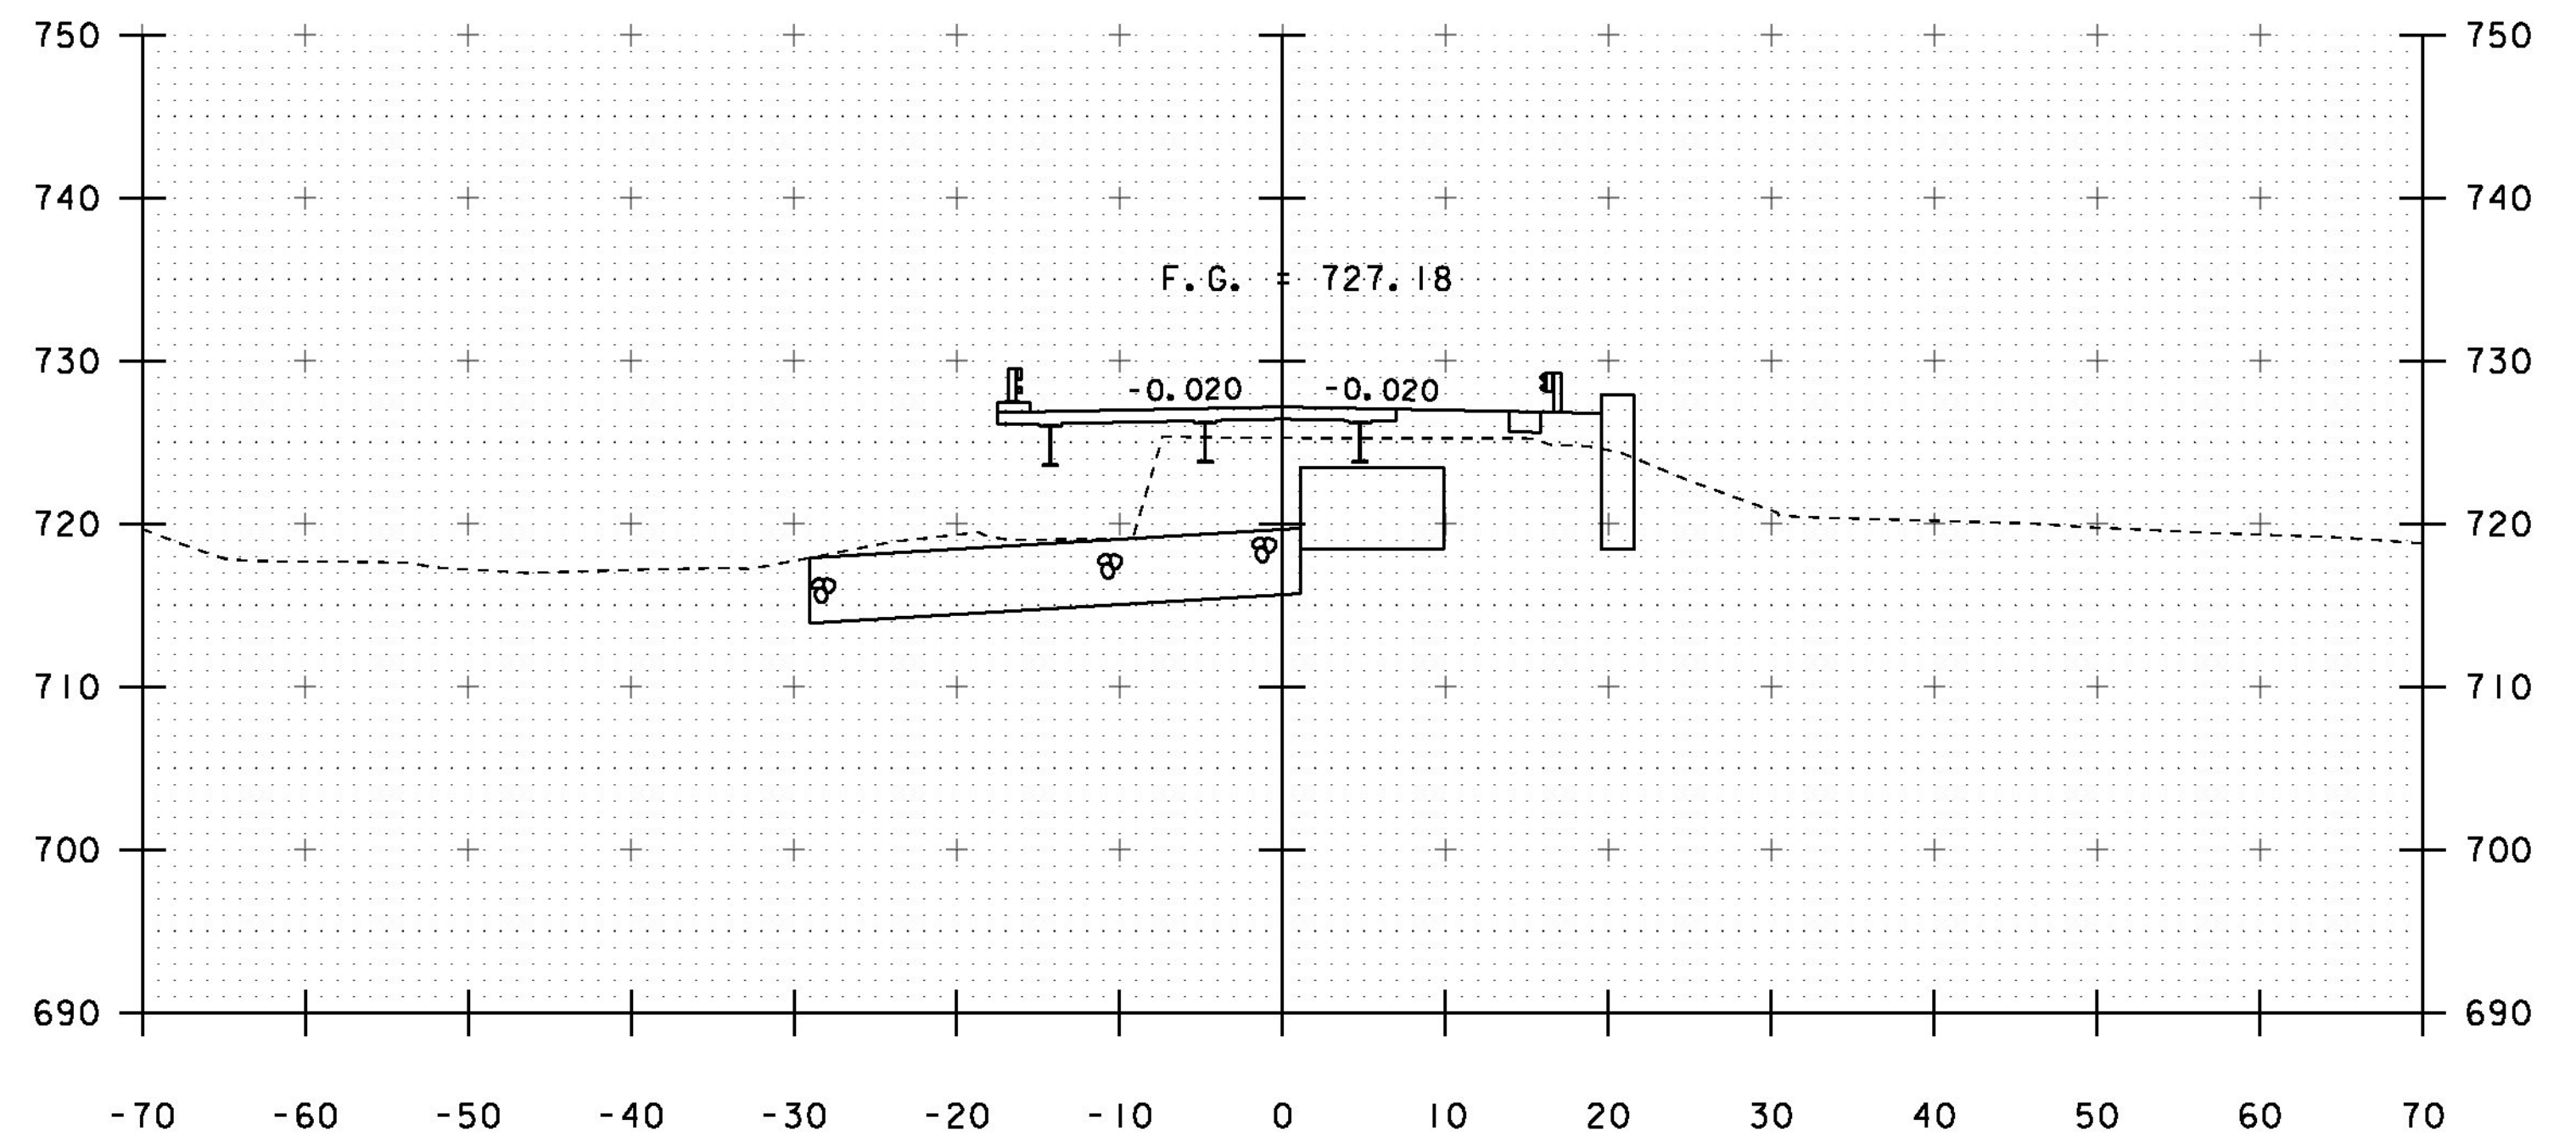


29+00
BEGIN BRIDGE STA 28+97.11

PROJECT NAME: MIDDLESEX
PROJECT NUMBER: BRF 024-K(37)


FILE NAME: sl0c220xs.dgn
PROJECT LEADER: C. CARLSON
DESIGNED BY: H. SALLS
VT 12 CROSS SECTIONS 3

PLOT DATE: 13-JAN-2015
DRAWN BY: R. PELLETT
CHECKED BY: H. SALLS
SHEET 32 OF 46


STA. 28+50 TO STA. 29+25

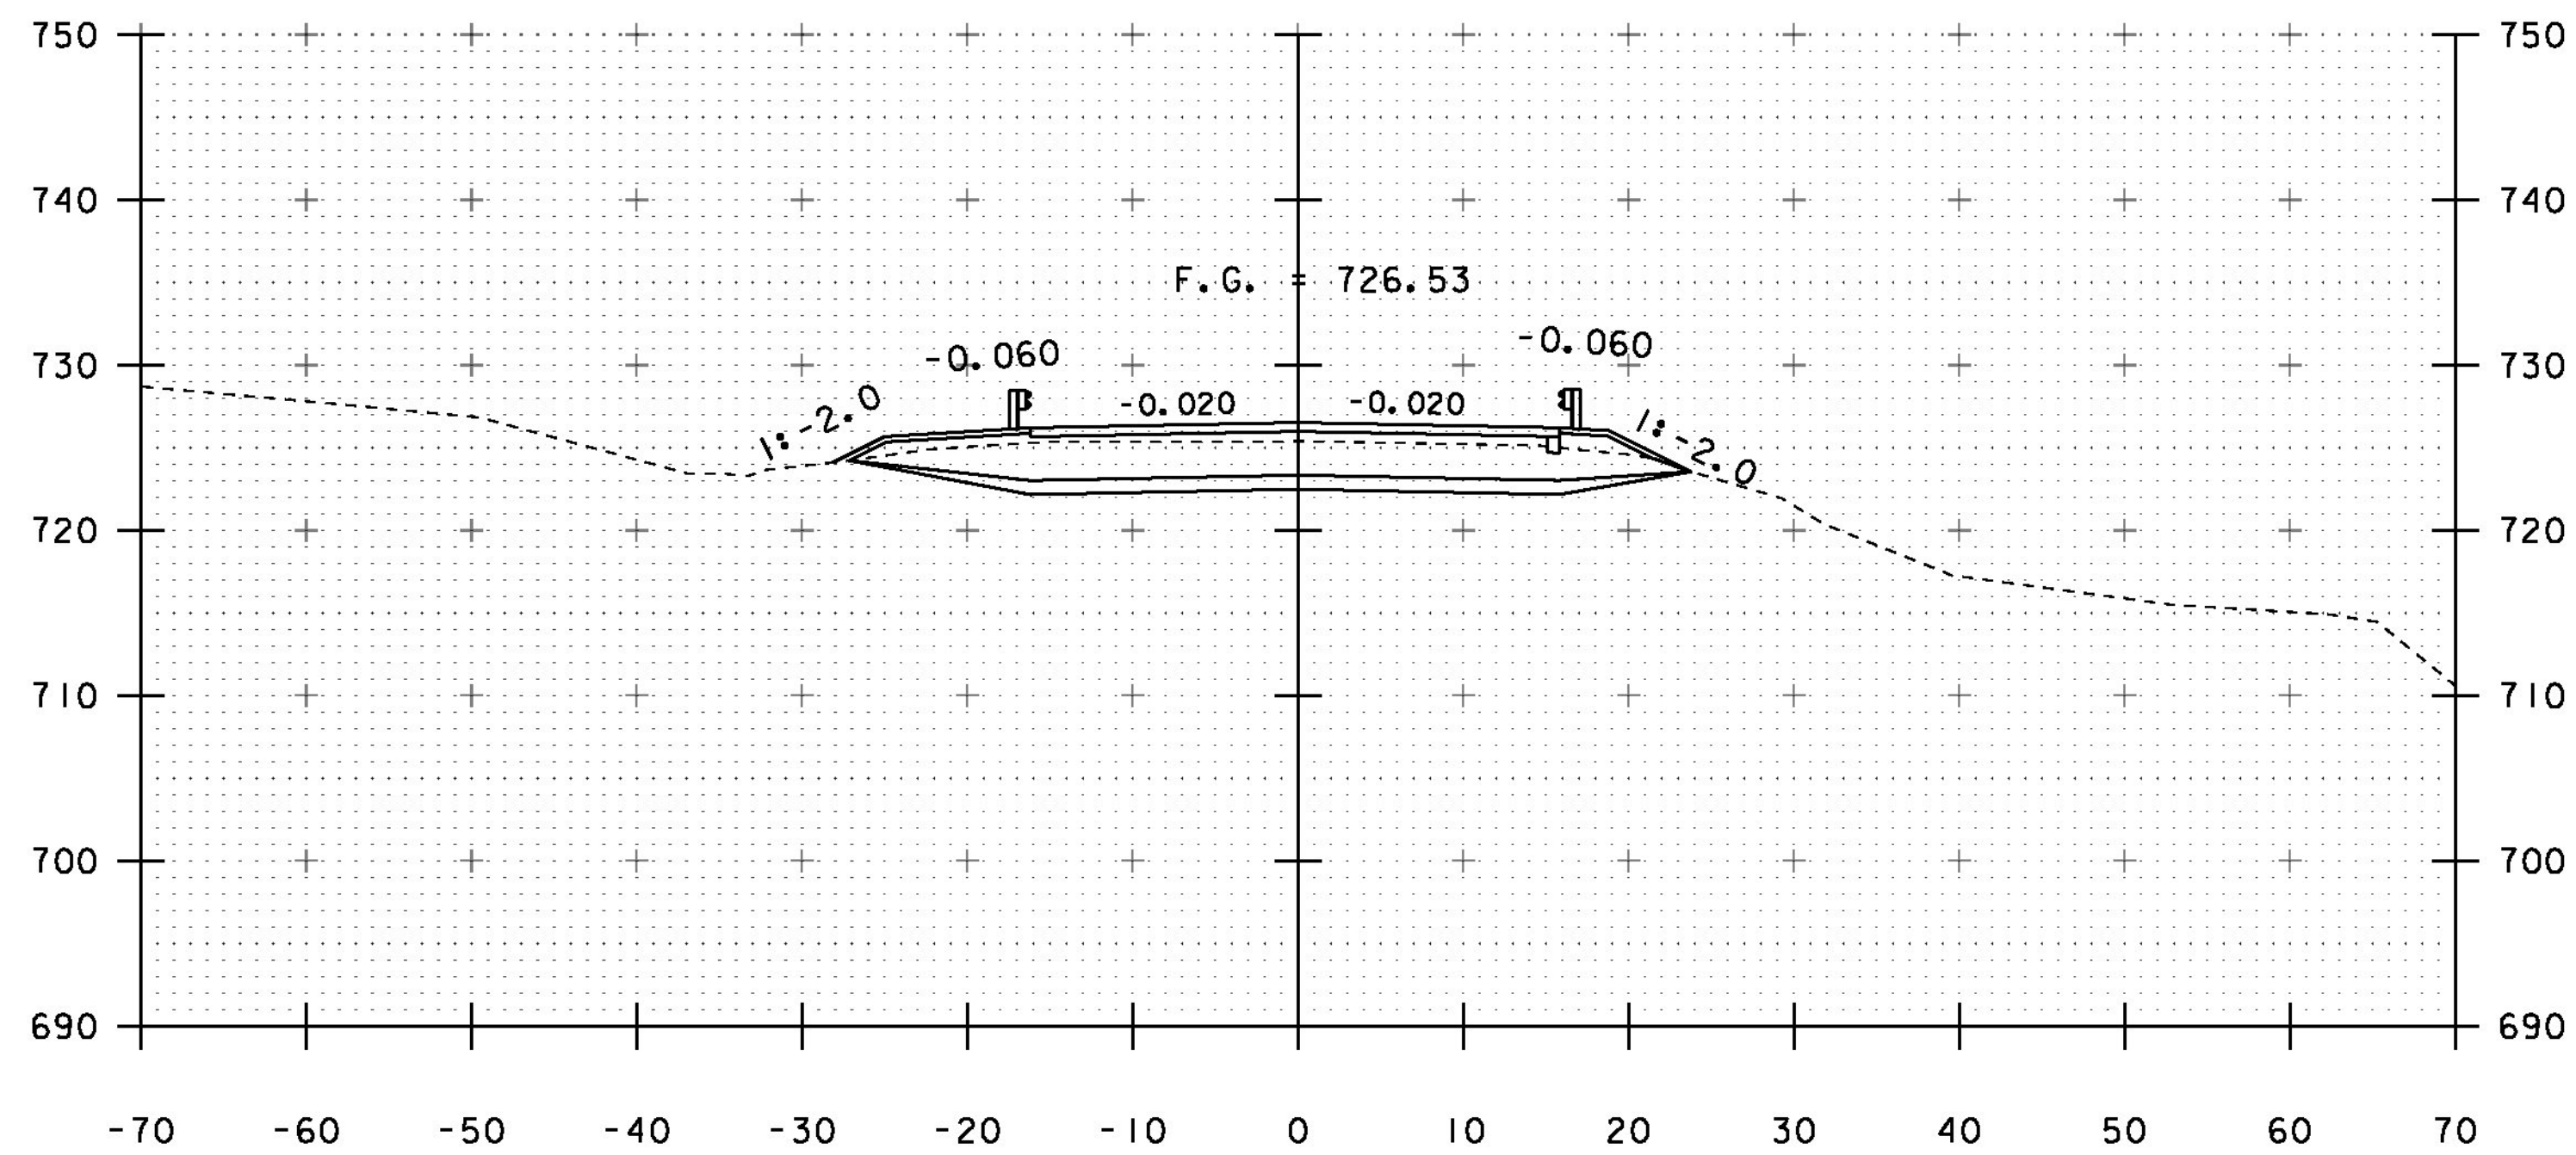


29+75

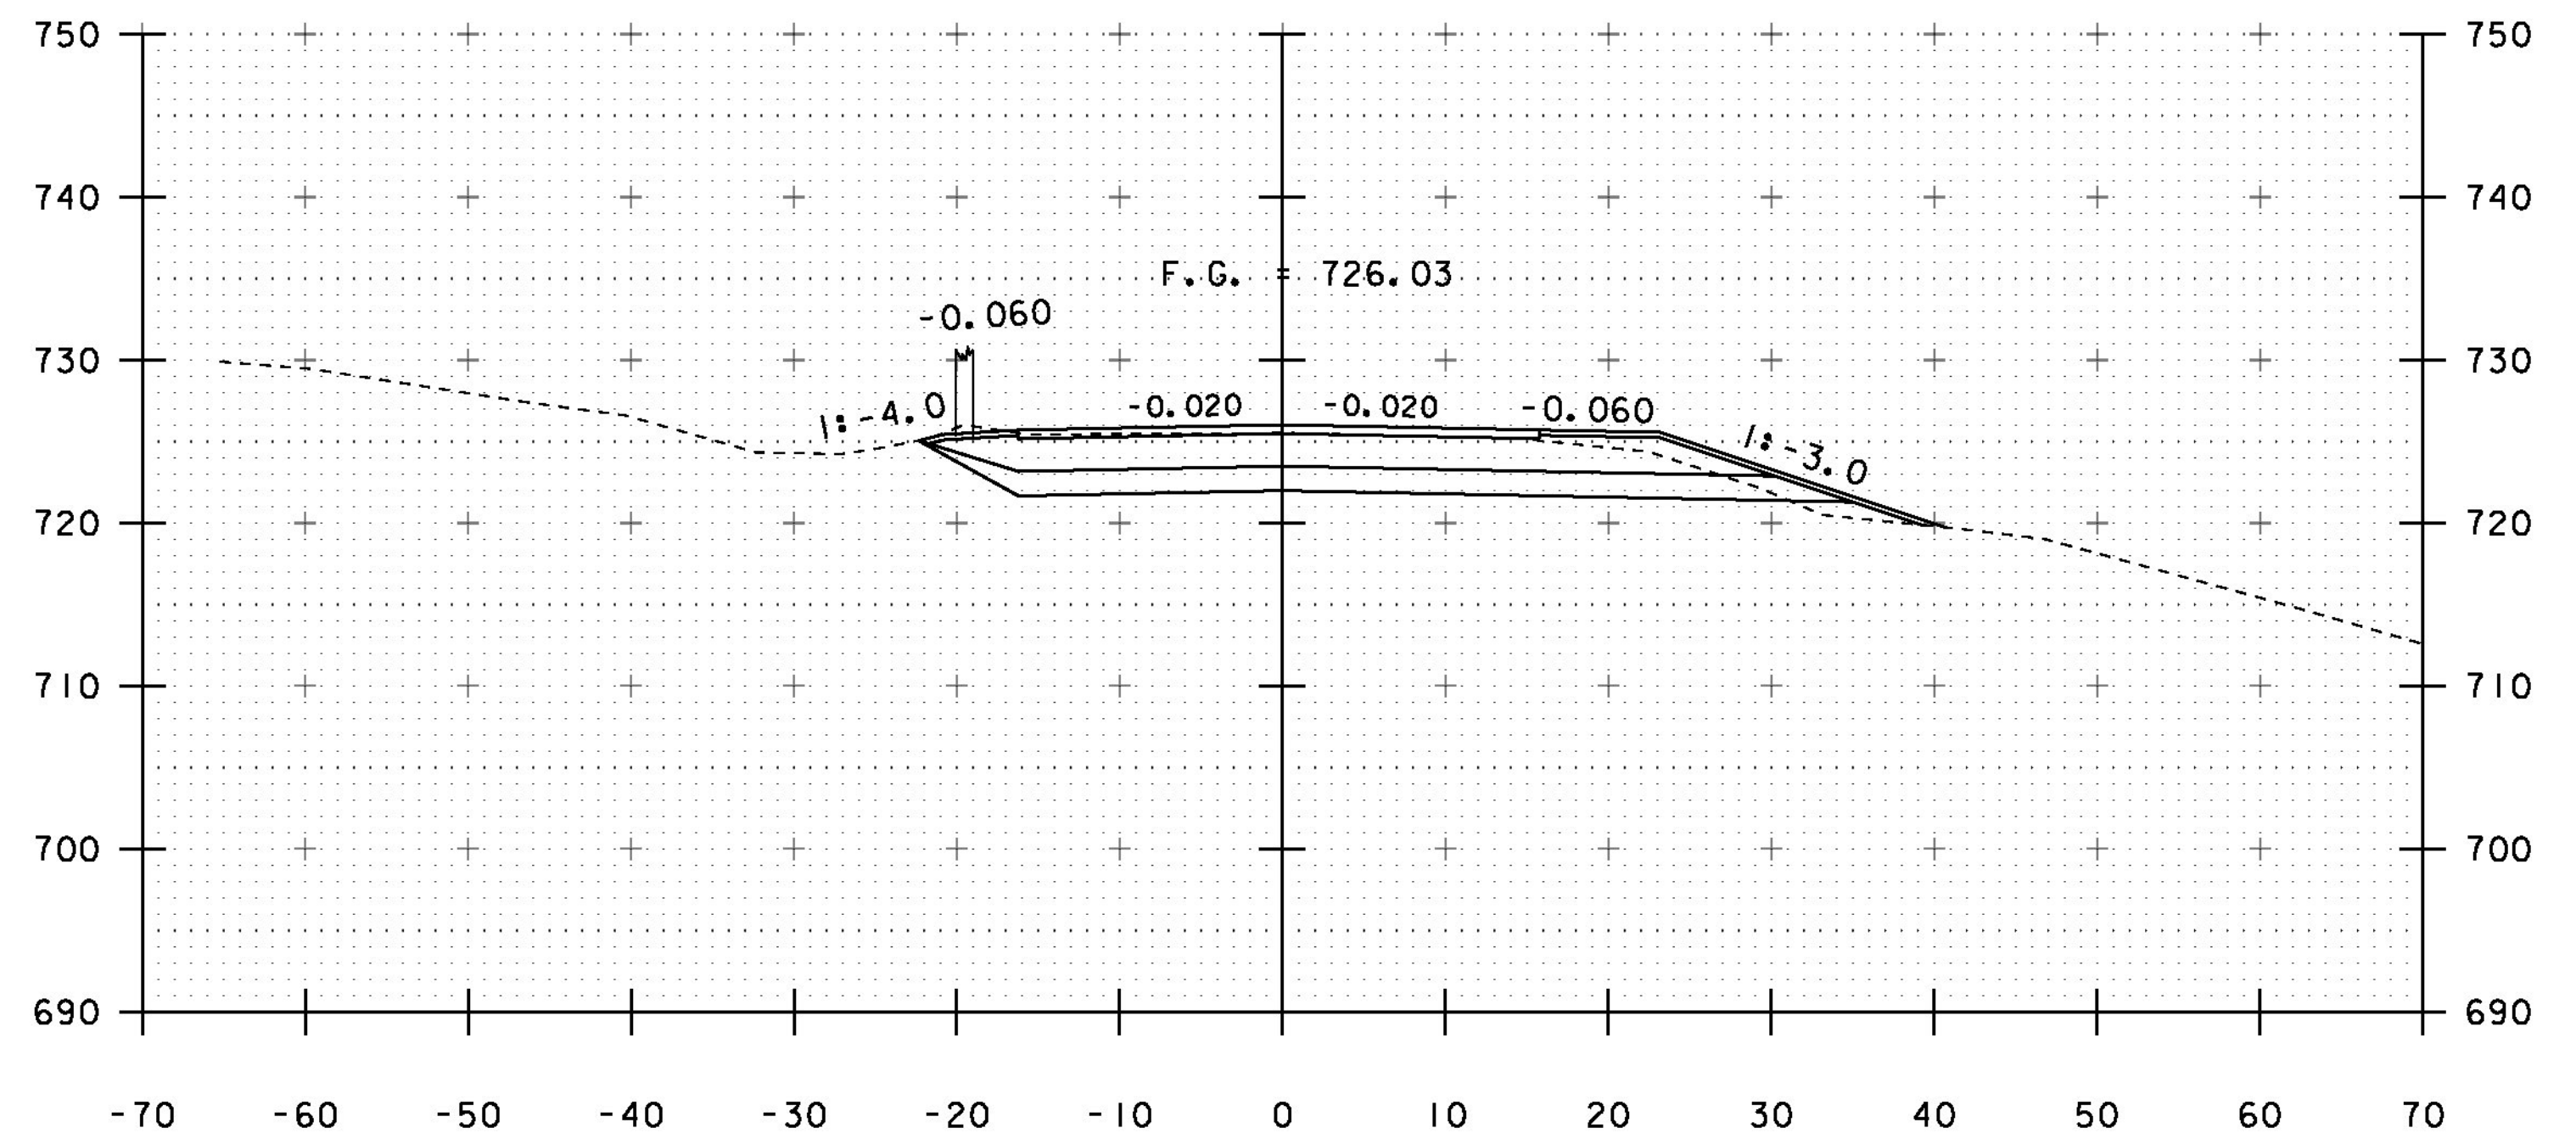

30+25

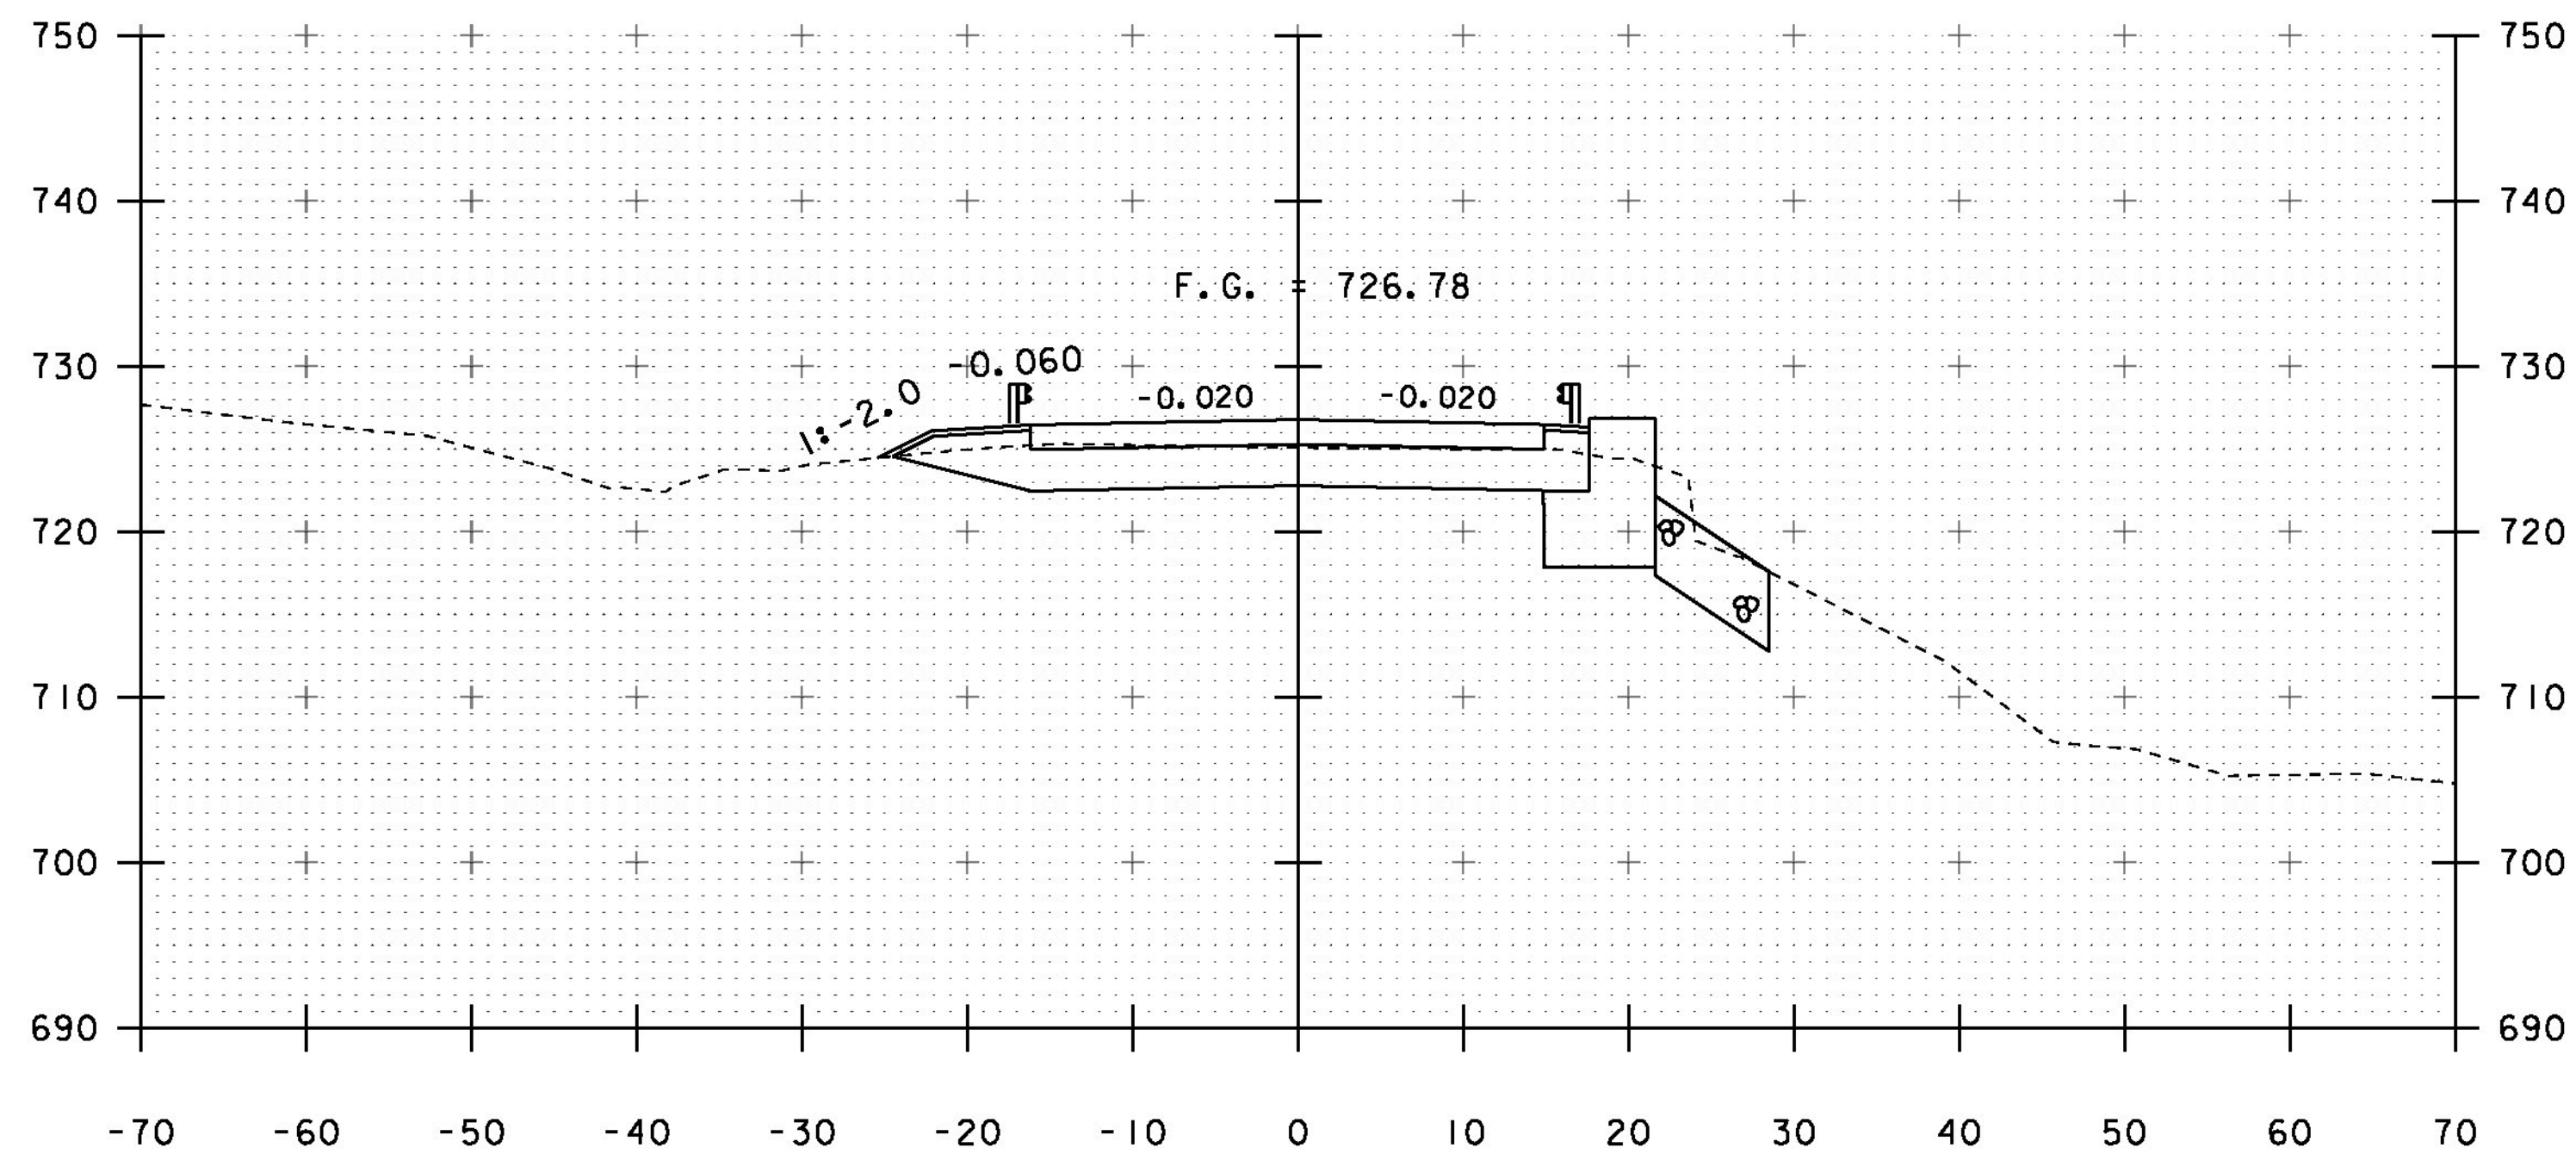

29+50
END BRIDGE STA 29+43.89

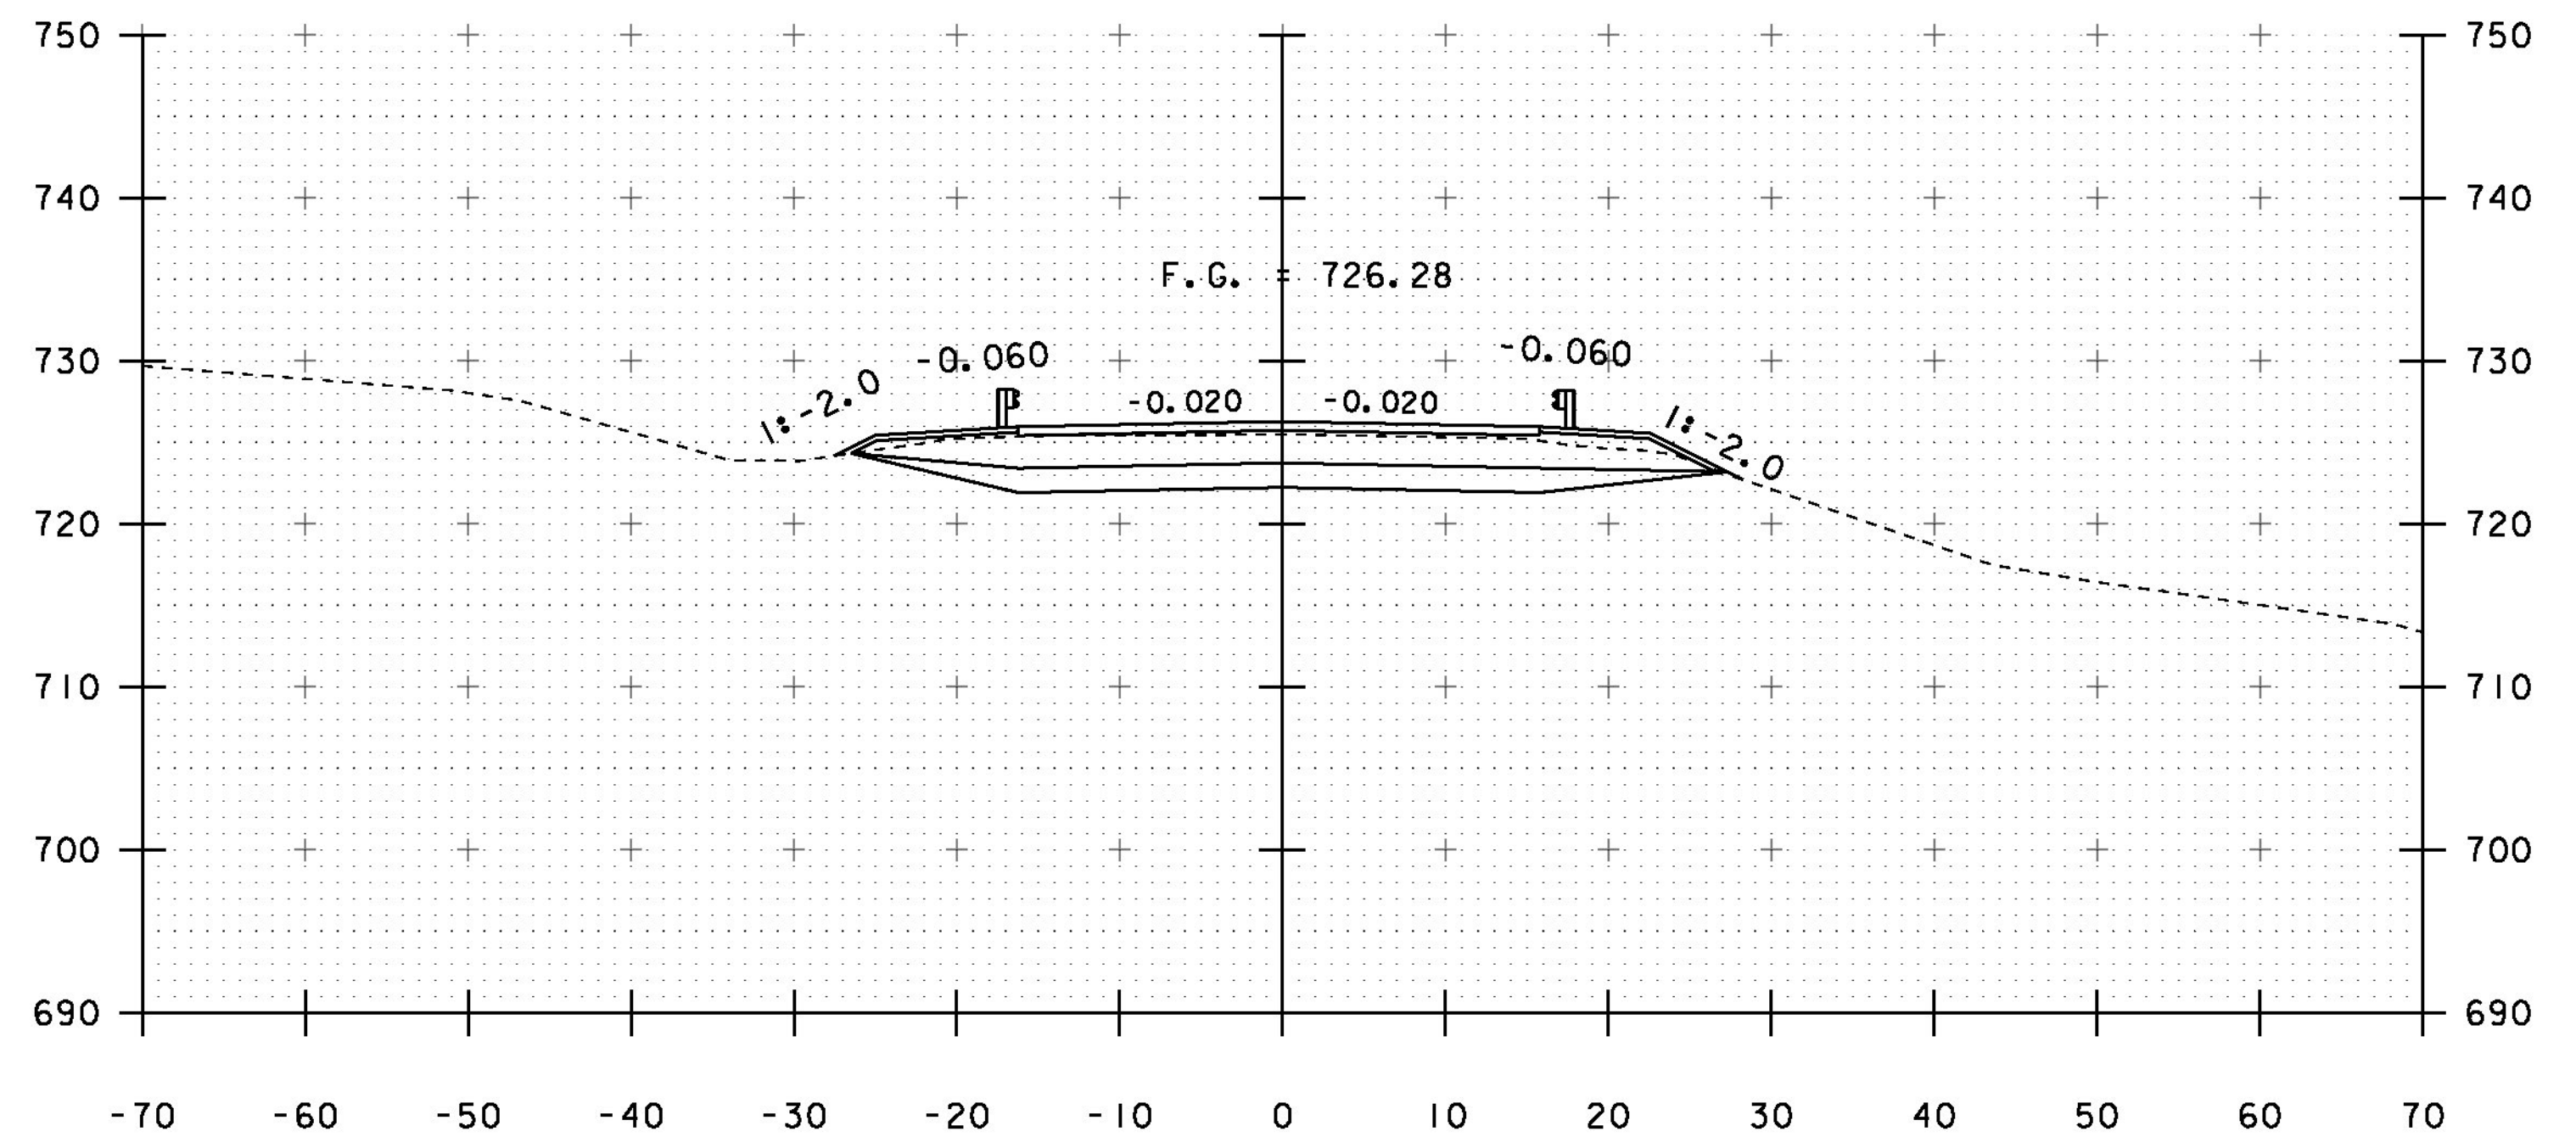


30+00

PROJECT NAME: MIDDLESEX
PROJECT NUMBER: BRP 024-1(37)


FILE NAME: sl0c220xs.dgn
PROJECT LEADER: C. CARLSON
DESIGNED BY: H. SALLS
VT 12 CROSS SECTIONS 4

PLOT DATE: 13-JAN-2015
DRAWN BY: R. PELLETT
CHECKED BY: H. SALLS
SHEET 33 OF 46


STA. 29+50 TO STA. 30+25

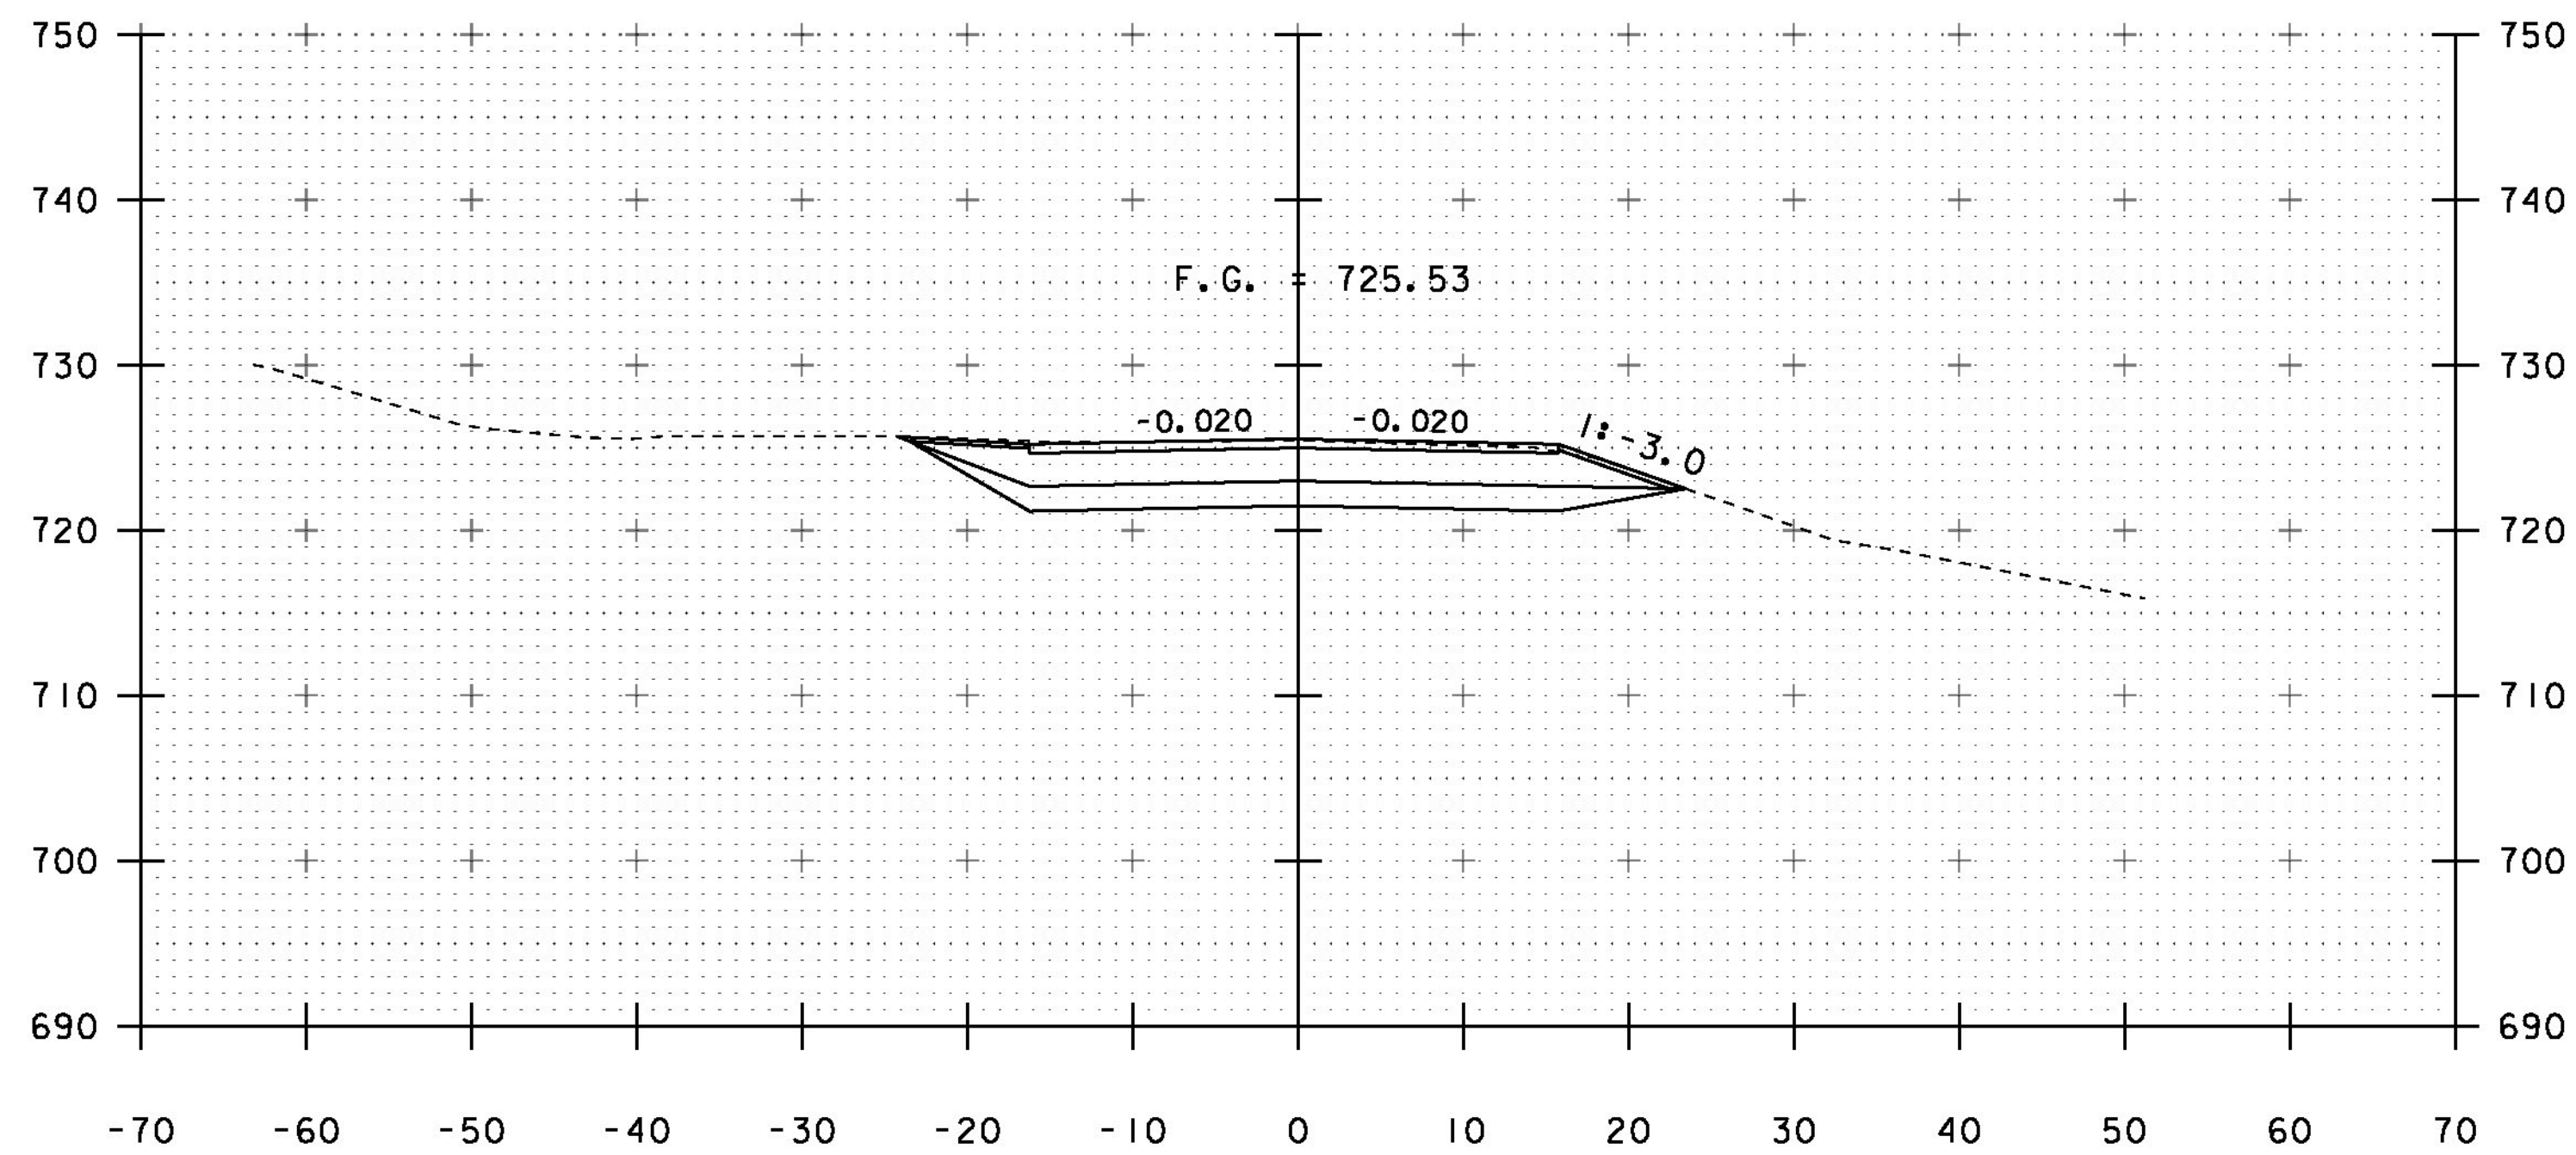


30+75
END PROJECT

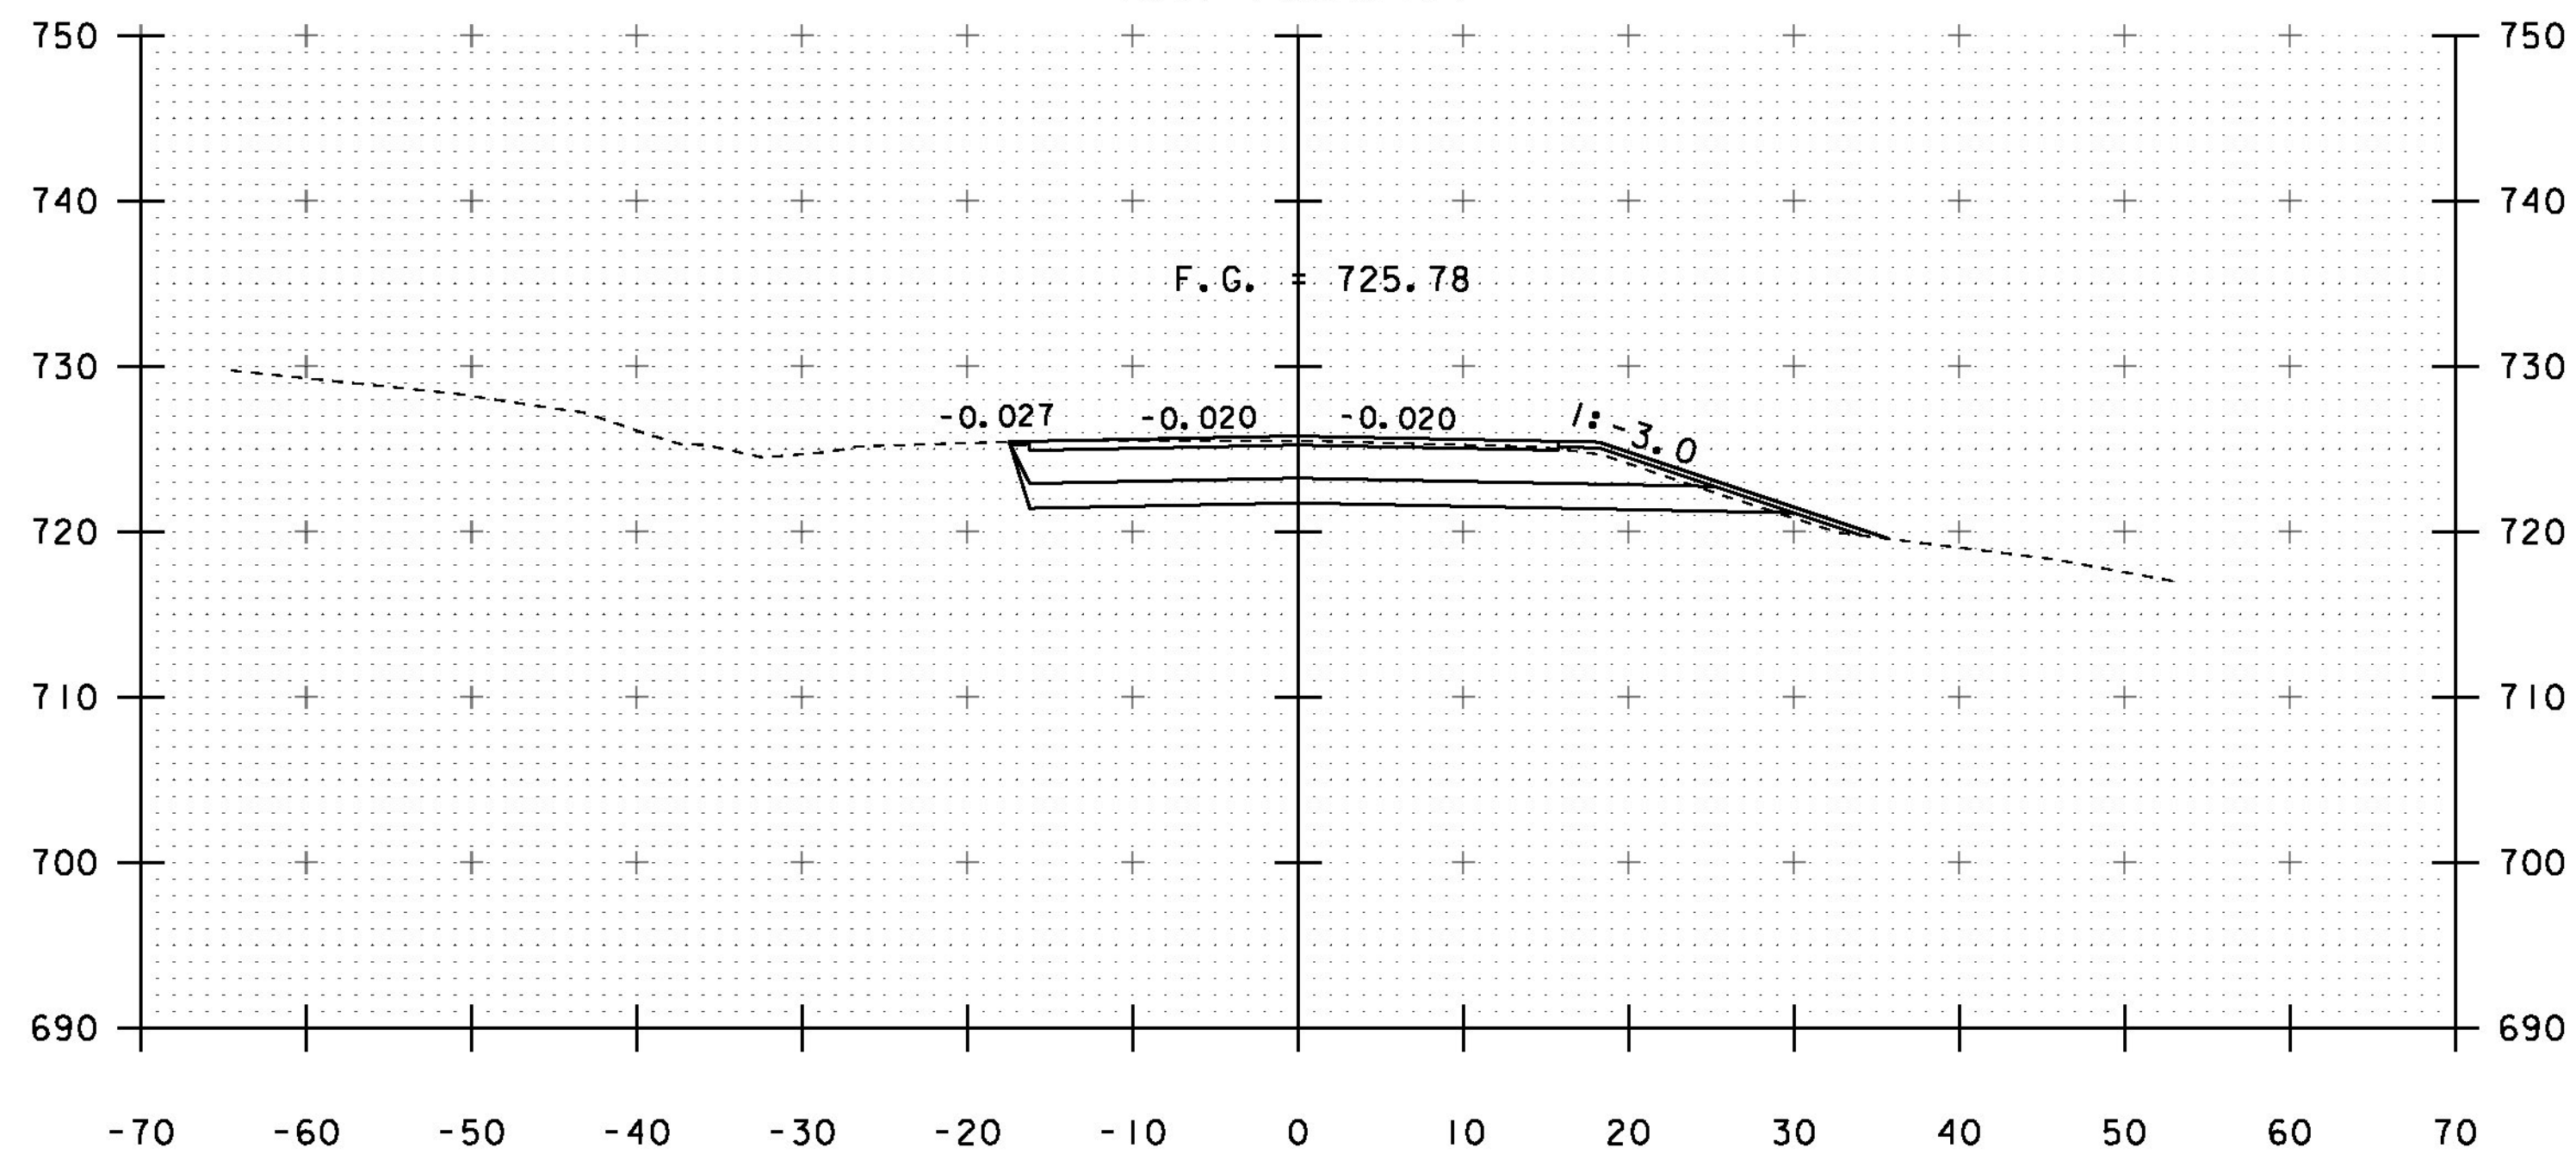

30+50

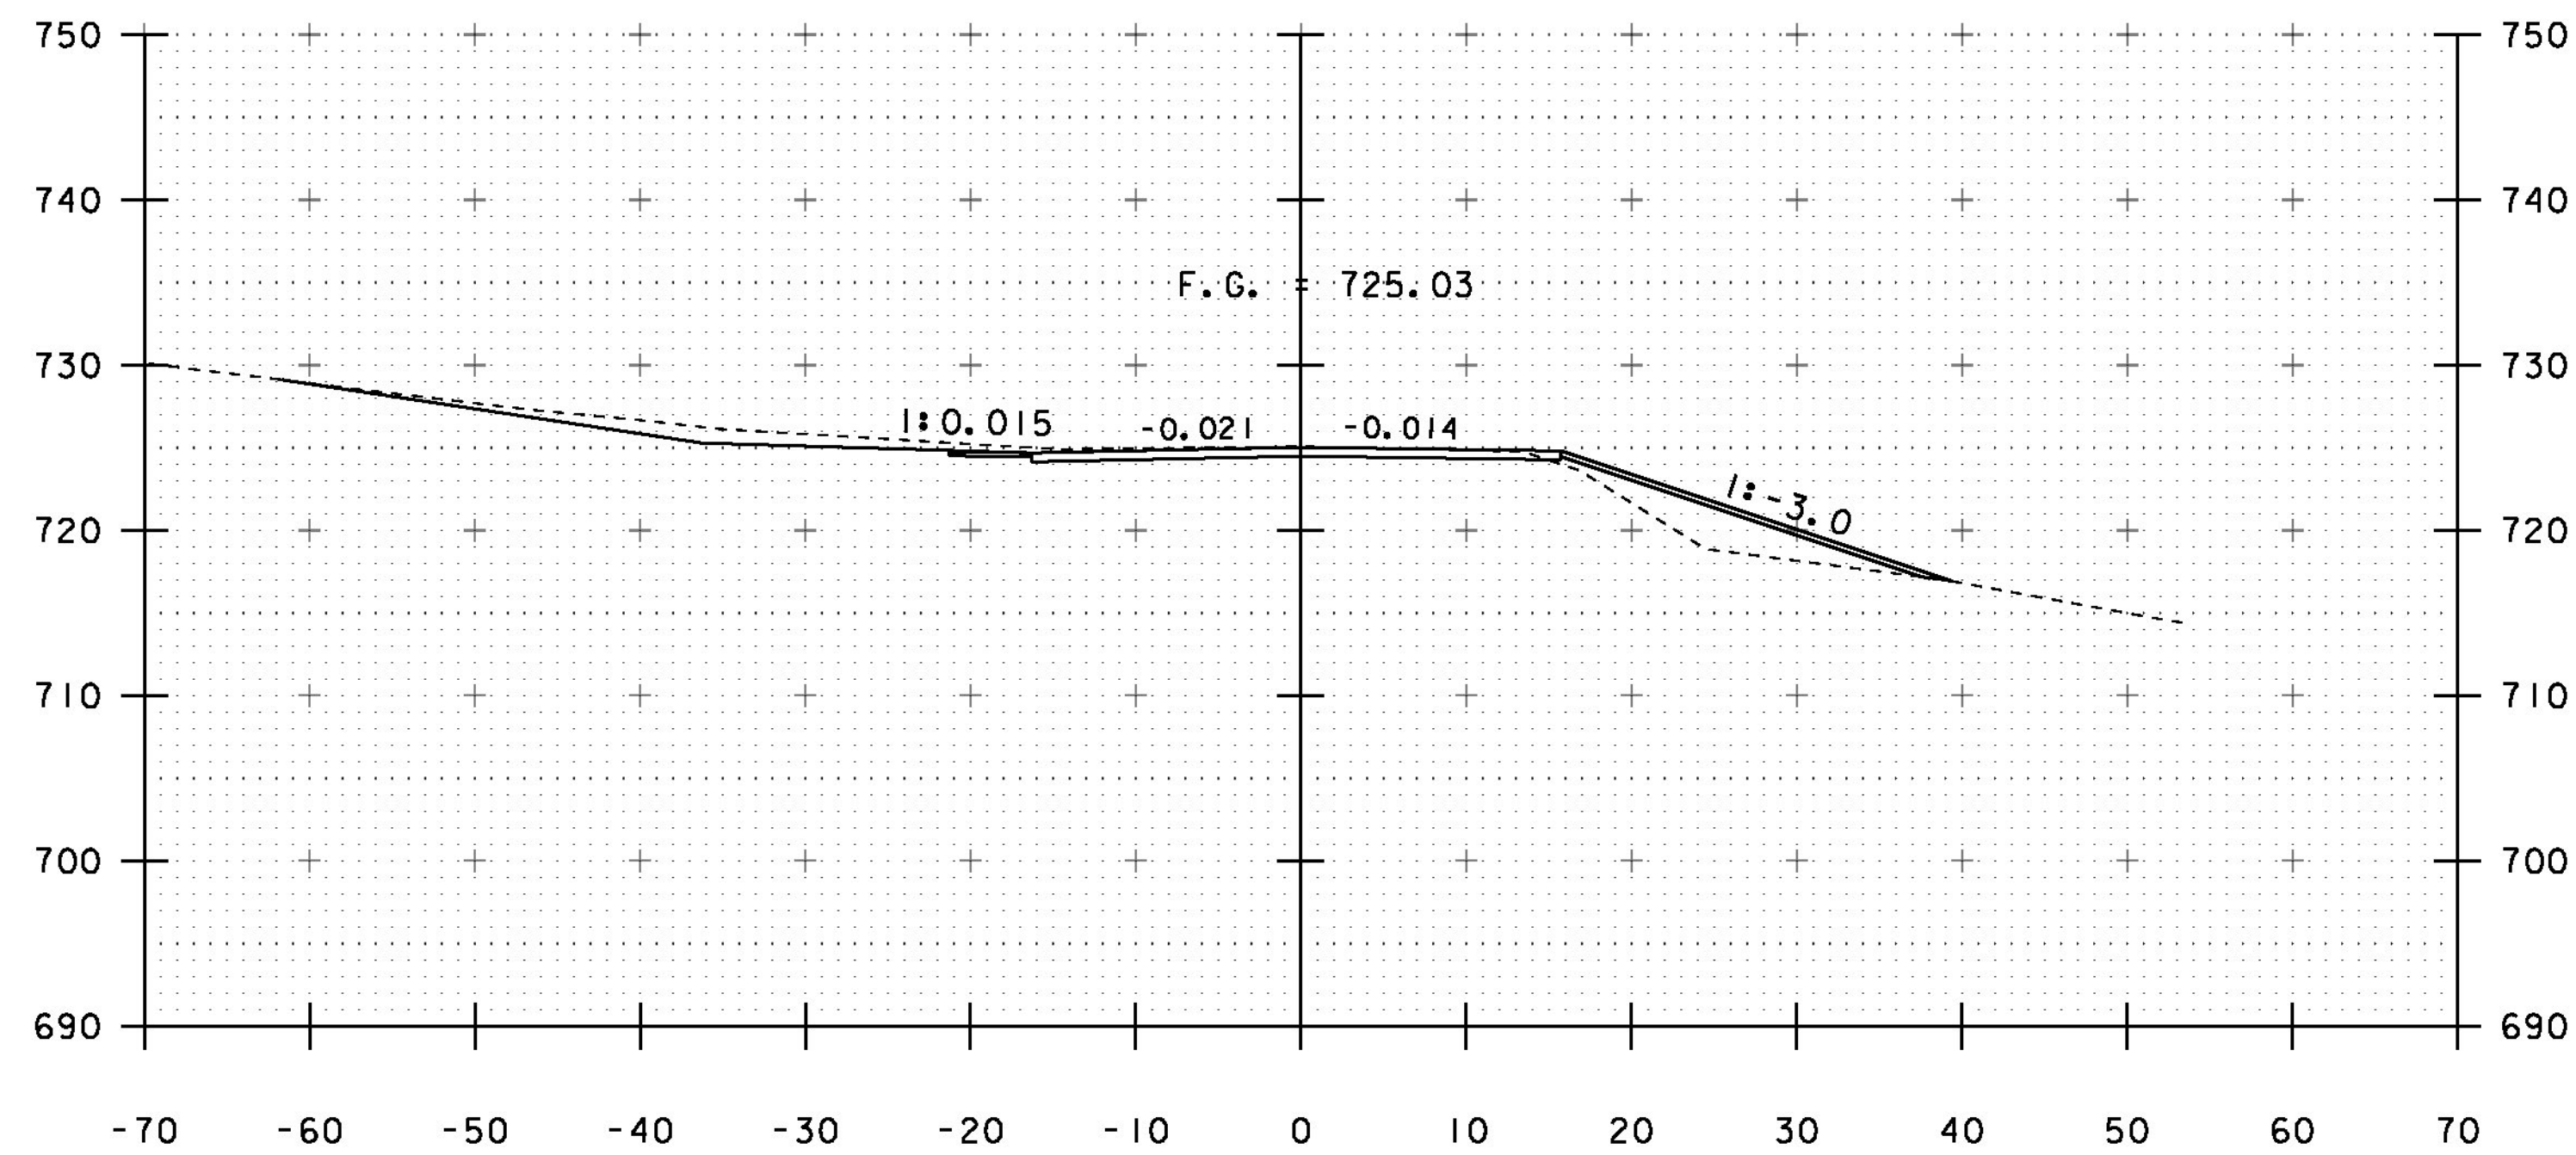


31+25

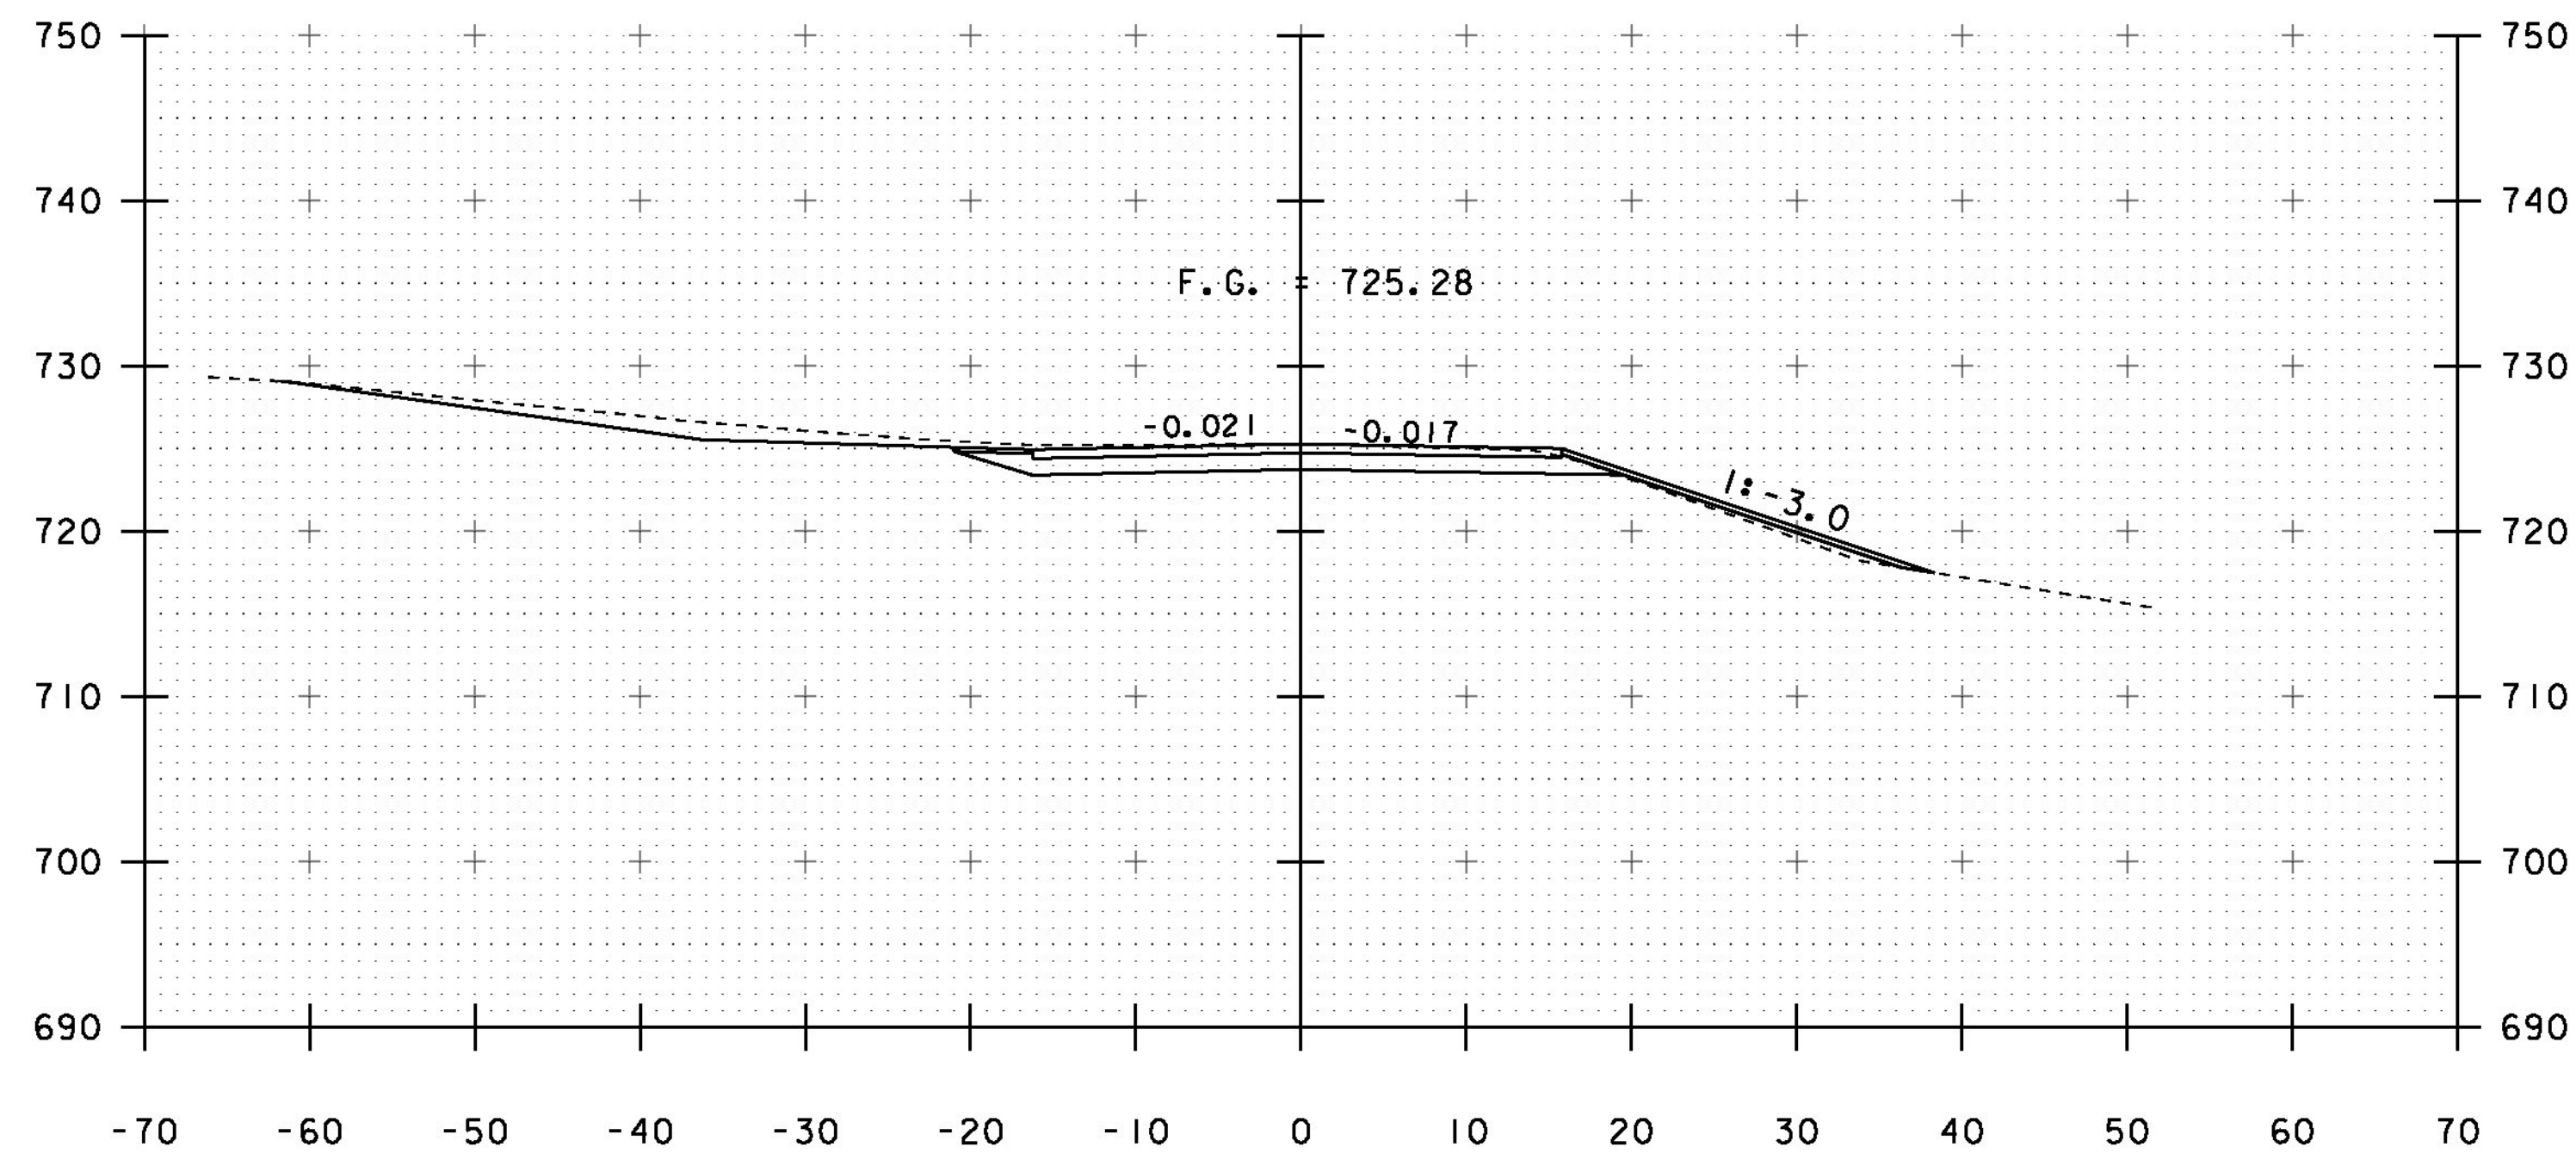


31+00

STA. 30+50 TO STA. 31+25


PROJECT NAME:	MIDDLESEX	PLOT DATE:	13-JAN-2015
PROJECT NUMBER:	BRF 024-1(37)	DRAWN BY:	R. PELLETT
FILE NAME:	sl0c220xs.dgn	DESIGNED BY:	H. SALLS
PROJECT LEADER:	C. CARLSON	CHECKED BY:	H. SALLS
VT 12 CROSS SECTIONS 5		SHEET	34 OF 46

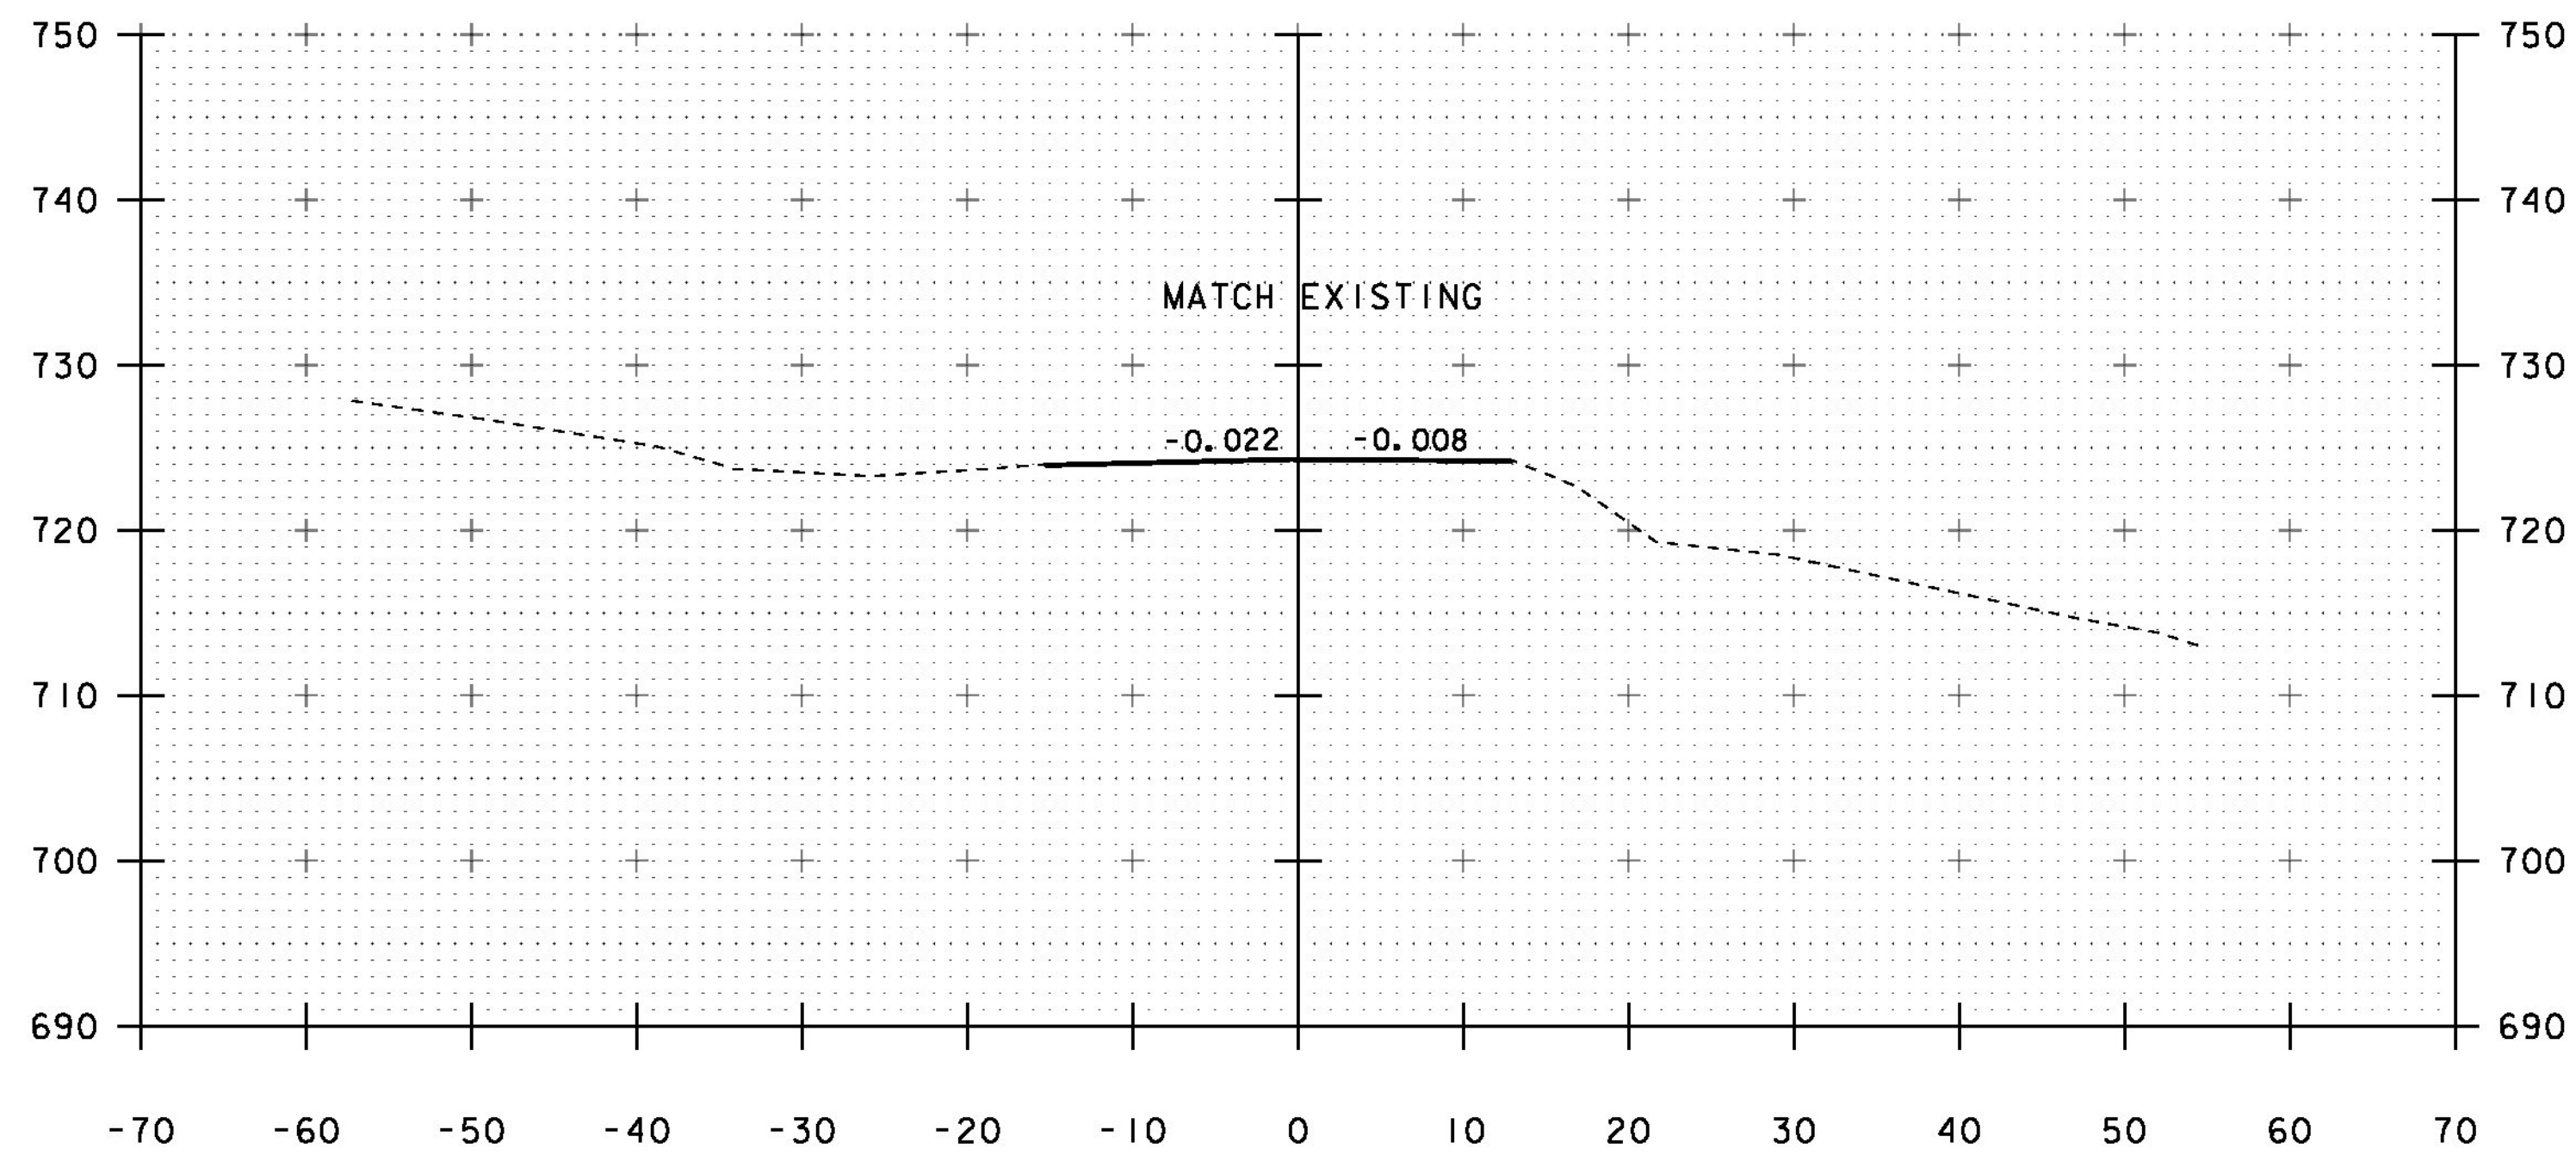

31+75
END APPROACH

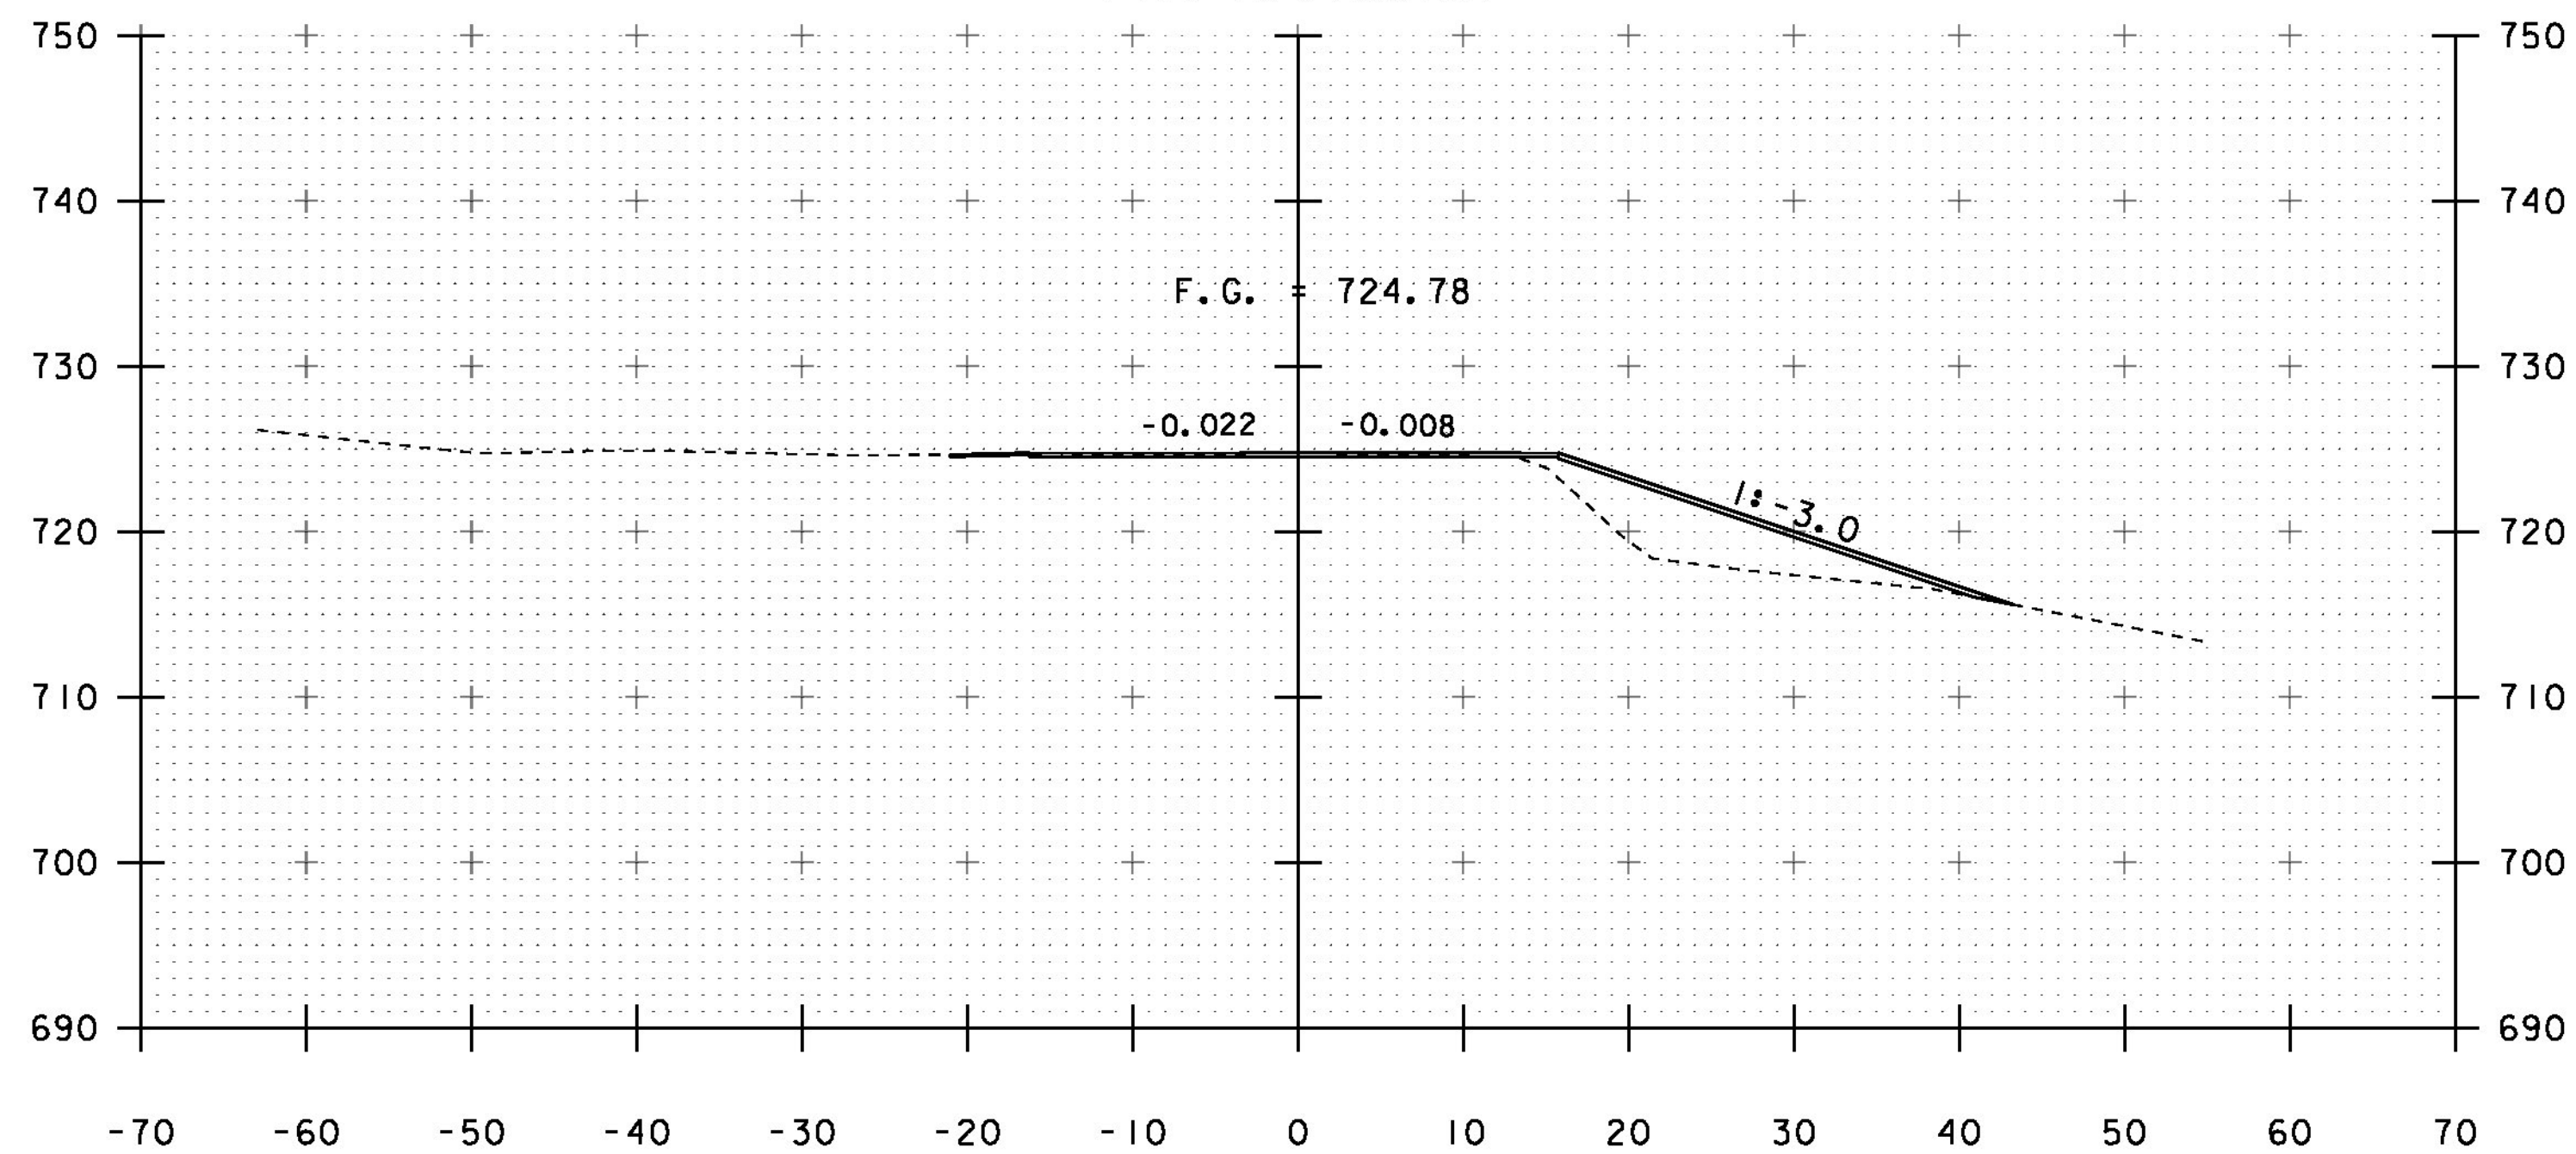

31+50

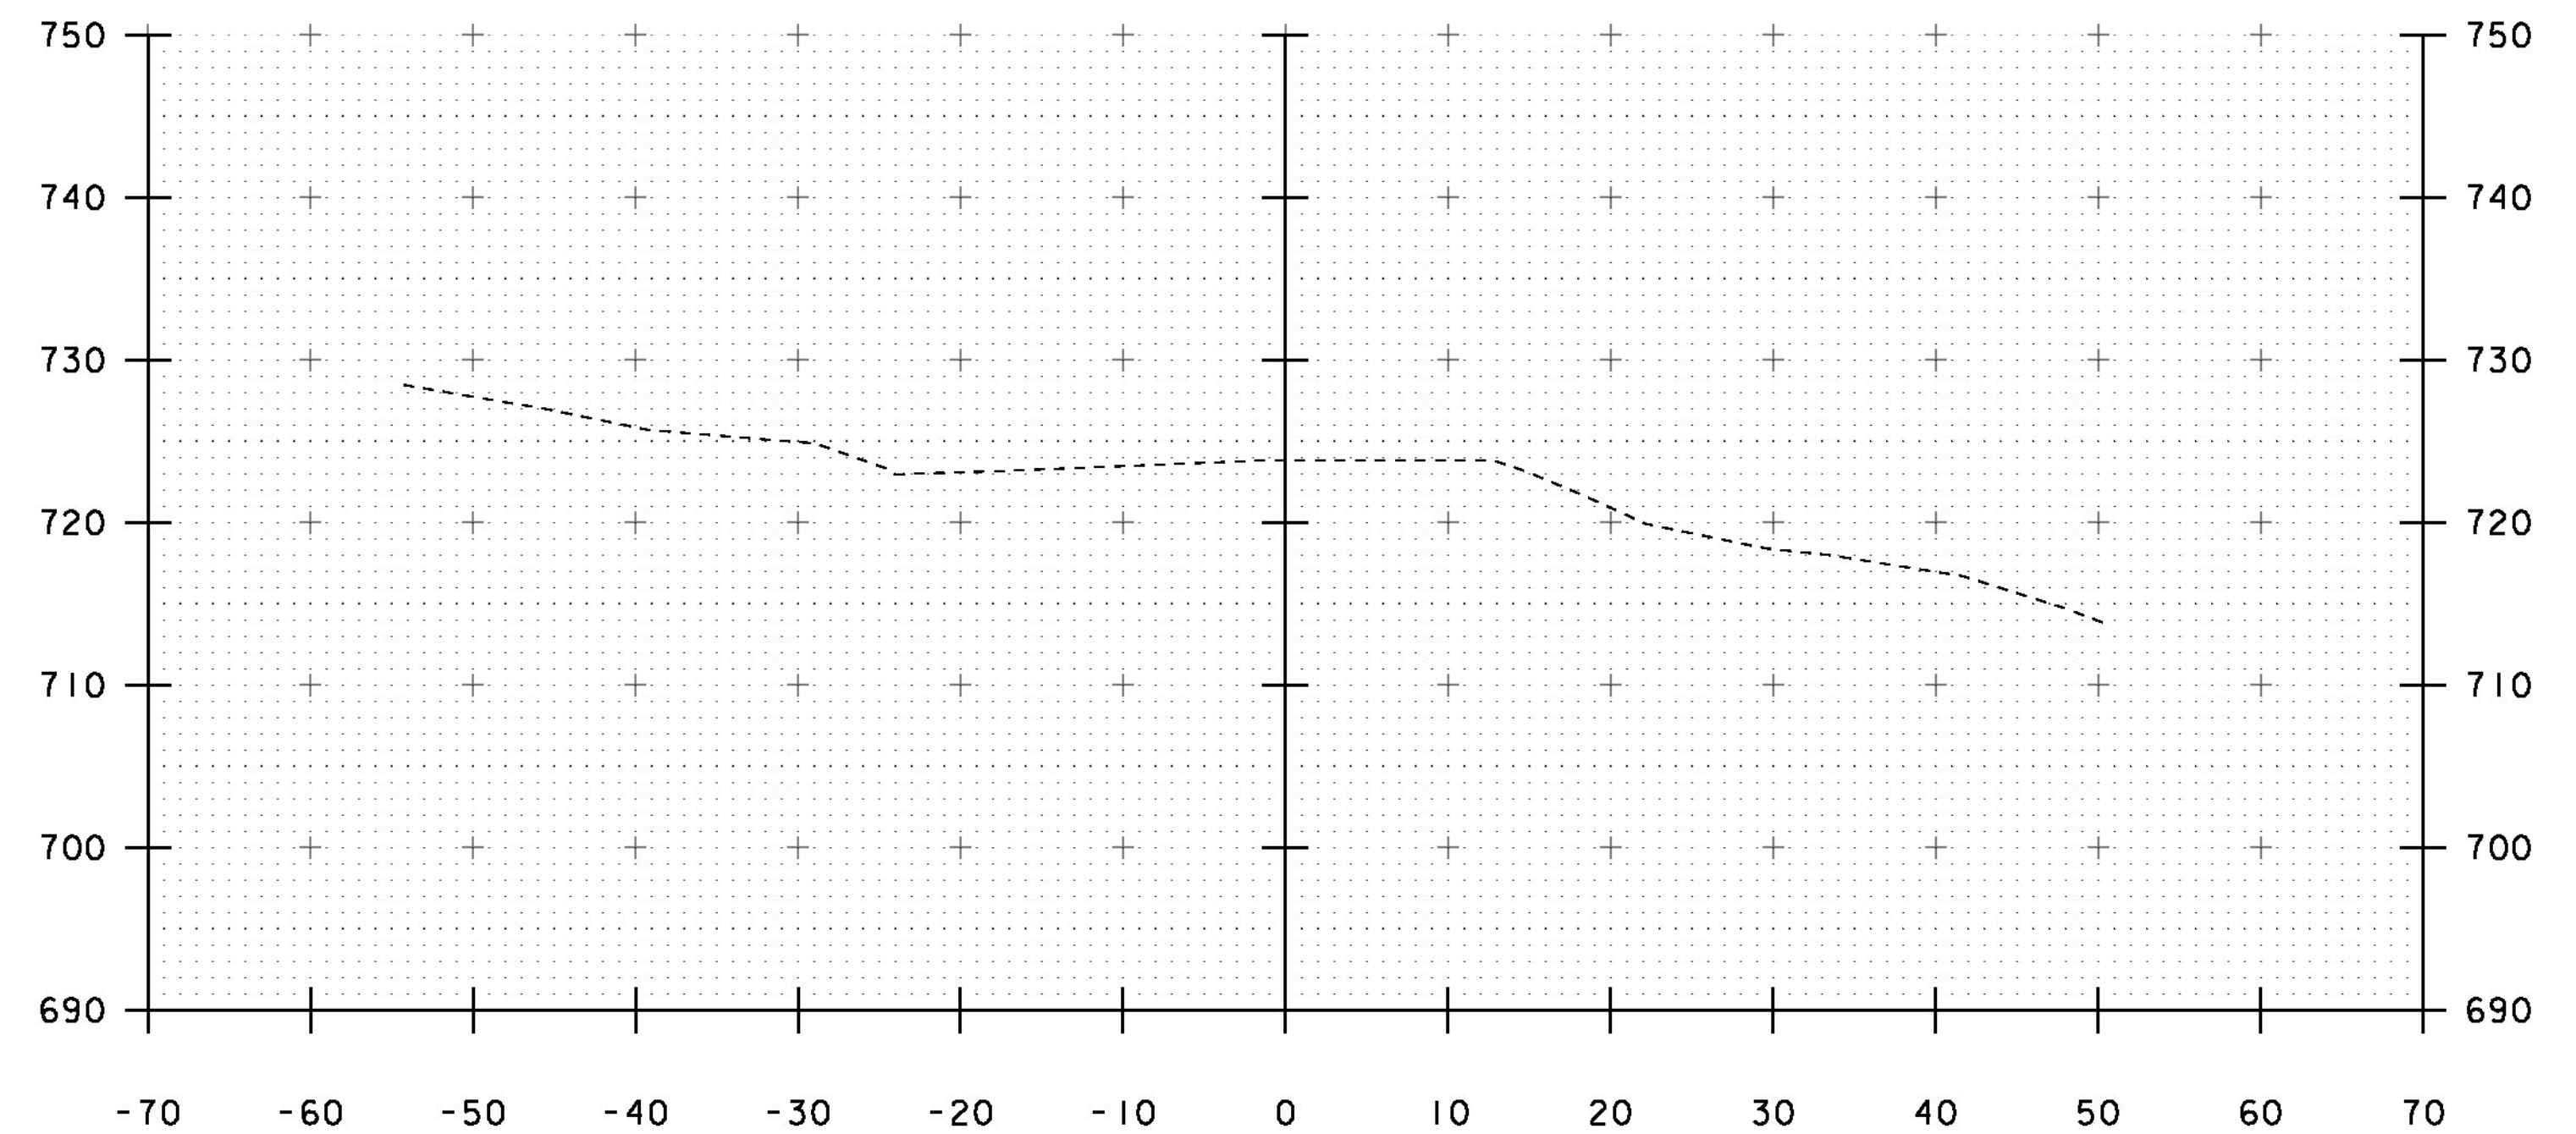


32+00

STA. 31+50 TO STA. 32+00

PROJECT NAME: MIDDLESEX
PROJECT NUMBER: BRP 024-1(37)


FILE NAME: sl0c220xs.dgn
PROJECT LEADER: C. CARLSON
DESIGNED BY: H. SALLS
VT 12 CROSS SECTIONS 6

PLOT DATE: 13-JAN-2015
DRAWN BY: R. PELLETT
CHECKED BY: H. SALLS
SHEET 35 OF 46

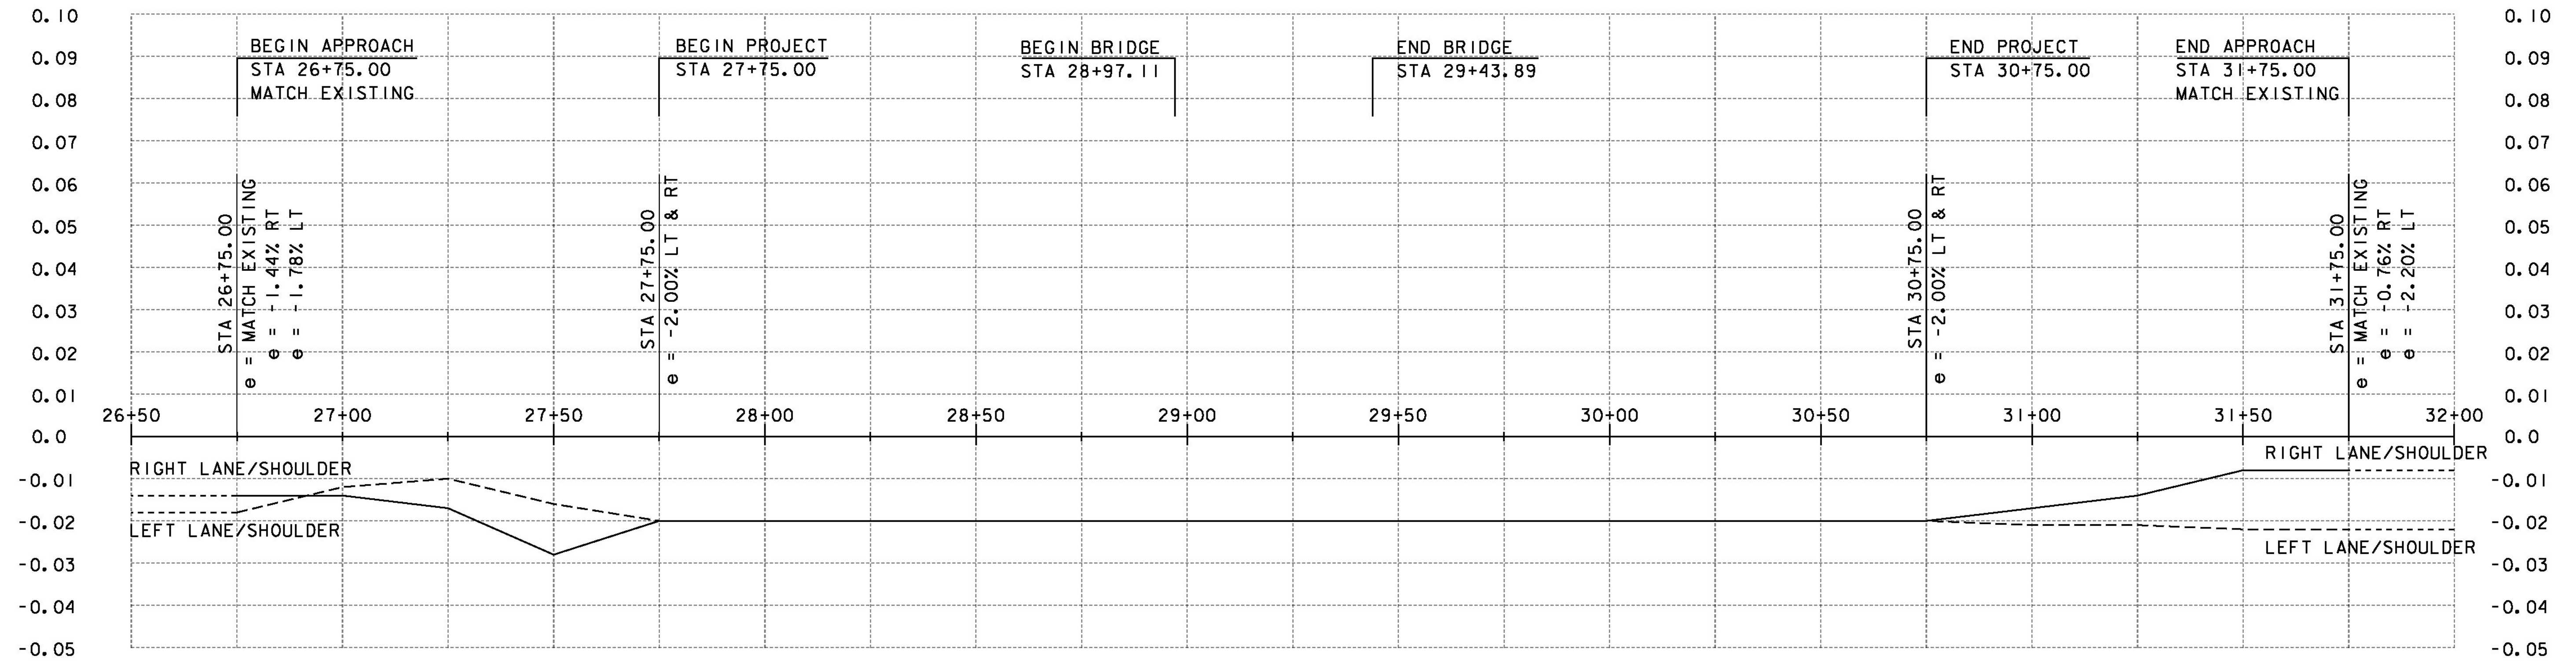

BANKING DIAGRAM


HOR. SCALE 1" = 20'-0"
NO VERT. SCALE

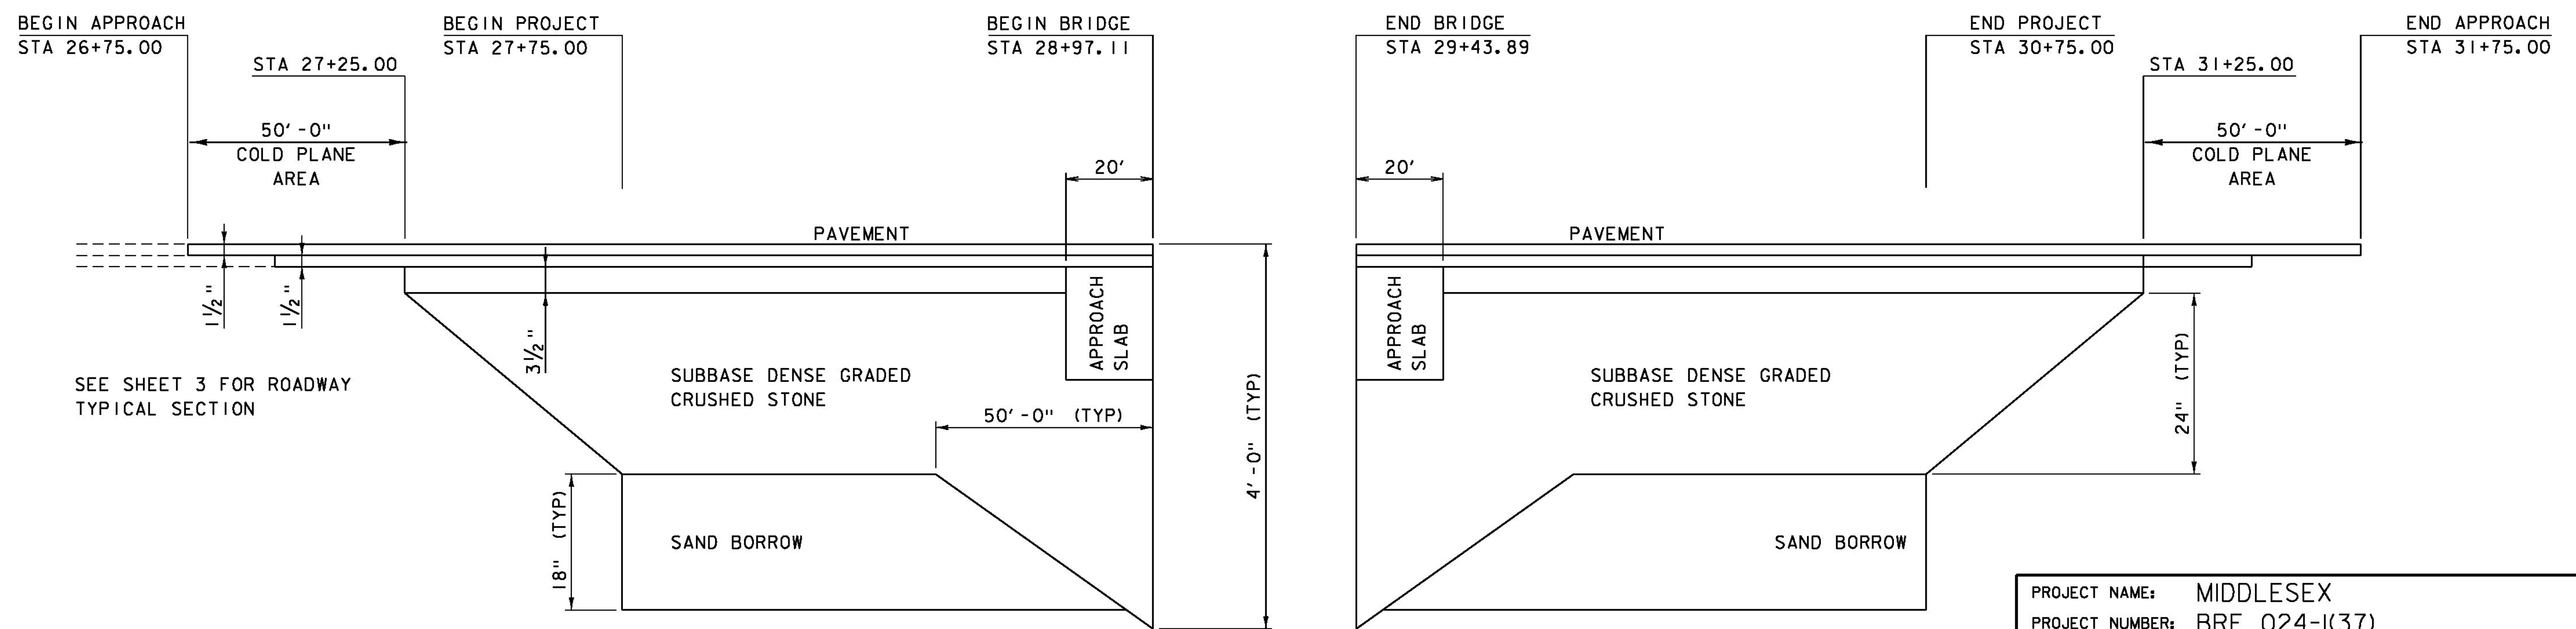


MATERIAL TRANSITION

HOR. SCALE 1" = 20'-0"
NO VERT. SCALE


PROJECT NAME: MIDDLESEX	
PROJECT NUMBER: BRF 024-1(37)	
FILE NAME: sl0c220xs.dgn	PLOT DATE: 13-JAN-2015
PROJECT LEADER: C. CARLSON	DRAWN BY: R. PELLETT
DESIGNED BY: H. SALLS	CHECKED BY: H. SALLS
BANKING & MATERIAL TRANSITION	SHEET 36 OF 46

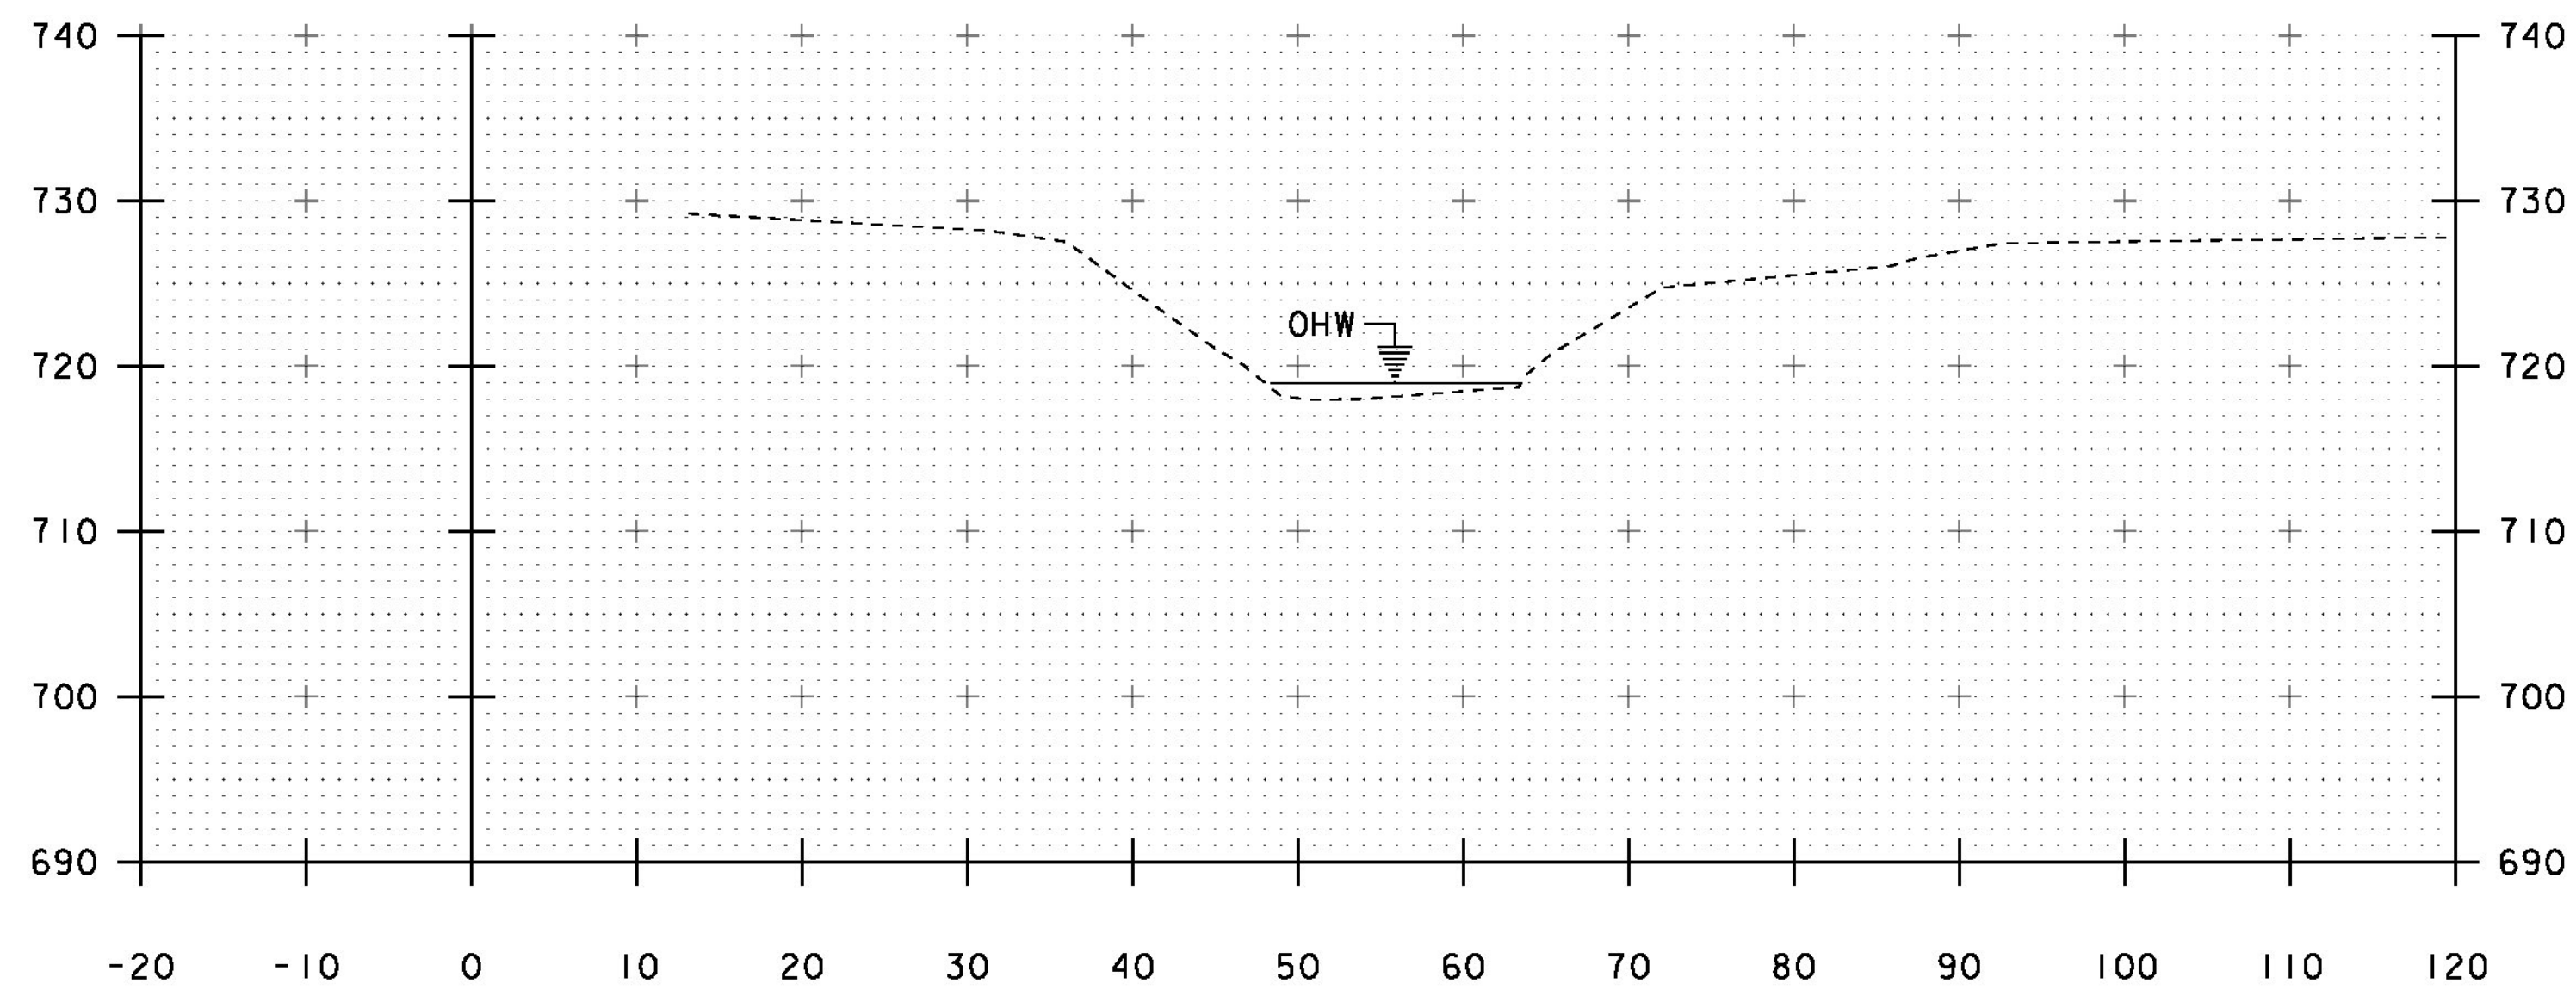


100+50

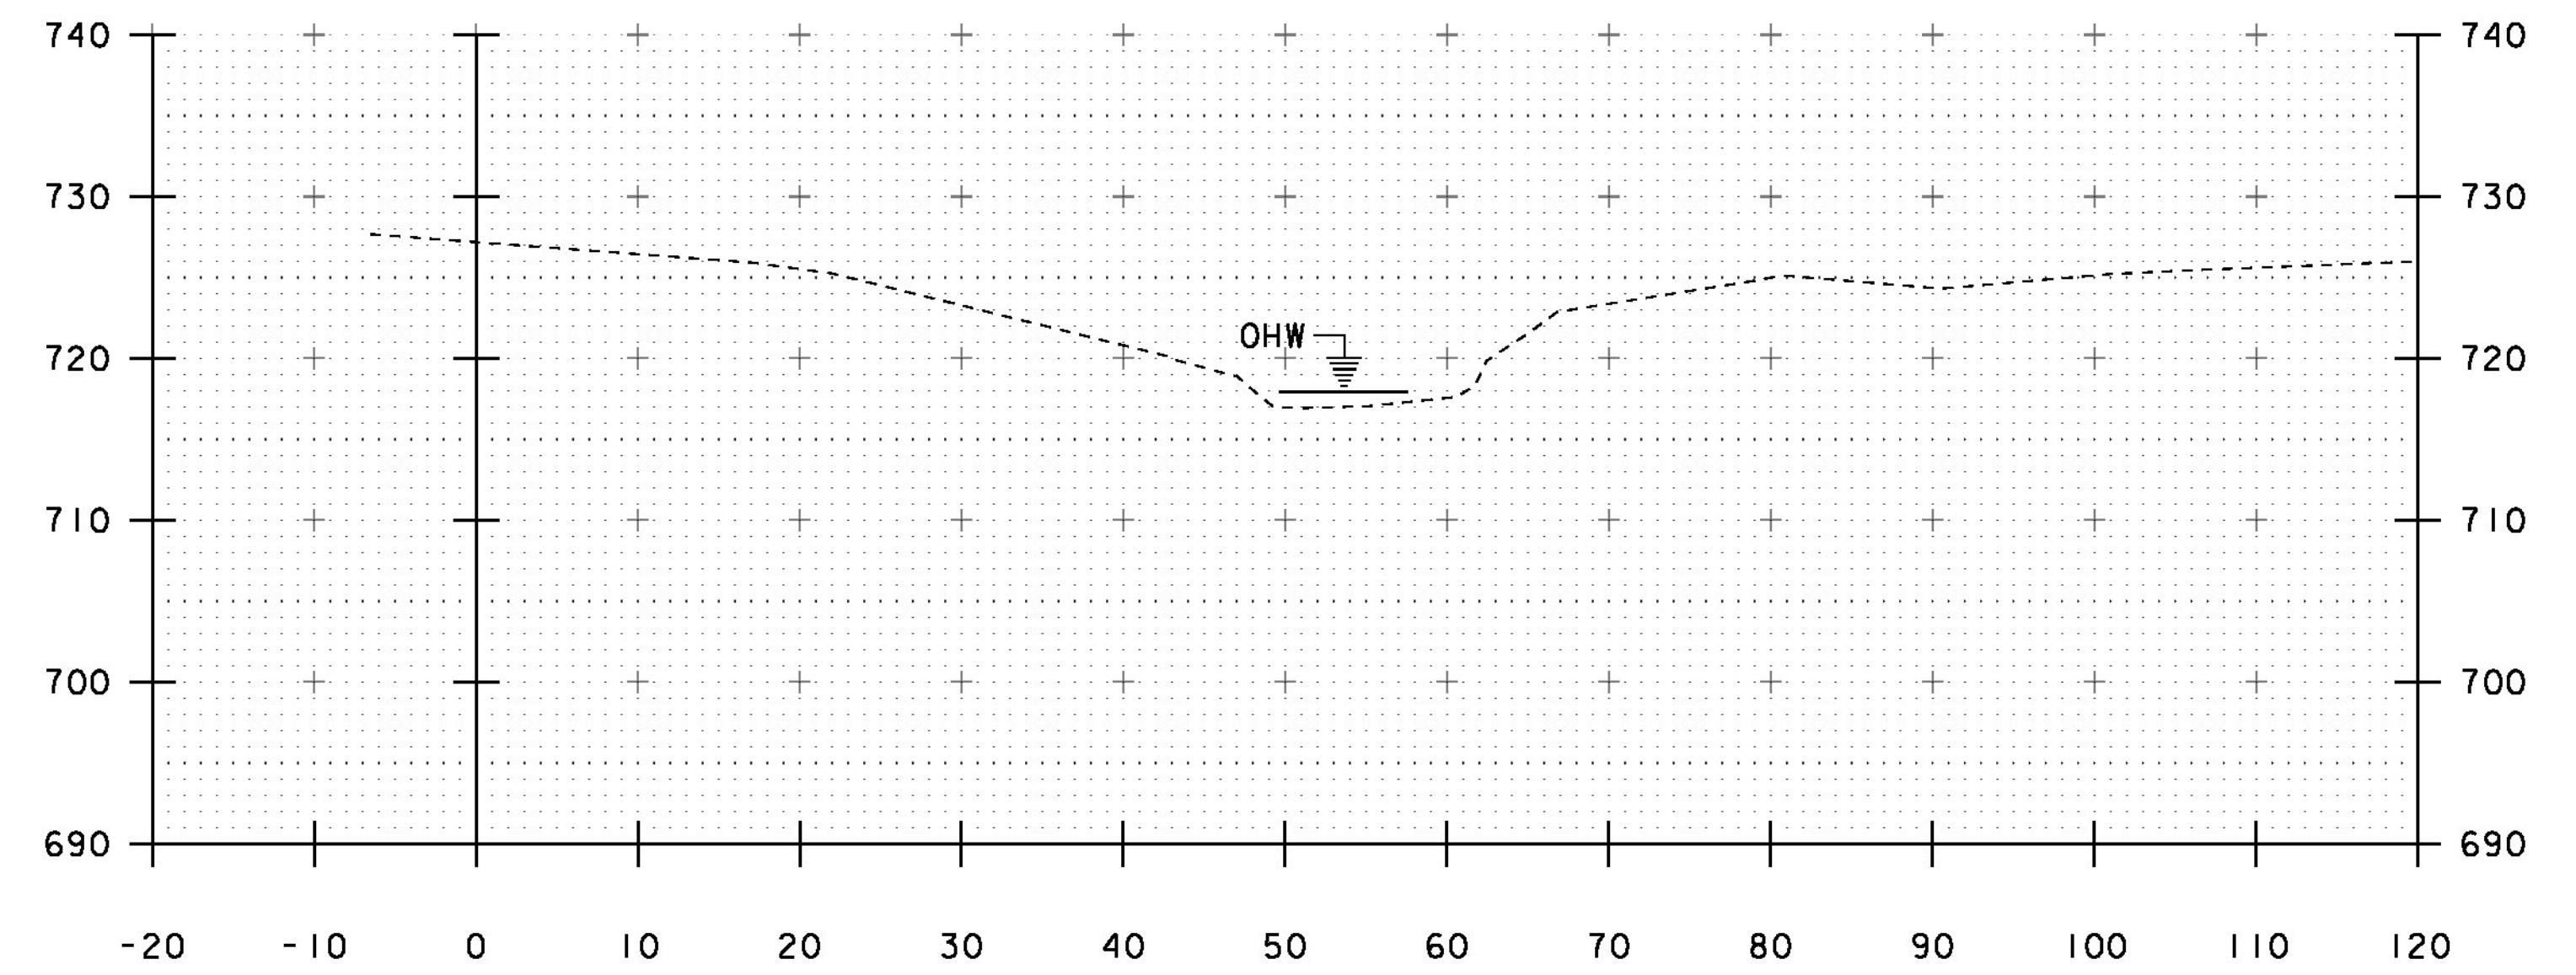

100+80

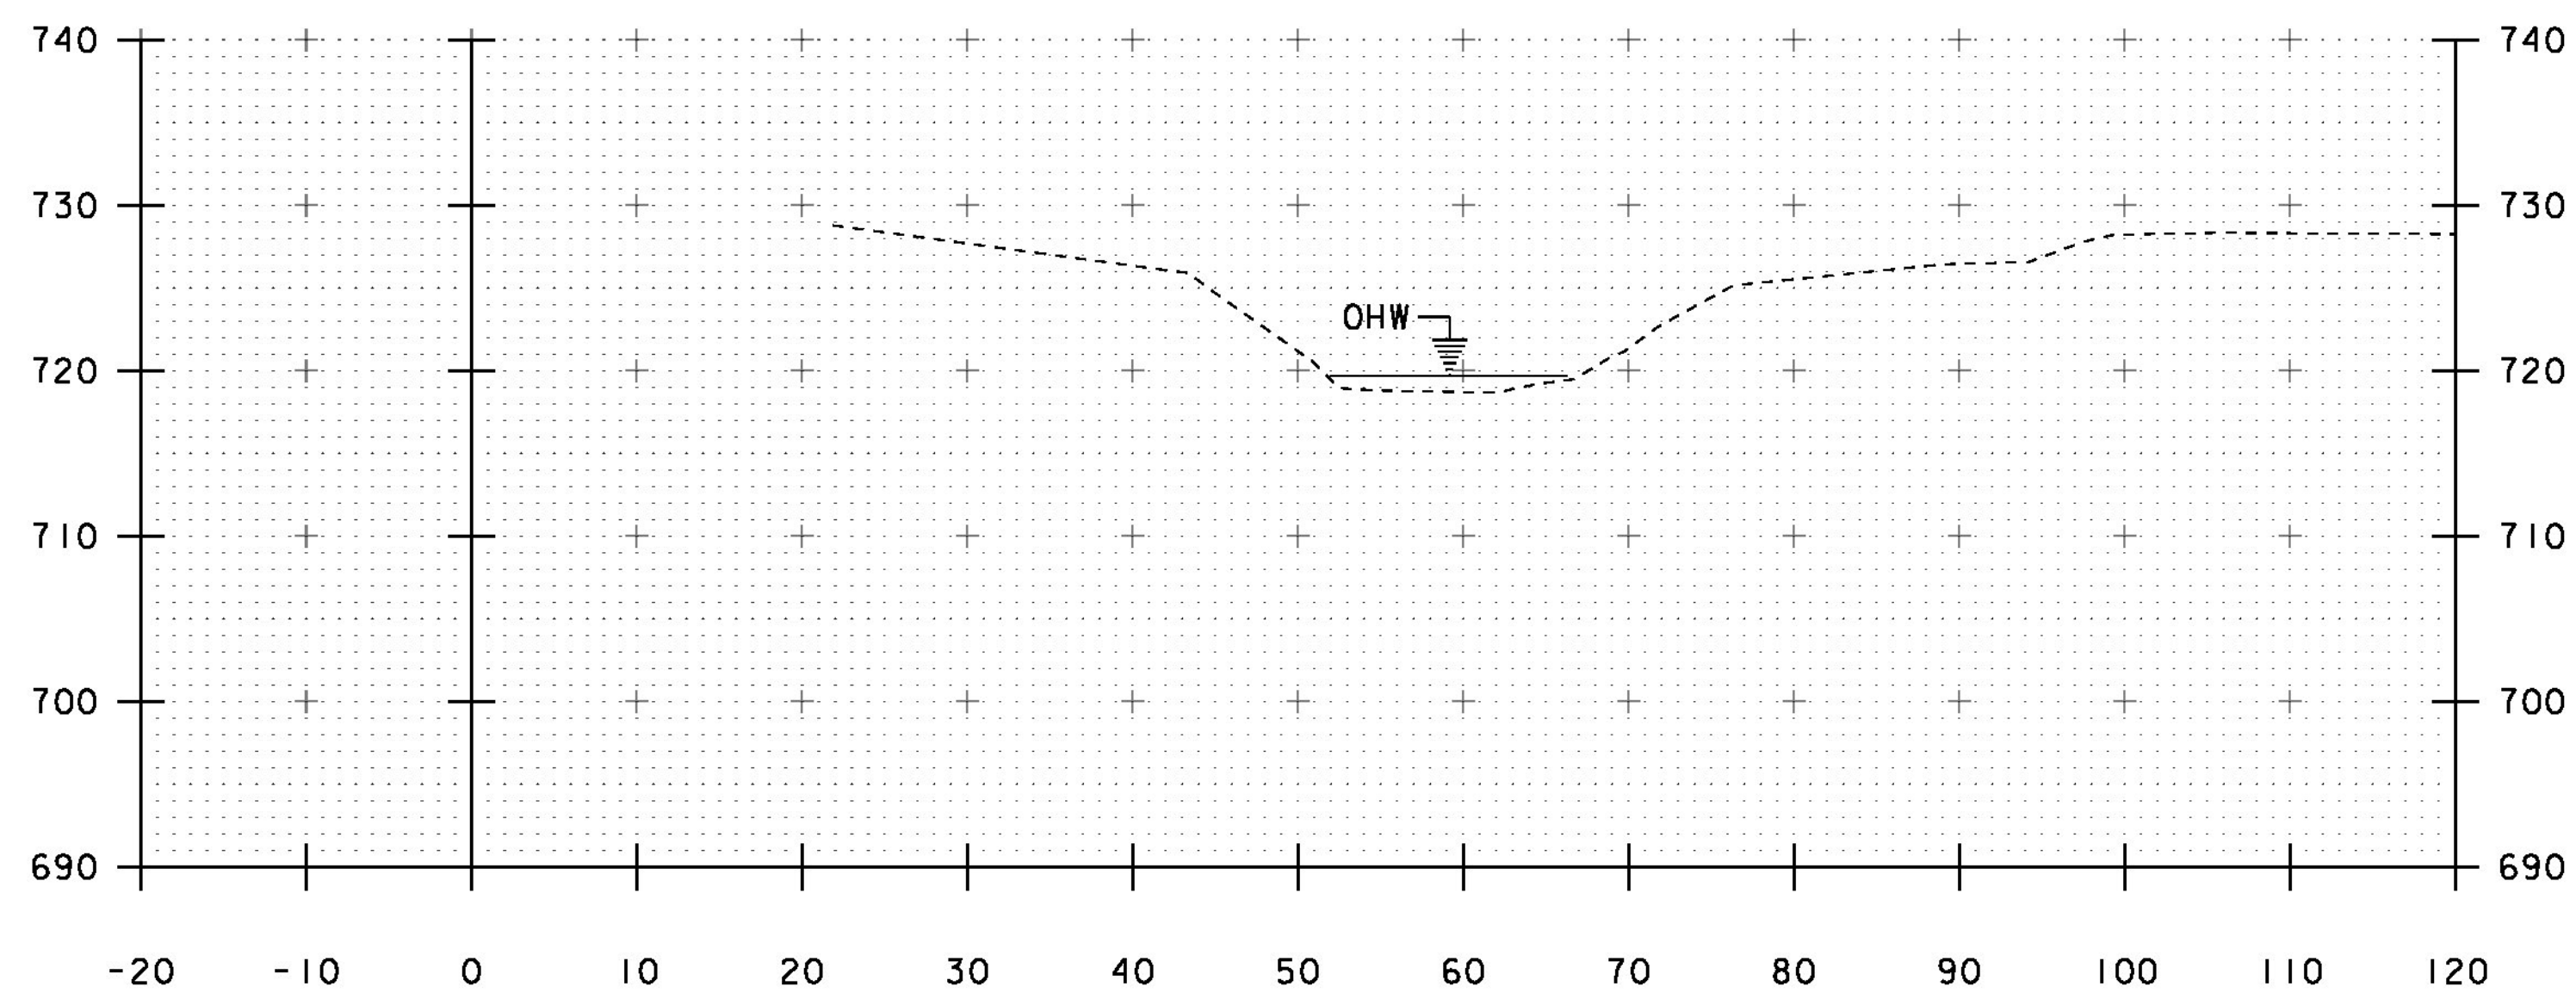


100+25

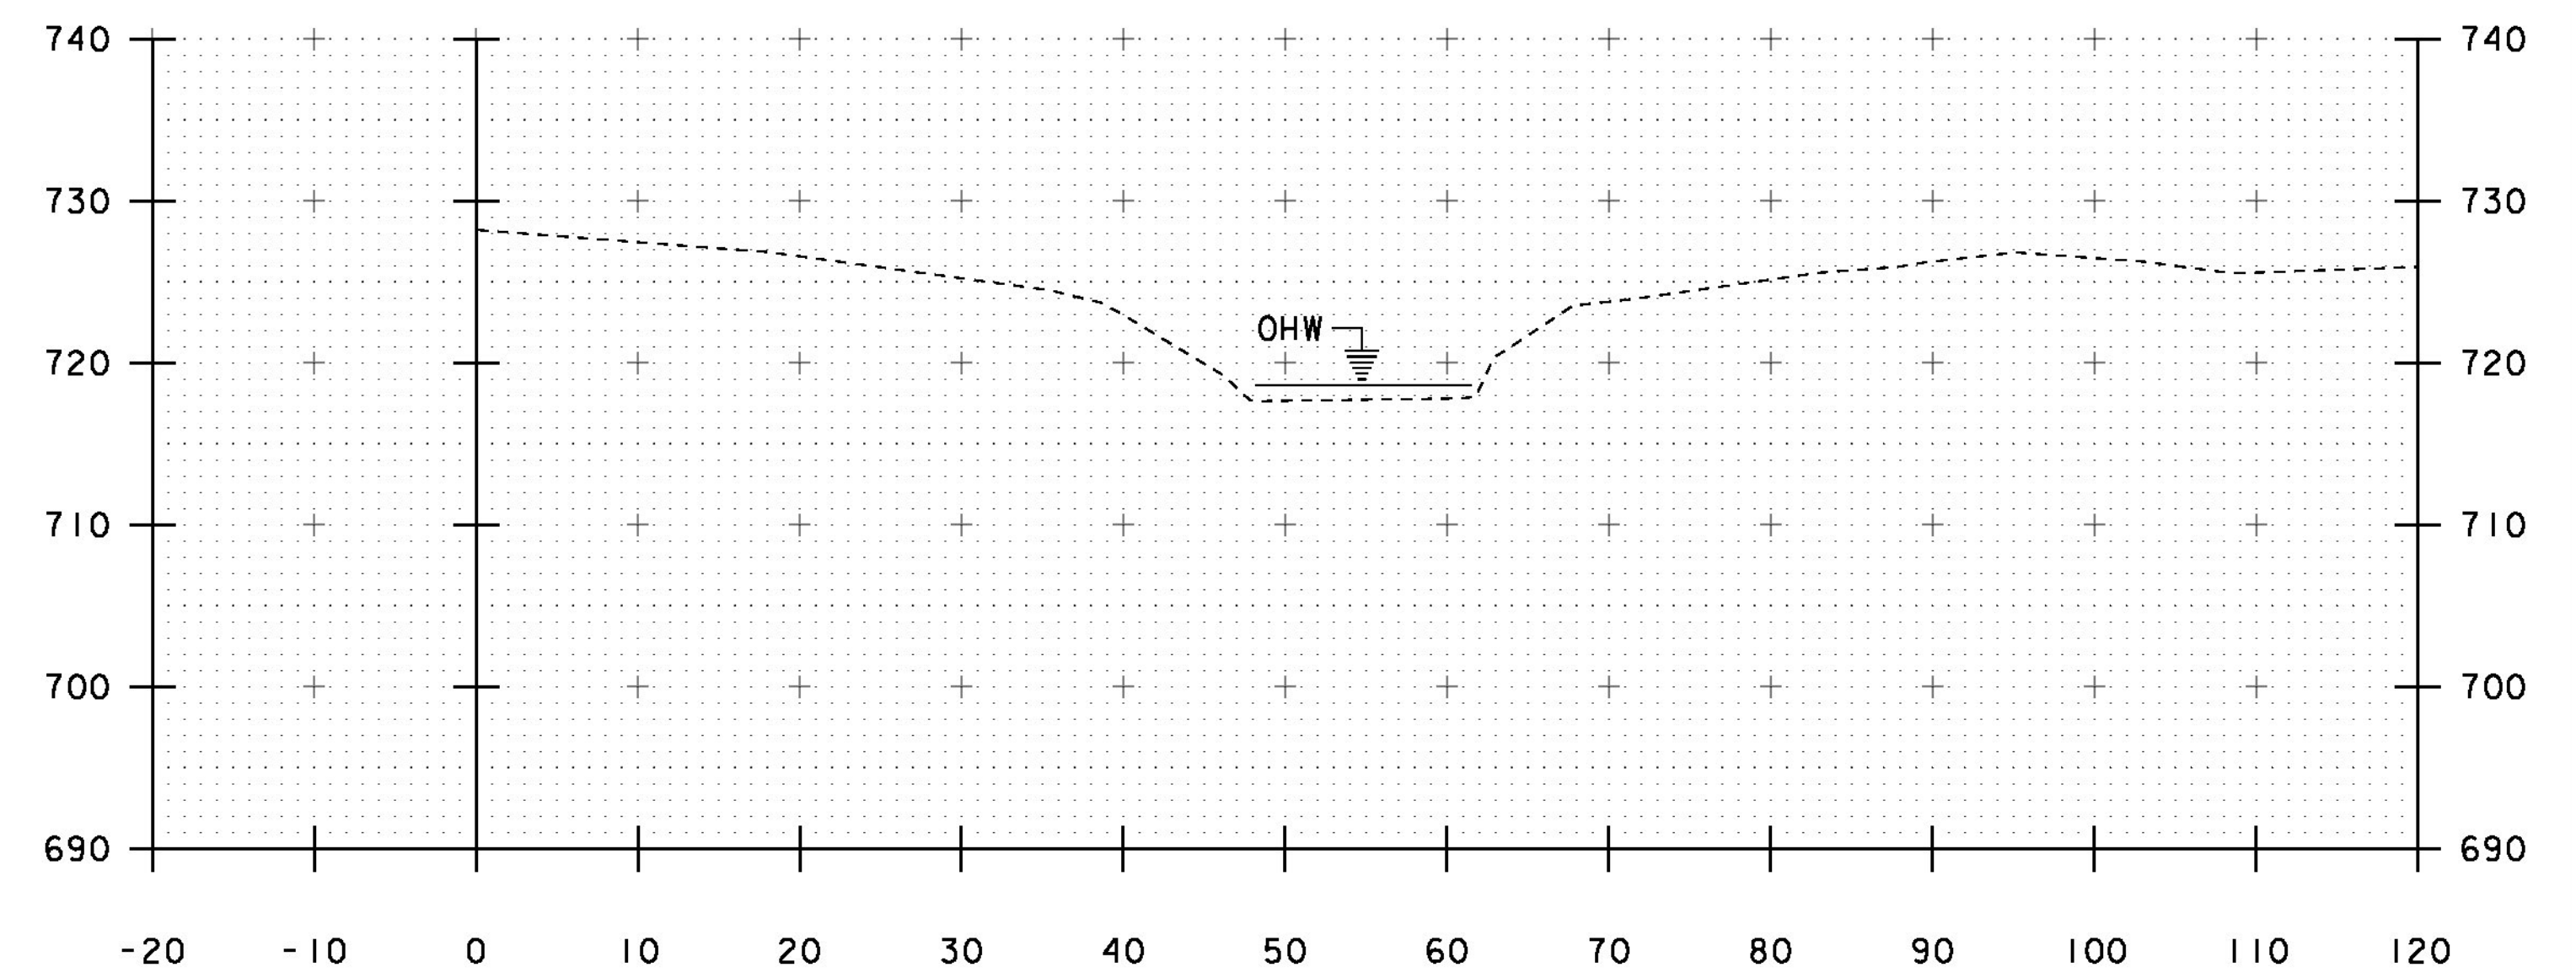


100+70

STA. 100+25 TO STA. 100+80


PROJECT NAME:	MIDDLESEX	PLOT DATE:	13-JAN-2015
PROJECT NUMBER:	BRF 024-I(37)	DRAWN BY:	R. PELLETT
FILE NAME:	sl0c220xs.dgn	DESIGNED BY:	H. SALLS
PROJECT LEADER:	C. CARLSON	CHECKED BY:	H. SALLS
CHANNEL CROSS SECTIONS I		SHEET	37 OF 46

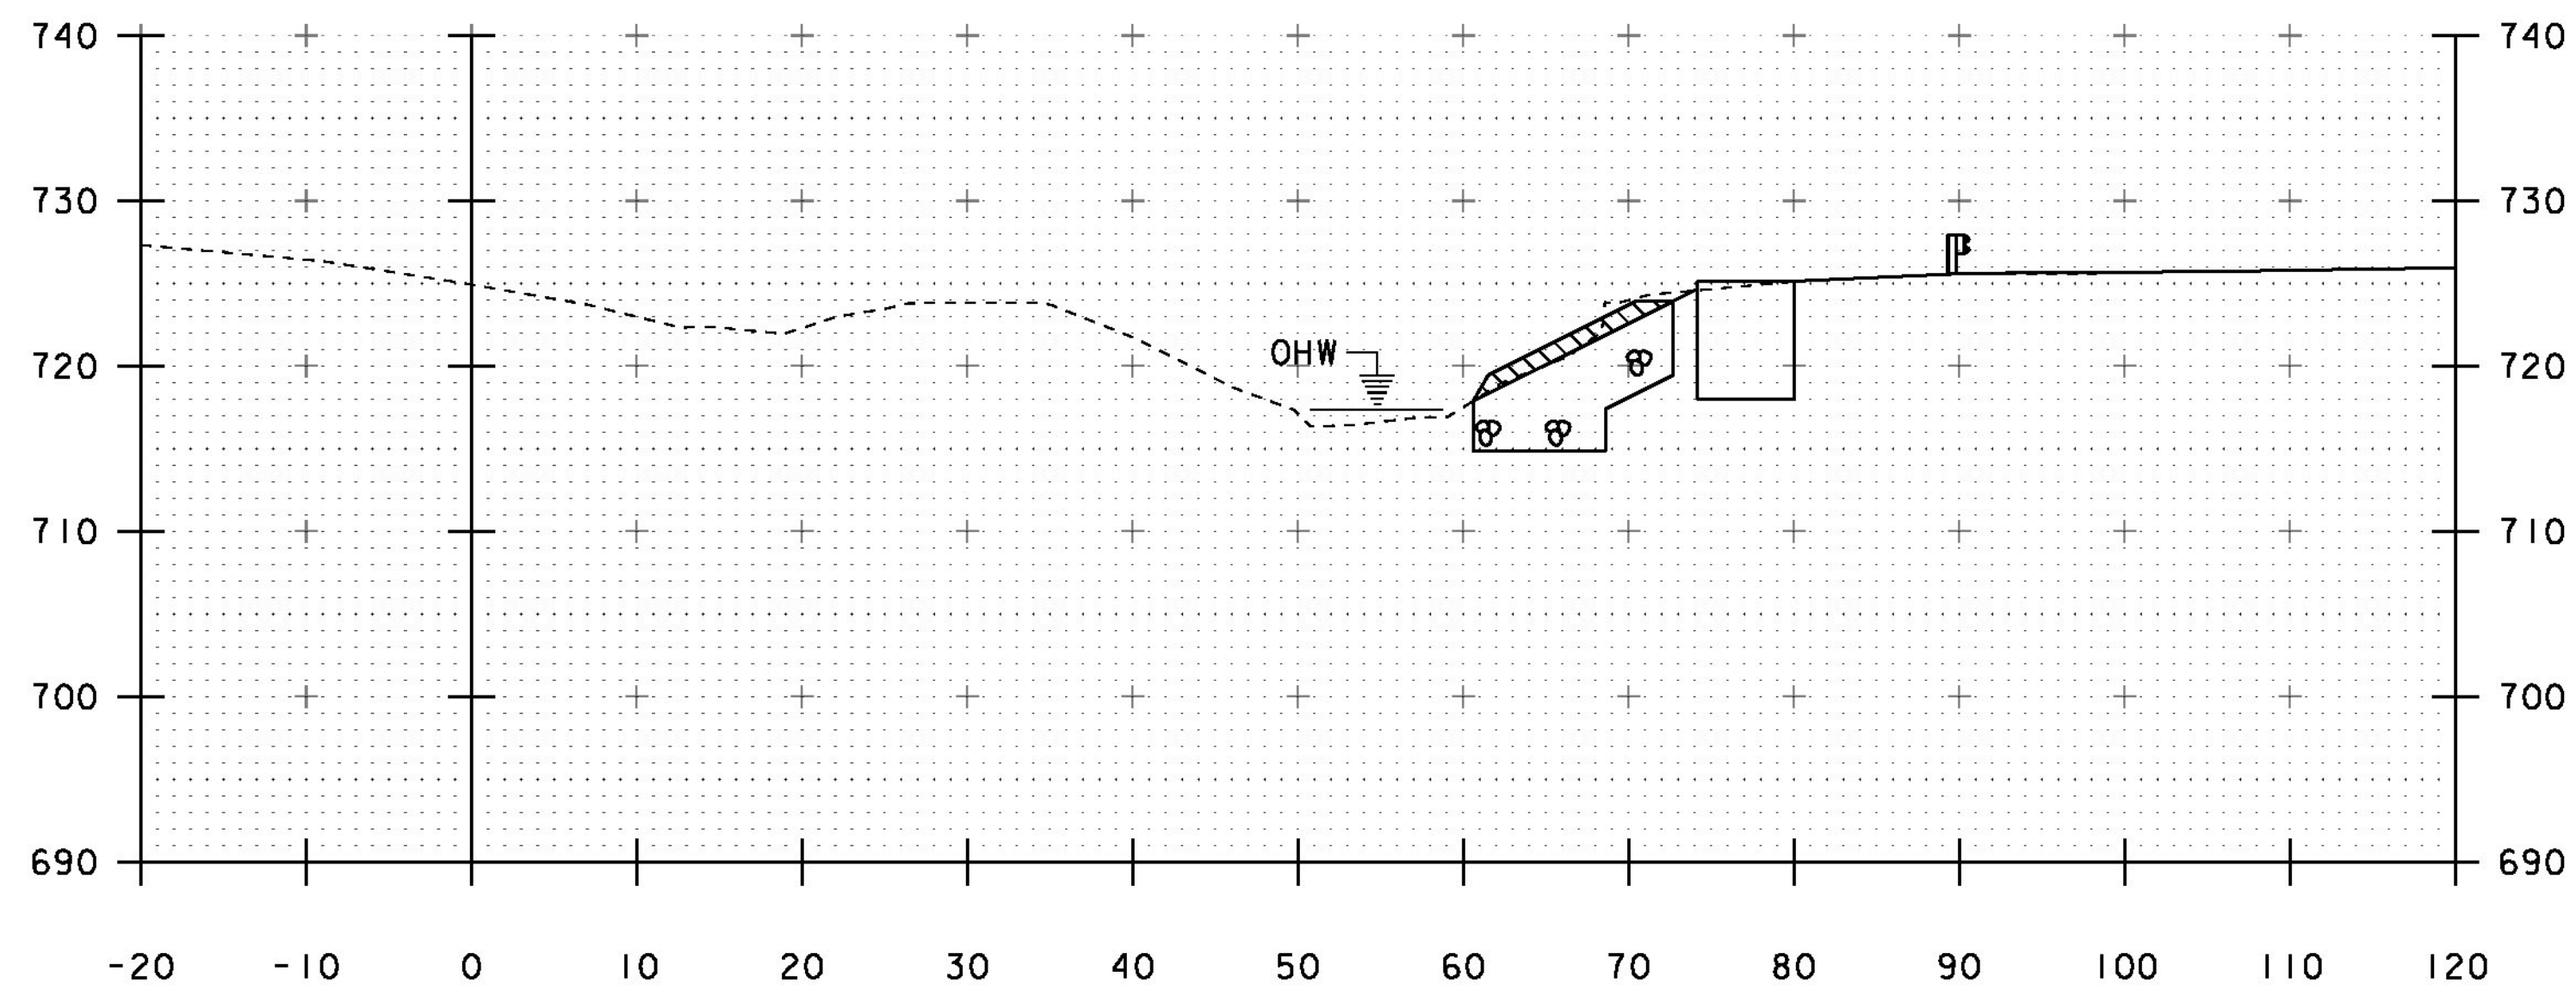


101+00

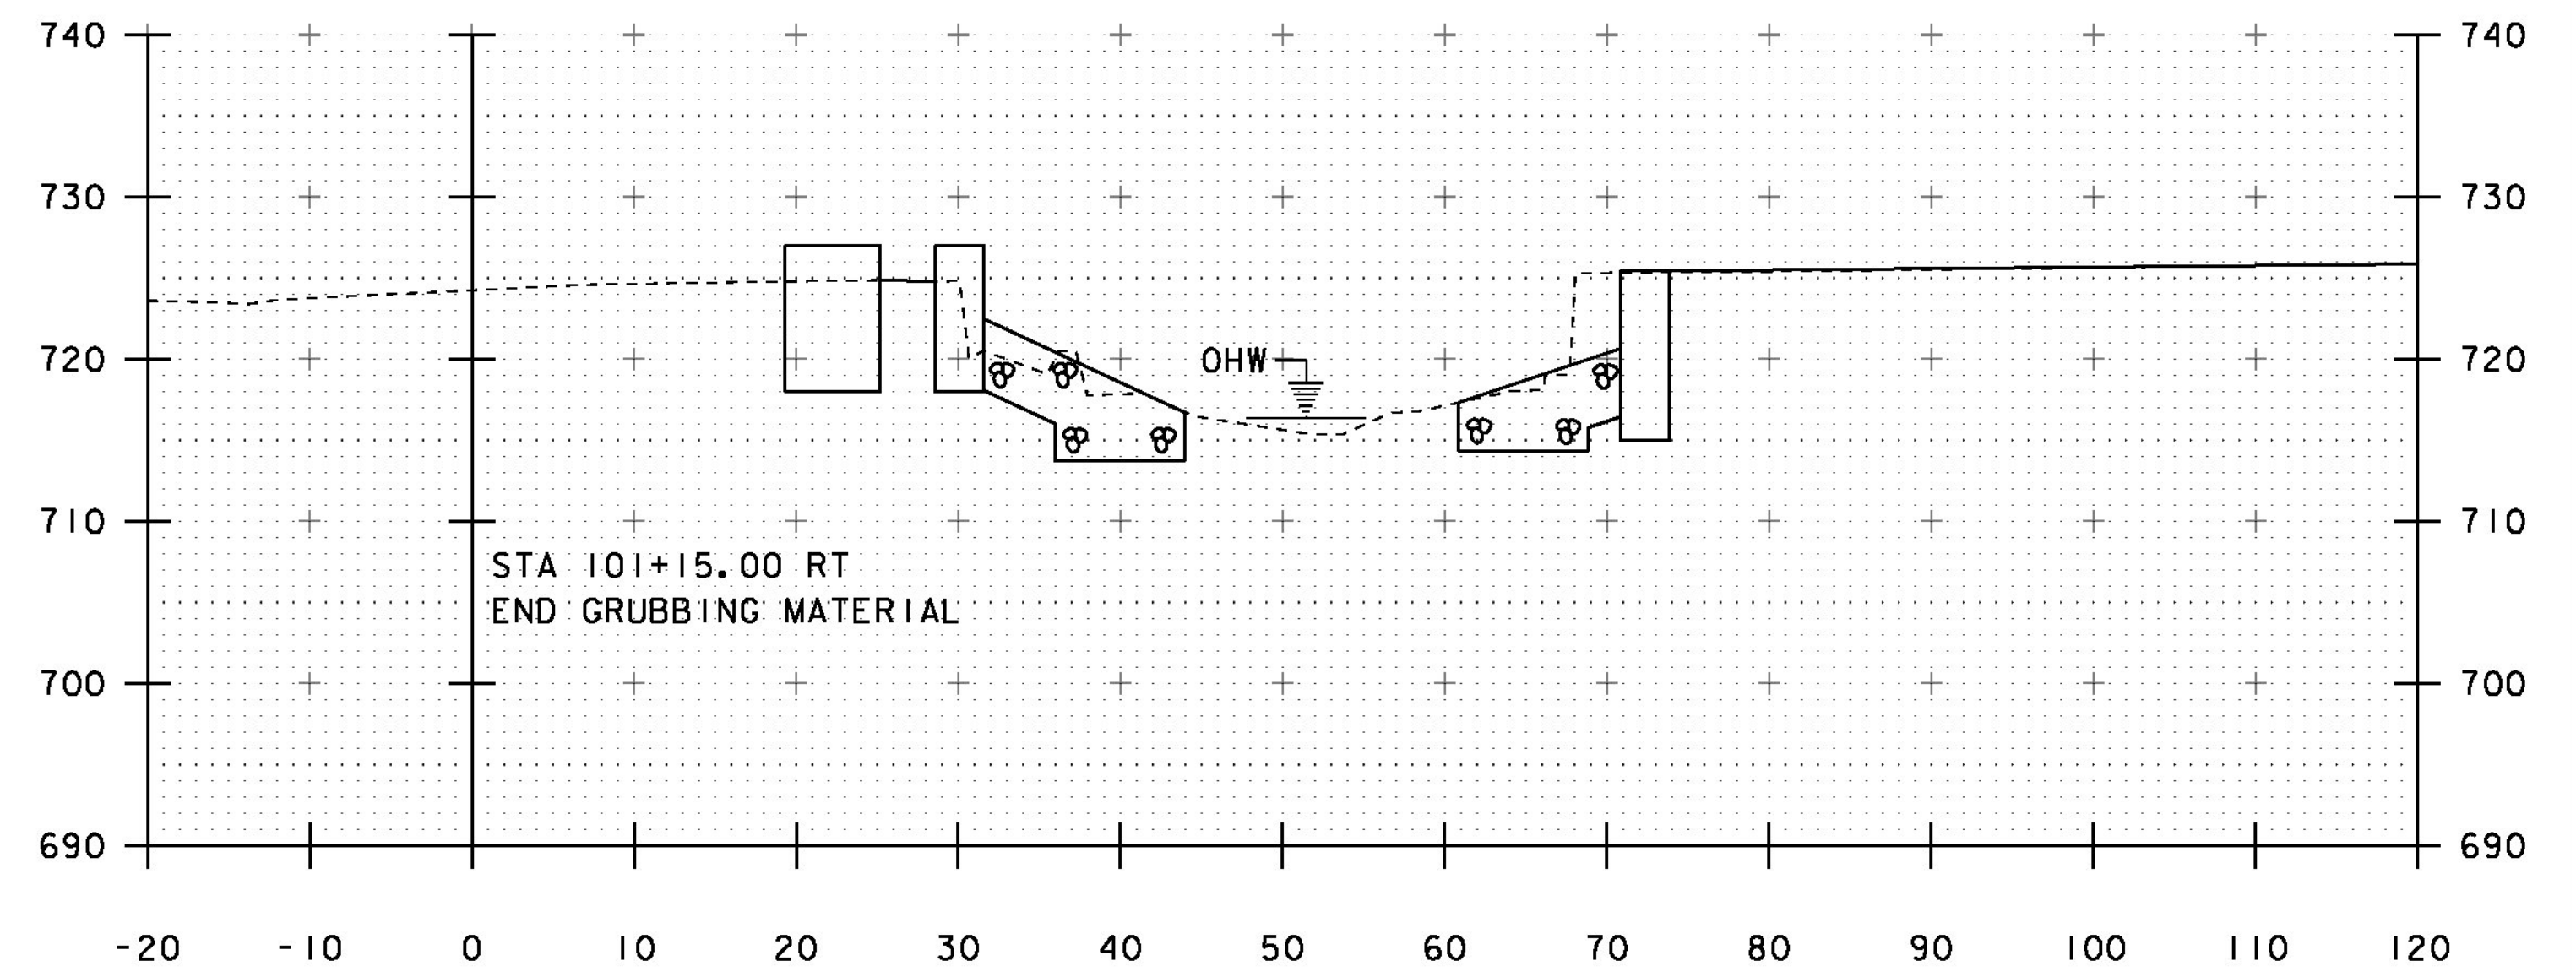

101+20

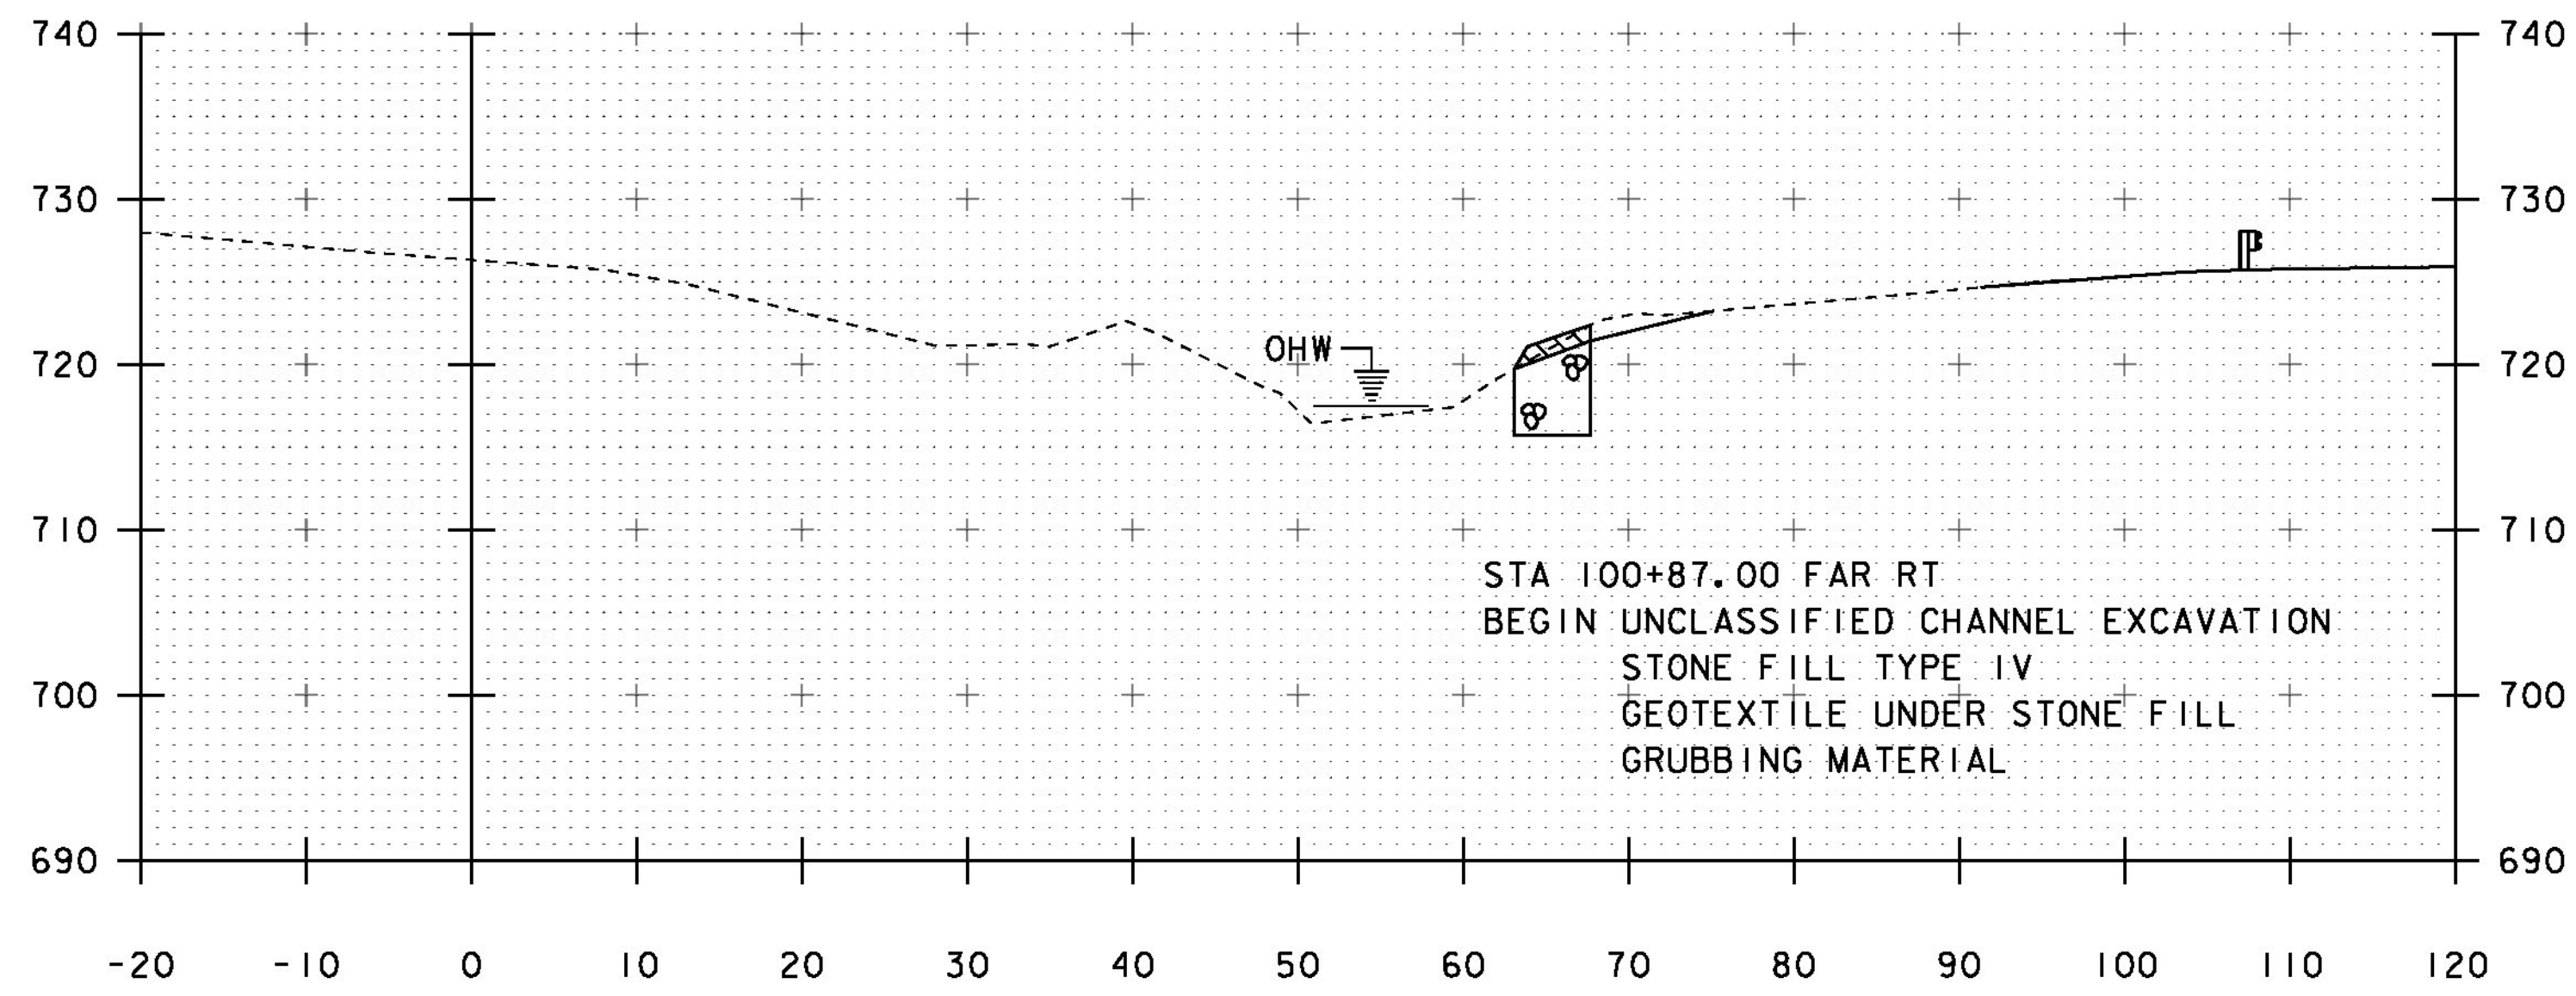

100+90

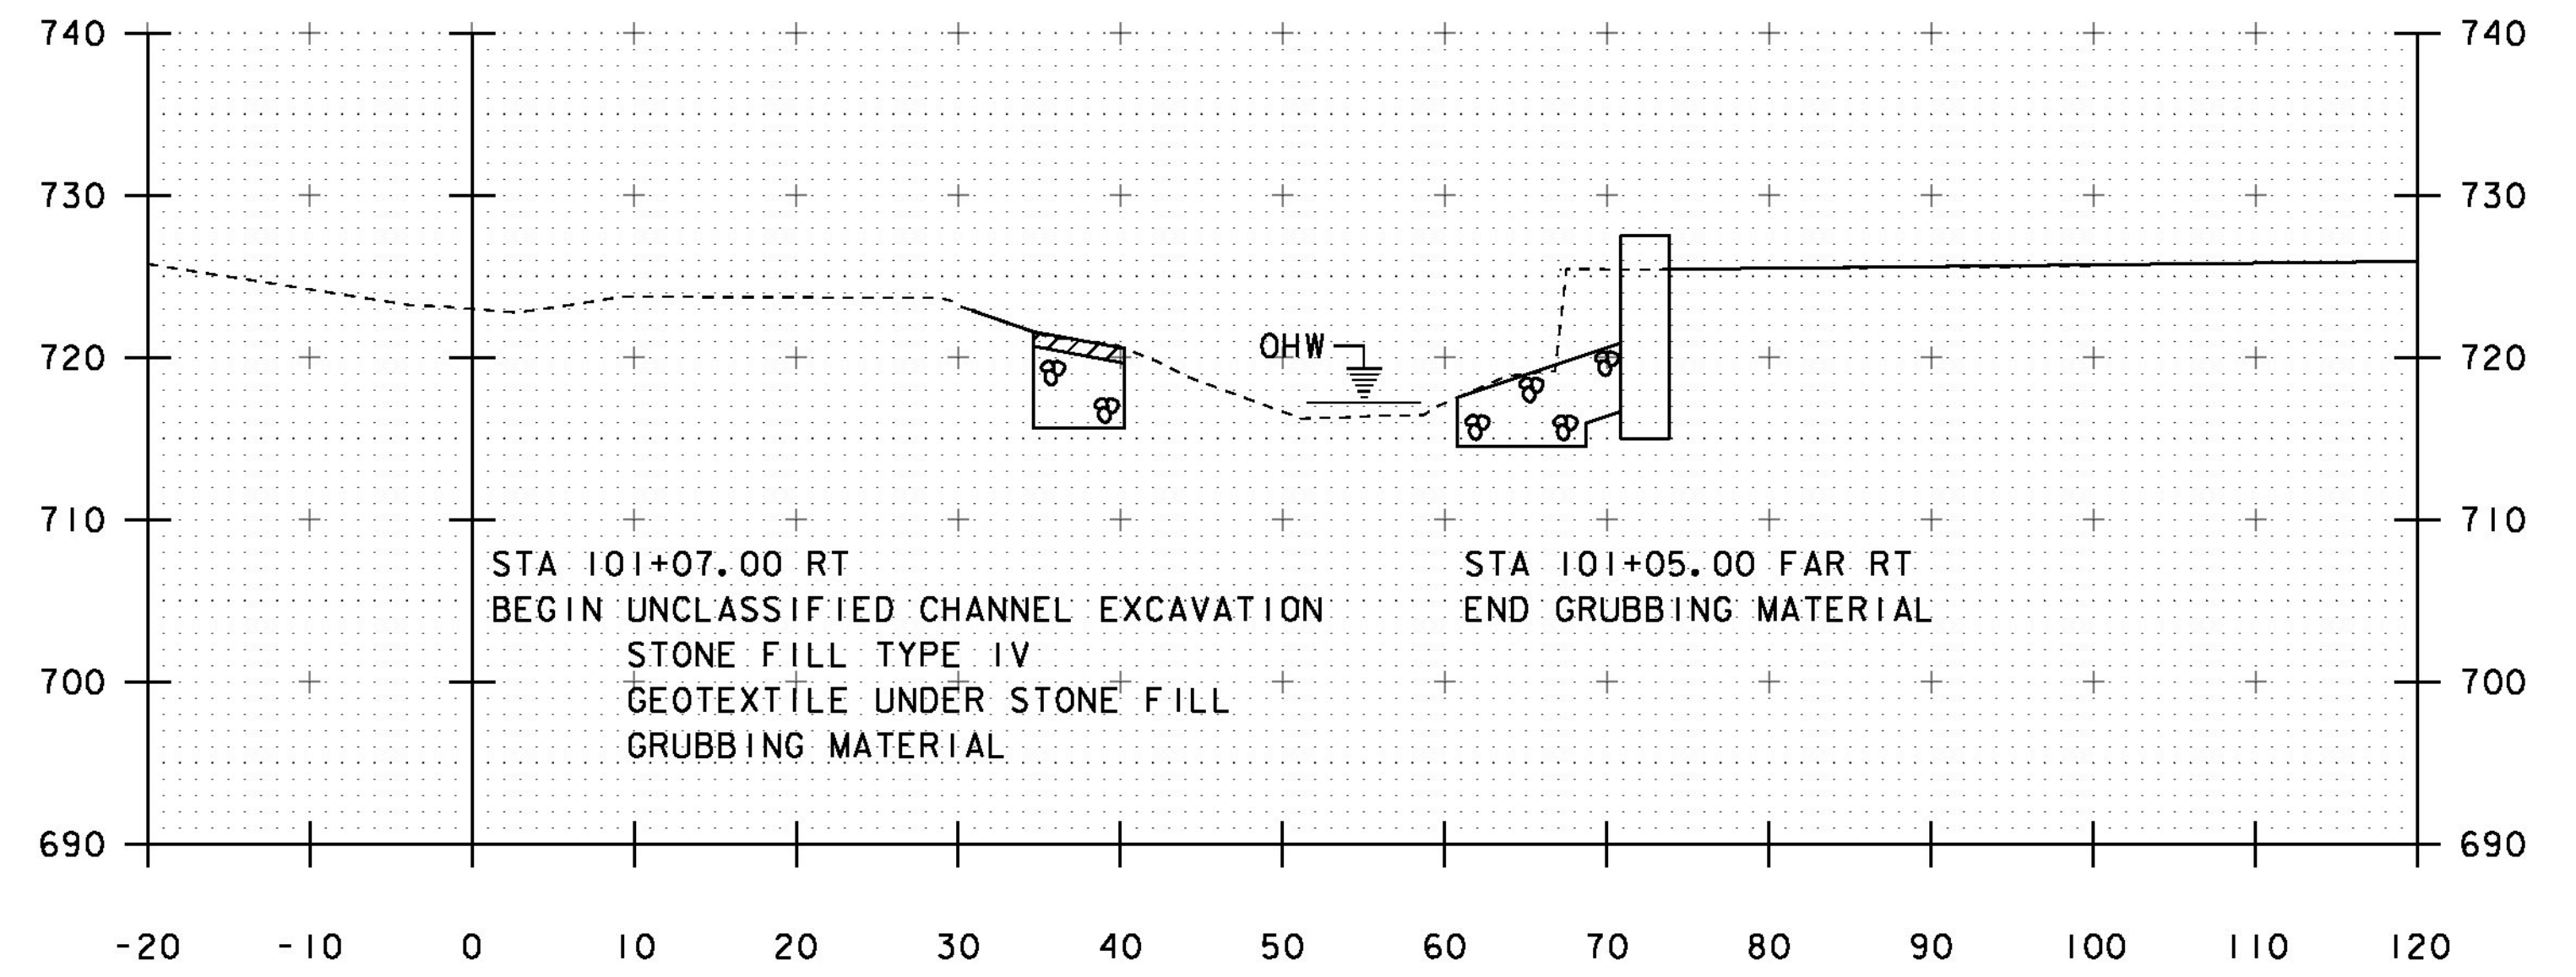


101+10

STA. 100+90 TO STA. 101+20


PROJECT NAME: MIDDLESEX
PROJECT NUMBER: BRP 024-1(37)

FILE NAME: sl0c220xs.dgn
PROJECT LEADER: C. CARLSON
DESIGNED BY: H. SALLS
CHANNEL CROSS SECTIONS 2


PLOT DATE: 13-JAN-2015
DRAWN BY: R. PELLETT
CHECKED BY: H. SALLS
SHEET 38 OF 46

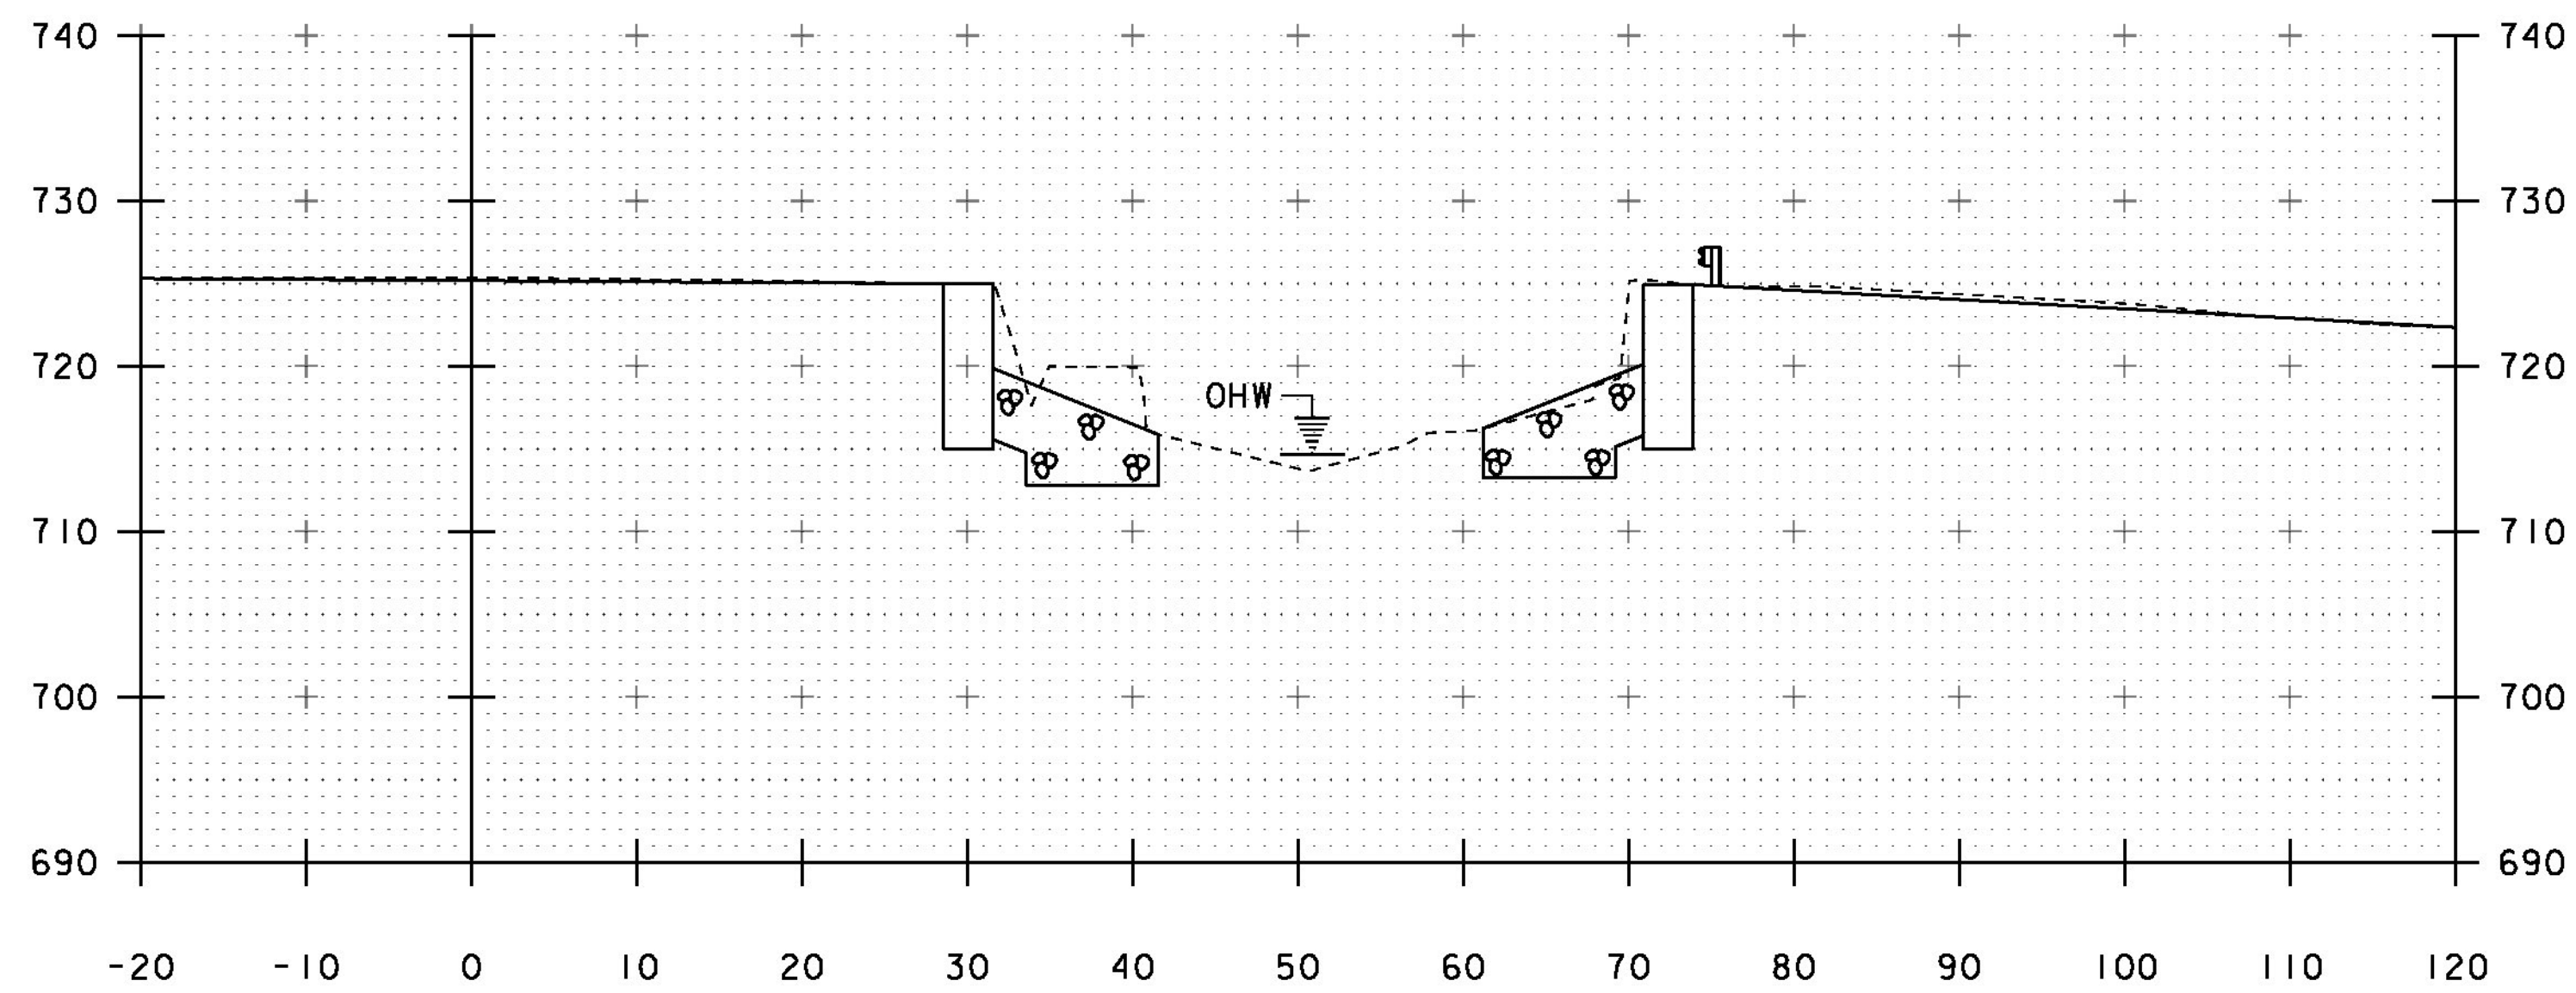


101+40

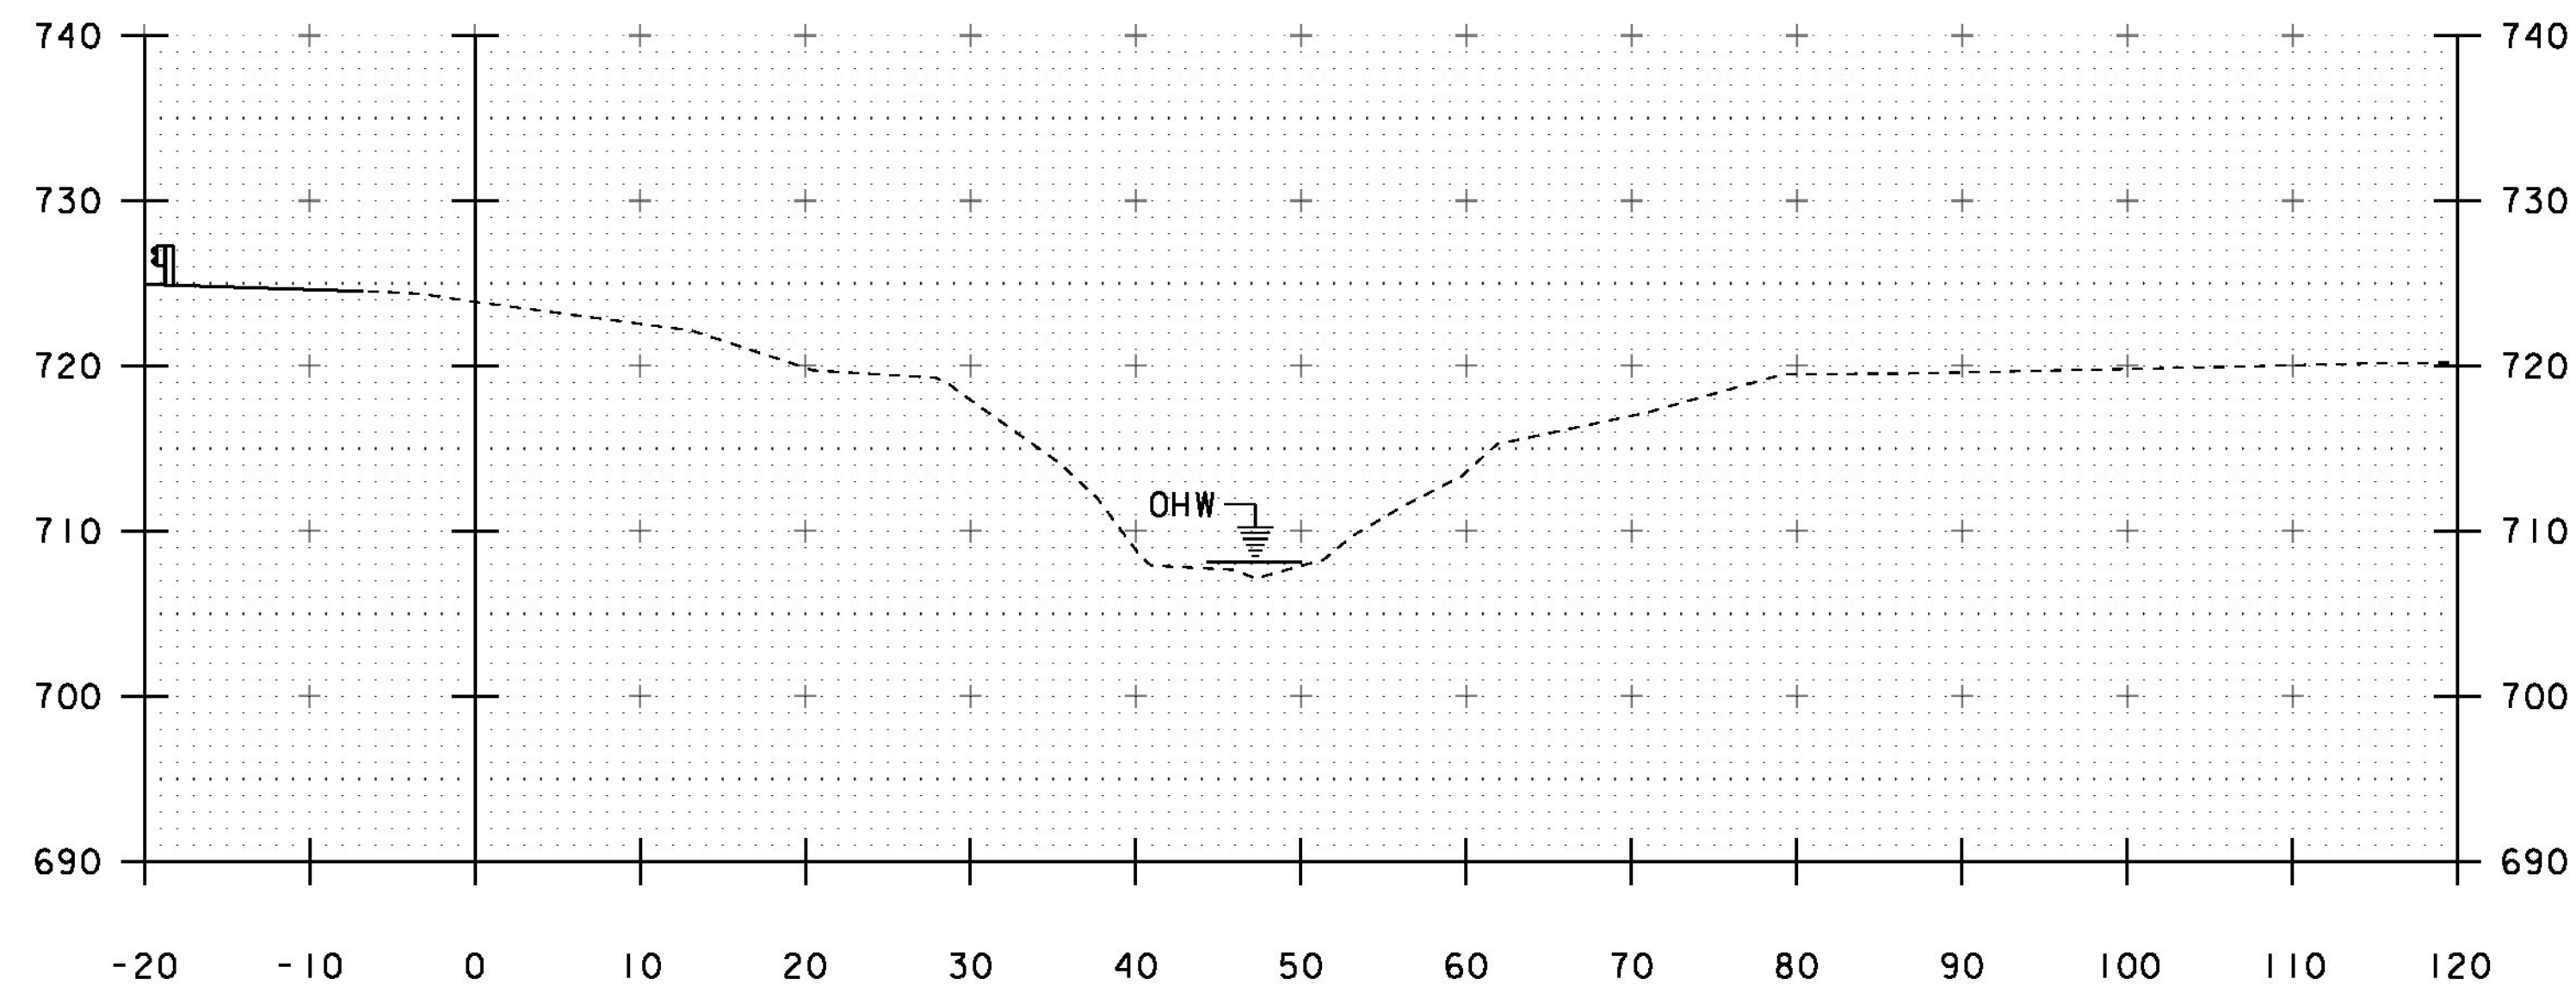

101+75

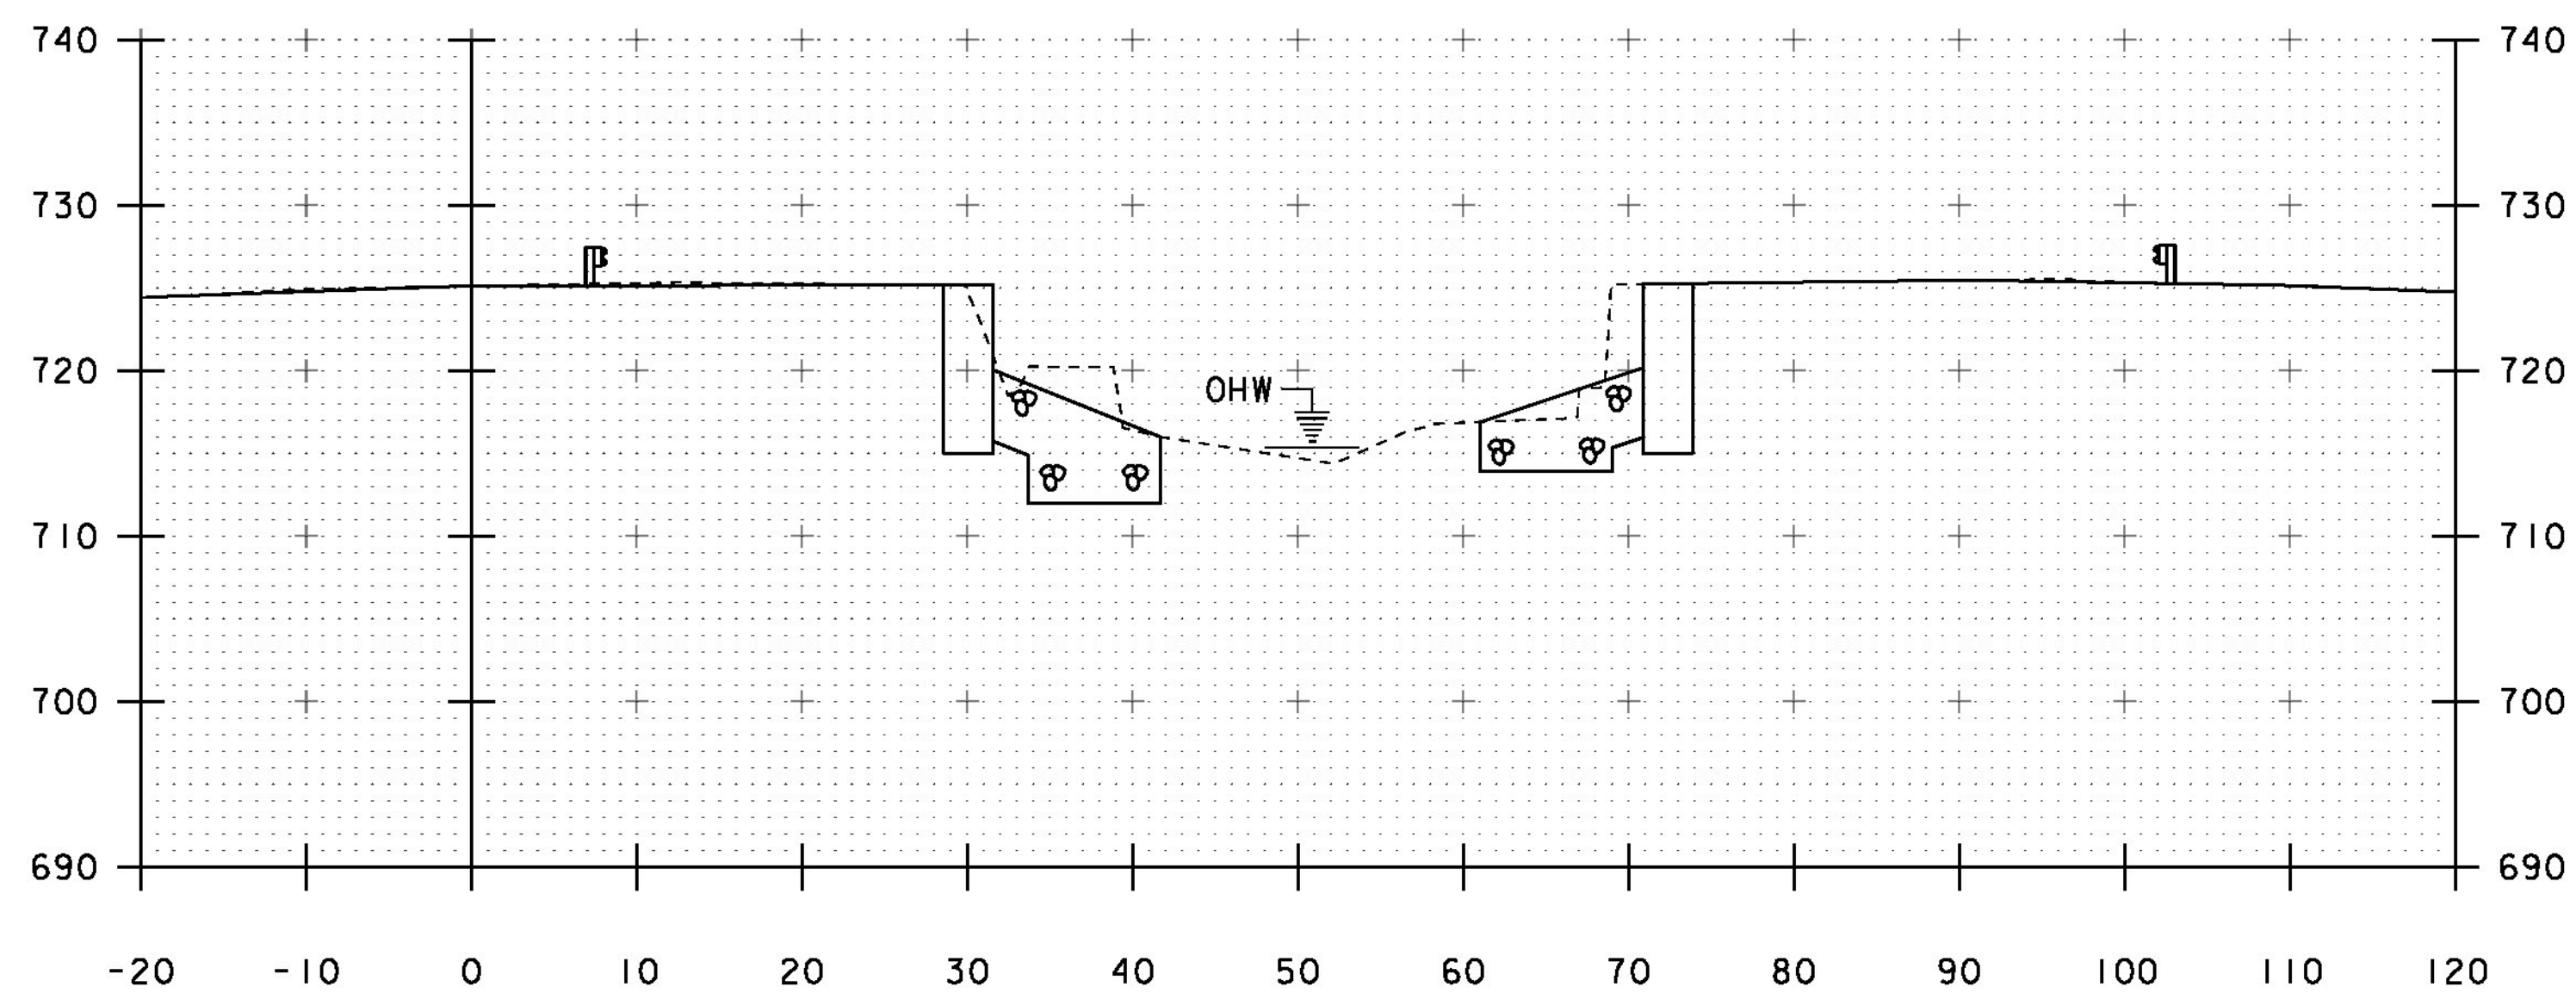

101+30

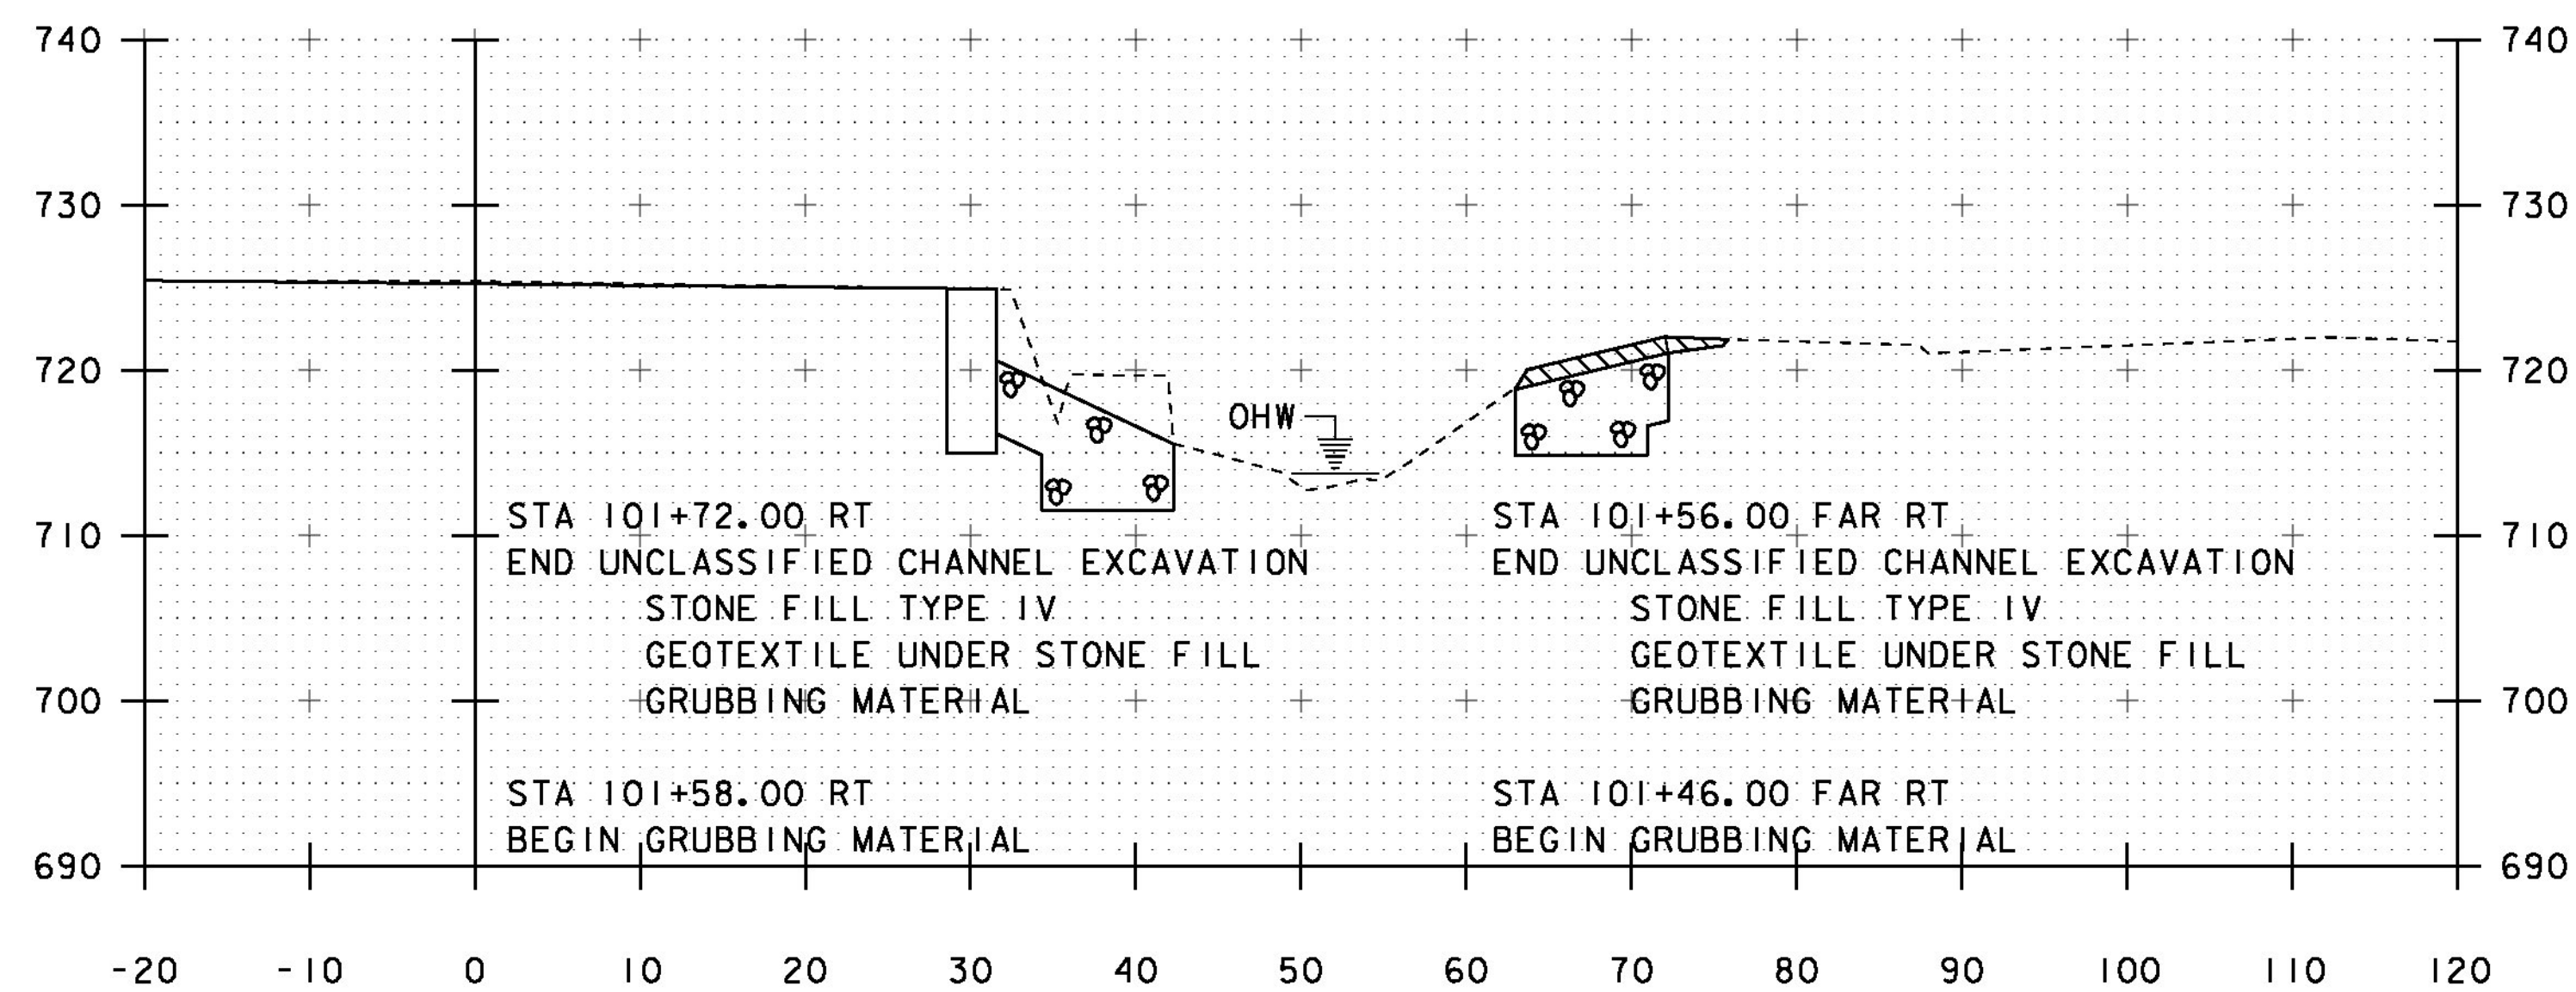

101+50

STA 101+72.00 RT
 END UNCLASSIFIED CHANNEL EXCAVATION
 STONE FILL TYPE IV
 GEOTEXTILE UNDER STONE FILL
 GRUBBING MATERIAL

STA 101+56.00 FAR RT
 END UNCLASSIFIED CHANNEL EXCAVATION
 STONE FILL TYPE IV
 GEOTEXTILE UNDER STONE FILL
 GRUBBING MATERIAL

STA 101+58.00 RT
 BEGIN GRUBBING MATERIAL

STA 101+46.00 FAR RT
 BEGIN GRUBBING MATERIAL

STA. 101+30 TO STA. 101+75

PROJECT NAME: MIDDLESEX
 PROJECT NUMBER: BRP 024-1(37)

FILE NAME: sl0c220xs.dgn
 PROJECT LEADER: C. CARLSON
 DESIGNED BY: H. SALLS
 CHANNEL CROSS SECTIONS 3

PLOT DATE: 13-JAN-2015
 DRAWN BY: R. PELLETT
 CHECKED BY: H. SALLS
 SHEET 39 OF 46

EPSC PLAN NARRATIVE

1.1 PROJECT DESCRIPTION

THIS PROJECT INVOLVES THE REMOVAL OF EXISTING BRIDGE 77, WHICH WILL BE REPLACED WITH A CONCRETE DECK & STEEL BEAM SUPERSTRUCTURE SPANNING 46.78 FEET OVER UNNAMED BROOK, ON NEW ABUTMENTS ALONG THE SAME ALIGNMENT, INCLUDING RELATED APPROACH AND CHANNEL WORK. BRIDGE 77 IS LOCATED IN THE TOWN OF MIDDLESEX, ON VT ROUTE 12, APPROXIMATELY AT THE INTERSECTIONS OF VT ROUTE 12 AND TOWN HIGHWAY 18.

NOTE: AREA OF DISTURBANCE INCLUDES LIMITS OF EARTH DISTURBANCE WITHIN THE PROJECT AREA, AS WELL AS WASTE, BORROW AND STAGING AREAS, AND OTHER EARTH DISTURBING ACTIVITIES WITHIN OR DIRECTLY ADJACENT TO THE PROJECT LIMITS AS SHOWN ON THE ATTACHED EPSC PLAN.

TOTAL AREA OF DISTURBANCE AS SHOWN ON THE ATTACHED EPSC PLAN IS APPROXIMATELY 0.63 ACRES.

IT IS ANTICIPATED THAT THIS PROJECT WILL LAST ONE CONSTRUCTION SEASON.

1.2 SITE INVENTORY

1.2.1 TOPOGRAPHY

THE TOPOGRAPHY OF THE AREA IS A SADDLE THAT IS MOSTLY WELL ESTABLISHED FOREST. VT ROUTE 12, AN UNNAMED BROOK, AND ROAD (TH 18) ARE WITHIN THE PROJECT SITE.

1.2.2 DRAINAGE, WATERWAYS, BODIES OF WATER, AND PROXIMITY TO NATURAL OR MAN-MADE WATER FEATURES

THE BROOK IS THE ONLY WATER SOURCE ON THE PROJECT SITE. THE BROOK IS CLASSIFIED AS STEEP, ALLUVIAL WITH COARSE GRAVEL, COBBLES AND BOULDERS. THE TRIBUTARY AREA AT THE BRIDGE IS 1.0 MILE². DUE TO THE NATURE OF THE SURROUNDING TERRAIN THE PROJECT SITE COULD RECEIVE RUNOFF WATER FROM A FEW NEARBY SLOPES.

1.2.3 VEGETATION

THE VEGETATION IN THE PROJECT AREA CONSISTS OF HARDWOOD TREES AND UNDERGROWTH. THE IMPACT TO VEGETATION WILL BE LIMITED TO THAT WHICH IS DIRECTLY AFFECTED BY REPLACEMENT OF THE EXISTING BRIDGE. UPON PROJECT COMPLETION, THE CHANNEL WILL BE ARMORED WITH STONE FILL TYPE IV AS SPECIFIED ON THE PLANS. DISTURBED VEGETATION WILL BE REESTABLISHED WITH STANDARD SEED AND MULCH PRACTICES.

1.2.4 SOILS

ALL SOIL DATA CAME FROM THE U.S. DEPARTMENT OF AGRICULTURE SOIL CONSERVATION SERVICE FOR THE COUNTY OF WINDSOR, VERMONT. SOILS ON THE PROJECT SITE ARE BUXON SILT LOAM, 25% TO 45% SLOPES, "K FACTOR" = 0.32 AND COLONEL FINE SANDY LOAM, 8% TO 15% SLOPES, "K FACTOR" = 0.20. THE SOILS ARE CONSIDERED MODERATELY ERODIBLE DUE TO SIGNIFICANT SLOPES.

NOTE: K-VALUES GENERALLY INDICATE THE FOLLOWING:

0.0-0.23 = LOW EROSION POTENTIAL
0.24-0.36 = MODERATE EROSION POTENTIAL
0.37 AND HIGHER = HIGH EROSION POTENTIAL

1.2.5 SENSITIVE RESOURCE AREAS

CRITICAL HABITATS: NO
HISTORICAL OR ARCHEOLOGICAL AREAS: NO
PRIME AGRICULTURAL LAND: NO
THREATENED AND ENDANGERED SPECIES: NO
WATER RESOURCE: BROOK
WETLANDS: NO

1.3 RISK EVALUATION

THIS PROJECT DOES NOT FALL UNDER THE JURISDICTION OF GENERAL PERMIT 3-9020 FOR STORMWATER RUNOFF FROM CONSTRUCTION SITES. SHOULD CHANGES PRIOR TO OR DURING CONSTRUCTION RESULT IN ONE OR MORE ACRES OF EARTH DISTURBANCE OR SHOULD THE PROJECT BECOME PART OF A LARGER PLAN OF DEVELOPMENT, THE CONTRACTOR WILL BE RESPONSIBLE FOR ANY ADDITIONAL PERMITTING.

1.4 EROSION PREVENTION AND SEDIMENT CONTROL

THE EROSION CONTROL PLANS ARE MEANT AS A GUIDELINE FOR PREVENTING EROSION AND CONTROLLING SEDIMENT TRANSPORT. THE PRINCIPLES OUTLINED IN THIS NARRATIVE CONSIST OF APPLYING MEASURES THROUGHOUT CONSTRUCTION OF THE PROJECT IN ORDER TO MINIMIZE SEDIMENT TRANSPORT TO THE RECEIVING WATERS. THE MEASURES INCLUDE STABILIZATION AND STRUCTURAL PRACTICES, STORM WATER CONTROLS AND OTHER POLLUTION PREVENTION PRACTICES. THEY HAVE BEEN PROPOSED BY THE DESIGNER AS A BASIS FOR PROTECTING RESOURCES AND WILL NEED TO BE BUILT UPON BASED ON THE SPECIFIC MEANS AND METHODS OF THE CONTRACTOR. REFER TO THE LOW RISK SITE HANDBOOK AND APPROPRIATE DETAIL SHEETS FOR SPECIFIC GUIDANCE AND CONSTRUCTION DETAILING.

ALL MEASURES SHALL BE REGULARLY MAINTAINED AND SHALL BE CHECKED FOR SEDIMENT BUILD-UP. SEDIMENT SHALL BE DISPOSED OF AT AN APPROVED SITE WHERE IT WILL NOT BE SUBJECT TO EROSION.

1.4.1 MARK SITE BOUNDARIES

SITE BOUNDARIES AND AREAS CONSTRUCTION EQUIPMENT CAN ACCESS SHALL BE DELINEATED.

PROJECT DEMARCATION FENCING (PDF) SHALL BE USED TO PHYSICALLY MARK SITE BOUNDARIES.

1.4.2 LIMIT DISTURBANCE AREA

PREVENTING INITIAL SOIL EROSION BY MINIMIZING THE EXPOSED AREA IS MUCH MORE EFFECTIVE THAN TREATING ERODED SEDIMENT. EARTH DISTURBANCE CAN BE MINIMIZED THROUGH CONSTRUCTION PHASING BY ONLY OPENING UP EARTH AS NECESSARY. THIS CAN LIMIT THE AREA THAT WILL BE DISTURBED AND EXPOSED TO EROSION. EMPLOY TEMPORARY CONSTRUCTION STABILIZATION PRACTICES IN INCREMENTAL STAGES AS PHASES CHANGE. FOR PROJECTS WHICH FALL UNDER THE CONSTRUCTION GENERAL PERMIT, ONLY THE ACREAGE LISTED ON THE PERMIT AUTHORIZATION MAY BE EXPOSED AT ANY GIVEN TIME.

MAINTAINING VEGETATED BUFFERS ALONG STREAM BANKS, WETLANDS OR OTHER SENSITIVE AREAS IS A CRUCIAL EROSION AND SEDIMENT CONTROL MEASURE THAT SHOULD BE ESTABLISHED WHEREVER POSSIBLE.

1.4.3 SITE ENTRANCE/EXIT STABILIZATION

TRACKING OF SEDIMENT ONTO PUBLIC HIGHWAYS SHALL BE MINIMIZED TO REDUCE THE POTENTIAL FOR RUNOFF ENTERING RECEIVING WATERS. INSTALLATION SHALL COINCIDE WITH THE CONTRACTOR'S PROGRESS SCHEDULE.

STABILIZED CONSTRUCTION ENTRANCES SHALL BE INSTALLED AS PROPOSED ON THE EPSC PLAN AND ANYWHERE EQUIPMENT WILL BE GOING FROM AREAS OF EXPOSED SOILS TO PAVED SURFACES.

1.4.4 INSTALL SEDIMENT BARRIERS

SEDIMENT BARRIERS SHALL BE UTILIZED TO INTERCEPT RUNOFF AND ALLOW SUSPENDED SEDIMENT TO SETTLE OUT. THEY SHALL BE INSTALLED PRIOR TO ANY UP SLOPE WORK.

SILT FENCE WILL BE INSTALLED AS PROPOSED ON THE EPSC PLAN.

1.4.5 DIVERT UPLAND RUNOFF

DIVERSIONARY MEASURES SHALL BE USED TO INTERCEPT RUNOFF FROM ABOVE THE CONSTRUCTION AND DIRECT IT AROUND THE DISTURBED AREA SO THAT CLEAN WATER DOES NOT BECOME MUDDIED WHILE TRAVELING OVER EXPOSED SOILS ON THE CONSTRUCTION SITE.

THE PROJECT AREA IS RELATIVELY FLAT. THEREFORE IT IS NOT ANTICIPATED THAT DIVERSION MEASURES WILL BE NECESSARY.

(NOT ANTICIPATED FOR THIS PROJECT)

1.4.6 SLOW DOWN CHANNELIZED RUNOFF

CHECK STRUCTURES SHALL BE UTILIZED TO REDUCE THE VELOCITY, AND THUS THE EROSION POTENTIAL, OF CONCENTRATED FLOW IN CHANNELS.

(NOT ANTICIPATED FOR THIS PROJECT)

1.4.7 CONSTRUCT PERMANENT CONTROLS

PERMANENT STORMWATER TREATMENT DEVICES SHALL BE INSTALLED AS SHOWN ON THE PLANS AND IN ACCORDANCE WITH PERMIT CONDITIONS.

1.4.8 STABILIZE EXPOSED SOILS DURING CONSTRUCTION

ALL AREAS OF DISTURBANCE MUST HAVE TEMPORARY STABILIZATION IN PLACE WITHIN 48 HOURS OF DISTURBANCE OR IN ACCORDANCE WITH THE CONSTRUCTION GENERAL PERMIT 3-9020 AUTHORIZATION.

SURFACE ROUGHENING OF ALL EXPOSED SLOPES, COMBINED WITH TEMPORARY MULCHING, SHALL BE UTILIZED ON A REGULAR BASIS. BIODEGRADABLE EROSION CONTROL MATTING OR AN EQUIVALENT SHALL BE USED TO STABILIZE ALL SLOPES STEEPER THAN 1:3.

THE FORECAST OF RAINFALL EVENTS SHALL TRIGGER IMMEDIATE PROTECTION OF EXPOSED SOILS.

1.4.9 WINTER STABILIZATION

VARIOUS MEASURES SPECIFIC TO WINTER MAY BE NECESSARY SHOULD THE PROJECT EXTEND INTO WINTER (OCTOBER 15 THROUGH APRIL 15). REFER TO THE LOW RISK SITE HANDBOOK FOR GUIDANCE.

1.4.10 STABILIZE SOIL AT FINAL GRADE

EXPOSED SOIL MUST BE STABILIZED WITHIN 48 HOURS OF REACHING FINAL GRADE.

SEED, MULCH, FERTILIZER AND LIME SHALL BE USED TO ESTABLISH PERMANENT VEGETATION. FOR SLOPES STEEPER THAN 1:3, BIODEGRADABLE EROSION CONTROL MATTING OR AN EQUIVALENT SHALL BE USED INSTEAD OF MULCH.

1.4.11 DE-WATERING ACTIVITIES

DISCHARGE FROM DEWATERING ACTIVITIES THAT FLOWS OFF OF THE CONSTRUCTION SITE MUST NOT CAUSE OR CONTRIBUTE TO A VIOLATION OF THE VERMONT WATER QUALITY STANDARDS.

(NOT ANTICIPATED FOR THIS PROJECT)

1.4.12 INSPECT YOUR SITE

INSPECT THE PROJECT SITE BASED ON SPECIAL PROVISION REQUIREMENTS OR CONSTRUCTION GENERAL PERMIT AUTHORIZATION STIPULATIONS.

1.5 SEQUENCE AND STAGING

THIS SECTION WILL BE DEVELOPED BY THE CONTRACTOR USING THE GUIDANCE OUTLINED IN THE VTRANS EPSC PLAN CONTRACTOR CHECKLIST.


1.5.2 OFF-SITE ACTIVITIES

IN ADDITION TO THE CONTRACTOR CHECKLIST ANY ACTIVITIES OUTSIDE THE CONSTRUCTION LIMITS SHALL FOLLOW SUBSECTIONS 105.25- 105.29 OF THE STANDARD SPECIFICATIONS FOR CONSTRUCTION.

PROJECT NAME: MIDDLESEX
PROJECT NUMBER: BRF 024-1(37)

FILE NAME: sl0c220erodtlis.dgn
PROJECT LEADER: C. CARLSON
DESIGNED BY: H. SALLS
EPSC NARRATIVE

PLOT DATE: 13-JAN-2015
DRAWN BY: R. PELLET
CHECKED BY: H. SALLS
SHEET 40 OF 46

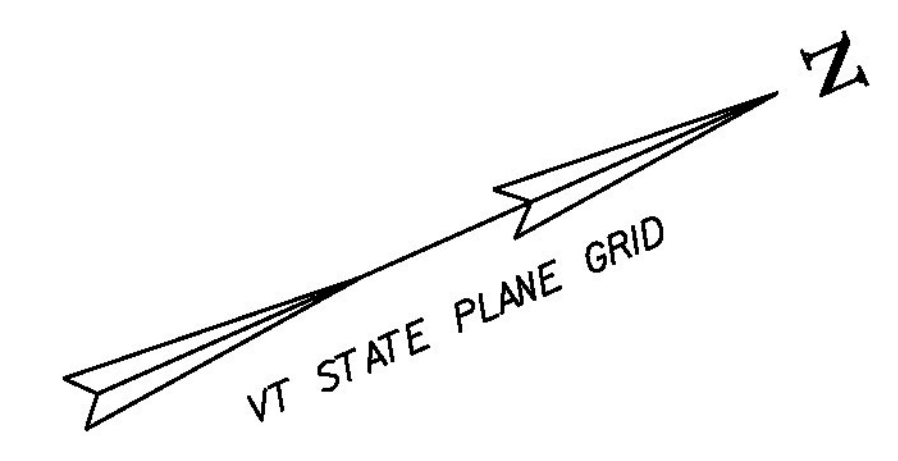

39C - COLTON GRAVELLY SAND
WITH 8% TO 15% SLOPES
"K FACTOR" = 0.17

19C - COLONEL FINE SANDY LOAM
WITH 8% TO 15% SLOPES
"K FACTOR" = 0.20

41E - BUXON SILT LOAM
WITH 25% TO 45% SLOPES
"K FACTOR" = 0.32

BEGIN APPROACH
STA 26+75.00


BEGIN PROJECT
STA 27+75.00

BEGIN BRIDGE
STA 28+97.11

END BRIDGE
STA 29+43.89



END PROJECT
STA 30+75.00

END APPROACH
STA 31+75.00

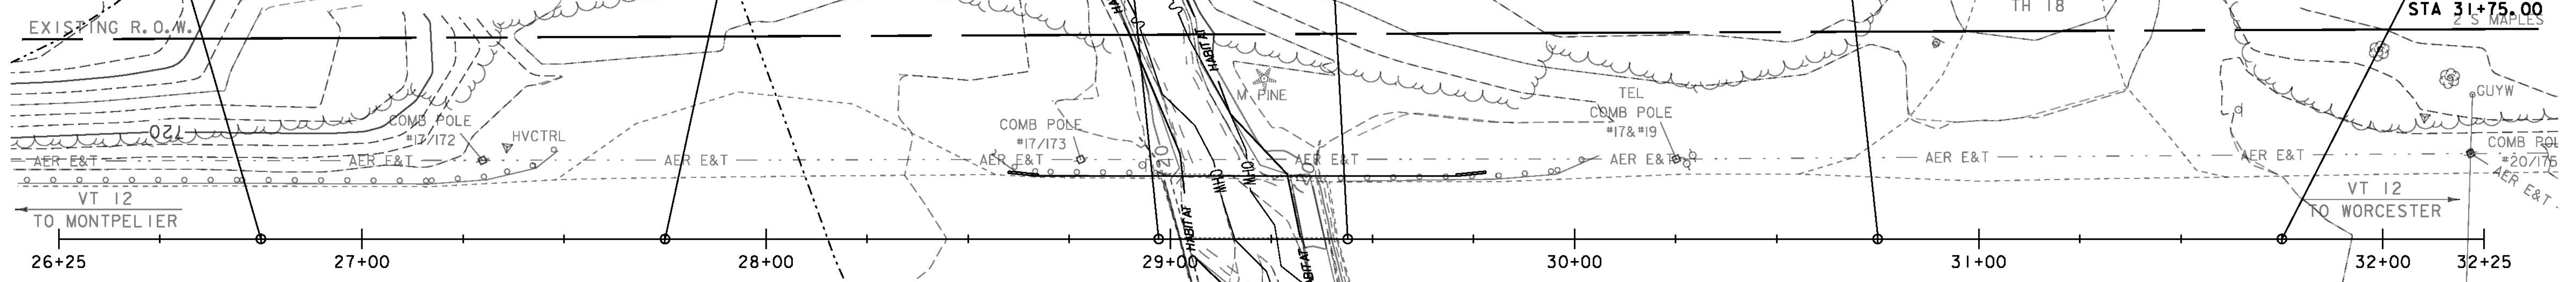

SCALE 1" = 20'-0"
20 0 20


PROJECT NAME: MIDDLESEX	PLOT DATE: 13-JAN-2015
PROJECT NUMBER: BRF 024-K(37)	DRAWN BY: R. PELLETT
FILE NAME: s10c220bdrero.dgn	CHECKED BY: H. SALLS
PROJECT LEADER: C. CARLSON	SHEET 41 OF 46
DESIGNED BY: H. SALLS	
EPSC EXISTING LAYOUT	

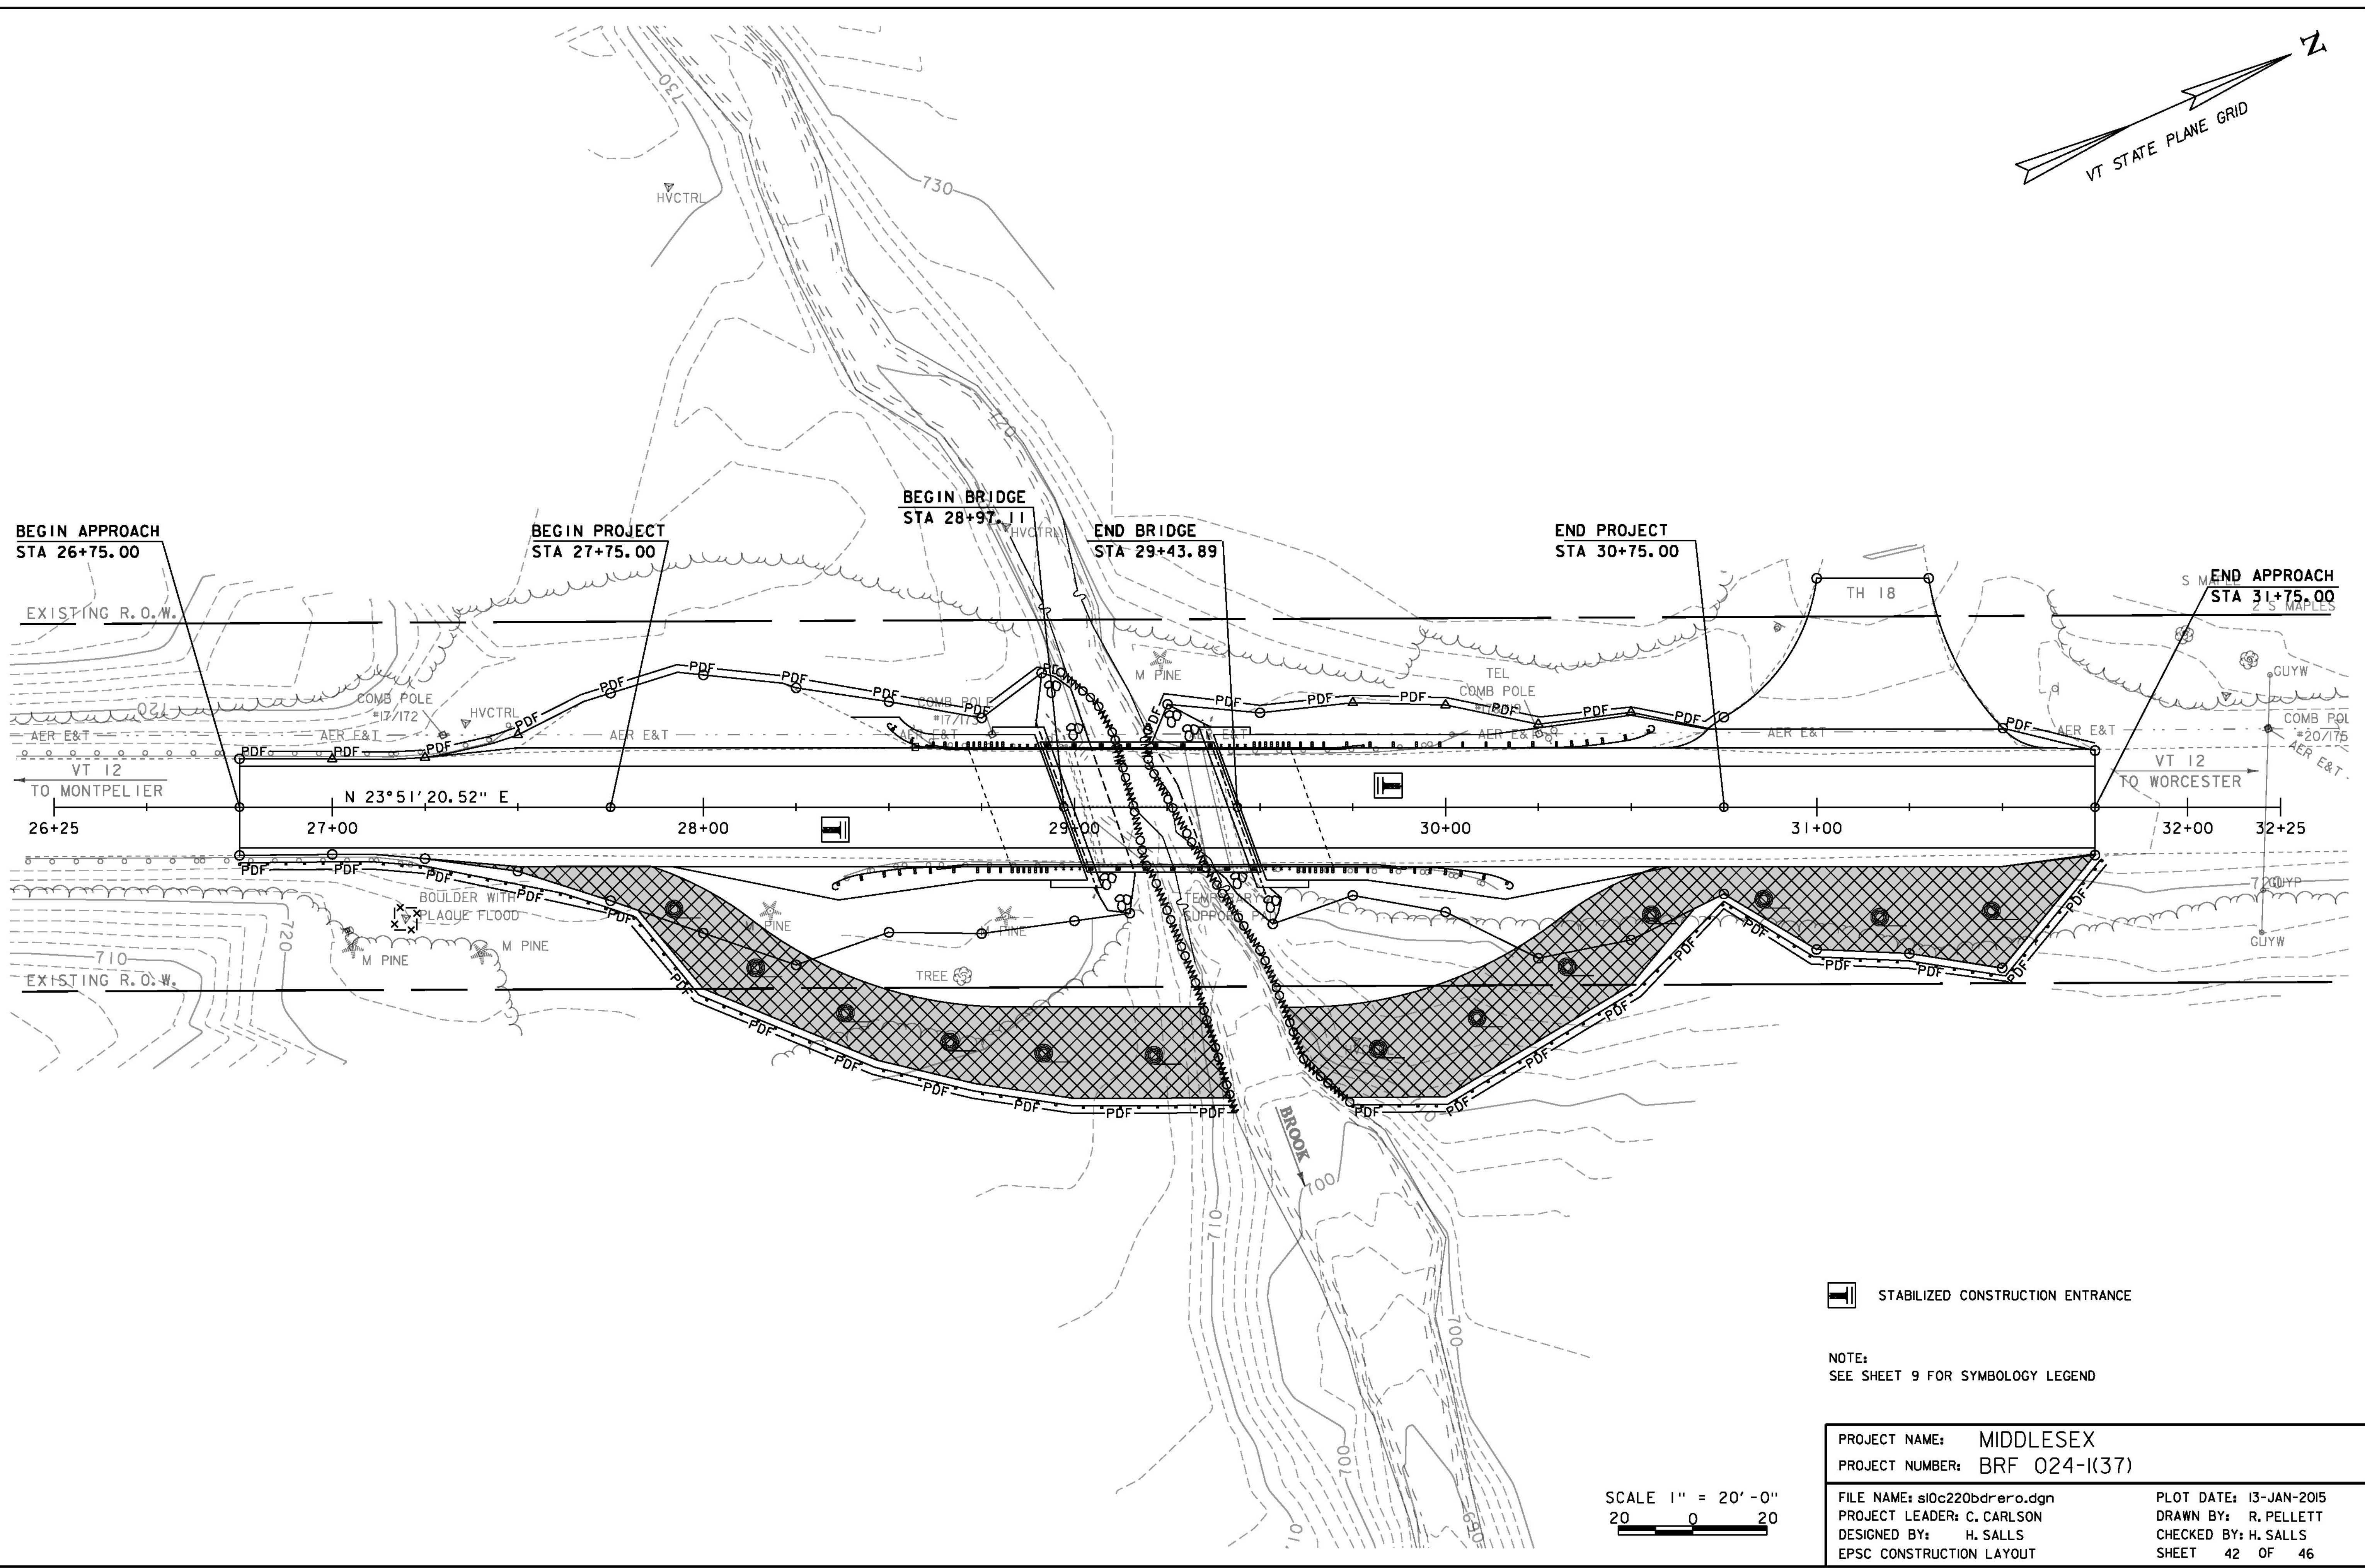
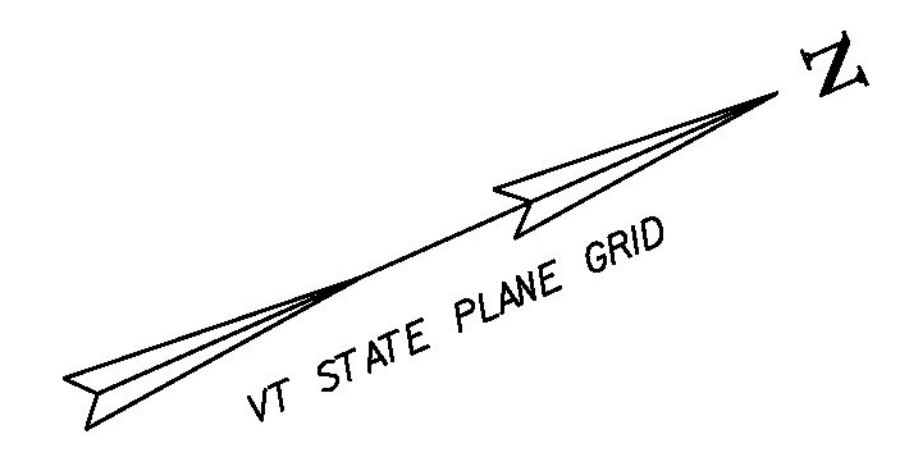


 STABILIZED CONSTRUCTION ENTRANCE

NOTE:
SEE SHEET 9 FOR SYMBOLOGY LEGEND

PROJECT NAME: MIDDLESEX	PLOT DATE: 13-JAN-2015
PROJECT NUMBER: BRF 024-K(37)	DRAWN BY: R. PELLETT
FILE NAME: s10c220bdrero.dgn	CHECKED BY: H. SALLS
PROJECT LEADER: C. CARLSON	SHEET 42 OF 46
DESIGNED BY: H. SALLS	
EPSC CONSTRUCTION LAYOUT	


SCALE 1" = 20'-0"

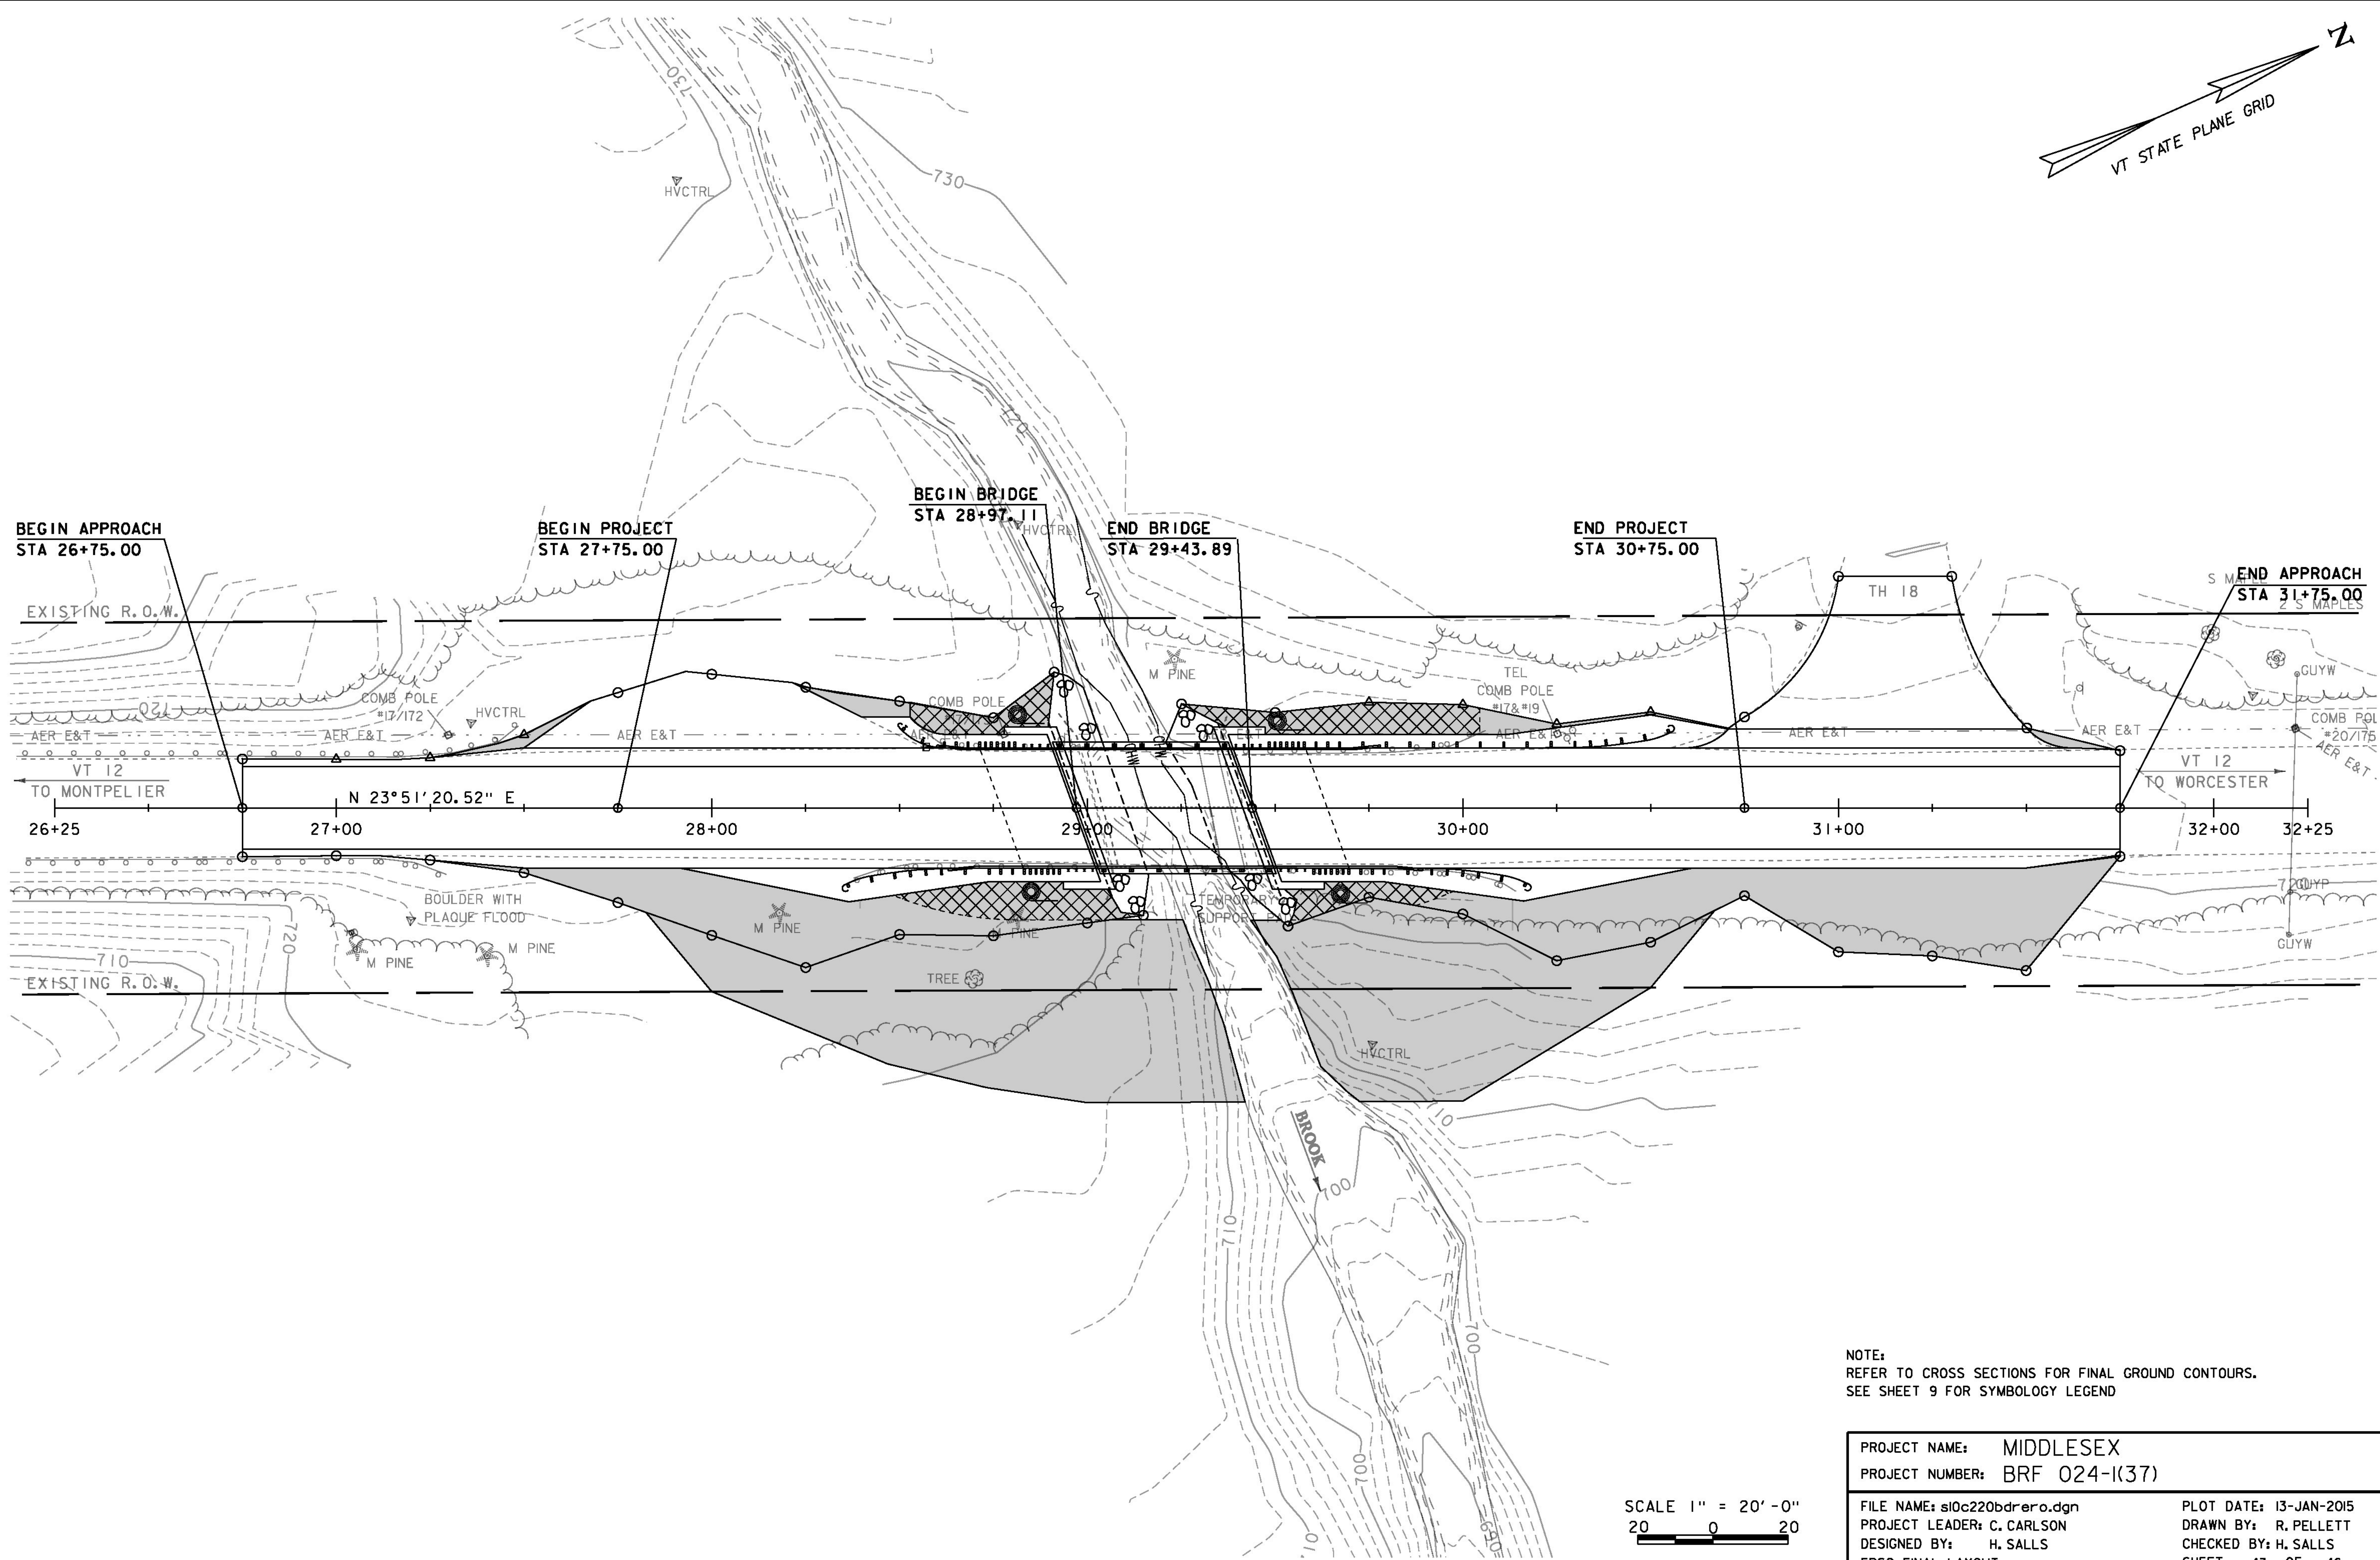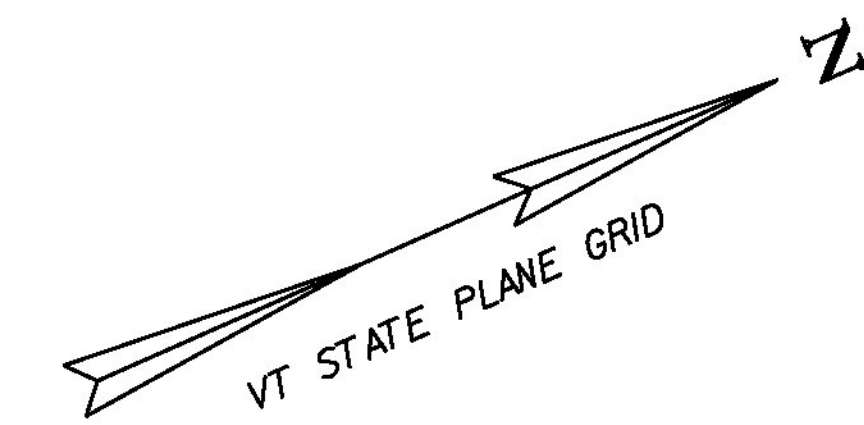


NOTE:
REFER TO CROSS SECTIONS FOR FINAL GROUND CONTOURS.
SEE SHEET 9 FOR SYMBOLOGY LEGEND

PROJECT NAME:	MIDDLESEX	FILE NAME:	sl0c220bdrero.dgn	PLOT DATE:	13-JAN-2015
PROJECT NUMBER:	BRF 024-K(37)	PROJECT LEADER:	C. CARLSON	DRAWN BY:	R. PELLETT
		DESIGNED BY:	H. SALLS	CHECKED BY:	H. SALLS
		EPSC FINAL LAYOUT		SHEET	43 OF 46

SCALE 1" = 20'-0"
20 0 20

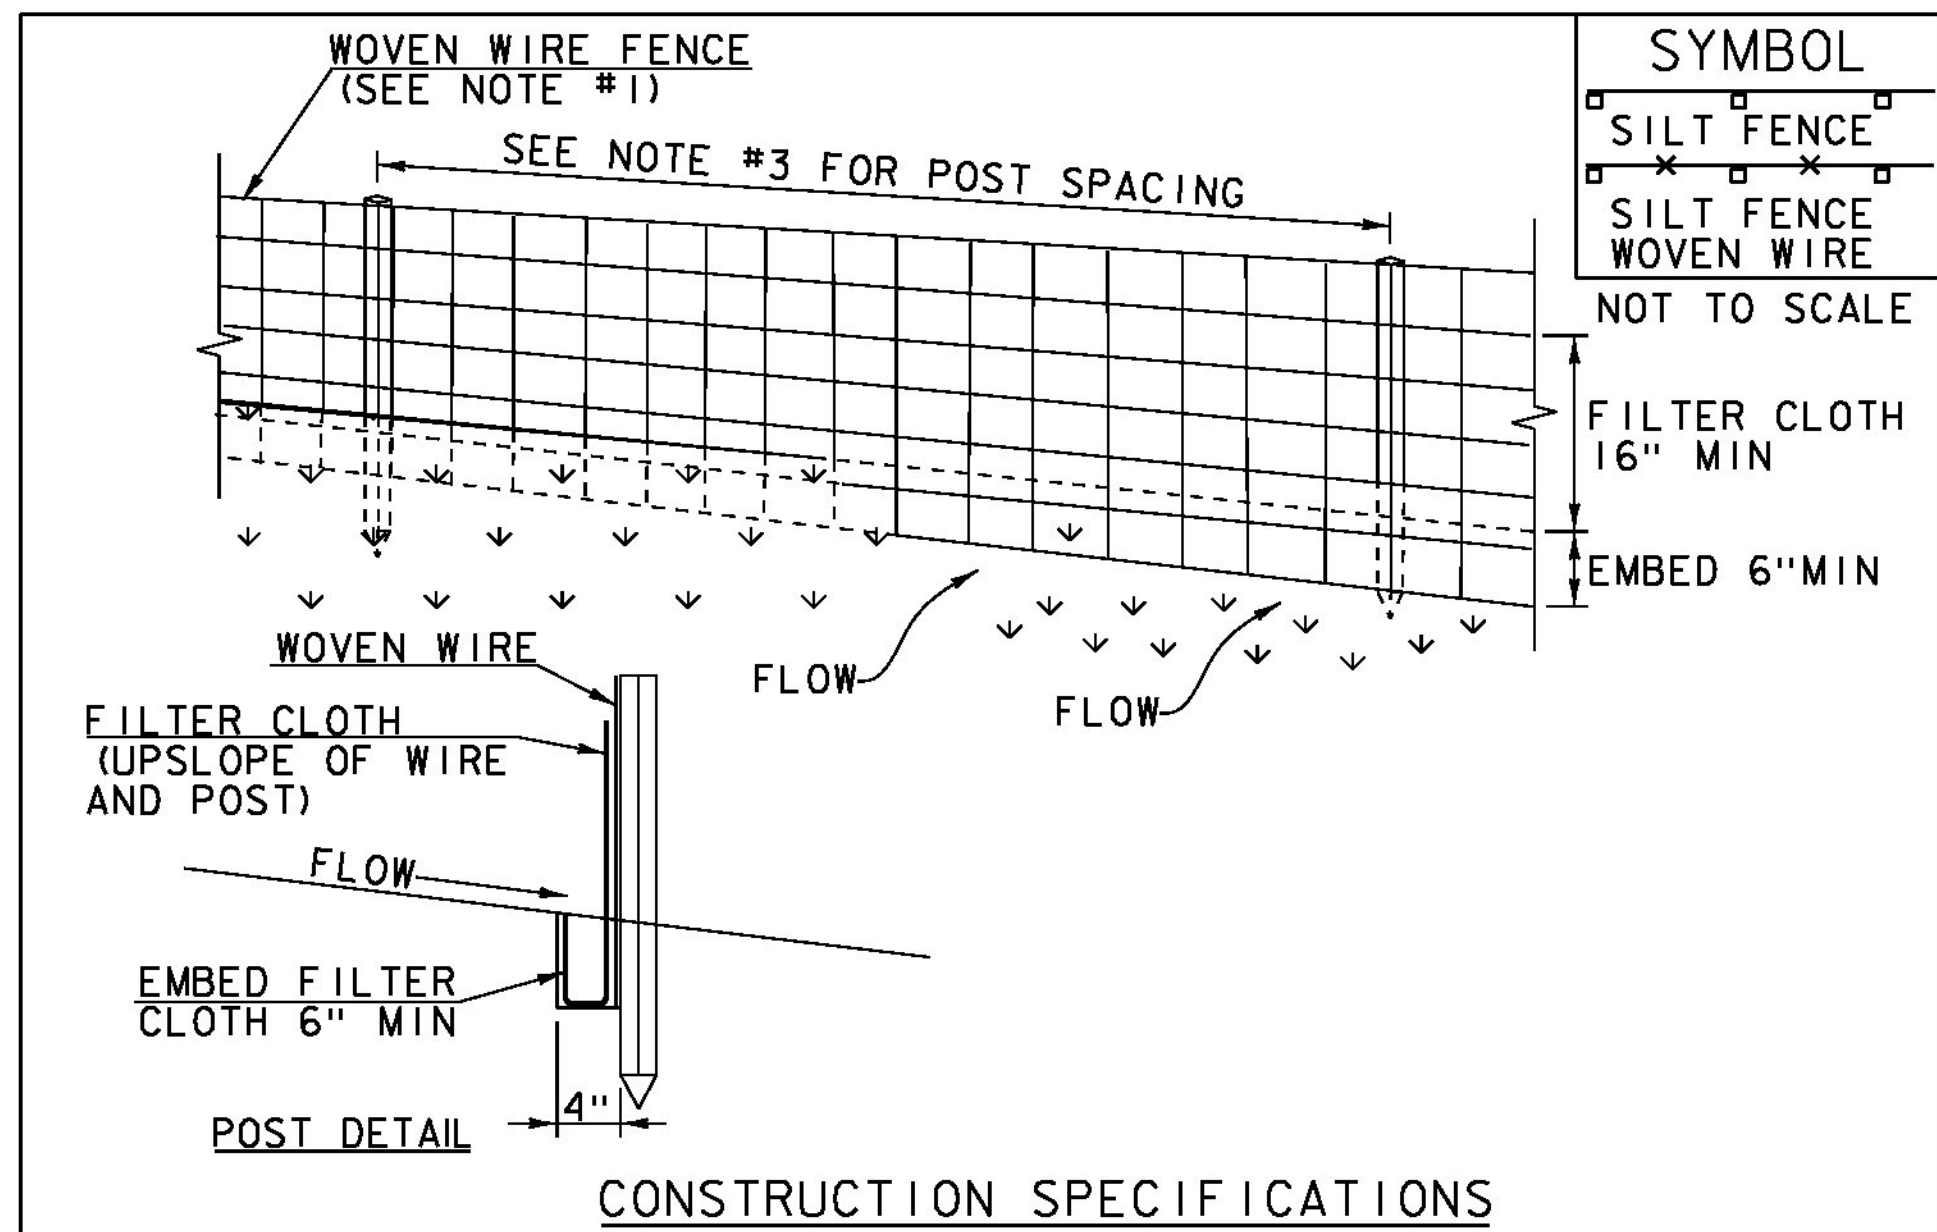

SYMBOL	
	SILT FENCE
	SILT FENCE WOVEN WIRE

- CONSTRUCTION SPECIFICATIONS**
- WOVEN WIRE REINFORCED FENCE IS REQUIRED WITHIN 100' UPSLOPE OF RECEIVING WATERS WHEN THE PROJECT FALLS UNDER A CONSTRUCTION STORMWATER PERMIT. WOVEN WIRE SHALL BE A MIN. 14 GAUGE WITH A 6" MAX. MESH OPENING.
 - FILTER CLOTH SHALL BE EITHER FILTER X, MIRAF1100X, STABILINKA T140N OR APPROVED EQUIVALENT.
 - POST SPACING FOR WIRE-BACKED FENCE SHALL BE 10' MAXIMUM. FOR FILTER-CLOTH FENCE, WHEN ELONGATION IS >50%, POST SPACING SHALL NOT EXCEED 4' AND WHEN ELONGATION IS <50%, POST SPACING SHALL NOT EXCEED 6'.
 - WOVEN WIRE FENCE IS TO BE FASTENED SECURELY TO FENCE POSTS WITH WIRE TIES. FILTER CLOTH IS TO BE FASTENED SECURELY TO WOVEN WIRE FENCE WITH TIES SPACED EVERY 24" AT TOP AND MID SECTION.
 - WHEN TWO SECTIONS OF FILTER CLOTH ADJOIN EACH OTHER THEY SHALL BE OVER-LAPPED BY 6" AND FOLDED.
 - MAINTENANCE SHALL BE PERFORMED AS NEEDED AND MATERIAL REMOVED WHEN SEDIMENT REACHES HALF OF FABRIC HEIGHT.


ADAPTED FROM DETAILS PROVIDED BY: NEW YORK STATE DEC
ORIGINALLY DEVELOPED BY USDA-NRCS
VERMONT DEPARTMENT OF ENVIRONMENTAL CONSERVATION

SILT FENCE

NOTES:
REFER TO "THE VERMONT STANDARDS & SPECIFICATIONS FOR EROSION PREVENTION & SEDIMENT CONTROL -2006- "FROM THE VT AGENCY OF NATURAL RESOURCES FOR ADDITIONAL GUIDANCE.

REVISIONS	
MARCH 21, 2008	WHF
DECEMBER 11, 2008	WHF
JANUARY 13, 2009	WHF

THIS WORK SHALL BE PERFORMED IN ACCORDANCE WITH SECTION 649 AND AS SHOWN IN THE PLANS FOR GEOTEXTILE FOR SILT FENCE (PAY ITEM 649.5) OR GEOTEXTILE FOR SILT FENCE, WOVEN WIRE REINFORCED (PAY ITEM 649.51).

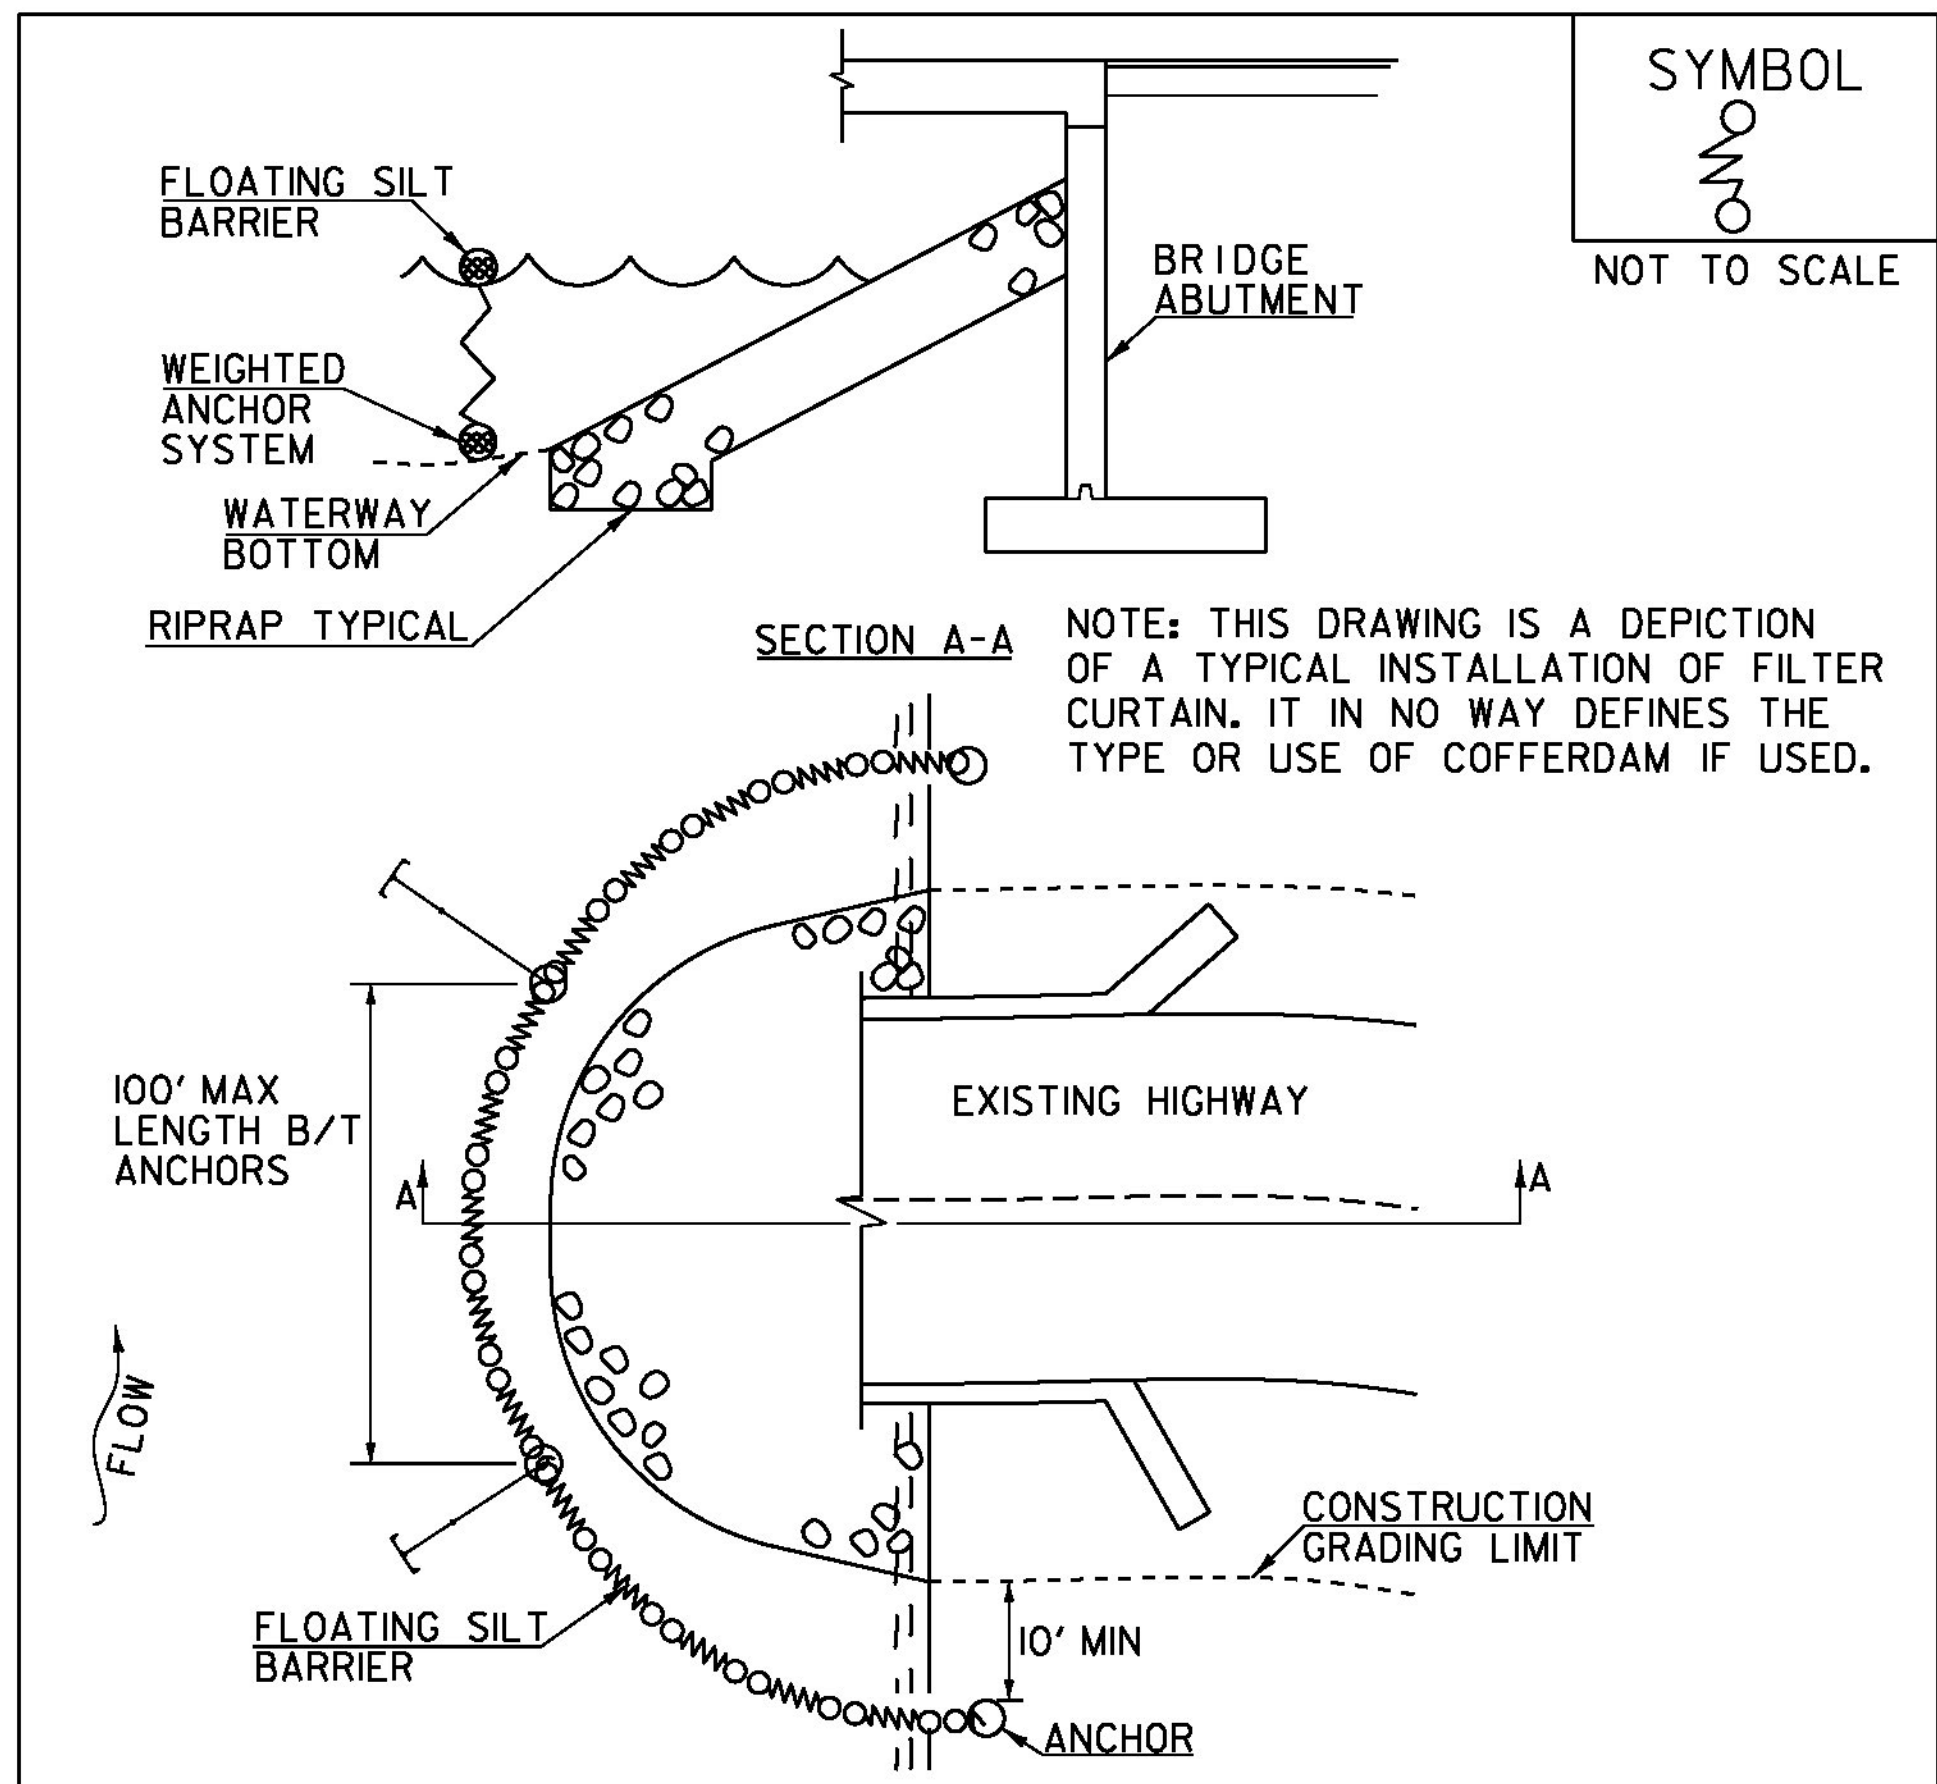

SYMBOL	
	FILTER CURTAIN

- CONSTRUCTION SPECIFICATIONS**
- FILTER CURTAIN SHALL NOT BE PLACED ACROSS A FLOWING WATERWAY, OR IN A WATERWAY WITH STREAM VELOCITIES GREATER THAN 1.5 FEET/SECOND.
 - MAXIMUM 100' LENGTH BETWEEN ANCHORS.
 - LAST SECTION SHALL TERMINATE A MINIMUM OF 10' BEYOND LIMIT OF DISTURBANCE.
 - THE WEIGHTED ANCHOR SYSTEM SHALL BE A TYPE WHICH ALLOWS THE CURTAIN TO CONFORM TO THE BOTTOM OF THE WATERWAY.
 - THE CURTAIN SHALL BE REMOVED BY SLOWLY PULLING TOWARD THE SHORE MINIMIZING THE ESCAPE OF SEDIMENTS INTO WATERWAY.


ADAPTED FROM DETAILS PROVIDED BY: NEW YORK STATE DEC
ORIGINALLY DEVELOPED BY USDA-NRCS
VERMONT DEPARTMENT OF ENVIRONMENTAL CONSERVATION

FILTER CURTAIN

NOTES:
REFER TO "THE VERMONT STANDARDS & SPECIFICATIONS FOR EROSION PREVENTION & SEDIMENT CONTROL -2006- "FROM THE VT AGENCY OF NATURAL RESOURCES FOR ADDITIONAL GUIDANCE.

REVISIONS	
APRIL 1, 2008	WHF
JANUARY 13, 2009	WHF
SEPTEMBER 4, 2009	WHF

THIS WORK SHALL BE PERFORMED IN ACCORDANCE WITH SECTION 649 FOR GEOTEXTILE FOR FILTER CURTAIN (PAY ITEM 649.6).

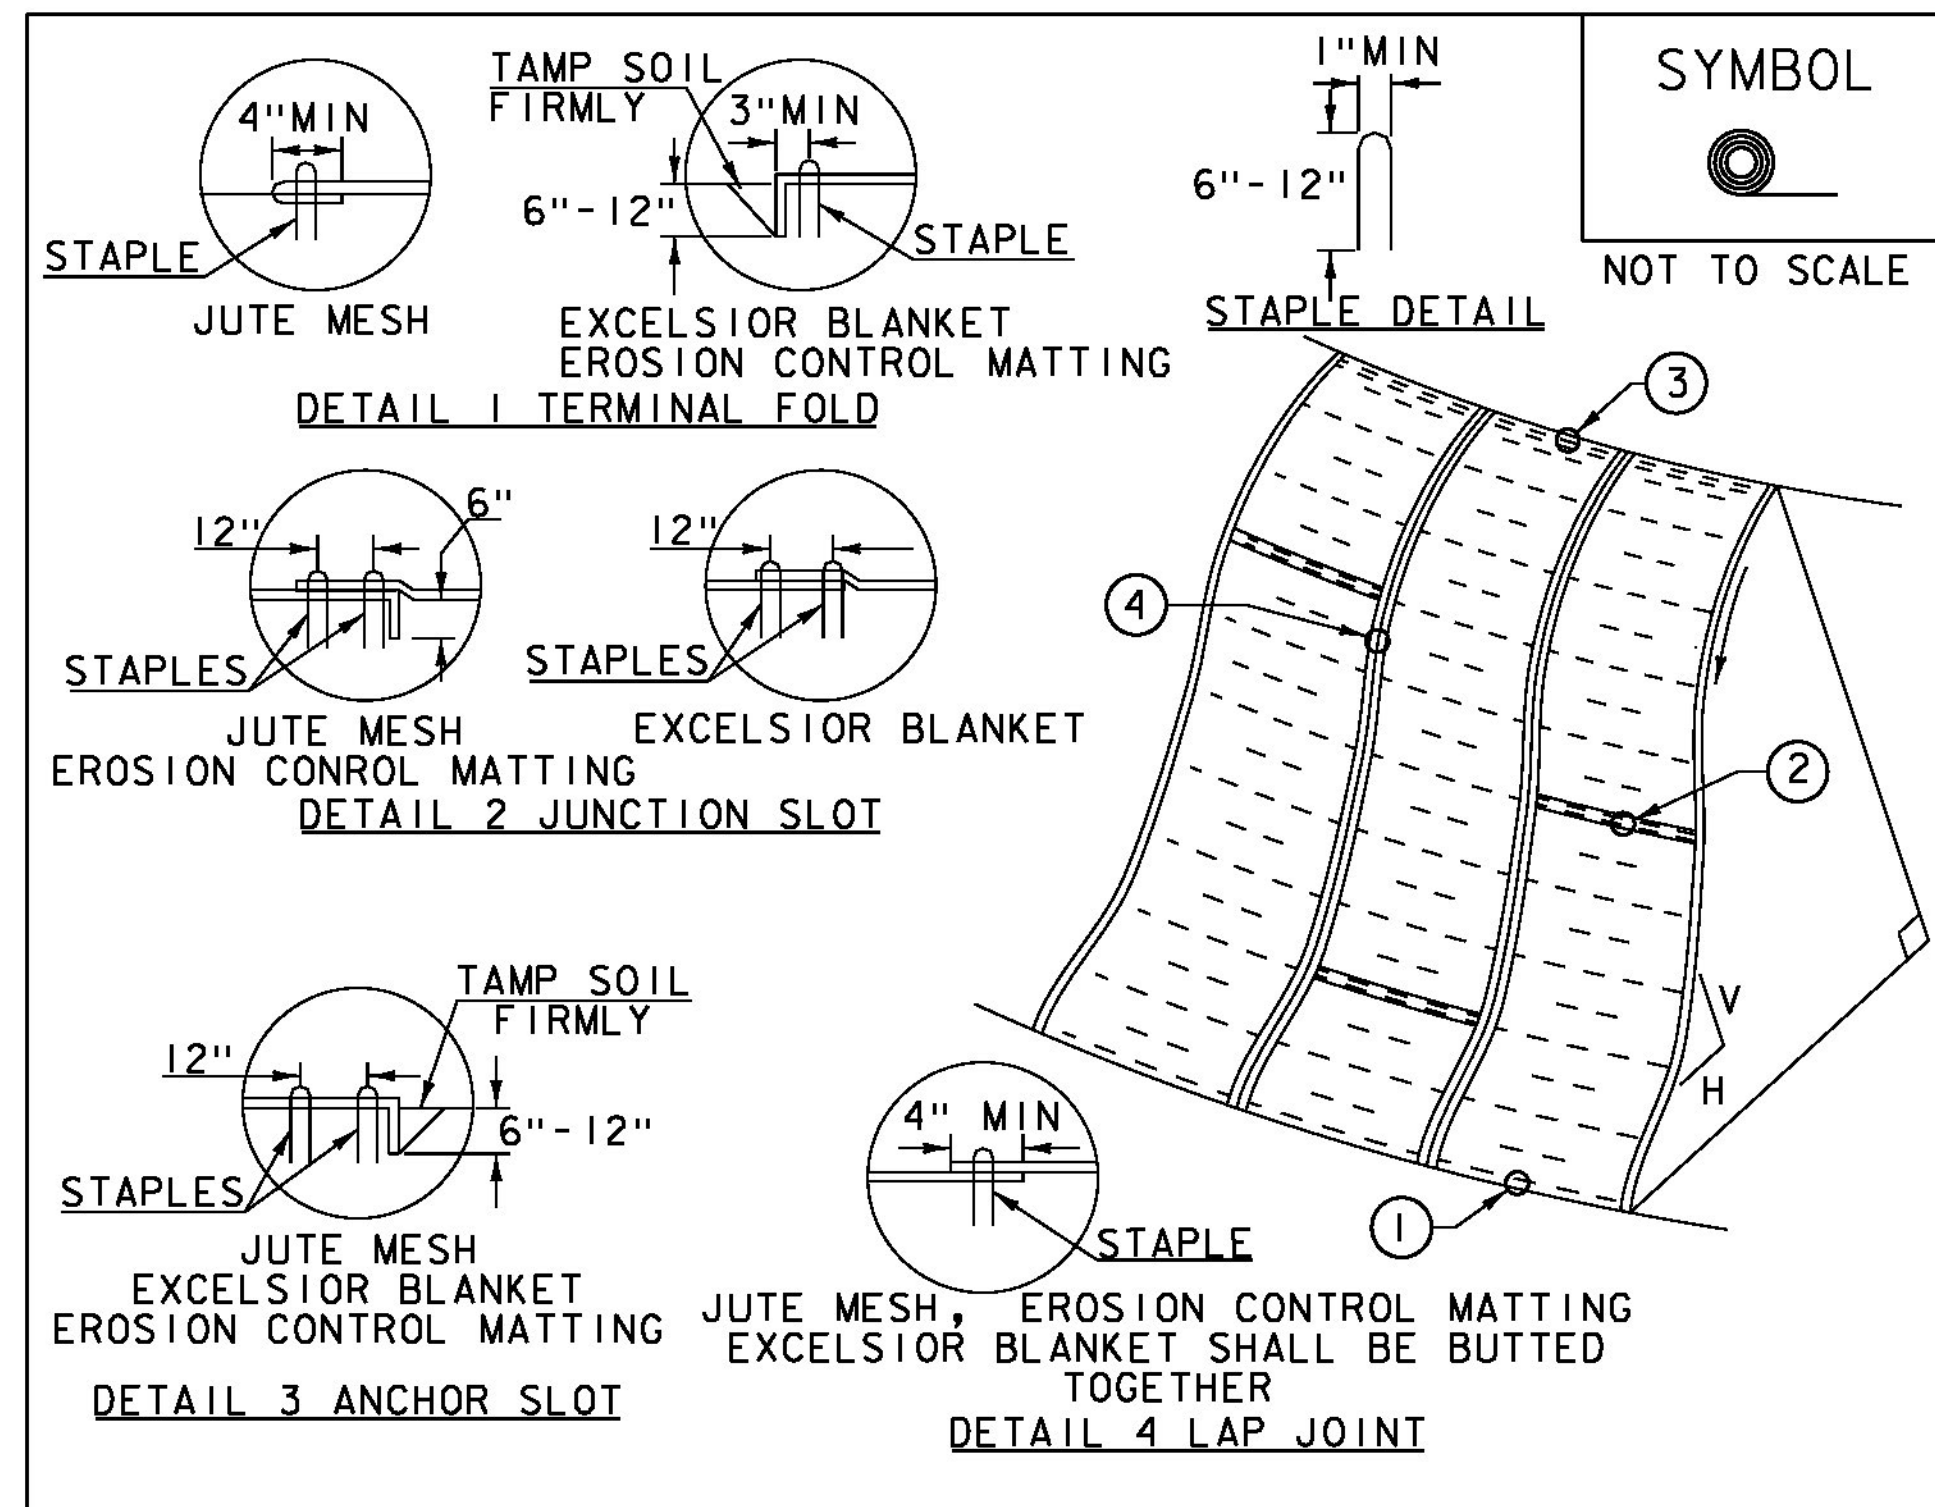

SYMBOL	
	ROLLED EROSION CONTROL PRODUCT

- CONSTRUCTION SPECIFICATIONS**
- APPLY TO SLOPES GREATER THAN 3H:1V OR WHERE NECESSARY TO AID IN ESTABLISHING VEGETATION.
 - APPLY FERTILIZER, LIME SEED PRIOR TO PLACING MATTING.
 - STAPLES ARE TO BE PLACED ALTERNATELY, IN COLUMNS APPROXIMATELY 2' APART AND IN ROWS APPROXIMATELY 3' APART. APPROXIMATELY 175 STAPLES ARE REQUIRED PER 4'X225' ROLL OF MATERIAL AND 125 STAPLES ARE REQUIRED PER 4'X150' ROLL OF MATERIAL.
 - DISTURBED AREAS SHALL BE SMOOTHLY GRADED. EROSION CONTROL MATERIAL SHALL BE PLACED LOOSELY OVER GROUND SURFACE. DO NOT STRETCH.
 - ALL TERMINAL ENDS AND TRANSVERSE LAPS SHALL BE STAPLED AT APPROXIMATELY 12" INTERVALS.


ADAPTED FROM DETAILS PROVIDED BY: NEW YORK STATE DEC
ORIGINALLY DEVELOPED BY USDA-NRCS
VERMONT DEPARTMENT OF ENVIRONMENTAL CONSERVATION

ROLLED EROSION CONTROL PRODUCT (RECP) SIDE SLOPE

NOTES:
REFER TO "THE VERMONT STANDARDS & SPECIFICATIONS FOR EROSION PREVENTION & SEDIMENT CONTROL -2006- "FROM THE VT AGENCY OF NATURAL RESOURCES FOR ADDITIONAL GUIDANCE.
THIS WORK SHALL BE PERFORMED IN ACCORDANCE WITH SECTION 653 AND AS SHOWN IN THE PLANS FOR TEMPORARY EROSION MATTING (PAY ITEM 653.20) OR PERMANENT EROSION MATTING (PAY ITEM 653.21).

REVISIONS	
APRIL 16, 2007	JMF
JANUARY 13, 2009	WHF

PROJECT NAME:	MIDDLESEX
PROJECT NUMBER:	BRF 024-1(37)
FILE NAME:	sl0c220e.odt1s.dgn
PROJECT LEADER:	C. CARLSON
DESIGNED BY:	H. SALLS
EPSC DETAILS (1)	
PLOT DATE:	13-JAN-2015
DRAWN BY:	R. PELLET
CHECKED BY:	H. SALLS
SHEET	44 OF 46

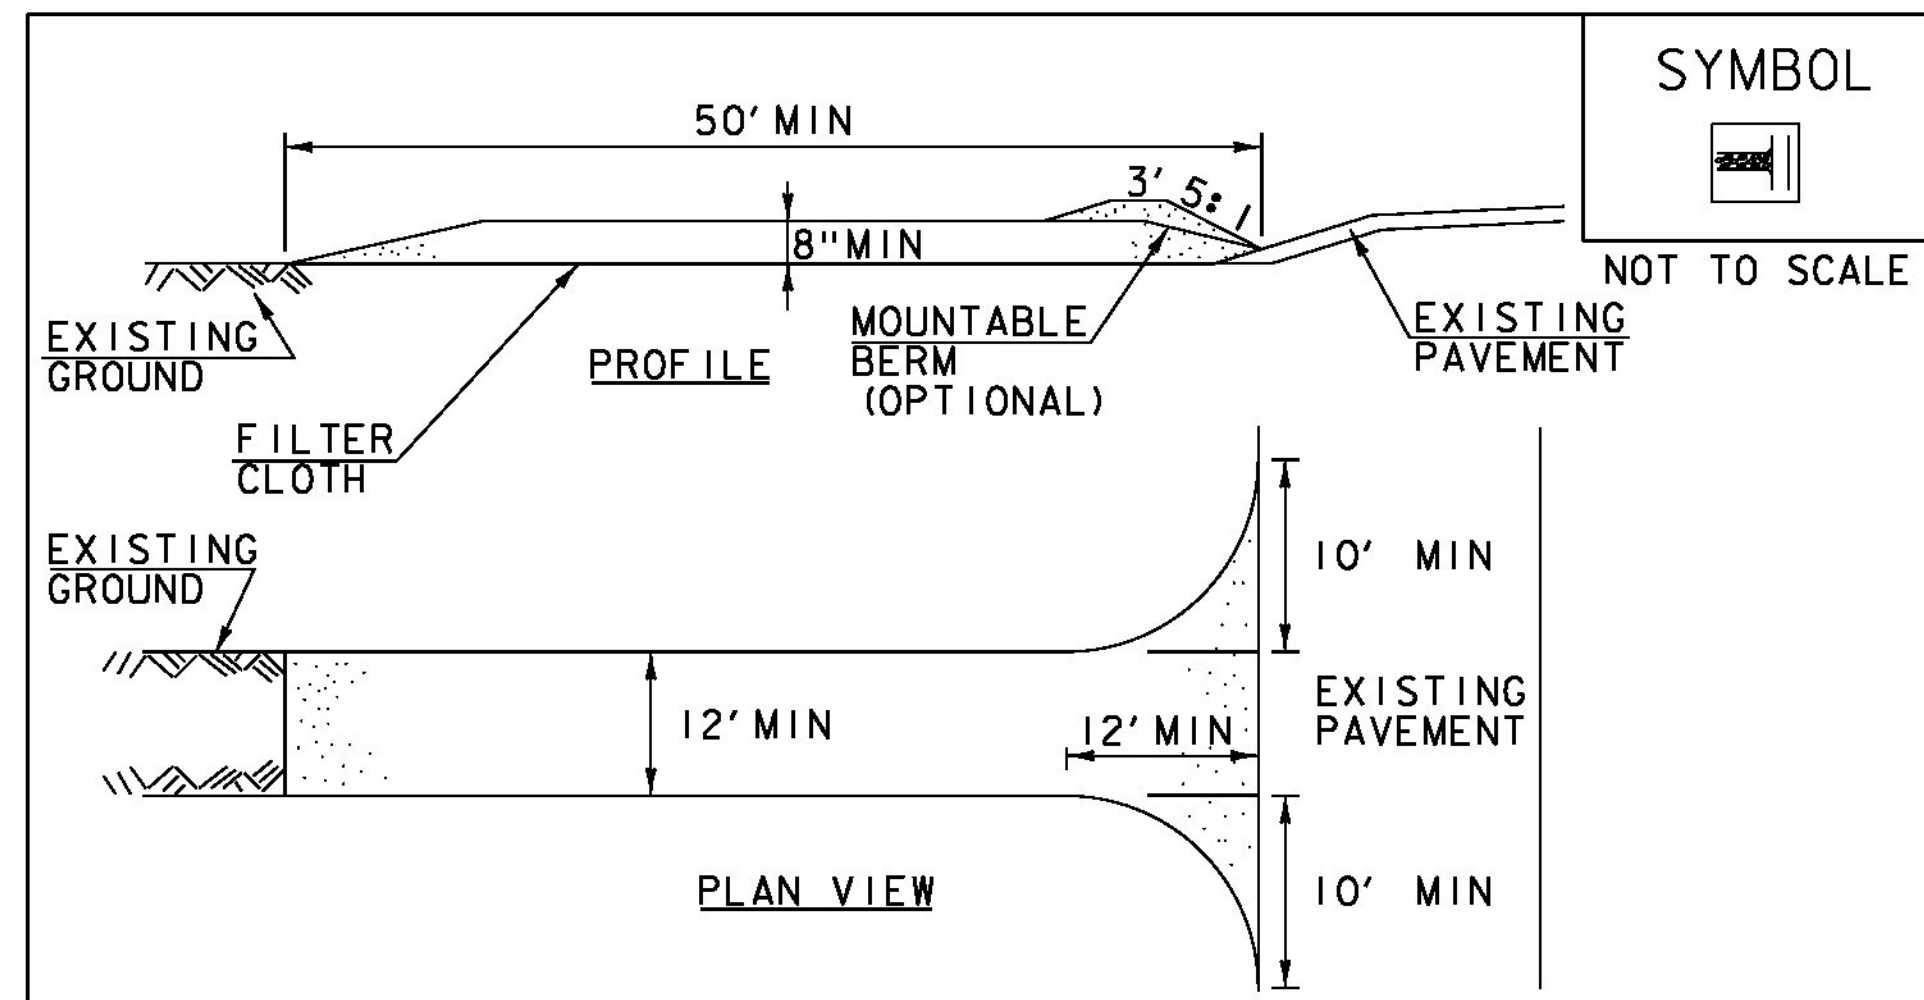

CONSTRUCTION SPECIFICATIONS

1. STONE SIZE- USE 1-4" STONE, RECLAIMED OR RECYCLED CONCRETE EQUIVALENT.
2. LENGTH- NOT LESS THAN 50' (EXCEPT ON A SINGLE RESIDENCE LOT WHERE A 30' MINIMUM LENGTH APPLIES).
3. THICKNESS- NOT LESS THAN 8".
4. WIDTH- 12' MINIMUM, BUT NOT LESS THAN THE FULL WIDTH AT POINTS WHERE INGRESS OR EGRESS OCCURS. 24' IF SINGLE ENTRANCE TO SITE.
5. GEOTEXTILE MUST BE PLACED OVER THE ENTIRE AREA PRIOR TO PLACING STONE.
6. SURFACE WATER- ALL SURFACE WATER FLOWING OR DIVERTED TOWARD CONSTRUCTION ENTRANCES SHALL BE PIPED BENEATH THE ENTRANCE. IF PIPING IS IMPRACTICAL, A MOUNTABLE BERM WITH 5:1 SLOPES WILL BE PERMITTED.
7. MAINTENANCE- THE ENTRANCE SHALL BE MAINTAINED IN A CONDITION WHICH WILL PREVENT TRACKING OR FLOWING OF SEDIMENT ONTO PUBLIC RIGHTS-OF-WAY, ALL SEDIMENT SPILLED, DROPPED, WASHED OR TRACKED ONTO PUBLIC RIGHTS-OF-WAY MUST BE REMOVED IMMEDIATELY.
8. WHEN WASHING IS REQUIRED, IT SHALL BE DONE ON AN AREA STABILIZED WITH STONE AND WHICH DRAINS INTO AN APPROVED SEDIMENT TRAPPING DEVICE.
9. PERIODIC INSPECTION AND NEEDED MAINTENANCE SHALL BE PROVIDED ACCORDING TO PERMIT REQUIREMENTS.



ADAPTED FROM DETAILS PROVIDED BY: NEW YORK STATE DEC
ORIGINALLY DEVELOPED BY USDA-NRCS
VERMONT DEPARTMENT OF ENVIRONMENTAL CONSERVATION

**STABILIZED
CONSTRUCTION
ENTRANCE**

NOTES:
REFER TO "THE VERMONT STANDARDS & SPECIFICATIONS FOR EROSION PREVENTION & SEDIMENT CONTROL -2006-" FROM THE VT AGENCY OF NATURAL RESOURCES FOR ADDITIONAL GUIDANCE.

THIS WORK SHALL BE PERFORMED IN ACCORDANCE WITH SECTION 653 FOR VEHICLE TRACKING PAD (PAY ITEM 653.35) OR AS SPECIFIED IN THE CONTRACT.

REVISIONS	
MARCH 24, 2008	WHF
JANUARY 13, 2009	WHF

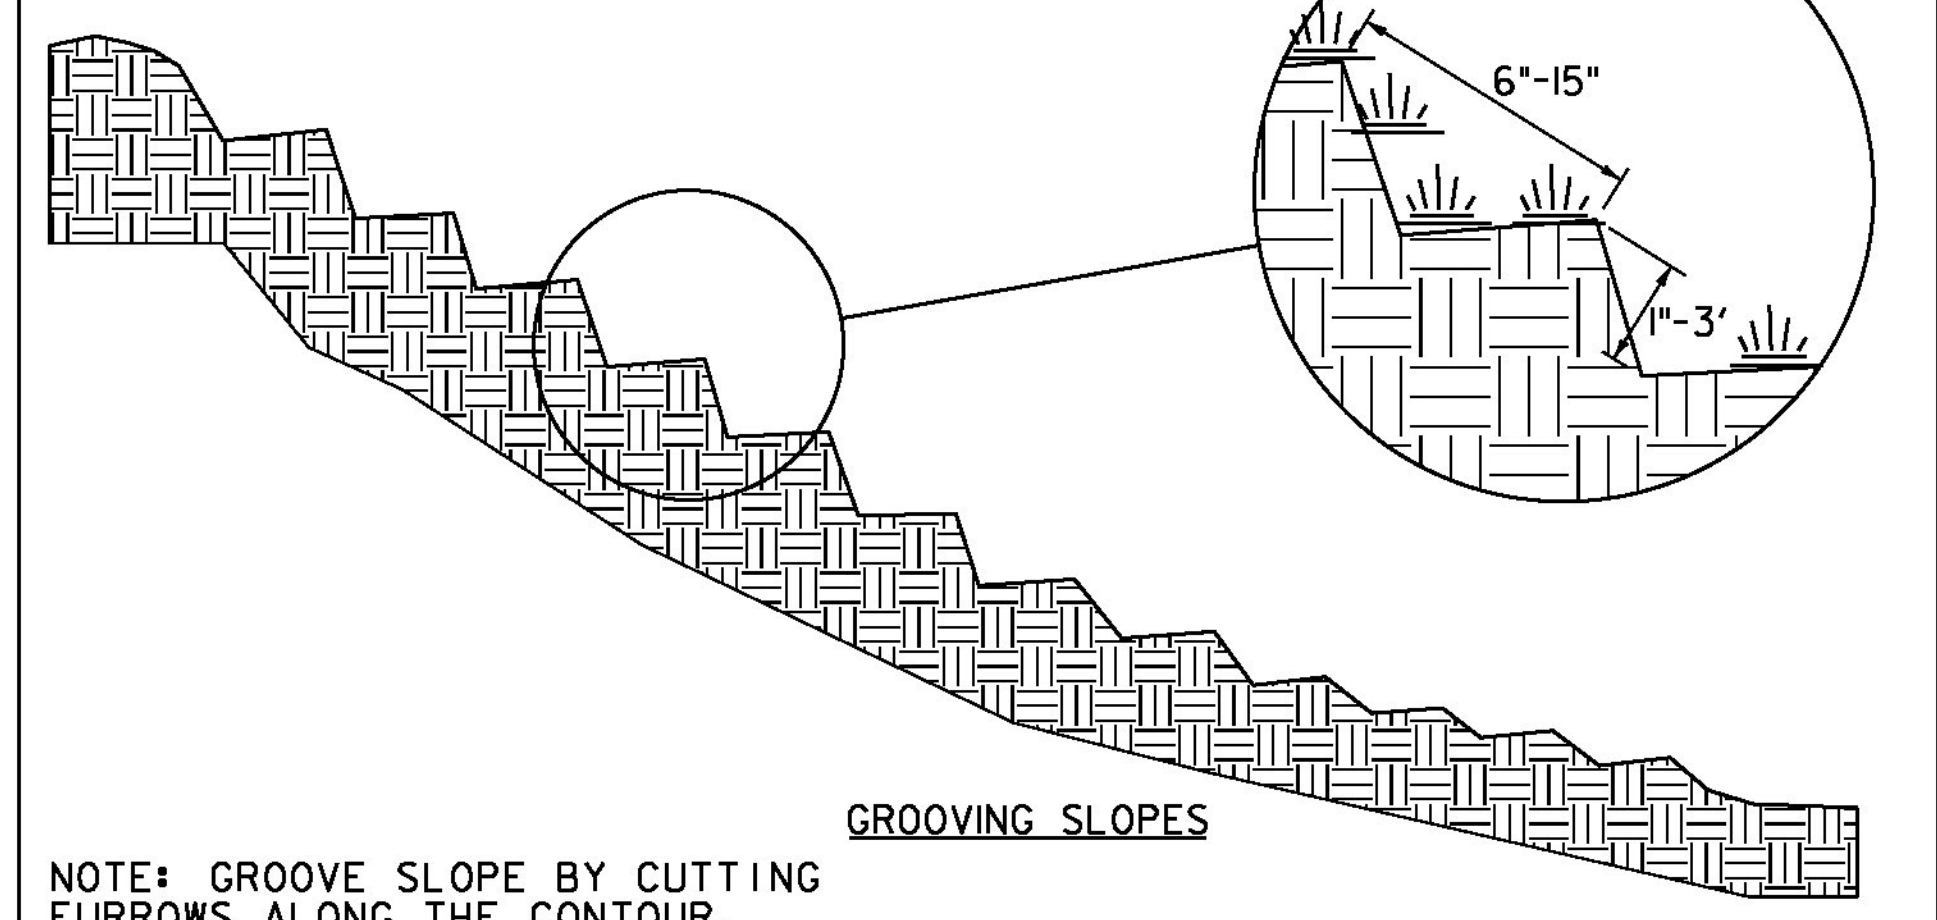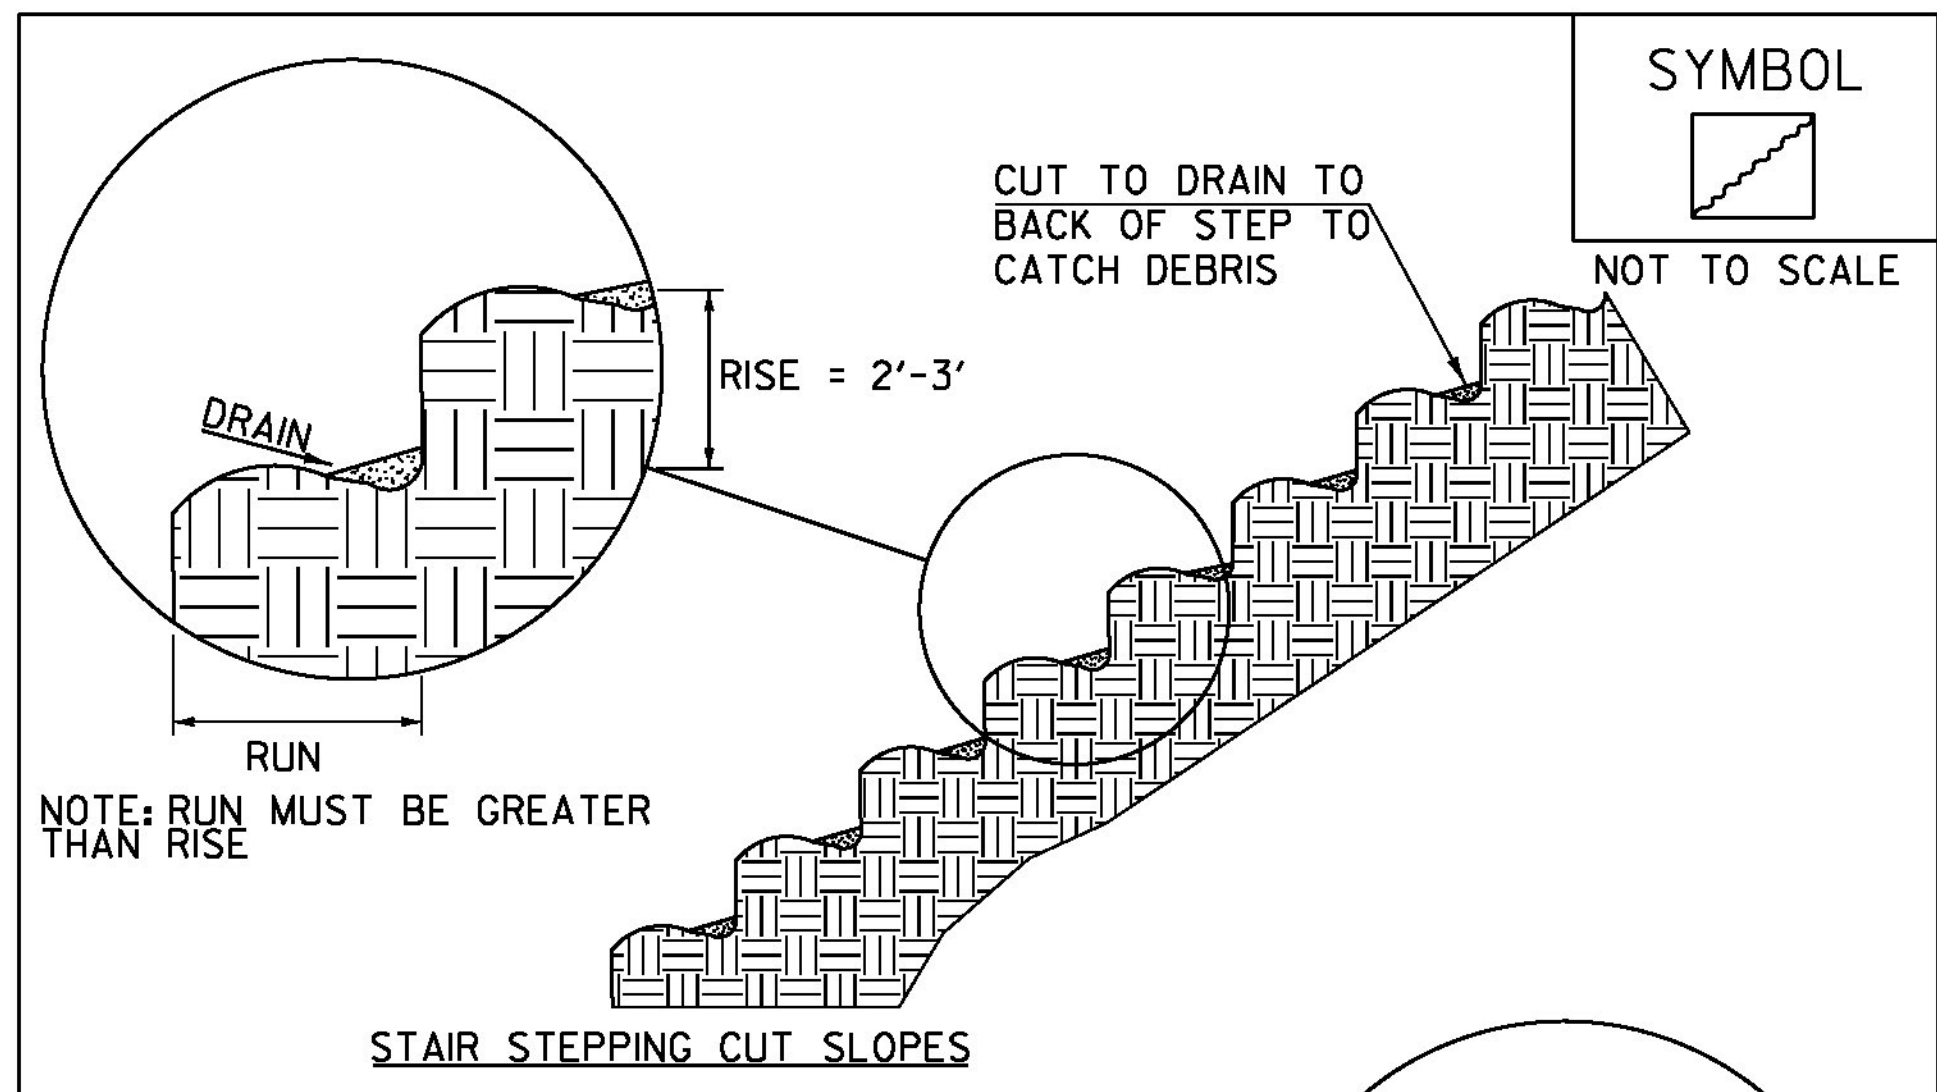

ADAPTED FROM DETAILS PROVIDED BY: NEW YORK STATE DEC
ORIGINALLY DEVELOPED BY USDA-NRCS
VERMONT DEPARTMENT OF ENVIRONMENTAL CONSERVATION

SURFACE ROUGHENING

NOTES:
REFER TO "THE VERMONT STANDARDS & SPECIFICATIONS FOR EROSION PREVENTION & SEDIMENT CONTROL -2006-" FROM THE VT AGENCY OF NATURAL RESOURCES FOR ADDITIONAL GUIDANCE.

THIS WORK SHALL BE CONSIDERED INCIDENTAL TO THE CONTRACT

REVISIONS	
APRIL 1, 2008	WHF
JANUARY 13, 2009	WHF

VAOT RURAL AREA MIX					
% WEIGHT	LBS/AC		NAME	GERM %	PURITY %
	BROADCAST	HYDROSEED			
37.5%	22.5	45	CREEPING RED FESCUE	85%	98%
37.5%	22.5	45	TALL FESCUE	90%	95%
5.0%	3	6	RED TOP	90%	95%
15.0%	9	18	BIRDSFOOT TREFOIL	85%	98%
5.0%	3	6	ANNUAL RYE GRASS	85%	95%
100%	60	120			

VAOT URBAN AREA MIX					
% WEIGHT	LBS/AC		NAME	GERM %	PURITY %
	BROADCAST	HYDROSEED			
42.5%	34	68	CREEPING RED FESCUE	85%	98%
10.0%	8	16	PERENNIAL RYE GRASS	90%	95%
42.5%	34	68	KENTUCKY BLUE GRASS	85%	85%
5.0%	4	8	ANNUAL RYE GRASS	85%	95%
100%	80	160			

SOIL AMENDMENT GUIDANCE			
FERTILIZER		LIME	
BROADCAST	HYDROSEED	BROADCAST	HYDROSEED
10-20-10	FOLLOW	PELLETIZED	FOLLOW
500 LBS/AC	MANUFACTURER	2 TONS/AC	MANUFACTURER

CONSTRUCTION GUIDANCE

1. RURAL SEED MIX: USE AS INDICATED IN THE PLANS AND/OR FOR ALL ESTABLISHED UPLAND (NON WETLAND) AREAS DISTURBED BY THE CONTRACTOR.
2. URBAN SEED MIX: USE AS INDICATED IN THE PLANS AND/OR FOR ALL ESTABLISHED LAWN AREAS DISTURBED BY THE CONTRACTOR.
3. ALL SEED MIXTURES: SHALL NOT HAVE A WEED CONTENT EXCEEDING 0.40% BY WEIGHT AND SHALL BE FREE OF ALL NOXIOUS SEED.
4. FERTILIZER AND LIMESTONE: SHALL FOLLOW RATES SHOWN ON PLAN OR AS DIRECTED BY THE ENGINEER
5. HAY MULCH: TO BE PLACED ON EARTH SLOPES AT THE RATE OF 2 TONS/ACRE, ACHIEVE 90% GROUND COVER OR AS DIRECTED BY THE ENGINEER.
6. TOPSOIL: TO BE USED WITH SEED AS INDICATED ON THE PLANS, OR AS DIRECTED BY THE ENGINEER.
7. HYDROSEEDING: ALTHOUGH GUIDANCE IS GIVEN ABOVE THE SITE CONDITIONS AND THE TYPE OF HYDROSEED WILL ULTIMATELY DICTATE THE AMOUNTS AND TYPES OF SOIL AMENDMENTS TO BE APPLIED
8. TURF ESTABLISHMENT: PLACING SEED, FERTILIZER, LIME AND MULCH PRIOR TO SEPTEMBER 15 AND AFTER APRIL 15 CAN BETTER ENSURE A VIGOROUS GROWTH OF GRASS.

ADAPTED FROM VTRANS TECHNICAL LANDSCAPE MANUAL FOR ROADWAYS AND TRANSPORTATION FACILITIES


TURF ESTABLISHMENT

THIS WORK SHALL BE PERFORMED IN ACCORDANCE WITH SECTION 651 FOR SEED (PAY ITEM 651.15)

REVISIONS	
JUNE 23, 2009	WHF
JANUARY 15, 2010	WHF
FEBRUARY 16, 2011	WHF

PROJECT NAME: MIDDLESEX
PROJECT NUMBER: BRF 024-(K37)

FILE NAME: sl0c220e.odt1s.dgn PLOT DATE: 13-JAN-2015
PROJECT LEADER: C. CARLSON DRAWN BY: R. PELLET
DESIGNED BY: H. SALLS CHECKED BY: H. SALLS
EPSC DETAILS (2) SHEET 45 OF 46

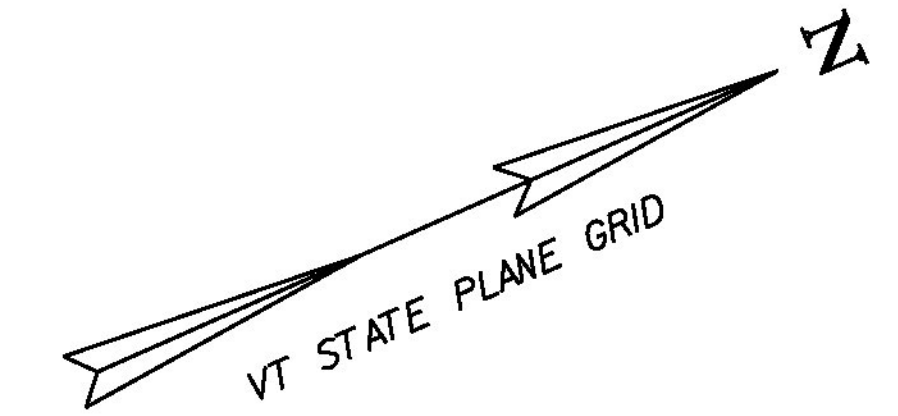

**CAST-IN-PLACE CONCRETE CURB,
TYPE B**
 STA 28+60.00 - STA 29+00.00 LT
 STA 28+63.00 - STA 29+03.00 RT
 STA 29+38.00 - STA 29+78.00 LT
 STA 29+50.00 - STA 29+90.00 RT

**REMOVAL AND DISPOSAL OF
GUARDRAIL**
 STA 28+37.79 - STA 29+05.13 RT
 STA 28+55.75 - STA 28+96.94 LT
 STA 29+41.53 - STA 30+06.03 LT
 STA 29+46.89 - STA 30+14.07 RT


**MANUFACTURED TERMINAL
SECTION, FLARED**
 STA 28+34.75 - STA 28+73.84 RT
 STA 30+17.15 - STA 30+56.28 LT
 STA 29+79.01 - STA 30+18.14 RT

PAVED APRON
 STA 30+70.75 - 31+50.00 LT
**HD STEEL BEAM GUARDRAIL,
GALVANIZED**
 STA 28+49.62 - STA 28+61.96 LT
 STA 29+67.15 - STA 30+17.15 LT

**GUARDRAIL APPROACH SECTION,
GALVANIZED 2 RAIL BOX BEAM**
 STA 28+61.96 - STA 28+91.29 LT
 STA 28+73.84 - STA 29+02.94 RT
 STA 29+38.06 - STA 29+67.15 LT
 STA 29+49.71 - STA 29+79.01 RT

**BRIDGE RAIL, GALVANIZED
2 RAIL BOX BEAM**
 STA 28+91.29 - STA 29+38.06 LT
 STA 29+02.94 - STA 29+49.71 RT

**END R.O.W. PROJECT
BRF 024-1(37)
STA 31+15 61.68' LT**

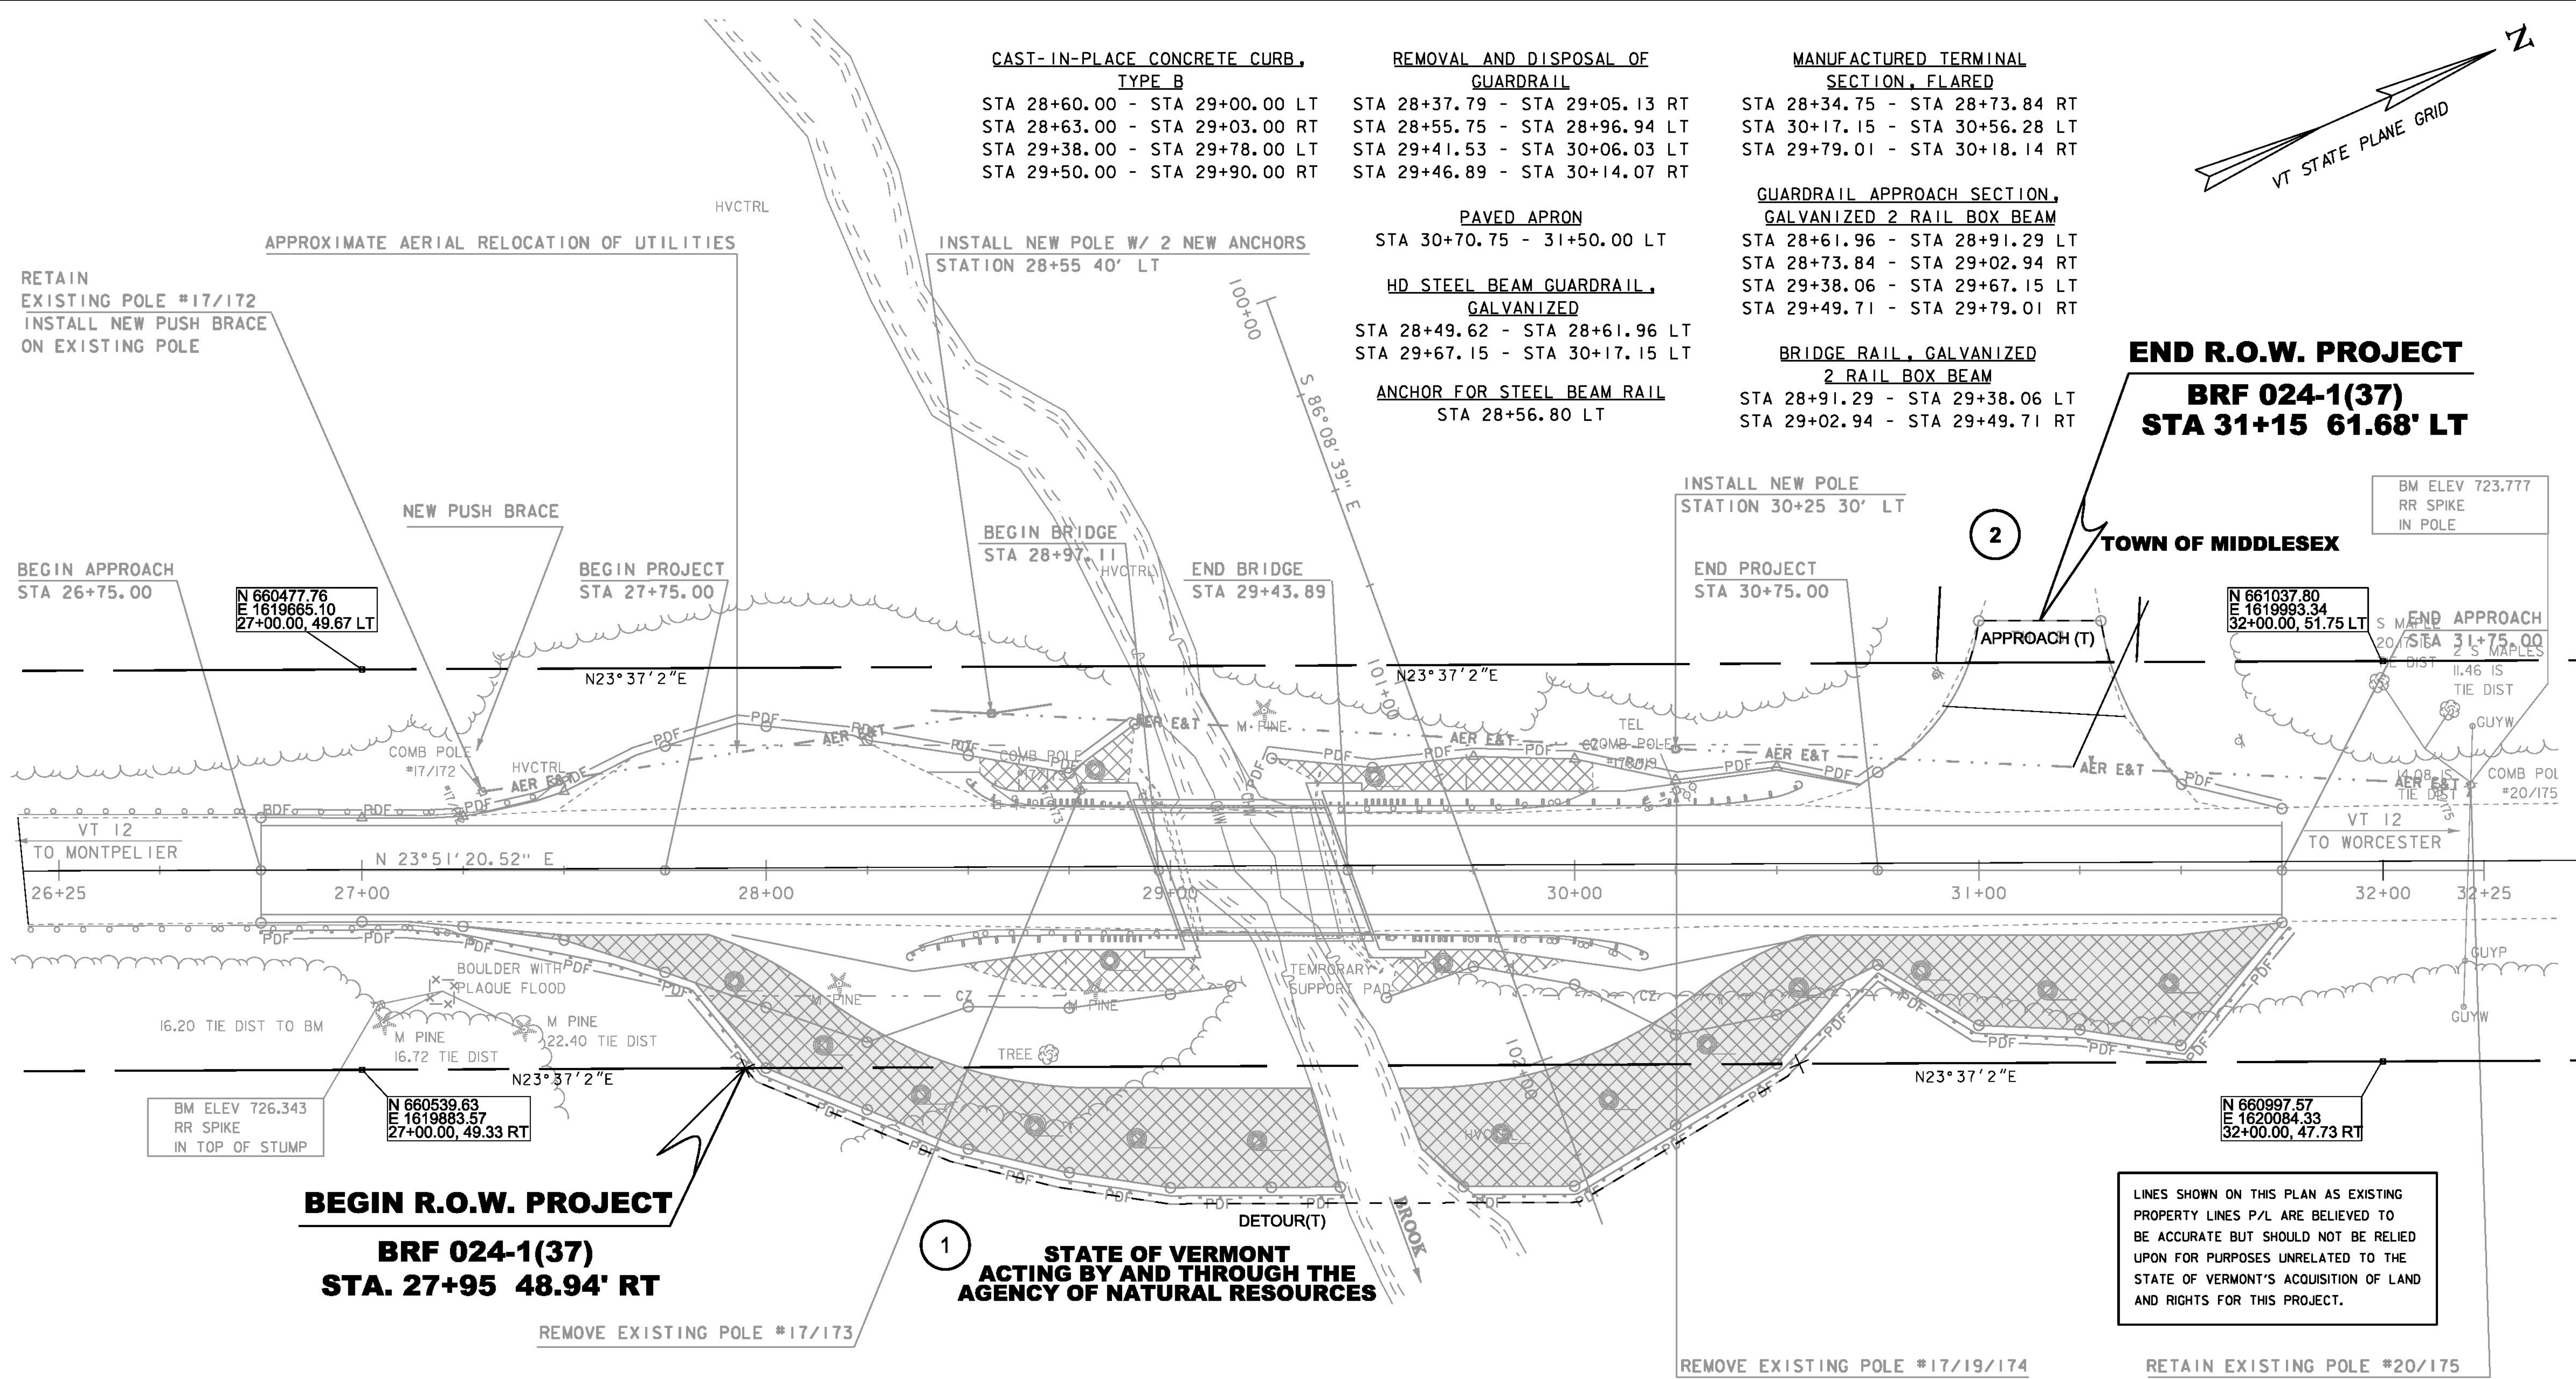

**BEGIN R.O.W. PROJECT
BRF 024-1(37)
STA. 27+95 48.94' RT**

**STATE OF VERMONT
ACTING BY AND THROUGH THE
AGENCY OF NATURAL RESOURCES**

LINES SHOWN ON THIS PLAN AS EXISTING PROPERTY LINES P/L ARE BELIEVED TO BE ACCURATE BUT SHOULD NOT BE RELIED UPON FOR PURPOSES UNRELATED TO THE STATE OF VERMONT'S ACQUISITION OF LAND AND RIGHTS FOR THIS PROJECT.

STATE OF VERMONT
AGENCY OF TRANSPORTATION

RIGHT - OF - WAY DETAIL SHEET

TABLE OF PROPERTY ACQUISITION													
PARCEL NO.	PROPERTY OWNER	SHEET NO.	BEGINNING STATION	ENDING STATION	TAKE		RIGHT			RECORDING DATA			REMARKS
					AREA±	AREA±	TYPE	(T)/P	AREA±	TITLE	DATE	TOWN/CITY	
1	STATE OF VERMONT ACTING BY AND THROUGH THE AGENCY OF NATURAL RESOURCES	1	27+95 RT	30+56 LT			DETOUR	T	0.15A				6,833 SF±; INCL. PDF & EC
2	TOWN OF MIDDLESEX	1	31+15 LT				APPROACH	T	332 SF				

TABLE OF REVISIONS			
REVISION NO.	SHEET NO.	DESCRIPTION	DATE


NOTE: UTILITY WORK TO BE DONE BY OTHERS

PROJECT NAME: MIDDLESEX
PROJECT NUMBER: BRF 024-1(37)

FILE NAME: NAME.DGN
PROJECT LEADER: C. CARLSON
DESIGNED BY: H. SALLS
R.O.W. INFORMATION SHEET


PLOT DATE: 13-JAN-2015
DRAWN BY: J. BLANCHARD
CHECKED BY: R. CLOUTIER
SHEET 46 OF 46

FOR R.O.W.
USE ONLY

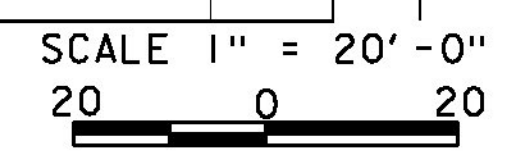


CONCRETE GENERAL NOTES

1. ALL EXPOSED EDGES OF CONCRETE SHALL BE CHAMFERED 1" x 1"
2. REINFORCING STEEL SIZE AND SPACING SHOWN IN THE PLANS IS BASED ON 60 KSI STEEL, UNLESS NOTED OTHERWISE. WITH THE ENGINEER'S PERMISSION, BAR SIZE AND SPACING MAY BE MODIFIED ACCORDING TO THE LATEST AASHTO LRFD BRIDGE DESIGN SPECIFICATION AND STRUCTURES DESIGN MANUAL WHEN USING HIGHER STRENGTH STEEL.

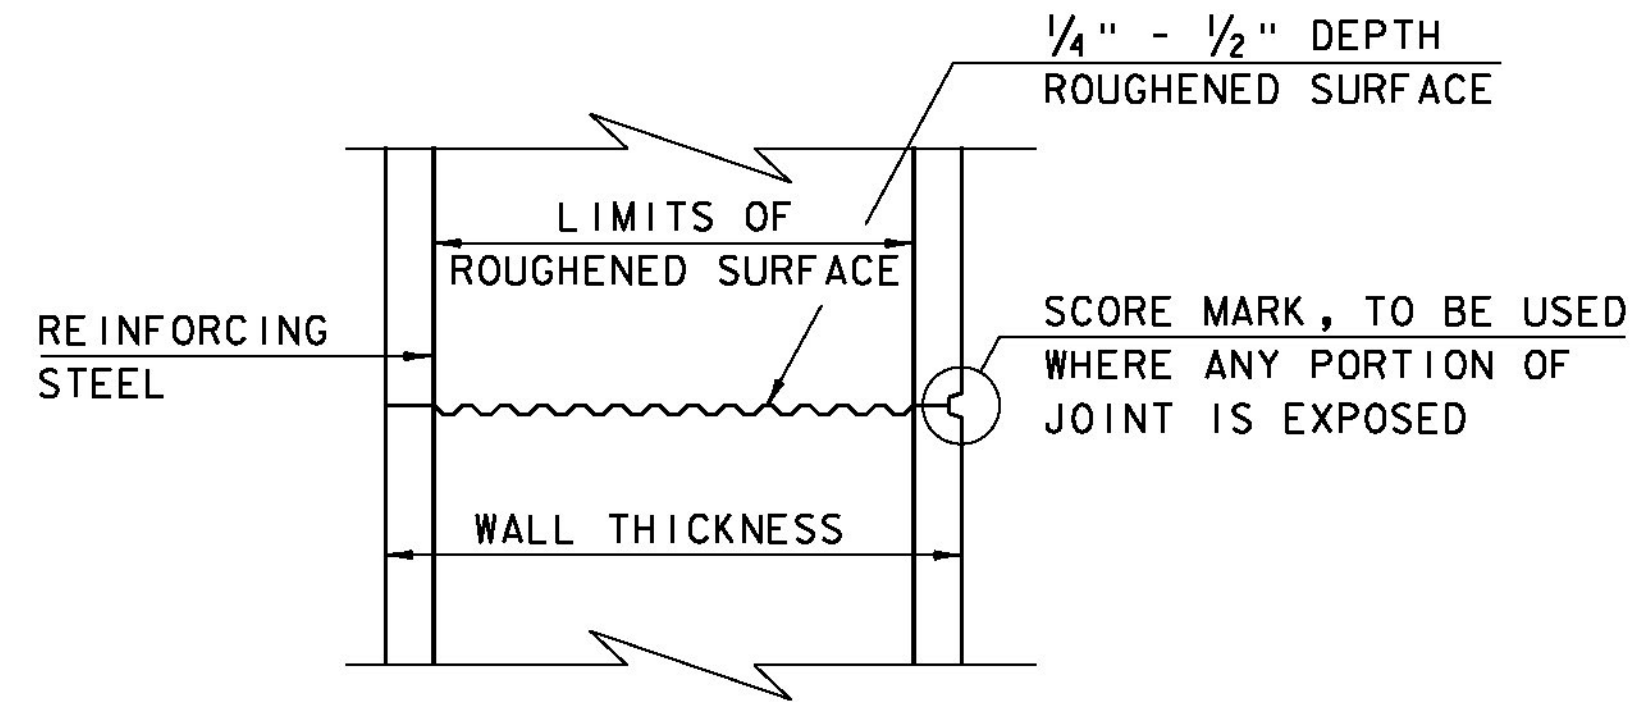


TYPICAL HORIZONTAL CONSTRUCTION JOINT
(NOT TO SCALE)


1. THE SURFACE OF THE CONCRETE CONSTRUCTION JOINTS SHALL BE CLEANED AND FREE OF LAITANCE.
2. IMMEDIATELY BEFORE NEW CONCRETE IS PLACED, ALL CONSTRUCTION JOINTS SHALL BE WETTED AND STANDING WATER REMOVED.

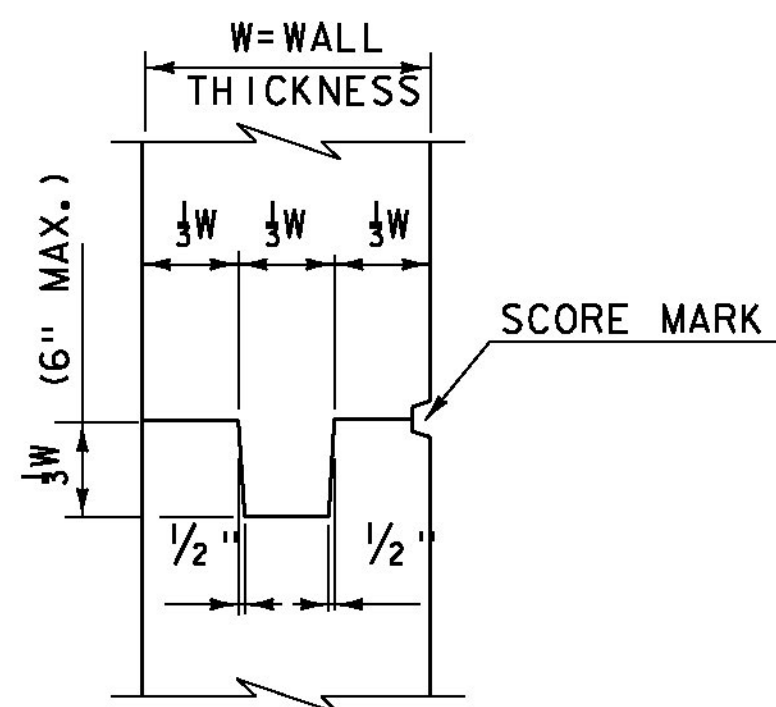


TYPICAL CONCRETE CONSTRUCTION JOINT
(NOT TO SCALE)

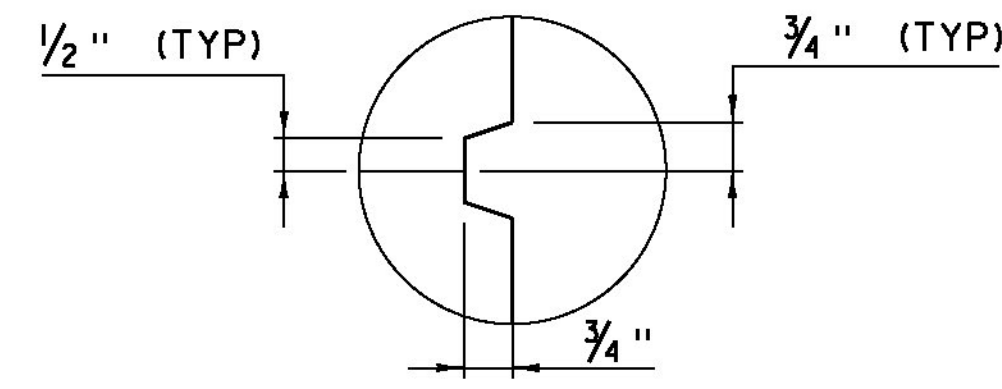


SCORE MARK DETAIL
(NOT TO SCALE)

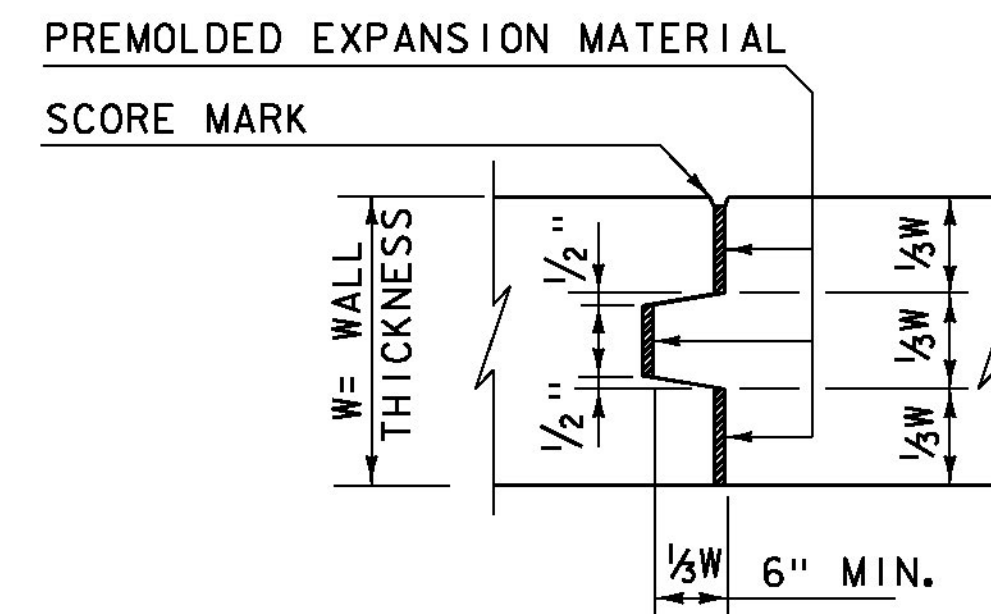

TYPICAL CONCRETE EXPANSION JOINT
(NOT TO SCALE)

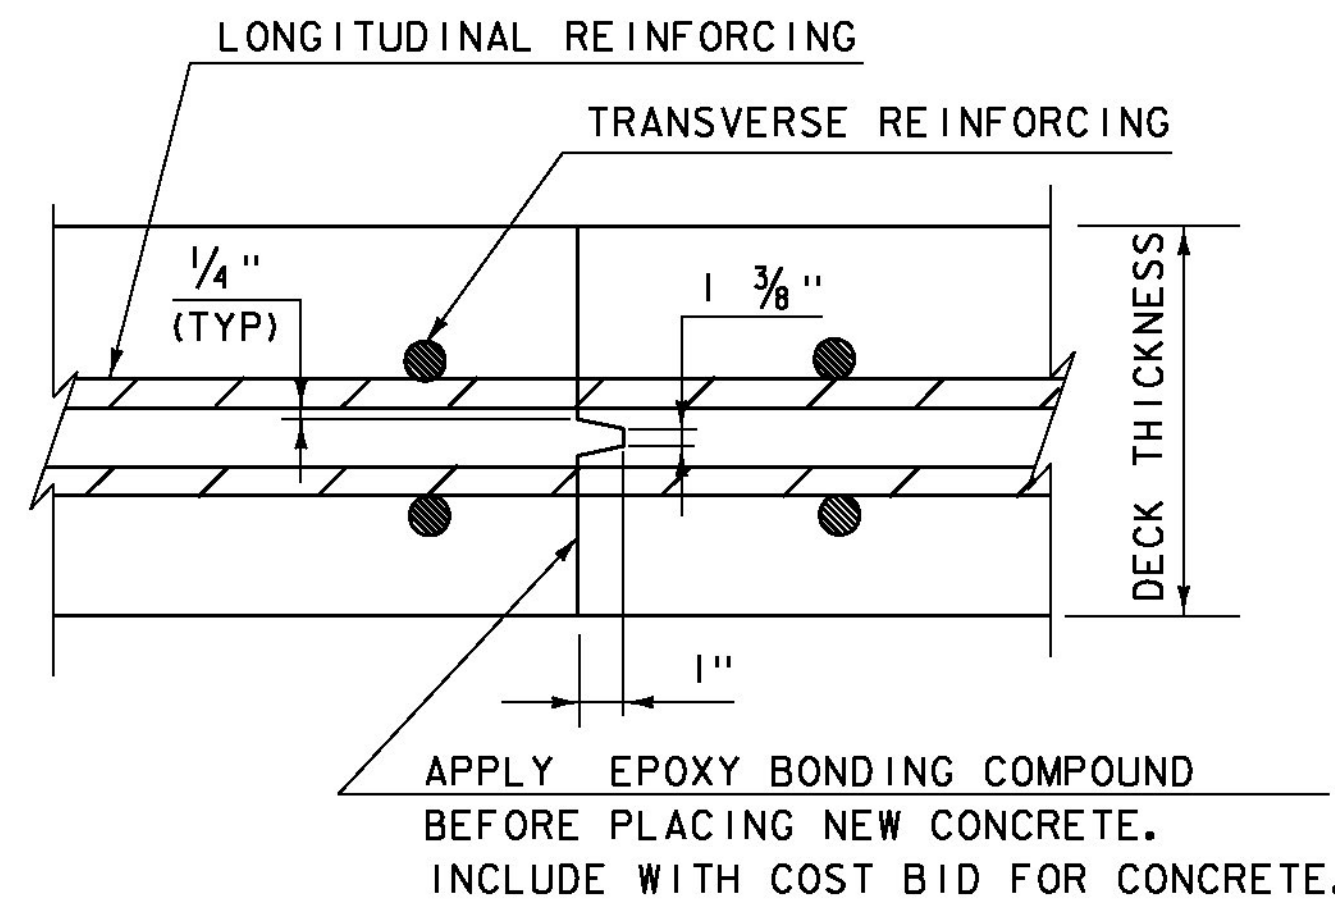


TRANSVERSE BRIDGE SLAB CONSTRUCTION JOINT DETAILS
(NOT TO SCALE)

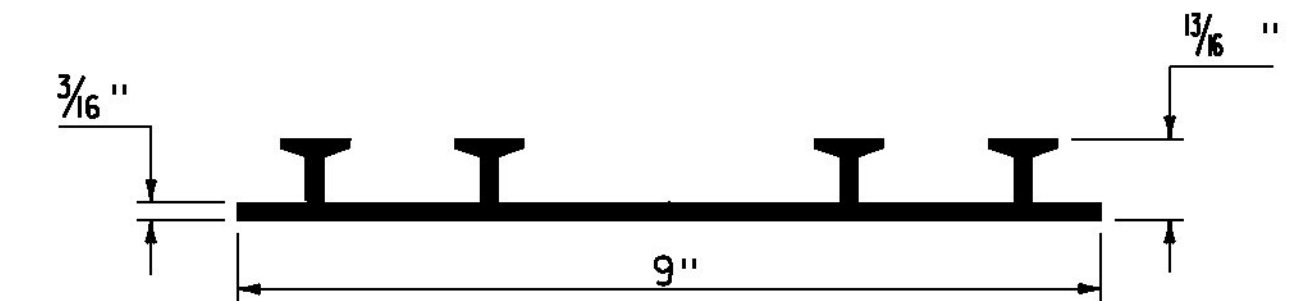

P.V.C. WATERSTOP FOR CONSTRUCTION JOINTS
(NOT TO SCALE)

PAYMENT FOR THE P.V.C. WATERSTOP SHALL BE INCIDENTAL TO THE UNIT BID PRICE FOR THE ADJACENT CONCRETE.


OTHER CONFIGURATIONS OF WATERSTOP MAY BE USED UPON APPROVAL OF THE ENGINEER.

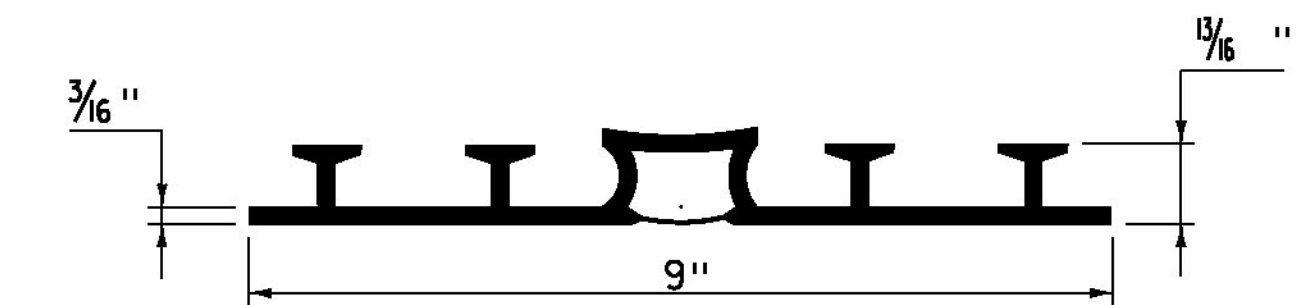

P.V.C. WATERSTOP FOR EXPANSION JOINTS
(NOT TO SCALE)

PAYMENT FOR THE P.V.C. WATERSTOP SHALL BE INCIDENTAL TO THE UNIT BID PRICE FOR THE ADJACENT CONCRETE.


OTHER CONFIGURATIONS OF WATERSTOP MAY BE USED UPON APPROVAL OF THE ENGINEER.

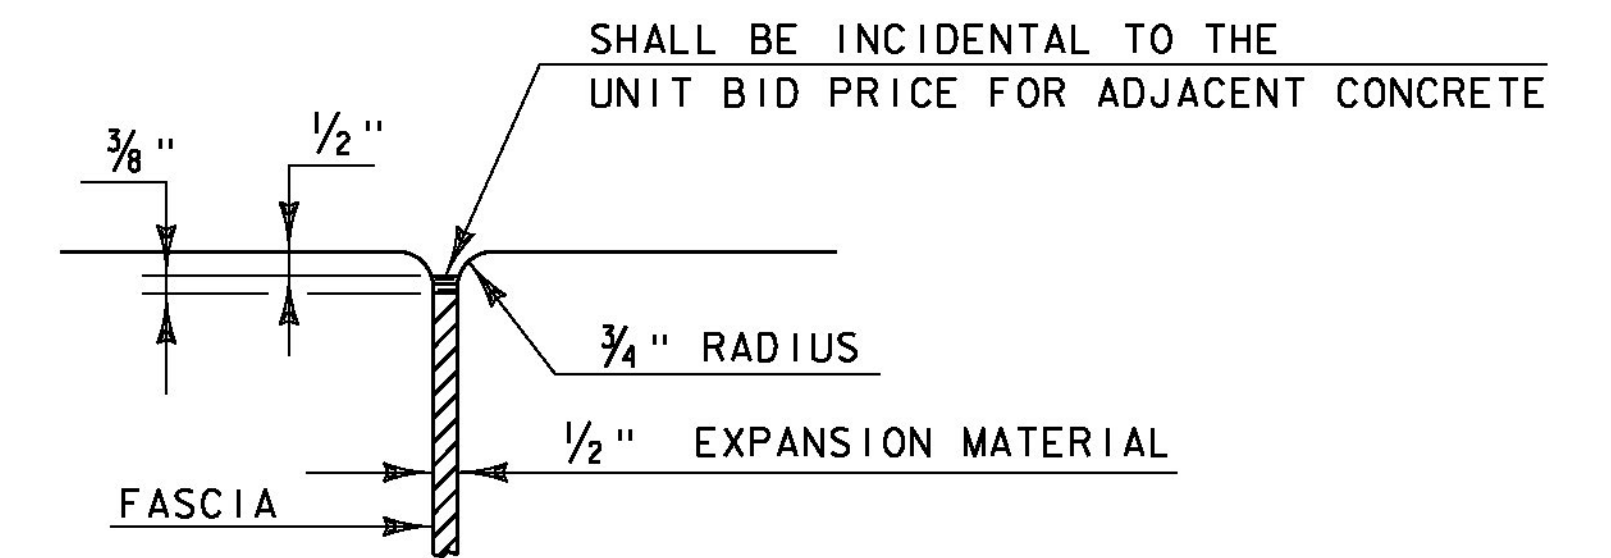

JOINT BETWEEN FASCIA AND WINGWALL
(NOT TO SCALE)


REVISIONS	
MAY 7, 2010	APPROVED FOR USE BY VAOT STRUCTURES SECTION
FEBRUARY 9, 2012	REBAR SUBSTITUTION ALLOWANCE ADDED TO CONCRETE GENERAL NOTES.

**CONCRETE
DETAILS AND NOTES**

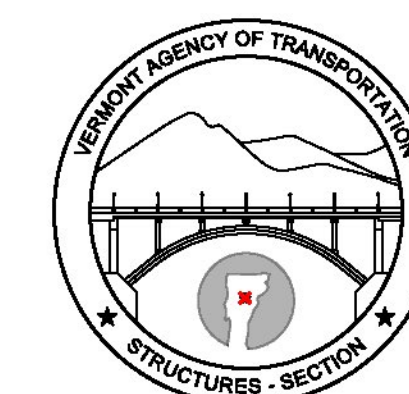


**STRUCTURES
DETAIL
SD-501.00**

POLYURETHANE JOINT SEALER MEETING THE REQUIREMENTS OF SECTION 524. COLOR TO MATCH CONCRETE. PAYMENT TO BE INCIDENTAL TO THE BRIDGE CURB CONCRETE ITEM

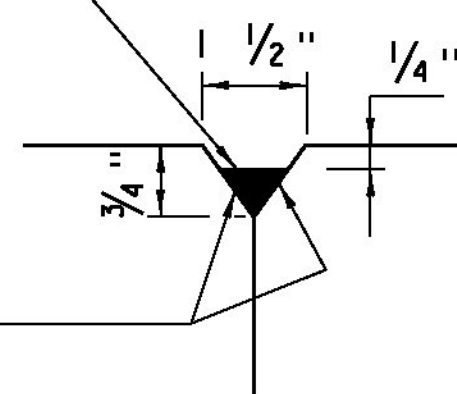


DETAIL "B"
(NOT TO SCALE)

ADHERE TO THESE SURFACES

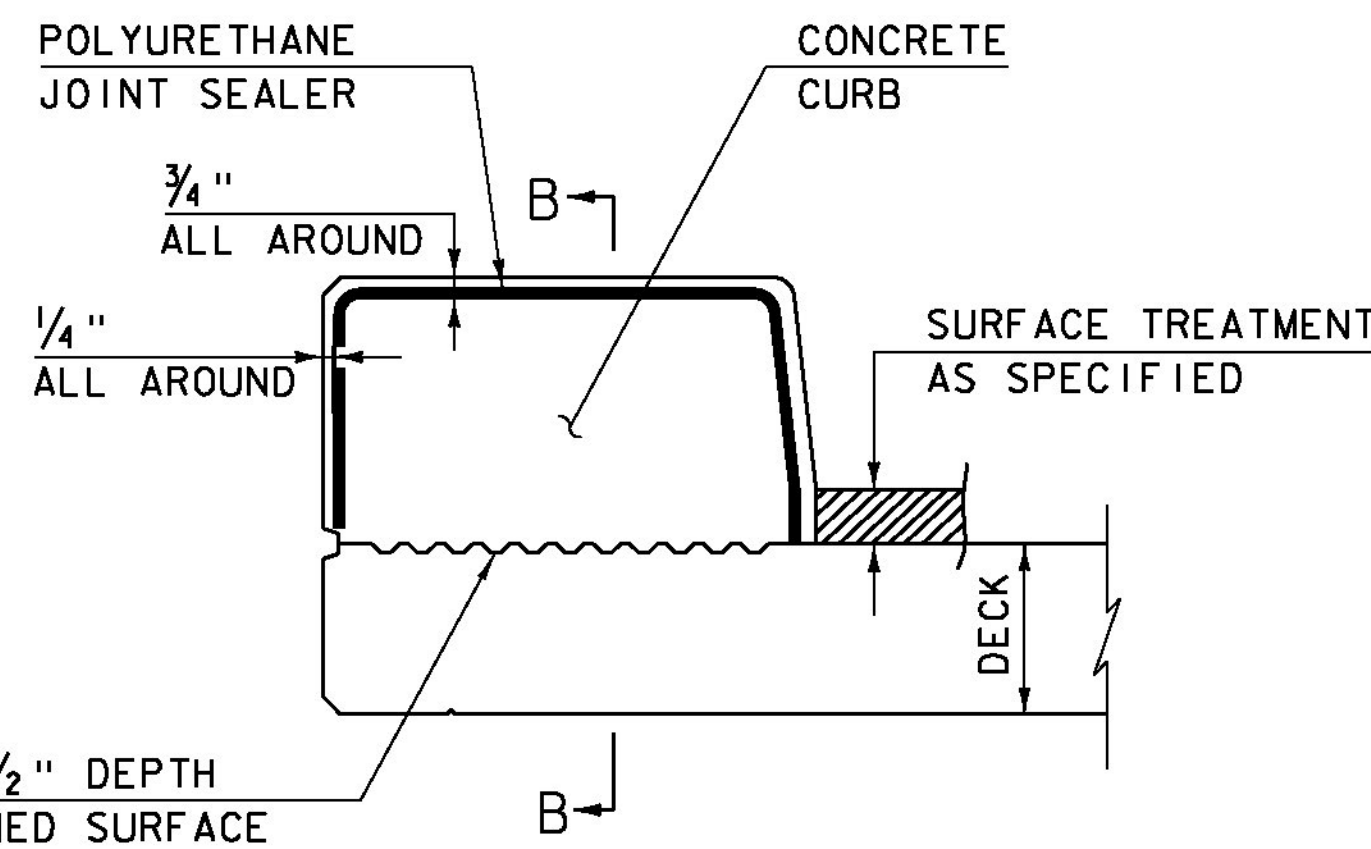


CONCRETE CURB JOINT SECTION
(NOT TO SCALE)

1. SEE TYPICAL HORIZONTAL CONSTRUCTION JOINT DETAIL FOR ADDITIONAL INFORMATION

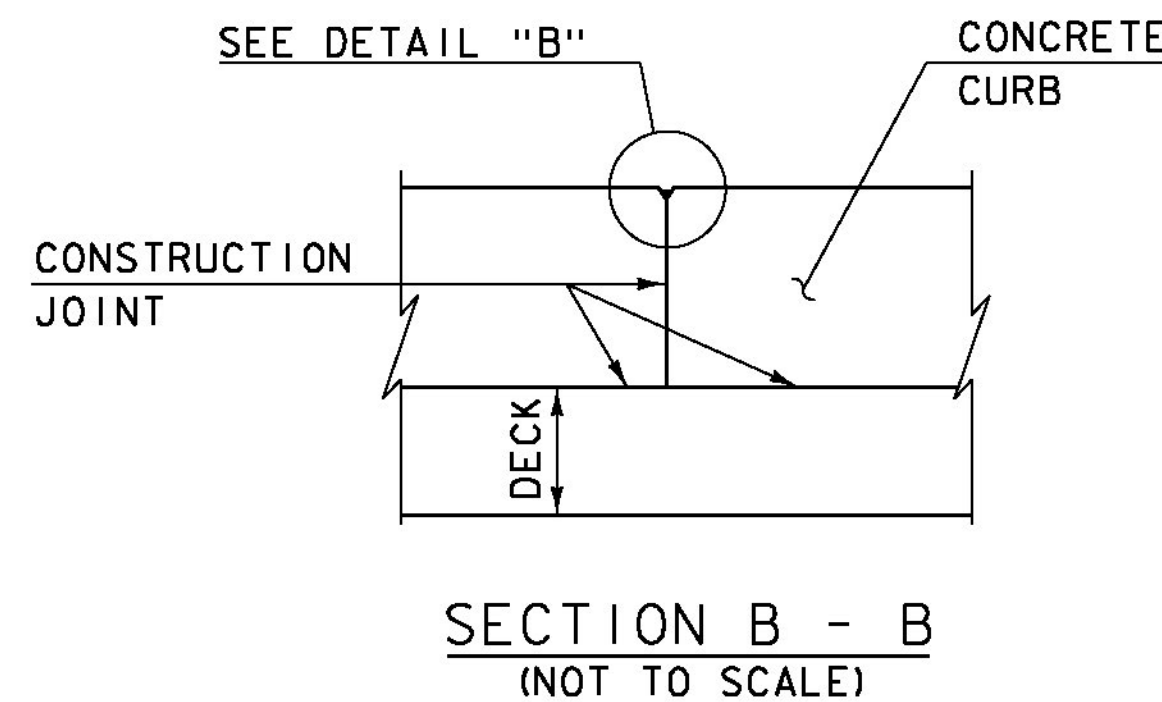


SECTION B - B
(NOT TO SCALE)

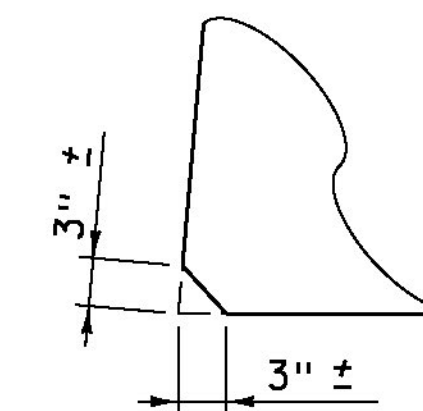


ACUTE ANGLE
CLIP DETAIL
(NOT TO SCALE)

CONCRETE CURB JOINT NOTES


1. CONCRETE CURBS MAY BE PLACED IN ONE CONTINUOUS OPERATION IF AN APPROVED SHRINKAGE REDUCING ADMIXTURE LISTED IN THE SPECIAL PROVISIONS IS USED WITH THE CONCRETE MIX DESIGN. PAYMENT FOR THE SHRINKAGE REDUCING ADMIXTURE WILL BE INCIDENTAL TO THE BRIDGE CURB CONCRETE ITEM.
2. IF THE CONTRACTOR CHOOSES NOT TO USE AN APPROVED SHRINKAGE REDUCING ADMIXTURE, THE CURBS SHALL BE CONSTRUCTED WITH CONSTRUCTION JOINTS SPACED AT A MAXIMUM OF 15'-0" CENTER TO CENTER AND 2'-0" MINIMUM FROM THE CENTER OF NEAREST BRIDGE RAILING POST.
3. ON MULTI-SPAN CONTINUOUS SUPERSTRUCTURES, REGARDLESS OF WHETHER APPROVED SHRINKAGE REDUCING ADMIXTURE IS USED, CURB JOINTS SHALL BE LOCATED OVER THE CENTERLINE OF PIERS AND 7'-0" EACH SIDE OF THE CENTERLINE OF EACH PIER.
4. WHEN CURB JOINTS ARE USED THE CURBS SHALL BE PLACED IN ALTERNATE SECTIONS WITH A MINIMUM OF 48 HOUR DELAY BETWEEN ADJACENT PLACEMENTS.
5. LONGITUDINAL REINFORCING SHALL BE CONTINUOUS THROUGH CURB CONSTRUCTION JOINTS. CURB STIRRUP BARS SHALL BE TURNED AS NECESSARY TO MAINTAIN COVER IN THE FLARED CURB ENDS.
6. THE JOINT SPACING AND DETAILS SHOWN SHALL APPLY TO SIDEWALKS WHEN SHOWN IN THE PLANS.

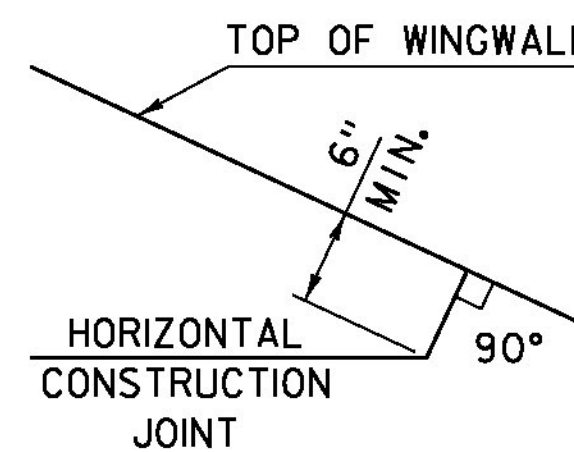


HORIZONTAL WINGWALL
CONSTRUCTION JOINT
(NOT TO SCALE)

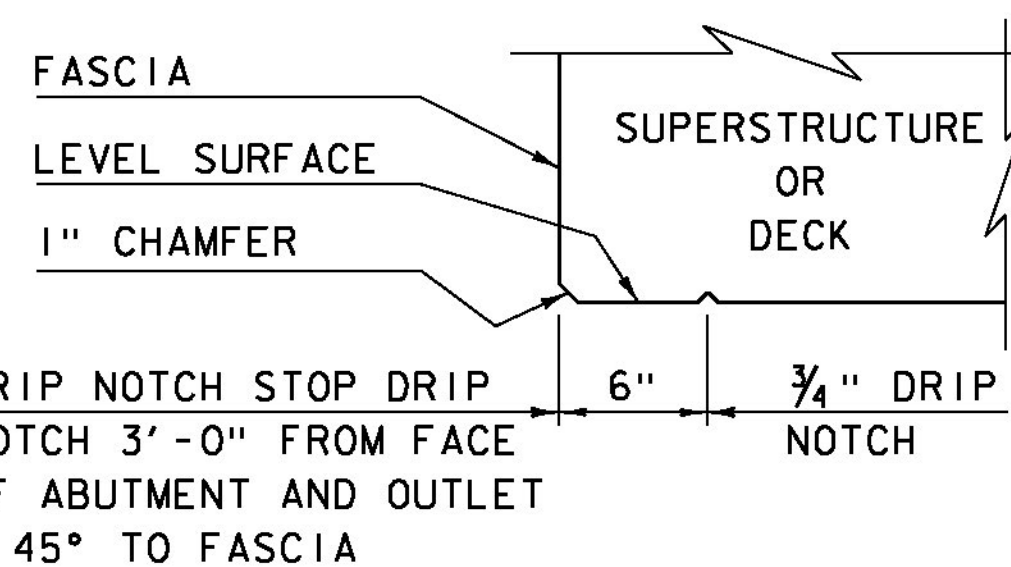

DRIP NOTCH DETAIL
(NOT TO SCALE)

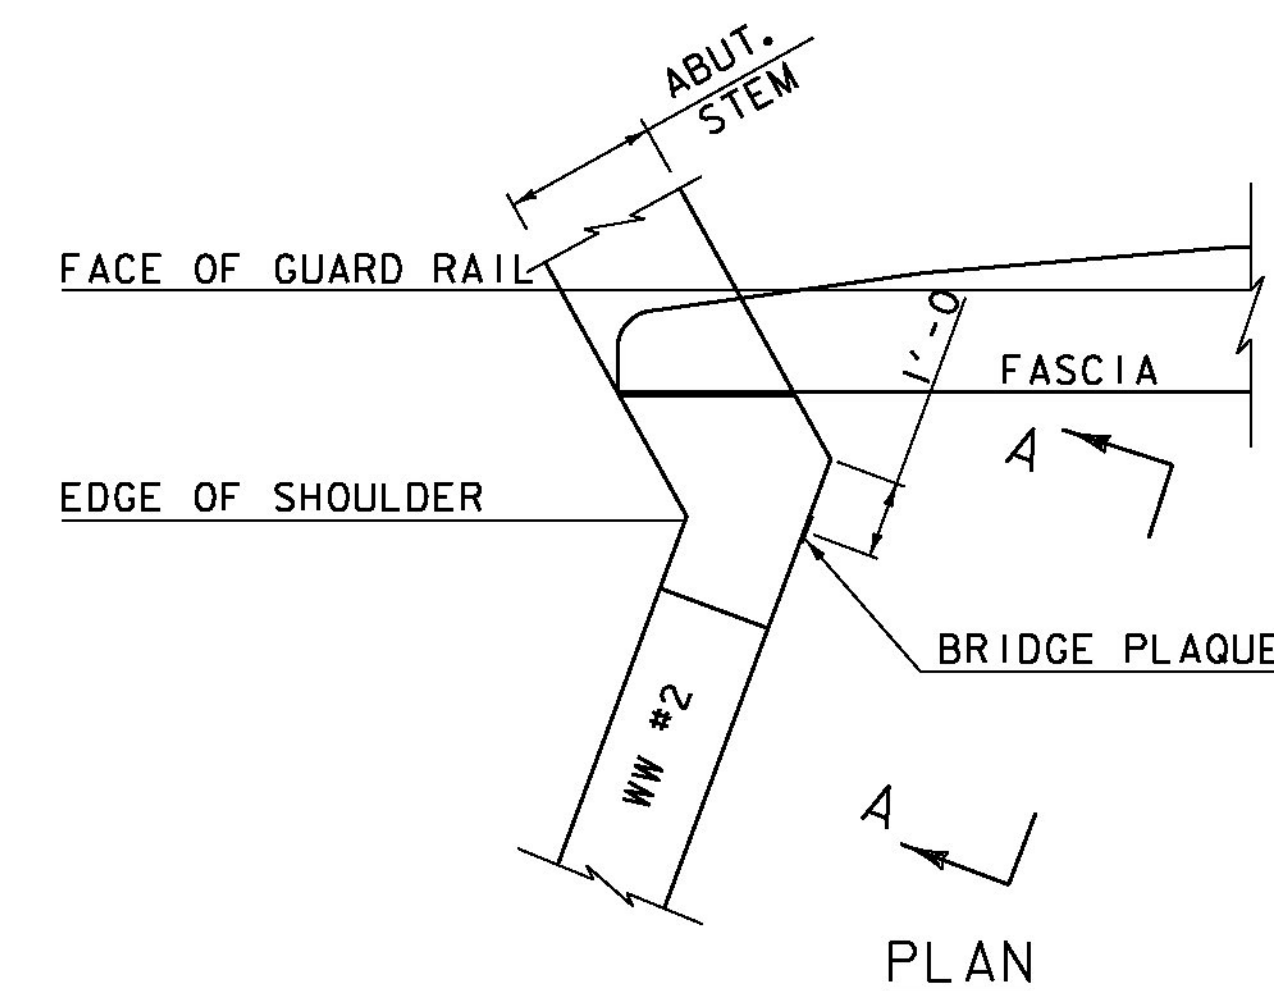

PLAN

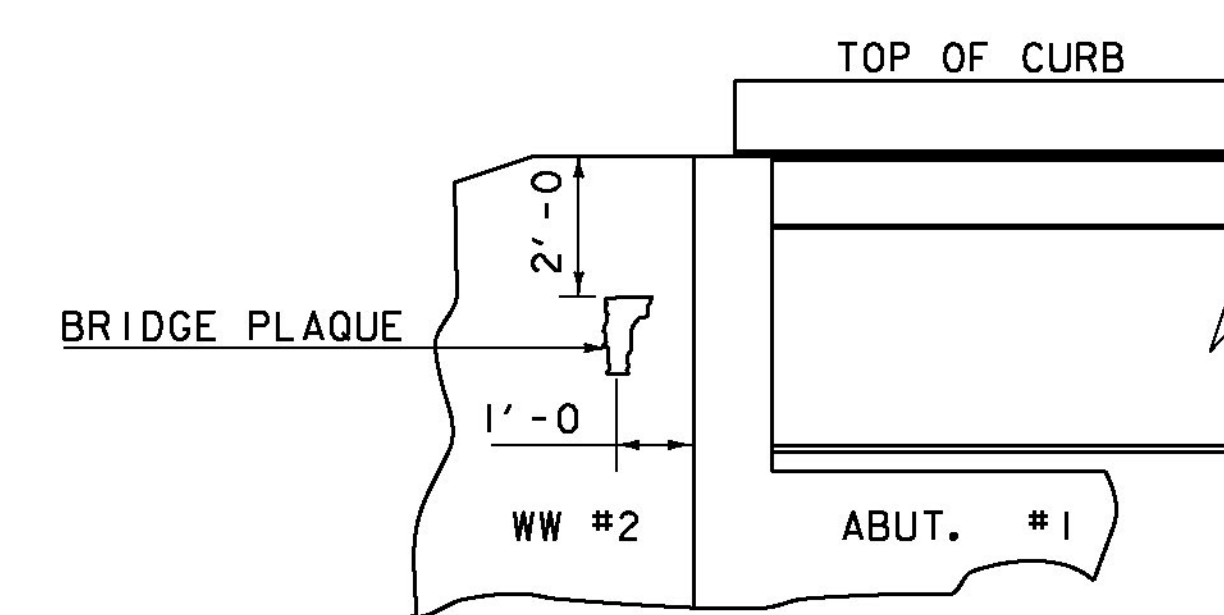

VIEW "A - A"
BRIDGE PLAQUE
(NOT TO SCALE)


THE BRIDGE PLAQUE WILL BE SUPPLIED BY THE AGENCY OF TRANSPORTATION AND SHALL BE INSTALLED BY THE CONTRACTOR AT ABUTMENT #1 ON THE RIGHT SIDE AS SHOWN OR AS DIRECTED BY THE ENGINEER.

PAYMENT FOR INSTALLATION OF THE BRIDGE PLAQUE SHALL BE INCIDENTAL TO THE ADJACENT CONCRETE.


REVISIONS

MAY 7, 2010	APPROVED FOR USE BY VAOT STRUCTURES SECTION
JUNE 4, 2010	MODIFIED AND ADDED TWO DETAILS
OCTOBER 10, 2012	MODIFIED HORZ. JOINT WINGWALL ADD 6" MIN. DIMENSION

CONCRETE
DETAILS AND NOTES

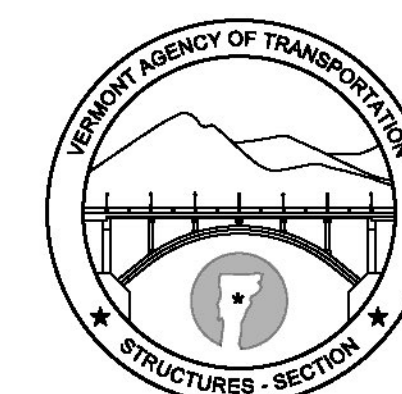


STRUCTURES
DETAIL
SD-502.00

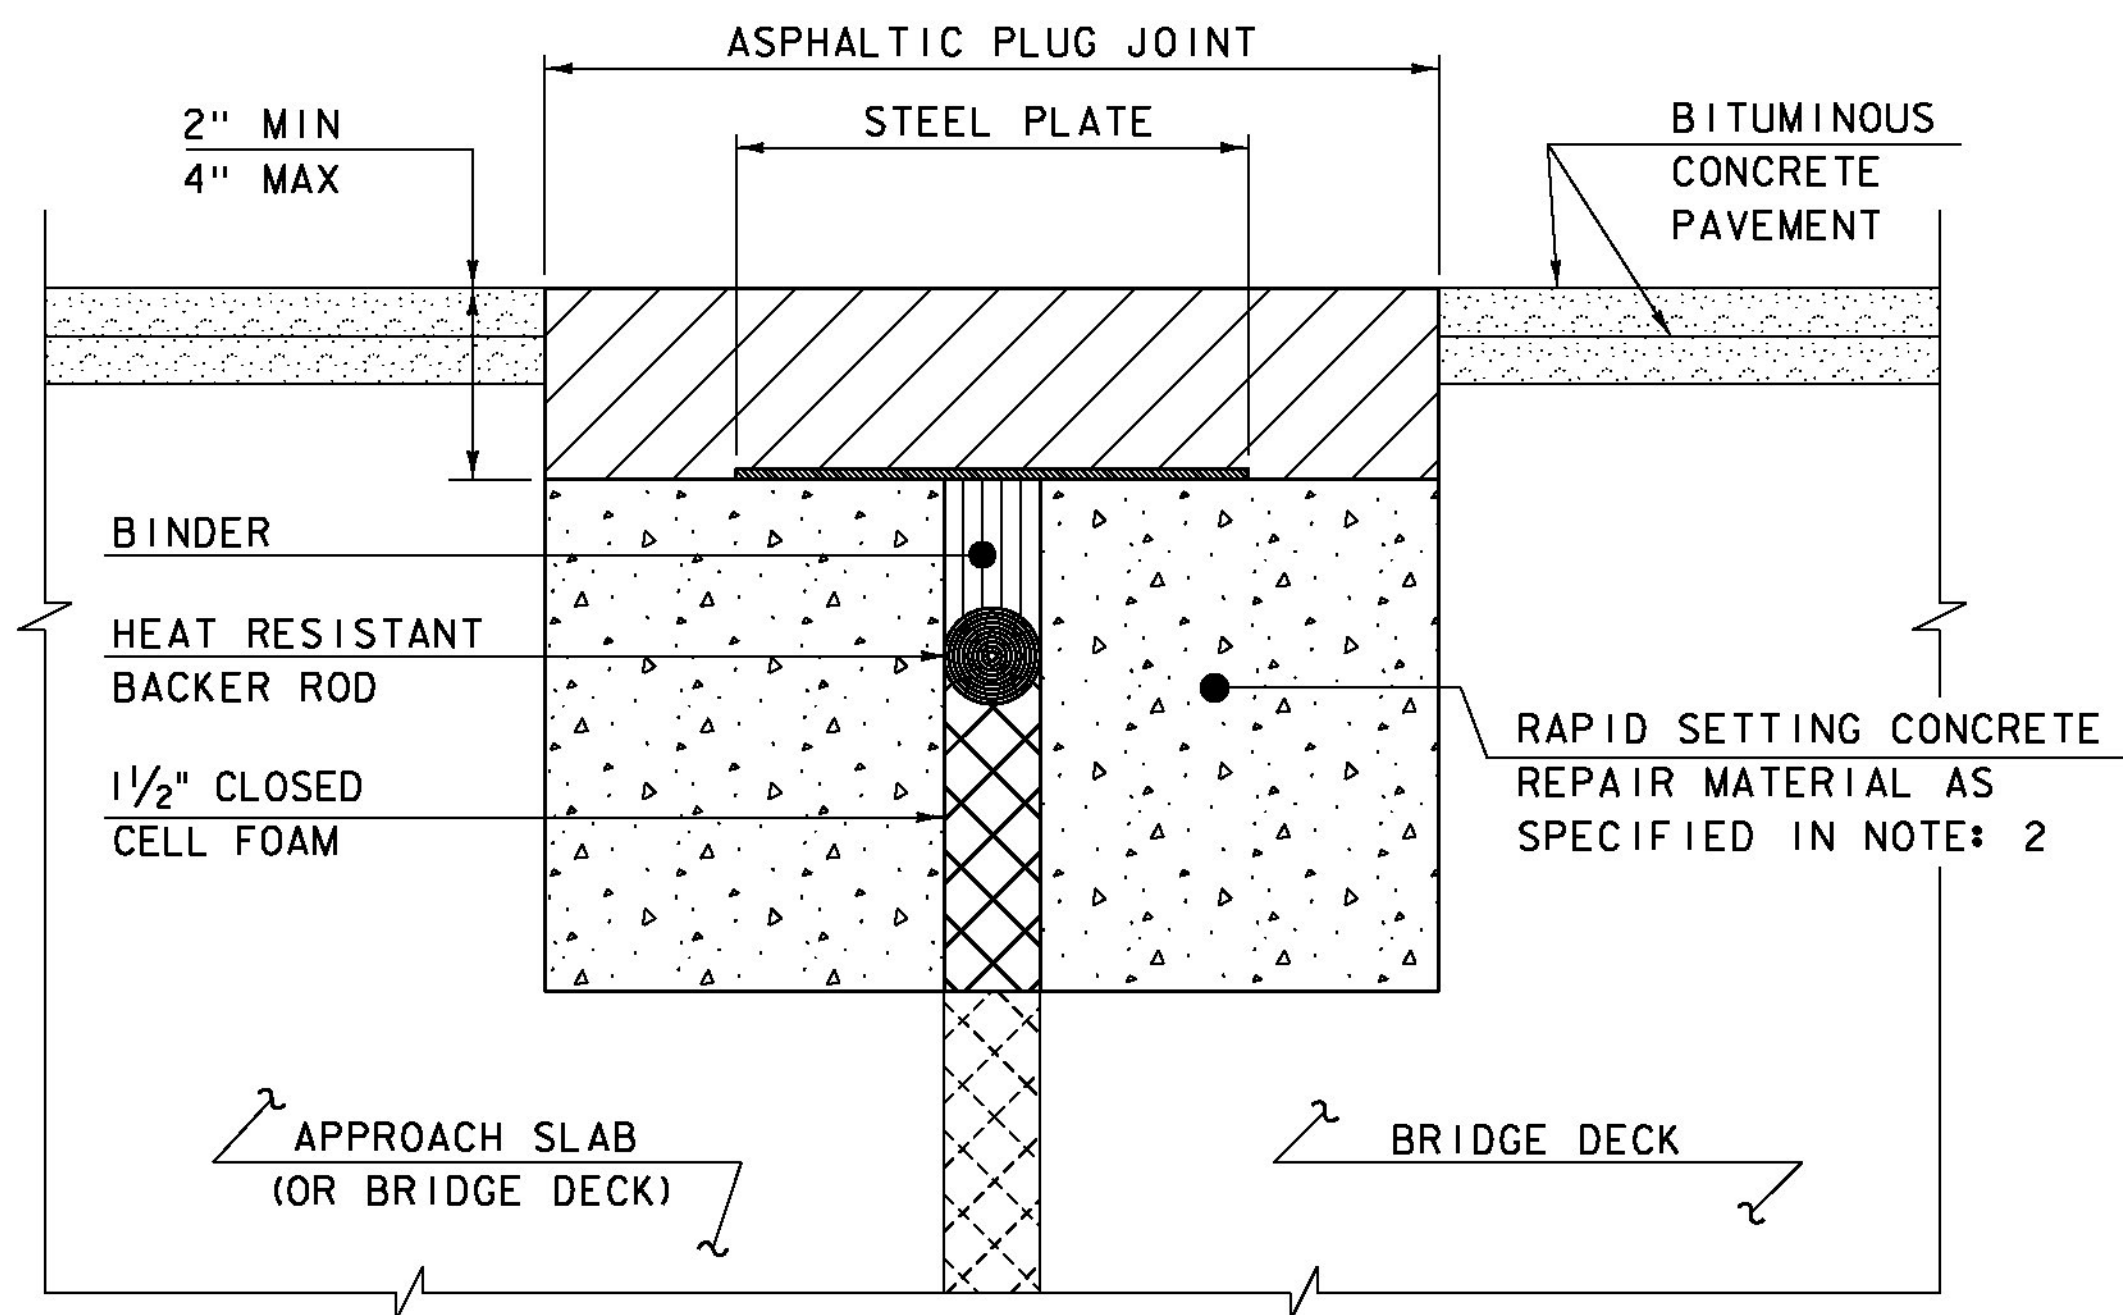

ASPHALTIC PLUG JOINT DETAIL - REHAB

NOTES:


1. THE CONTRACTOR SHALL REMOVE ALL ASPHALTIC PLUG JOINT MATERIAL AND DETERIORATED CONCRETE AS DIRECTED BY THE ENGINEER. REMOVAL OF THE FIRST 4 INCHES OF MATERIAL SHALL BE INCLUDED IN THE BID PRICE FOR ITEM 516.10 BRIDGE EXPANSION JOINT, ASPHALTIC PLUG. ANY REMOVAL OF MATERIAL GREATER THAN 4 INCHES SHALL BE INCLUDED IN THE BID PRICE OF ITEM 580.20 RAPID SETTING CONCRETE REPAIR MATERIAL WITH COARSE AGGREGATE.
2. THE CONTRACTOR SHALL REPLACE REMOVED MATERIAL THAT IS LESS THAN 4" FROM FINISHED GRADE WITH ASPHALTIC PLUG JOINT MATERIAL MEETING THE REQUIREMENTS OF SUBSECTION 707.15. ALL REMOVED MATERIAL THAT IS GREATER THAN 4 INCHES FROM FINISHED GRADE SHALL BE REPLACED WITH RAPID SETTING CONCRETE REPAIR MATERIAL WITH COARSE AGGREGATE MEETING THE REQUIREMENTS OF SUBSECTION 780.04.
3. REINFORCING STEEL NOT SHOWN FOR CLARITY.
4. PLACE 1/4" THICK BY 8" WIDE SECTIONS OF STEEL PLATE OVER THE CENTER OF THE MOVEMENT GAP. SECURE THE PLATES FROM MOVING BY INSERTING LOCATING PINS THROUGH THE PRE-STAMPED HOLES INTO BACKER ROD AND COVER WITH HOT BINDER. THE STEEL PLATES MAY BE OMITTED WHERE THE ENGINEER DETERMINES THAT THE APPROACH SLAB OR BRIDGE DECK WILL PROVIDE INADEQUATE SUPPORT AND WHERE VERTICAL MOVEMENT OF THE PLATES MIGHT OCCUR.

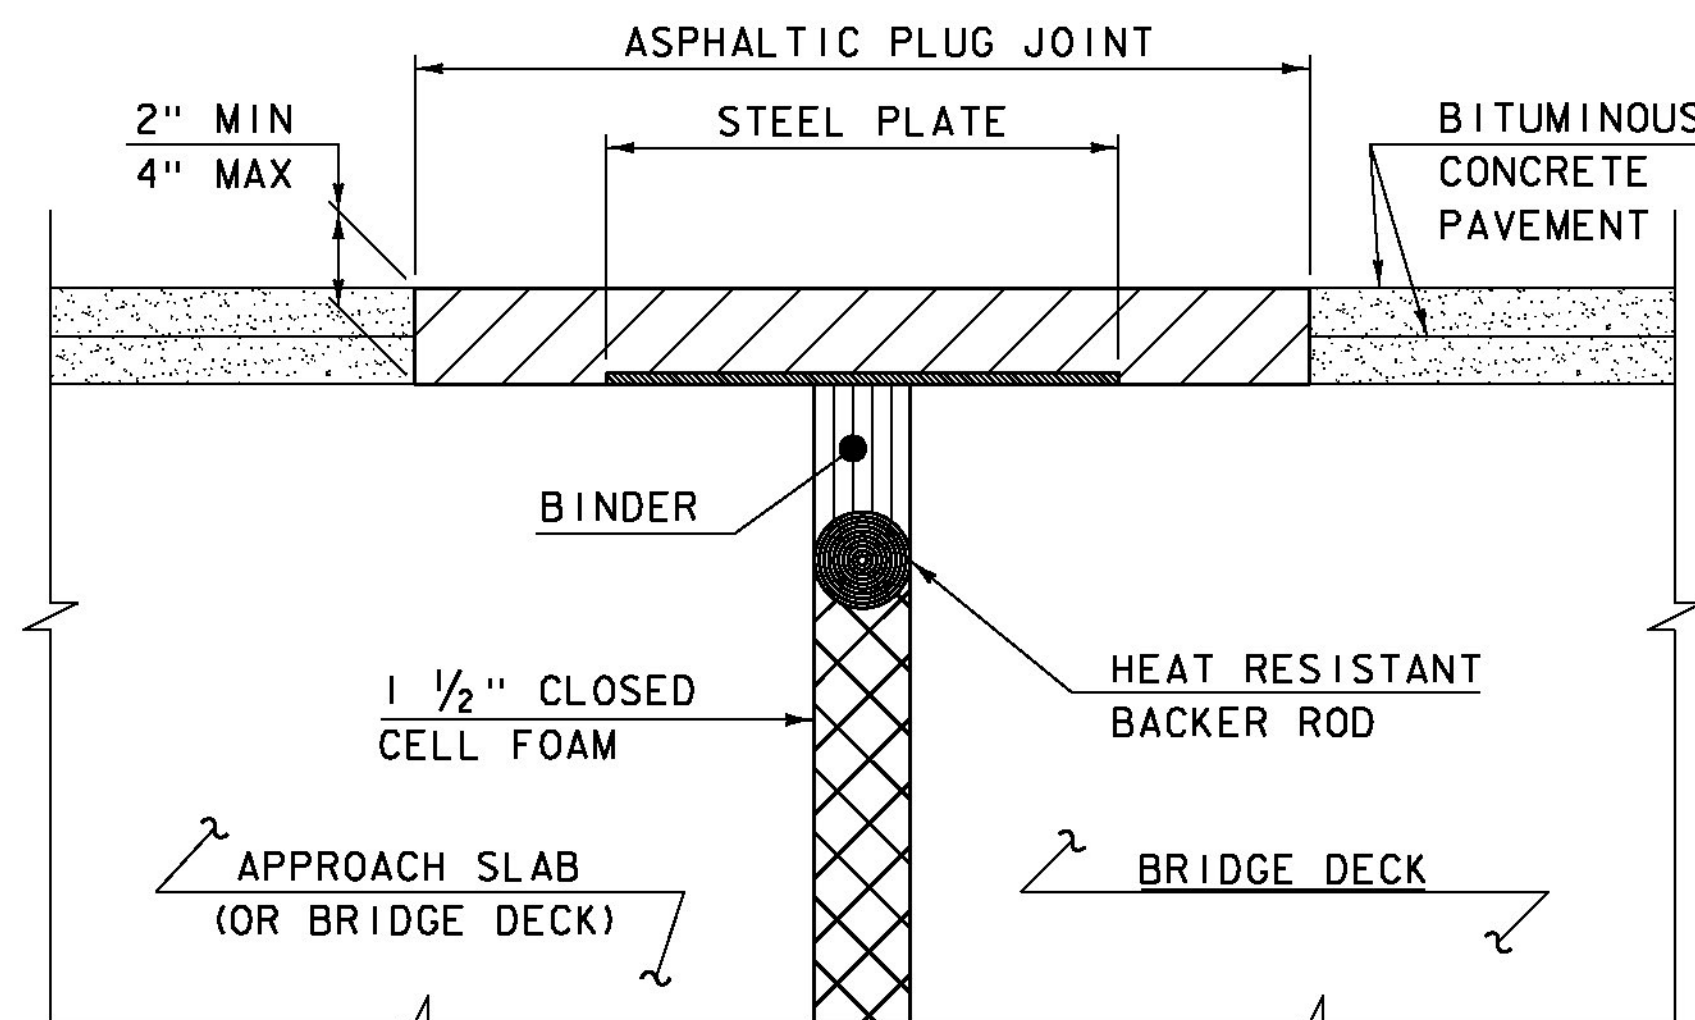

ASPHALTIC PLUG JOINT DETAIL "A" - NEW

NOTE:

PLACE 1/4" THICK BY 8" WIDE SECTIONS OF STEEL PLATE OVER THE CENTER OF THE MOVEMENT GAP. SECURE THE PLATES FROM MOVING BY INSERTING LOCATING PINS THROUGH THE PRE-STAMPED HOLES INTO BACKER ROD AND COVER WITH HOT BINDER.

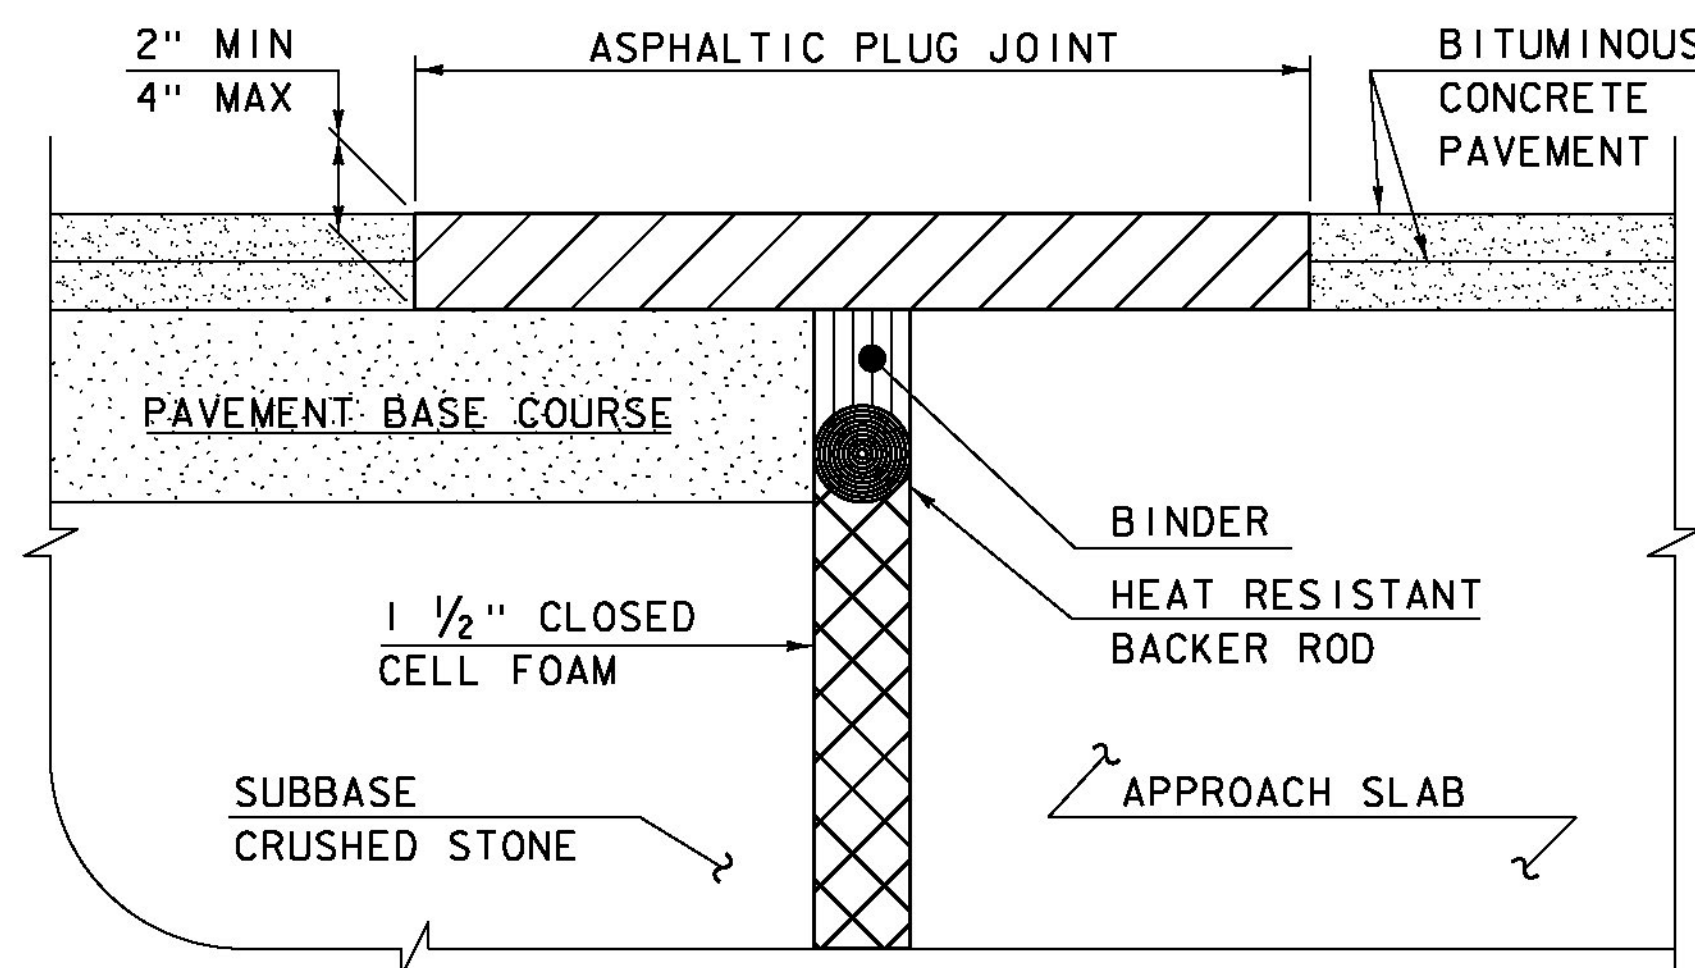

ASPHALTIC PLUG JOINT DETAIL "B" - NEW

ASPHALTIC PLUG JOINT NOTES

INSTALLATION:

1. LOCATE THE JOINT CENTRALLY OVER THE DECK OVERLAY EXPANSION GAP OR FIXED JOINT, MARKED OUT TO THE MANUFACTURER'S RECOMMENDED WIDTH.
2. REMOVE THE BITUMINOUS CONCRETE PAVEMENT FULL DEPTH AS SHOWN ON THE PLANS. THE PAVEMENT SHALL BE DRY AND SAW CUT TO THE LIMITS REQUIRED TO PLACE THE JOINT. A PNEUMATIC HAMMER AND CHISEL MAY BE USED ADJACENT TO THE CURB ONLY WHEN SAW CUTTING IS NOT POSSIBLE.
3. BLAST CLEAN THE JOINT AREA OF DEBRIS, ASPHALT AND SHEET MEMBRANE. THOROUGHLY DRY THE JOINT AREA WITH COMPRESSED AIR PRIOR TO APPLYING BINDER MATERIAL.
4. PLACE PROPERLY SIZED HEAT RESISTANT BACKER ROD IN THE MOVEMENT GAP ALLOWING FOR 1" +/- OF BINDER ABOVE THE ROD.
5. HEAT AND PLACE THE BINDER MATERIAL AS RECOMMENDED BY THE MANUFACTURER.
6. IMMEDIATELY AFTER TOP COATING, CAST AN ANTI-SKID MATERIAL OVER THE JOINT TO REDUCE THE RISK OF TRACKING.

WEATHER LIMITATIONS


APPLY BINDER MATERIAL ONLY WHEN THE FOLLOWING CONDITIONS PREVAIL OR AS RECOMMENDED BY THE MANUFACTURER:

1. THE AMBIENT AIR TEMPERATURE IS AT LEAST 10 DEG C (50 DEG F) AND RISING.
2. THE ROAD SURFACE IS DRY.
3. WEATHER CONDITIONS OR OTHER CONDITIONS ARE FAVORABLE AND ARE EXPECTED TO REMAIN SO FOR THE PERFORMANCE OF SATISFACTORY WORK.

DETAILS ON THIS SHEET ARE NOT TO SCALE.

REVISIONS	
MAY 7, 2010	APPROVED FOR USE BY VAOT STRUCTURES SECTION
AUGUST 29, 2011	ADD DETAIL "B" AND REV. NOTES


**BRIDGE JOINT
ASPHALTIC PLUG**

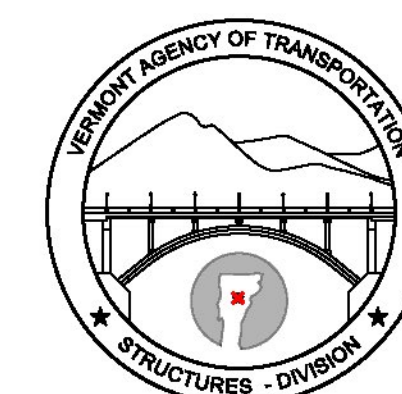

**STRUCTURES
DETAIL
SD-516.10**

STRUCTURAL STEEL GENERAL NOTES:


1. ALL FIELD CONNECTIONS SHALL BE MADE WITH 7/8" DIAMETER HIGH-STRENGTH BOLTS IN 15/16" DIAMETER HOLES, PER SUBSECTION 506.I9, UNLESS OTHERWISE SPECIFIED.
2. ALL HOLES IN THE WEBS OF THE FASCIA GIRDERS THAT ARE NOT OTHERWISE FILLED, SHALL BE FILLED WITH EITHER BUTT HEAD OR HEX HEAD BOLTS. THESE BOLTS SHALL BE TIGHTENED IN ACCORDANCE WITH SUBSECTION 506.I9.
3. ALL WELDING SHALL CONFORM TO THE PROVISIONS OF SUBSECTION 506.I0.
4. ANY CONNECTIONS THAT ARE NOT DETAILED ON THE PLANS SHALL BE DETAILED BY THE FABRICATOR AND SUBMITTED TO THE STRUCTURES ENGINEER FOR APPROVAL.
5. STRUCTURAL STEEL MEMBERS DESIGNATED "CVN" IN THE PLANS SHALL BE CHАРY V-NOTCH TESTED IN ACCORDANCE WITH SUBSECTION 714.01 OF THE STANDARD SPECIFICATIONS.
6. ENDS OF GIRDERS ARE TO BE VERTICAL IN THEIR FINAL POSITION.
7. AFTER SUPERSTRUCTURE STEEL HAS BEEN ERECTED, ELEVATIONS ALONG THE TOP OF THE GIRDERS SHALL BE TAKEN AS DIRECTED BY THE RESIDENT ENGINEER FOR USE IN DETERMINING FINISHED GRADES.

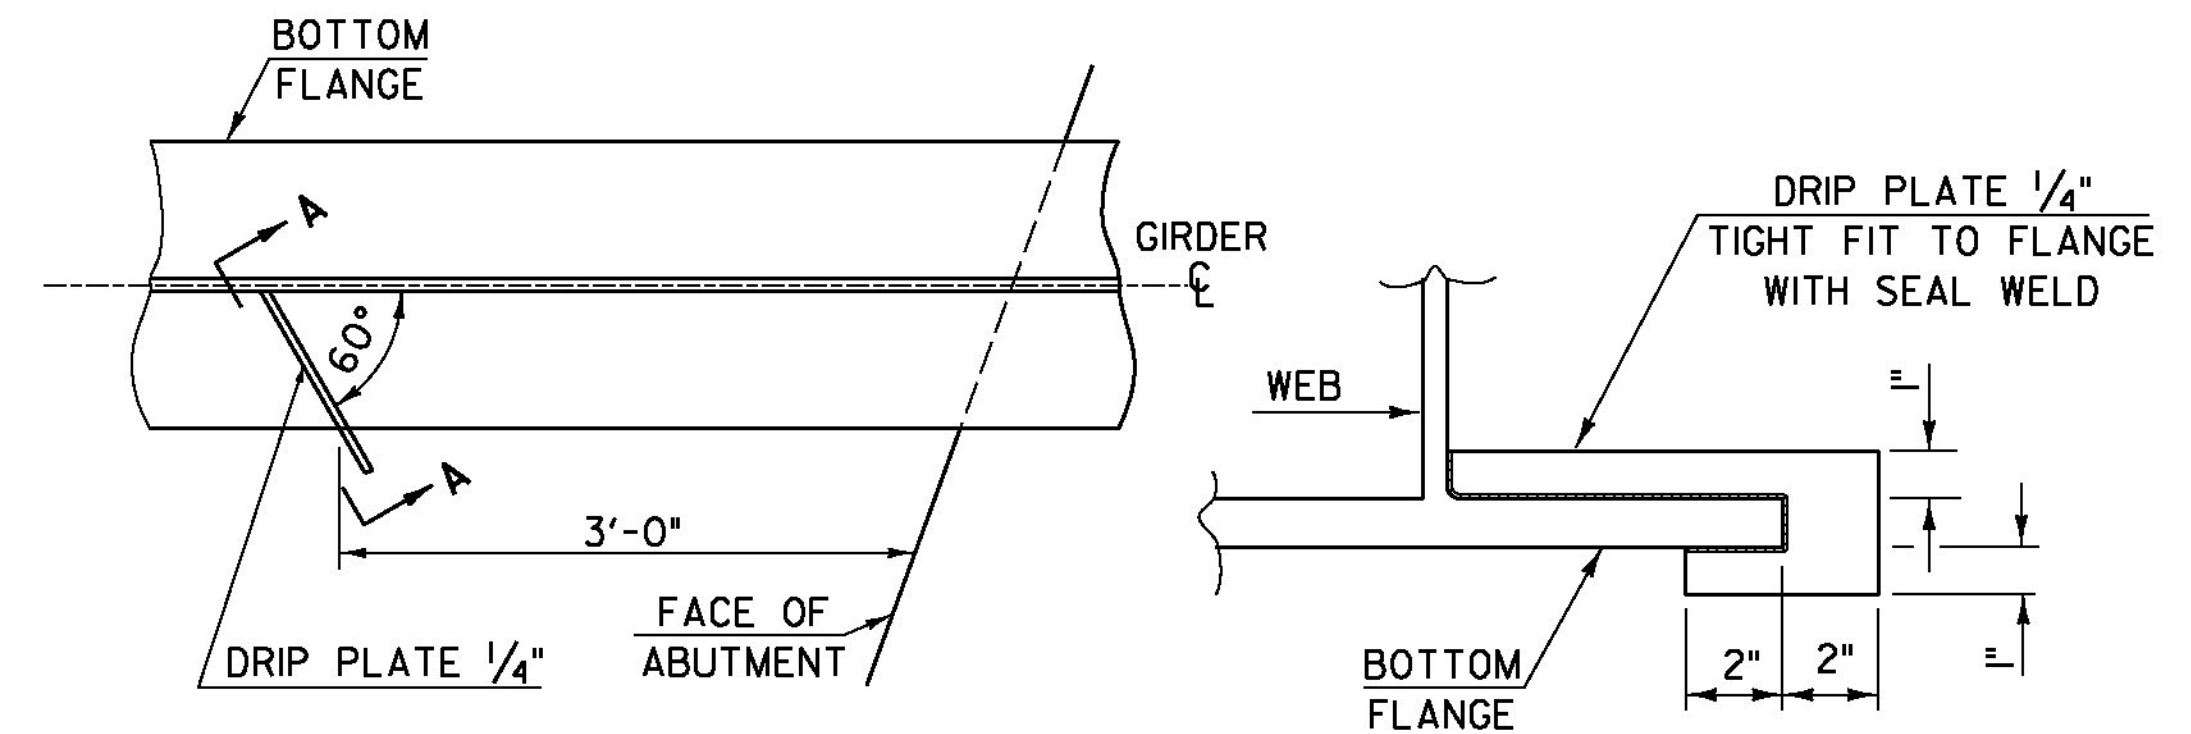

PLAN DRIP PLATE


SECTION A - A

NOTE: DRIP PLATES SHALL BE PLACED ON OUTSIDE EDGE OF FASCIA GIRDERS ON THE HIGH SIDE OF ALL PIERS AND ABUTMENTS OR AS INDICATED ON PROJECT PLANS.

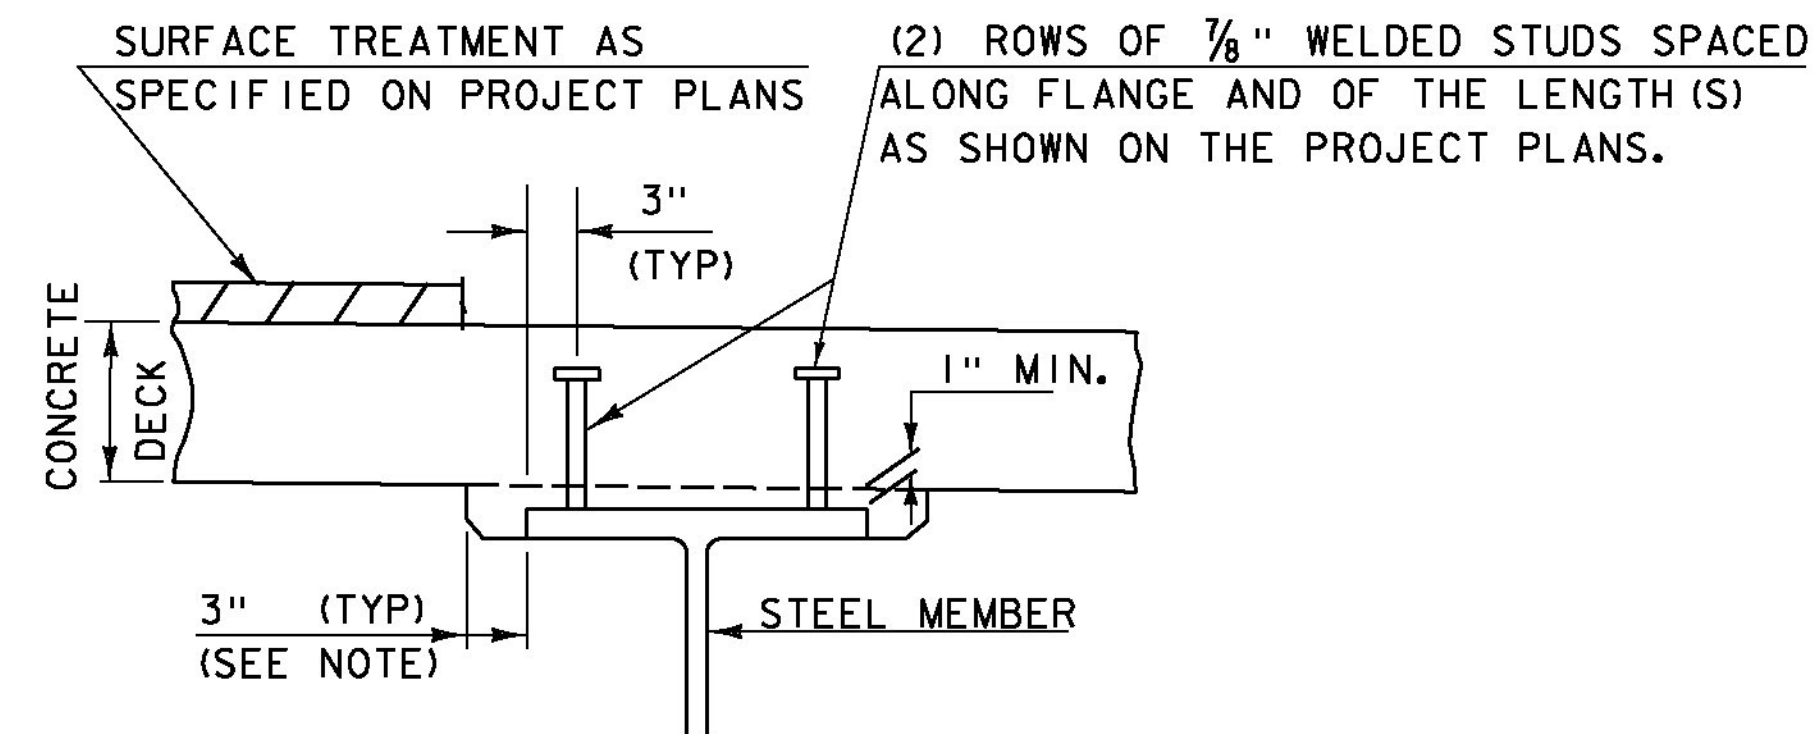

NOTE:
THE 3" HORIZONTAL SECTION MAY BE ELIMINATED FOR FORMING SYSTEMS DESIGNED FOR THE CONSTRUCTION OF VERTICAL HAUNCHES. ANY VOIDS RESULTING FROM FORMING SYSTEM ELEMENTS SHALL BE FILLED WITH JOINT SEALER, POLYURETHANE MEETING THE REQUIREMENTS OF SECTION 524. THE COST OF THE JOINT SEALER, POLYURETHANE SHALL BE INCIDENTAL TO THE ADJACENT CONCRETE.


HAUNCH AND SHEAR CONNECTOR DETAIL

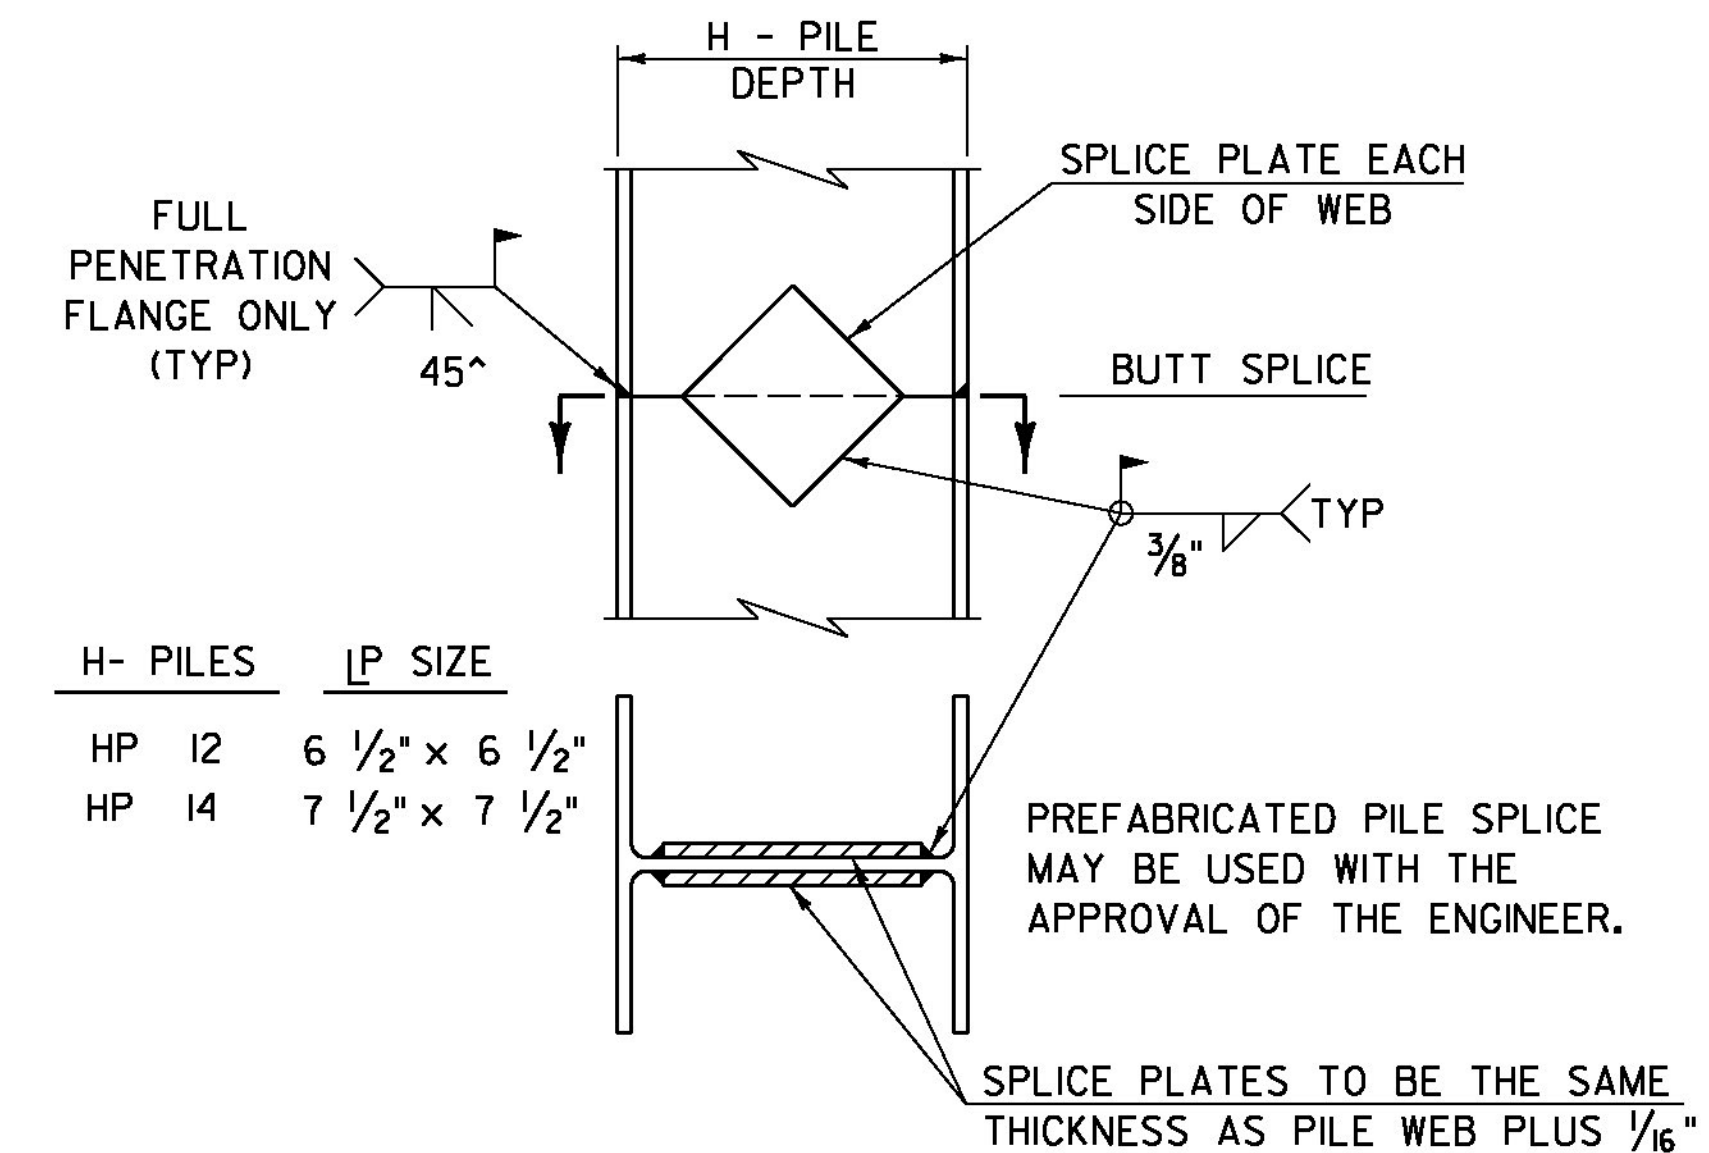

DETAIL OF PILE SPLICE

DETAILS ON THIS SHEET ARE "NOT TO SCALE" UNLESS NOTED OTHERWISE.


**STRUCTURAL STEEL
DETAILS & NOTES**

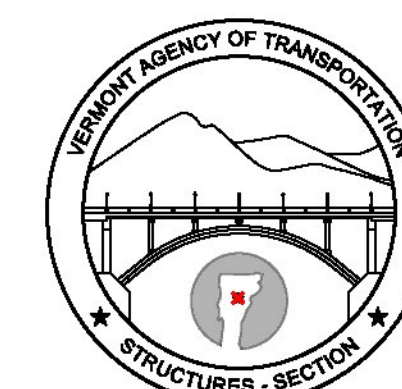

**STRUCTURES
DETAIL
SD-601.00**


REVISIONS

MAY 7, 2010	APPROVED FOR USE BY VAOT STRUCTURES SECTION
JUNE 4, 2010	MODIFIED NOTES

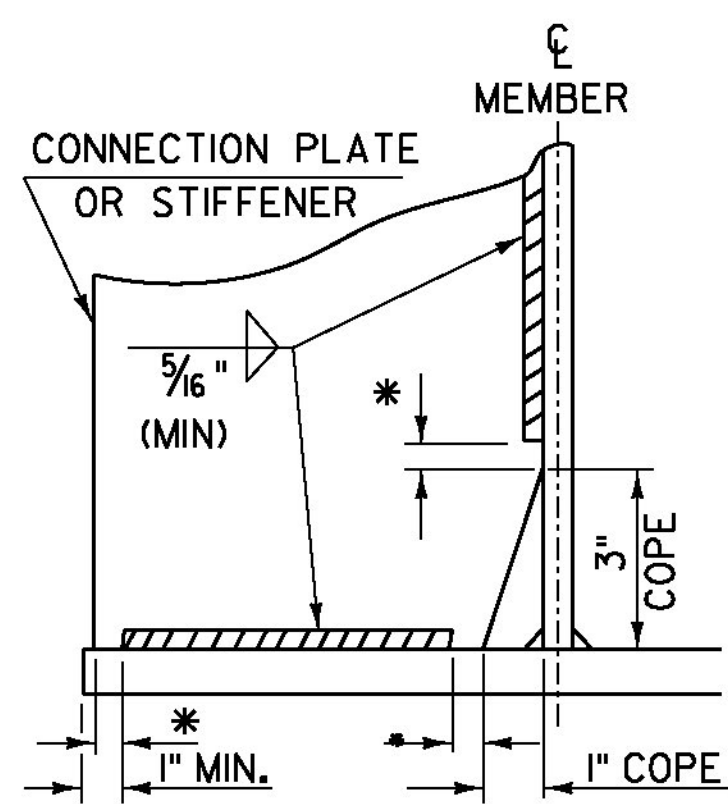


WELD TERMINATION AND COPING
DETAILS FOR STEEL MEMBERS

*NO WELD FOR 3/8" MIN. 7/8" MAX. (EXCEPT MUST MAINTAIN 1" MINIMUM FROM EDGE OF FLANGE)

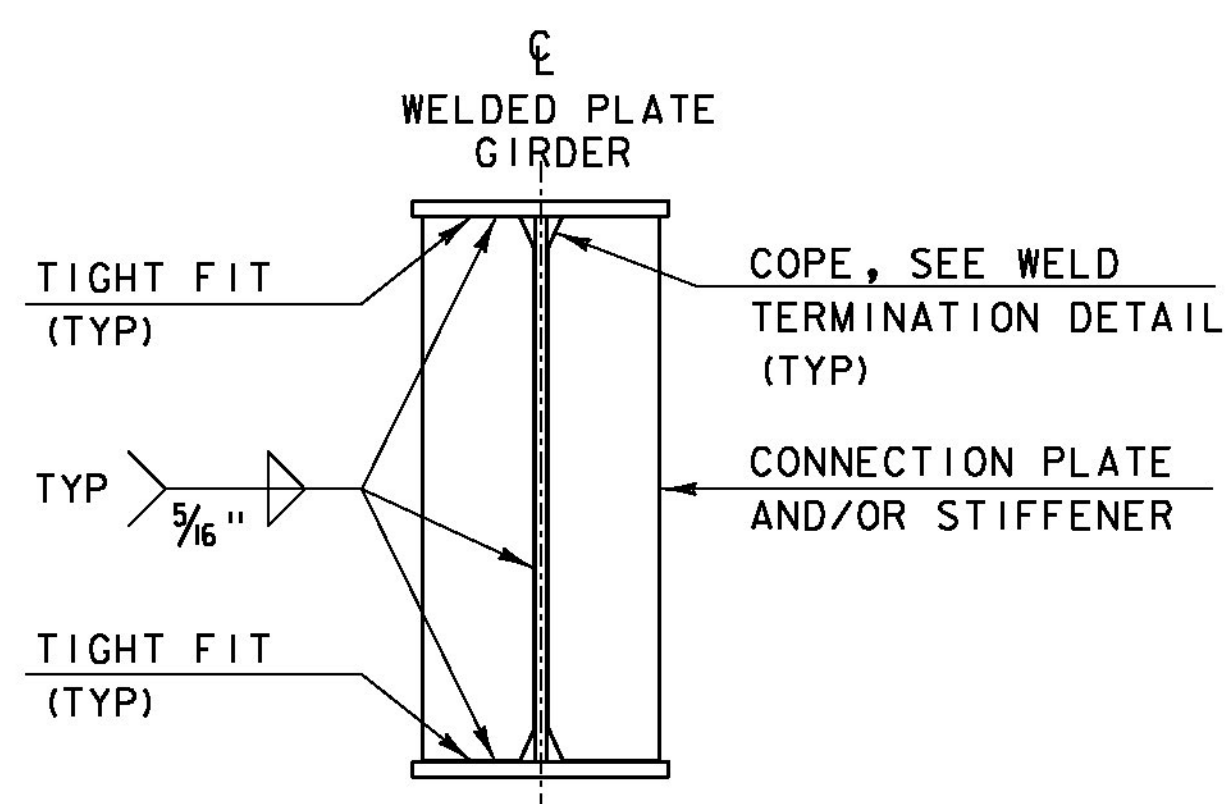


INTERMEDIATE CONNECTION PLATES
AND/OR STIFFENERS FOR WELDED
PLATE GIRDERS


INTERMEDIATE DETAIL IS ONLY USED WHEN PLATE DOES NOT OCCUR AT AN ABUTMENT OR PIER.

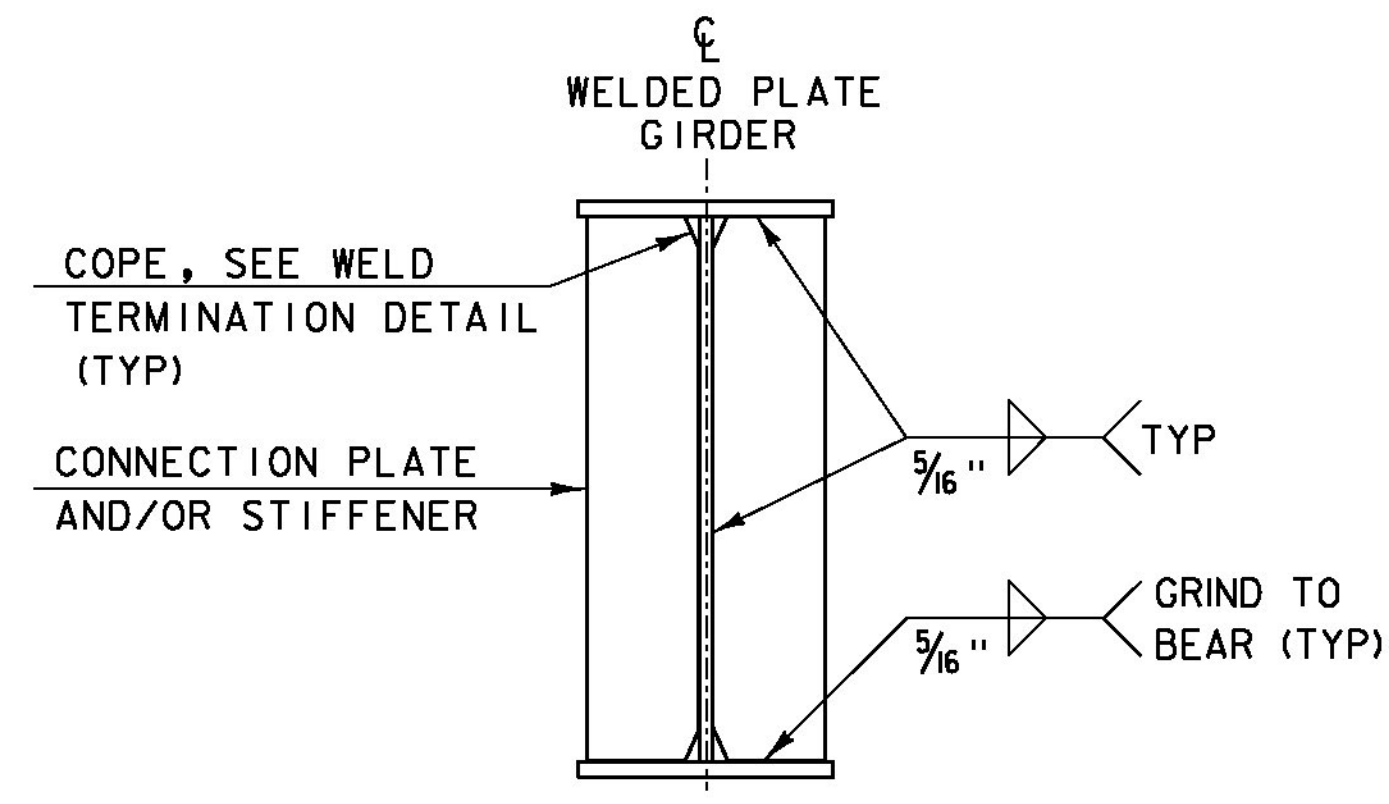

ABUTMENT BEARING STIFFENERS
AND/OR CONNECTION PLATES
FOR WELDED PLATE GIRDERS

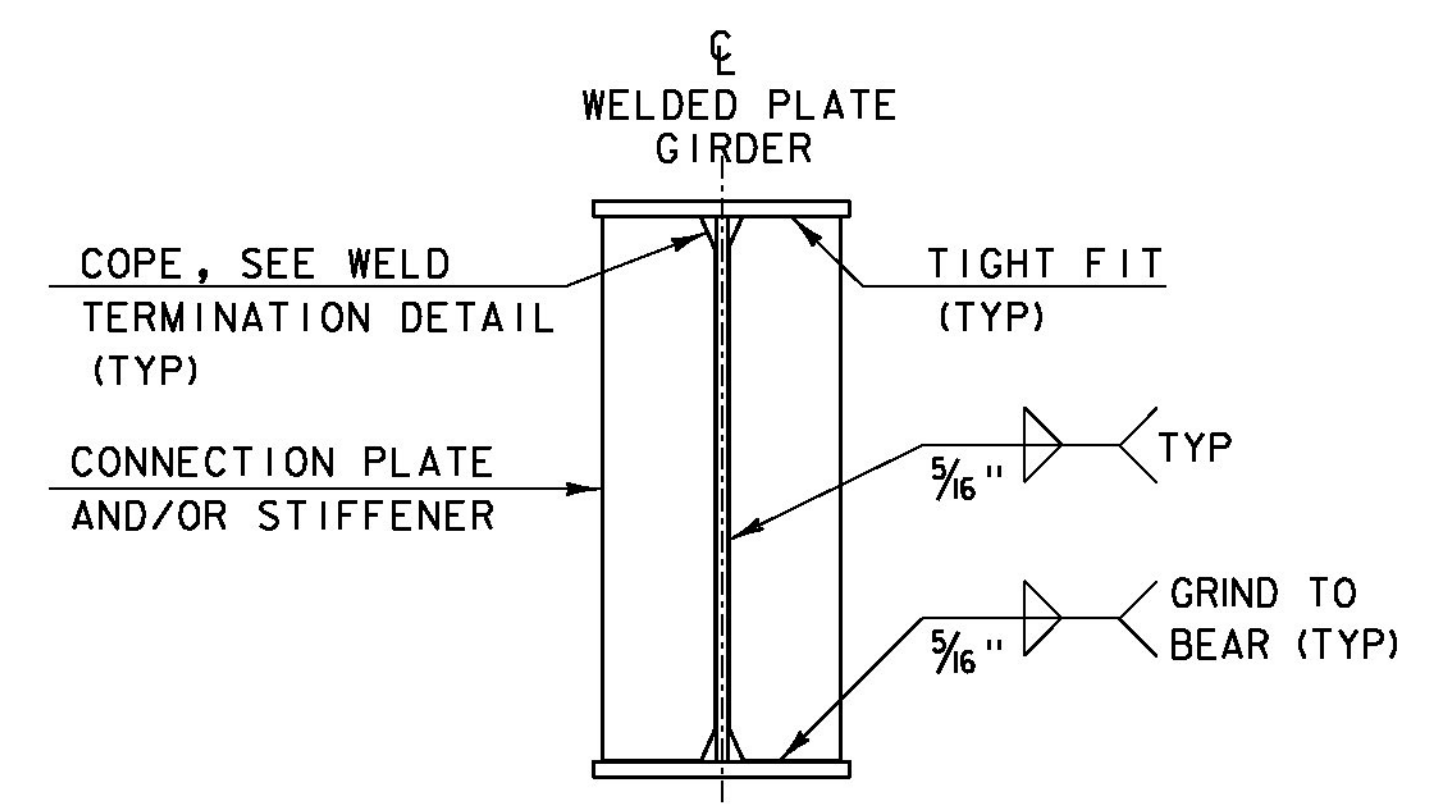


PIER BEARING STIFFENERS
AND/OR CONNECTION PLATES
FOR WELDED PLATE GIRDERS

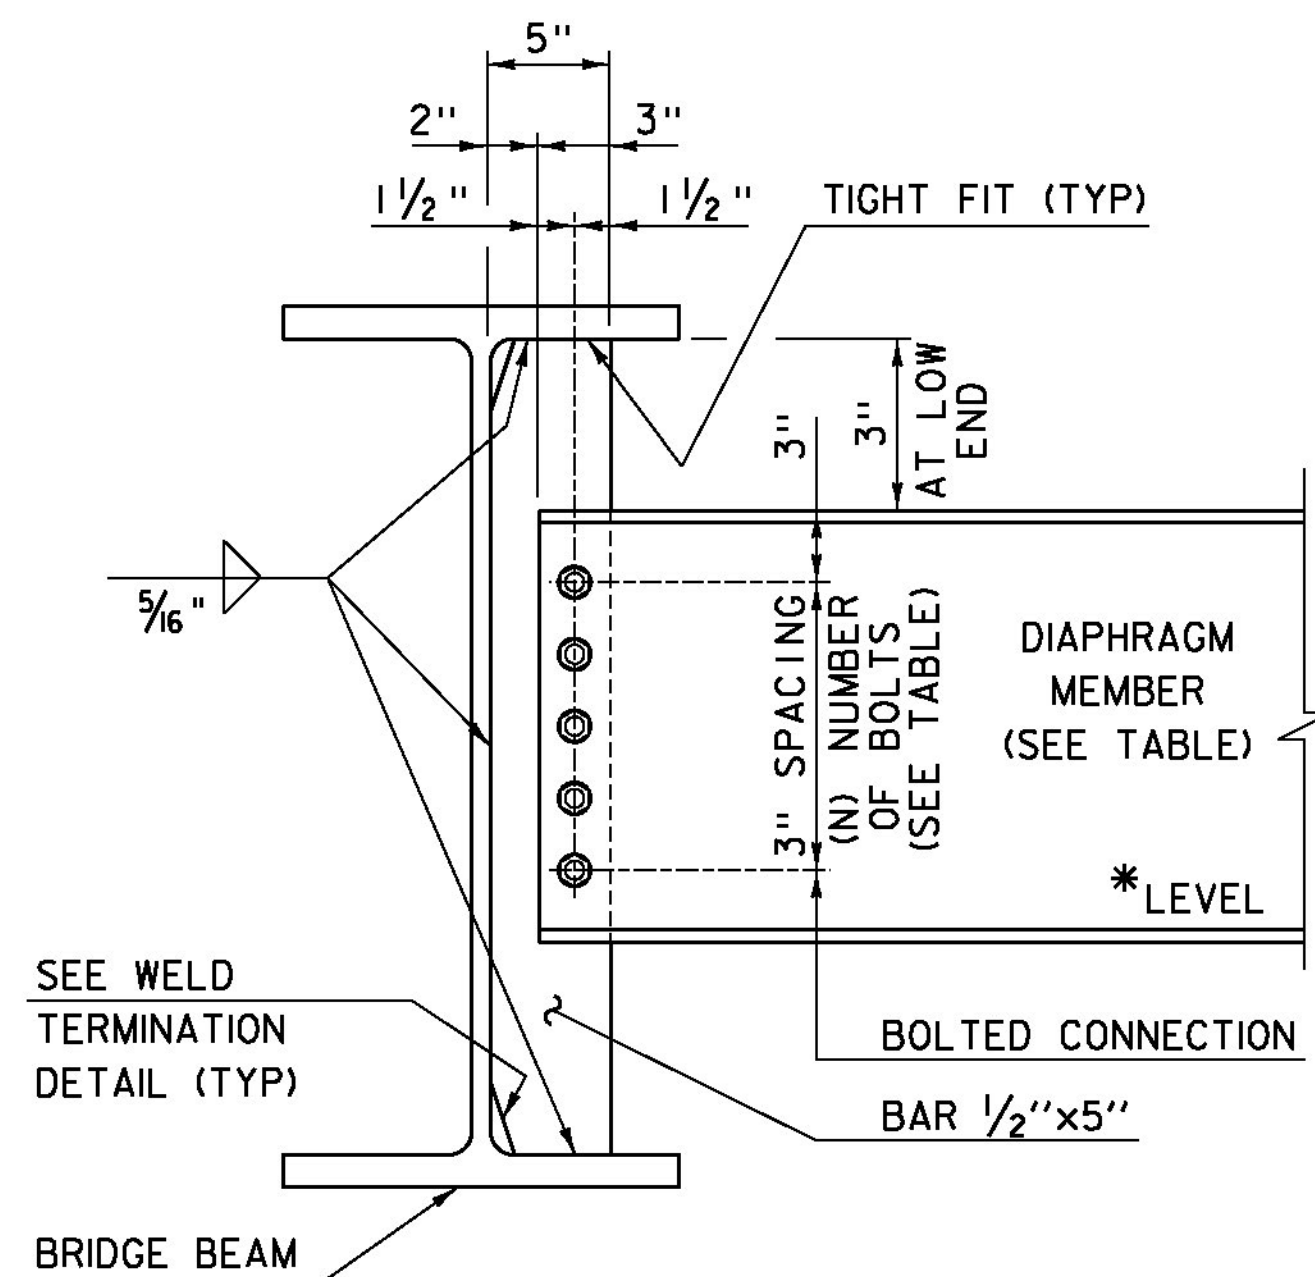


INTERMEDIATE DIAPHRAGMS
FOR 24" TO 48" BRIDGE BEAMS

* IF CLEARANCE CANNOT BE MET, DIAPHRAGM MAY BE SLOPED.

	DEPTH	DIAPHRAGM MEMBER	(N) BOLTS
ROLLED BEAM	24"	C15x33.9	4
	30"		
	31"	MCI8x42.7	5
	36"		
PLATE GIRDER WEB	37"	W21x44	6
	42"		
	31"	W27x84	7
	36"		
PLATE GIRDER WEB	37"	W33x118	9
	42"		
	43"	W36x135	10
48"			

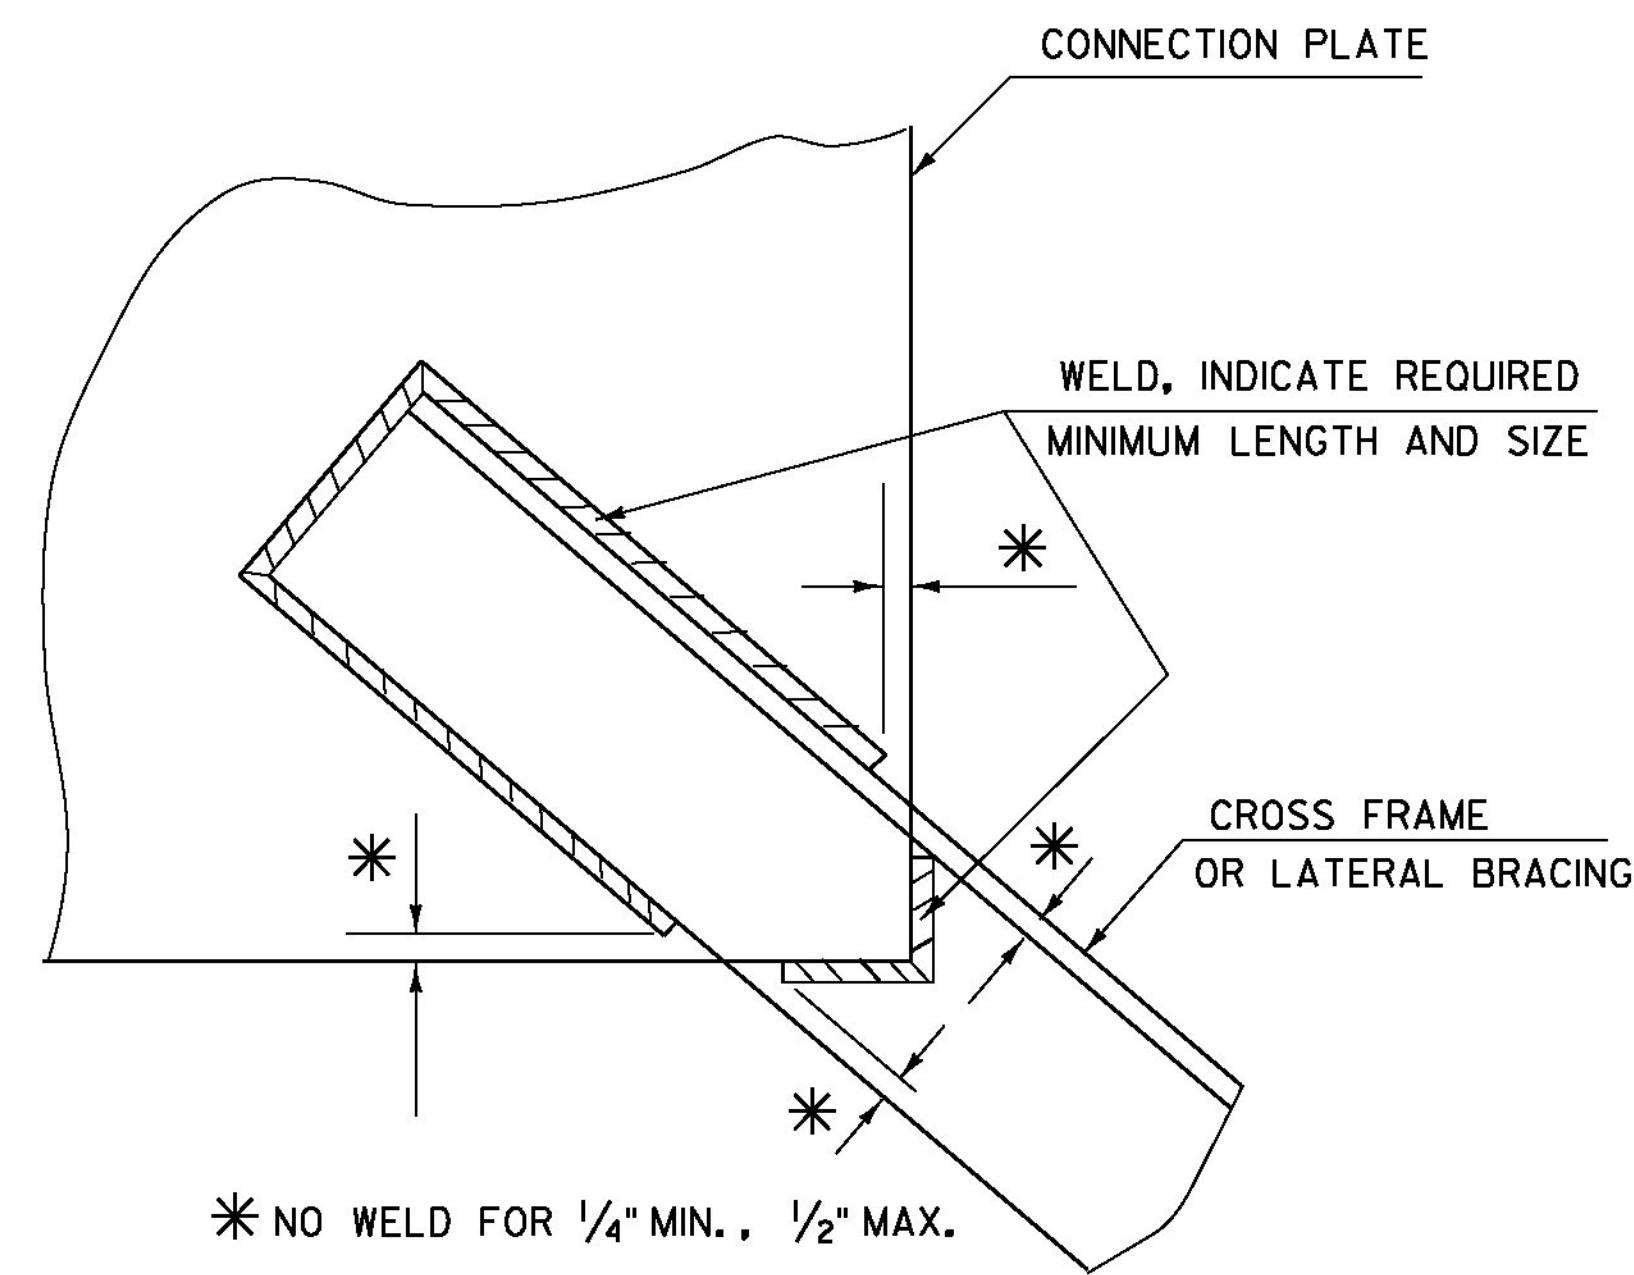

WELD LOCATION DETAIL AT CROSS
FRAMES AND LATERAL BRACING

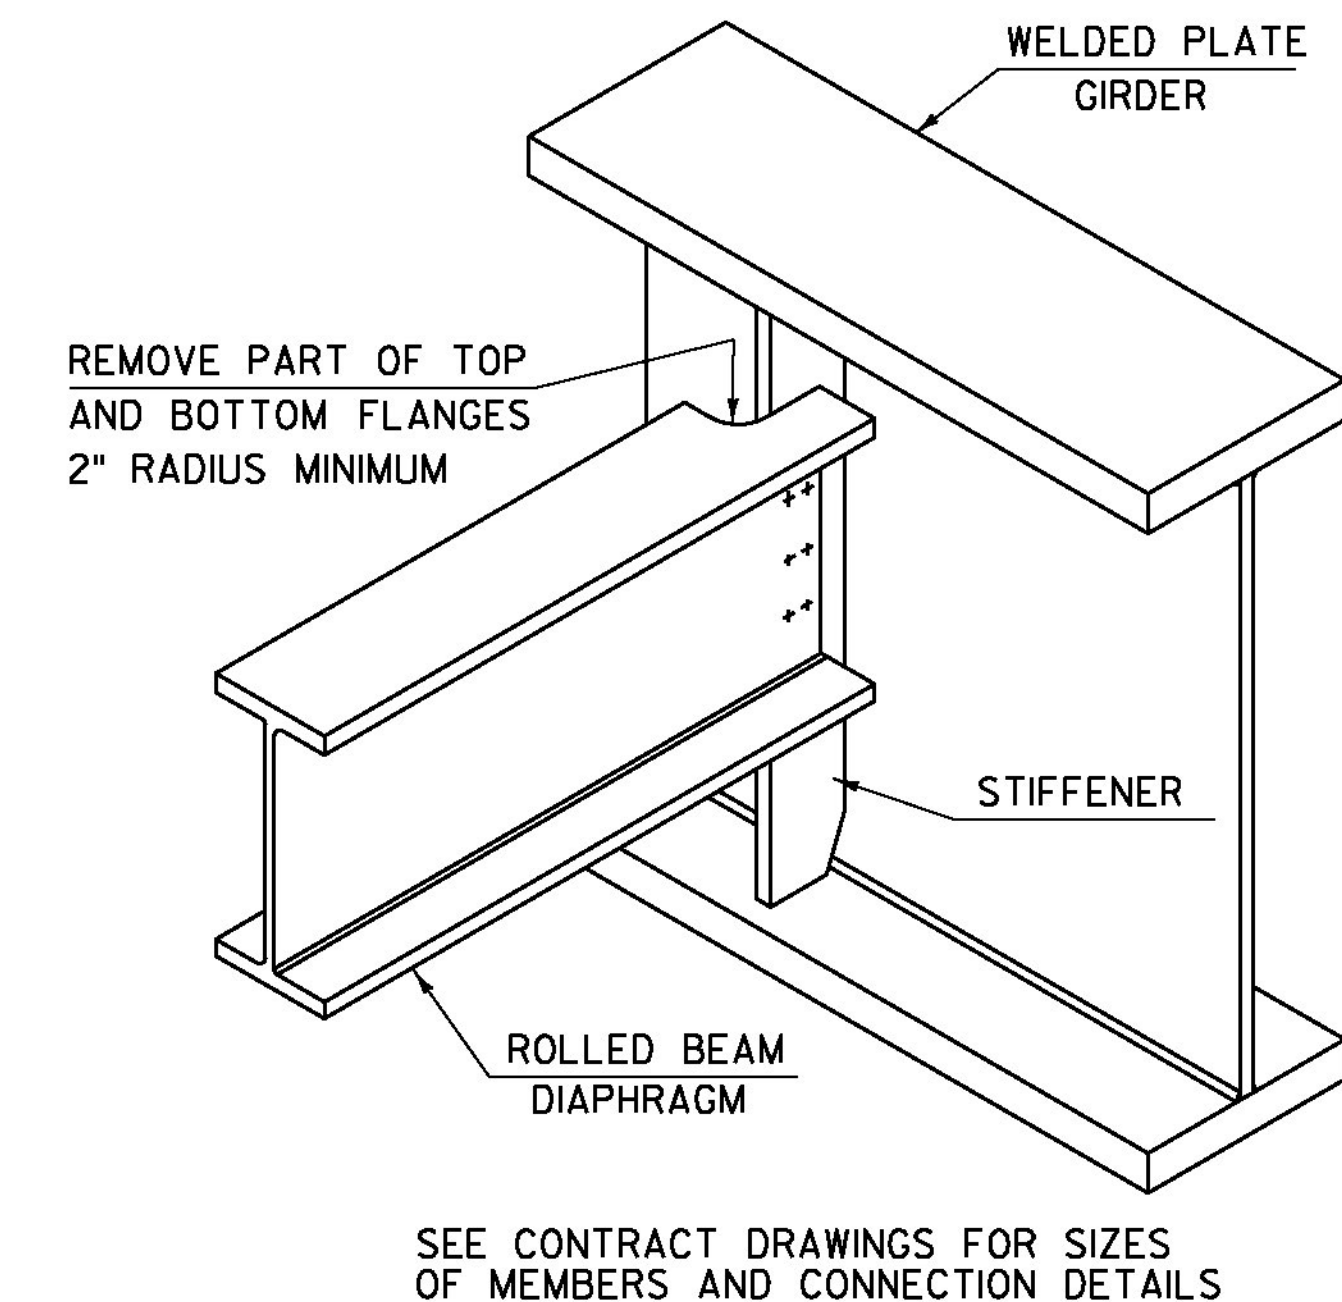


ROLLED BEAM USED AS DIAPHRAGM

DETAILS ON THIS SHEET ARE "NOT TO SCALE" UNLESS NOTED OTHERWISE.

REVISIONS

MAY 7, 2010	APPROVED FOR USE BY VAOT STRUCTURES SECTION
MAY 2, 2011	ADD INTERMEDIATE DIAPHRAGMS DETAIL & ADD NOT TO SCALE NOTE

**STRUCTURAL STEEL PLATE
GIRDER DETAILS AND NOTES**

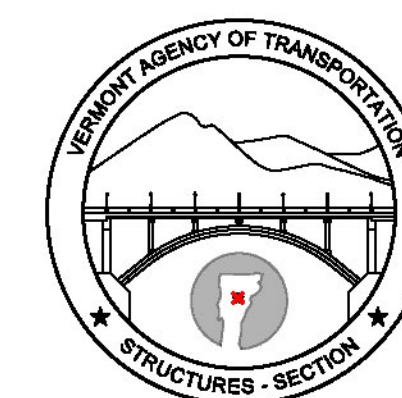

**STRUCTURES
DETAIL
SD-602.00**


Vermont Agency of Transportation

RECEIVED


CK'D BY FDB OK'D BY HIS

May 19, 2015


RESUBMIT NO Approved
 BY Carolyn Carlson DATE 05/21/2015

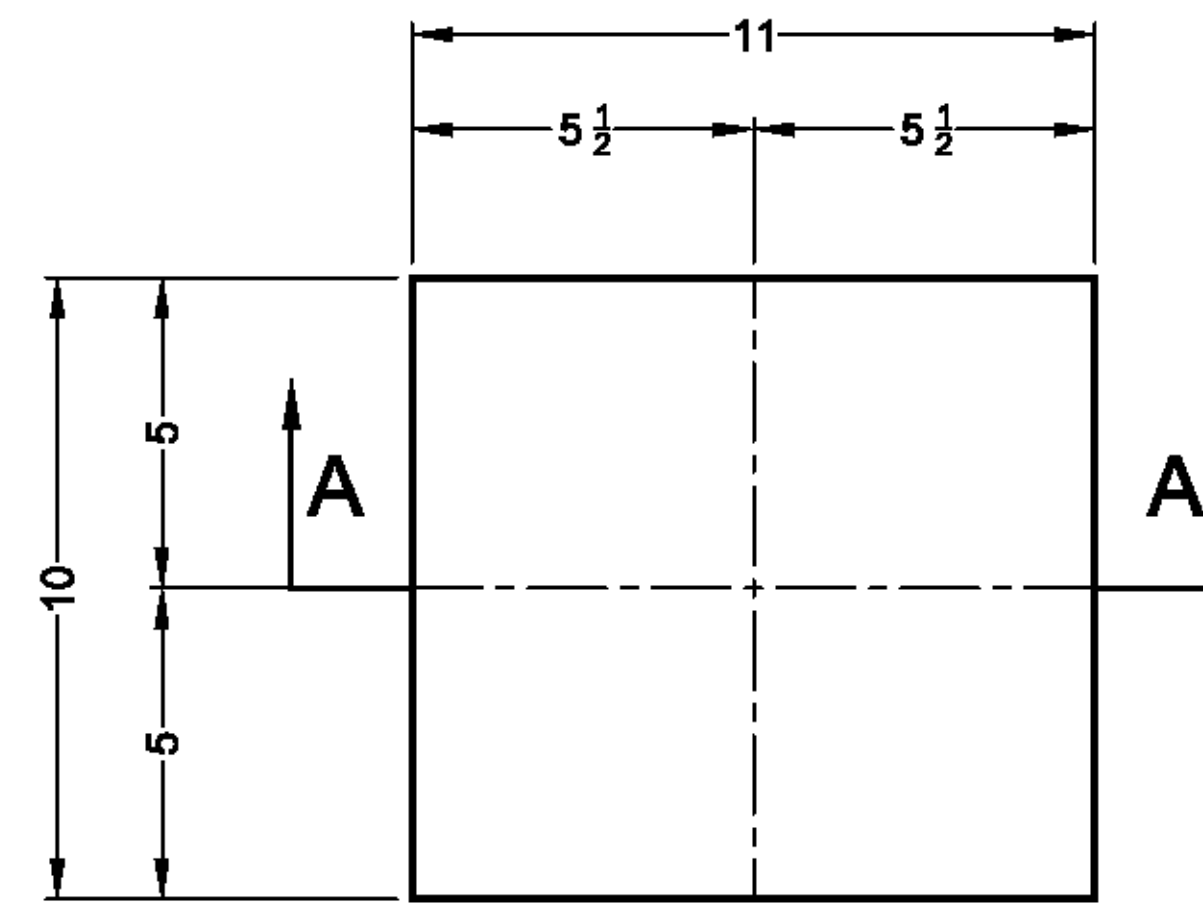

PLAN VIEW

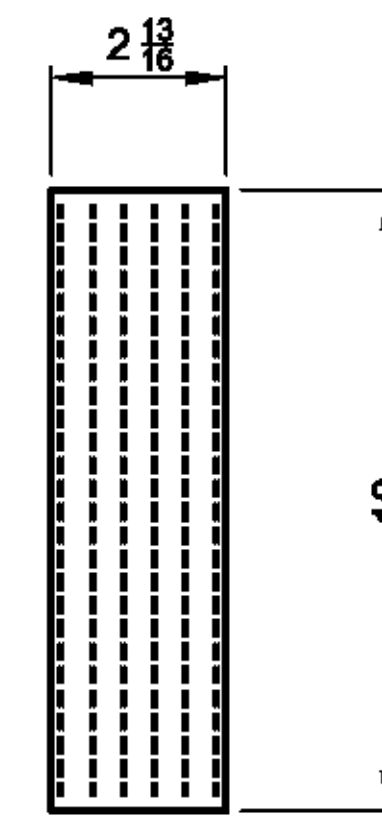

SIDE VIEW

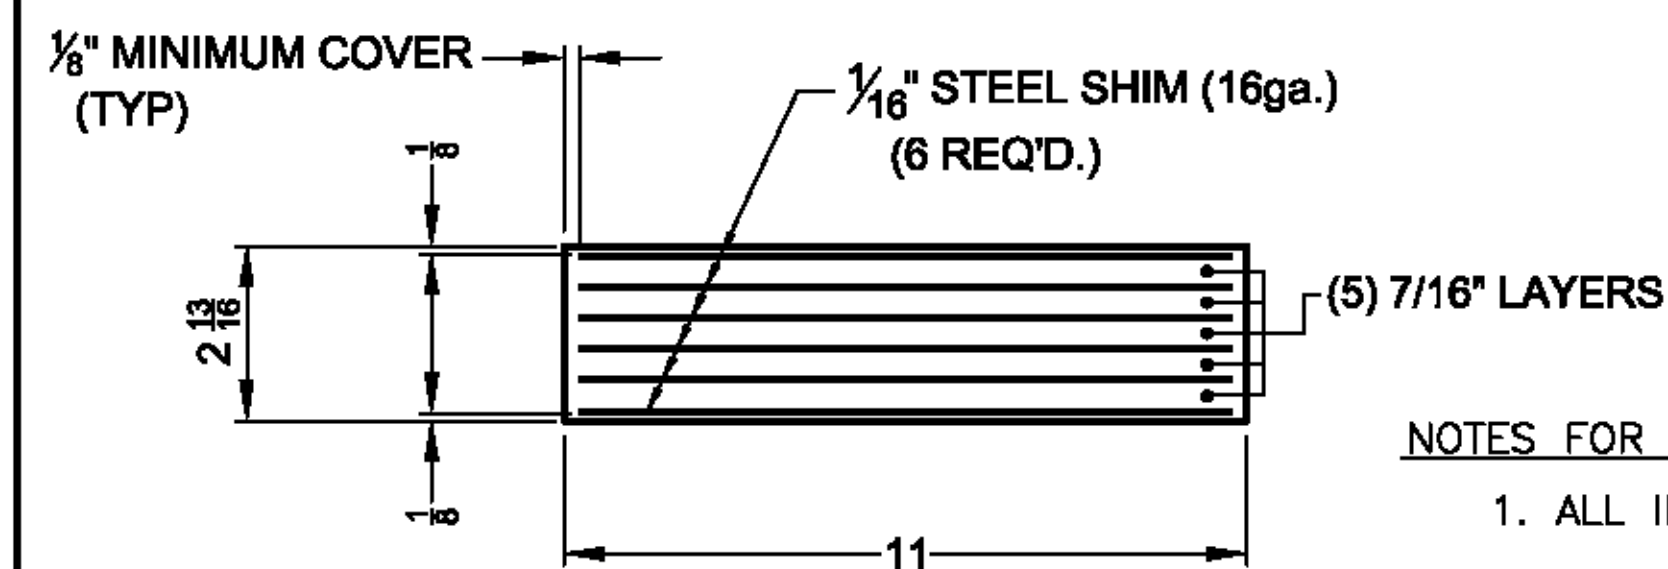


SECTION A-A

QTY. REQ'D. = 8

NOTES FOR LAMINATED ELASTOMERIC BEARING PADS (ITEM NO. 531.17):

1. ALL INTERNAL STEEL SHIMS SHALL BE ASTM A1011 GRADE 36
2. BEARINGS TO BE MANUFACTURED ACCORDING TO AASHTO LRFD STANDARD SPECIFICATIONS FOR HIGHWAY BRIDGES, SECTION 14 & 18, 17th. EDITION, 2002 AND 2010 INTERIMS. BEARINGS SHALL ALSO CONFORM TO VT AOT APPLICABLE SUBSECTIONS OF SECTIONS 531 AND 731.
3. ELASTOMERIC NATURAL RUBBER MATERIAL TO BE 50+/-5 DUROMETER HARDNESS, GR. 4
4. ALL STEEL PRODUCED IN THE U.S.A.
5. THE BEARINGS ARE DESIGNED SO THAT THE SUPERSTRUCTURE MAY BE ERECTED WHEN THE AMBIENT AIR TEMPERATURE IS WITHIN THE RANGE OF 40 DEG. F. TO 90 DEG. F.
6. ALL LOOSE STEEL SHIMS SHALL BE ASTM GRADE 36 AND SHALL BE GALVANIZED.

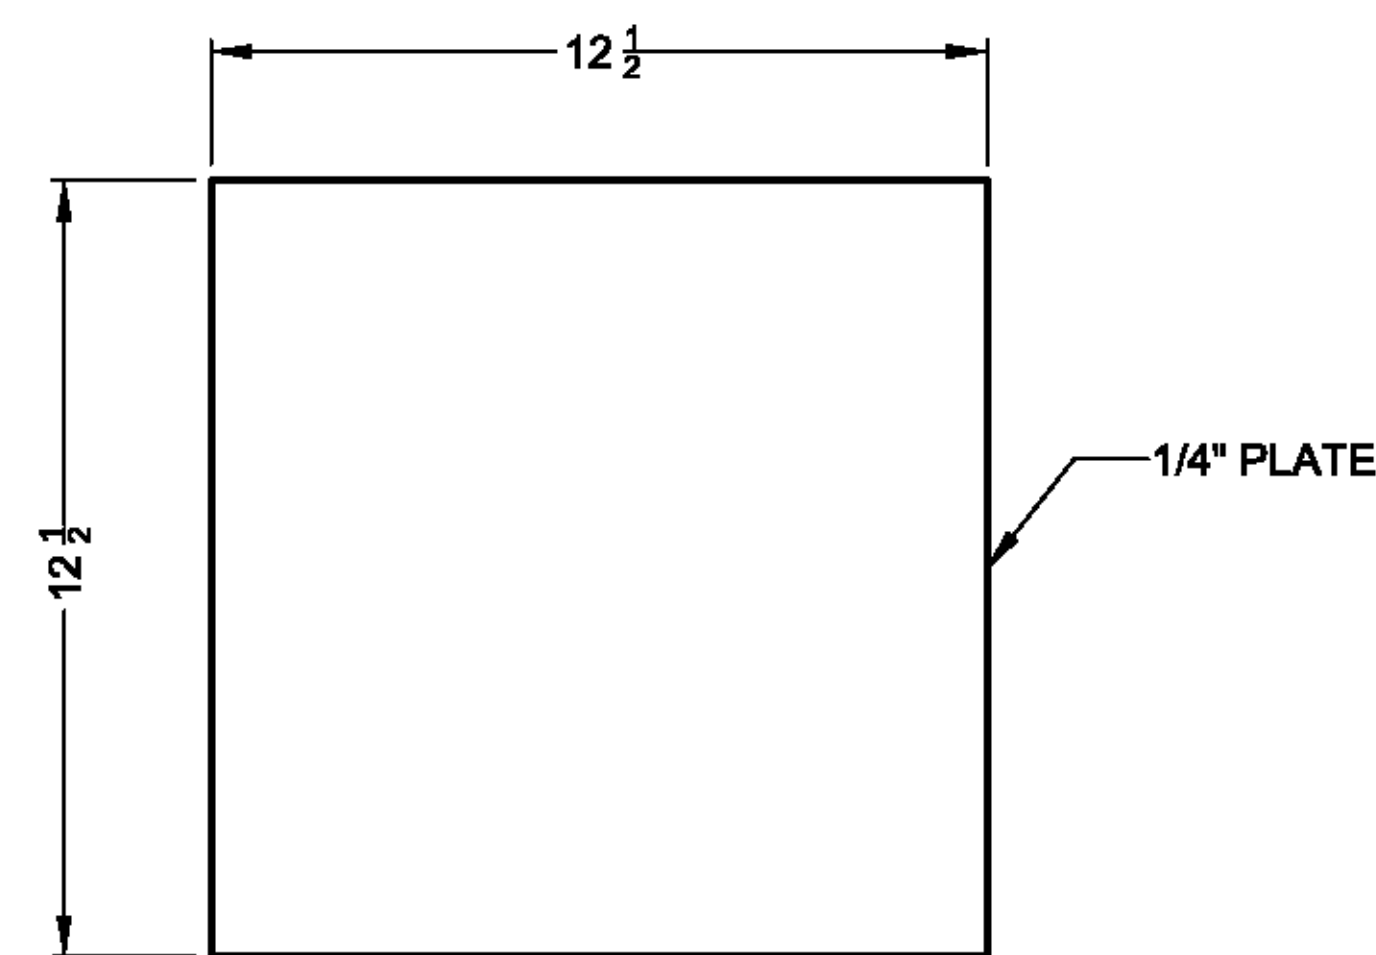

SHIM PLATE

QTY. REQ'D. = 8
 GALVANIZED

VERMONT AOT
 TOWN OF MIDDLESEX
 WASHINGTON COUNTY, VERMONT

PROJECT NO. : BRF-024-1 (37)

ROUTE NO. : VT 12 BRIDGE NO. : 77

STEEL REINFORCED ELASTOMERIC BEARING
 PAD & LOOSE SHIM DETAILS


AMSCOT
 STRUCTURAL PRODUCTS CORP.

SCALE: N.T.S. APPR'D: BF DRAWN BY: E.J.G.
 DATE: 4/21/15 REVISION: 0

FOR: A.L. St. ONGE

DWG NO: AS015C1R0 SHEET 1 OF 1


REVISIONS					
ZONE	REV	DESCRIPTION	REVISED BY	DATE	APPROVED

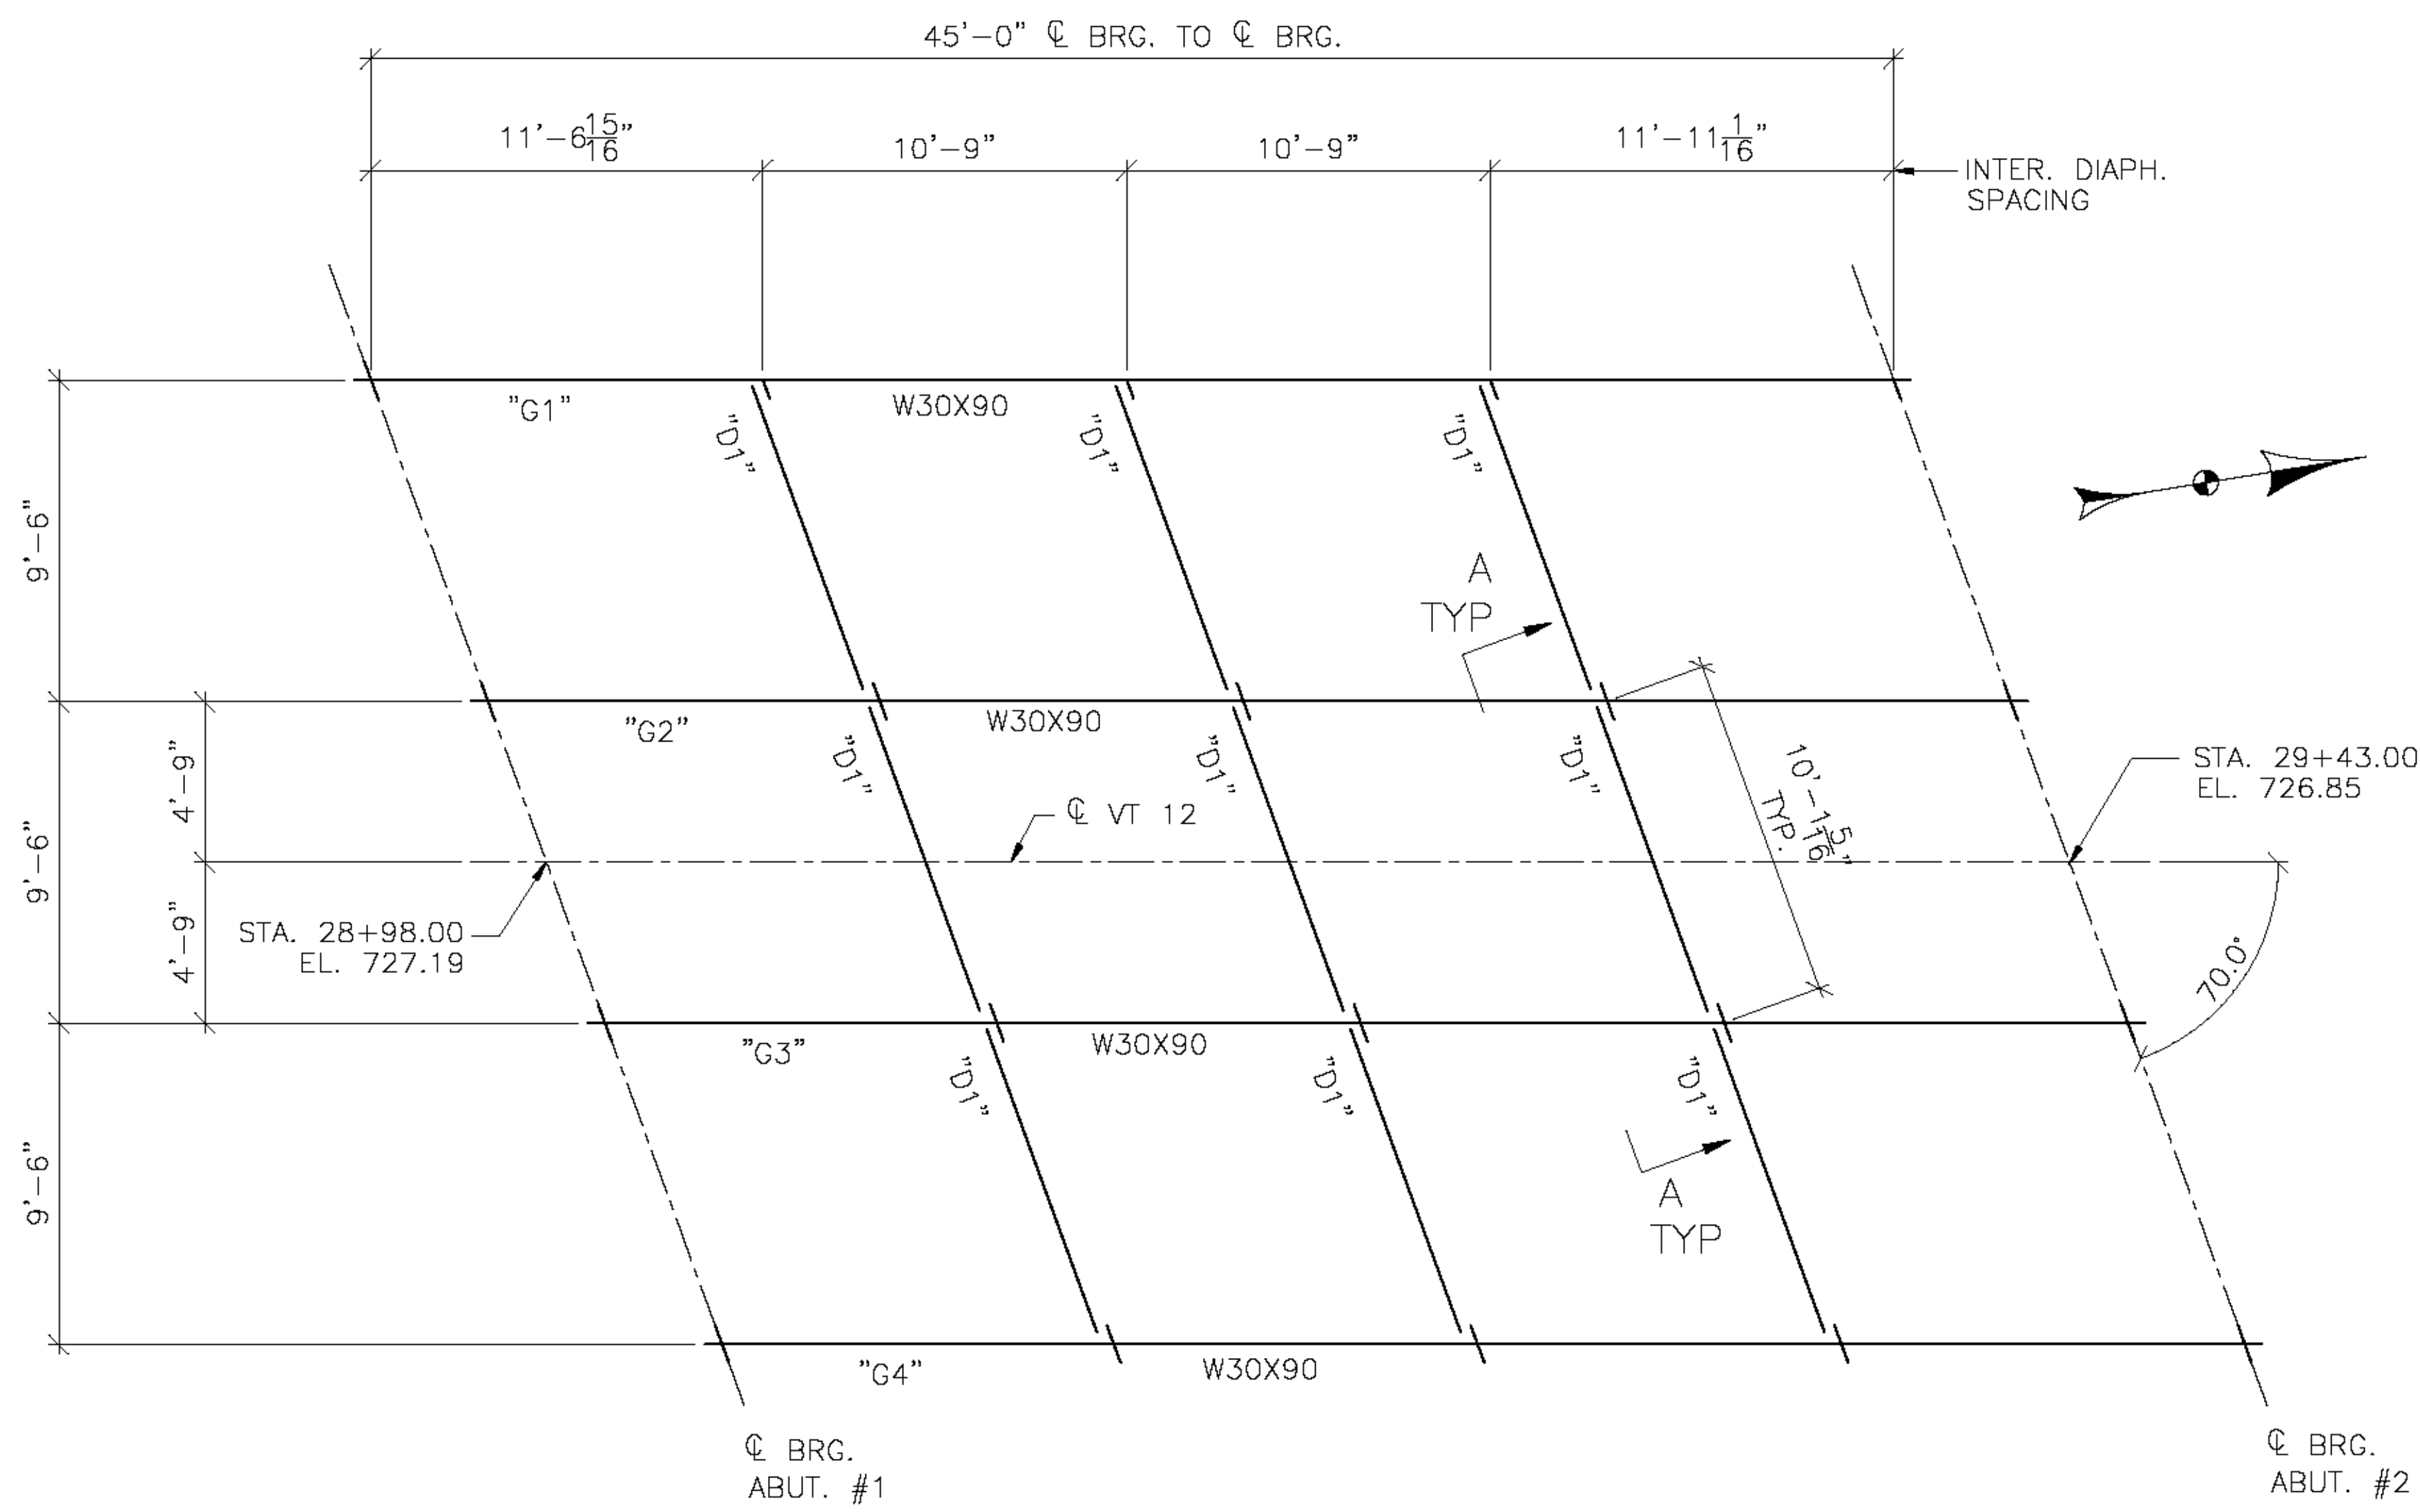

FRAMING PLAN

GENERAL NOTES:

- ALL MATERIALS AND CONSTRUCTION SHALL CONFORM TO STATE OF VERMONT AGENCY OF TRANSPORTATION'S STANDARD SPECIFICATIONS FOR CONSTRUCTION, DATED 2011, AND IT'S LATEST REVISIONS, AND THE AASHTO LRFD BRIDGE DESIGN SPECIFICATIONS, 5TH EDITION AND IT'S LATEST REVISIONS.
- ALL MATERIAL SHALL CONFORM TO AASHTO M270 (ASTM A709) GRADE 50. ALL MATERIAL NOTED "CVN" SHALL MEET THE CHARPY V-NOTCH TESTING REQUIREMENTS OF ZONE 2, H FREQUENCY: 15 FT.-LB AT 40' F. NDT MUST BE ACCORDING TO ANSI/AASHTO/AWS D1.5, SECTION 6
- ALL BOLTS SHALL BE 7/8"Ø IN 15/16"Ø HOLES AND CONFORMING TO ASTM A325, TYPE 1 WITH RO-CAP TESTING AND MECHANICALLY GALVANIZED. INCLUDING ADDITIONAL BOLT TESTING PER VTRANS SUBSECTION 714.05
- ALL STEEL SHALL BE GALVANIZED IN ACCORDANCE WITH VTRANS SUBSECTION 726.08 AFTER FABRICATION.

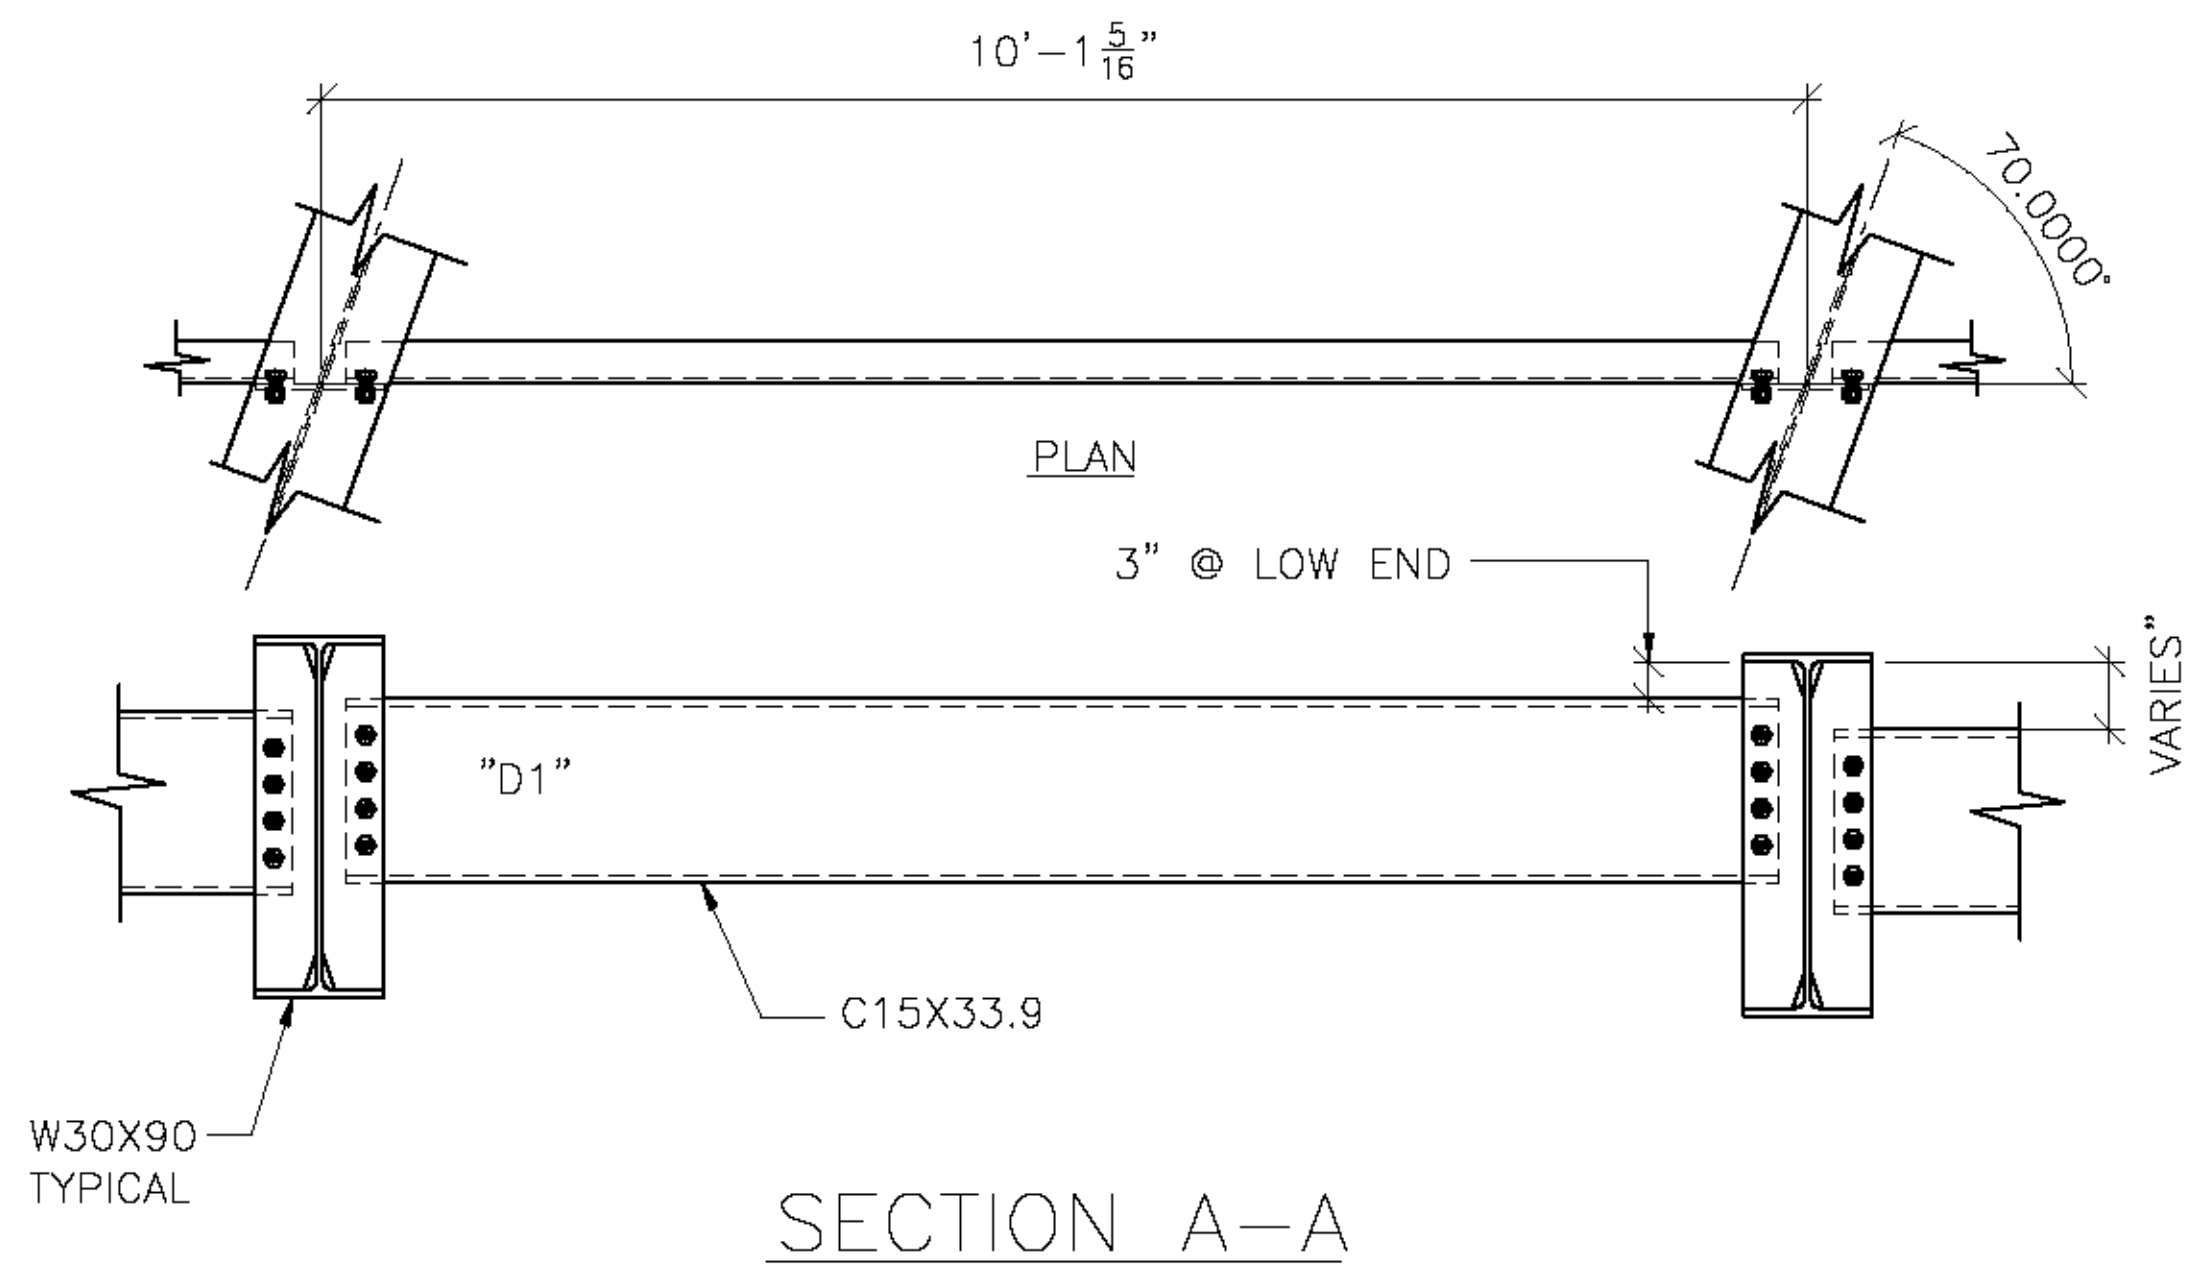

SECTION A-A





FIELD BOLT LIST

MARK	QTY.	DESCRIPTION	LOCATION
FB3	72	7/8"Ø X 2 1/4"	INTER. DIAPH. TO CONN. PL
	72	DIRECT TENSION INDICATORS + THREE (3) TEST ASSEMBLIES	

Vermont Agency of Transportation
RECEIVED
 CK'D BY FDB OK'D BY CLB
 May 29, 2015
 RESUBMIT No Approved AsNoted
 BY Carolyn Carlson DATE 06/02/15

FINISH				
MATERIAL	SEE DETAIL SHEETS			
HOLES				
ELECTRODES				
WELDS	PER WPS			
SURFACE PREP		5/27/15	PER APPROVAL	JAC
	NO	DATE	DESCRIPTION	BY
REVISIONS				
		ADVANCED RESOURCES & CONST. ENTERPRISES, INCORPORATED P.O. BOX 120 KINGFIELD, ME 04947 PHONE: (207) 285-2848 - FAX: (207) 285-4054		
DRAFTER	JAC	FRAMING PLAN	PROJECT NO.	
DATE	5/11/15	TOWN OF MIDDLESEX, VT 12 (RURAL MAJOR COLLECTOR)	15-114	
CHECKED	JS	PROJECT NUMBER BR 024-1(37)	DWG. NO.	
DATE	5/14/15	AL ST. ONGE CONTRACTOR, INC.	1	

J.A.C. DRAFTING/555815/1

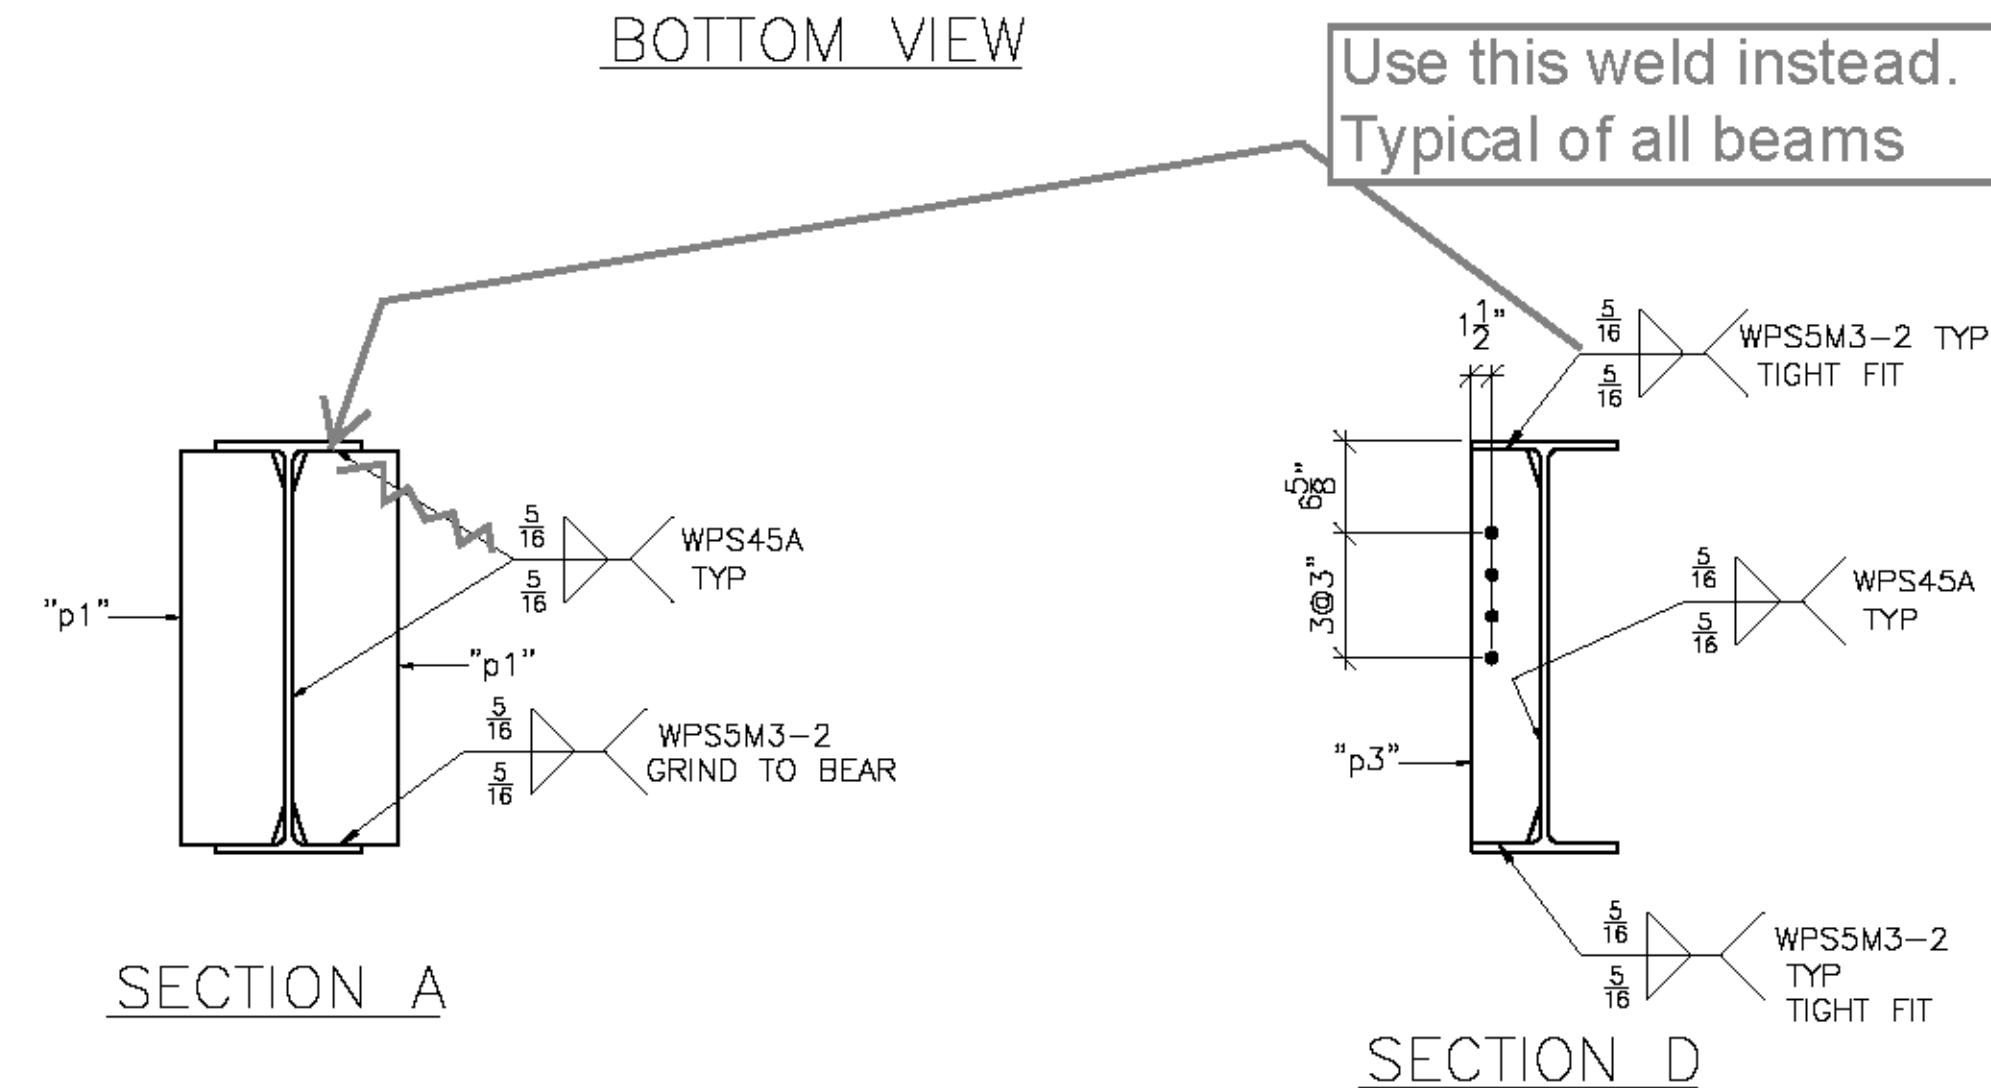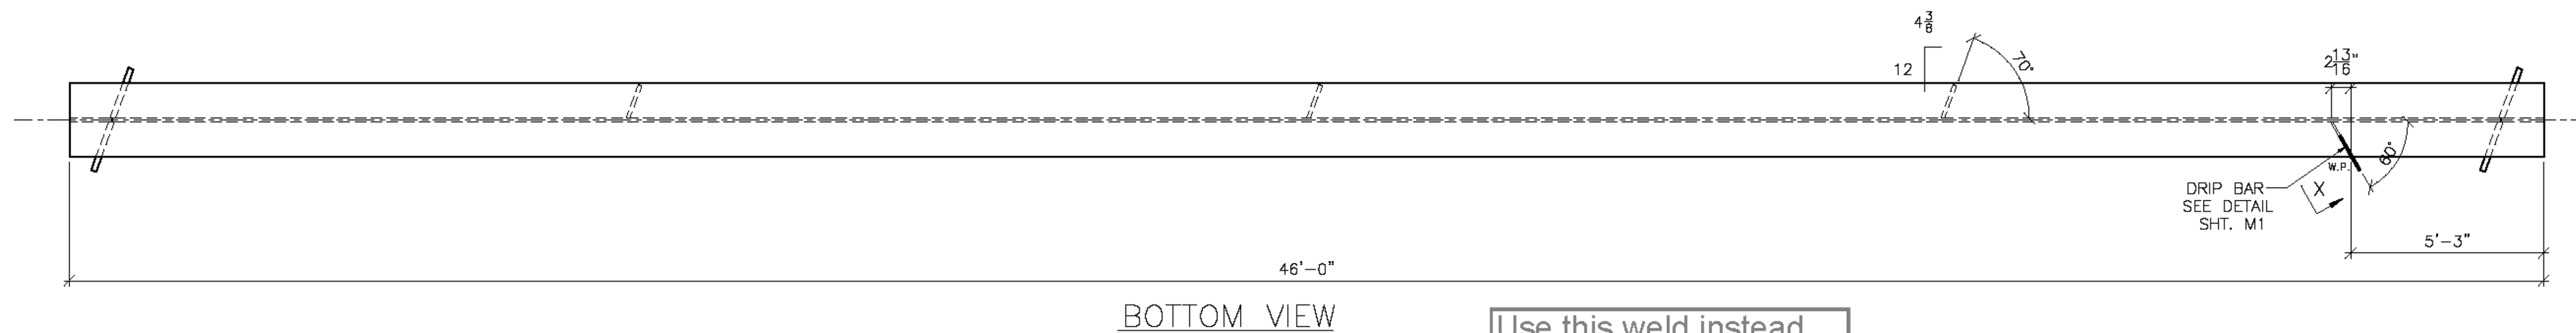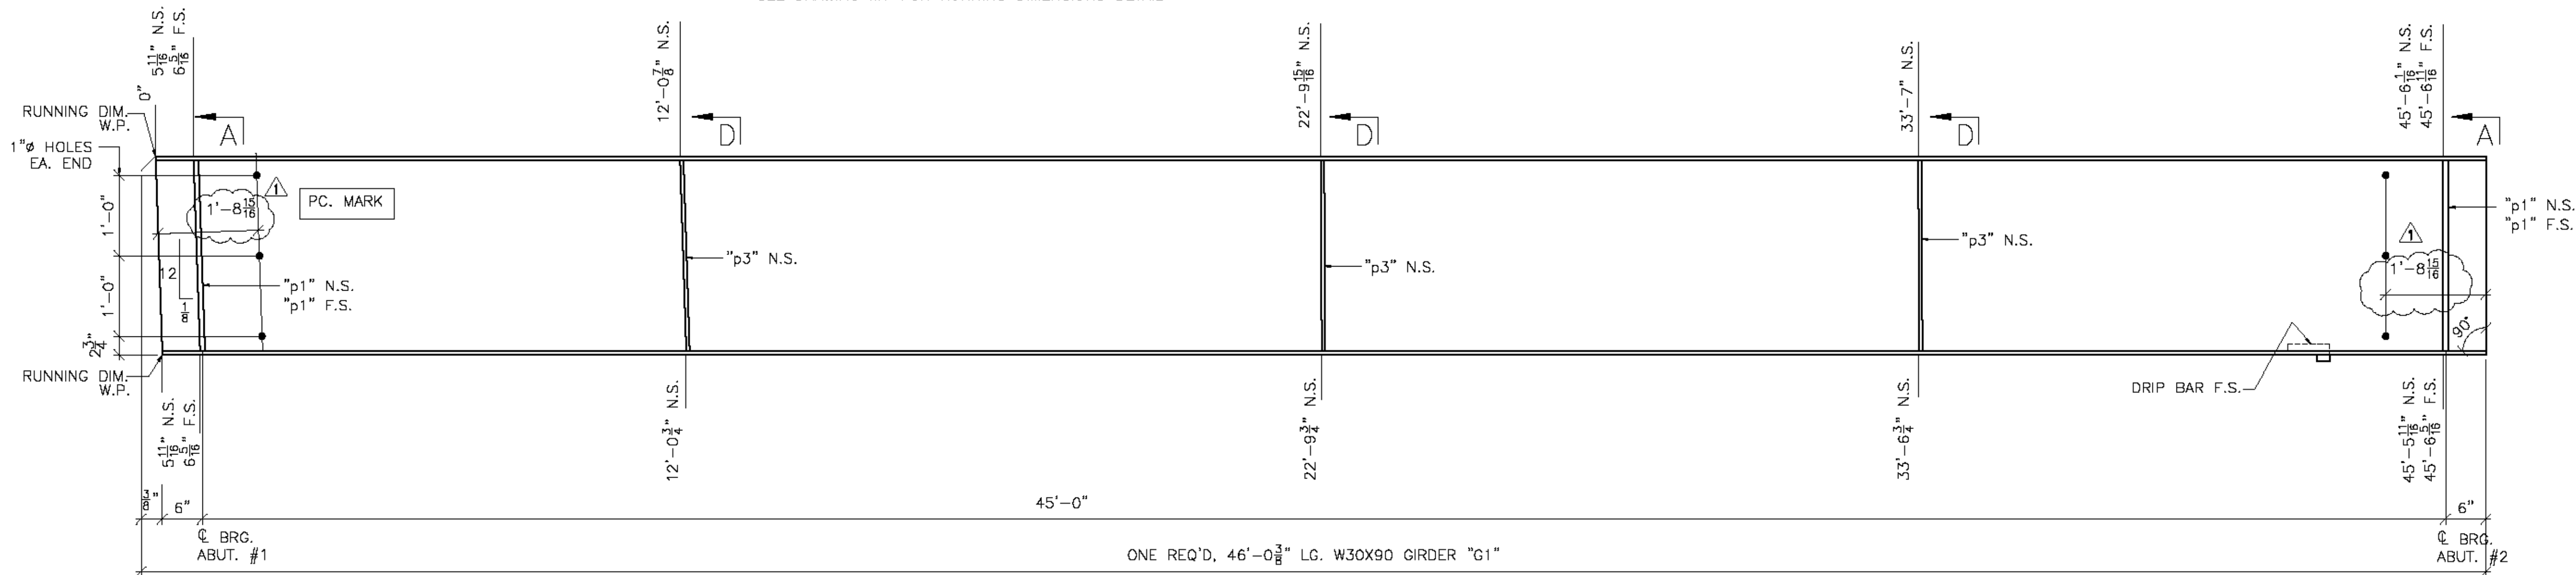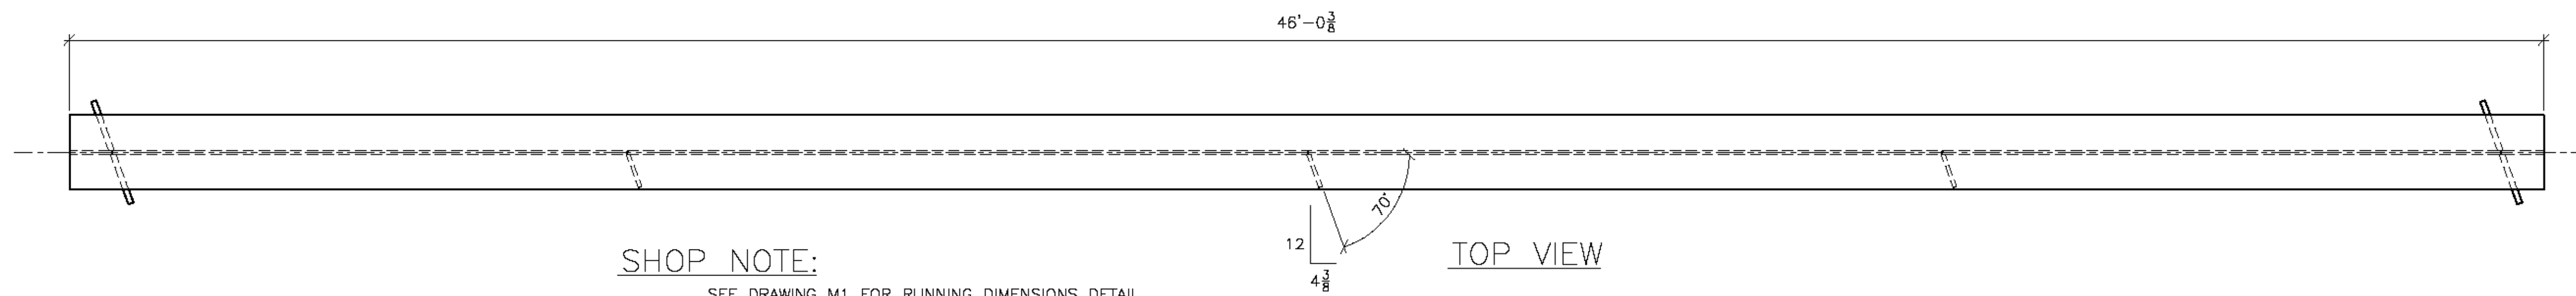

SHOP NOTE:
ENTIRE TOP FLANGE IS IN COMPRESSION
ENTIRE BOTT FLANGE IS IN TENSION


FINISH	GALVANIZED			
MATERIAL	ASHITO M270 (ASTM A708) GR. 50 U.O.N.			
HOLES	15/16" U.O.N.			
ELECTRODES				
WELDS	PER WPS			
SURFACE PREP	SSPC SP6	5/27/15	PER APPROVAL	JAC
		NO	DATE	DESCRIPTION

		ADVANCED RESOURCES & CONST. ENTERPRISES, INCORPORATED P.O. BOX 120 KINGFIELD, ME. 04947 PHONE: (207) 265-2646 - FAX: (207) 265-4054	
DRAFTER	JAC	STRINGER DETAILS, G1	PROJECT NO.
DATE	5/11/15	TOWN OF MIDDLESEX, VT 12 (RURAL MAJOR COLLECTOR)	15-114
CHECKED	JS	PROJECT NUMBER BR# 024-1(37)	DWG. NO.
DATE	5/14/15	G.C. AL ST. ONCE CONTRACTOR INC.	2


BILL OF MATERIAL							
SHIP	SHIP MARK	NO. PCS.	PIECE MARK	DESCRIPTION	LENGTH	REMARKS	WT.
1	G1			GIRDER	46'-0 3/8"	CVN	4377
		4	p1	SEE SHT. M1			4140
		3	p3	SEE SHT. M1			
		1	dp1	1/4" THK. DRIP BAR SEE SHT. M1			

Vermont Agency of Transportation
RECEIVED
 CK'D BY FDB OK'D BY CLB
 May 29, 2015
 RESUBMIT No Approved AsNoted
 BY Carolyn Carlson DATE 06/02/15


SEE SHEET M1 FOR CAMBER AND SECTIONS & DETAILS NOT SHOWN

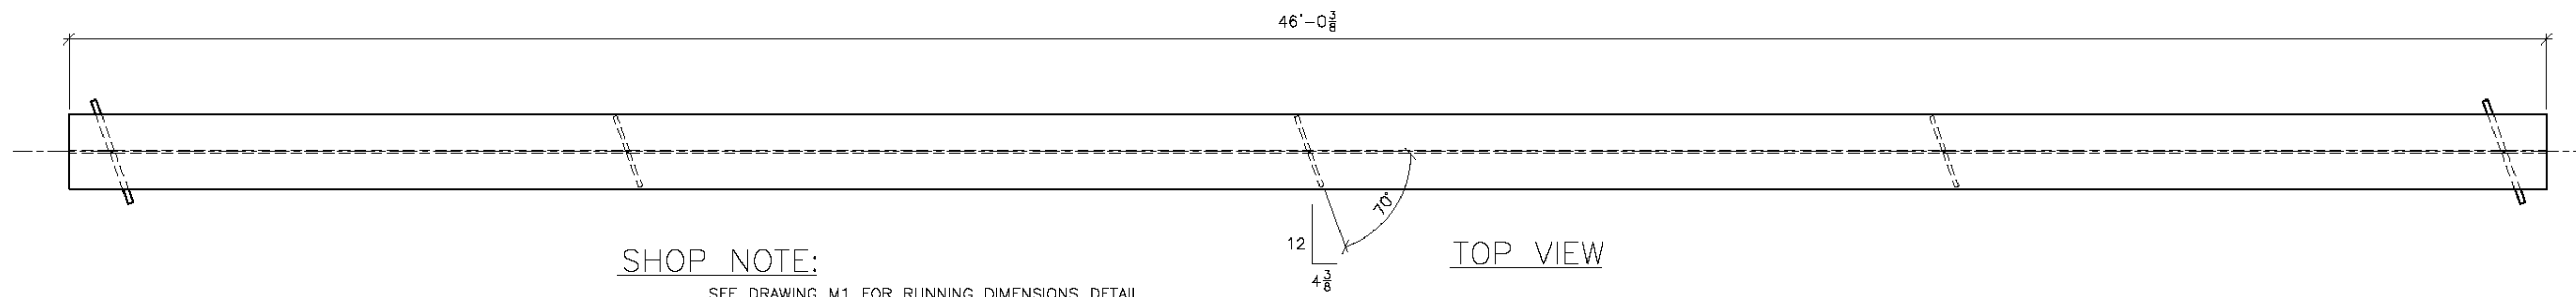


SHOP NOTE:
SEE DRAWING M1 FOR RUNNING DIMENSIONS DETAIL

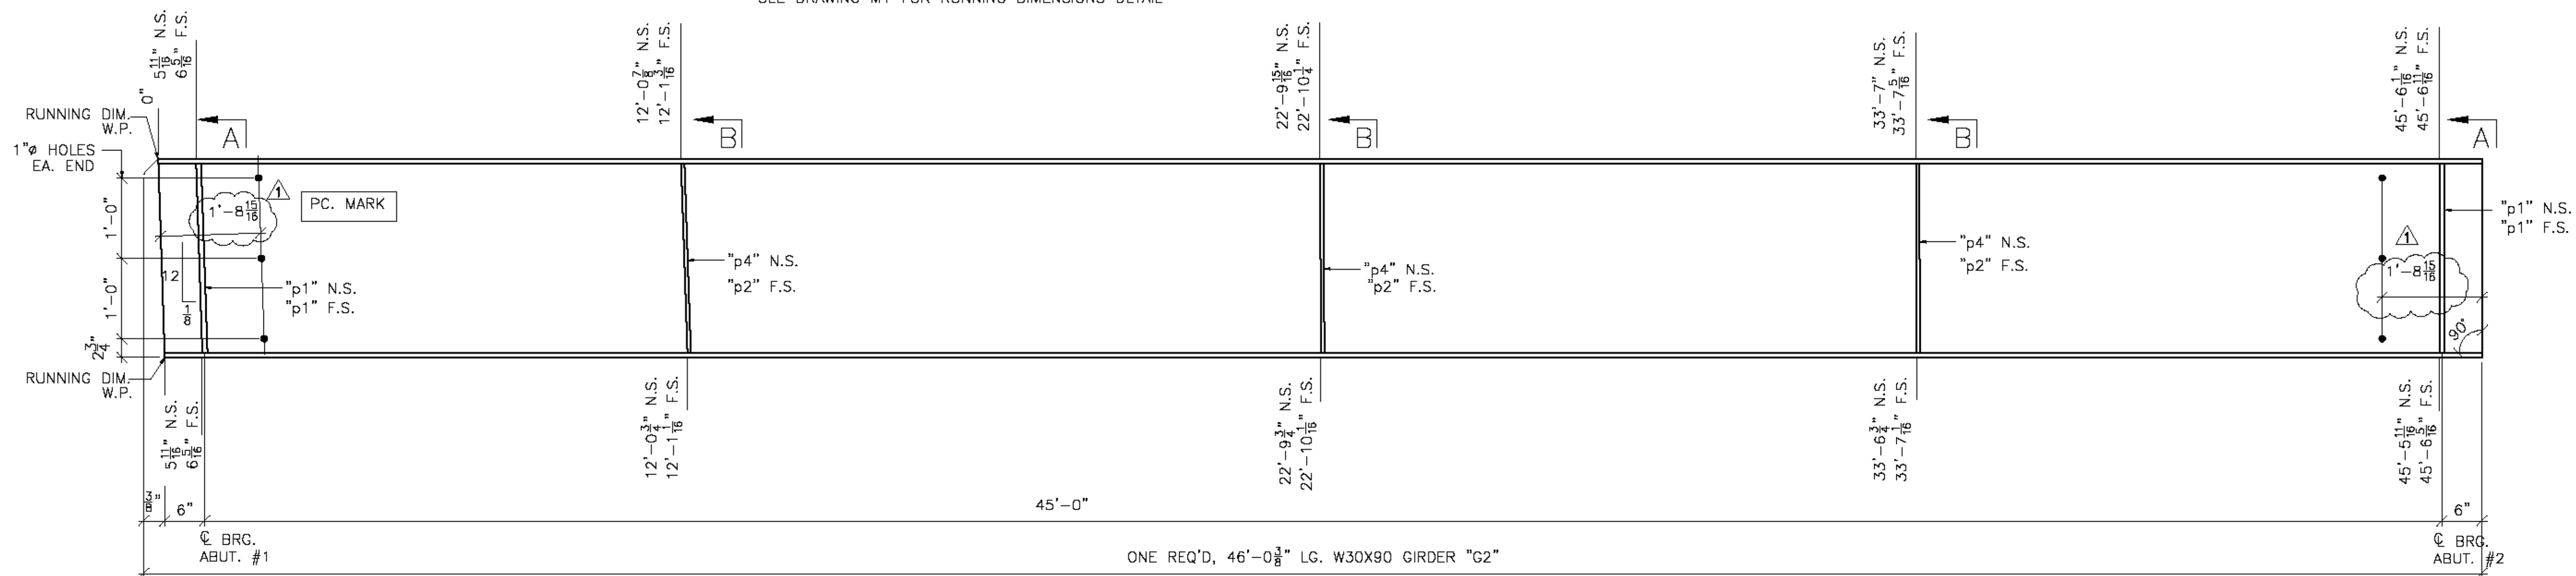

ONE REQ'D, 46'-0 3/8" LG. W30X90 GIRDER "G2"

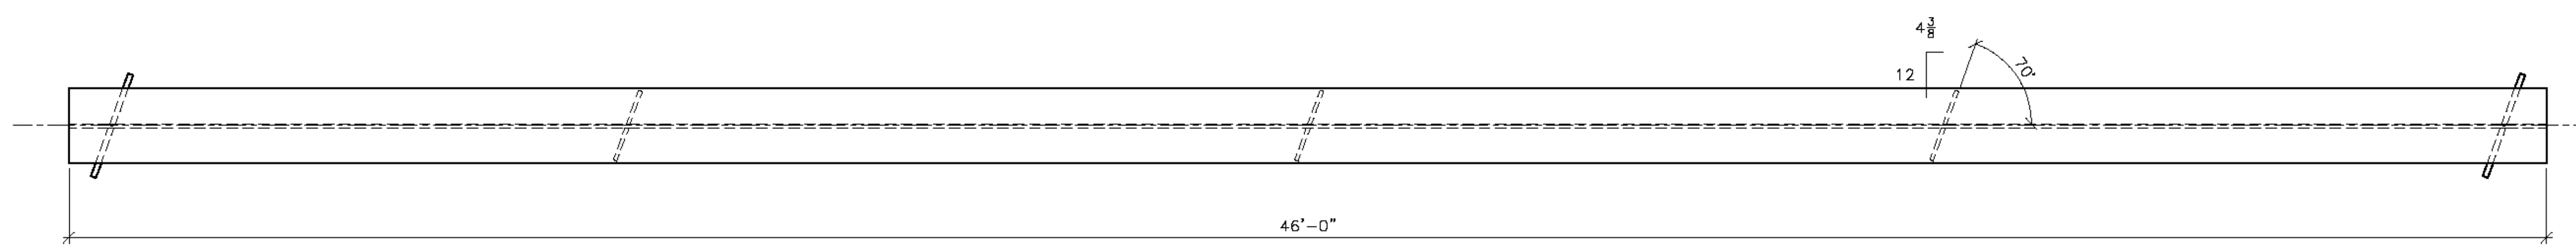

BOTTOM VIEW

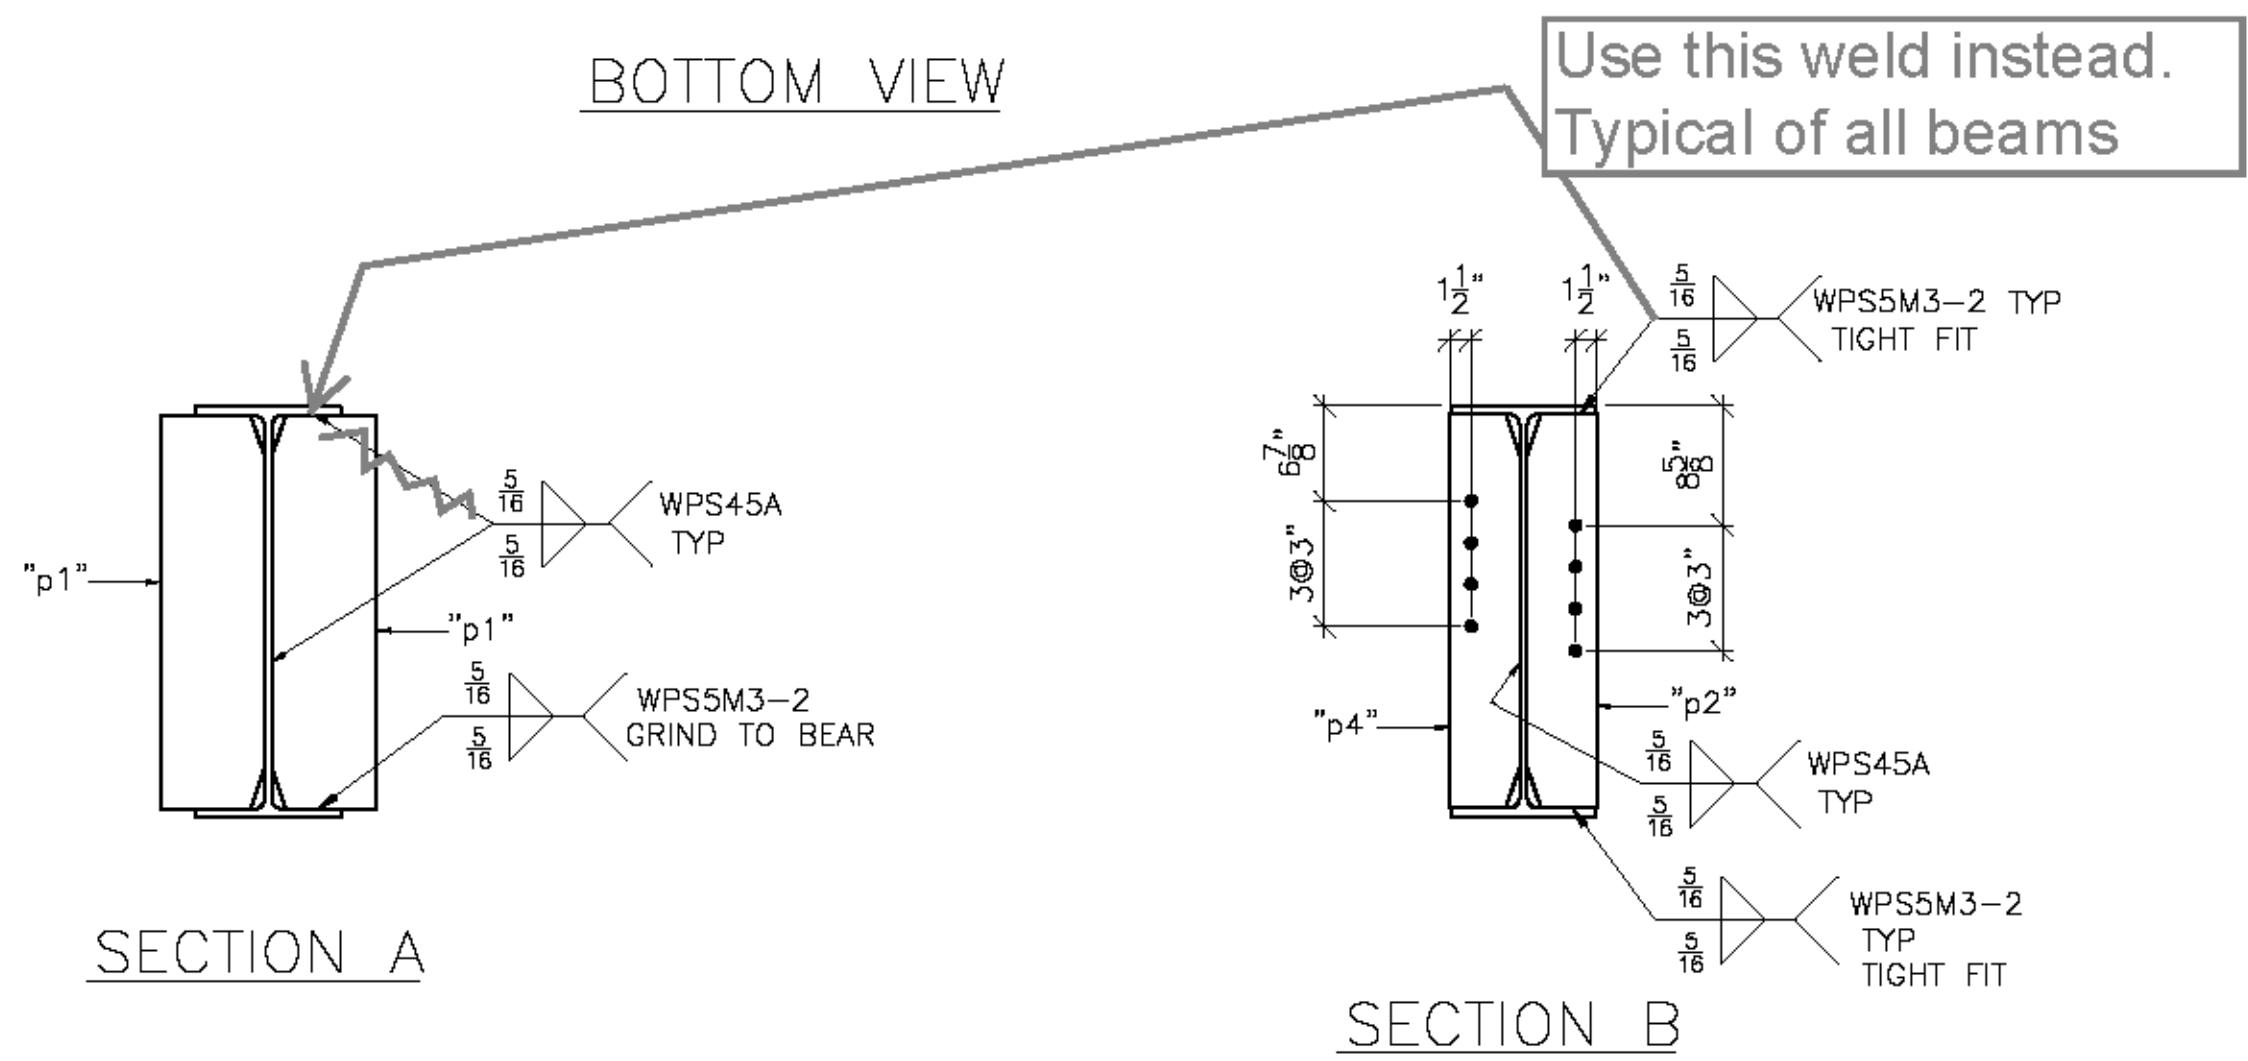

SECTION A

SECTION B

SHOP NOTE:
ENTIRE TOP FLANGE IS IN COMPRESSION
ENTIRE BOTT FLANGE IS IN TENSION


BILL OF MATERIAL

SHIP	SHIP MARK	NO. PCS.	PIECE MARK	DESCRIPTION	LENGTH	REMARKS	WT.
1	G2			GIRDER	46'-0 3/8"	CVN	4436
		1		W30X90			4140
		4	p1	SEE SHT. M1			
		3	p2	SEE SHT. M1			
		3	p4	SEE SHT. M1			

Vermont Agency of Transportation
RECEIVED
CK'D BY FDB OK'D BY CLB
May 29, 2015
RESUBMIT No Approved AsNoted
BY Carolyn Carlson DATE 06/02/15


SEE SHEET M1 FOR CAMBER AND SECTIONS & DETAILS NOT SHOWN

FINISH	GALVANIZED		
MATERIAL	AASHTO M270 (ASTM A709) GR. 50 U.O.N.		
HOLES	15/16" U.O.N.		
ELECTRODES			
WELDS	PER WPS		
SURFACE PREP	SSPC SP6	DATE	5/27/15
		PER APPROVAL	JAC
REVISIONS			
		ADVANCED RESOURCES & CONST. ENTERPRISES, INCORPORATED P.O. BOX 120 KINGFIELD, ME 04947 PHONE: (207) 265-2646 - FAX: (207) 265-4054	
DRAFTER	JAC	STRINGER DETAILS, G2	PROJECT NO.
DATE	5/11/15	TOWN OF MIDDLESEX, VT 12 (RURAL MAJOR COLLECTOR)	15-114
CHECKED	JS	PROJECT NUMBER BR# 024-1(37)	DWG. NO.
DATE	5/14/15	G.C. AL ST. ONCE CONTRACTOR INC.	3

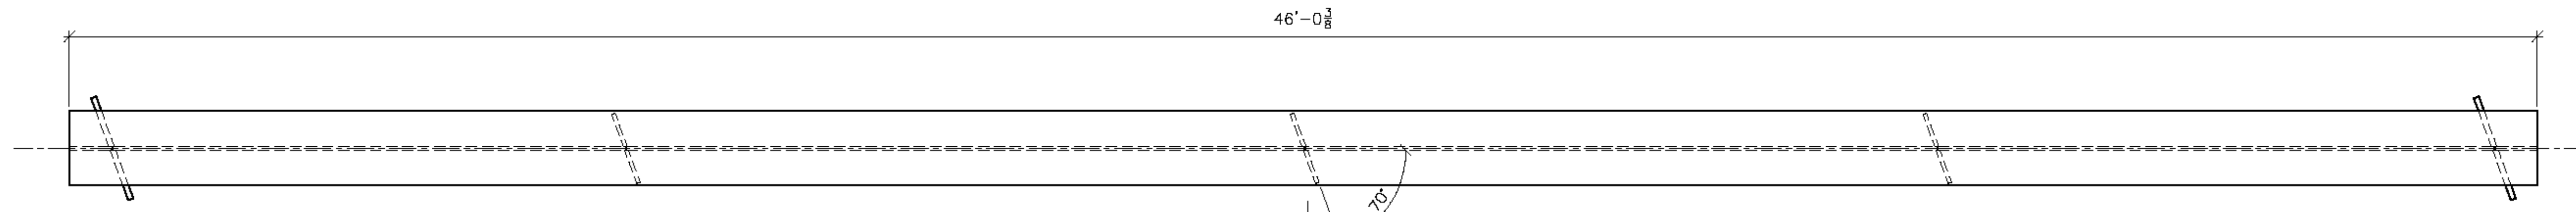


SHOP NOTE:
SEE DRAWING M1 FOR RUNNING DIMENSIONS DETAIL

TOP VIEW

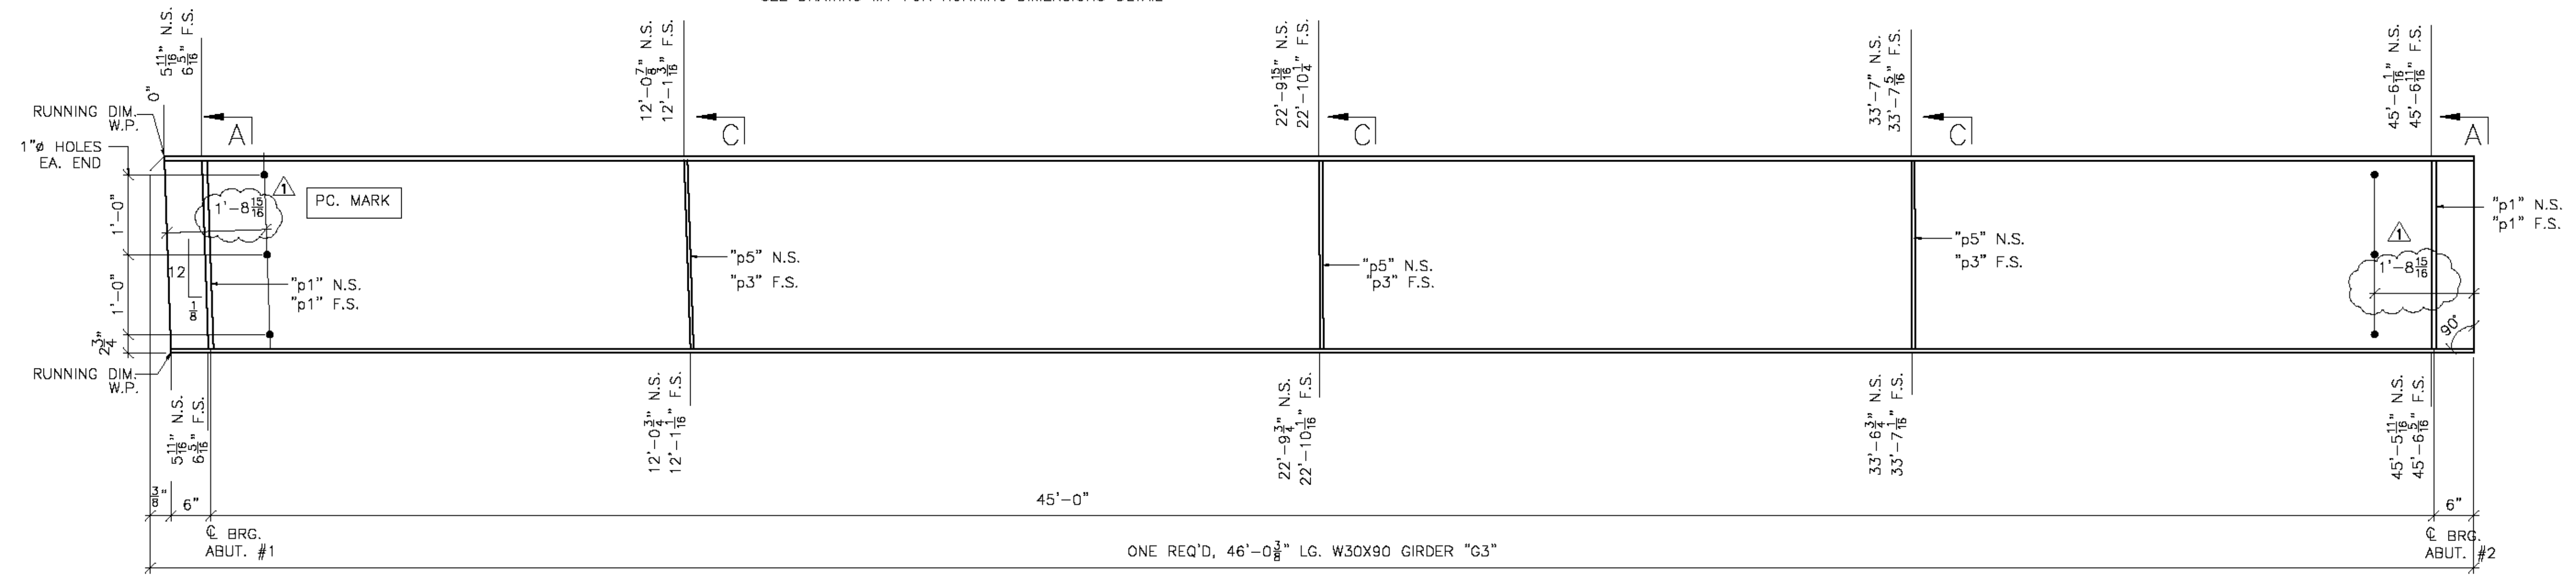


ONE REQ'D, 46'-0 1/8" LG. W30X90 GIRDER "G3"

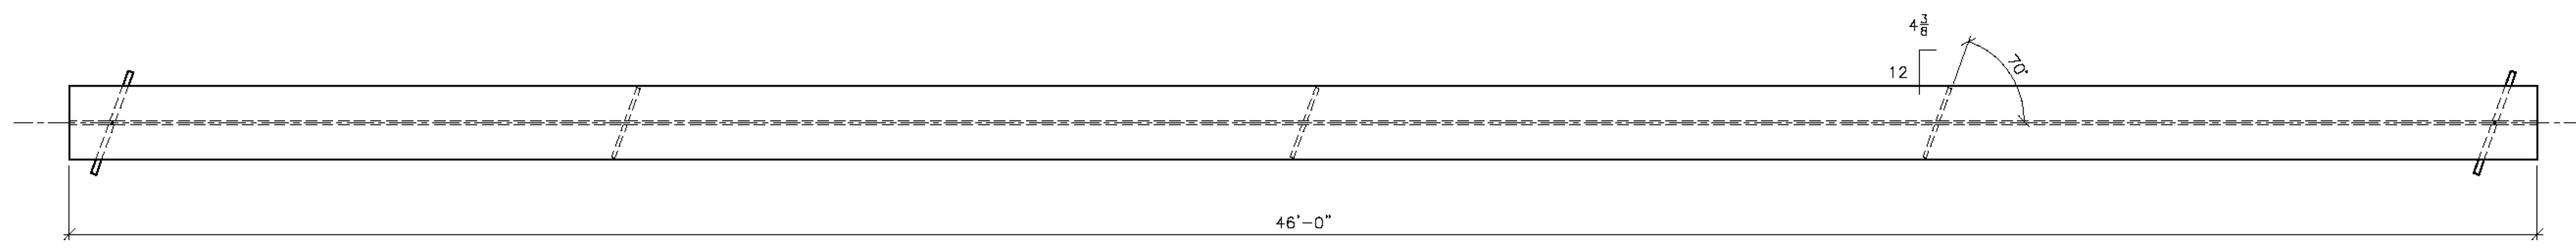


BOTTOM VIEW

Use this weld instead.
Typical of all beams

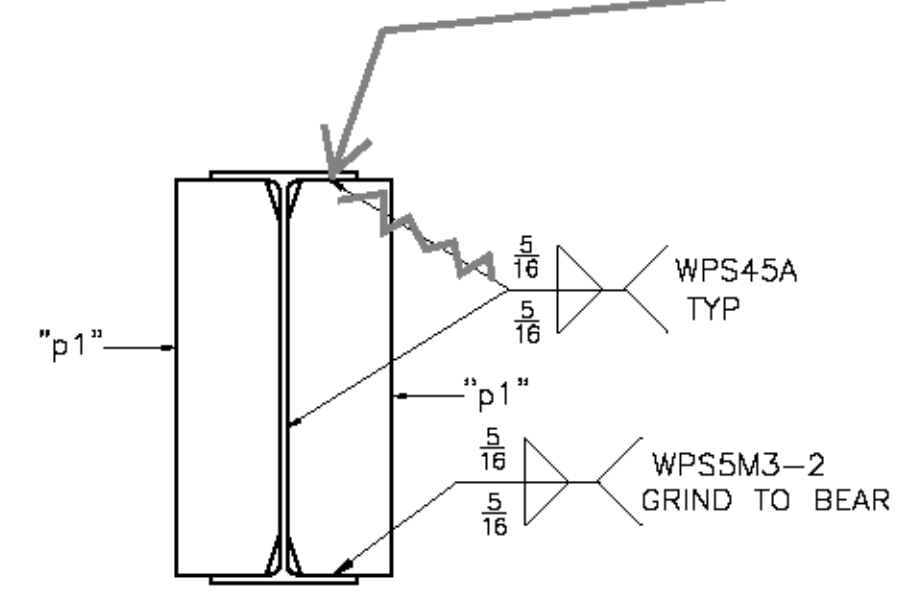

SECTION A

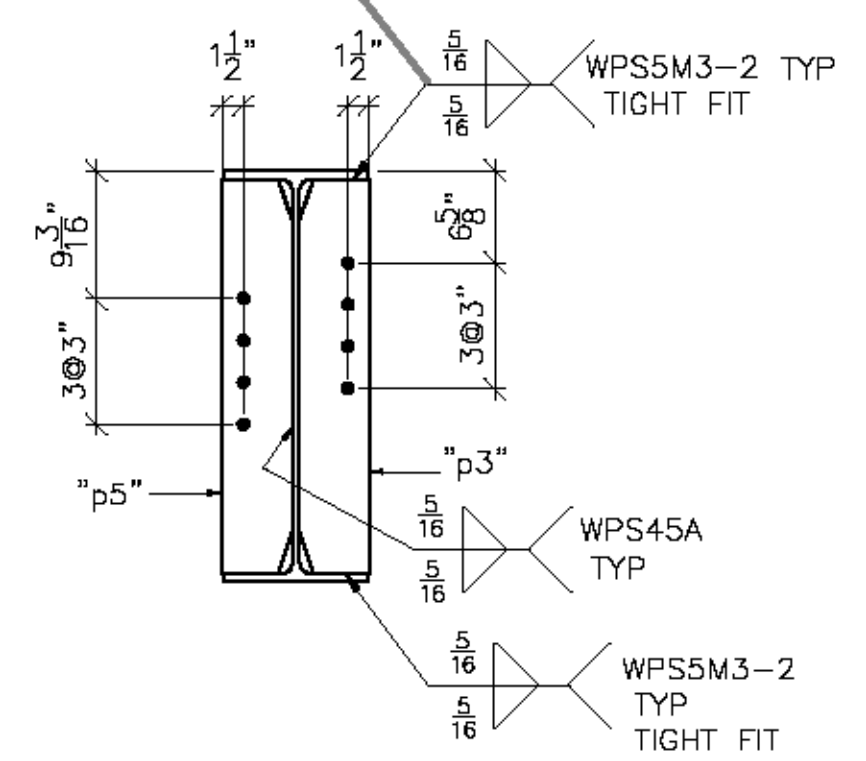

SECTION C

SHOP NOTE:
ENTIRE TOP FLANGE IS IN COMPRESSION
ENTIRE BOTT FLANGE IS IN TENSION

BILL OF MATERIAL

SHIP	SHIP MARK	NO. PCS.	PIECE MARK	DESCRIPTION	LENGTH	REMARKS	WT.
1	G3			GIRDER	46'-0 1/8"	CVN	4436
		4	p1	SEE SHT. M1			4140
		3	p5	SEE SHT. M1			
		3	p3	SEE SHT. M1			

Vermont Agency of Transportation

RECEIVED

CK'D BY FDB OK'D BY CLB

May 29, 2015

RESUBMIT No Approved AsNoted

BY Carolyn Carlson DATE 06/02/15


SEE SHEET M1 FOR CAMBER AND SECTIONS & DETAILS NOT SHOWN

NO	DATE	DESCRIPTION	BY
REVISIONS			



ADVANCED RESOURCES & CONST.
ENTERPRISES, INCORPORATED
P.O. BOX 120 KINGFIELD, ME. 04847
PHONE: (207) 285-2646 - FAX: (207) 285-4054

DRAFTER JAC	DATE 5/11/15	PROJECT NO. 15-114
CHECKED JS	DATE 5/14/15	DWG. NO. 4
STRINGER DETAILS, G3		PROJECT NO. 15-114
TOWN OF MIDDLESEX, VT 12 (RURAL MAJOR COLLECTOR)		DWG. NO. 4
PROJECT NUMBER BRP 024-1(37)		
G.C. AL ST. ONCE CONTRACTOR INC.		

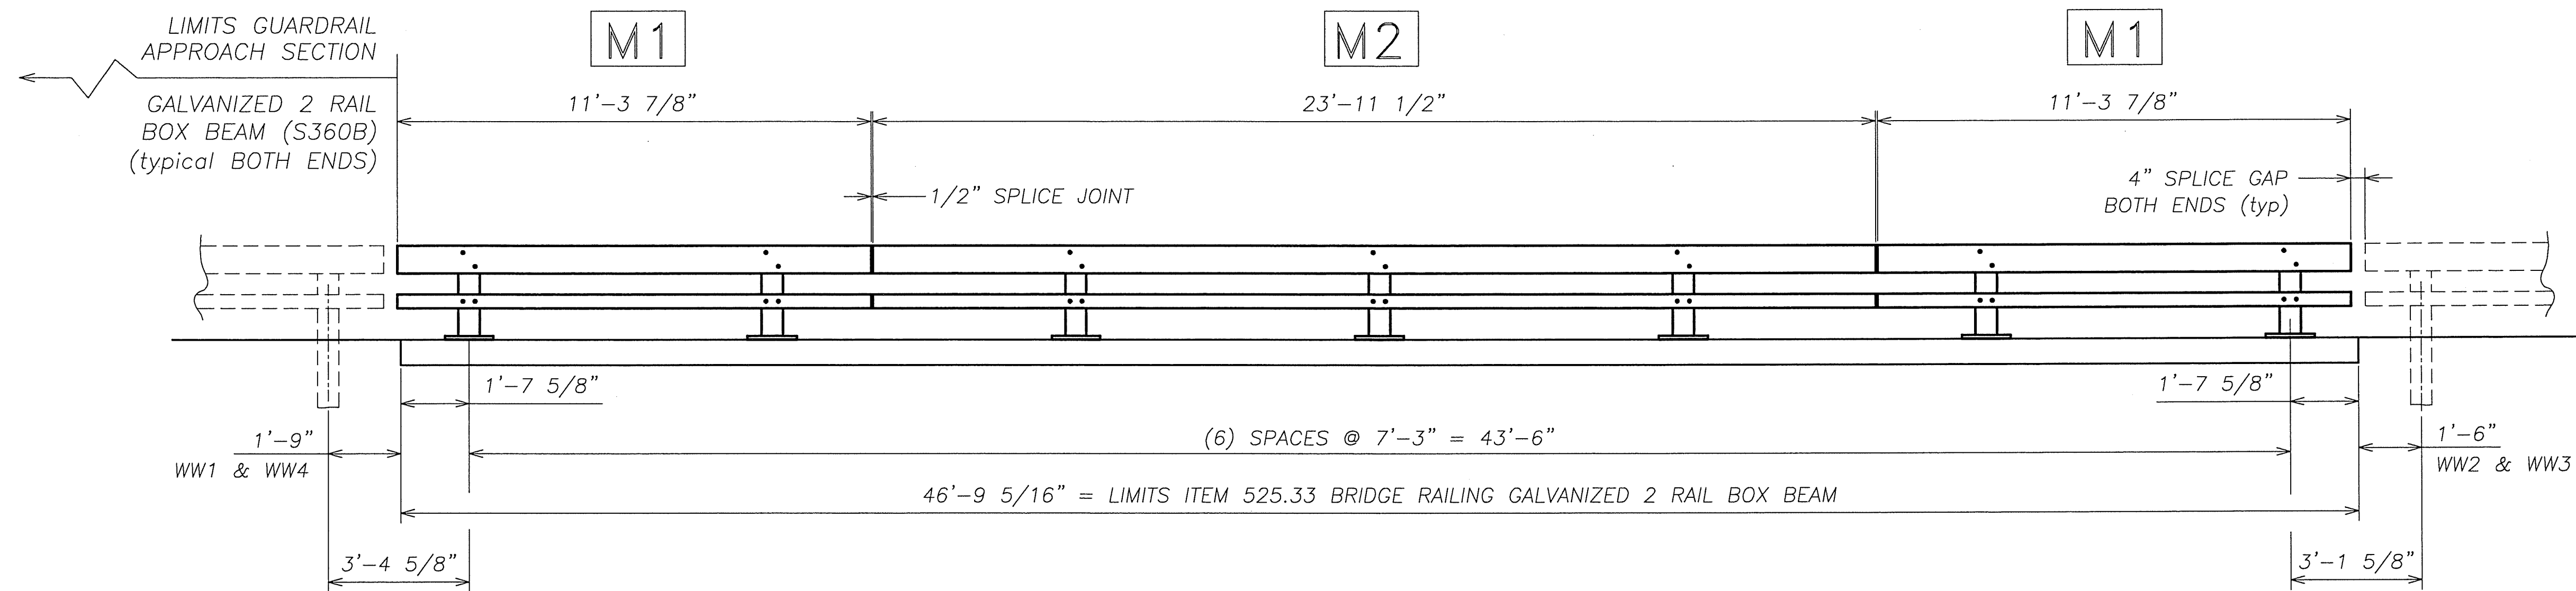

TYPICAL RAILING ELEVATION
 LOOKING AT FACE OF RAILING FROM CENTERLINE OF ROAD
 BOTH SIDES TYPICAL

BILL OF MATERIAL

Qty	mk	Description	Spec.
94 LF		ITEM 525.33 BRIDGE RAILING, GALVANIZED, 2 RAIL BOX BEAM	
14		BRIDGE RAILING POST W6 x 25 x 2'-2.375" OAH WITH 1 x 10 x 14 BASE PLATE (GLV)	A709 gr 50
4		SPLICE TUBE (FOR 8X4 RAIL) HSS 7 x 3 x 3/8 x 1'-8.000" OAL w/ TAPPED HOLES & 2 WELDED NUTS (GLV)	A500 gr B
4		SPLICE TUBE (FOR 4X4 RAIL) HSS 3 x 3 x 5/16 x 1'-8.000" OAL w/ TAPPED HOLES & 2 WELDED NUTS (GLV)	A500 gr B
4	M1	RAIL TUBE HSS 8 x 4 x 5/16 x 11 ft - 3.875 in OAL - FIX splice 1 end, EXP splice 1 end (GLV)	A500 gr B
2	M2	RAIL TUBE HSS 8 x 4 x 5/16 x 23 ft - 11.5 in OAL - FIX splice both ends (GLV)	A500 gr B
4	M1	RAIL TUBE HSS 4 x 4 x 1/4 x 11 ft - 3.875 in OAL - FIX splice 1 end, EXP splice 1 end (GLV)	A500 gr B
2	M2	RAIL TUBE HSS 4 x 4 x 1/4 x 23 ft - 11.5 in OAL - FIX splice both ends (GLV)	A500 gr B
14		ANCHOR SPACER PLATE PL 0.375 x 13.000 x 9.375	A709 gr 36
56		ANCHOR STUD DBL END PART THREAD - 1" DIA x 12.000 w/ 2.250" THD EACH END (GLV)	A449
112		HEAVY HEX NUT 1" (GLV)	A563 DH
56		ROUND WASHER (SAE) - 1" DIA SMALL (GLV)	F436
56		JAM NUT 1" (GALV)	A563 DH
56		ROUND HEAD POST BOLT slot or wrench head - no shoulder 3/4" DIA x 6" LG. FULL BODY (GLV)	A449 / A325
56		LOCK NUT 3/4" (GLV)	A563 DH
56		ROUND WASHER (SAE) 3/4" (GLV)	F436
32		HEX HEAD BOLT 5/8" DIA x 1.75" LG. (GLV)	A325
32		ROUND WASHER (SAE) 5/8" (GLV)	F436
14		BEARING PAD 0.125" THICK x 10.000 x 14.000 (NEOPRENE 80 duro +/-10)	aashto M251

No.	Remarks	Date
A	review corrections	5/20/15
0	initial submittal	05-07-15
REVISIONS		

Vermont Agency of Transportation
RECEIVED
 CK'D BY FDB OK'D BY HIS
 May 29, 2015
 RESUBMIT No Approved
 BY Carolyn Carlson DATE 6/2/2015



HIGHWAY SAFETY CORP
 GLASTONBURY, CT
 860-633-9445

ITEM 525.33 BRIDGE RAILING, GALVANIZED 2 RAIL BOX BEAM (S-360A)
 ITEM 621.72 GUARDRAIL APPROACH SECTION, GALVANIZED 2 RAIL BOX BEAM (S-360B)
 BR 024-1(37)
 VT ROUTE 12 - BRIDGE 77
 TOWN OF MIDDLESEX, WASHINGTON COUNTY VT


CERTIFIED FABRICATOR

GENERAL CONTRACTOR SHEET NO. 2048
 SUB CONTRACTOR LAFAYETTE SHEET NO. 1 of 3


DATE 05-07-15 SCALE NONE SIZE D

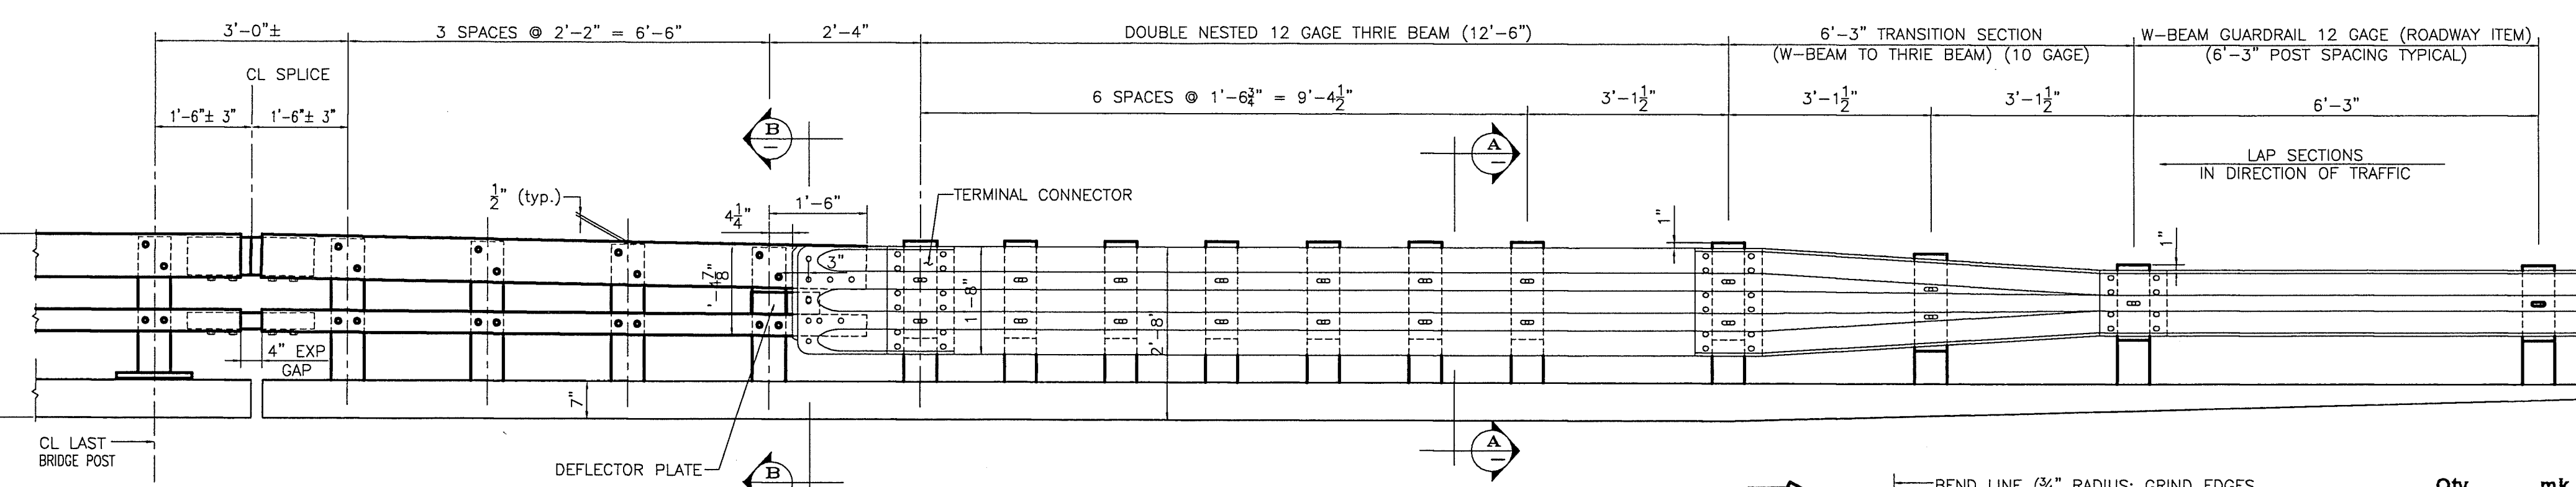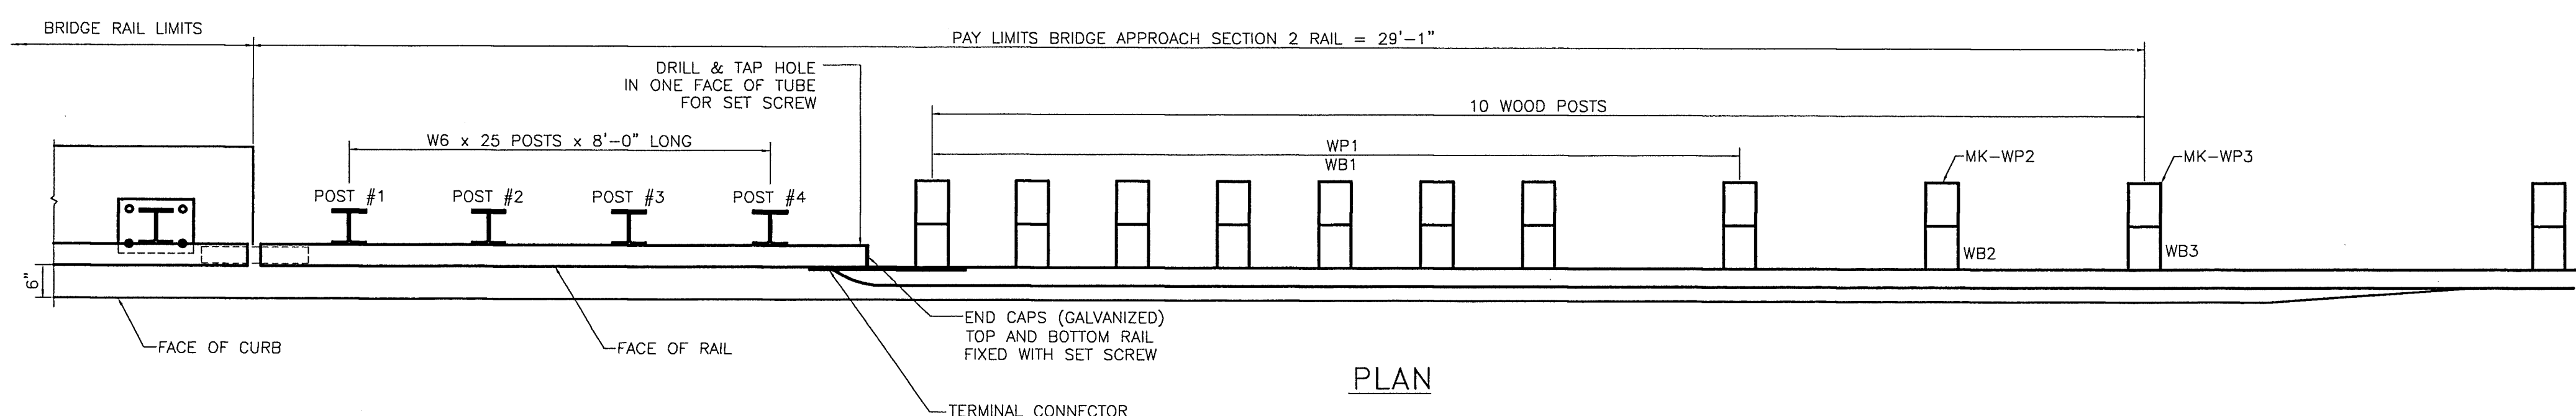


LEADING END (RIGHT) IS SHOWN
DEPARTURE END (LEFT) SIMILAR BUT OPPOSITE HAND

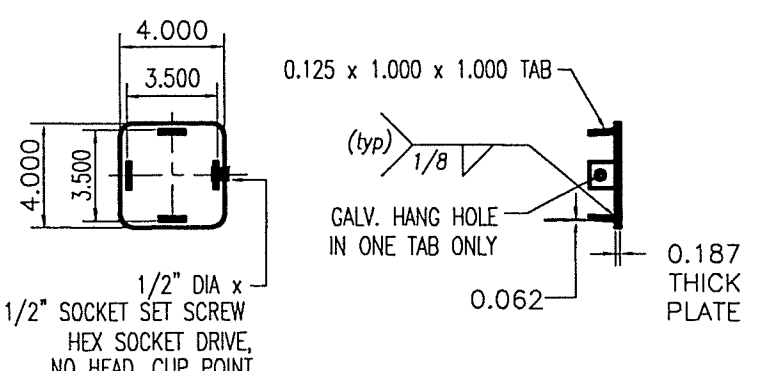

END CAP (4x4)
0.187 x 4.000 x 4.000 (A709 gr 36)

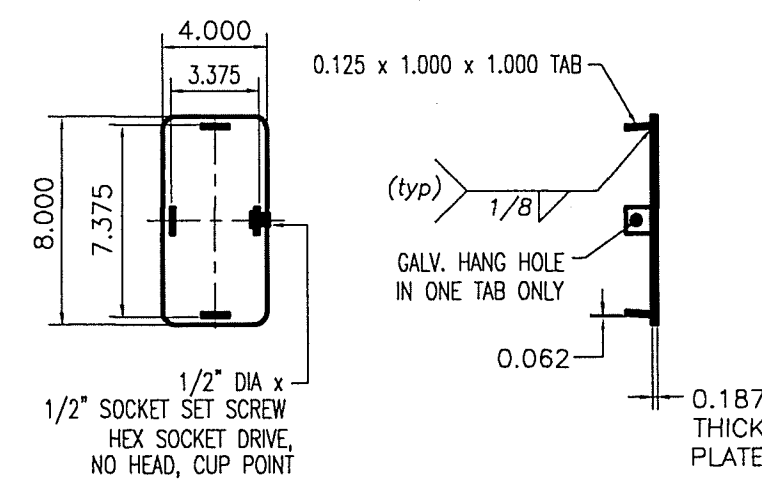


END CAP (8x4)
0.187 x 4.000 x 8.000 (A709 gr 36)

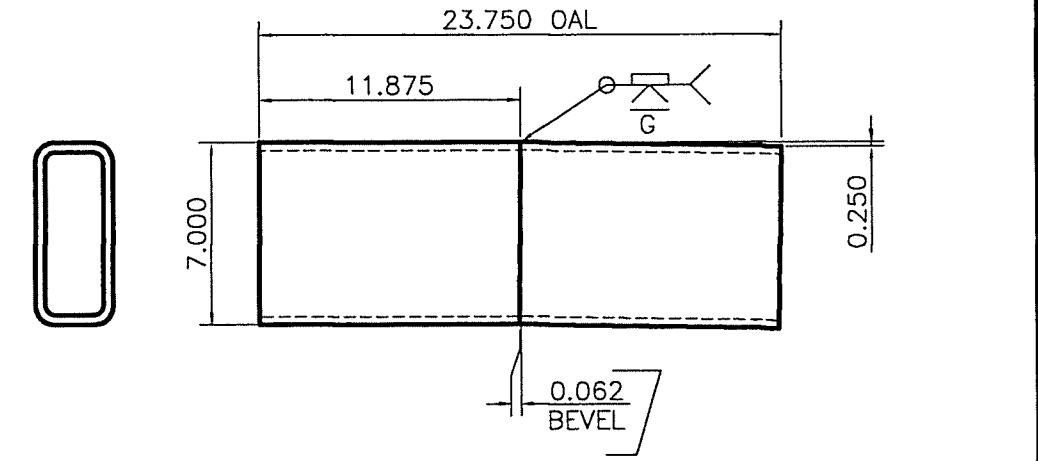

ANGLED SPLICE DETAIL
HSS 7 x 3 x 3/8 - FOR UPPER RAIL SPLICE
SEE BRIDGE RAIL SHEET FOR DETAIL ON LOWER RAIL SPLICE TUBE


BILL OF MATERIAL

Qty	mk	Description	Spec.
4 EA		ITEM 621.72 GUARDRAIL APPROACH SECTION, GALVANIZED, 2 RAIL BOX BEAM	
4	01	W6x25 APPROACH POST - #1 x 8'-0" OAL (GALV)	A709 gr 50
4	02	W6x25 APPROACH POST - #2 x 8'-0" OAL (GALV)	A709 gr 50
4	03	W6x25 APPROACH POST - #3 x 8'-0" OAL (GALV)	A709 gr 50
4	04	W6x25 APPROACH POST - #4 x 8'-0" OAL (GALV)	A709 gr 50
4		UPPER RAIL APPROACH TUBE HSS 8 x 4 x 5/16 x 9'-4.000" w/ 3.500 SLOTS FOR 4" EXP GAP (GALV)	A500 gr B
4		LOWER RAIL APPROACH TUBE HSS 4 x 4 x 1/4 x 9'-4.000" w/ 3.500 SLOTS FOR 4" EXP GAP (GALV)	A500 gr B
4		CONNECTION PLATE PL 0.375" x 20.000" x 27.000" (GALV)	A709 gr 36
2		DEFLECTOR PLATE (RIGHT) PL 0.375 x 4.000 x 13.375 (GALV)	A709 gr 36
2		DEFLECTOR PLATE (LEFT) PL 0.375 x 4.000 x 13.375 (GALV)	A709 gr 36
4		END CAP FOR 8x4 TUBE 0.187 THICK PLATE 8.000 x 4.000 w/ WELDED TABS (GALV)	A709 gr 36
4		END CAP FOR 4x4 TUBE 0.187 THICK PLATE 4.000 x 4.000 w/ WELDED TABS (GALV)	A709 gr 36
4		(ANGLED) SPLICE TUBE (EXPANSION) FOR 8x4 UPPER RAIL HSS 7 x 3 x 3/8 x 1'-11.750" OAL (GALV)	A500 gr B
4		SPLICE TUBE (EXPANSION) FOR 4x4 LOWER RAIL HSS 3 x 3 x 5/16 x 1'-11.750" OAL (GALV)	A500 gr B
32		WOOD POST (WP1) 6 x 8 x 7'-0"	TIMBER
32		WOOD BLOCKOUT (WB1) 6 x 8 x 1'-6"	TIMBER
4		WOOD POST (WP2) 6 x 8 x 7'-0"	TIMBER
4		WOOD BLOCKOUT (WB2) 6 x 8 x 1'-6"	TIMBER
4		WOOD POST (WP3) 6 x 8 x 7'-0"	TIMBER
4		WOOD BLOCKOUT (WB3) 6 x 8 x 1'-2"	TIMBER
4		THRIE FLAT LIP BRIDGE SHOE (MODIFIED) 10 GA. GALV	aashto M180 B2
4		THRIE TRANSITION PANEL 6'-3" / 3'-1 1/2" 10 GA. GALV.	aashto M180 B2
8		THRIE PANEL 12'-6" / 1'-6 3/4" 12 GA. GALV.	aashto M180 A2
92		ROUND HEAD POST BOLT slot or wrench head - no shoulder 3/4" DIA x 6" LG. (GLV) w/ LOCK NUT & FLAT WASHER	A449
4		ROUND HEAD POST BOLT slot or wrench head - no shoulder 3/4" DIA x 2" LG. (GLV) w/ HEX NUT	A449
8		ROUND HEAD POST BOLT - oval shoulder 5/8" DIA x 1'-8" LG. (GALV) w/ DBL RECESS NUT, FLAT WASHER	A307
68		ROUND HEAD POST BOLT - oval shoulder 5/8" DIA x 1'-6" LG. (GALV) w/ DBL RECESS NUT, FLAT WASHER	A307
32		HEX HEAD BOLT 5/8 x 1-3/4" (GALV) w/ FLAT WASHER	A325
128		PANEL SPLICE BOLT 5/8 x 1-1/4" (GALV) w/ DOUBLE RECESSED NUT	A307
76		RECTANGULAR PLATE WASHER 0.187 x 1.750 x 3.000 (GALV)	A709 gr 36
32		SPACER PIPE - GALVANIZED 3/4" SCH. 40 x 1/2" LONG (GLV)	A53 gr B

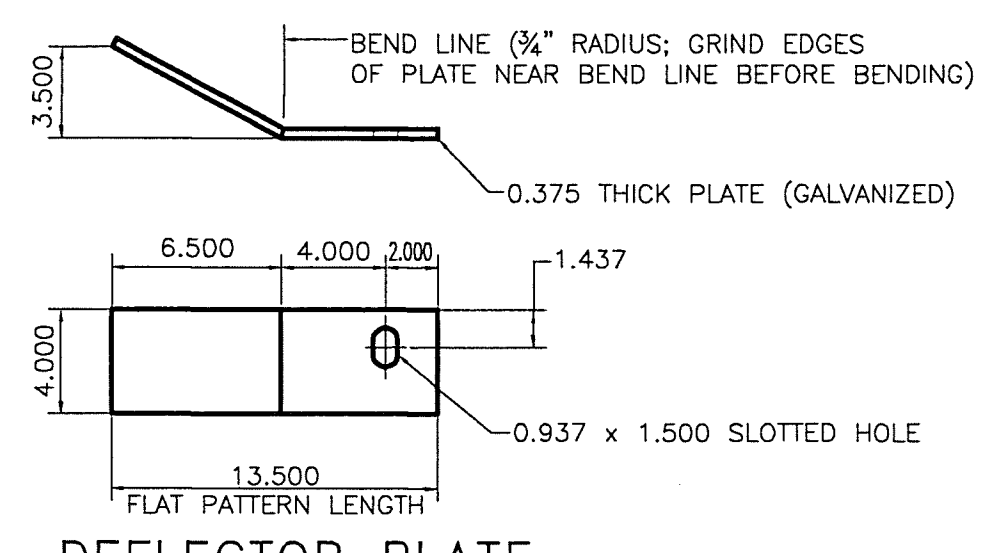


DEFLECTOR PLATE
0.375 x 4.000 x 13.500 (A709 gr 36)


RIGHT HAND APPROACH SHOWN - LEFT HAND BENT OPPOSITE

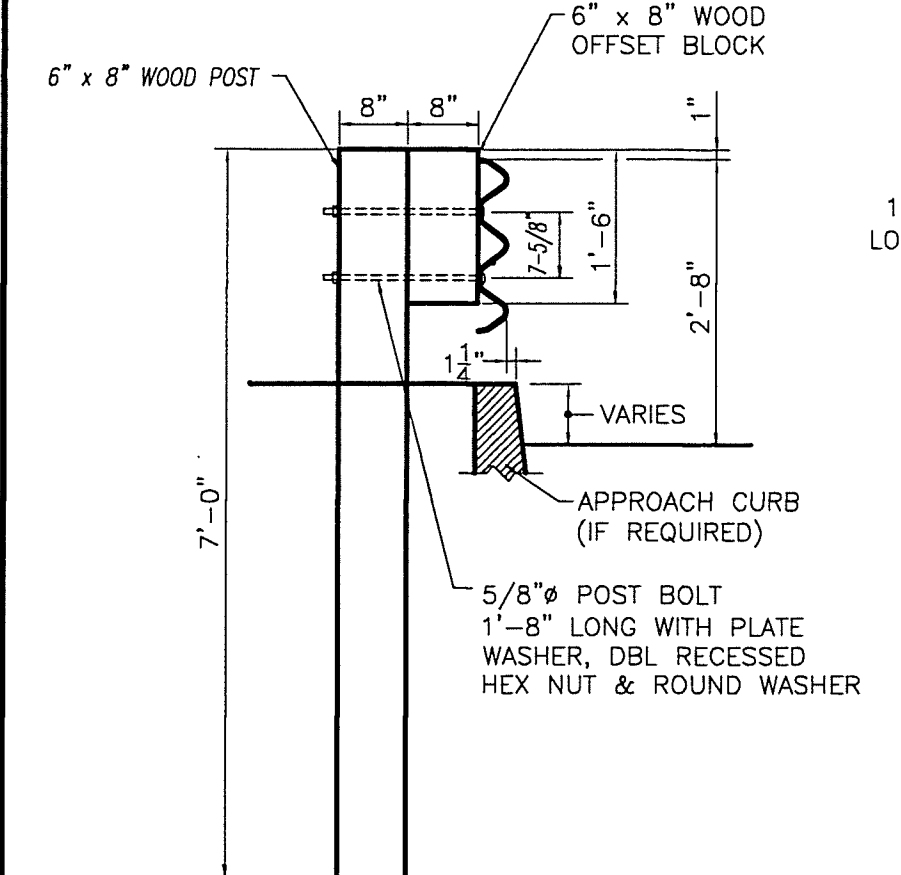


SECTION A-A

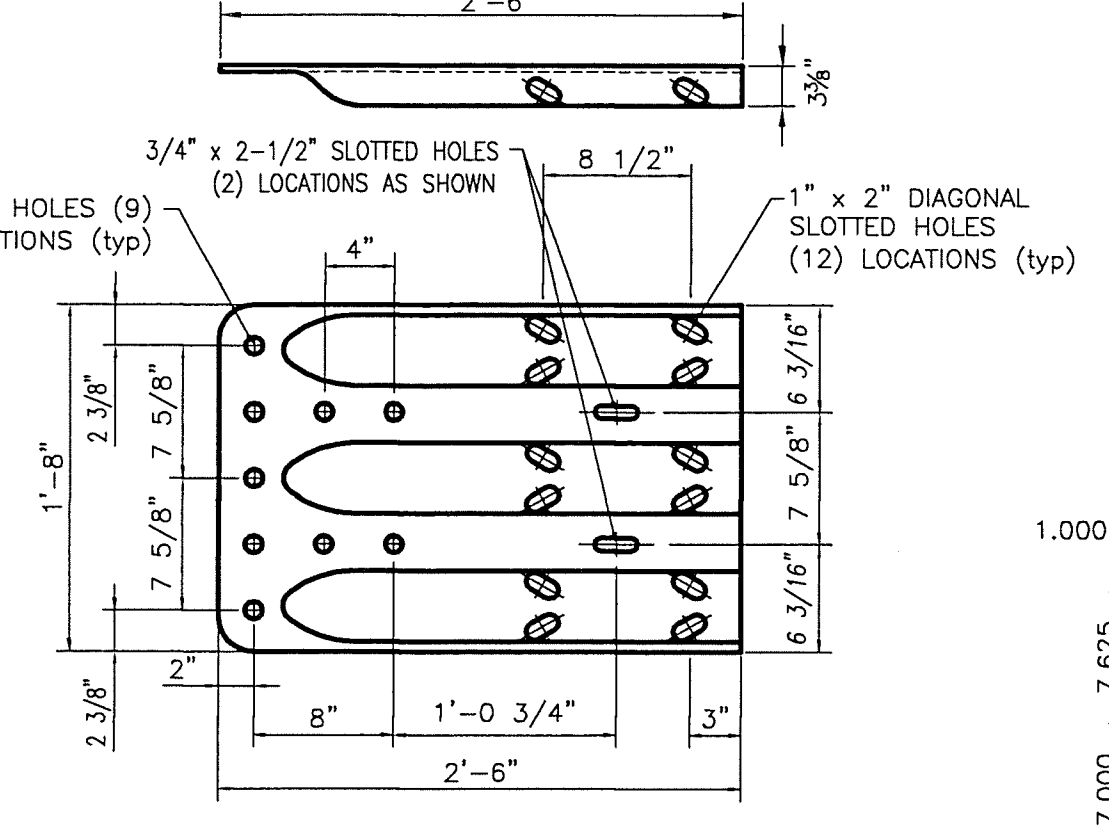


TERMINAL CONNECTOR
10 GAUGE (AASHTO M180 B2)

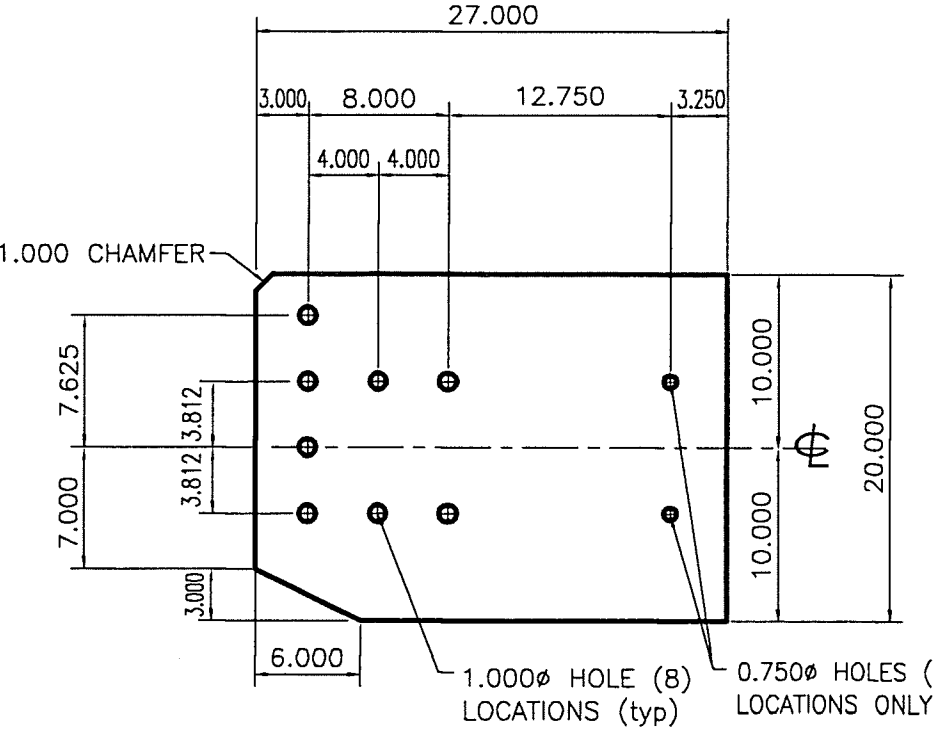

CONNECTION PLATE
0.375 x 20.000 x 27.000 (A709 gr 36)

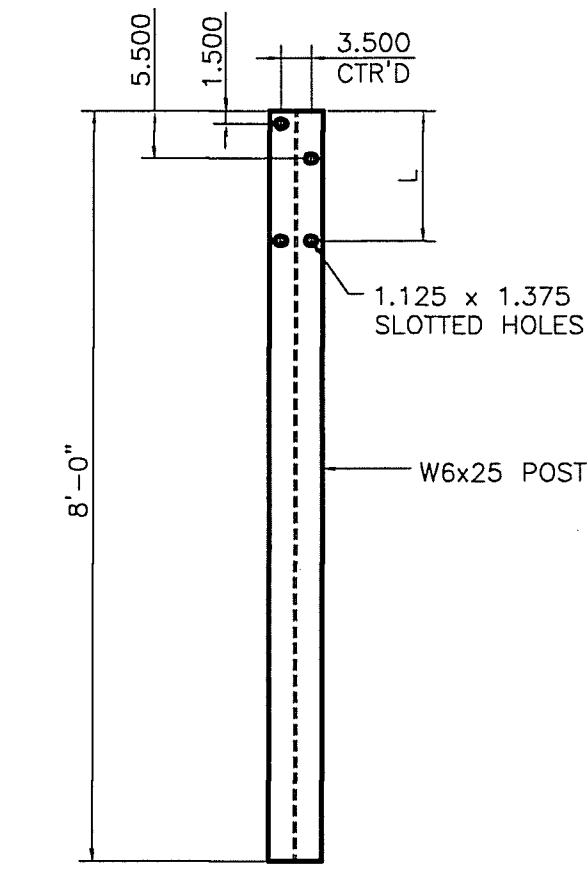


STEEL POST

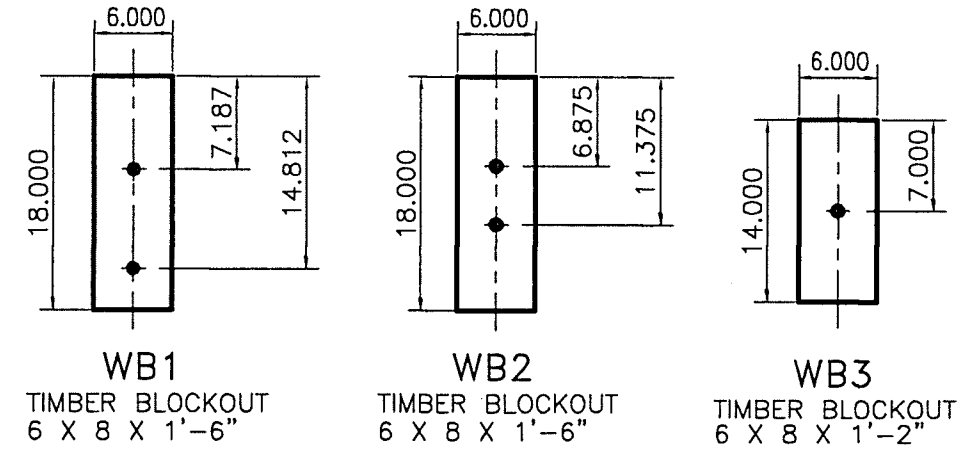


WOOD BLOCK DETAILS

STEEL POST CHART

No.	L
#1	1'-3.250"
#2	1'-3.000"
#3	1'-2.687"
#4	1'-2.375"

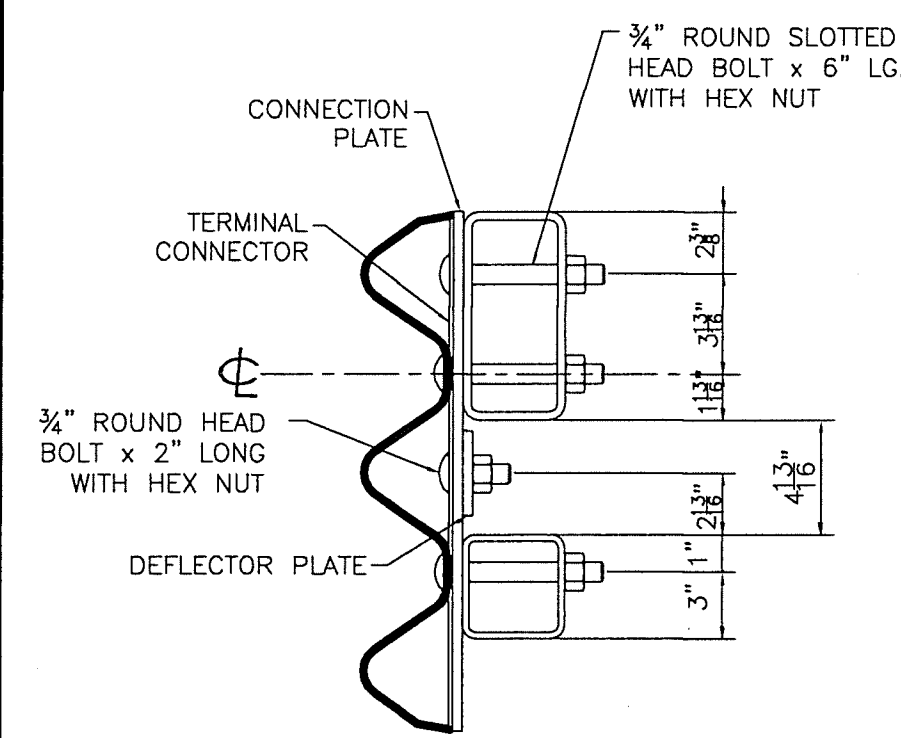

SECTION B-B

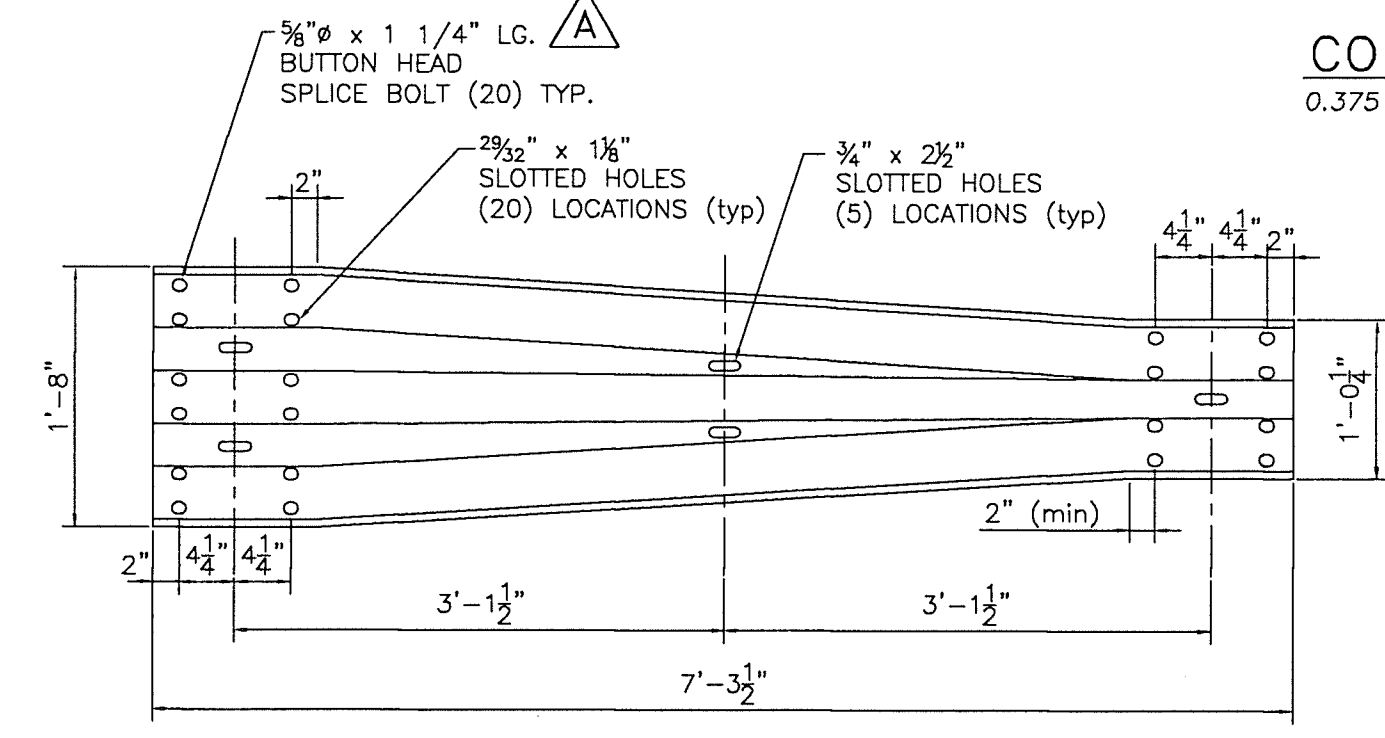

THRIE TRANSITION PANEL
10 GAUGE (AASHTO M180 B2)

Vermont Agency of Transportation
RECEIVED
CK'D BY FDB OK'D BY HIS
May 29, 2015
RESUBMIT No Approved
BY Carolyn Carlson DATE 6/2/2015

HIGHWAY SAFETY CORP
GLASTONBURY, CT
860-633-9445
ITEM 621.72 GUARDRAIL APPROACH SECTION, GALVANIZED 2 RAIL BOX BEAM (S-3608)
BRF 024-1(37)
VT ROUTE 12 - BRIDGE 77
TOWN OF MIDDLESEX, WASHINGTON COUNTY VT
GENERAL CONTRACTOR
SUB CONTRACTOR LAFAYETTE
DRAWN PAR CHECKED DATE 05-07-15 SCALE NONE SIZE D
CERTIFIED FABRICATOR
HSC JOB NO. 2048
SHEET NO. 3 of 3