

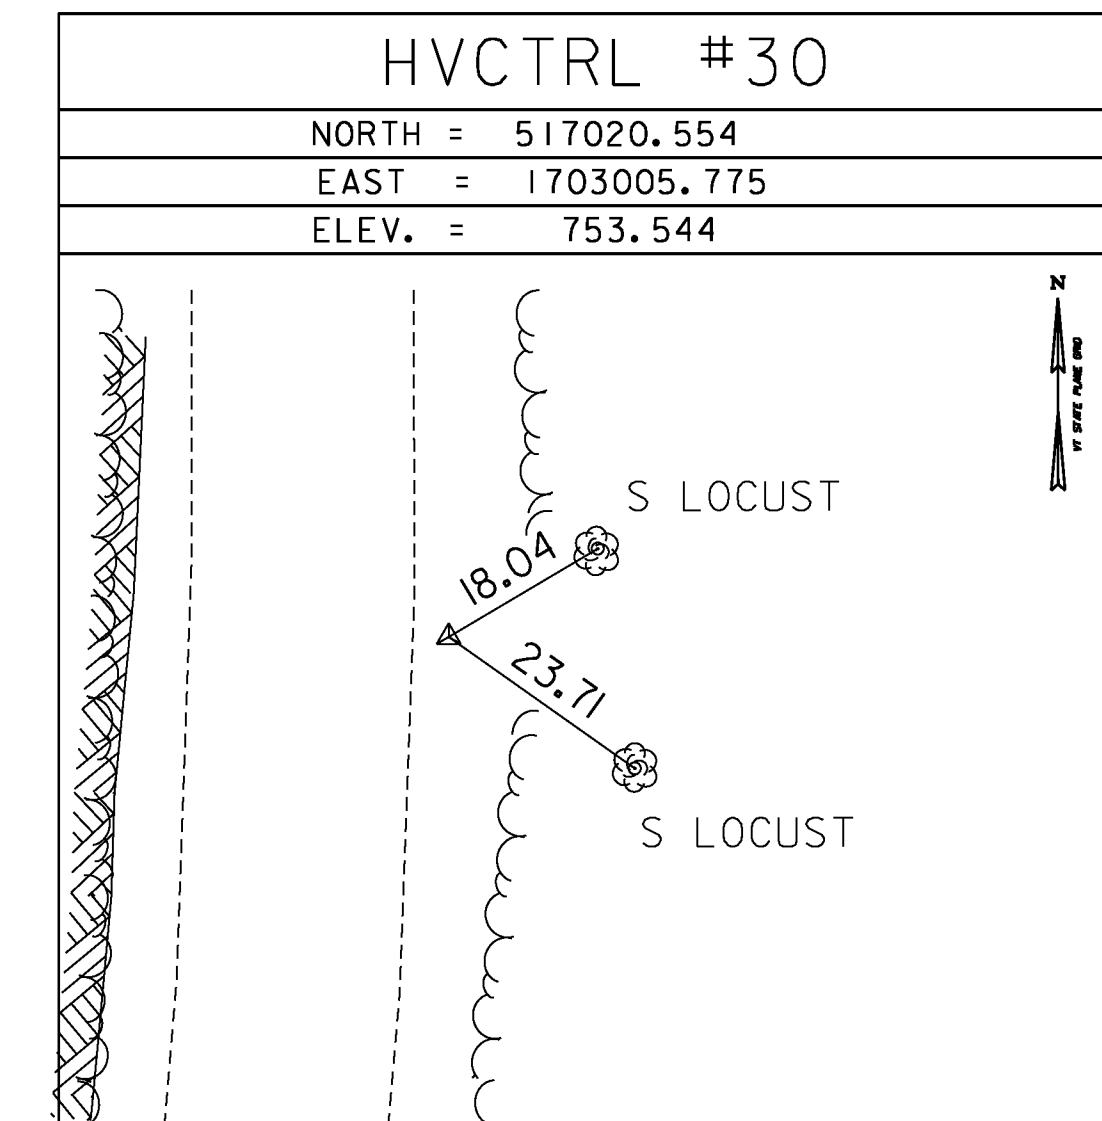
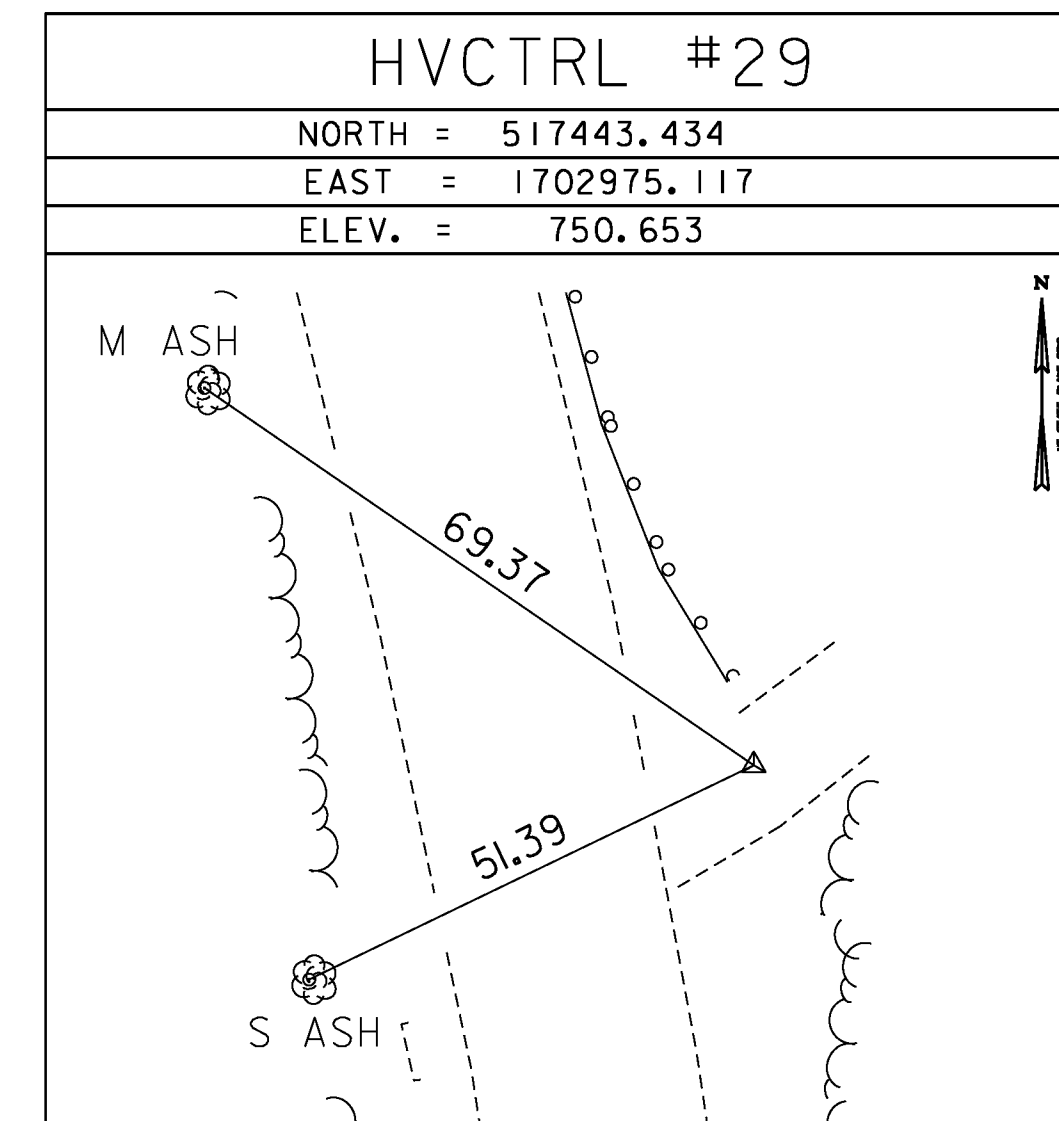
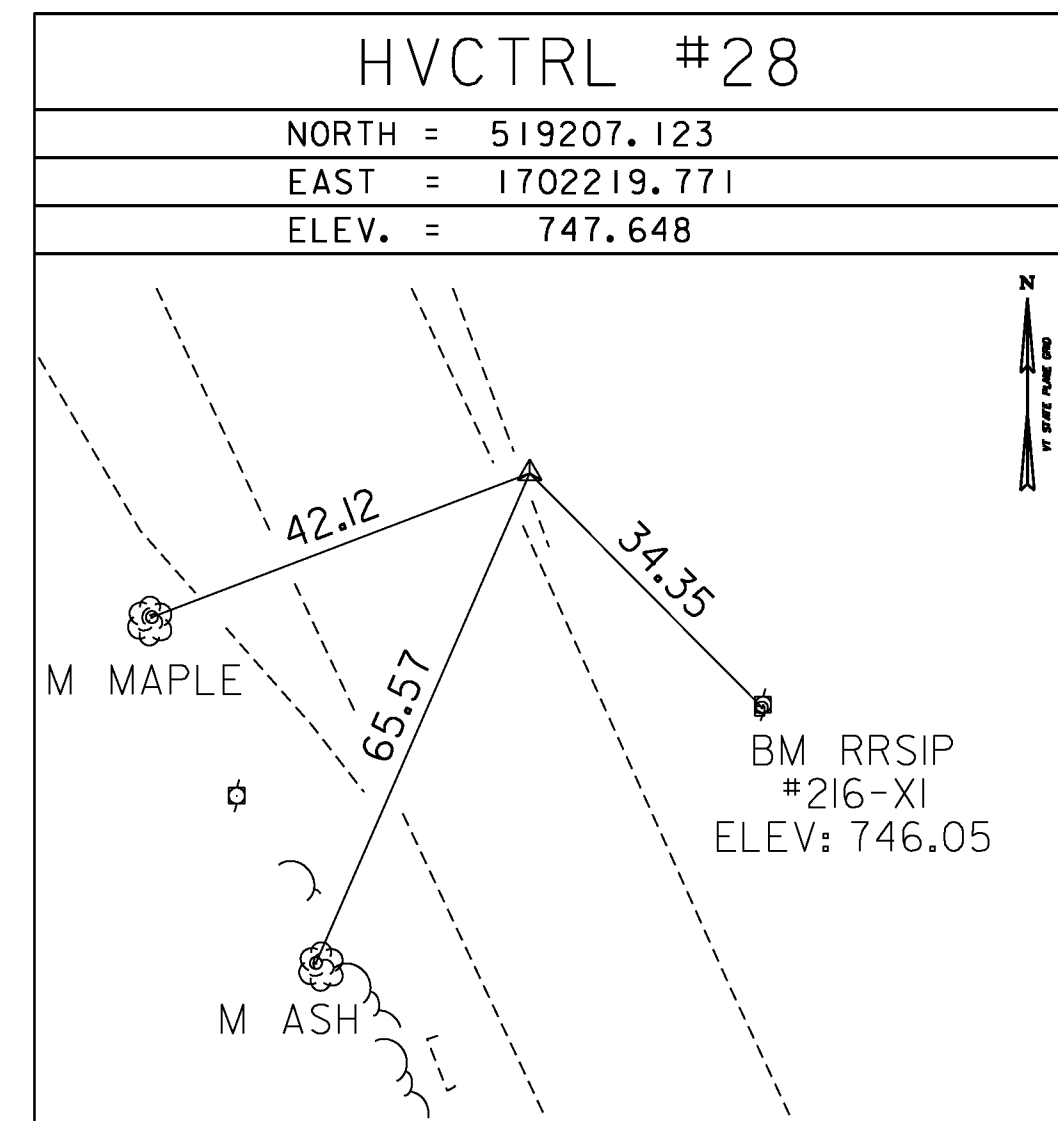
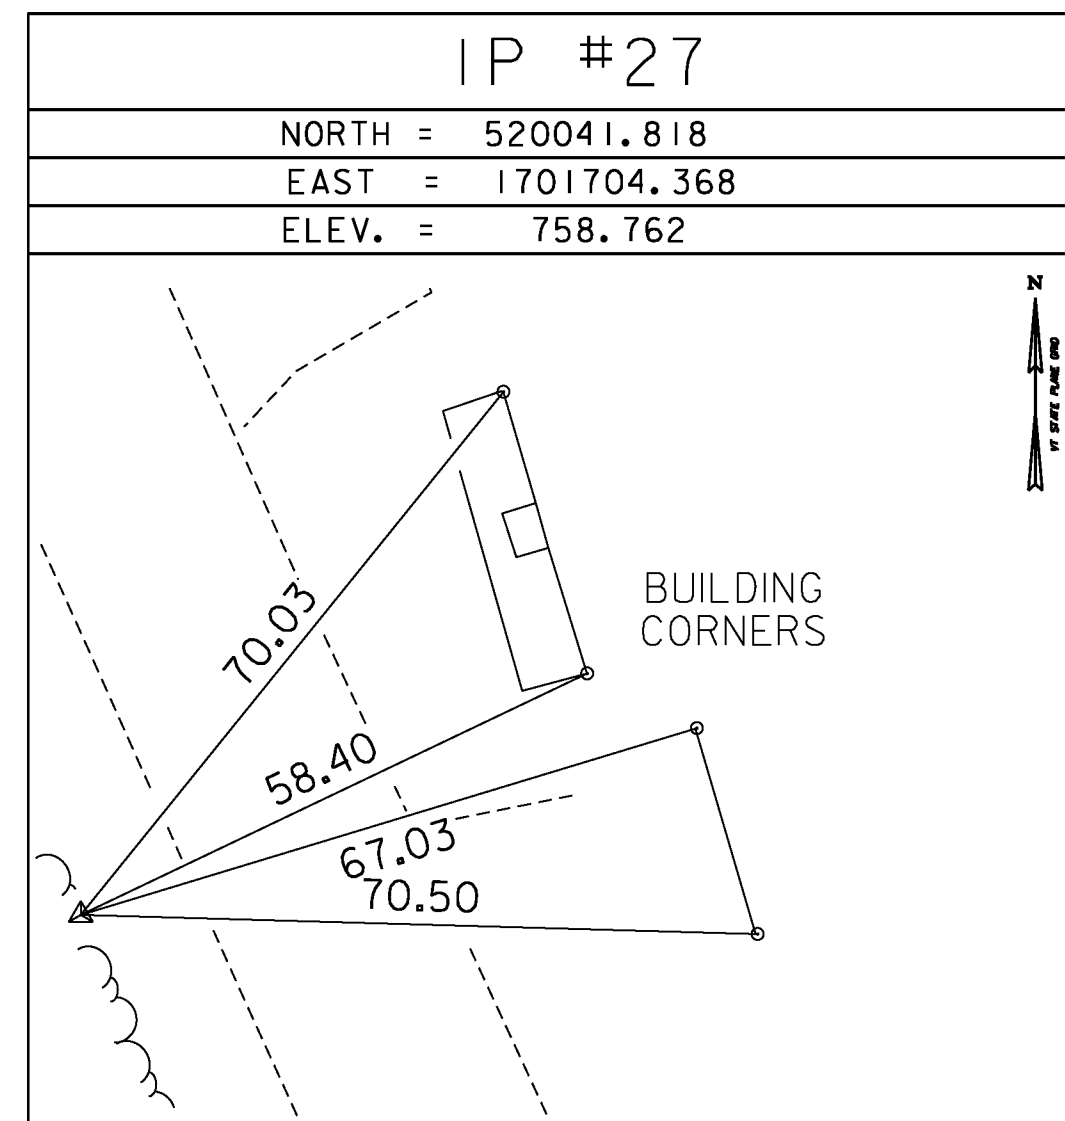
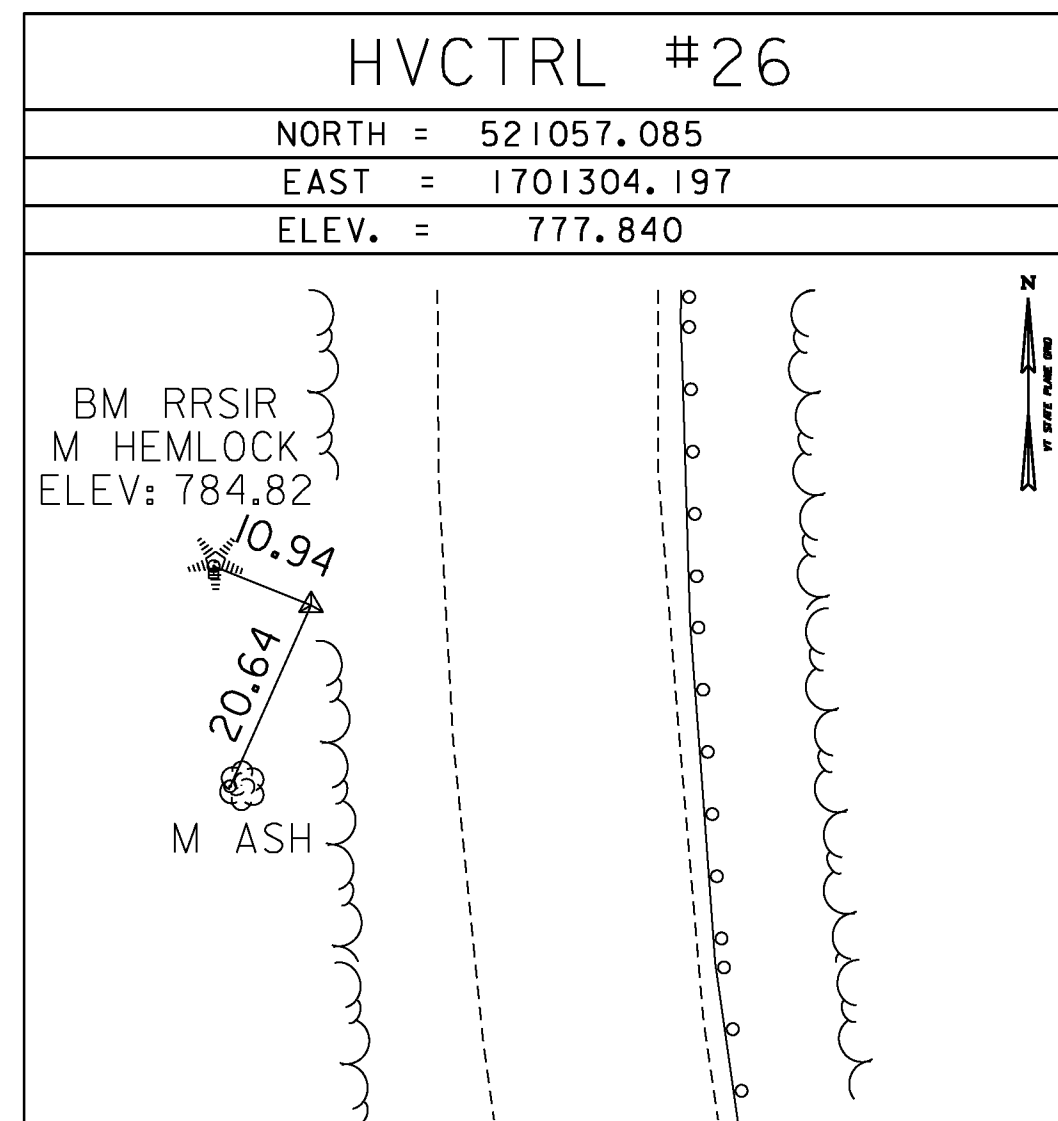
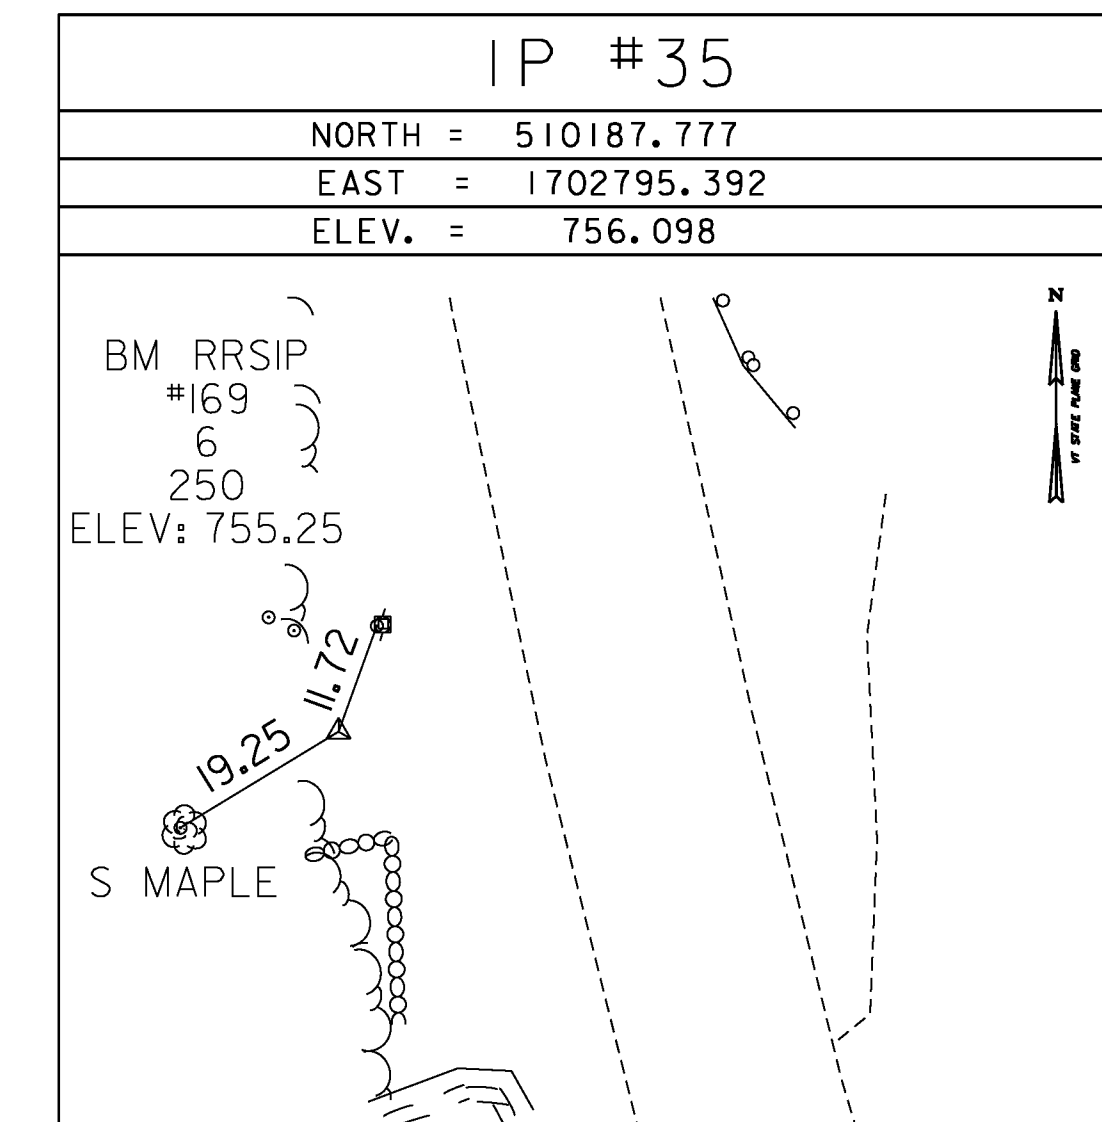
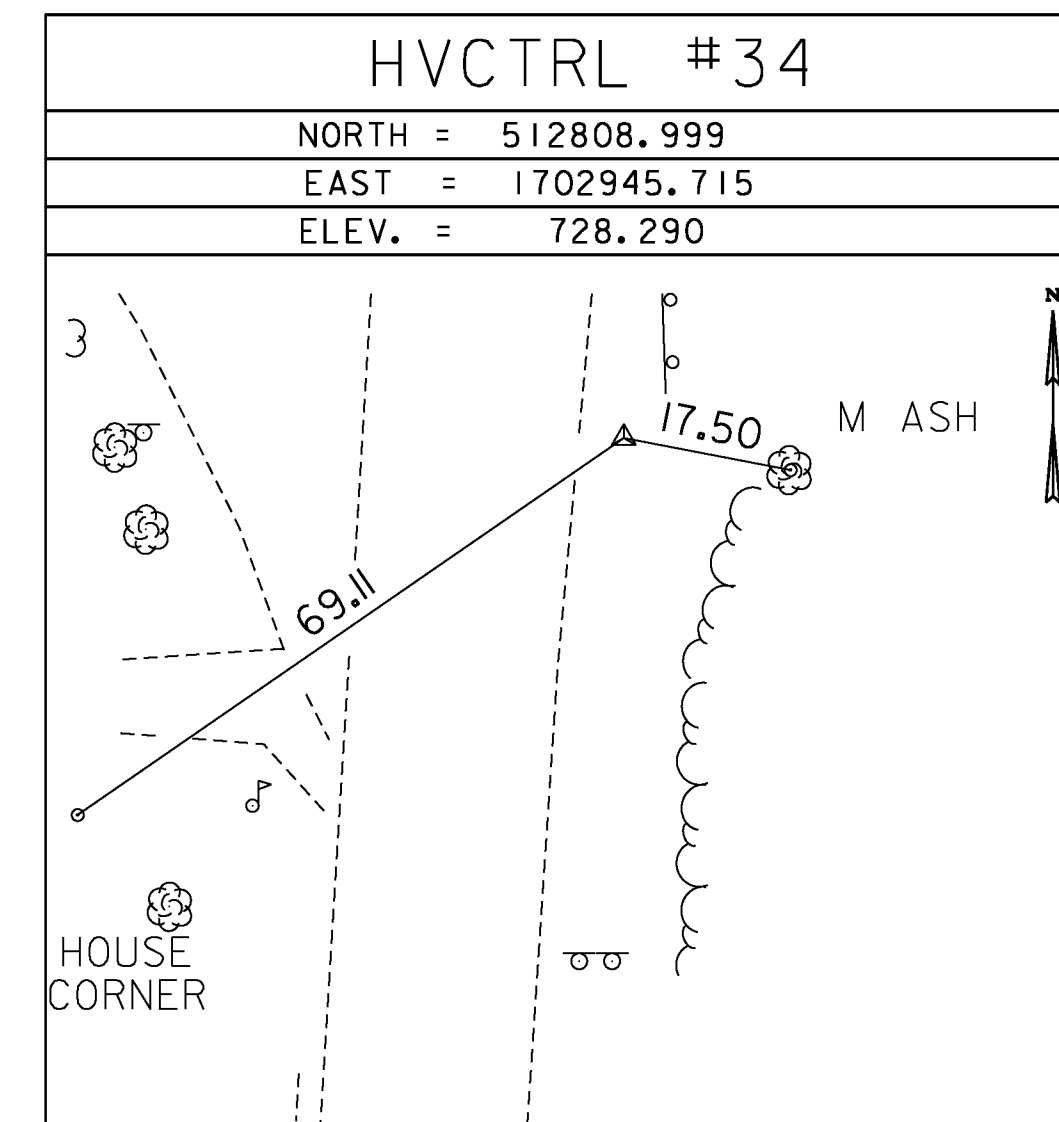
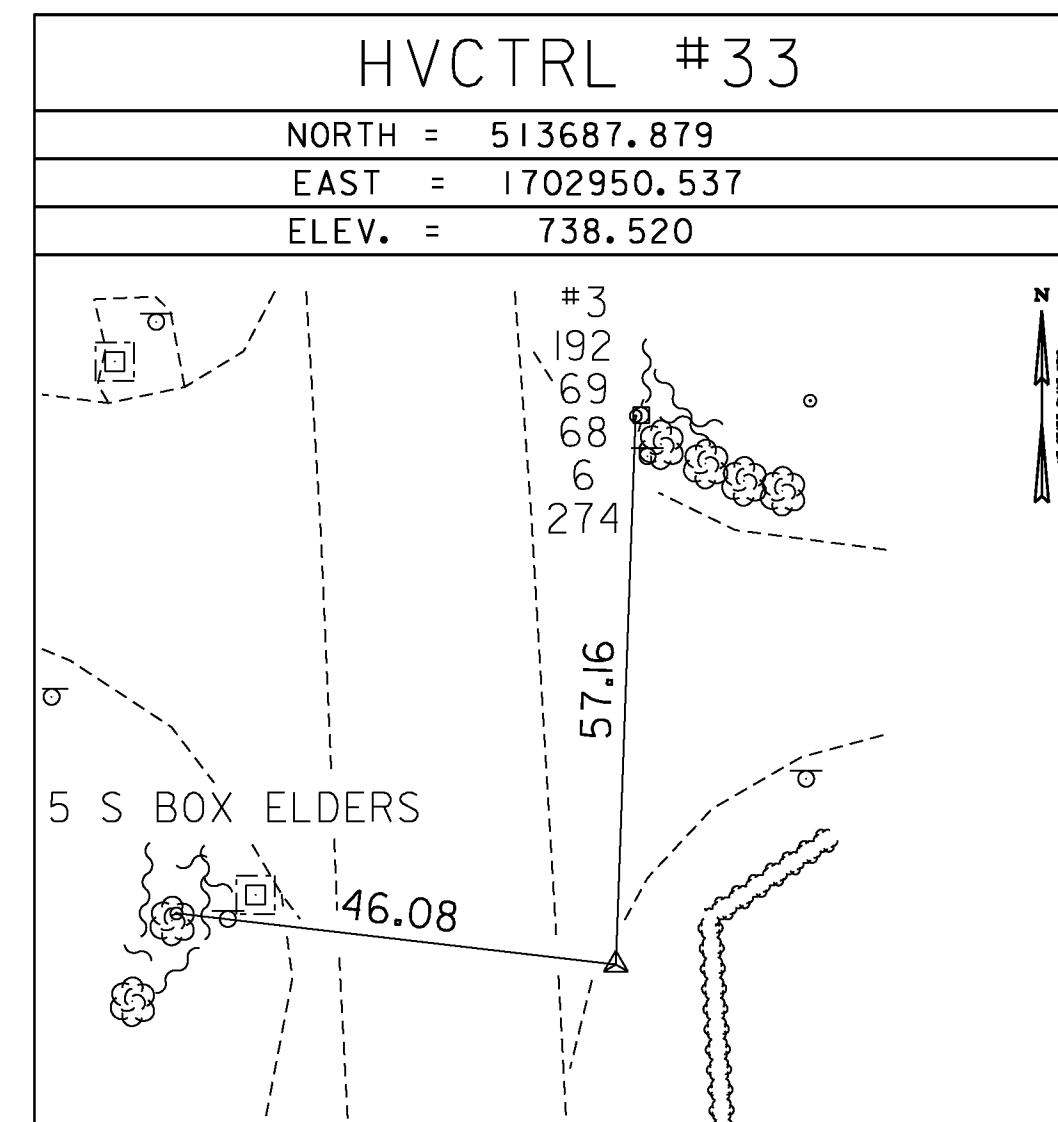







TRAVERSE TIES

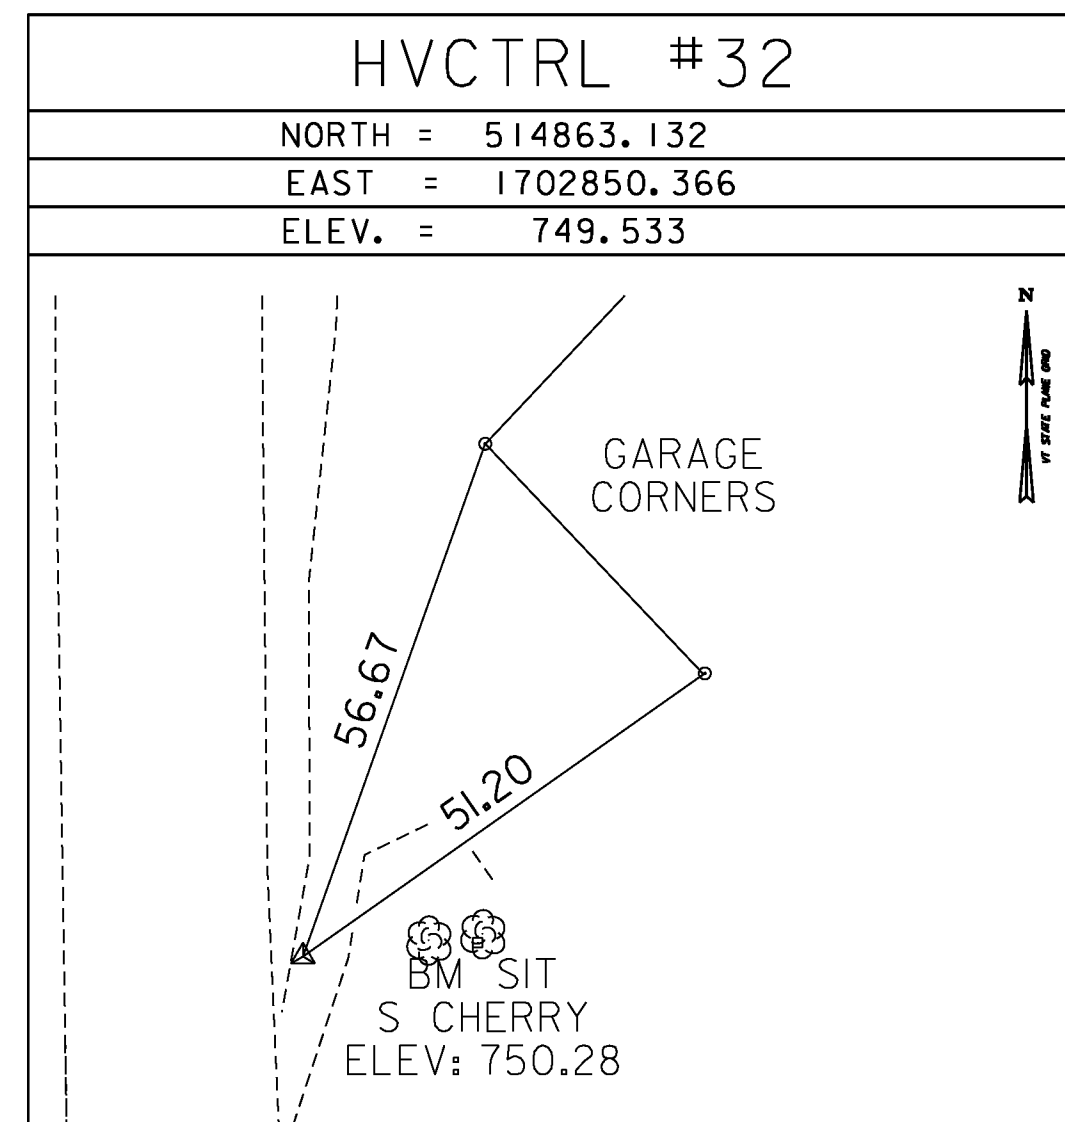

TRAVERSE TIES

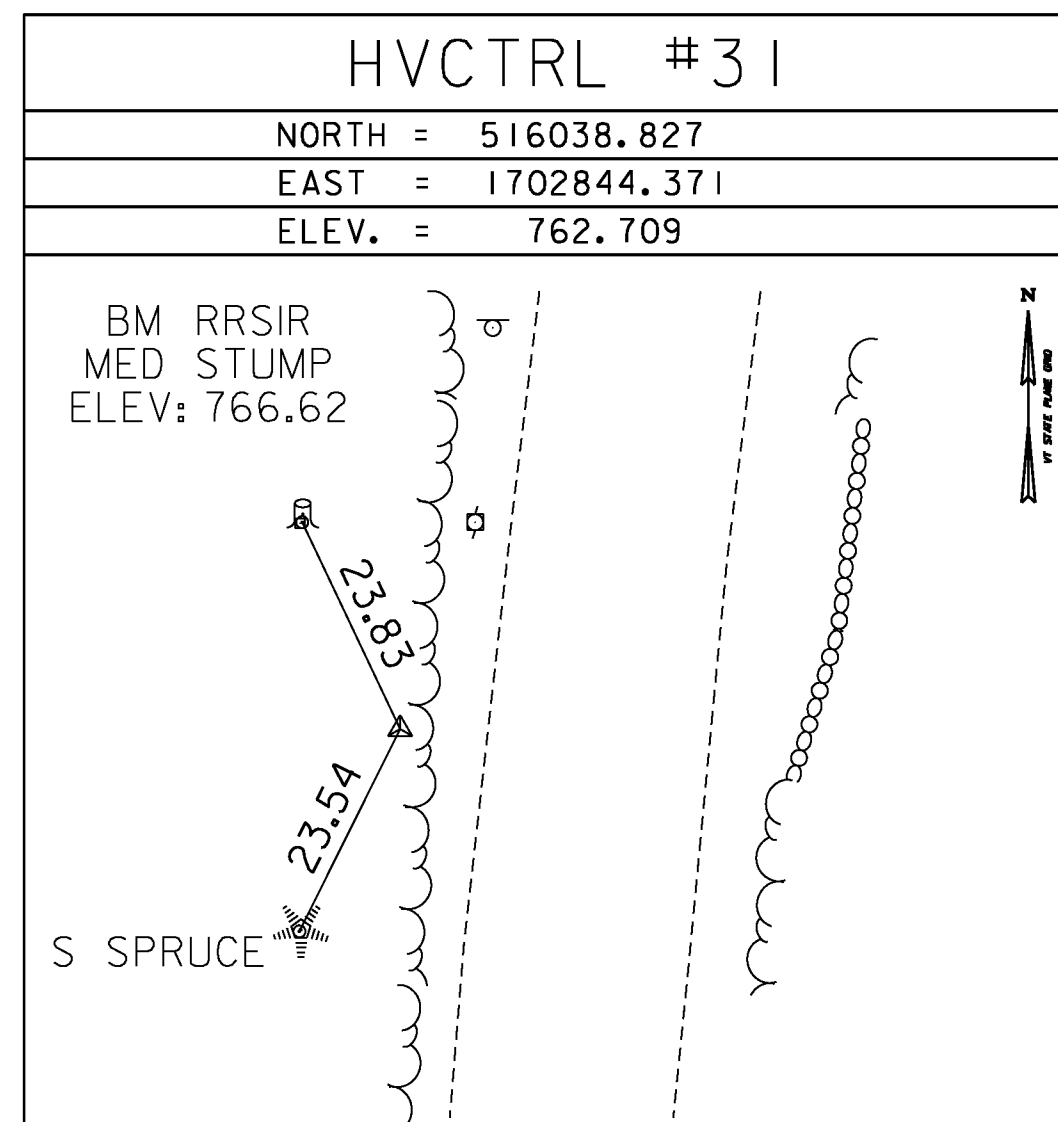

TRAVERSE TIES

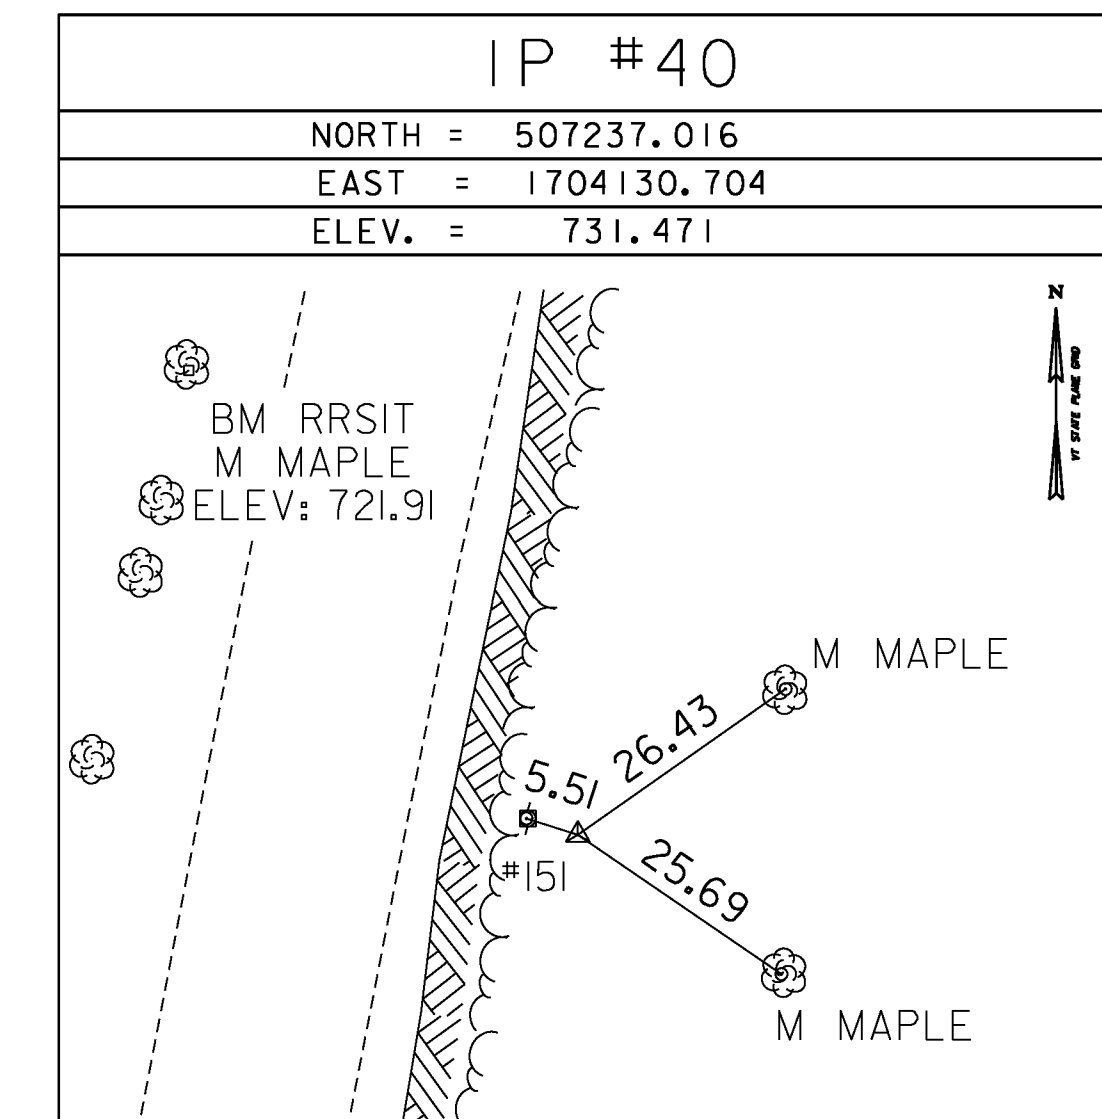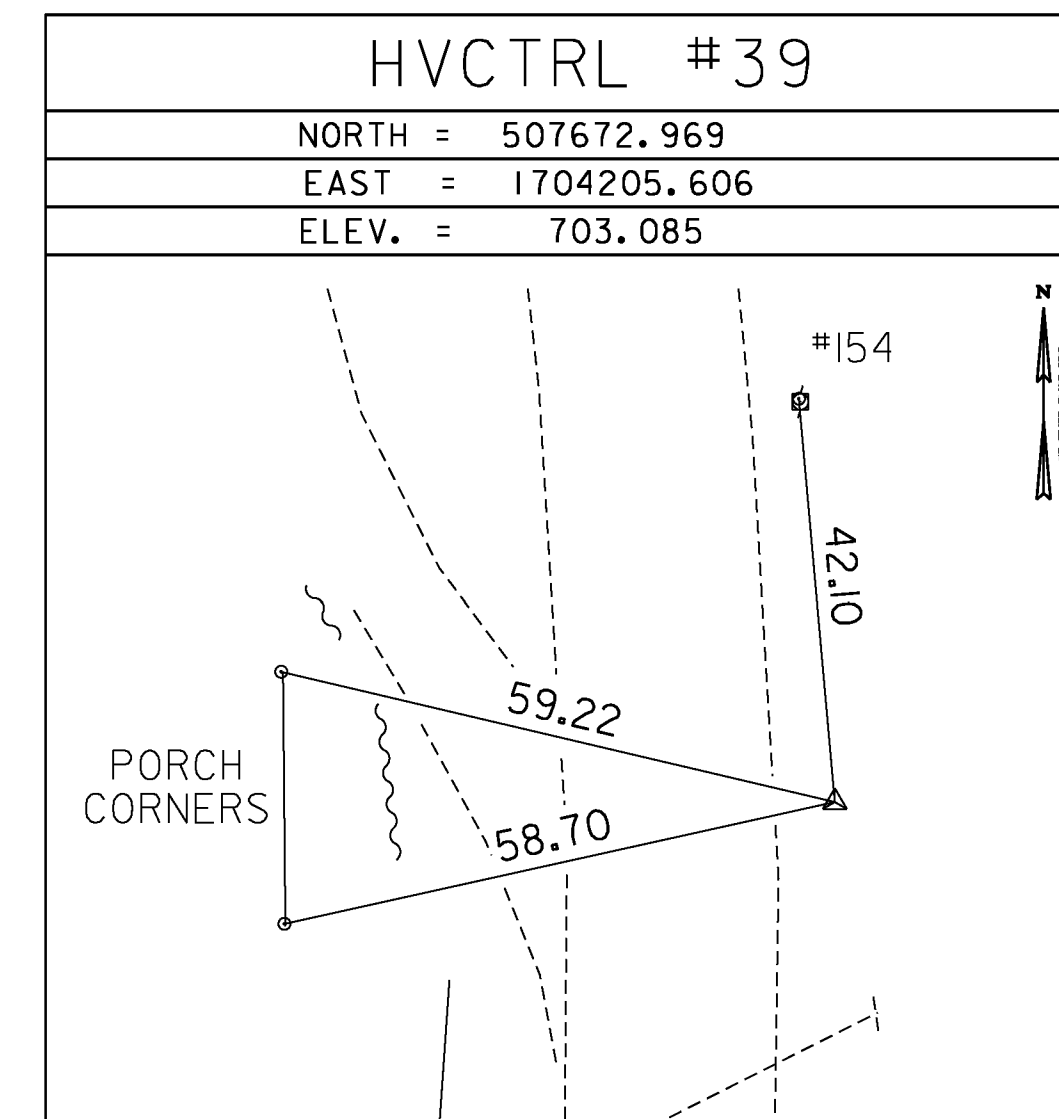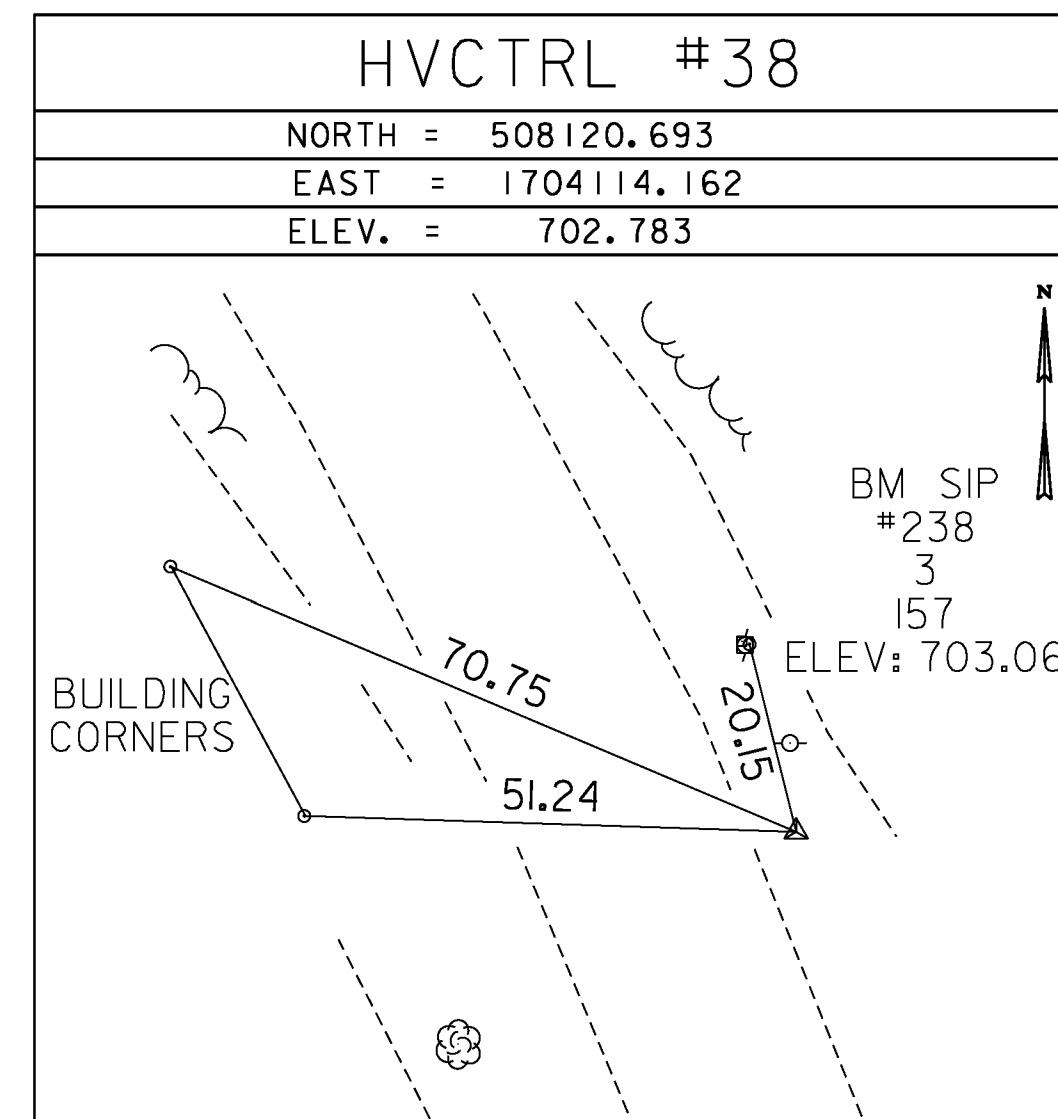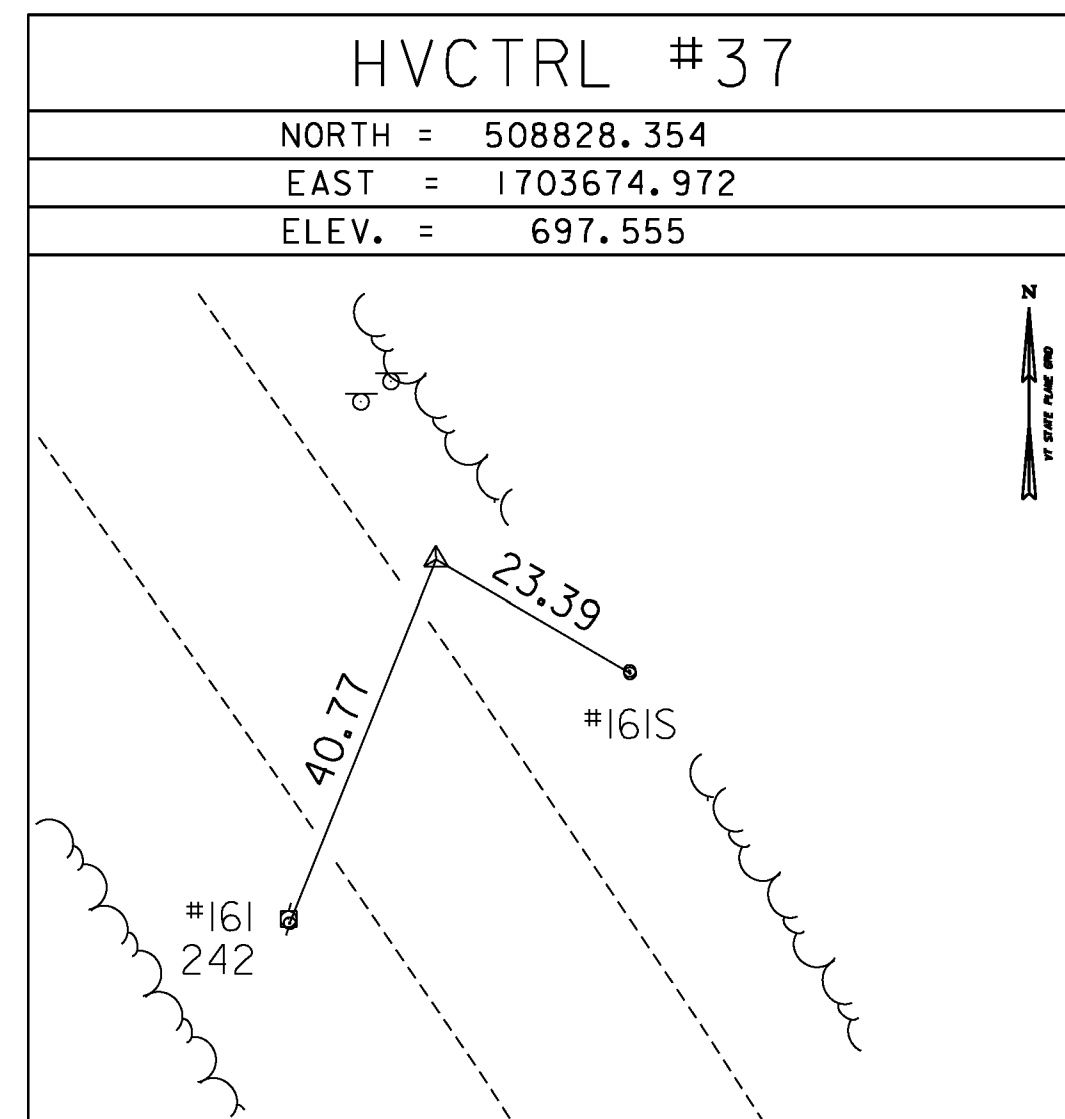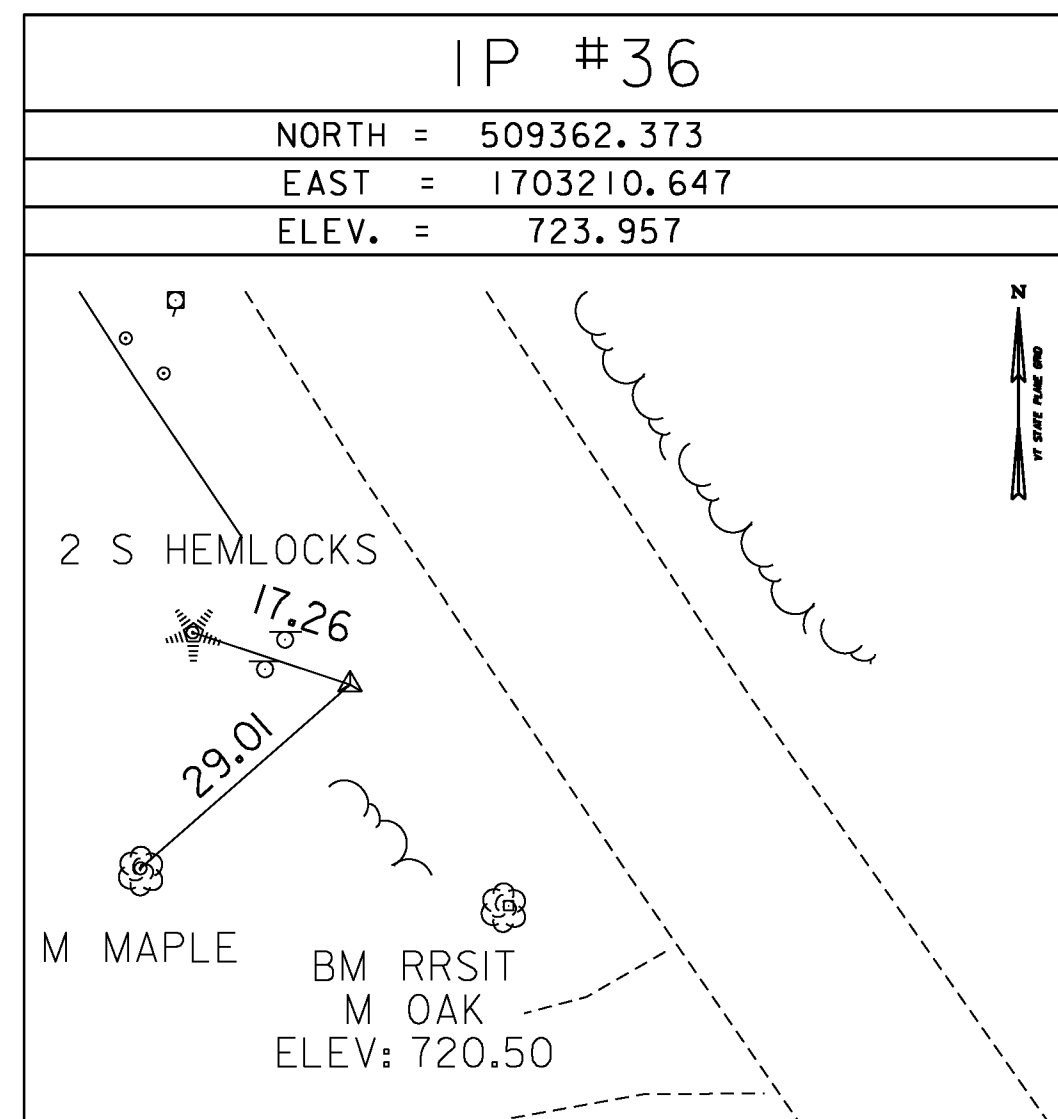

DATUM	
VERTICAL	NAVD 88
HORIZONTAL	NAD 83(07)
ADJUSTMENT	COMPASS

PROJECT NAME:	VERSHIRE - THETFORD
PROJECT NUMBER:	STP 29II (I)
FILE NAME:	survey\xl0c224t1.dgn
PROJECT LEADER:	MIKE FOWLER
DESIGNED BY:	VTRANS
TIE SHEET	3
PLOT DATE:	1/29/2013
DRAWN BY:	R. BULLOCK
CHECKED BY:	VTRANS
SHEET	5 OF 232