

TEMPORARY 4 INCH WHITE LINE, PAINT  
 DURABLE 4 INCH WHITE LINE (OPTION BID ITEM)  
 192+50 TO 204+50 SOLID LT  
 192+50 TO 204+50 SOLID RT

TEMPORARY 4 INCH YELLOW LINE, PAINT  
 DURABLE 4 INCH YELLOW LINE (OPTION BID ITEM)  
 192+50 TO 204+50 SOLID LT & RT

6 INCH UNDERDRAIN PIPE  
 192+50 TO 195+25 LT  
 192+23 TO 195+75 LT  
 STEEL BEAM GUARDRAIL,  
 GALVANIZED W/8 FEET POSTS  
 192+80 TO 195+92.5 RT  
 202+46 TO 204+46 RT



ANCHOR FOR STEEL BEAM RAIL  
 192+80 RT  
 195+92.5 RT  
 202+46 RT  
 204+46 RT

DELINEATOR WITH STEEL POST  
 192+80 RT  
 195+92.5 RT  
 202+46 RT  
 204+46 RT

REMOVAL AND DISPOSAL OF GUARDRAIL  
 192+80 TO 195+92 RT  
 197+56 TO 198+70 LT  
 197+68 TO 198+58 RT  
 202+56 TO 204+47 RT

REMOVING SIGNS  
 AS SHOWN - 4

CURVE (1)  
 DELTA = 5° 16' 53" LT  
 D = 2° 59' 59"  
 R = 1910.10'  
 T = 88.10'  
 L = 176.07'  
 E = 2.03'  
 BANK = 0.037

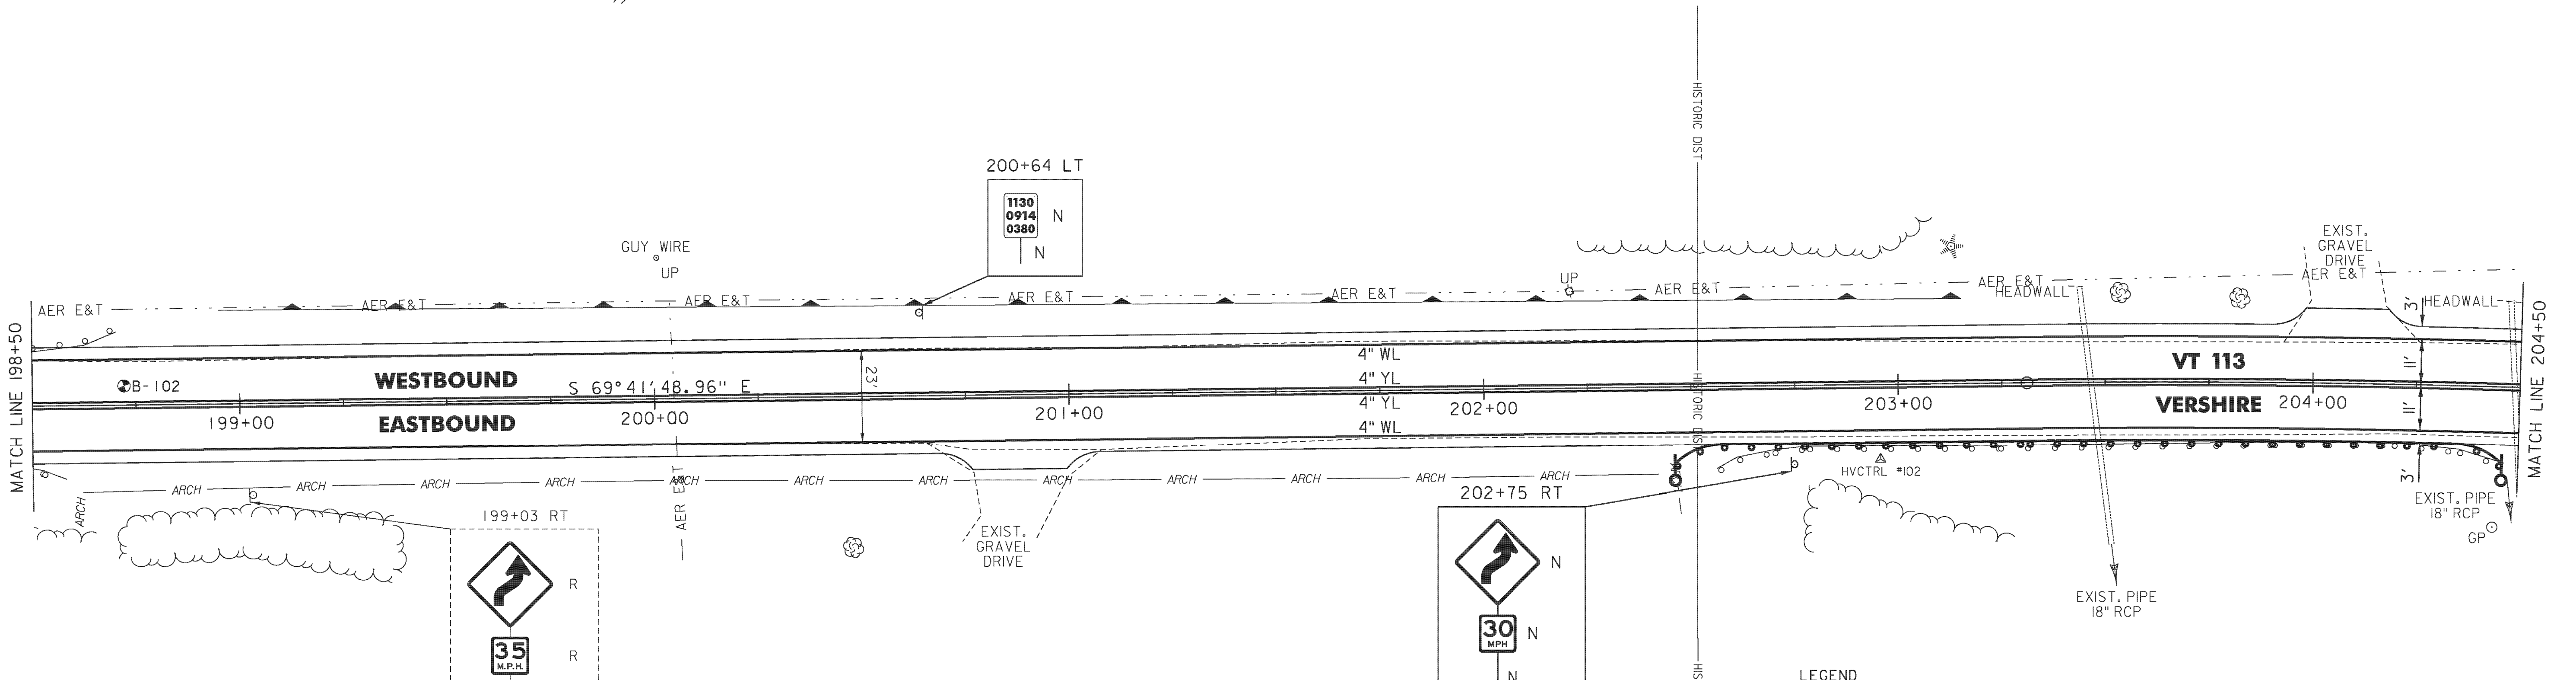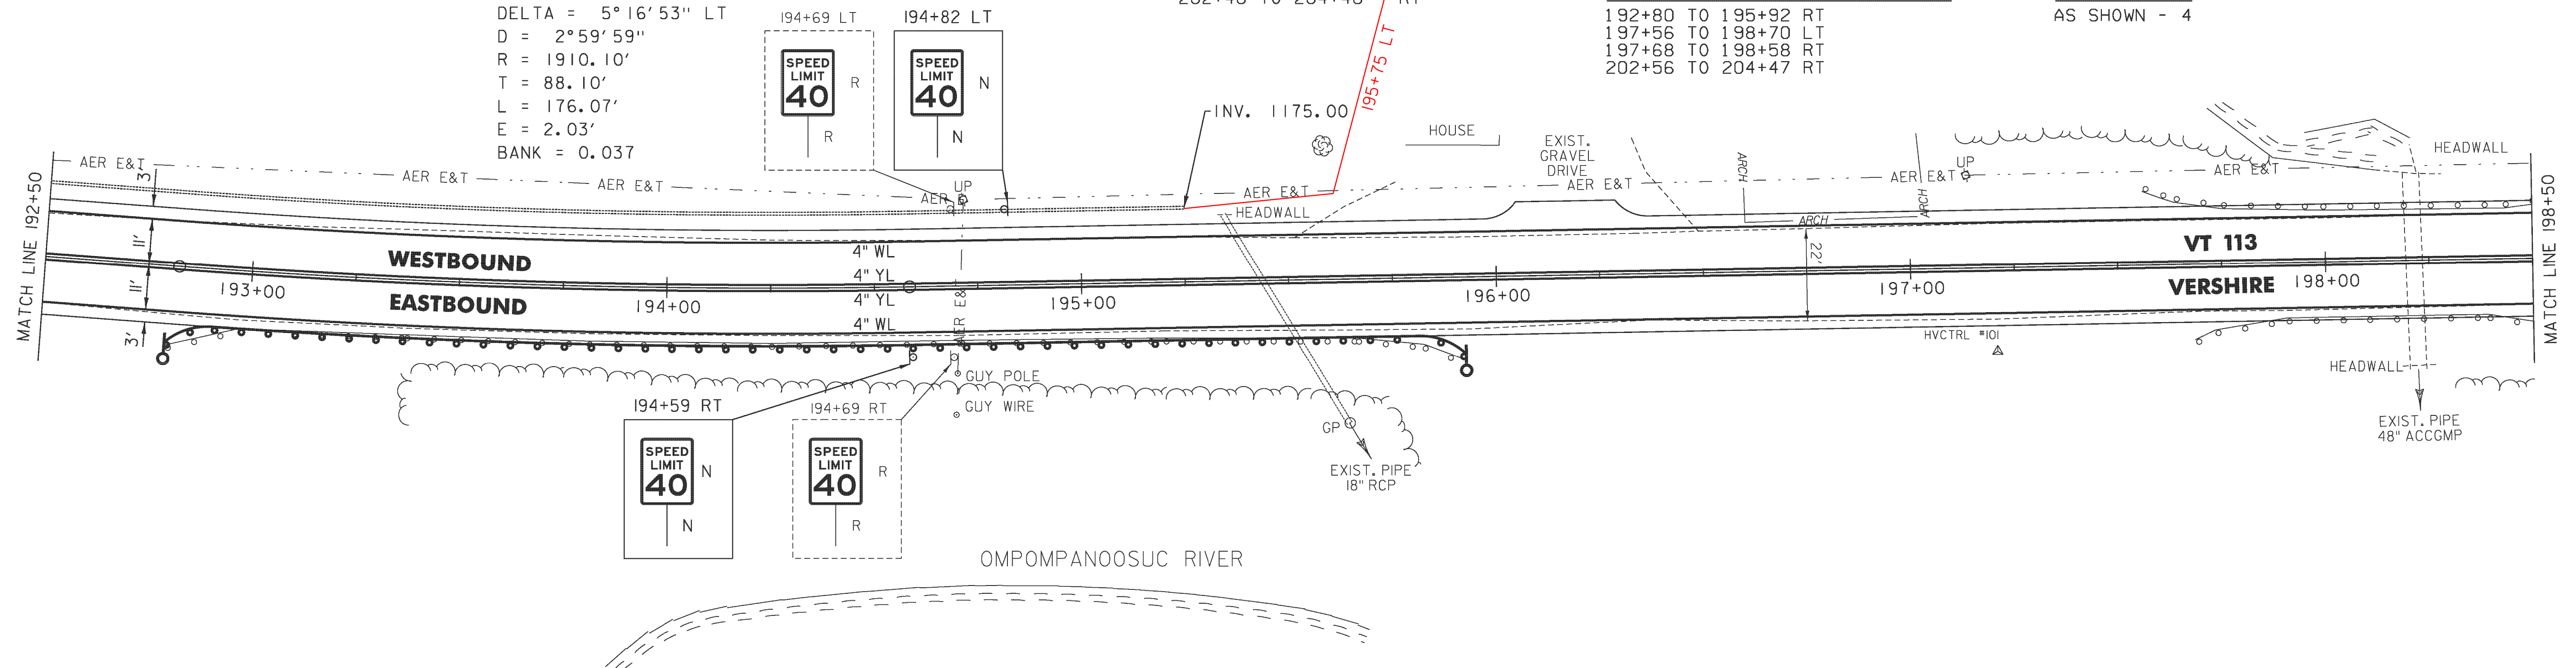

- LEGEND**
- R = REMOVE EXISTING
  - S = SALVAGE
  - R&S = REMOVE AND SALVAGE
  - N = NEW
  - RET = RETAIN
  - B-B = BACK TO BACK
  - o— = EXISTING GUARDRAIL
  - b— = PROPOSED GUARDRAIL
  - YL = YELLOW LINE
  - WL = WHITE LINE
  - o— = DELINEATOR
  - o— = PROPOSED UP

**ROADWAY LAYOUT 2**

PROJECT NAME: VERSHIRE-THETFORD  
 PROJECT NUMBER: STP 2911(I)

FILE NAME: p10c224.dgn  
 PROJECT LEADER: PTS  
 DESIGNED BY: NLL  
 IPARM FILE NAME: IOC224.29

PLOT DATE: 3/8/2013  
 DRAWN BY: SNG  
 CHECKED BY: PTS  
 SHEET 29 OF 232

NOT TO SCALE