

TEMPORARY 4 INCH WHITE LINE, PAINT
 DURABLE 4 INCH WHITE LINE (OPTION BID ITEM)
 321+50 TO 333+50 SOLID LT
 321+50 TO 333+50 SOLID RT


TEMPORARY 4 INCH YELLOW LINE, PAINT
 DURABLE 4 INCH YELLOW LINE (OPTION BID ITEM)
 321+50 TO 323+14 SOLID LT & RT
 323+14 TO 330+53 SOLID LT, DASHED RT
 330+53 TO 333+50 DASHED CL

6 INCH UNDERDRAIN PIPE
 333+00 TO 333+50 RT
 333+15


STEEL BEAM GUARDRAIL, GALVANIZED
 321+50 TO 322+43.8 LT
 ANCHOR FOR STEEL BEAM RAIL
 322+43.8 LT

REMOVAL AND DISPOSAL OF GUARDRAIL
 321+50 TO 322+43 LT
 330+68 TO 332+57 LT
 331+16 TO 332+56 RT
 DELINEATOR WITH STEEL POST
 322+43.8 LT

REMOVING SIGNS
 AS SHOWN - 2

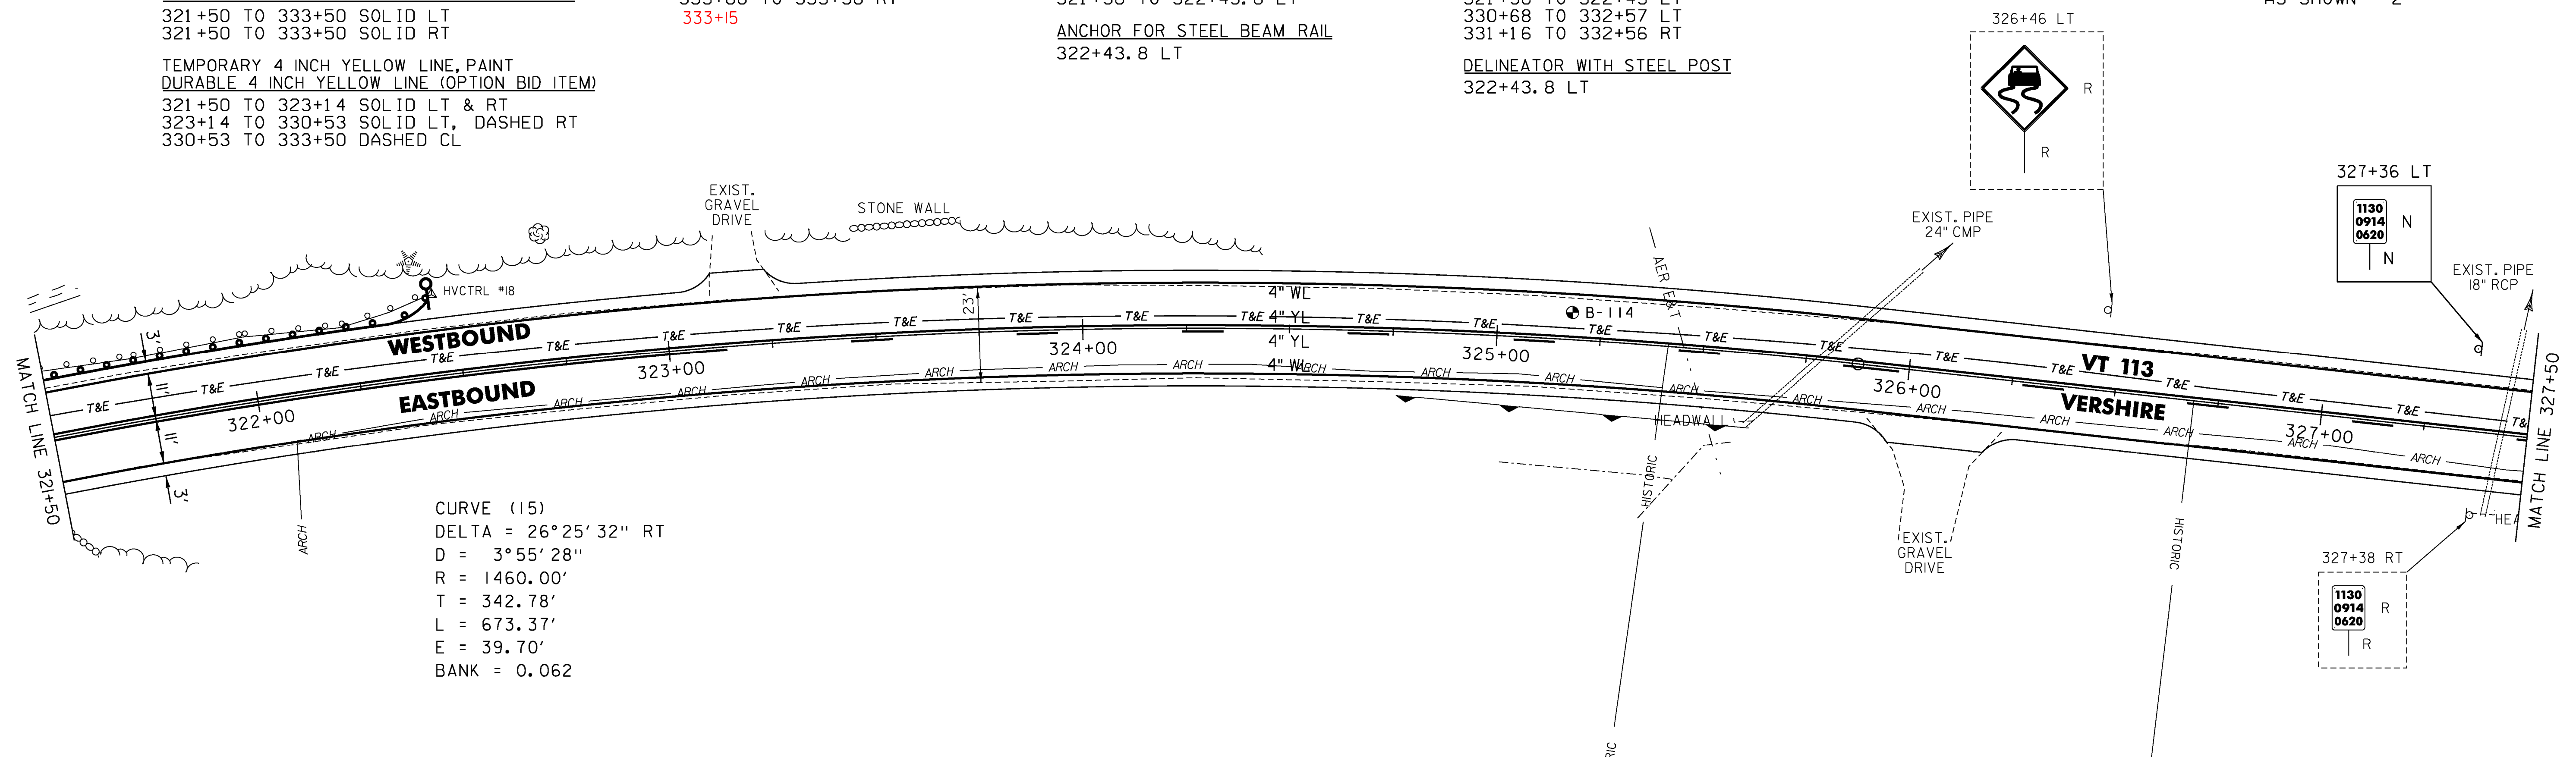

CURVE (15)
 DELTA = 26°25'32" RT
 D = 3°55'28"
 R = 1460.00'
 T = 342.78'
 L = 673.37'
 E = 39.70'
 BANK = 0.062

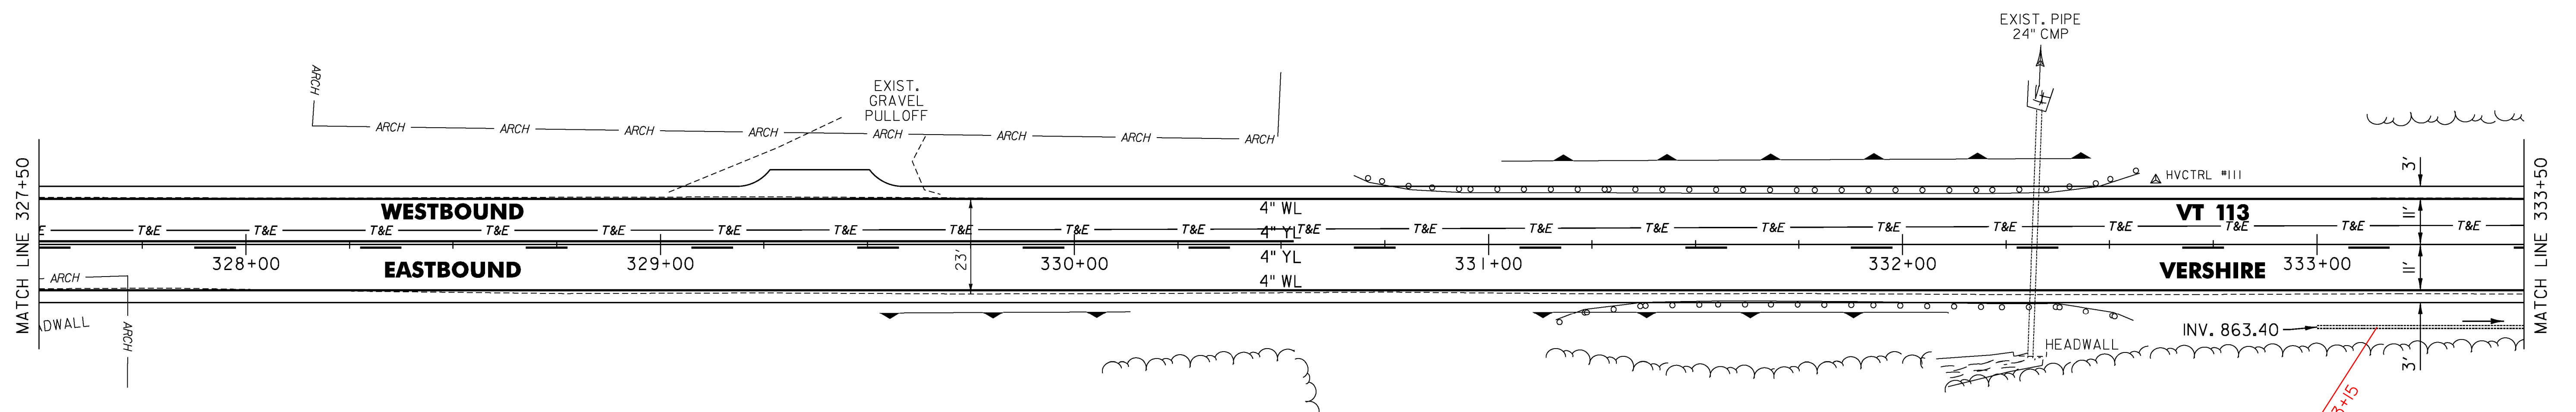

- LEGEND**
- R = REMOVE EXISTING
 - S = SALVAGE
 - R&S = REMOVE AND SALVAGE
 - N = NEW
 - RET = RETAIN
 - B-B = BACK TO BACK
 - = EXISTING GUARDRAIL
 - ⊥ = PROPOSED GUARDRAIL
 - YL = YELLOW LINE
 - WL = WHITE LINE
 - ⊥ = DELINEATOR
 - ⊥ = PROPOSED UP

ROADWAY LAYOUT 14

PROJECT NAME: VERSHIRE-THETFORD

PROJECT NUMBER: STP 2911(I)

FILE NAME: p10c224.dgn
 PROJECT LEADER: PTS
 DESIGNED BY: NLL
 IPARM FILE NAME: IOC224.4I

PLOT DATE: 3/8/2013
 DRAWN BY: SNG
 CHECKED BY: PTS
 SHEET 41 OF 232

NOT TO SCALE