

TEMPORARY 4 INCH WHITE LINE, PAINT
 DURABLE 4 INCH WHITE LINE (OPTION BID ITEM)
 345+50 TO 356+50 SOLID LT
 345+50 TO 347+38 SOLID RT
 347+38 TO 347+84 SOLID RT (TH 27)
 348+00 TO 348+14 SOLID RT (TH 27)
 348+14 TO 356+50 SOLID RT


TEMPORARY 4 INCH YELLOW LINE, PAINT
 DURABLE 4 INCH YELLOW LINE (OPTION BID ITEM)
 345+50 TO 347+60 SOLID LT & RT
 347+80 TO 347+92 DOUBLE SOLID LT (TH 27)
 348+00 TO 353+76 SOLID LT, DASHED RT
 353+76 TO 355+34 DASHED CL
 355+34 TO 356+50 DASHED LT, SOLID RT

TEMPORARY 24" STOP BAR, PAINT
 DURABLE 24" STOP BAR (OPTION BID ITEM)
 347+80 TO 348+00 RT (TH 27)
 TEMPORARY LETTER OR SYMBOL, PAINT
 DURABLE LETTER OR SYMBOL (OPTION BID ITEM)
 347+92 RT - "STOP" (TH 27)

6 INCH UNDERDRAIN PIPE
~~345+50 TO 347+40 RT~~
~~345+03 TO 347+75 RT~~
 STEEL BEAM GUARDRAIL, GALVANIZED
 350+27 TO 356+50 LT
 ANCHOR FOR STEEL BEAM RAIL
 350+27 LT

REMOVAL AND DISPOSAL OF GUARDRAIL
 350+26 TO 356+50 LT
 DELINEATOR WITH STEEL POST
 350+27 LT

REMOVING SIGNS
 AS SHOWN - 3

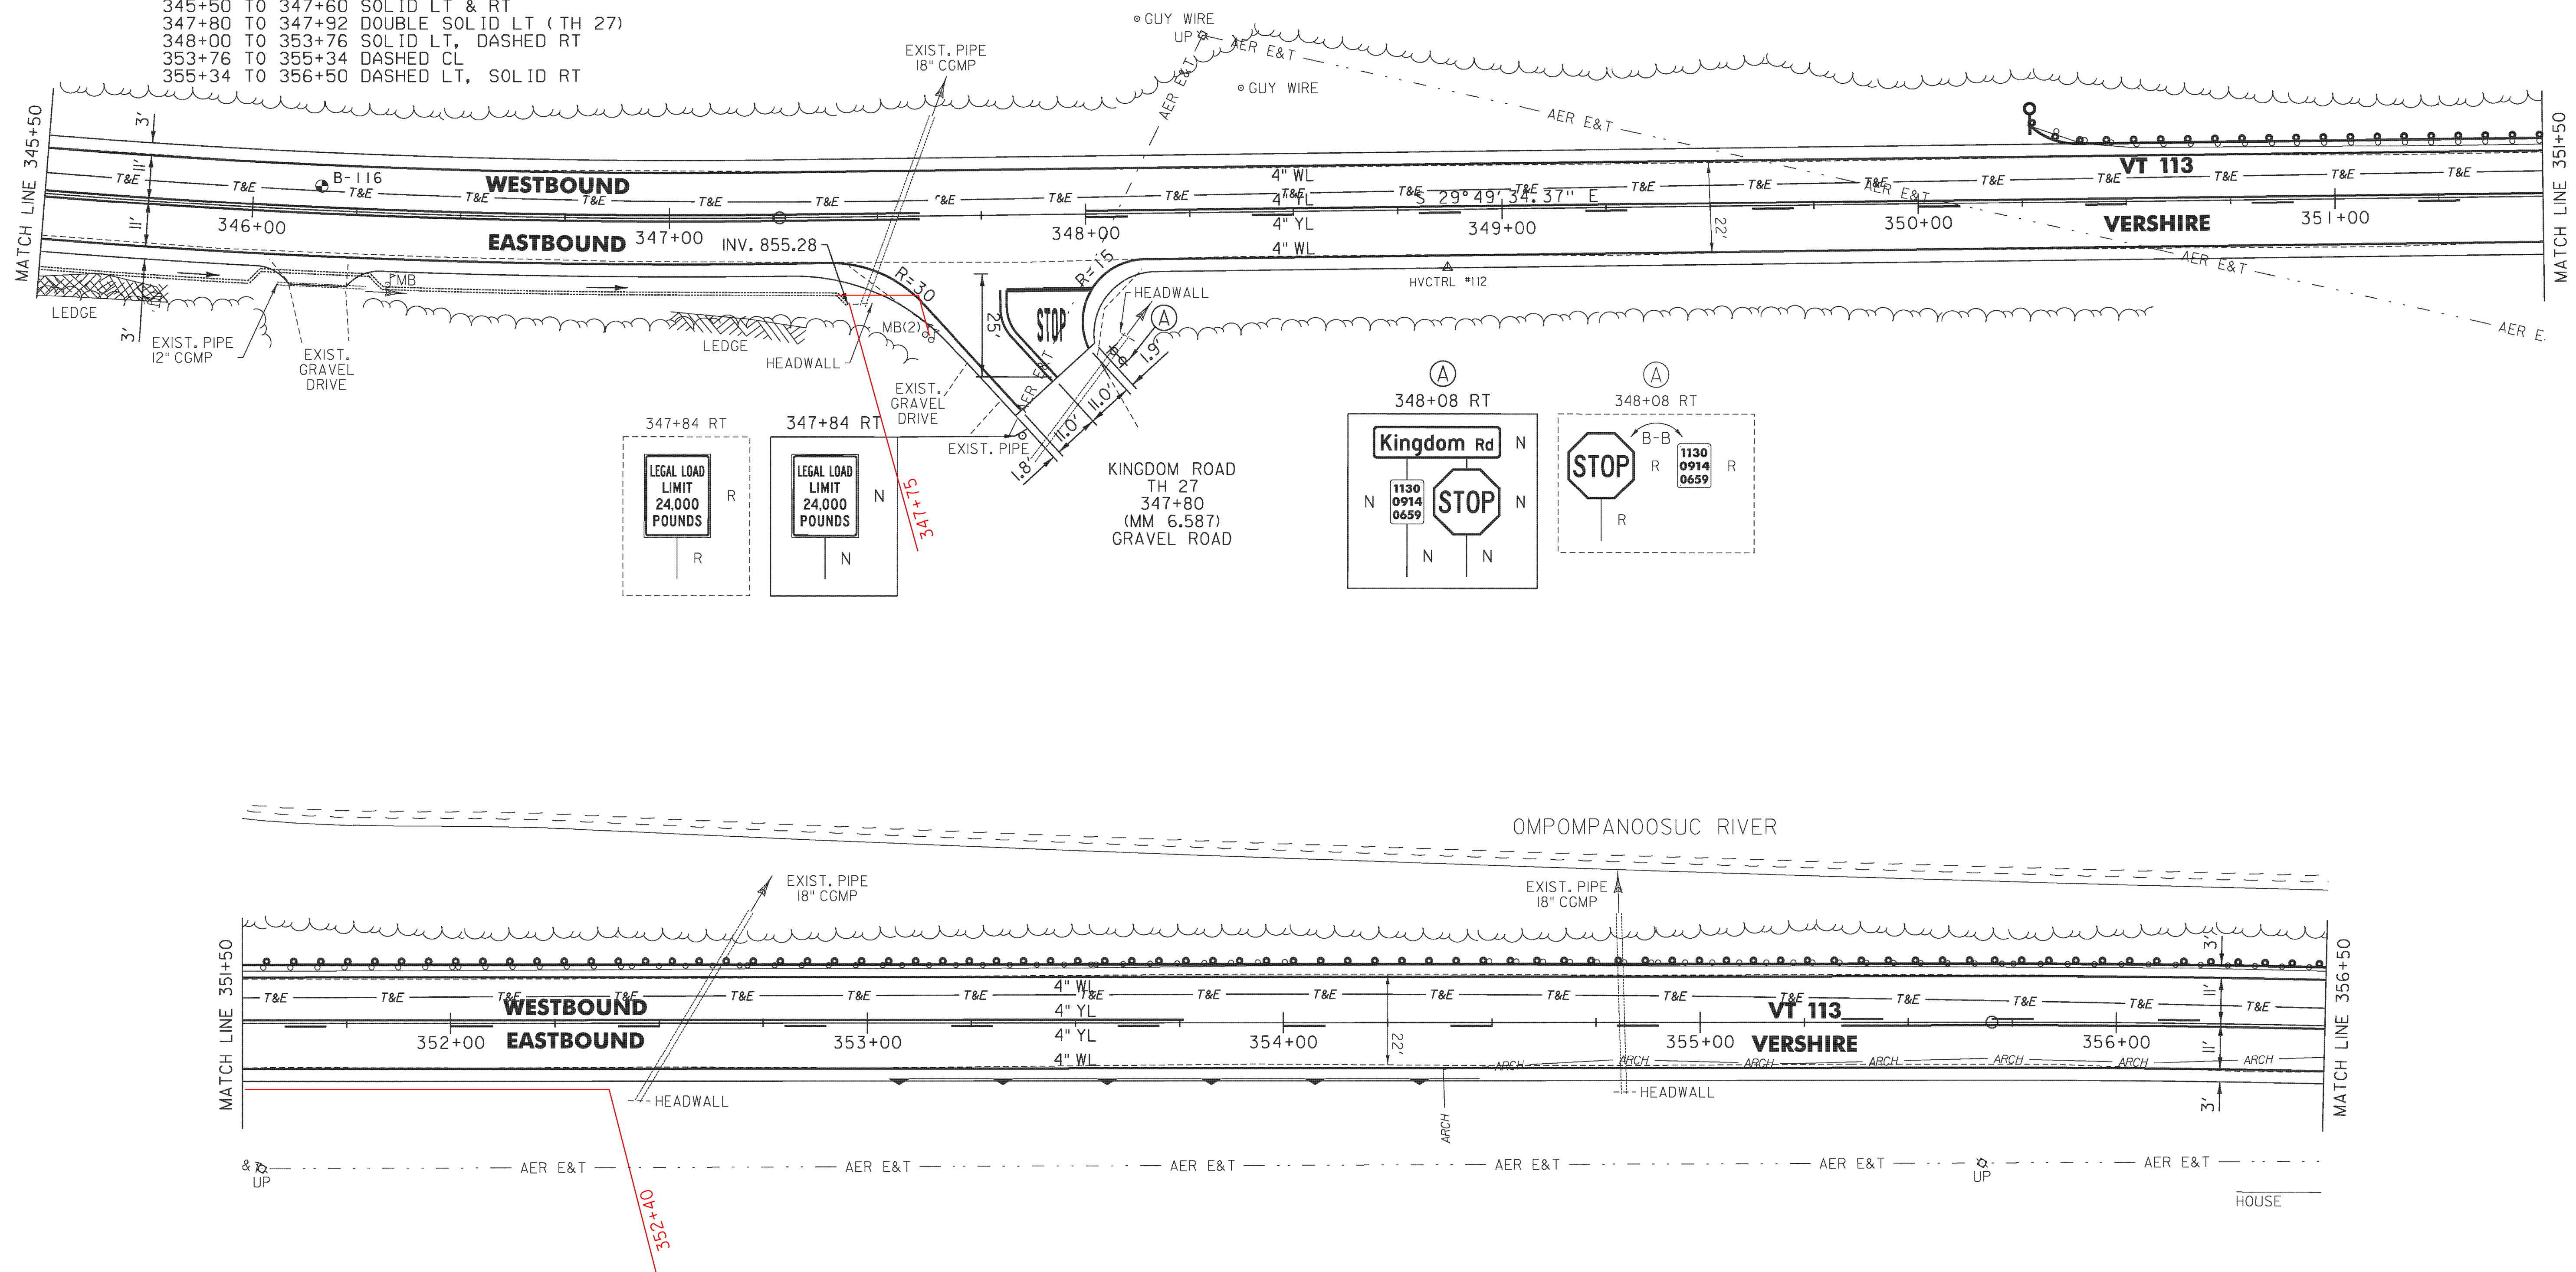

- LEGEND**
- R = REMOVE EXISTING
 - S = SALVAGE
 - R&S = REMOVE AND SALVAGE
 - N = NEW
 - RET = RETAIN
 - B-B = BACK TO BACK
 - = EXISTING GUARDRAIL
 - |— = PROPOSED GUARDRAIL
 - YL = YELLOW LINE
 - WL = WHITE LINE
 - = DELINEATOR
 - = PROPOSED UP

ROADWAY LAYOUT 16

PROJECT NAME: VERSHIRE-THETFORD
 PROJECT NUMBER: STP 2911(I)

FILE NAME: p10c224.dgn PLOT DATE: 3/8/2013
 PROJECT LEADER: PTS DRAWN BY: SNG
 DESIGNED BY: NLL CHECKED BY: PTS
 IPARM FILE NAME: IOC224.43 SHEET 43 OF 232