


TEMPORARY 4 INCH WHITE LINE, PAINT
 DURABLE 4 INCH WHITE LINE (OPTION BID ITEM)
 F42+50 TO F54+50 SOLID RT
 F42+50 TO F54+50 SOLID LT

TEMPORARY 4 INCH YELLOW LINE, PAINT
 DURABLE 4 INCH YELLOW LINE (OPTION BID ITEM)
 F42+50 TO F54+50 SOLID LT & RT


6 INCH UNDERDRAIN PIPE
 F44+00 TO F45+77 RT
 43+60
 F 52+40 TO 53+90 RT

REMOVAL AND DISPOSAL OF GUARDRAIL
 F42+50 TO F46+01 LT
 F48+50 TO F52+51 LT

REMOVING SIGNS
 AS SHOWN - 2

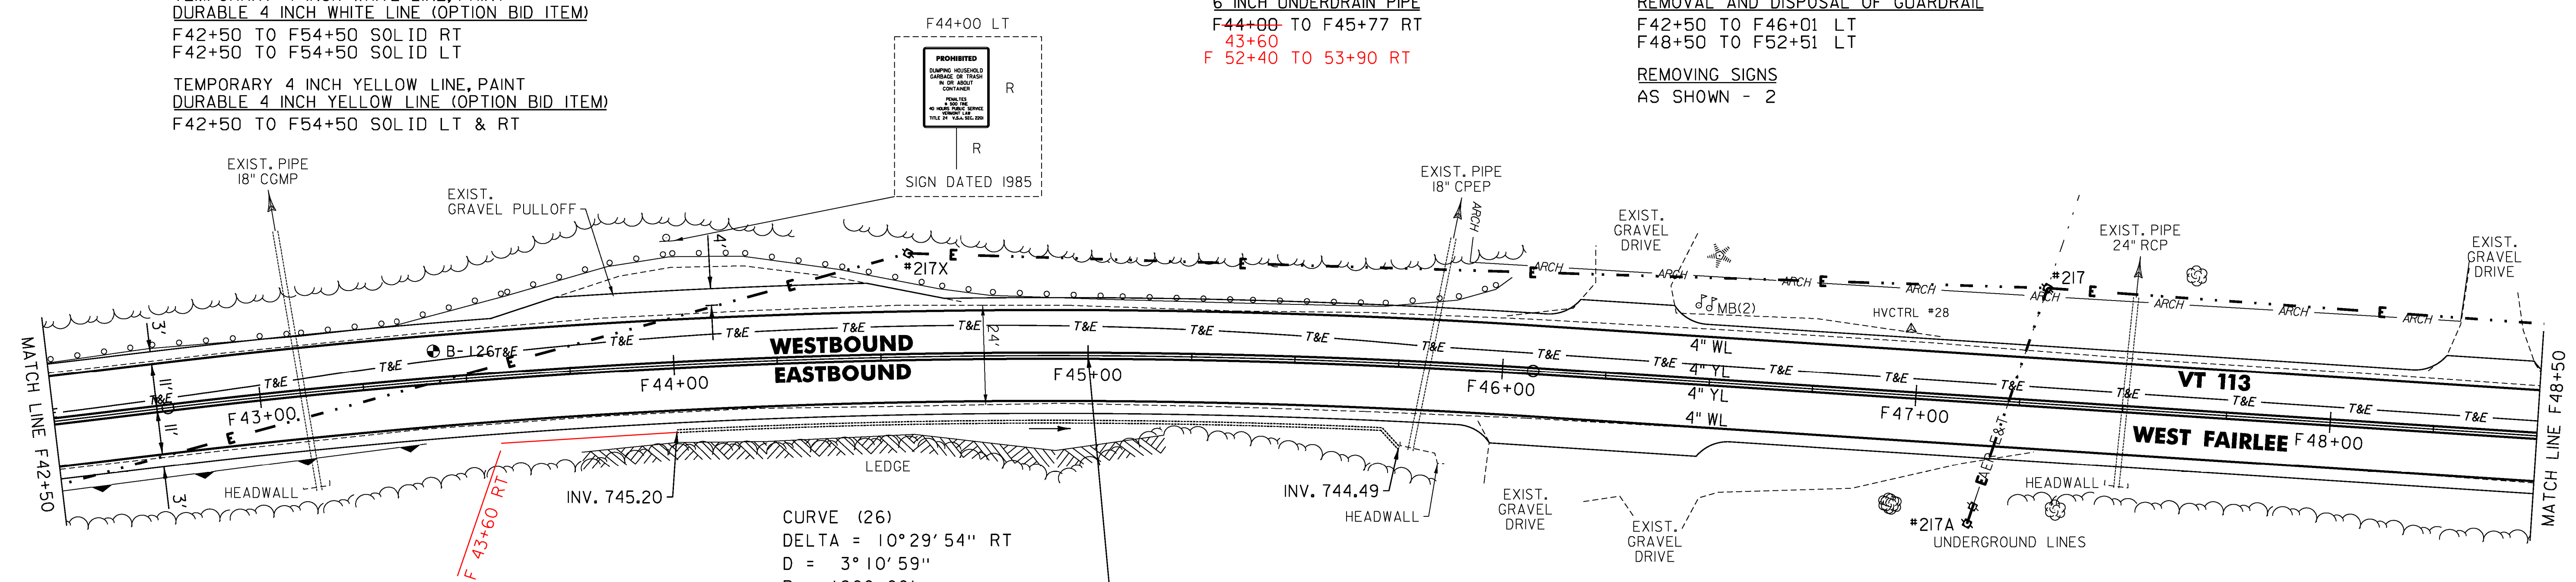

THERE IS A ONE INCH WATER LINE CROSSING VT 113 AT APPROXIMATELY F45+00. THE LOCATION AND DEPTH ARE NOT KNOWN. THE CONTRACTOR WILL TAKE THE NECESSARY PRECAUTIONS WHEN RECLAIMING IN THIS VICINITY SO NOT TO DAMAGE THE WATER LINE. ANY DAMAGES INCURRED DUE TO THE CONTRACTOR'S OPERATIONS WILL BE REPAIRED BY THE CONTRACTOR AT NO ADDITIONAL COST TO THE STATE.

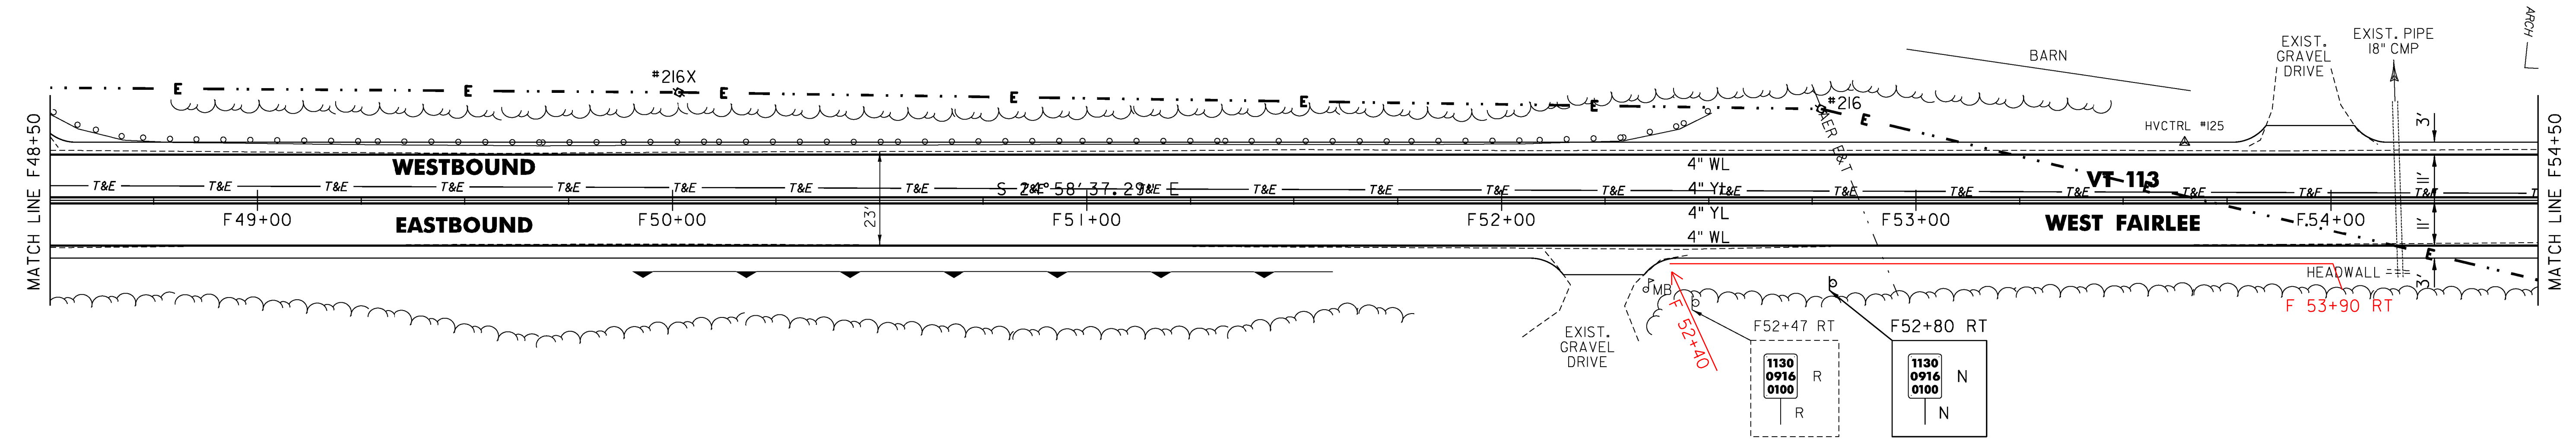

- LEGEND**
- R = REMOVE EXISTING
 - S = SALVAGE
 - R&S = REMOVE AND SALVAGE
 - N = NEW
 - RET = RETAIN
 - B-B = BACK TO BACK
 - = EXISTING GUARDRAIL
 - = PROPOSED GUARDRAIL
 - = YELLOW LINE
 - = WHITE LINE
 - = DELINEATOR
 - = PROPOSED UP

ROADWAY LAYOUT 26

PROJECT NAME: VERSHIRE-THETFORD	
PROJECT NUMBER: STP 2911(I)	
FILE NAME: p10c224.dgn	PLOT DATE: 3/8/2013
PROJECT LEADER: PTS	DRAWN BY: SNG
DESIGNED BY: NLL	CHECKED BY: PTS
IPARM FILE NAME: IOC224.53	SHEET 53 OF 232

NOT TO SCALE