

TEMPORARY 4 INCH WHITE LINE, PAINT
DURABLE 4 INCH WHITE LINE (OPTION BID ITEM)
F78+50 TO F90+50 SOLID RT
F78+50 TO F90+50 SOLID LT

TEMPORARY 4 INCH YELLOW LINE, PAINT
DURABLE 4 INCH YELLOW LINE (OPTION BID ITEM)
F78+50 TO F90+50 SOLID LT & RT

REHAB. DROP INLETS, CATCH BASINS, OR
MANHOLES, CLASS J
F84+77 RT
F86+71 RT

6 INCH UNDERDRAIN PIPE
F81+50 TO F83+66 RT 83+70 RT
F83+80 RT F84+78 RT
F85+05 TO F86+72 RT 86+73 RT
F87+35 TO F88+87 RT 88+10 RT

6 INCH UNDERDRAIN CARRIER PIPE
F88+87 RT TO F89+24 LT

STONE FILL, TYPE I
GEOTEXTILE UNDER STONE FILL
F83+90 TO F84+75 LT
F86+50 TO F87+75 LT


CURVE (30)
DELTA = 7°05'21" LT
D = 1°25'57"
R = 4000.00'
T = 247.77'
L = 494.91'
E = 7.67'
BANK = 0.020

RELOCATE MAILBOX, SINGLE SUPPORT
F87+82 LT

REMOVAL AND DISPOSAL OF GUIDE POSTS
F86+84 LT (1)

REMOVING SIGNS
AS SHOWN - 5

DELINEATOR WITH STEEL POST
F80+00 TO F83+00 LT (5)

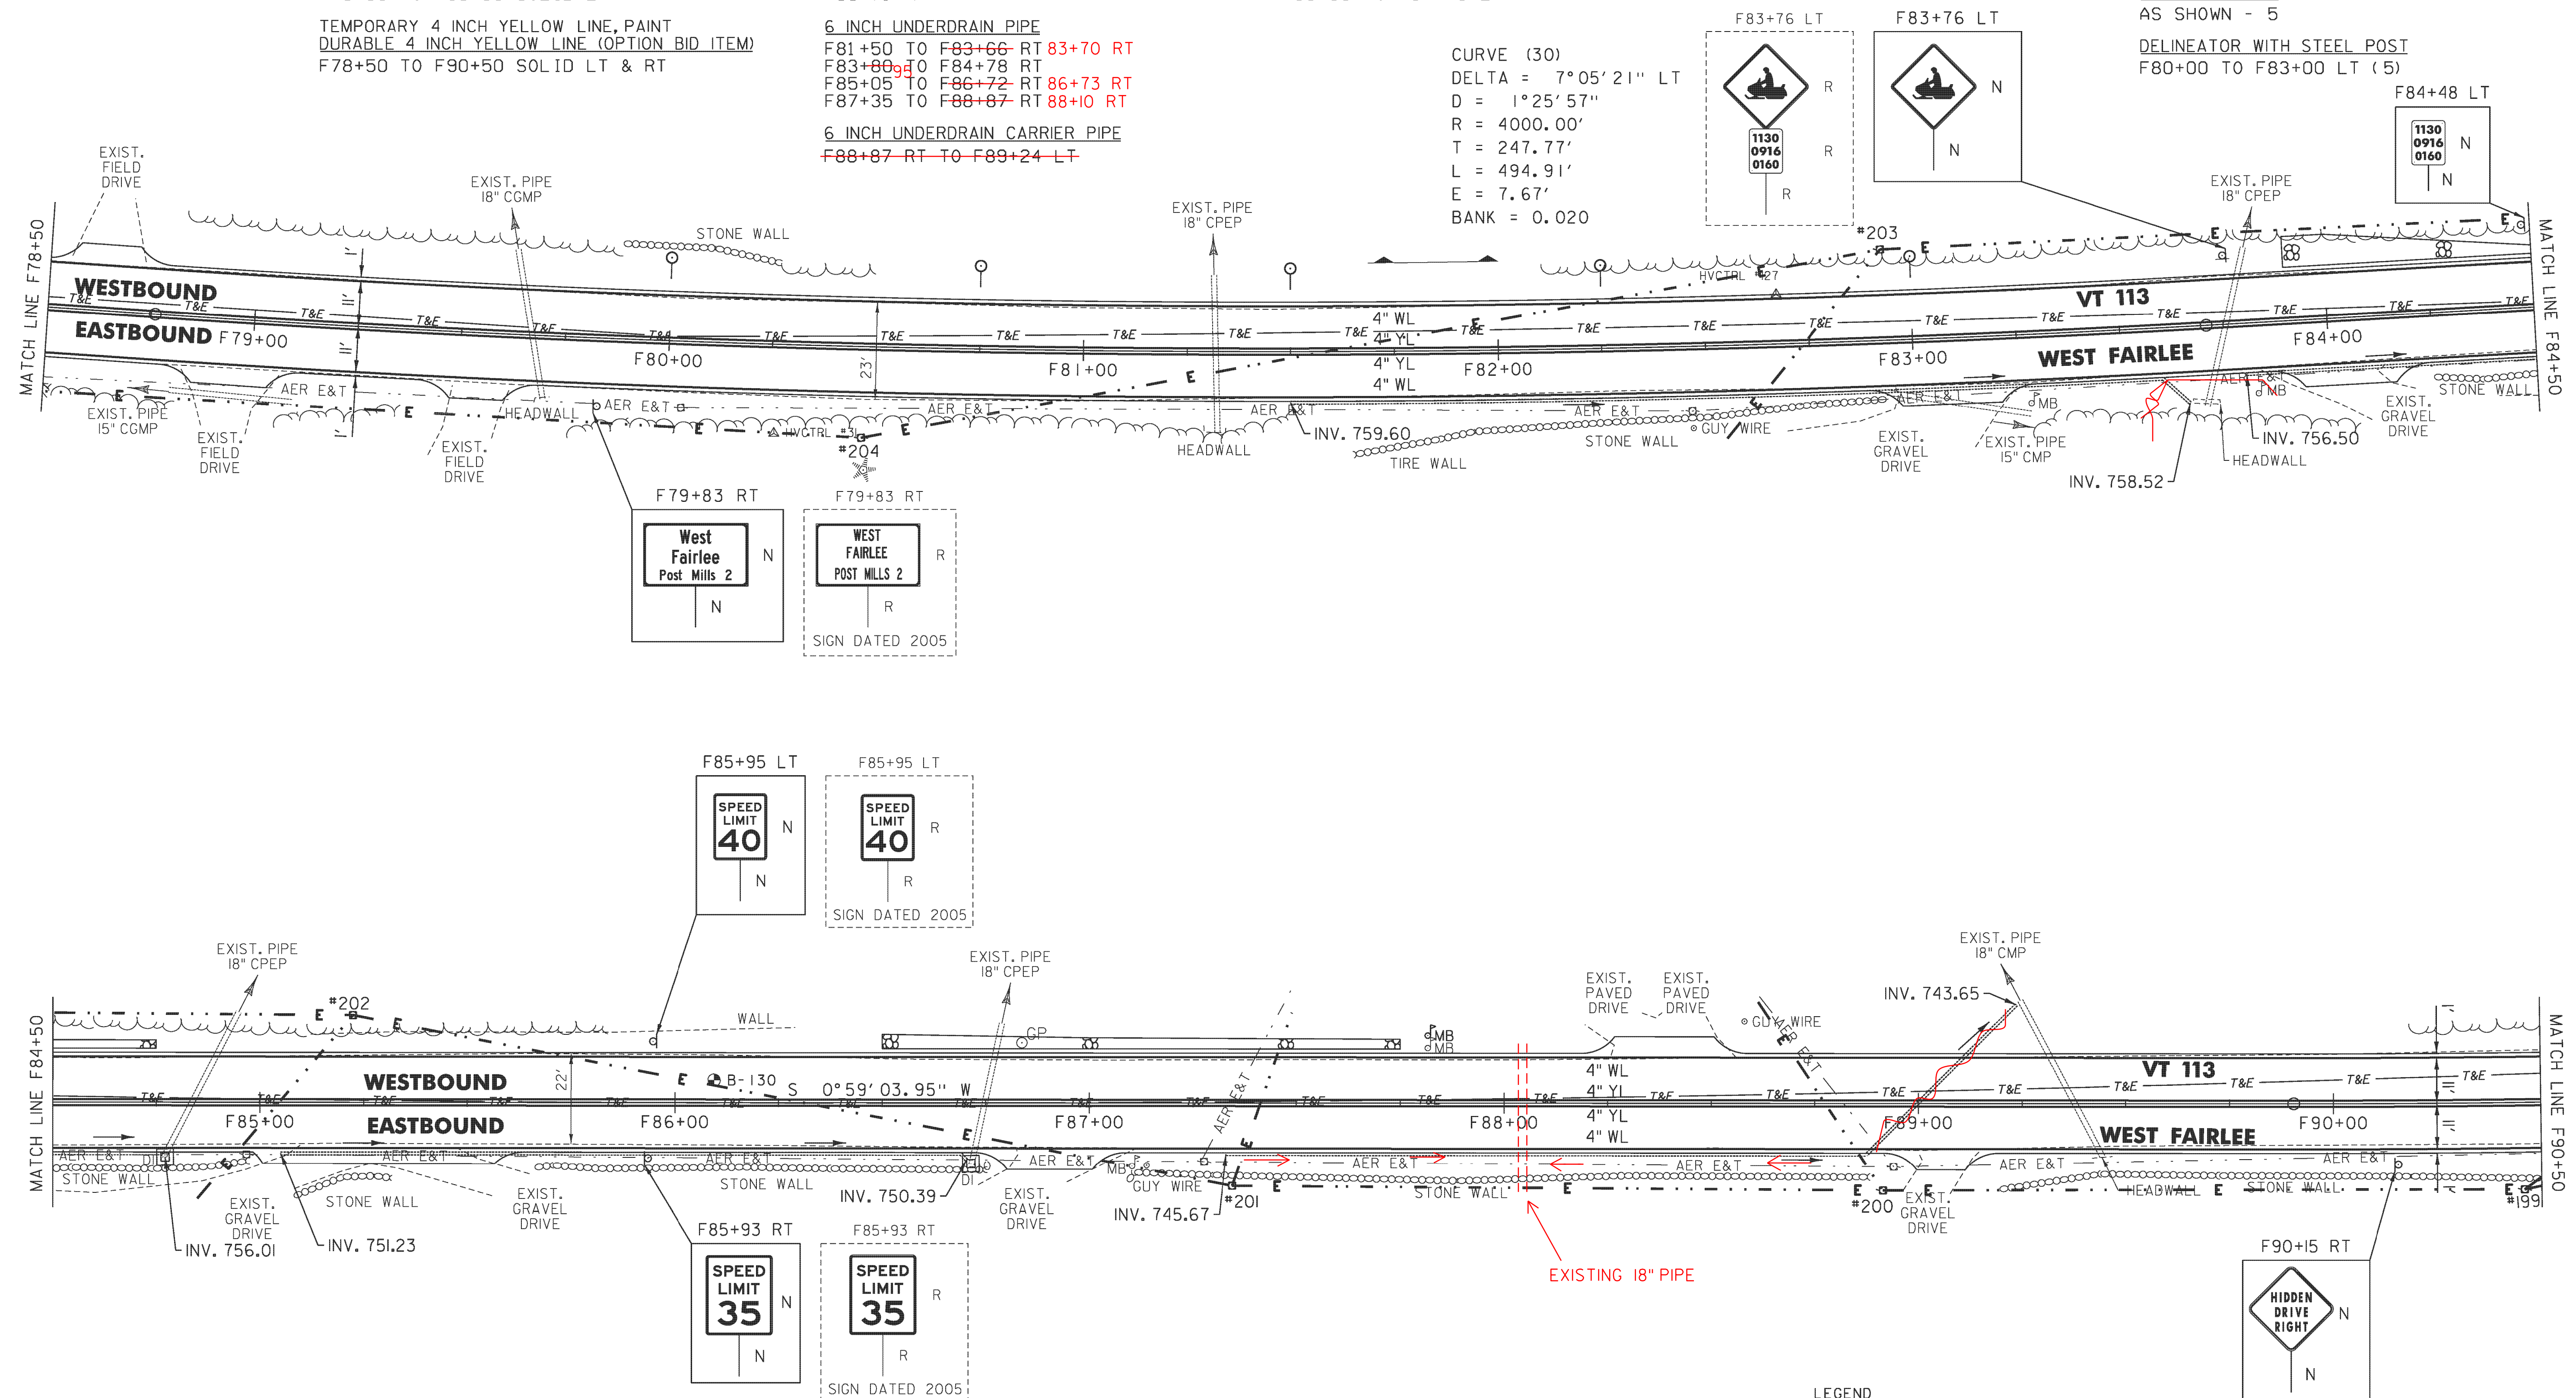

- LEGEND**
- R = REMOVE EXISTING
 - S = SALVAGE
 - R&S = REMOVE AND SALVAGE
 - N = NEW
 - RET = RETAIN
 - B-B = BACK TO BACK
 - = EXISTING GUARDRAIL
 - = PROPOSED GUARDRAIL
 - YL = YELLOW LINE
 - WL = WHITE LINE
 - = DELINEATOR
 - = PROPOSED UP

ROADWAY LAYOUT 29

PROJECT NAME: VERSHIRE-THETFORD	
PROJECT NUMBER: STP 2911(I)	
FILE NAME: p10c224.dgn	PLOT DATE: 3/8/2013
PROJECT LEADER: PTS	DRAWN BY: SNG
DESIGNED BY: NLL	CHECKED BY: PTS
IPARM FILE NAME: IOC224.56	SHEET 56 OF 232

NOT TO SCALE