


TEMPORARY 4 INCH WHITE LINE, PAINT
 DURABLE 4 INCH WHITE LINE (OPTION BID ITEM)
 F102+50 TO F103+08 SOLID LT
 F102+50 TO F103+00 SOLID RT
 F103+00 TO F103+20 SOLID RT (TH 3)
 F103+08 TO F103+37 SOLID LT (TH 28)
 F103+41 TO F103+87 SOLID RT (TH 3)
 F103+59 TO F103+89 SOLID LT (TH 28)
 F103+87 TO F108+50 SOLID RT
 F103+89 TO F108+50 SOLID LT

TEMPORARY 4 INCH YELLOW LINE, PAINT
 DURABLE 4 INCH YELLOW LINE (OPTION BID ITEM)
 F102+50 TO F103+28 SOLID LT & RT
 F103+48 DOUBLE SOLID LT (TH 28) (21' LONG)
 F103+31 TO F103+38 DOUBLE SOLID RT (TH 3)
 F103+68 TO F108+50 SOLID LT & RT

TEMPORARY 24" STOP BAR, PAINT
 DURABLE 24" STOP BAR (OPTION BID ITEM)
 F103+27 TO F103+48 LT (TH 28)
 F103+39 TO F103+61 RT (TH 3)
 TEMPORARY LETTER OR SYMBOL, PAINT
 DURABLE LETTER OR SYMBOL (OPTION BID ITEM)
 F103+41 LT - "STOP" (TH 28)
 F103+43 RT - "STOP" (TH 3)
 F106+65 RT - "SCHOOL"

REHAB. DROP INLETS, CATCH BASINS, OR
 MANHOLES, CLASS I
 F103+71 RT
 RELOCATE MAILBOX, SINGLE SUPPORT
 F107+50 LT
 F107+76 LT
 REMOVING SIGNS
 AS SHOWN - 12

HISTORIC DIST HISTORIC DIST HISTORIC DIST HISTORIC DIST HISTORIC DIST HISTORIC DIST HISTORIC DIST HISTORIC DIST

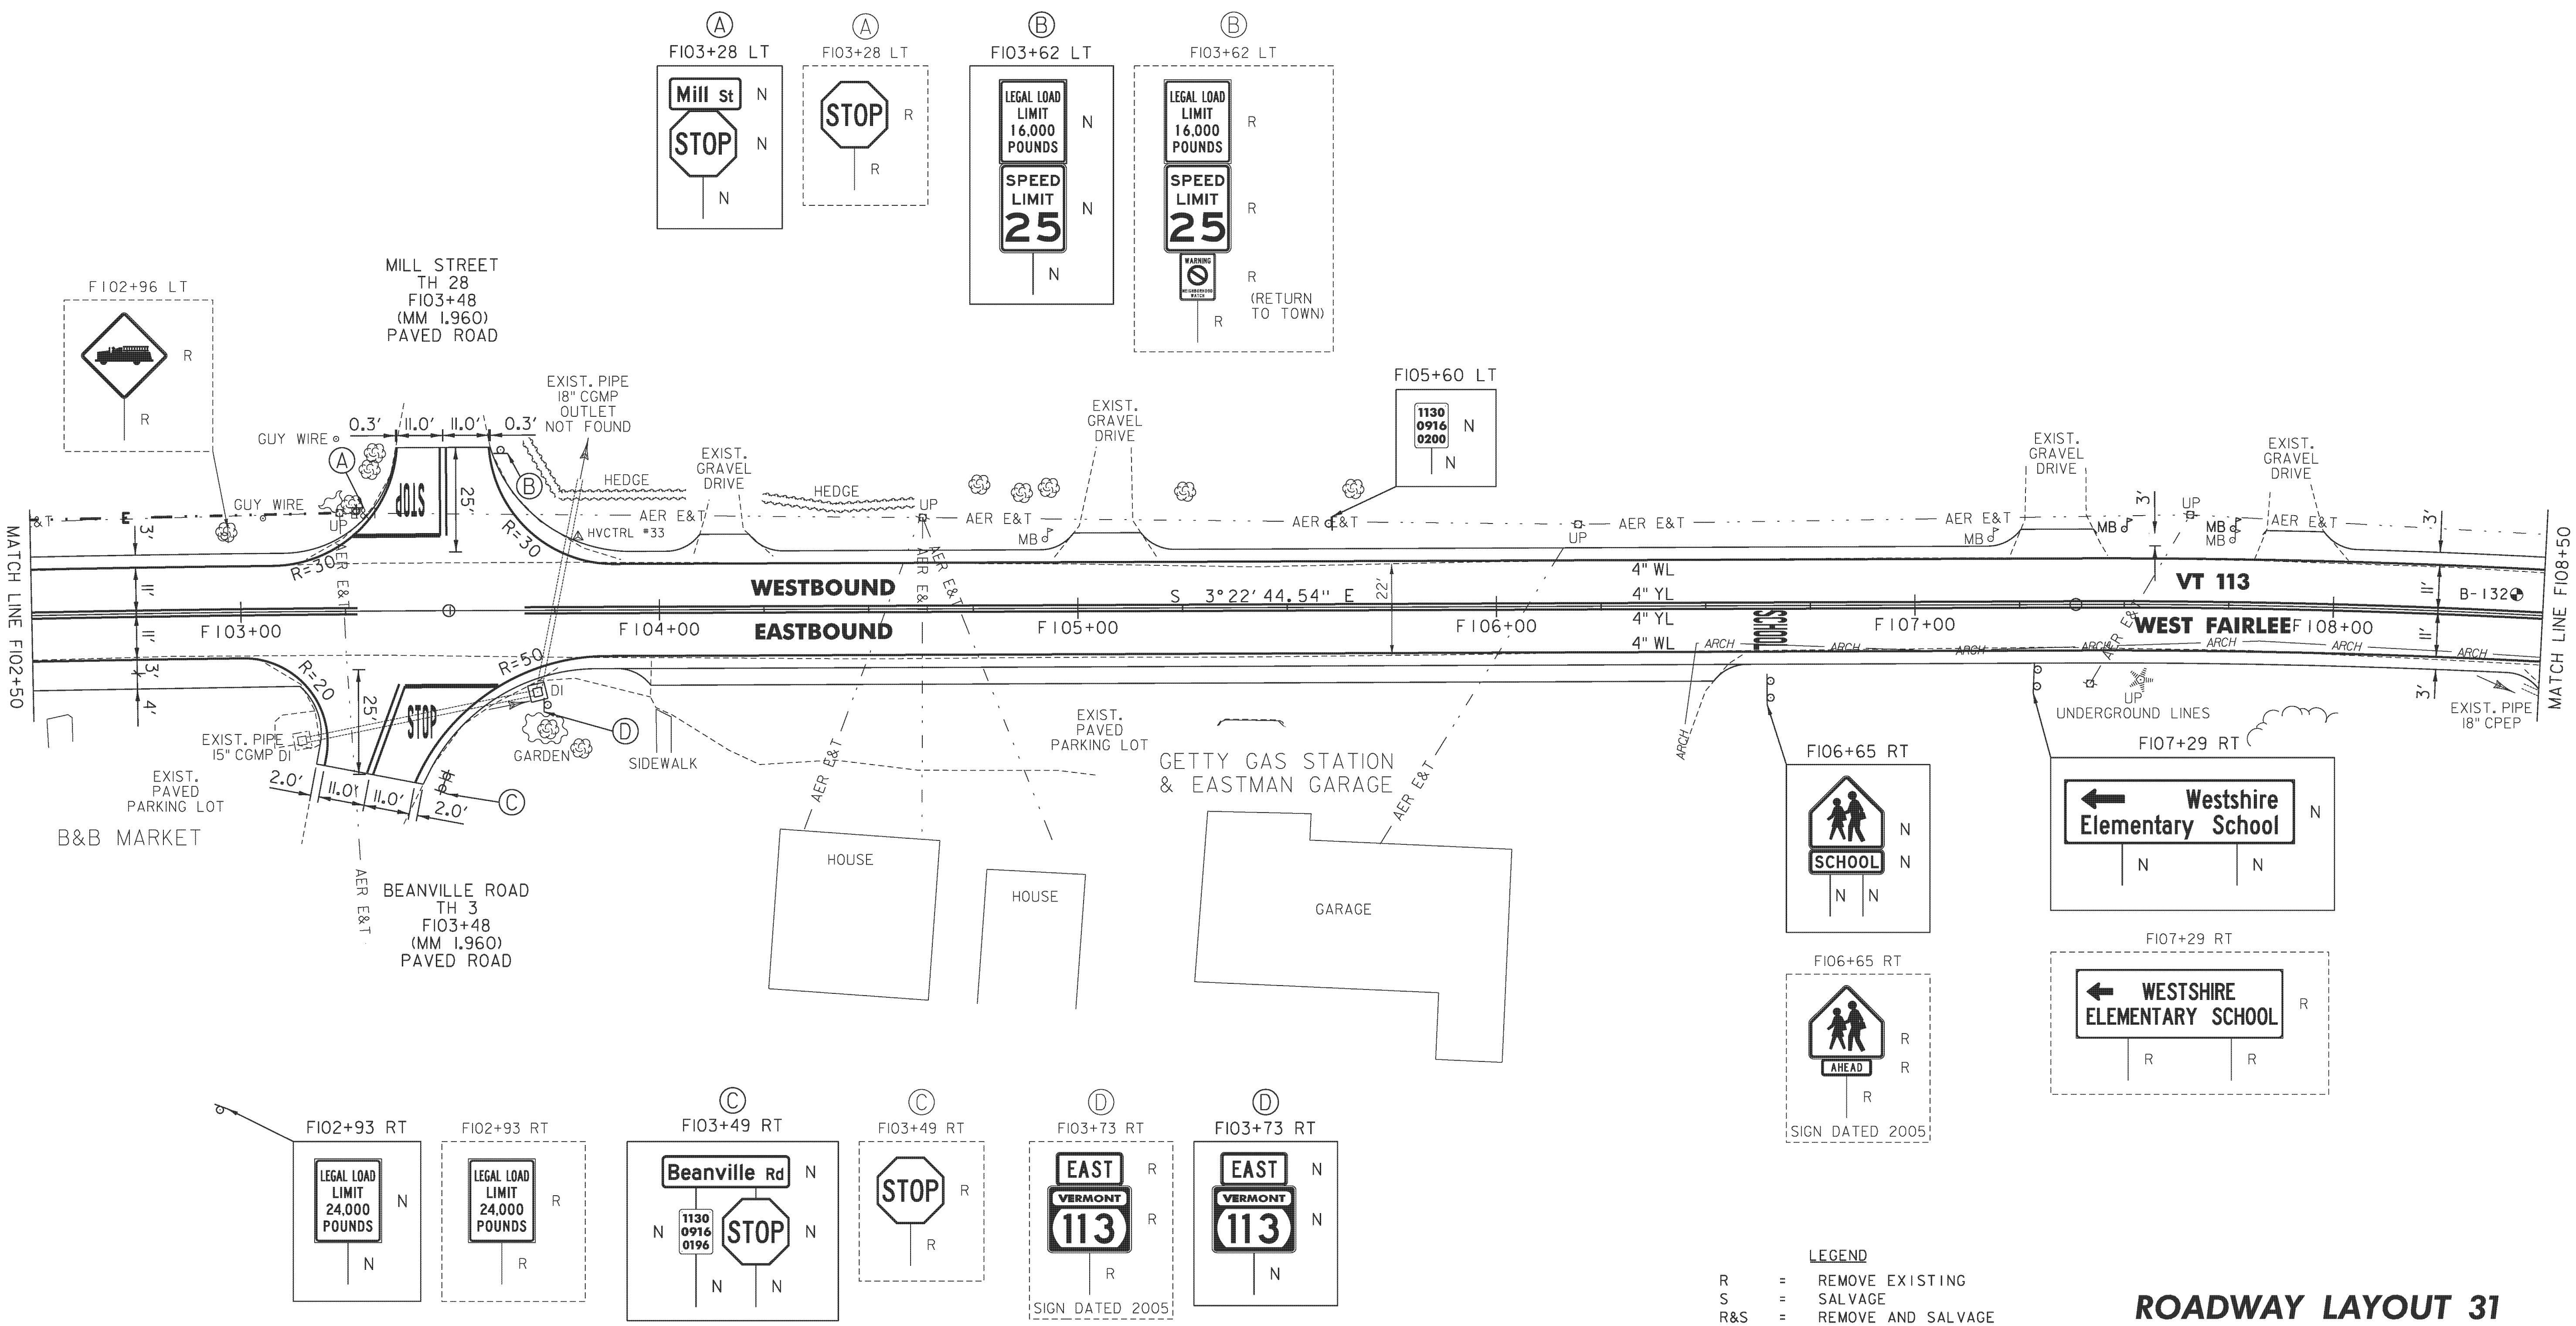

- LEGEND**
- R = REMOVE EXISTING
 - S = SALVAGE
 - R&S = REMOVE AND SALVAGE
 - N = NEW
 - RET = RETAIN
 - B-B = BACK TO BACK
 - = EXISTING GUARDRAIL
 - = PROPOSED GUARDRAIL
 - YL = YELLOW LINE
 - WL = WHITE LINE
 - = DELINEATOR
 - = PROPOSED UP

ROADWAY LAYOUT 31

PROJECT NAME: VERSHIRE-THETFORD
 PROJECT NUMBER: STP 2911(I)
 FILE NAME: pl0c224.dgn
 PROJECT LEADER: PTS
 DESIGNED BY: NLL
 IPARM FILE NAME: IOC224_58
 PLOT DATE: 3/8/2013
 DRAWN BY: SNG
 CHECKED BY: PTS
 SHEET 58 OF 232