

TEMPORARY 4 INCH WHITE LINE, PAINT
 DURABLE 4 INCH WHITE LINE (OPTION BID ITEM)
 F126+50 TO F138+50 SOLID RT
 F126+50 TO F138+50 SOLID LT

TEMPORARY 4 INCH YELLOW LINE, PAINT
 DURABLE 4 INCH YELLOW LINE (OPTION BID ITEM)
 F126+50 TO F138+50 SOLID LT & RT


6 INCH UNDERDRAIN PIPE
 F132+60 TO F136+00 RT
 F137+50 TO F138+50 RT
 F132+40 TO F128+50 RT

STONE FILL, TYPE I
 GEOTEXTILE UNDER STONE FILL
 F130+50 TO F137+00 RT


STEEL BEAM GUARDRAIL,
 GALVANIZED W/8 FEET POSTS
 F126+94.5 TO F138+50 LT
 ANCHOR FOR STEEL BEAM RAIL
 F126+94.5 LT

REMOVAL AND DISPOSAL OF GUARDRAIL
 F126+92 TO F138+50 LT
 DELINEATOR WITH STEEL POST
 F126+94.5 LT

REMOVING SIGNS
 AS SHOWN - 4

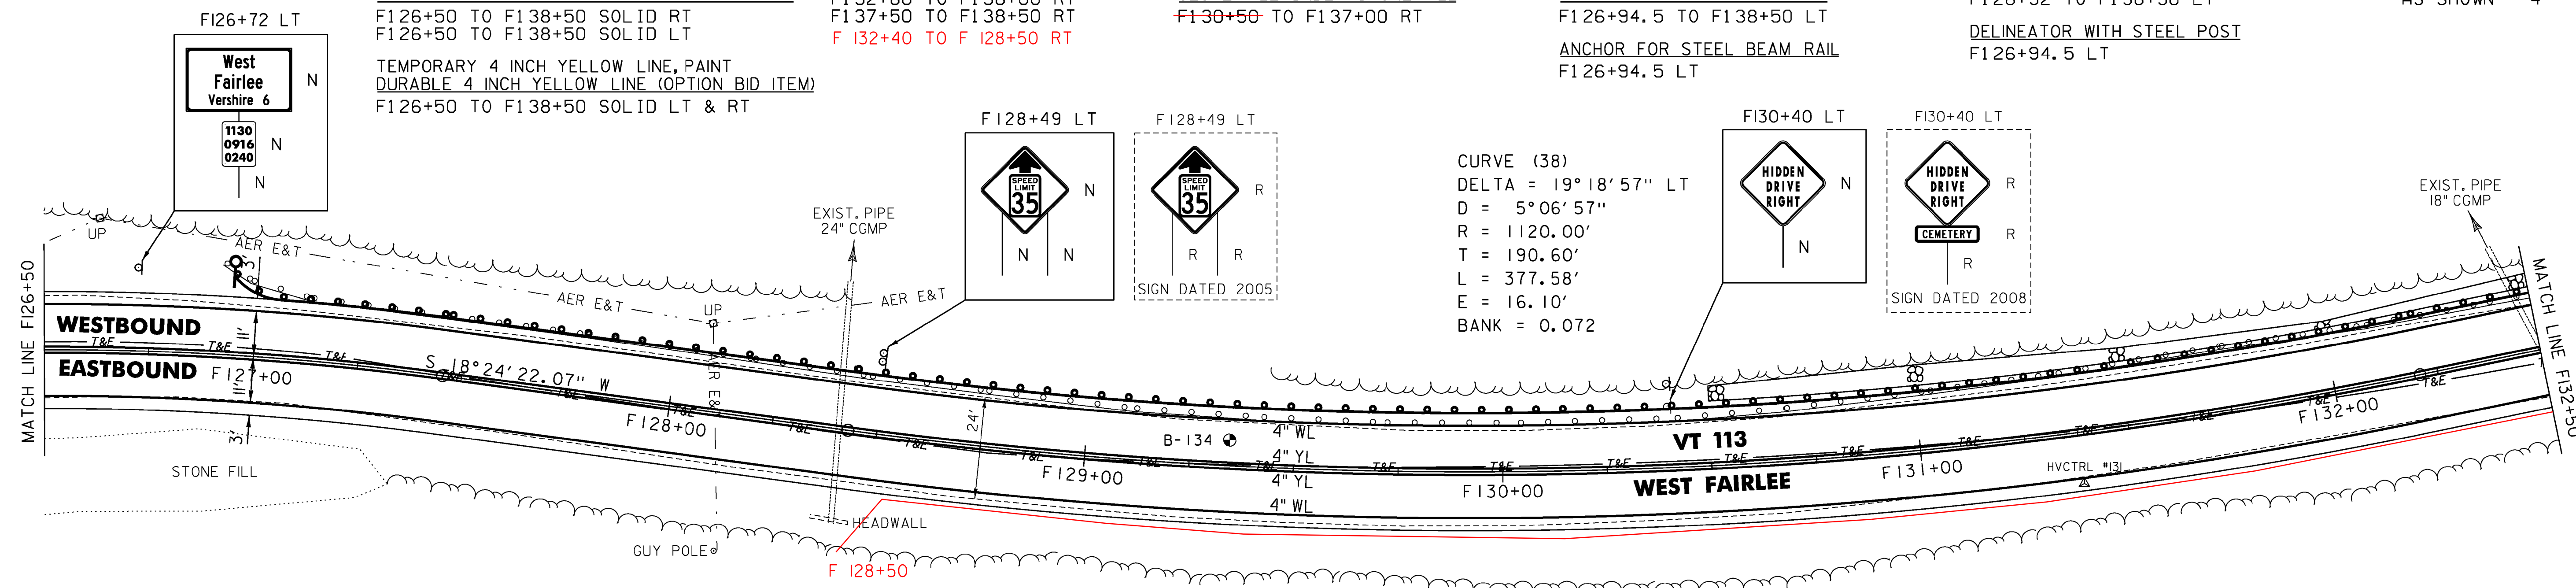

CURVE (39)
 DELTA = 23°41'56"
 D = 1°05'29" LT
 R = 5250.00'
 T = 561.31'
 L = 448.94'
 E = 29.92'
 BANK = 0.023

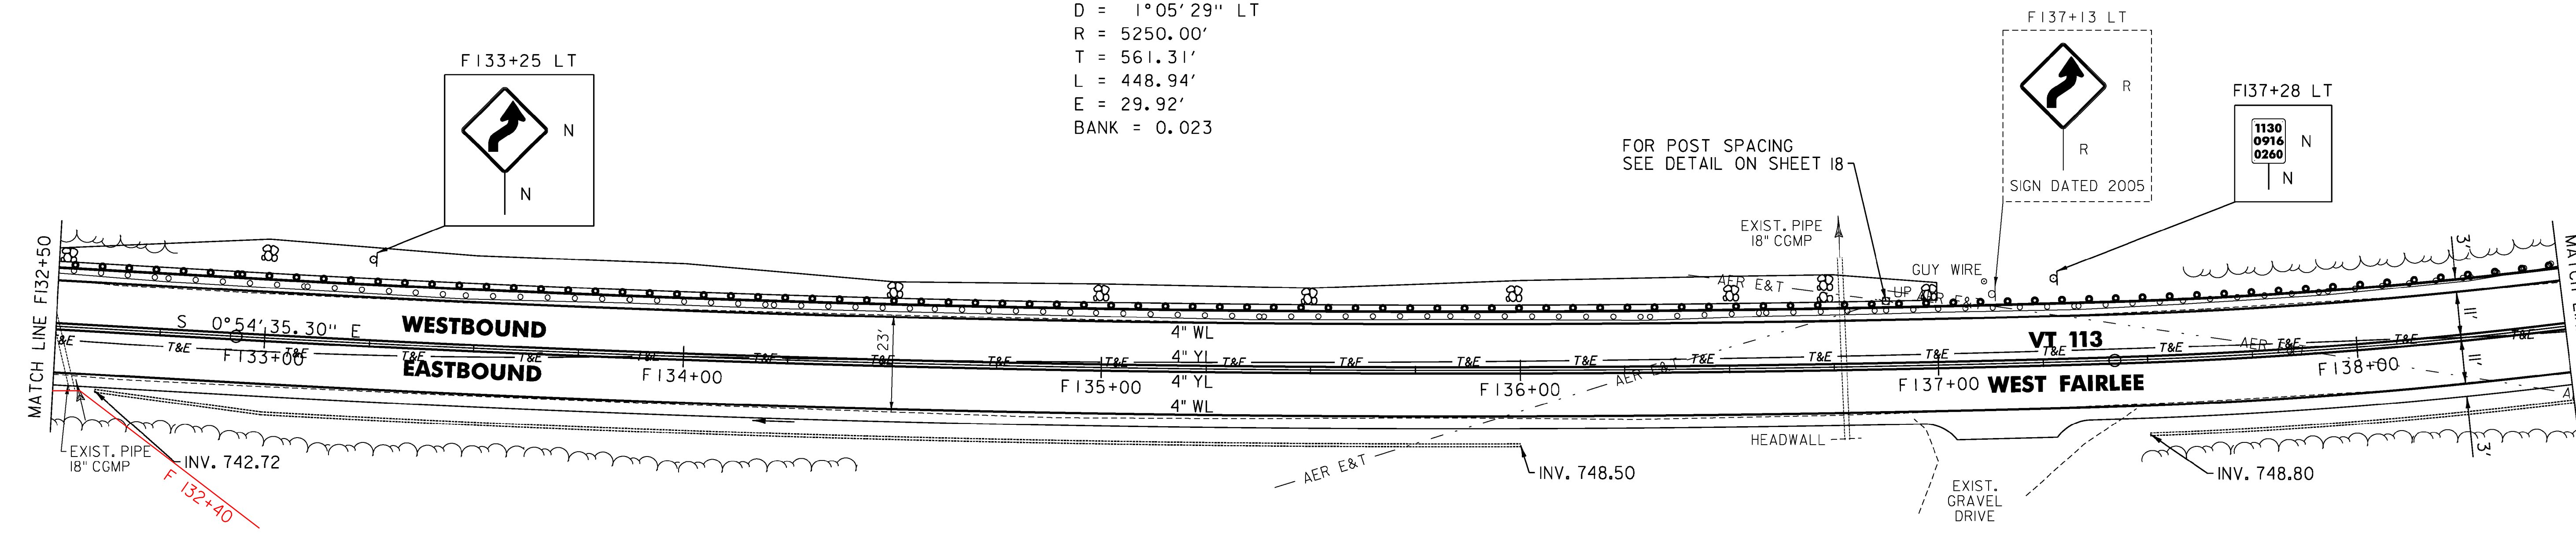

- LEGEND**
- R = REMOVE EXISTING
 - S = SALVAGE
 - R&S = REMOVE AND SALVAGE
 - N = NEW
 - RET = RETAIN
 - B-B = BACK TO BACK
 - = EXISTING GUARDRAIL
 - = PROPOSED GUARDRAIL
 - YL = YELLOW LINE
 - WL = WHITE LINE
 - = DELINEATOR
 - = PROPOSED UP

ROADWAY LAYOUT 34

PROJECT NAME: VERSHIRE-THETFORD
 PROJECT NUMBER: STP 2911(I)
 FILE NAME: p10c224.dgn
 PROJECT LEADER: PTS
 DESIGNED BY: NLL
 IPARM FILE NAME: IOC224_61
 PLOT DATE: 3/8/2013
 DRAWN BY: SNG
 CHECKED BY: PTS
 SHEET 61 OF 232

NOT TO SCALE