

TRAFFIC SIGN SUMMARY SHEET #5

SHSM = FHWA 2004 STANDARD
HIGHWAY SIGNS AND MARKINGS
BOOK AND THE 2012 SUPPLEMENT
TO THE 2004 EDITION

MILEMARKER, STATION, OR SIGN NUMBER	SIGN LEGEND	SIGN DIMENSIONS		NEW & SALVAGED SIGNS				EXIST POST NO. OF POSTS	NEW SIGN POSTS																REMARKS	SIGN DETAIL				
		E A	WIDTH (in)	HEIGHT (in)	"A"	"B"	SALV SIGN		SALV TIS	SQUARE STEEL (in)				TUBULAR ALUMINUM Ø (in)			TUBULAR STEEL Ø (in)				W-SHAPE STEEL		S H S M	D E T A I L O N S H E E T N U M B E R		S T D. S H E E T N U M B E R				
										1.75	2.0	2.5	ANCHOR S P A C E	3.0	4.0	4.0 MOD	FOUND- ATION	3.0	3.5	4.0	5.0	FTG. SIZE					WEIGHT	POST SIZE		
272+00 LT			18	24	3.00						X		X												WI-8	ASTM TYPE IX FLUORESCENT YELLOW SHEETING	X			
272+02 LT			18	24	3.00						X		X												WI-8	ASTM TYPE IX FLUORESCENT YELLOW SHEETING	X			
272+25 RT			6	10	0.42						X		X												VD-70I			84		
272+95 LT			6	10	0.42						X		X												VD-70I			84		
273+20 LT			18	24	3.00						X		X												WI-8	ASTM TYPE IX FLUORESCENT YELLOW SHEETING	X			
273+22 LT			18	24	3.00						X		X												WI-8	ASTM TYPE IX FLUORESCENT YELLOW SHEETING	X			
274+40 LT			18	24	3.00						X		X												WI-8	ASTM TYPE IX FLUORESCENT YELLOW SHEETING	X			
274+42 LT			18	24	3.00						X		X												WI-8	ASTM TYPE IX FLUORESCENT YELLOW SHEETING	X			
276+00 LT			30	30	6.25						X		X												WI-2L		X			
			18	18	2.25																				WI3-IP		X			
277+50 RT			72	12	6.00				2																2	152.0	VDI-IA VDI-IA			85 85
			72	12	6.00																				VDI-IA			85		
278+50 LT			24	12	2.00						X		X												M3-4	GREEN ON WHITE	X			
			30	24	5.00																				MI-5				E-136B	

FINAL POST LENGTHS ARE TO BE DETERMINED
IN THE FIELD. POST SIZES ARE COMPUTED
BASED ON INFORMATION FURNISHED ON THE STANDARD
SHEETS AND VTRANS "SIGN POST DESIGN GUIDELINE."

SHEET TOTALS

SF 52.34

SF

EA.

SF

EA.

SF


EA.

SF

EA.

SF

EA.

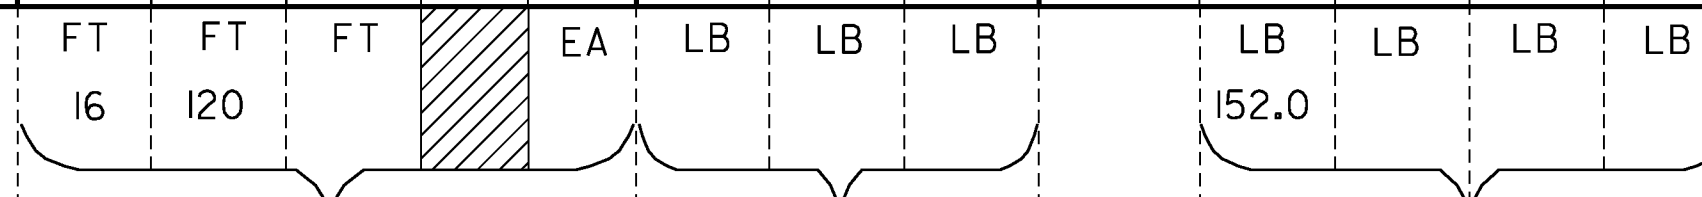

**TRAFFIC
SIGN
SUMMARY
SHEET #5**

PROJECT NAME: VERSHIRE-THETFORD

PROJECT NUMBER: STP 2911(I)

FILE NAME: pl0c224.dgn
PROJECT LEADER: PTS
DESIGNED BY: NLL
IPARM FILE NAME: IOC224_72

PLOT DATE: 1/29/2013
DRAWN BY: SNG
CHECKED BY: PTS
SHEET 72 OF 232