


CURVE 0 - VERSHIRE

CURVE 1 - VERSHIRE

NOTE

LIMIT OF VTRANS SURVEY STA 187+70.
THE CONTRACTOR WILL NEED TO VERIFY BANKING PRIOR TO COLD PLANING.

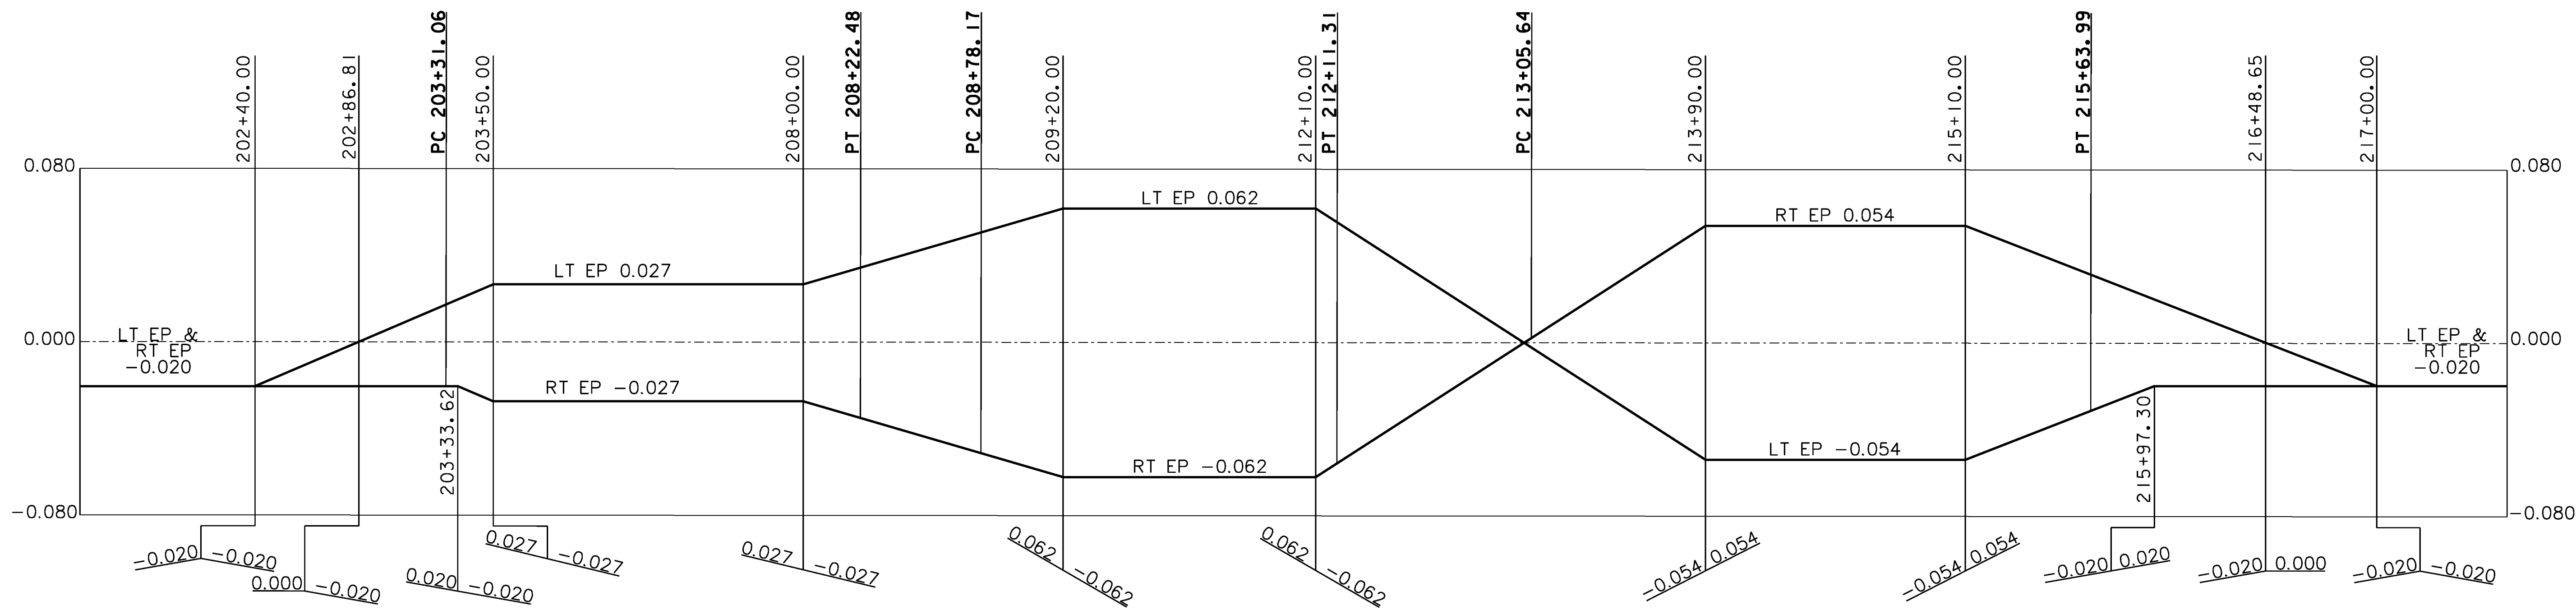

CURVE 2 - VERSHIRE

CURVE 3 - VERSHIRE

CURVE 4 - VERSHIRE

NOT TO SCALE

BANKING DIAGRAM 1

PROJECT NAME: VERSHIRE-THETFORD	PLOT DATE: 1/29/2013
PROJECT NUMBER: STP 2911(I)	DRAWN BY: JLS
FILE NAME: pl0c224.dgn	CHECKED BY: DAM
PROJECT LEADER: PTS	SHEET 88 OF 232
DESIGNED BY: NULL	
IPARM FILE NAME: IOC224_88	