


**CURVE 5 - VERSHIRE**

**CURVE 6 - VERSHIRE**

**CURVE 7 - VERSHIRE**

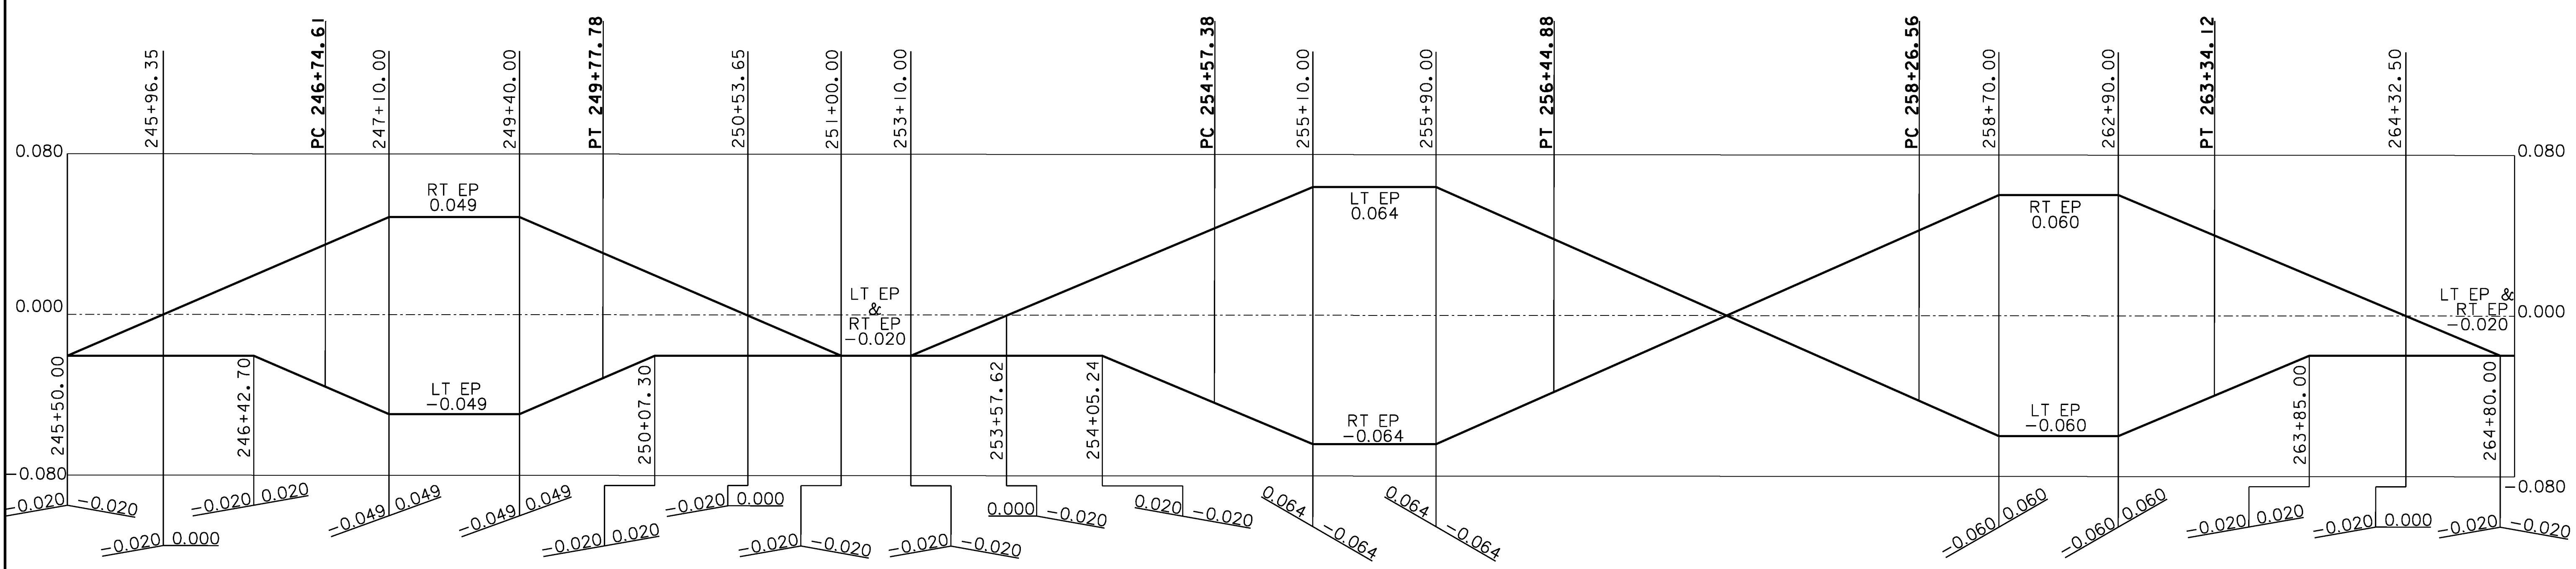

**CURVE 8 - VERSHIRE**

**CURVE 9 - VERSHIRE**

**CURVE 10 - VERSHIRE**

**BANKING DIAGRAM 2**

|                                 |                      |
|---------------------------------|----------------------|
| PROJECT NAME: VERSHIRE-THETFORD |                      |
| PROJECT NUMBER: STP 291(I)      |                      |
| FILE NAME: pl0c224.dgn          | PLOT DATE: 1/29/2013 |
| PROJECT LEADER: PTS             | DRAWN BY: JLS        |
| DESIGNED BY: NULL               | CHECKED BY: DAM      |
| IPARM FILE NAME: IOC224_89      | SHEET 89 OF 232      |

NOT TO SCALE