


CURVE 11 - VERSHIRE

CURVE 12 - VERSHIRE

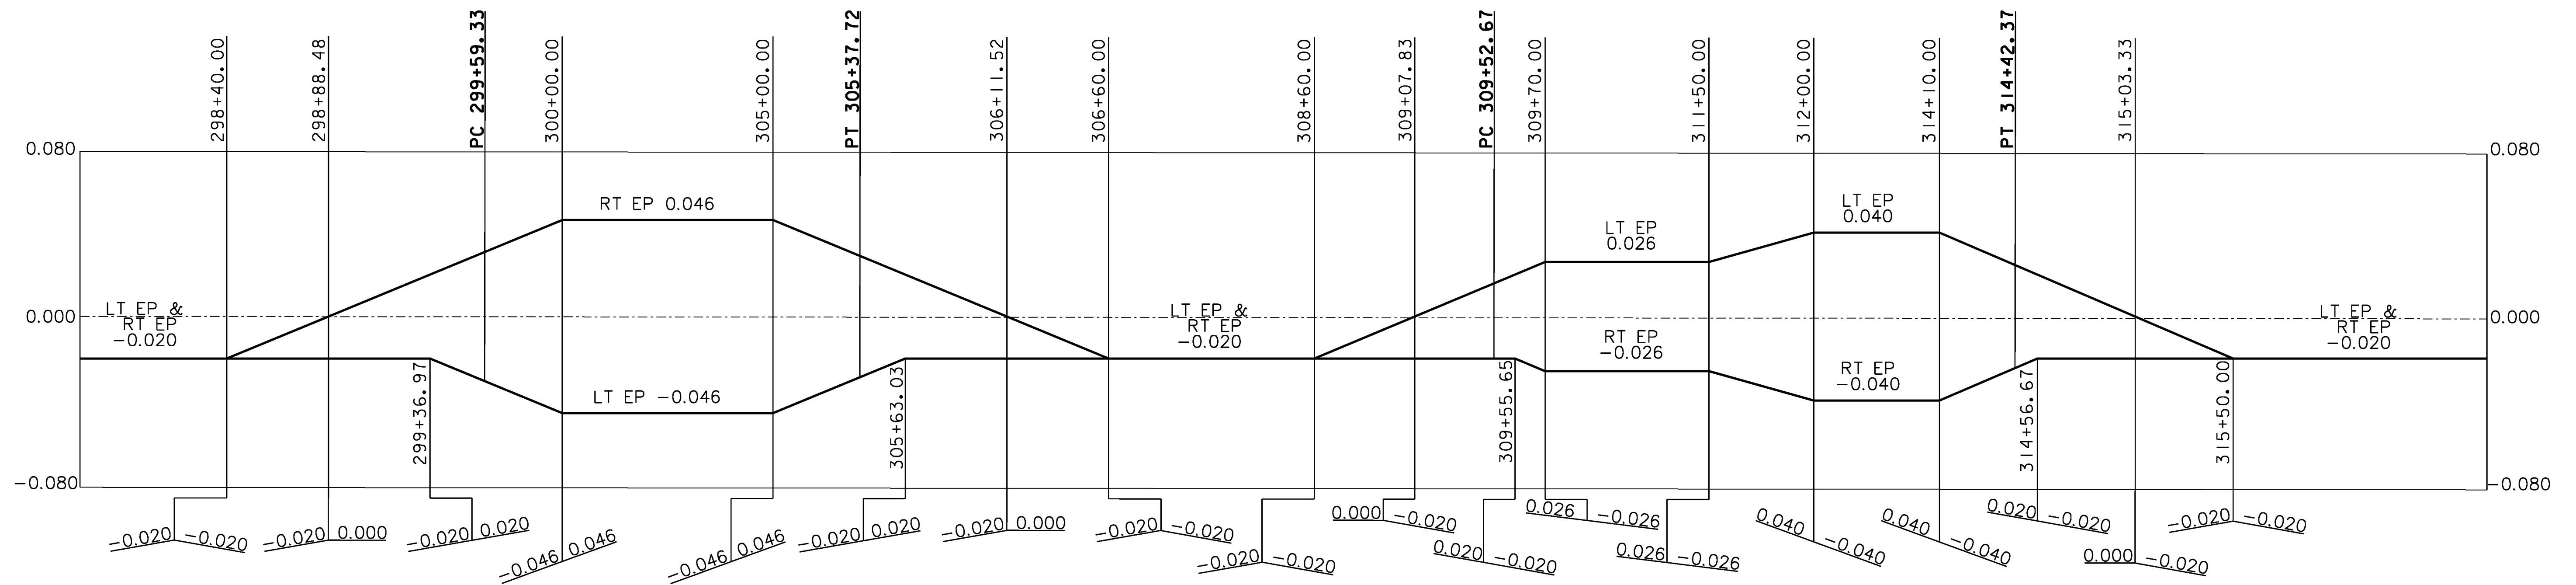

CURVE 13 - VERSHIRE

CURVE 14 - VERSHIRE

BANKING DIAGRAM 3

PROJECT NAME: VERSHIRE-THETFORD	PLOT DATE: 1/29/2013
PROJECT NUMBER: STP 291(K)	DRAWN BY: JLS
FILE NAME: pl0c224.dgn	CHECKED BY: DAM
PROJECT LEADER: PTS	SHEET 90 OF 232
DESIGNED BY: NULL	
IPARM FILE NAME: IOC224_90	

NOT TO SCALE