


**CURVE 15 - VERSHIRE**

**CURVE 16 - VERSHIRE**

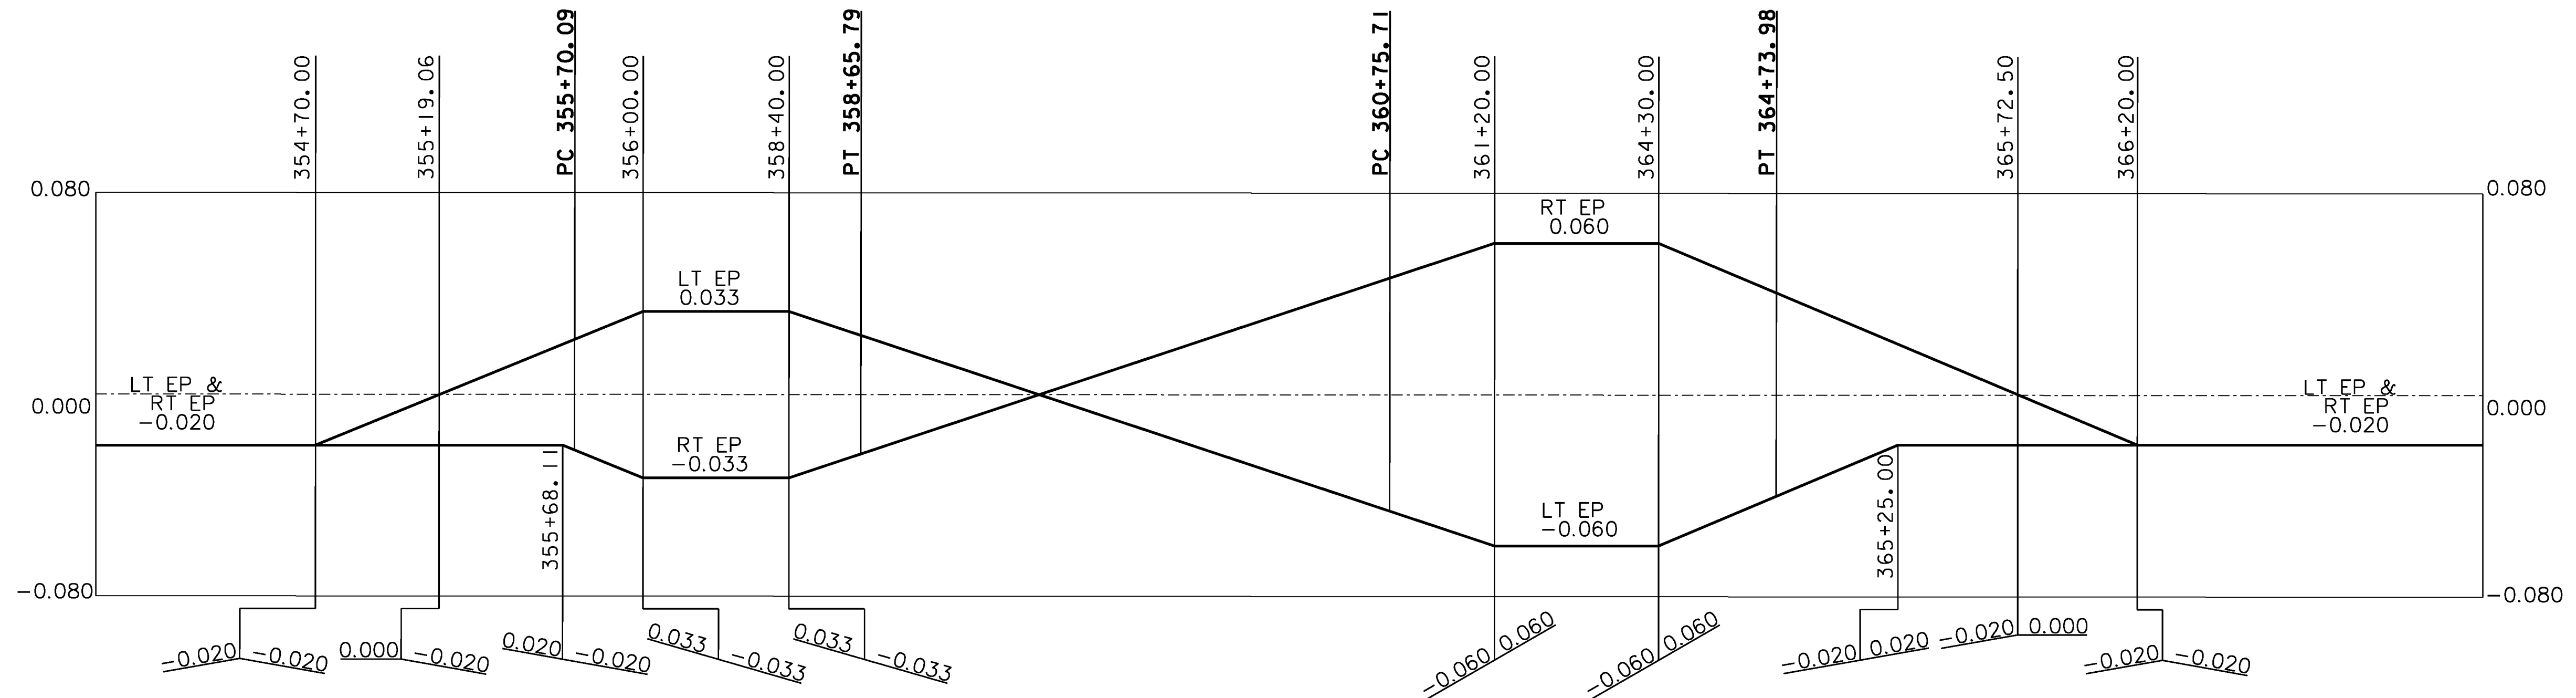

**CURVE 17 - VERSHIRE**

**CURVE 18 - VERSHIRE**

**BANKING DIAGRAM 4**

PROJECT NAME: VERSHIRE-THETFORD	
PROJECT NUMBER: STP 291(K)	
FILE NAME: pl0c224.dgn	PLOT DATE: 1/29/2013
PROJECT LEADER: PTS	DRAWN BY: JLS
DESIGNED BY: NULL	CHECKED BY: DAM
IPARM FILE NAME: IOC224_9I	SHEET 91 OF 232

NOT TO SCALE