


CURVE 35 - WEST FAIRLEE

CURVE 36 - WEST FAIRLEE

CURVE 37 - WEST FAIRLEE

CURVE 38 - WEST FAIRLEE

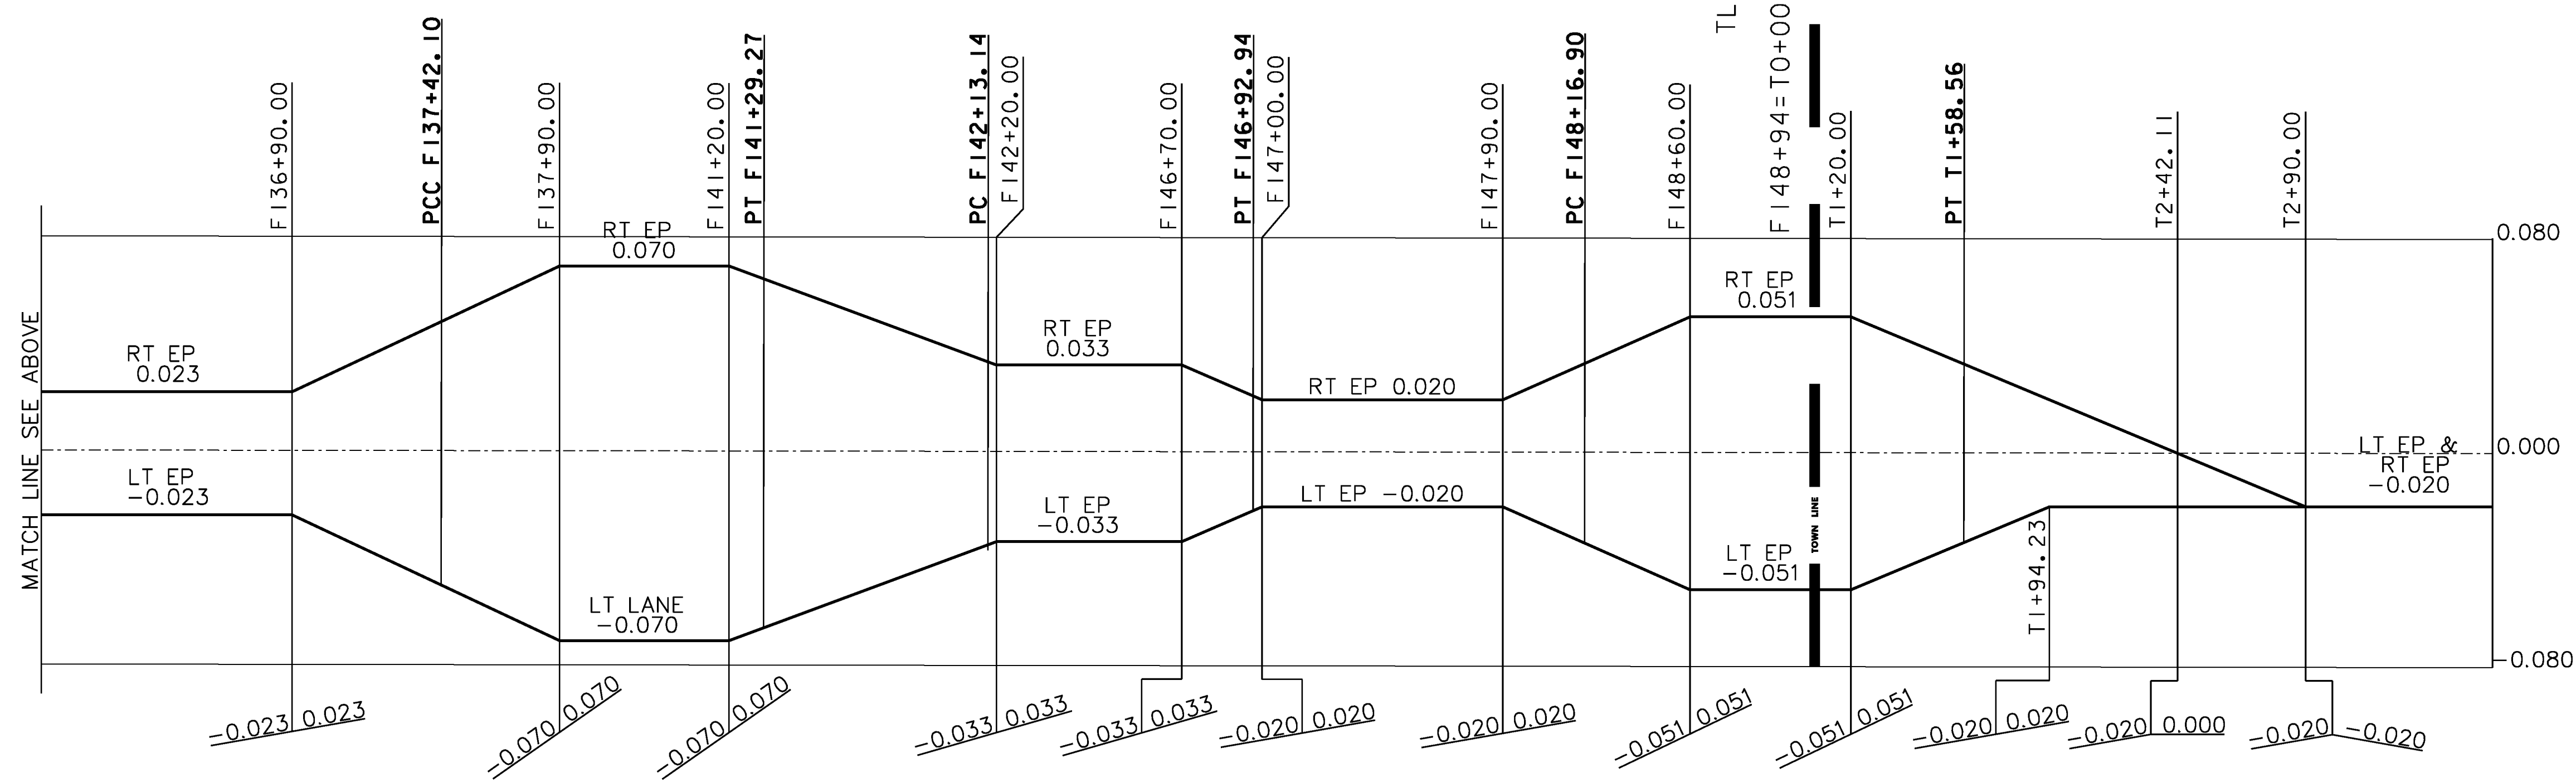

CURVE 39 - WEST FAIRLEE

CURVE 40 - WEST FAIRLEE

CURVE 41 - WEST FAIRLEE

CURVE 42 - WEST FAIRLEE-THETFORD

BANKING DIAGRAM 8

PROJECT NAME: VERSHIRE-THETFORD	PLOT DATE: 1/29/2013
PROJECT NUMBER: STP 2911(I)	DRAWN BY: JLS
FILE NAME: pl0c224.dgn	CHECKED BY: DAM
PROJECT LEADER: PTS	SHEET 95 OF 232
DESIGNED BY: NULL	
IPARM FILE NAME: IOC224_95	

NOT TO SCALE