




188+39  
TH 9

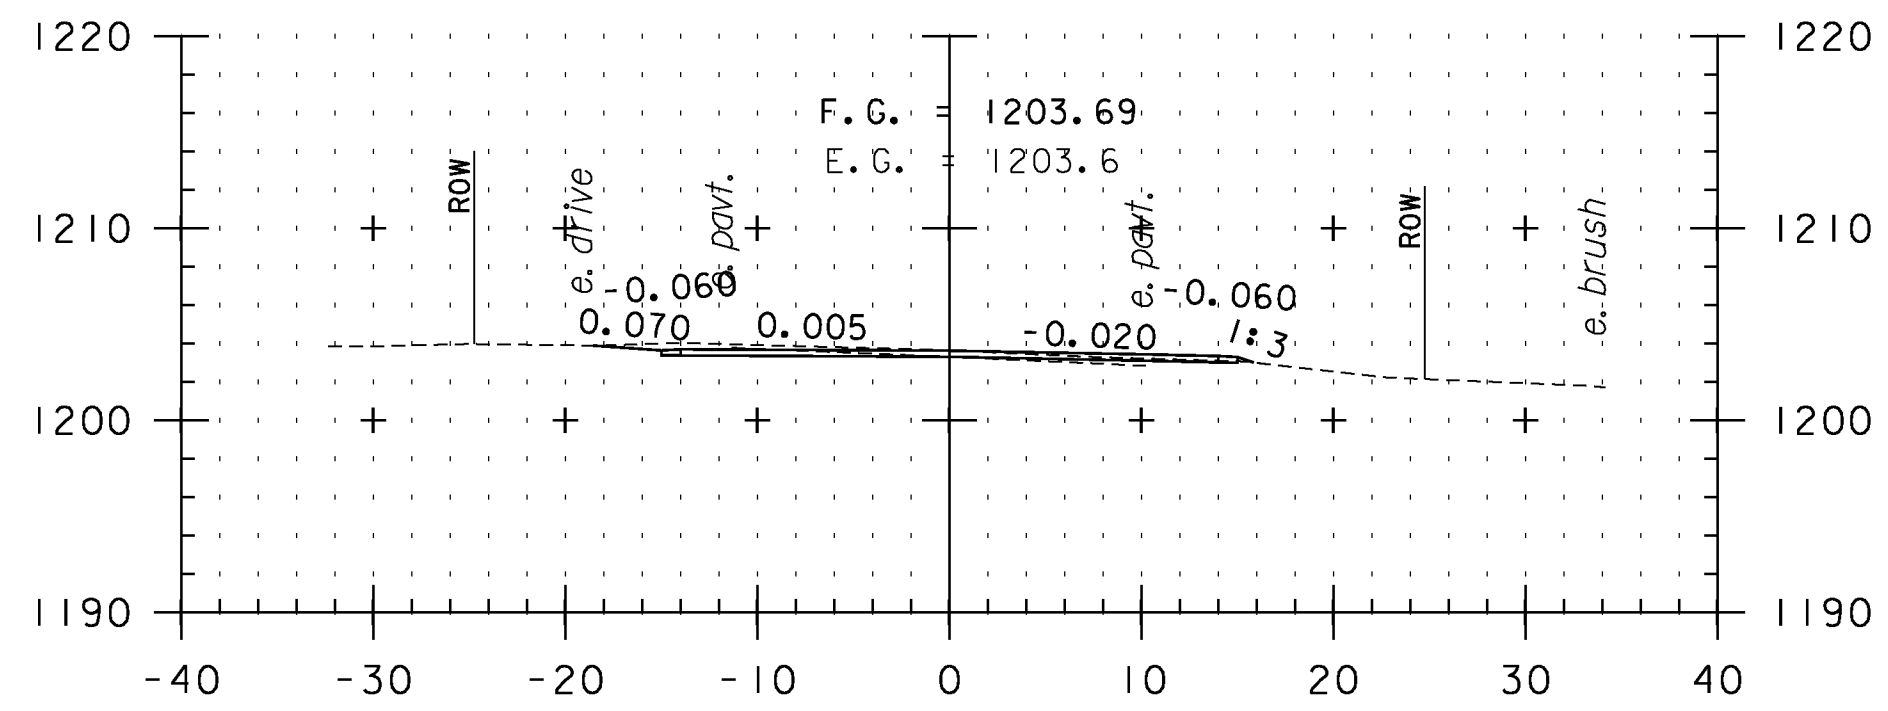


189+50

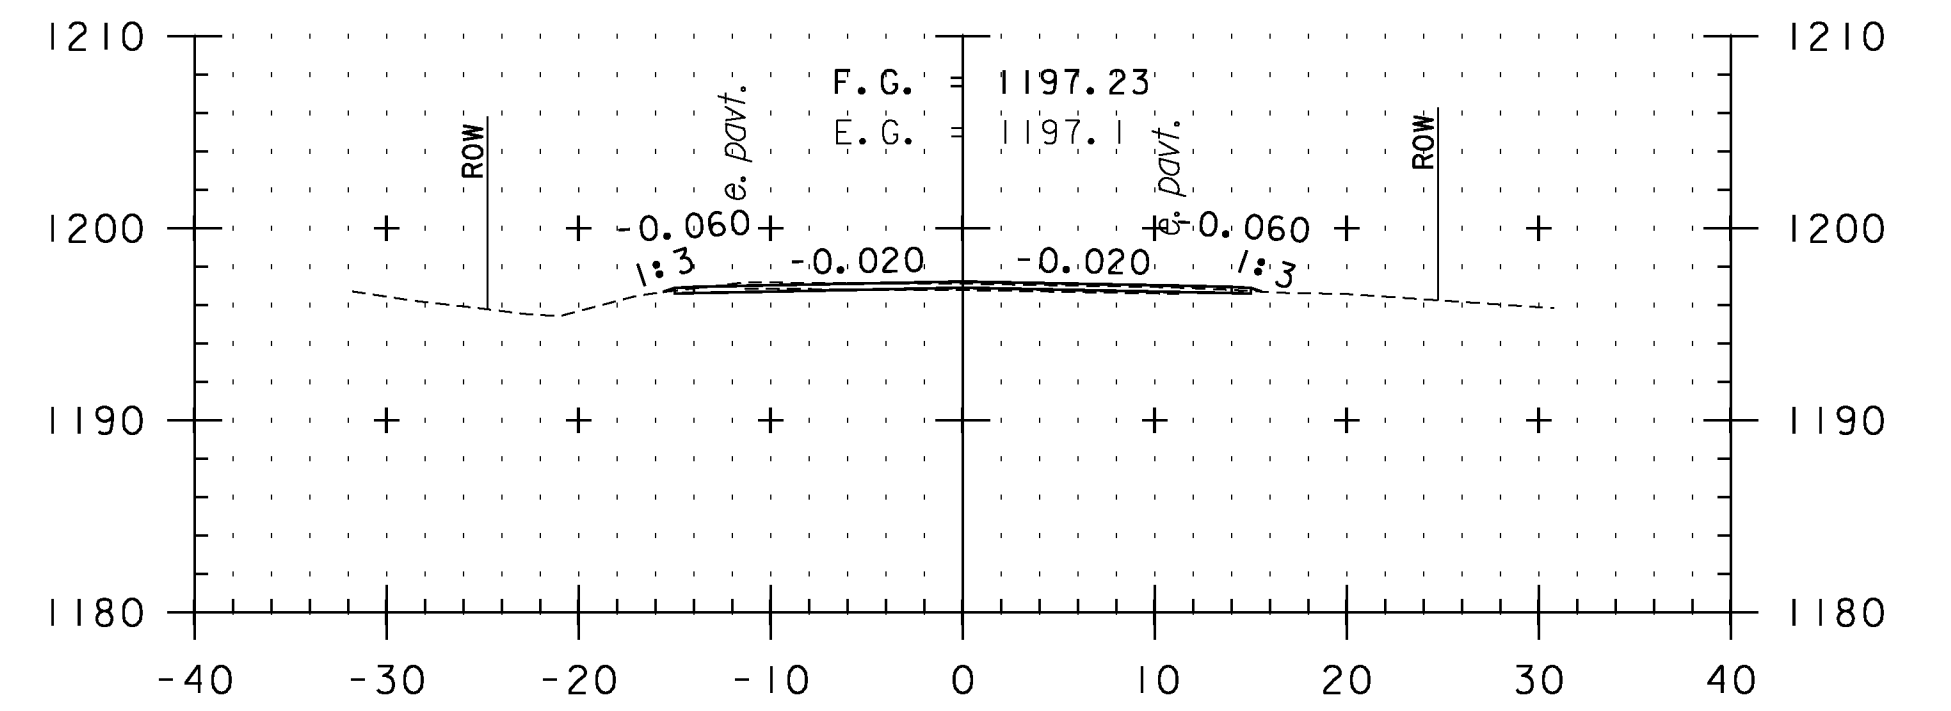


191+00

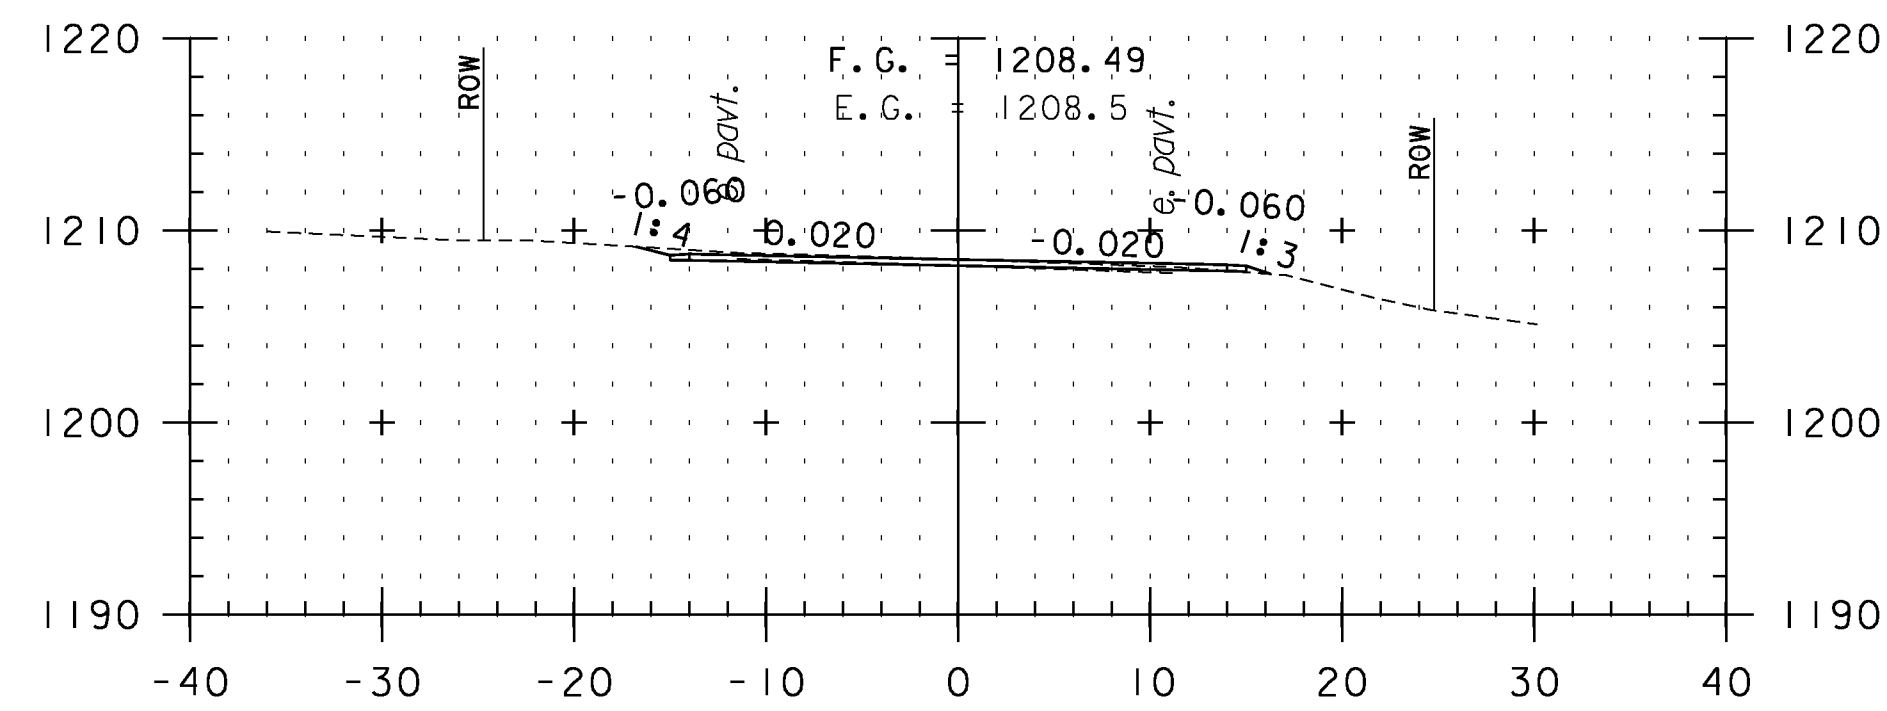


188+00

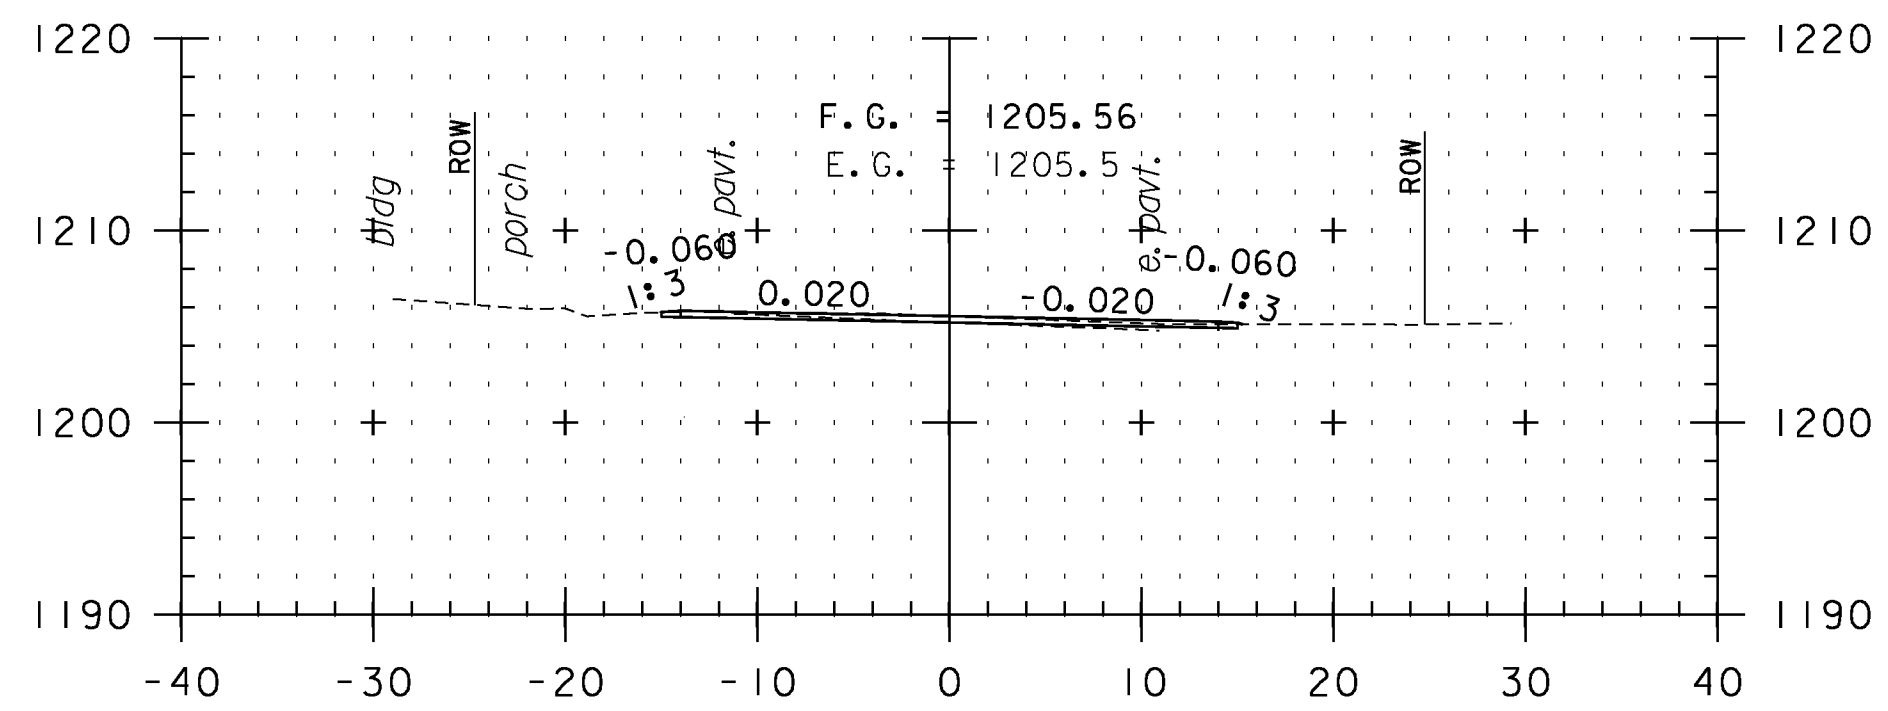


189+00

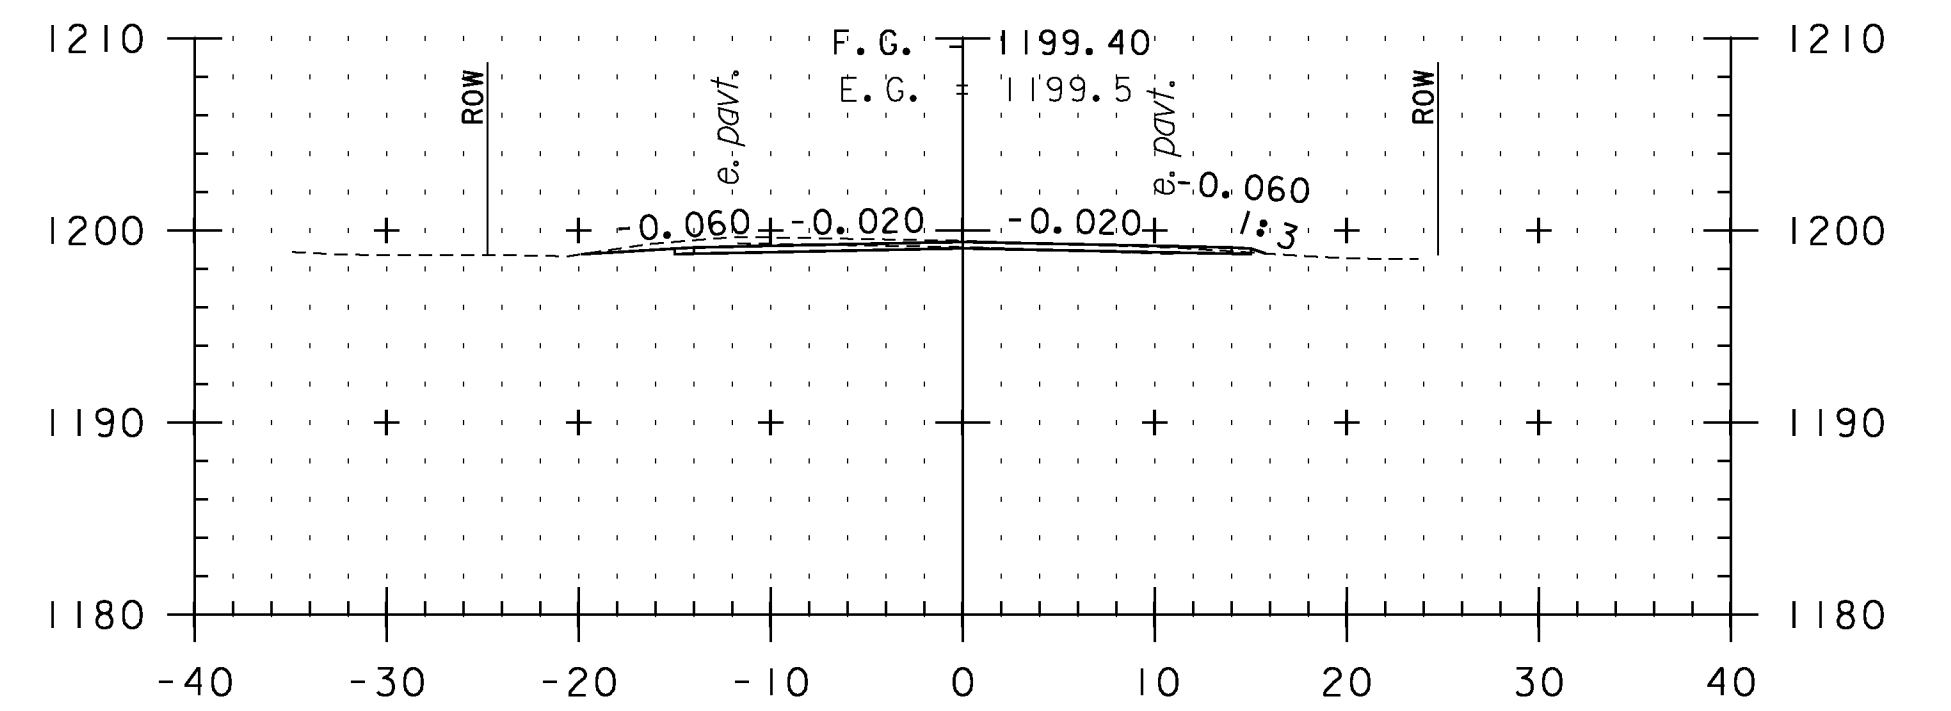


190+50

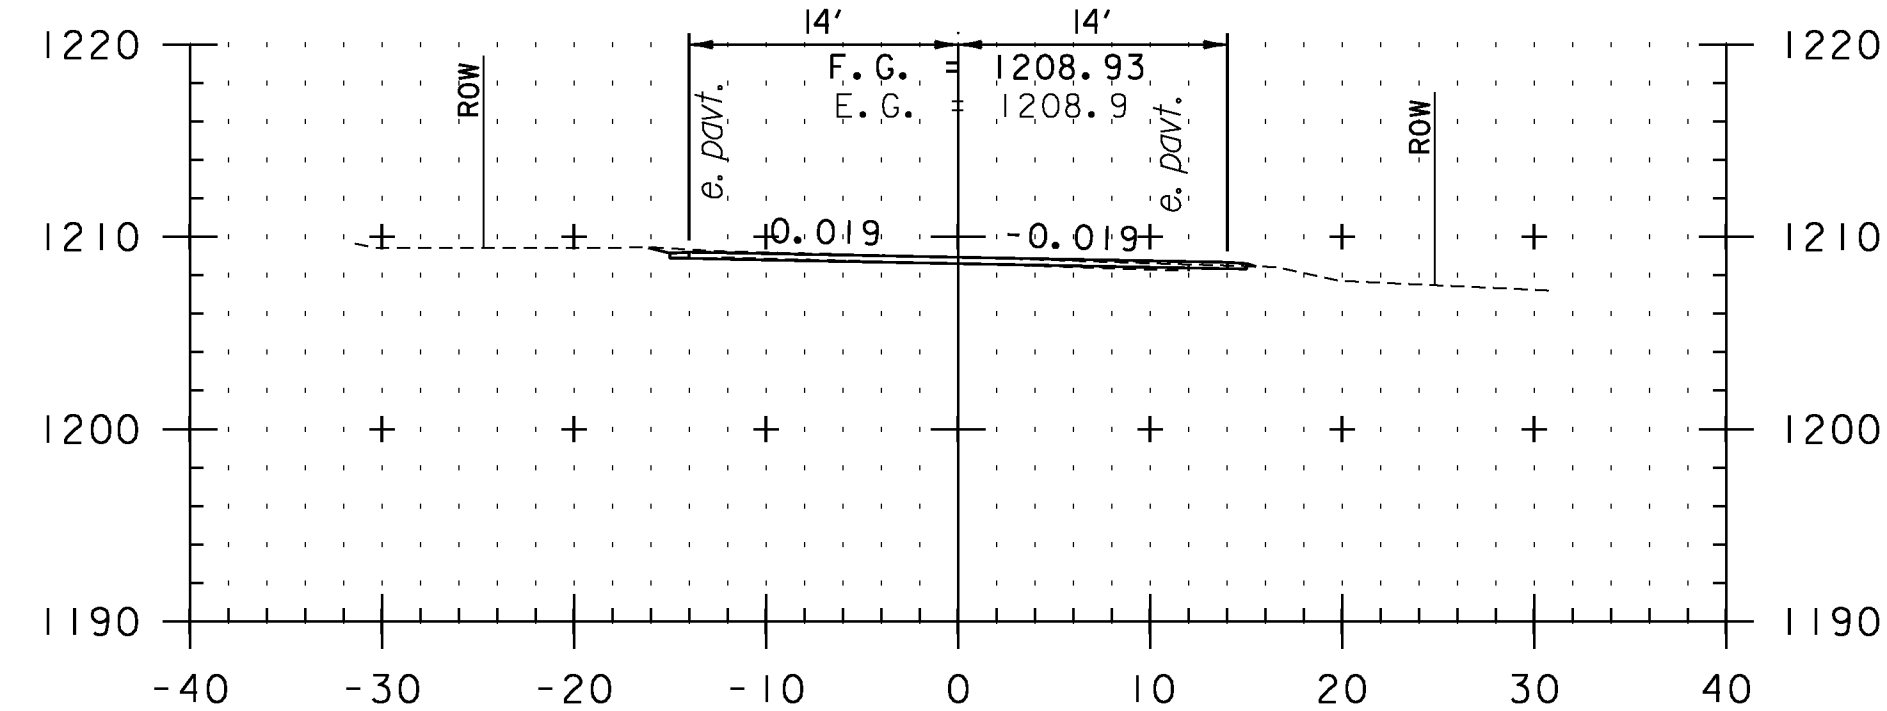

187+70

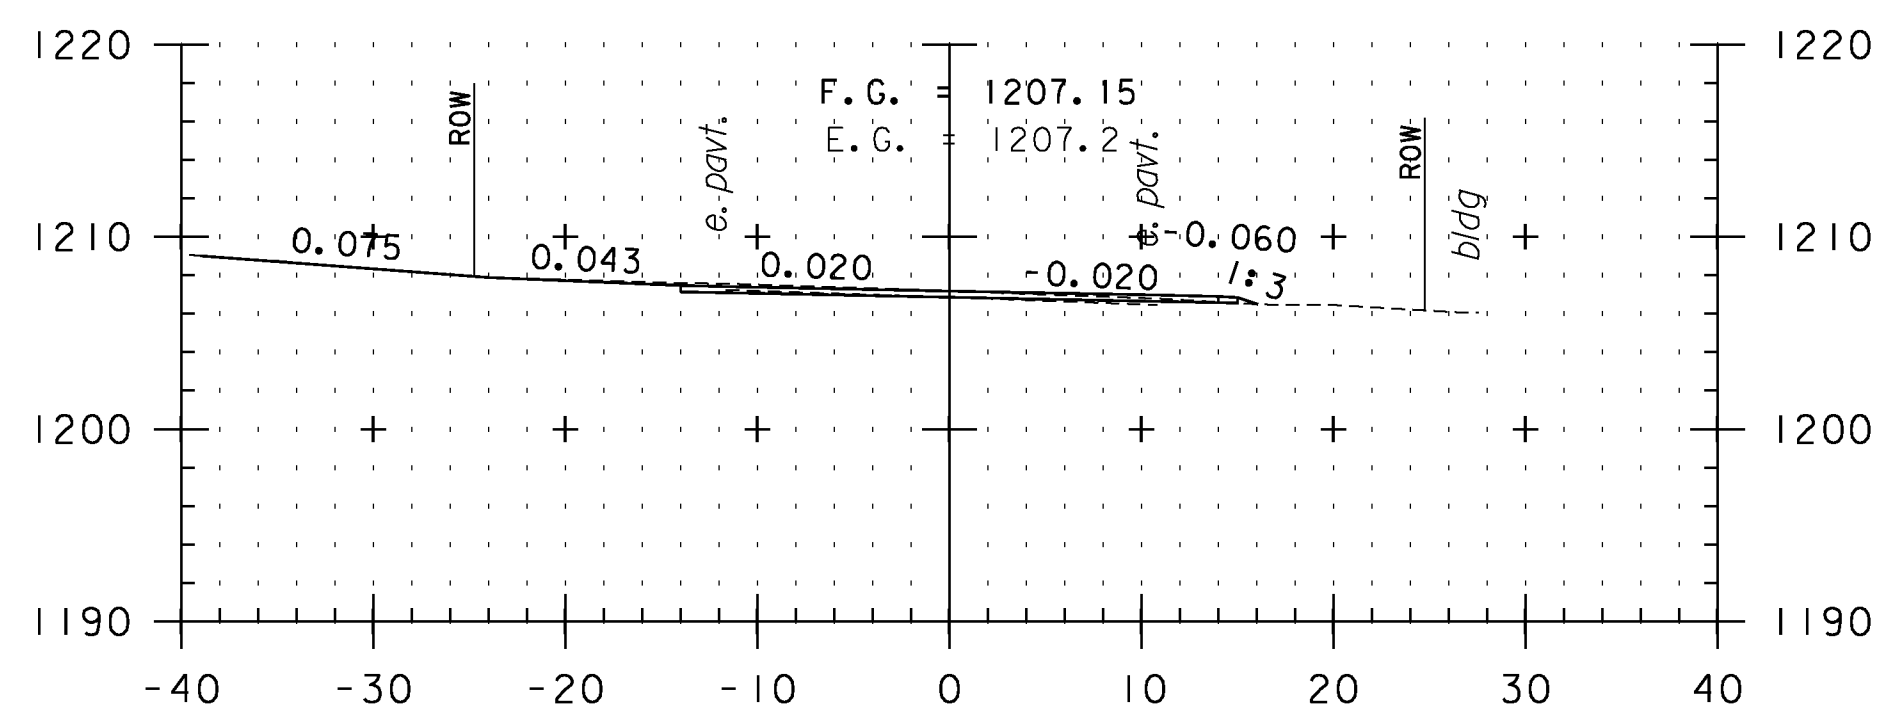


188+50

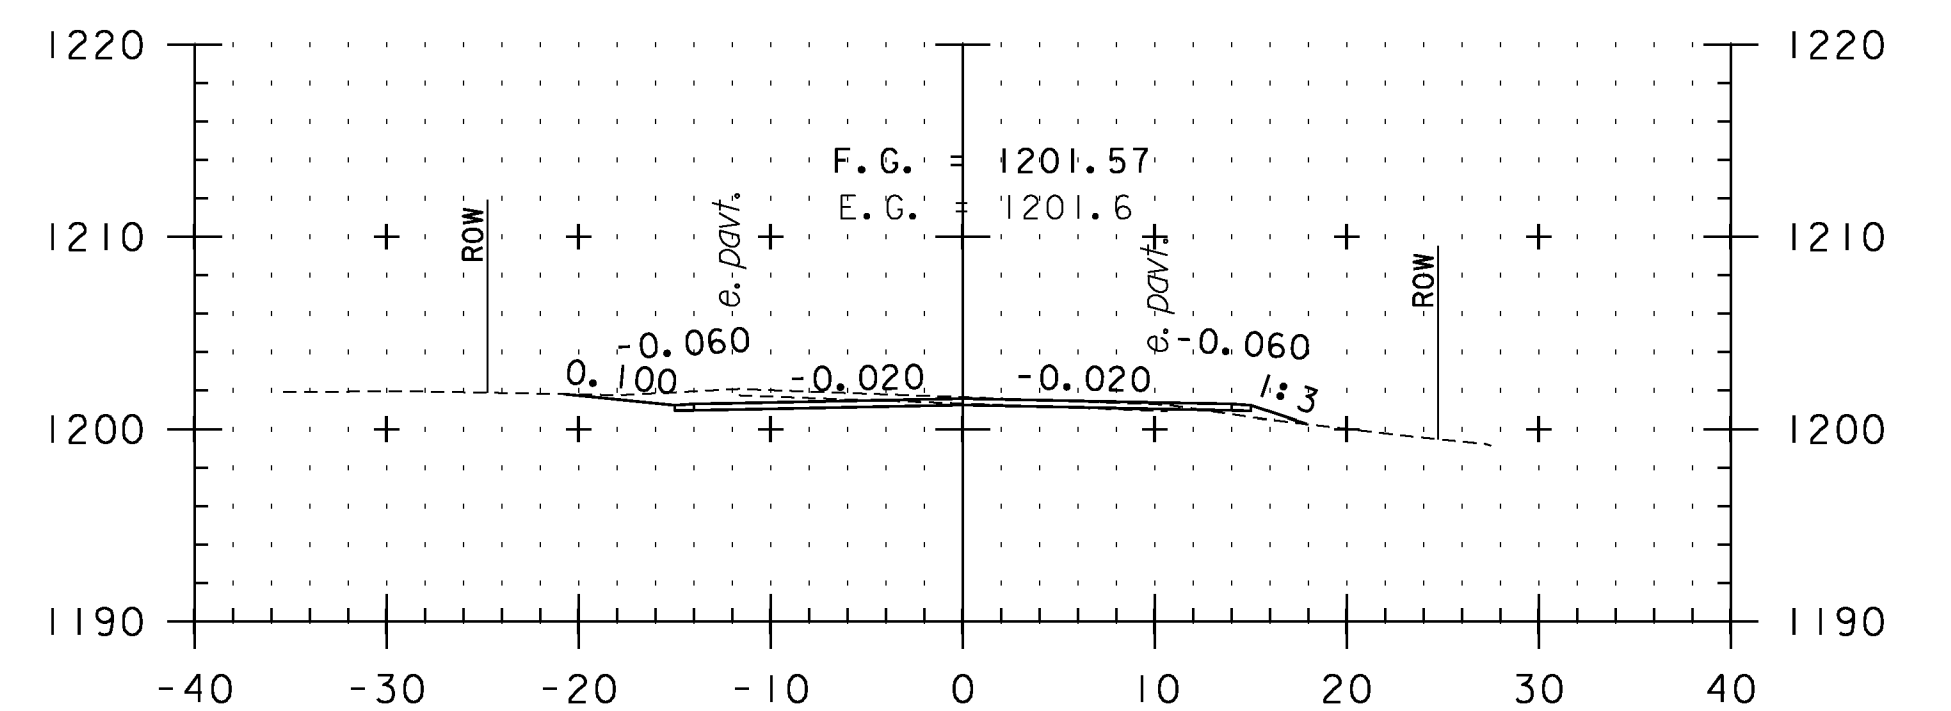

190+00

**CROSS SECTION SHEET 1**

STA. 187+70 TO STA. 191+00

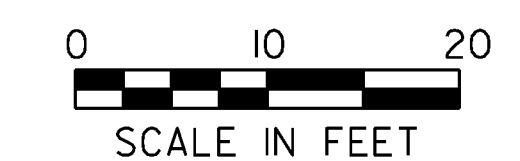

PROJECT NAME: VERSHIRE-THETFORD	PLOT DATE: 1/29/2013
PROJECT NUMBER: STP 2911(I)	DRAWN BY: SNG
FILE NAME: pl0c224.dgn	CHECKED BY: PTS
PROJECT LEADER: PTS	SHEET 109 OF 232
DESIGNED BY: NLL	
IPARM FILE NAME: IOC224_I09	