




192+50

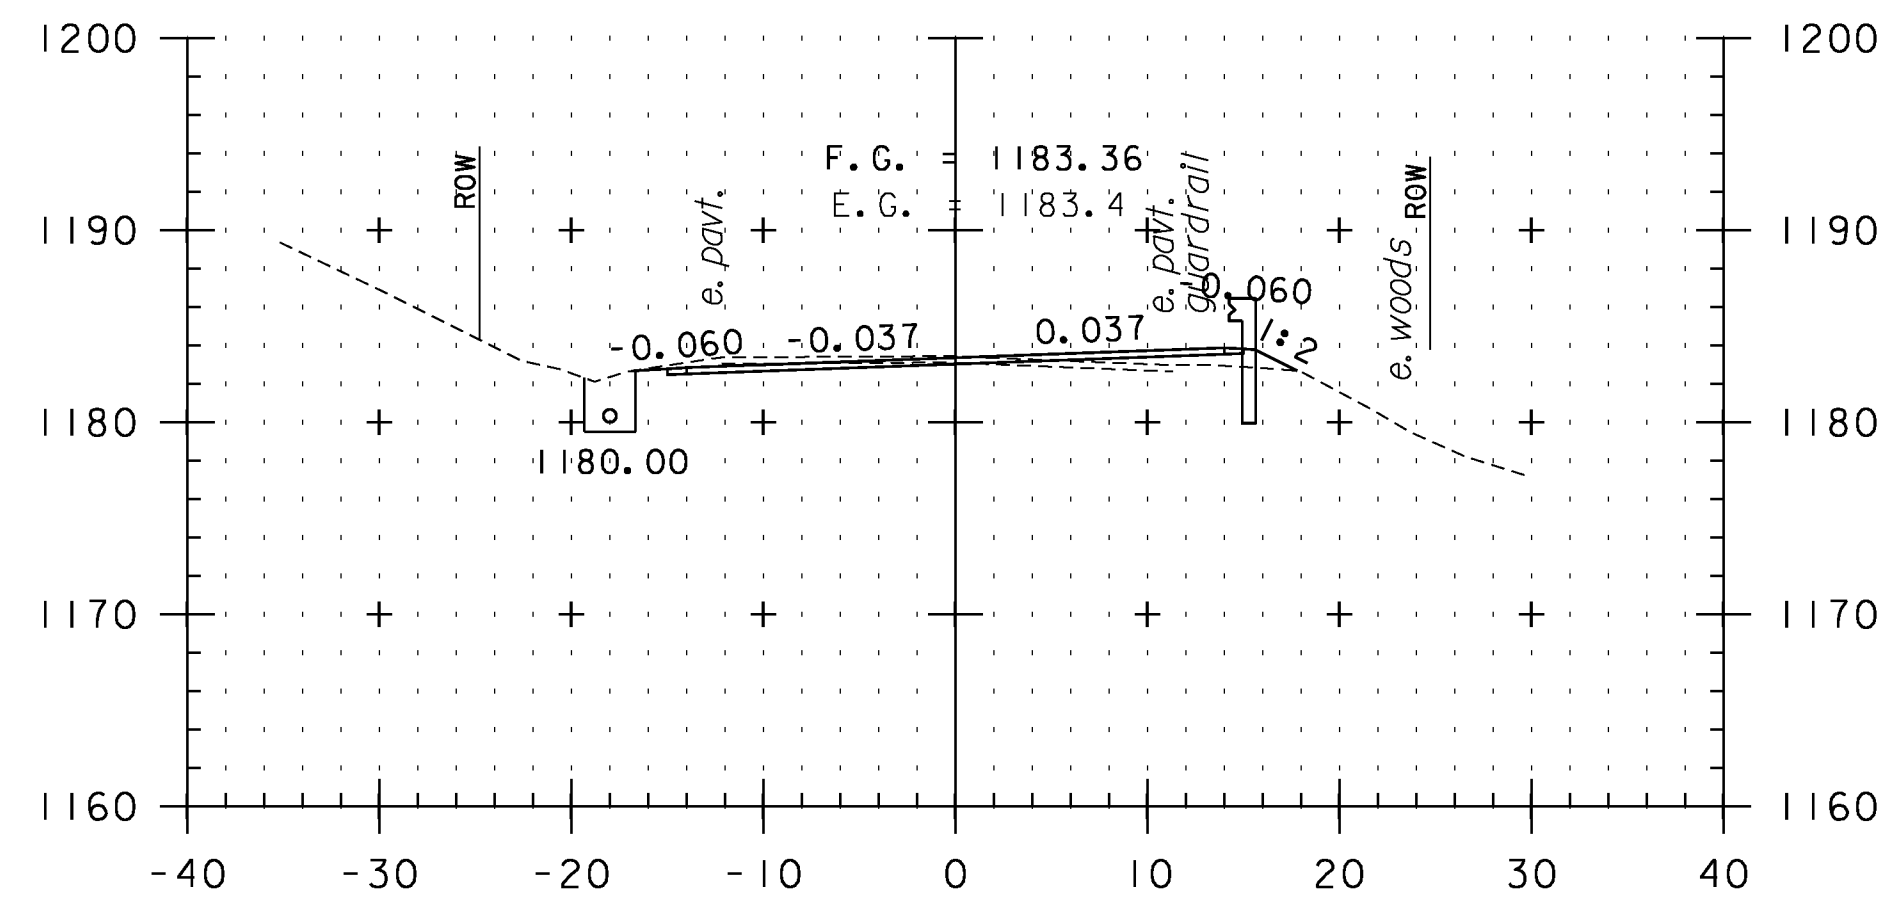


194+00

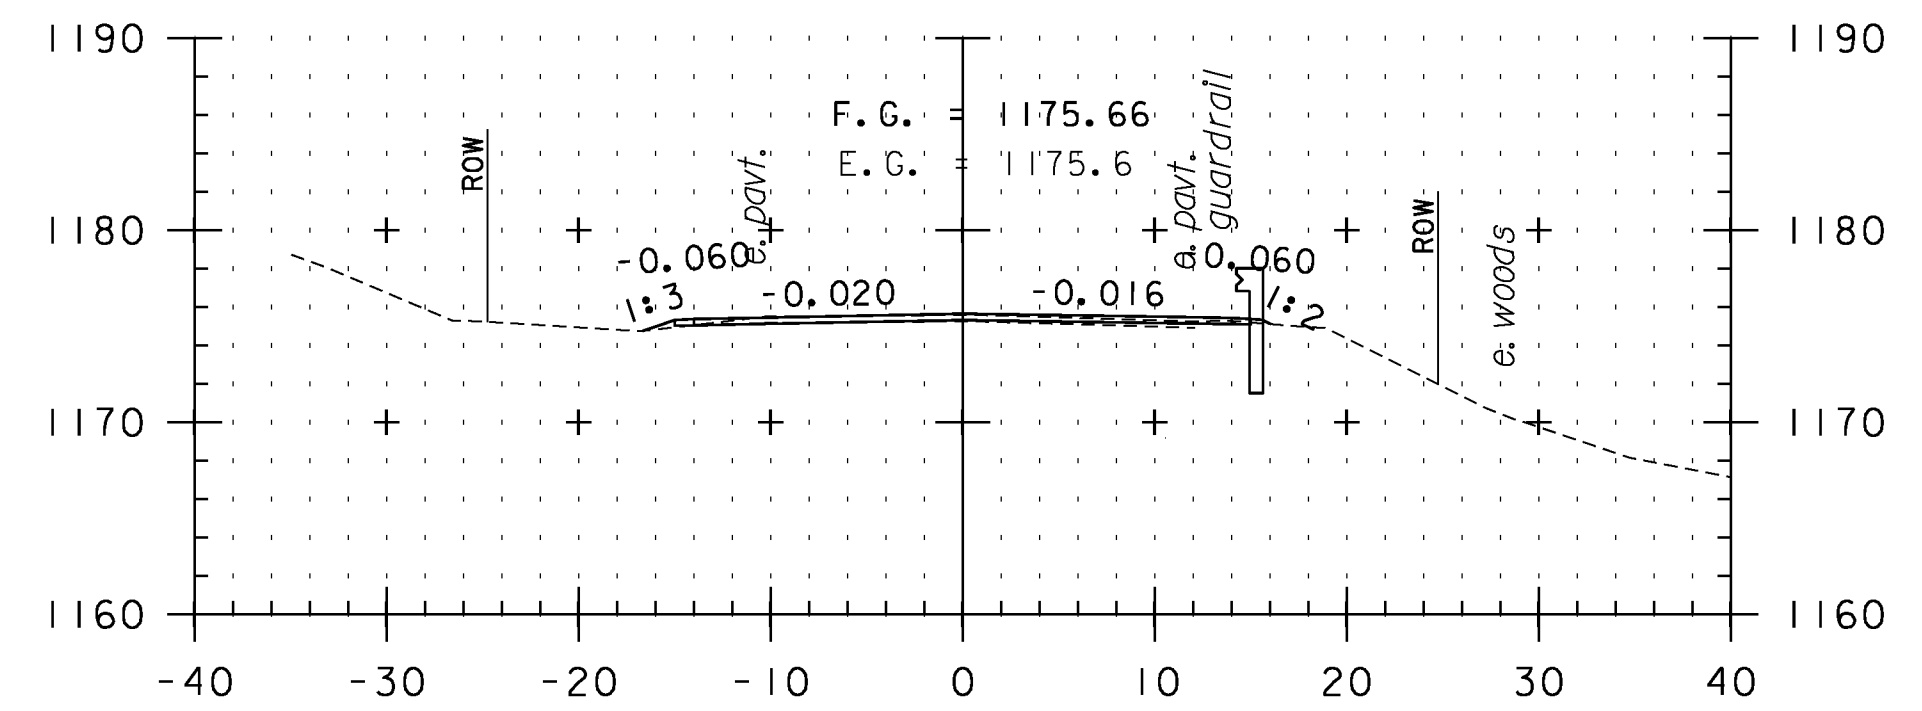


195+50

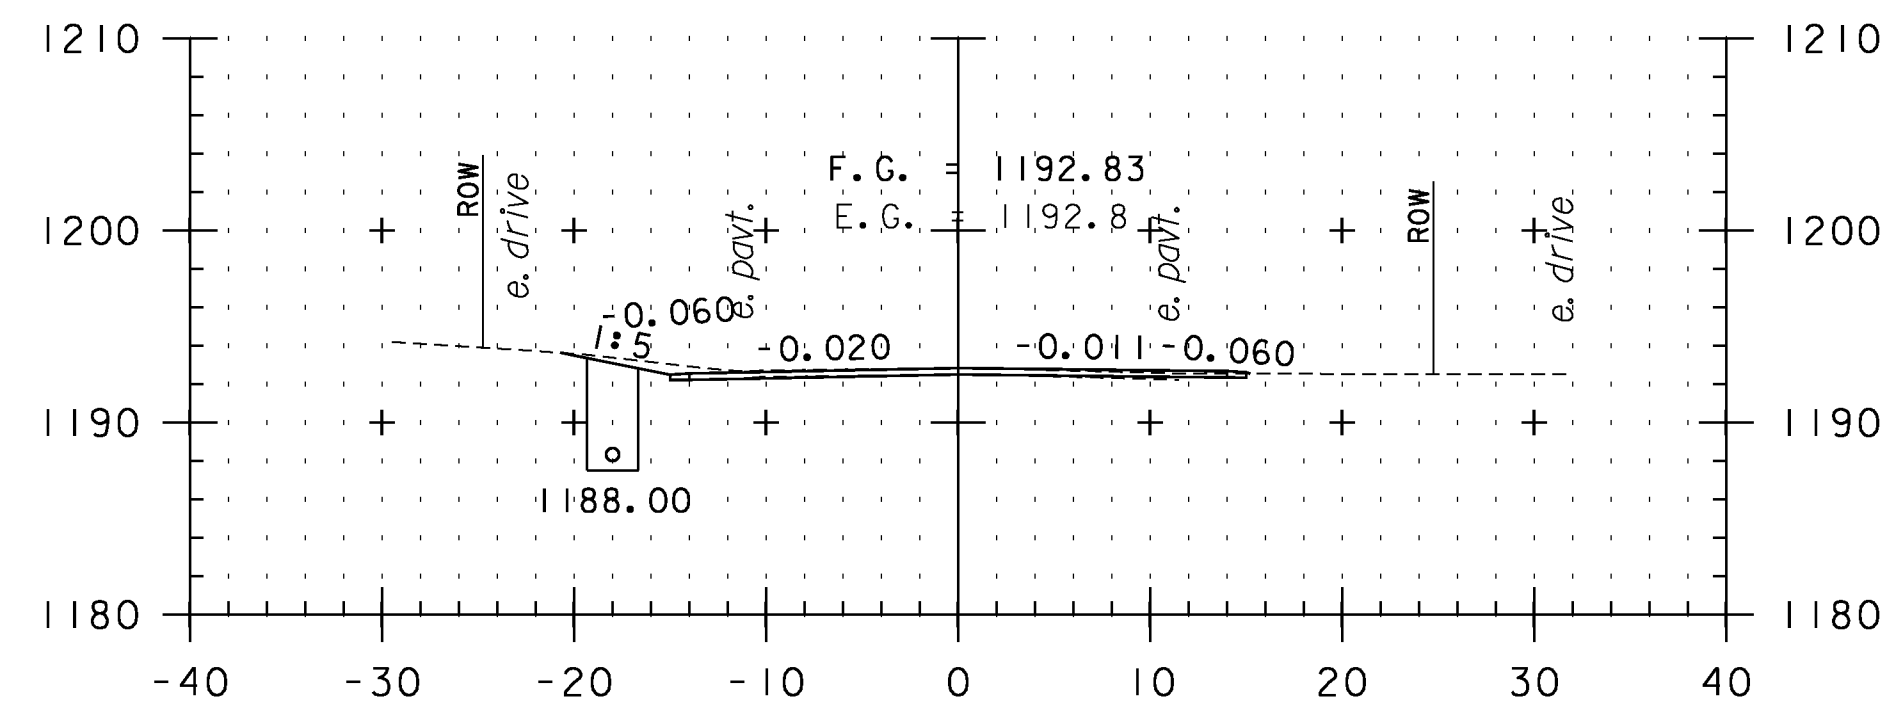


192+00

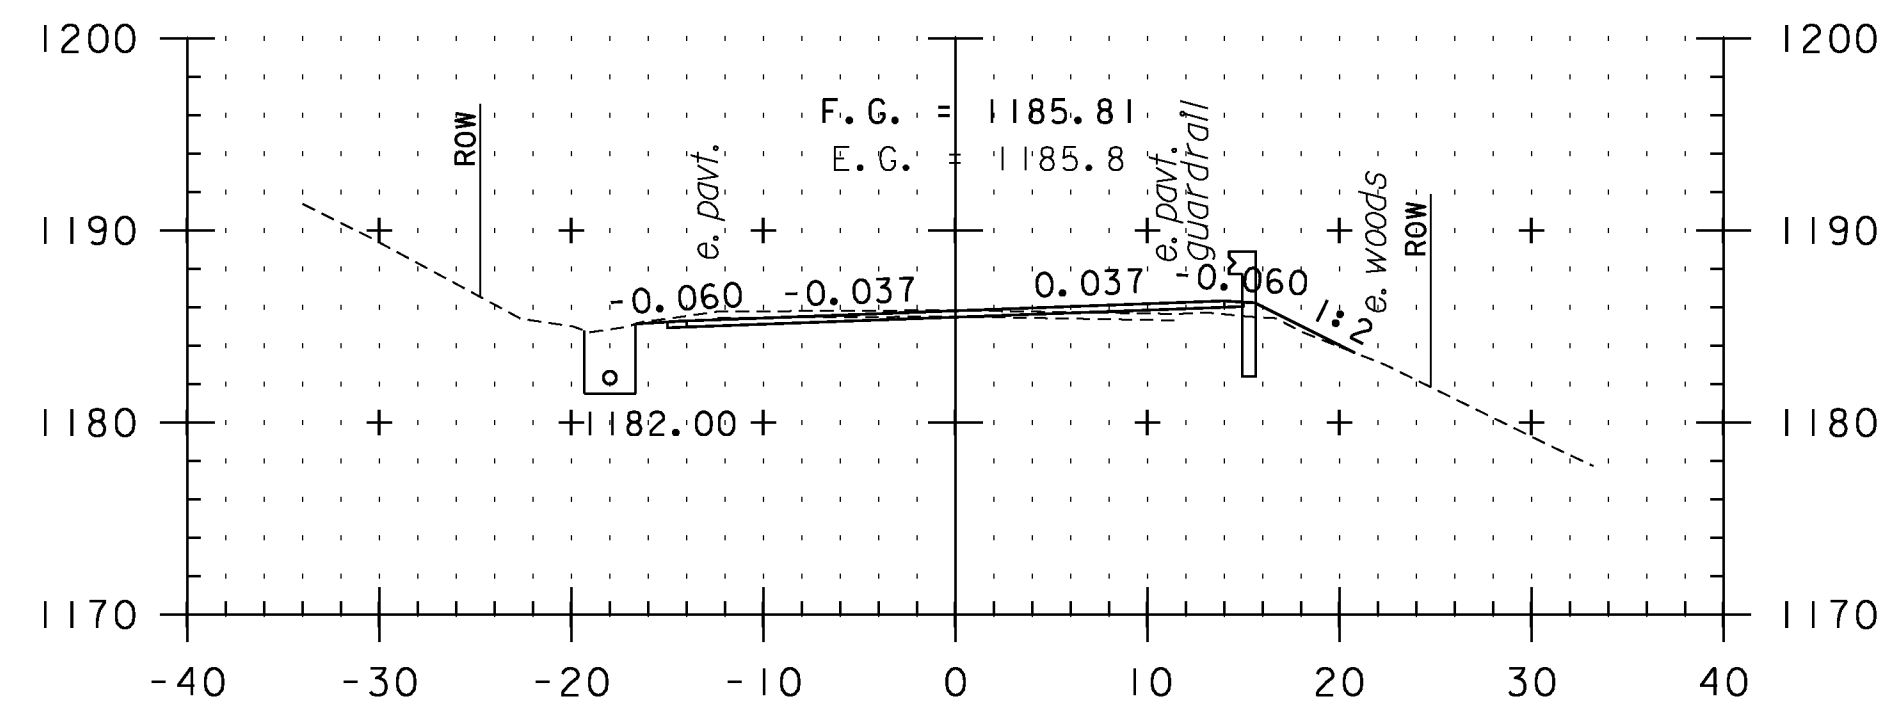


193+50

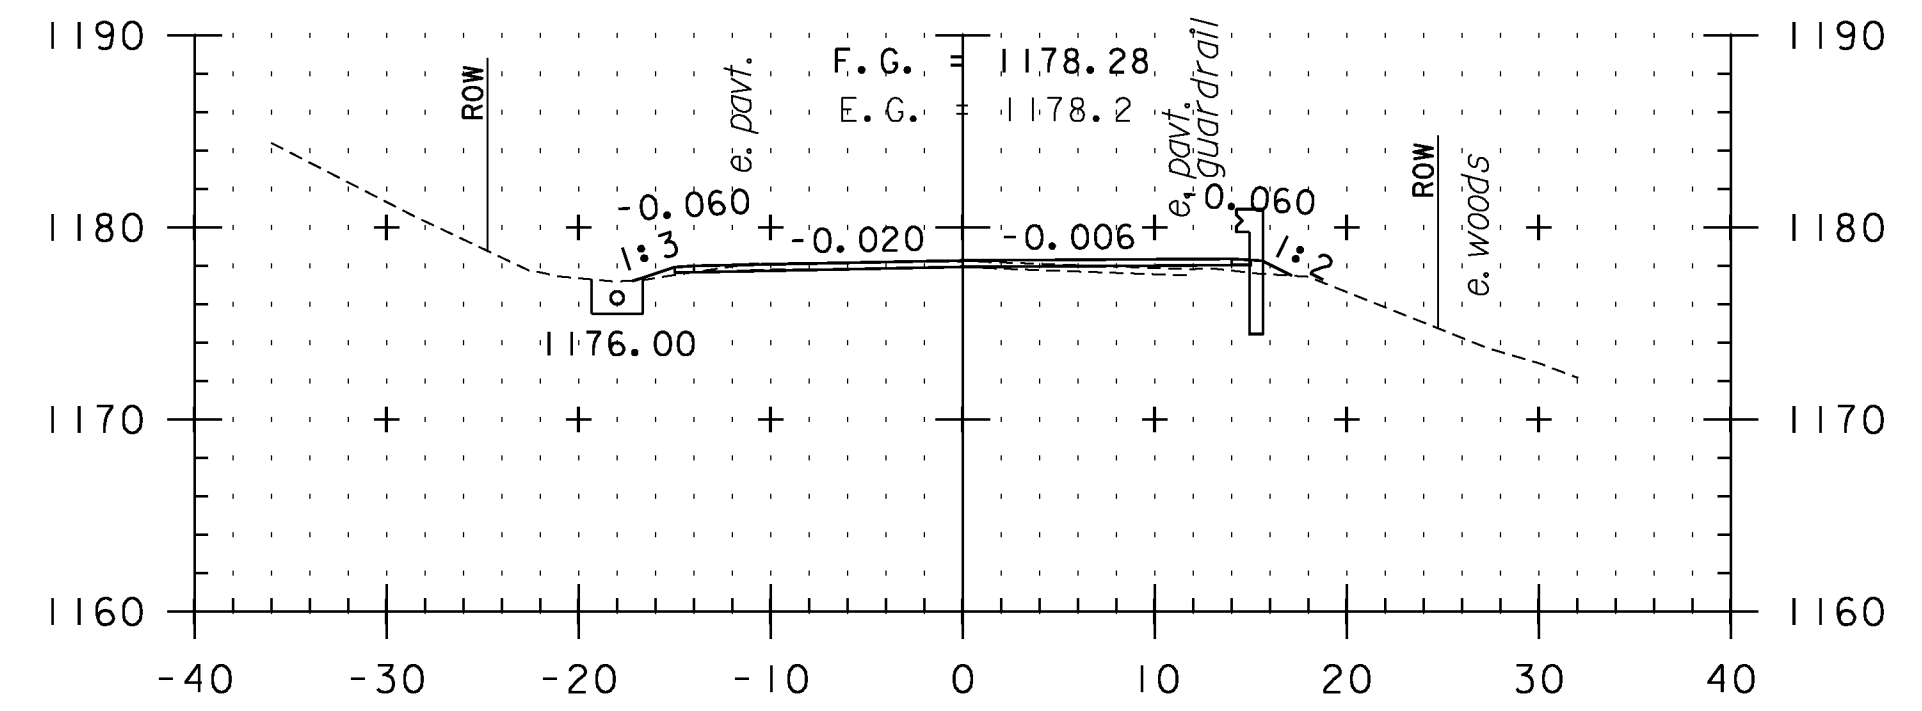


195+00

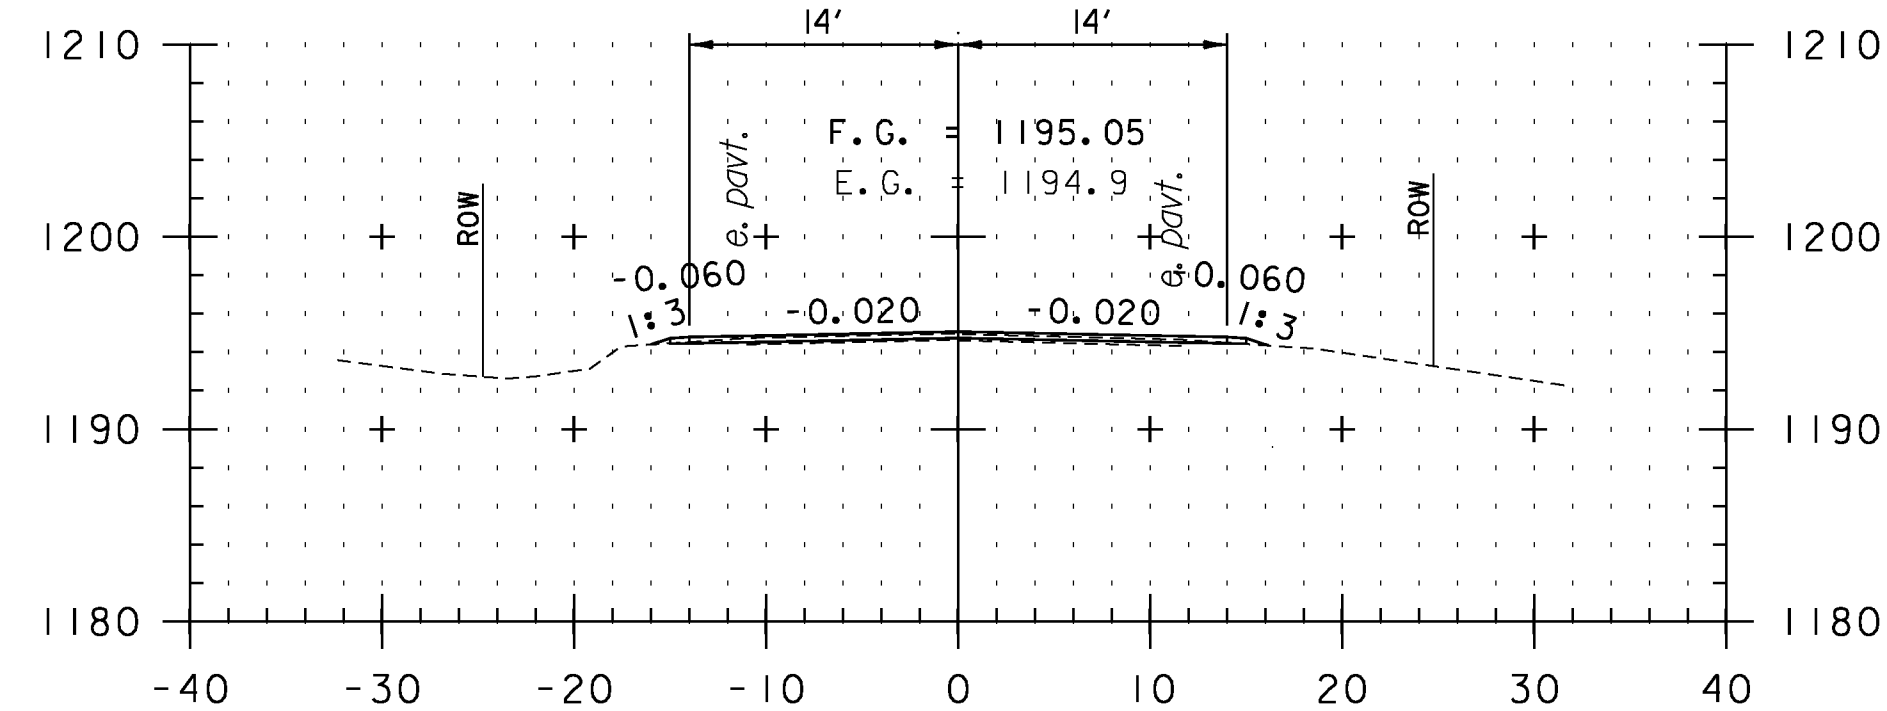

191+50

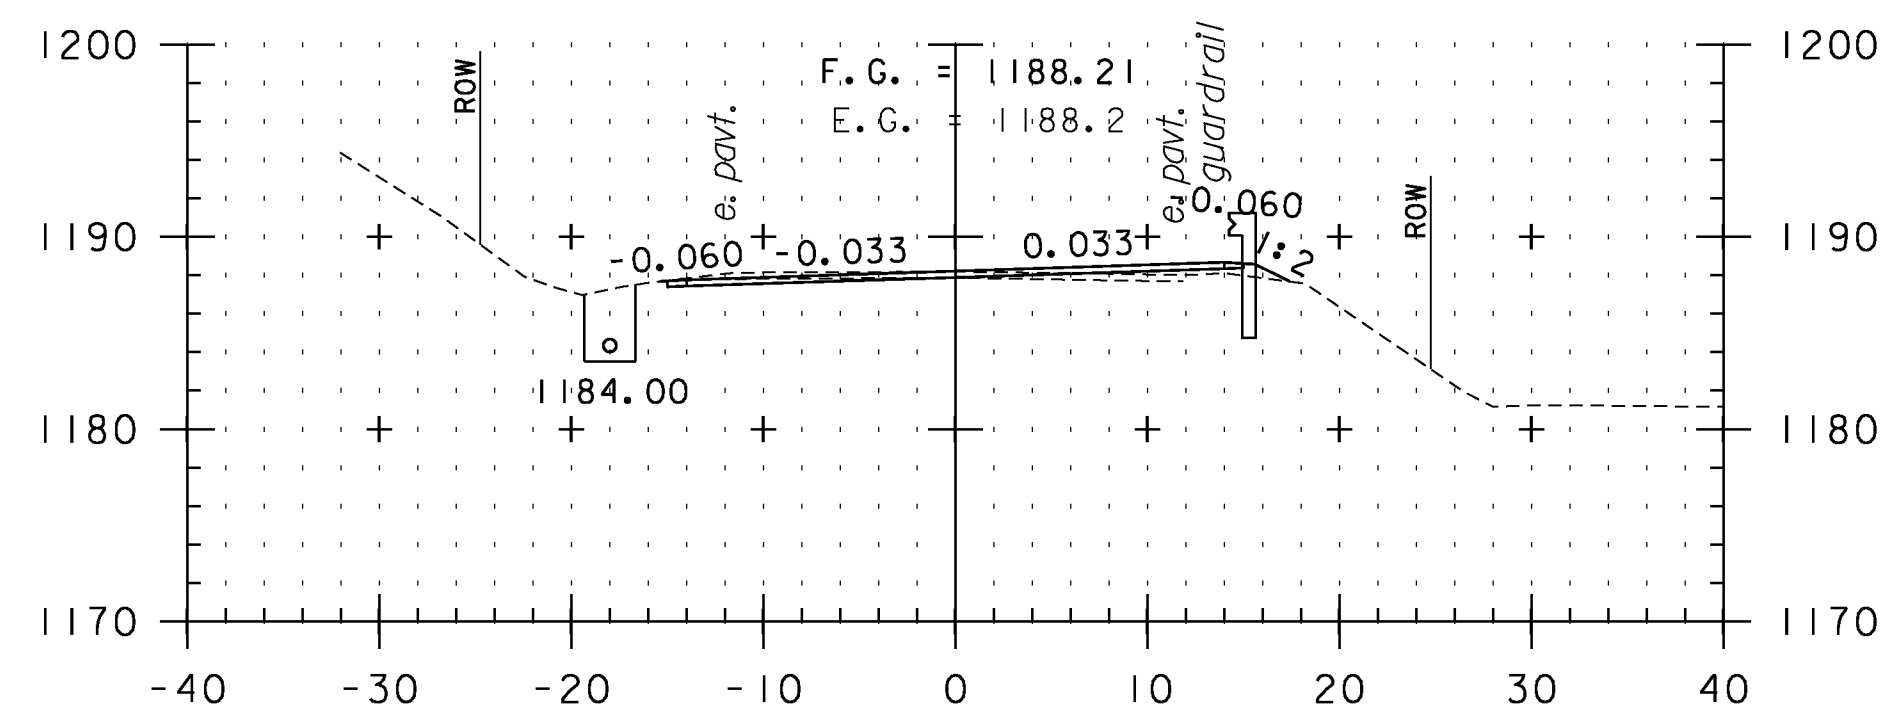

193+00

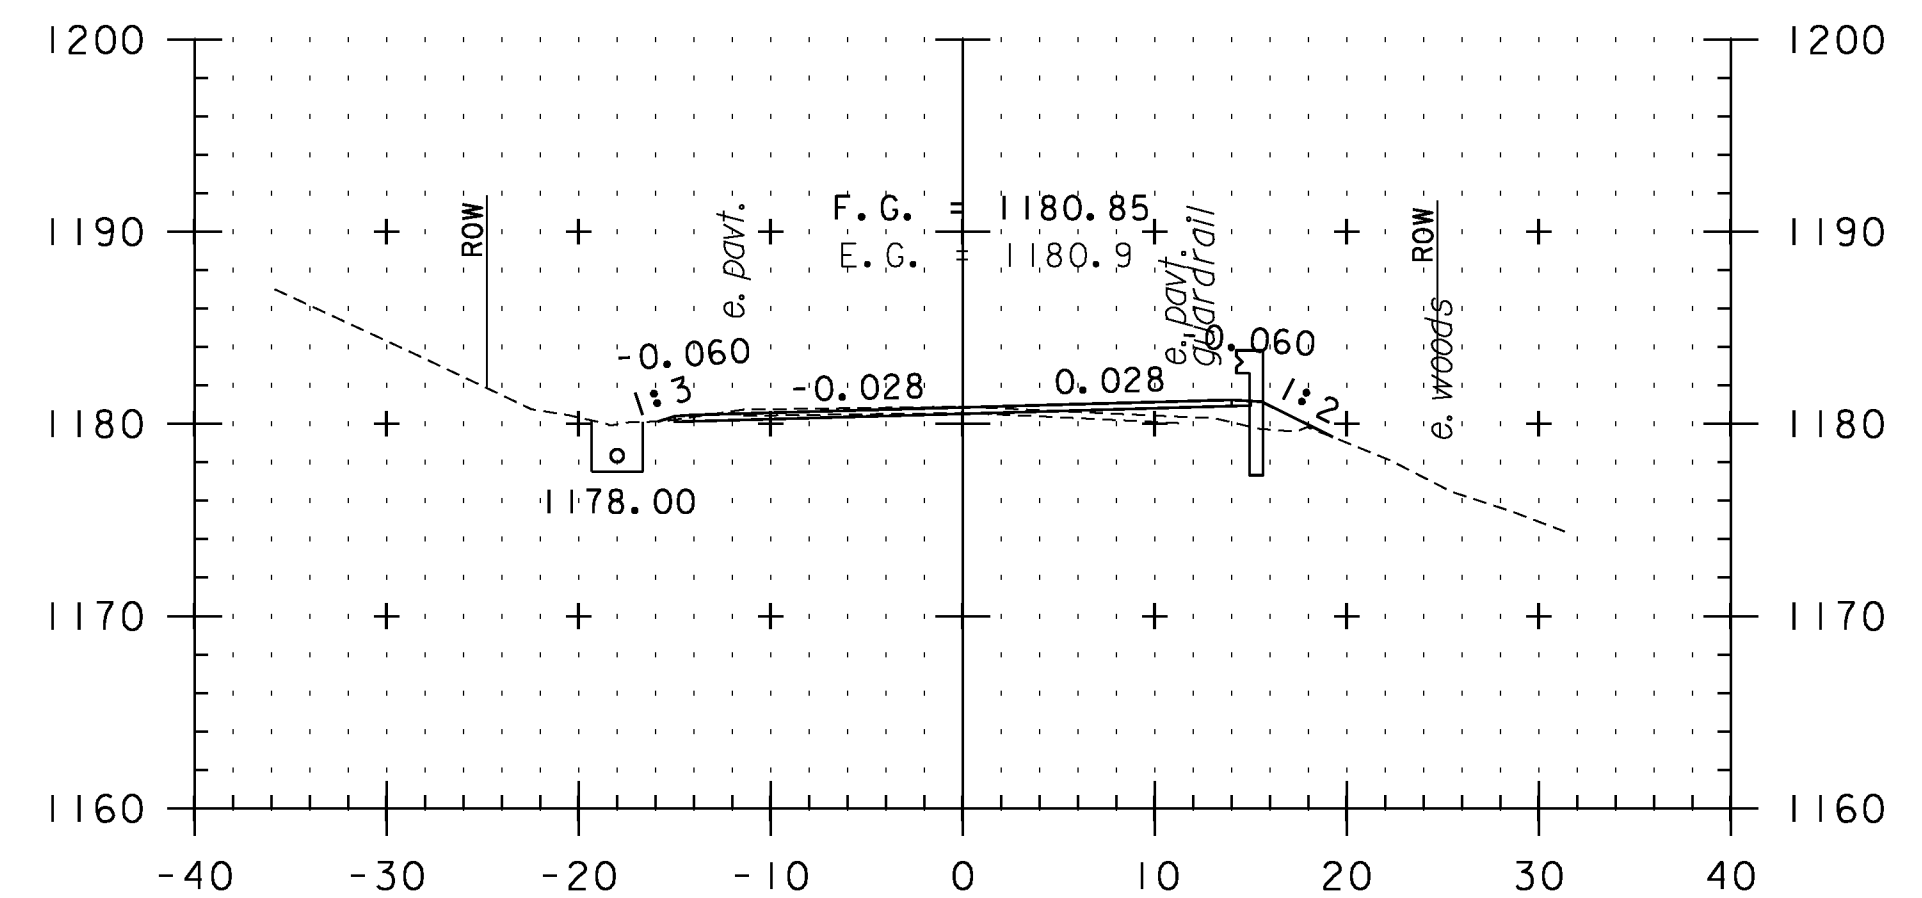

194+50

CROSS SECTION SHEET 2

STA. 191+50 TO STA. 195+50



PROJECT NAME: VERSHIRE-THETFORD	PLOT DATE: 1/29/2013
PROJECT NUMBER: STP 2911(I)	DRAWN BY: SNG
FILE NAME: pl0c224.dgn	CHECKED BY: PTS
PROJECT LEADER: PTS	SHEET 110 OF 232
DESIGNED BY: NLL	
IPARM FILE NAME: IOC224_110	