




197+00

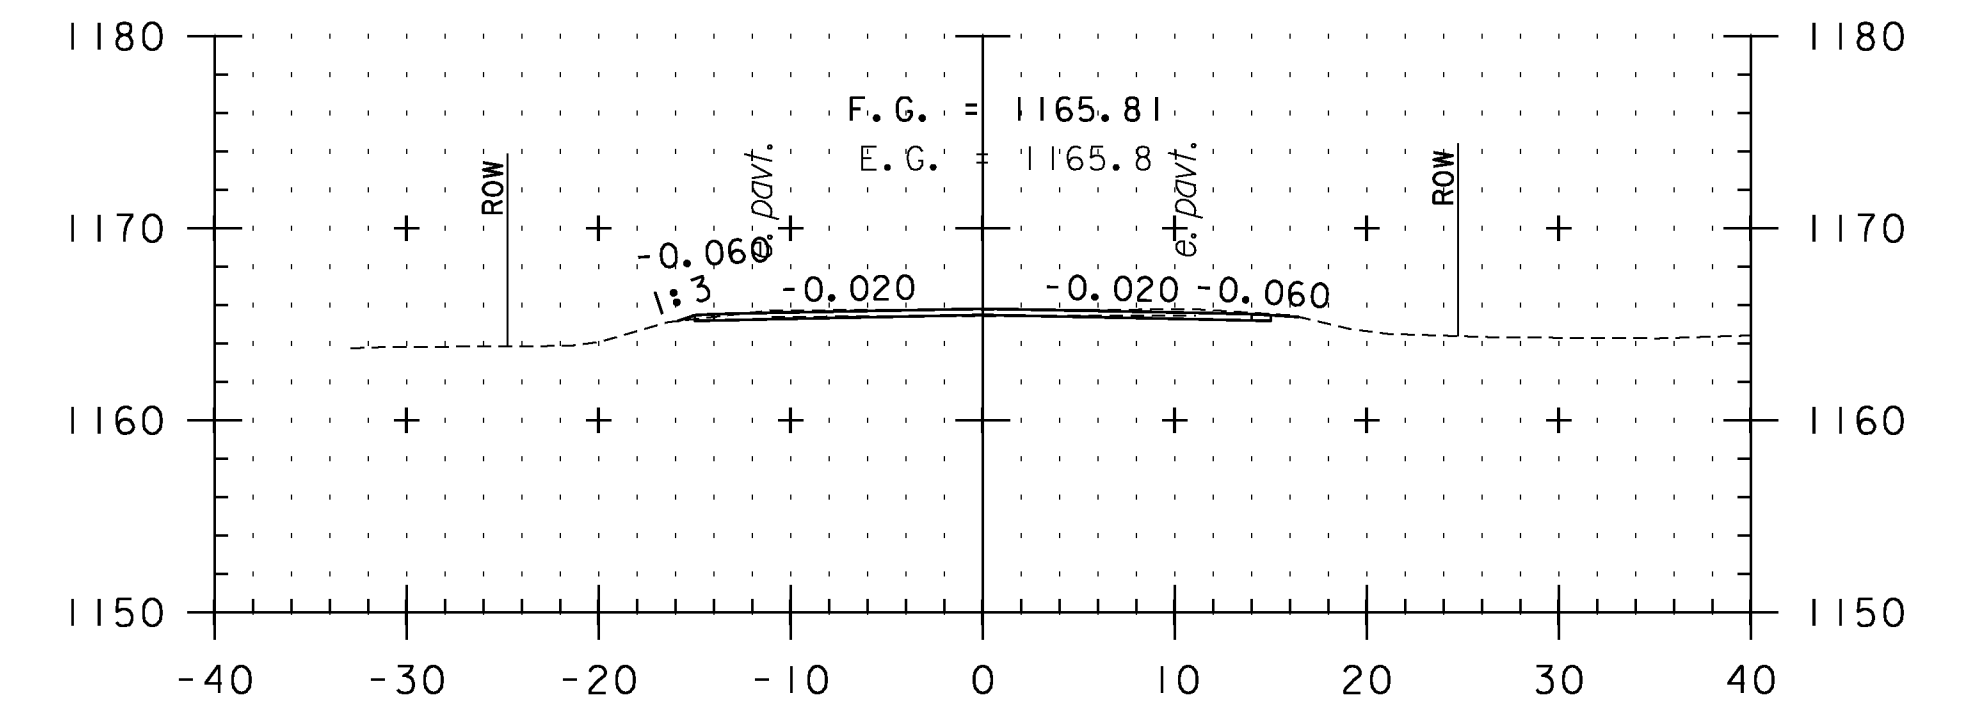


199+50

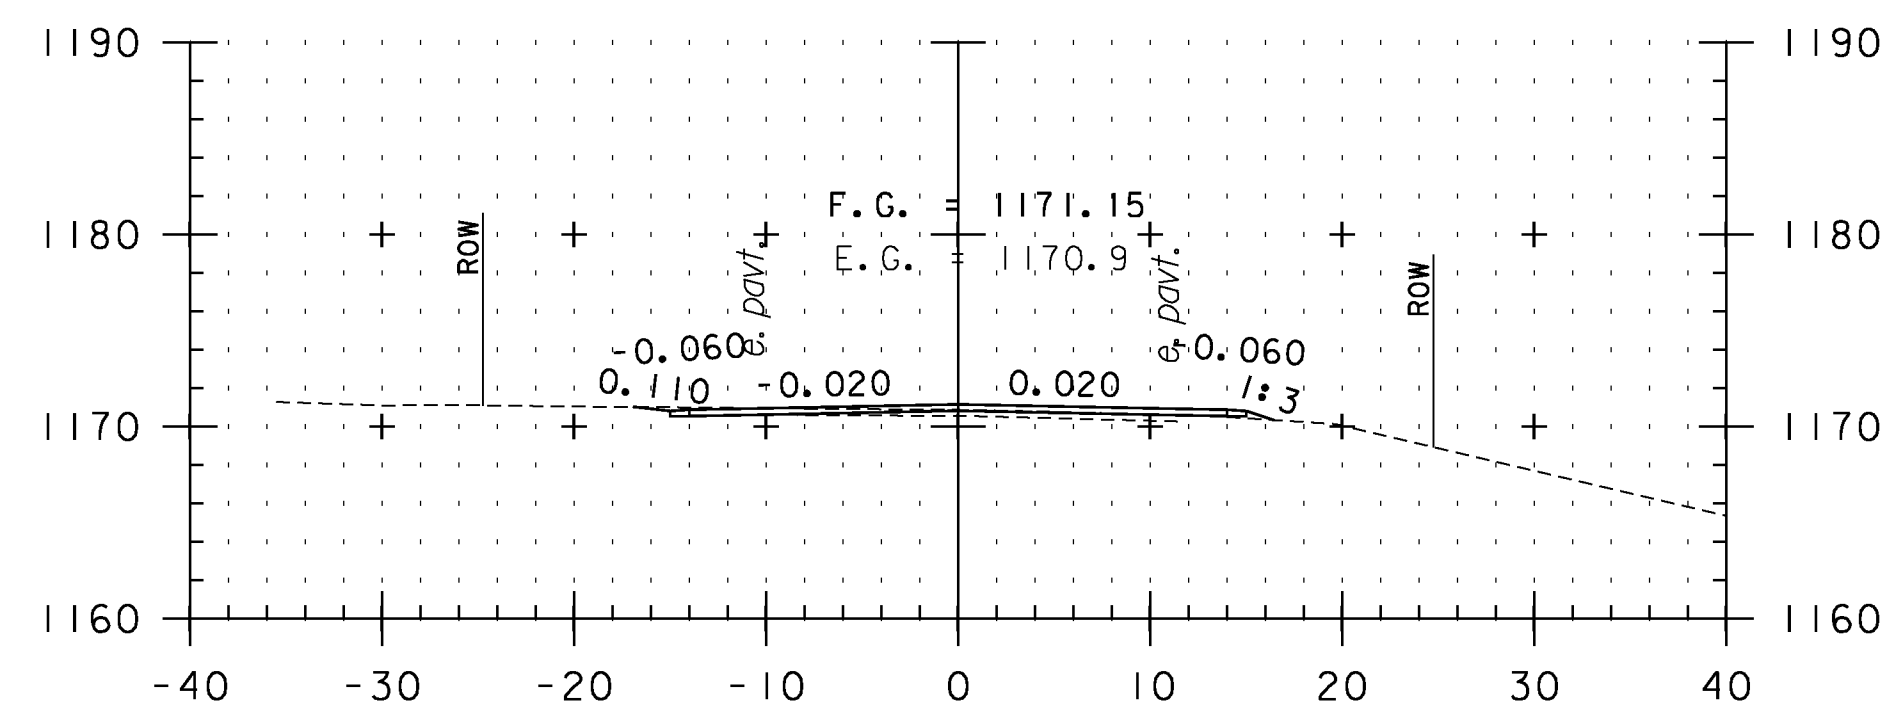


196+50

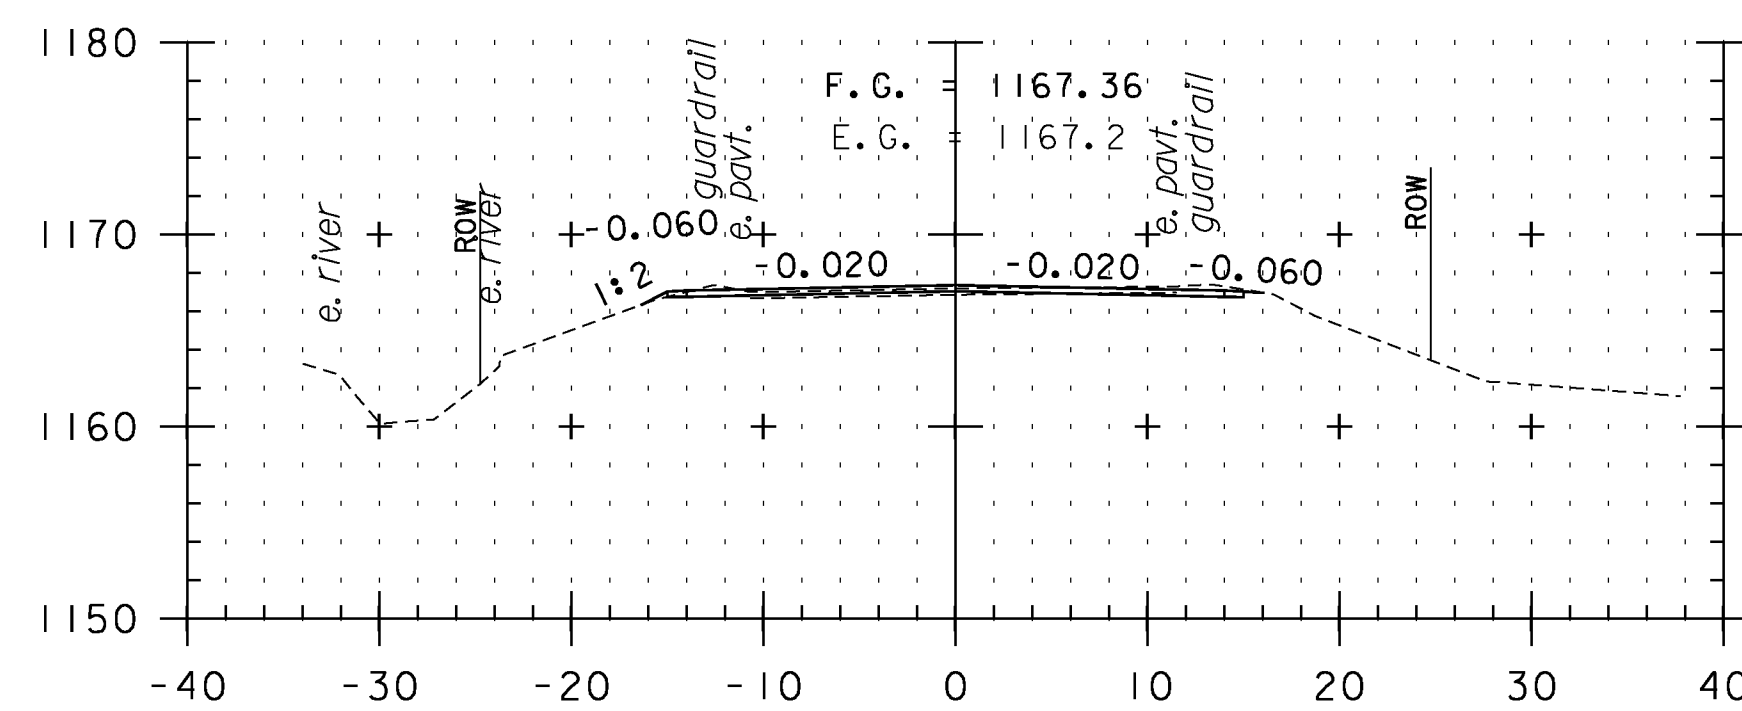


198+00

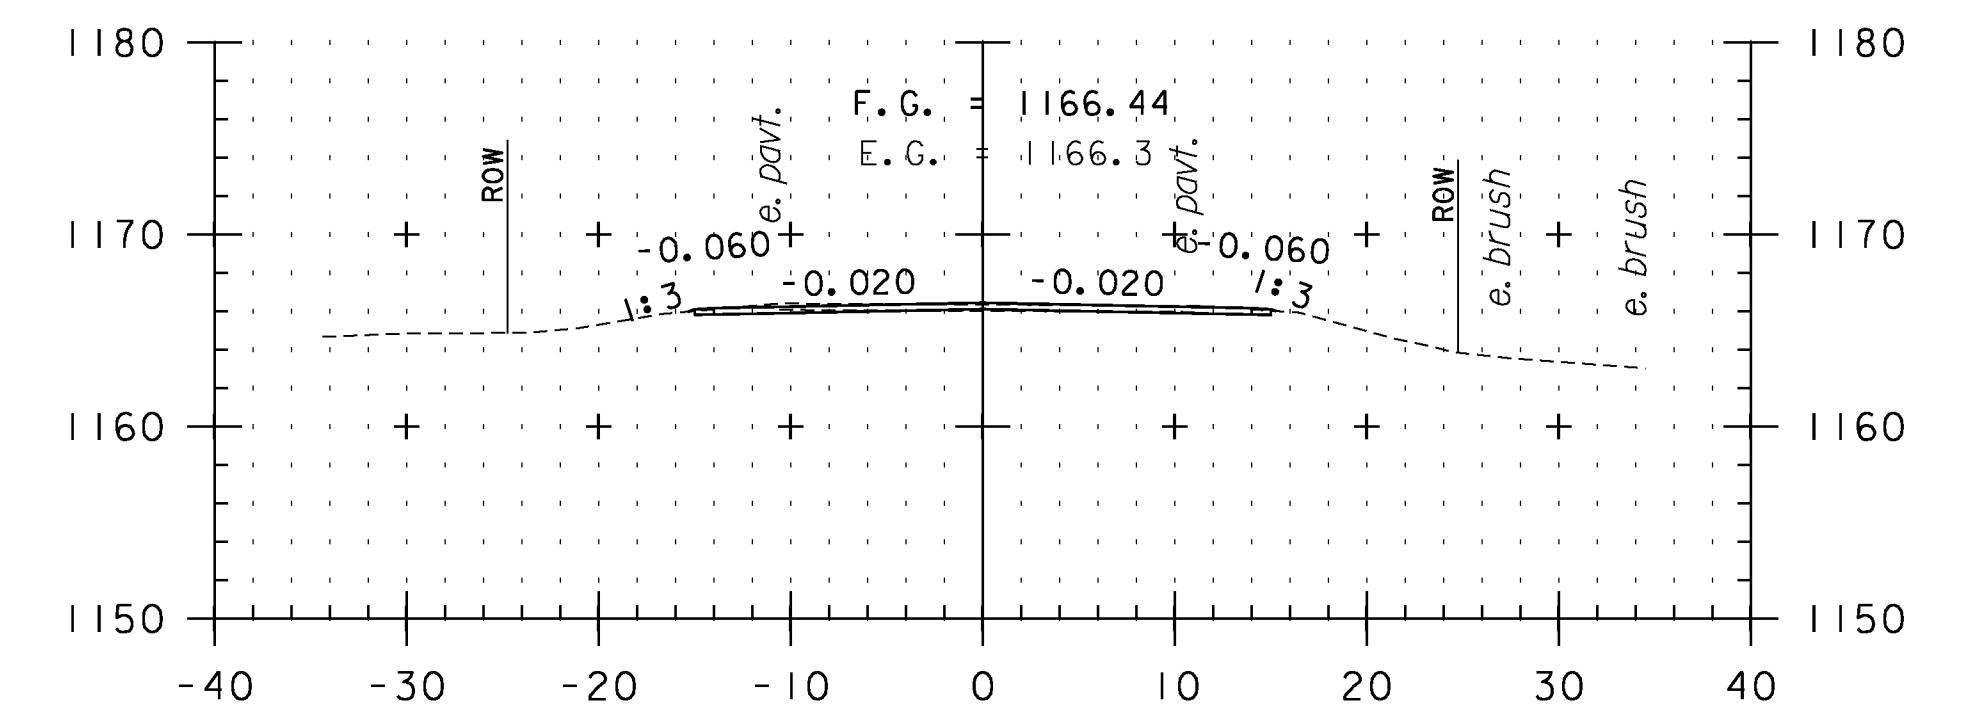


199+00

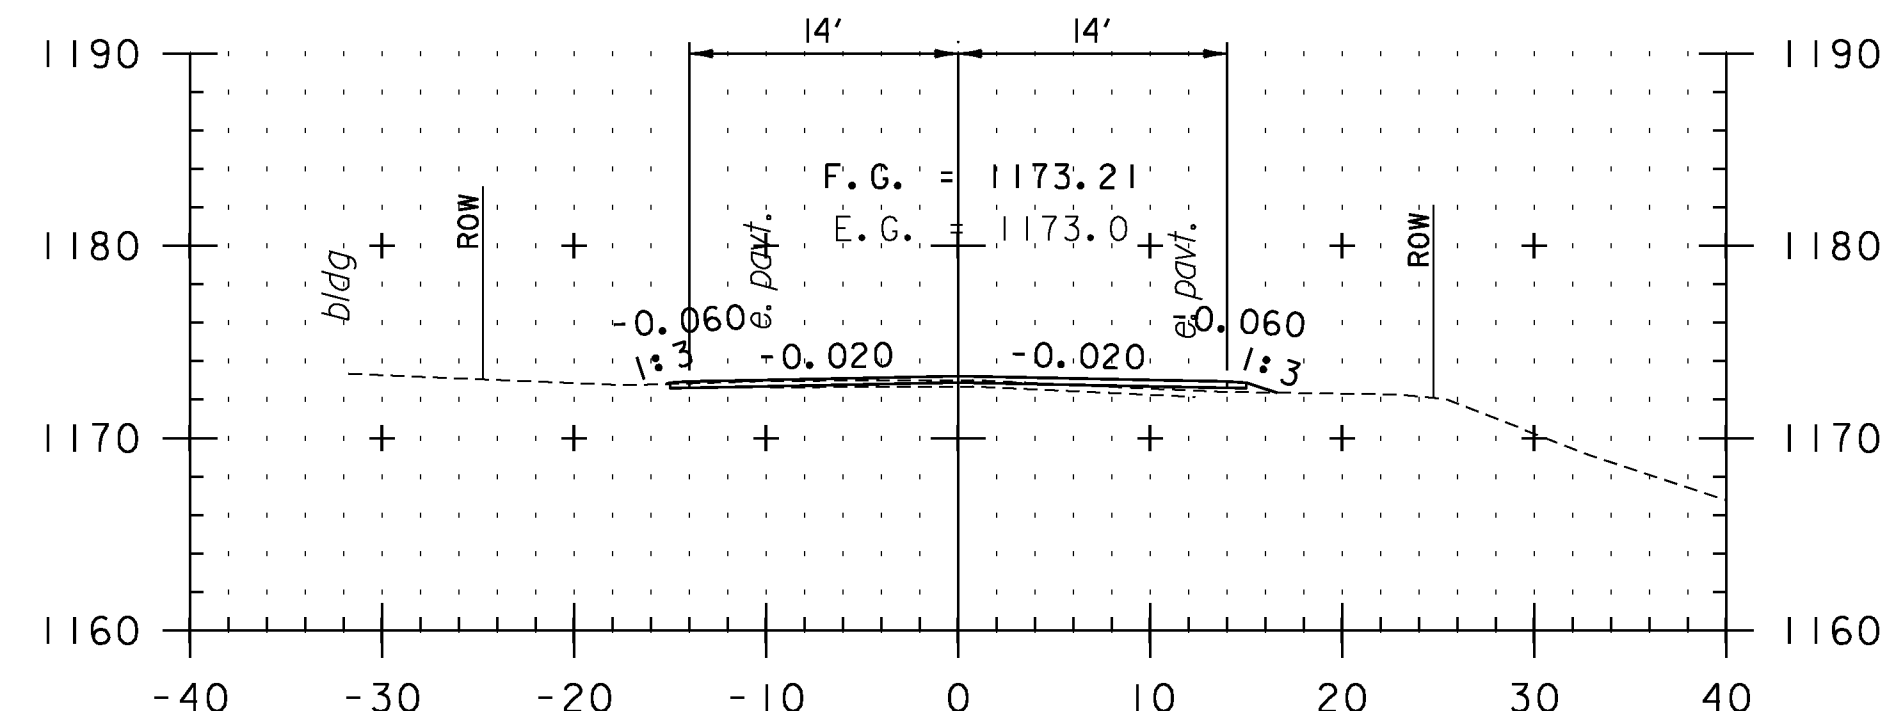

196+00

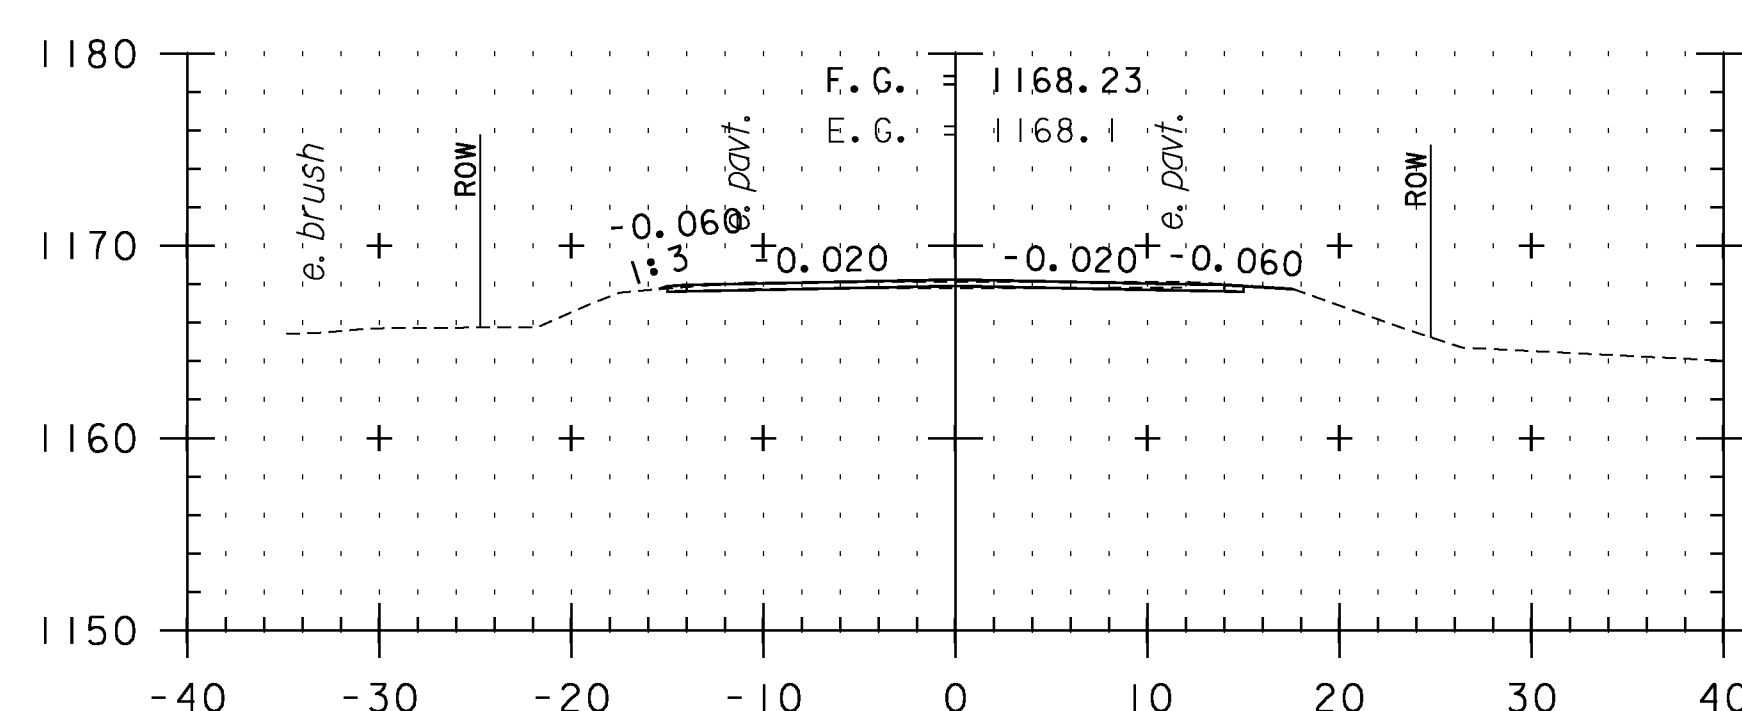


197+50

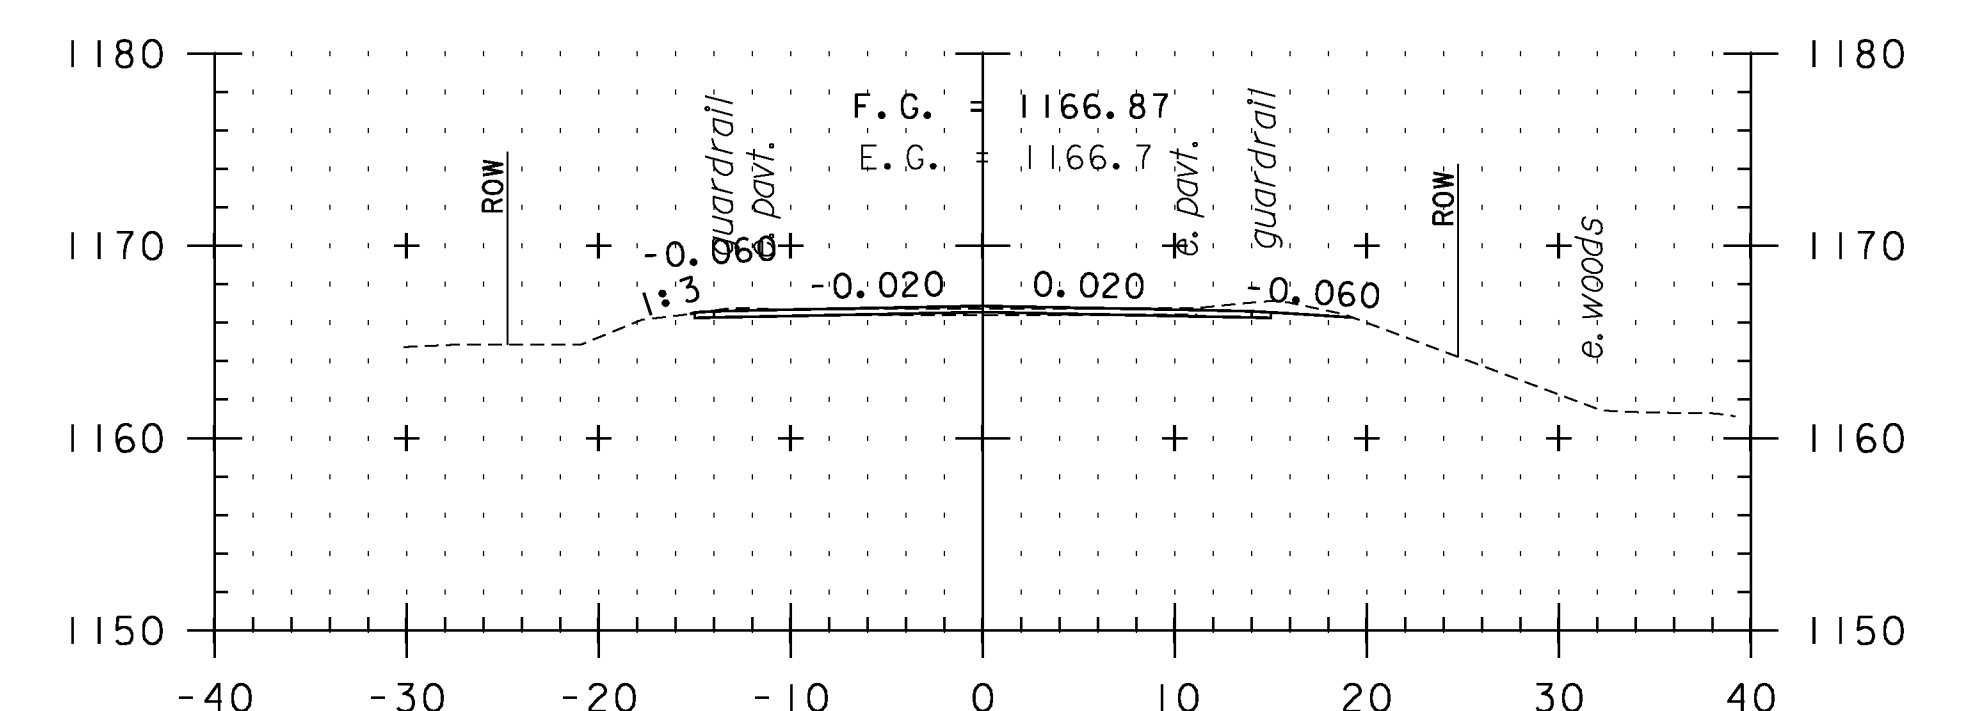

198+50

CROSS SECTION SHEET 3

STA. 196+00 TO STA. 199+50

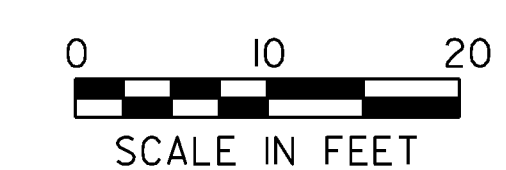

PROJECT NAME: VERSHIRE-THETFORD	
PROJECT NUMBER: STP 2911(I)	
FILE NAME: pl0c224.dgn	PLOT DATE: 1/29/2013
PROJECT LEADER: PTS	DRAWN BY: SNG
DESIGNED BY: NLL	CHECKED BY: PTS
IPARM FILE NAME: IOC224_III	SHEET III OF 232