




201+00

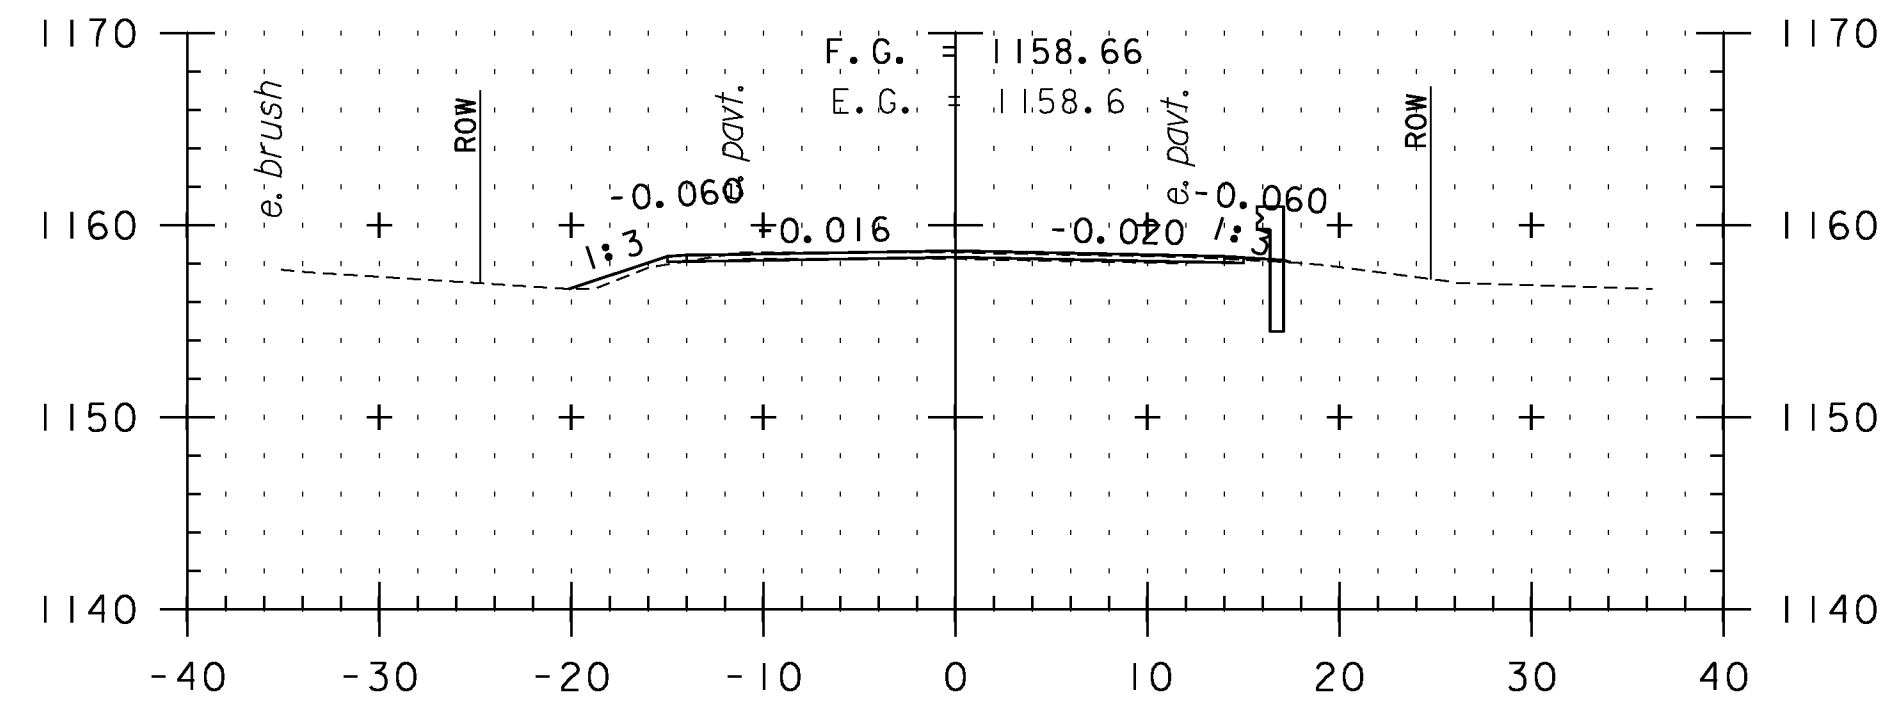


202+50

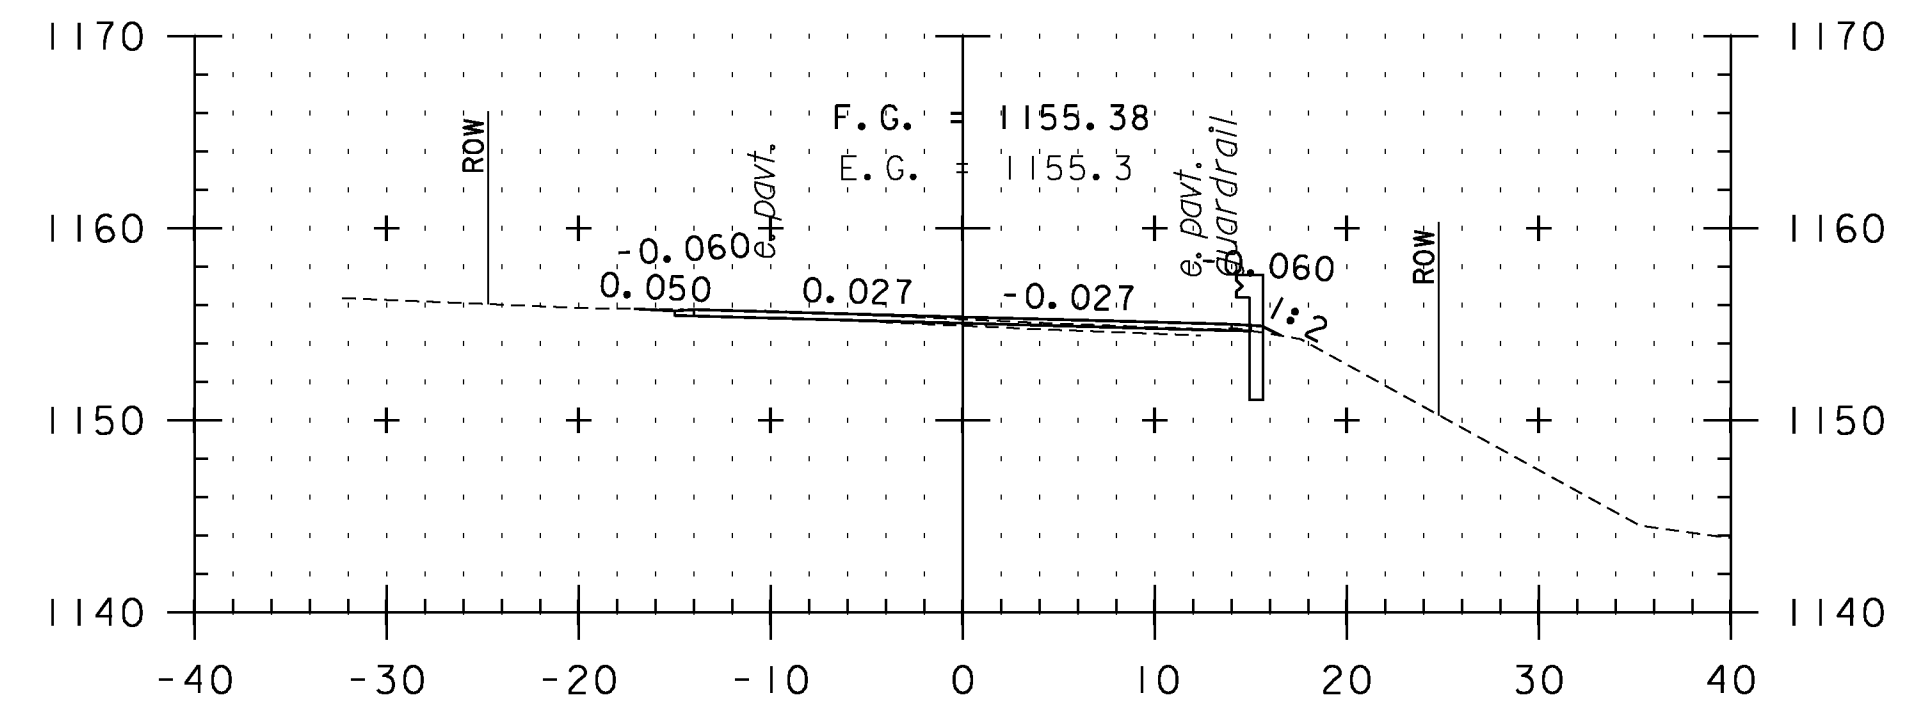


204+00

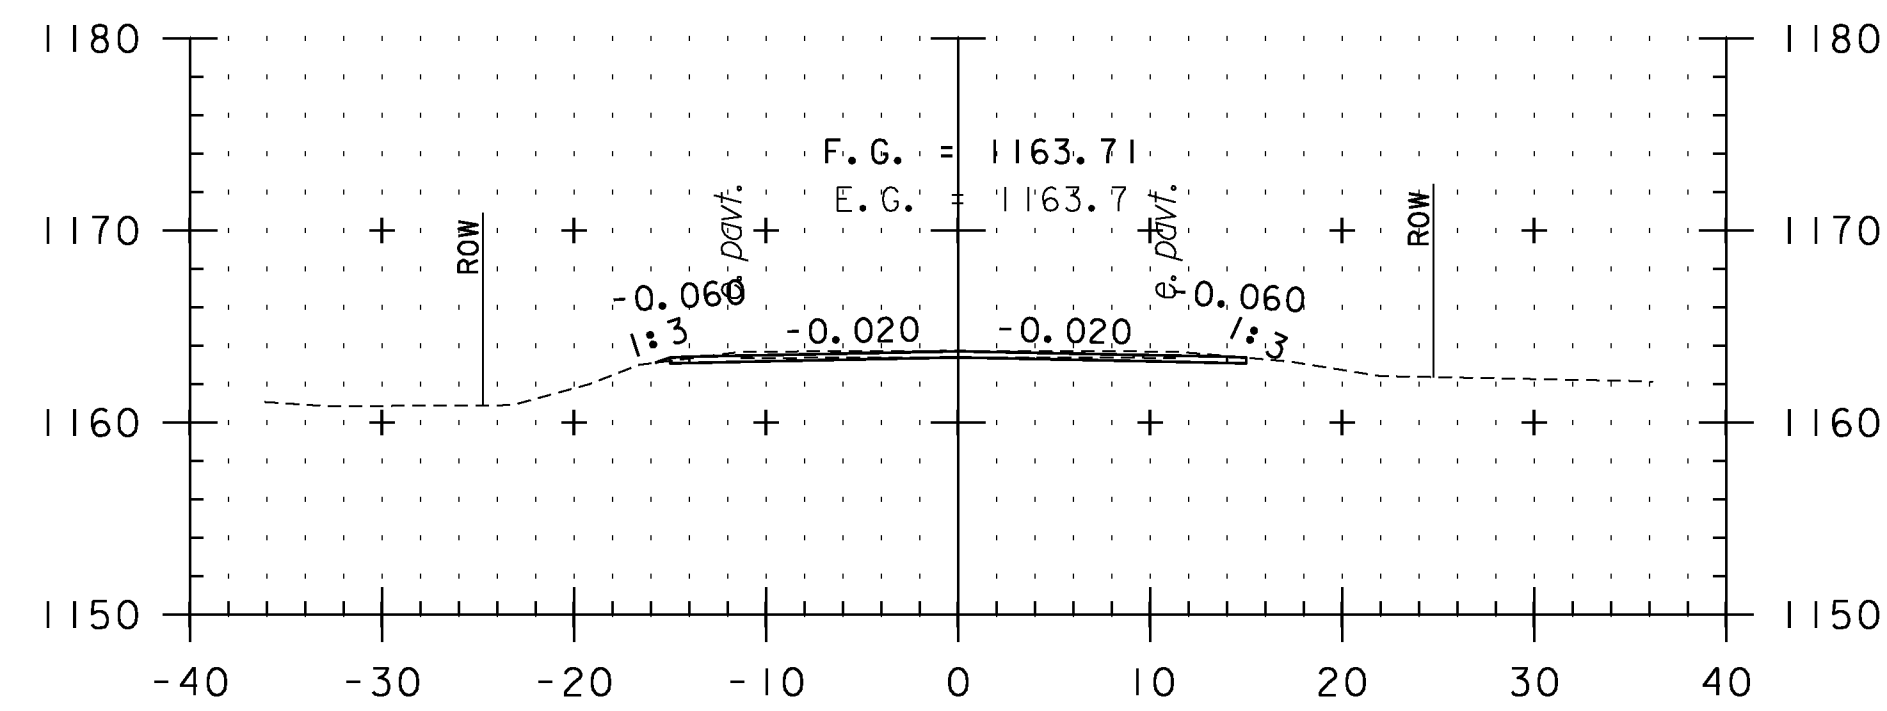


200+50

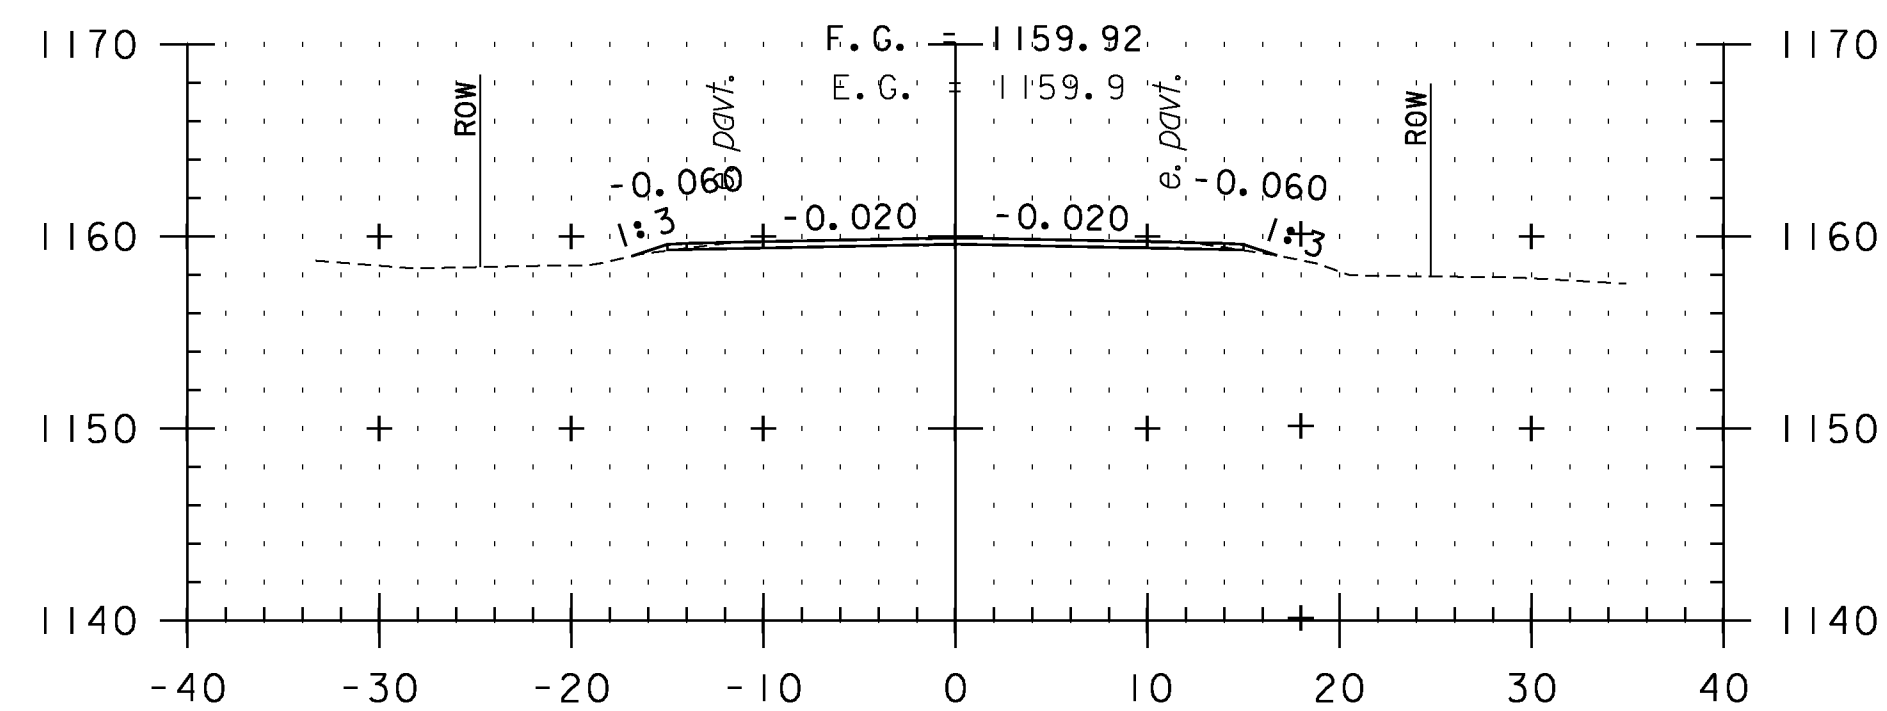


202+00

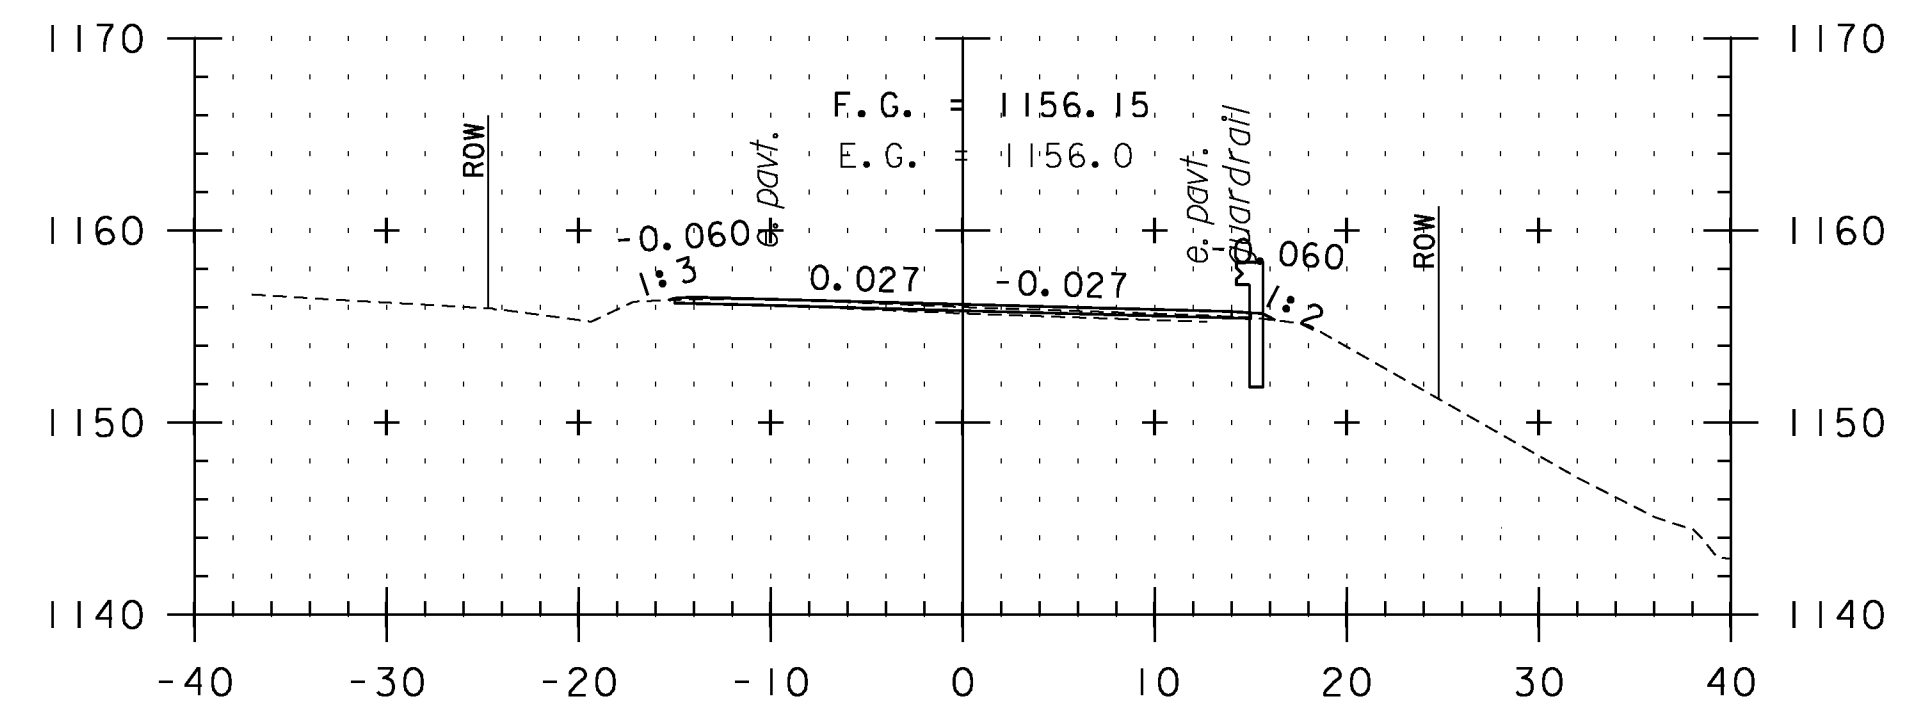


203+50

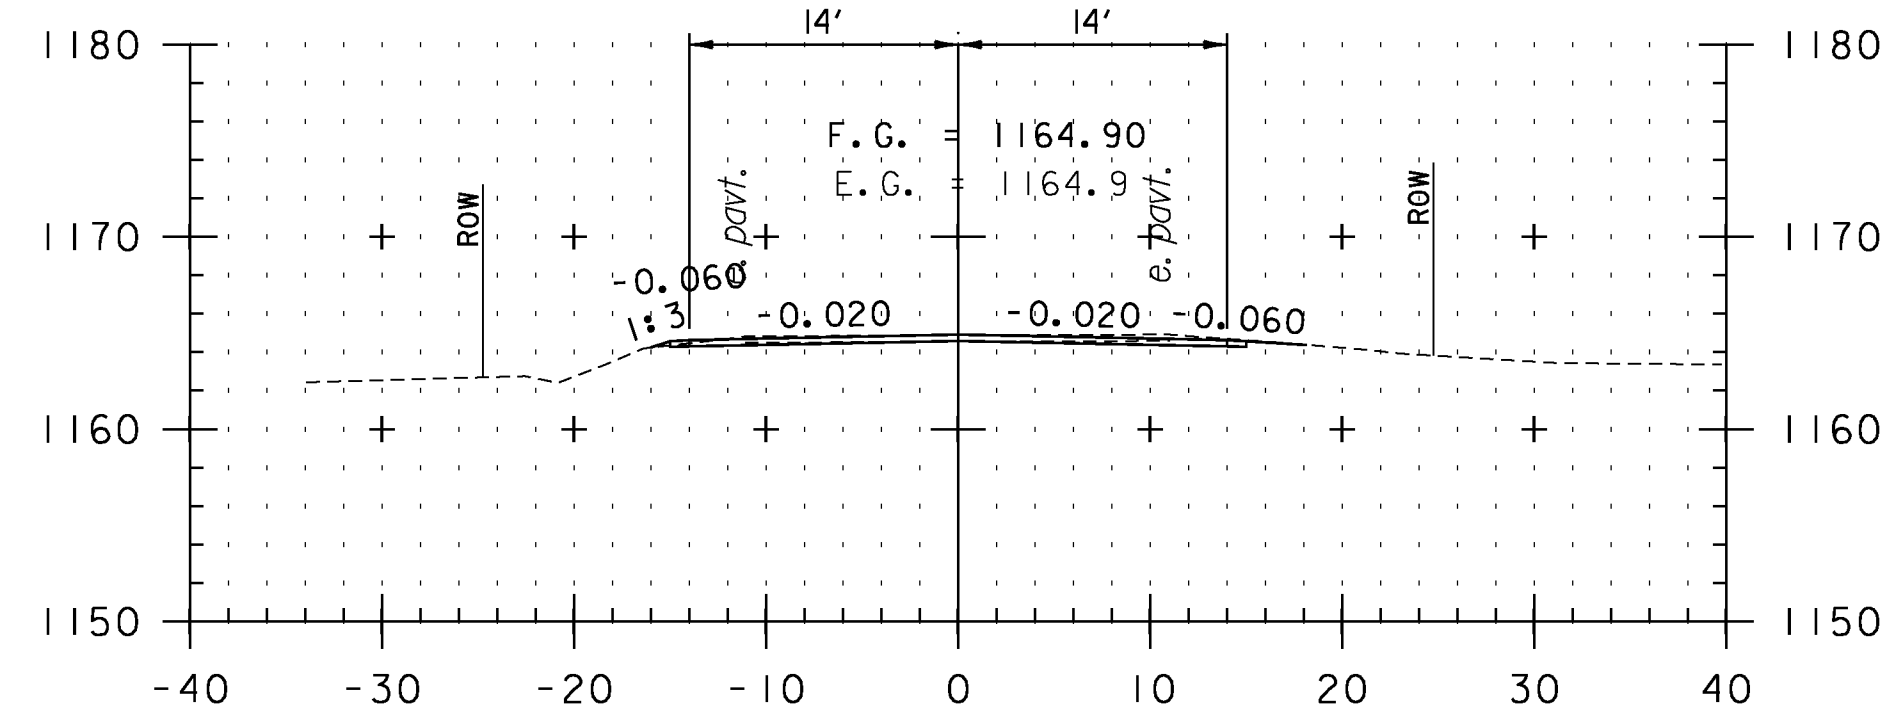

200+00

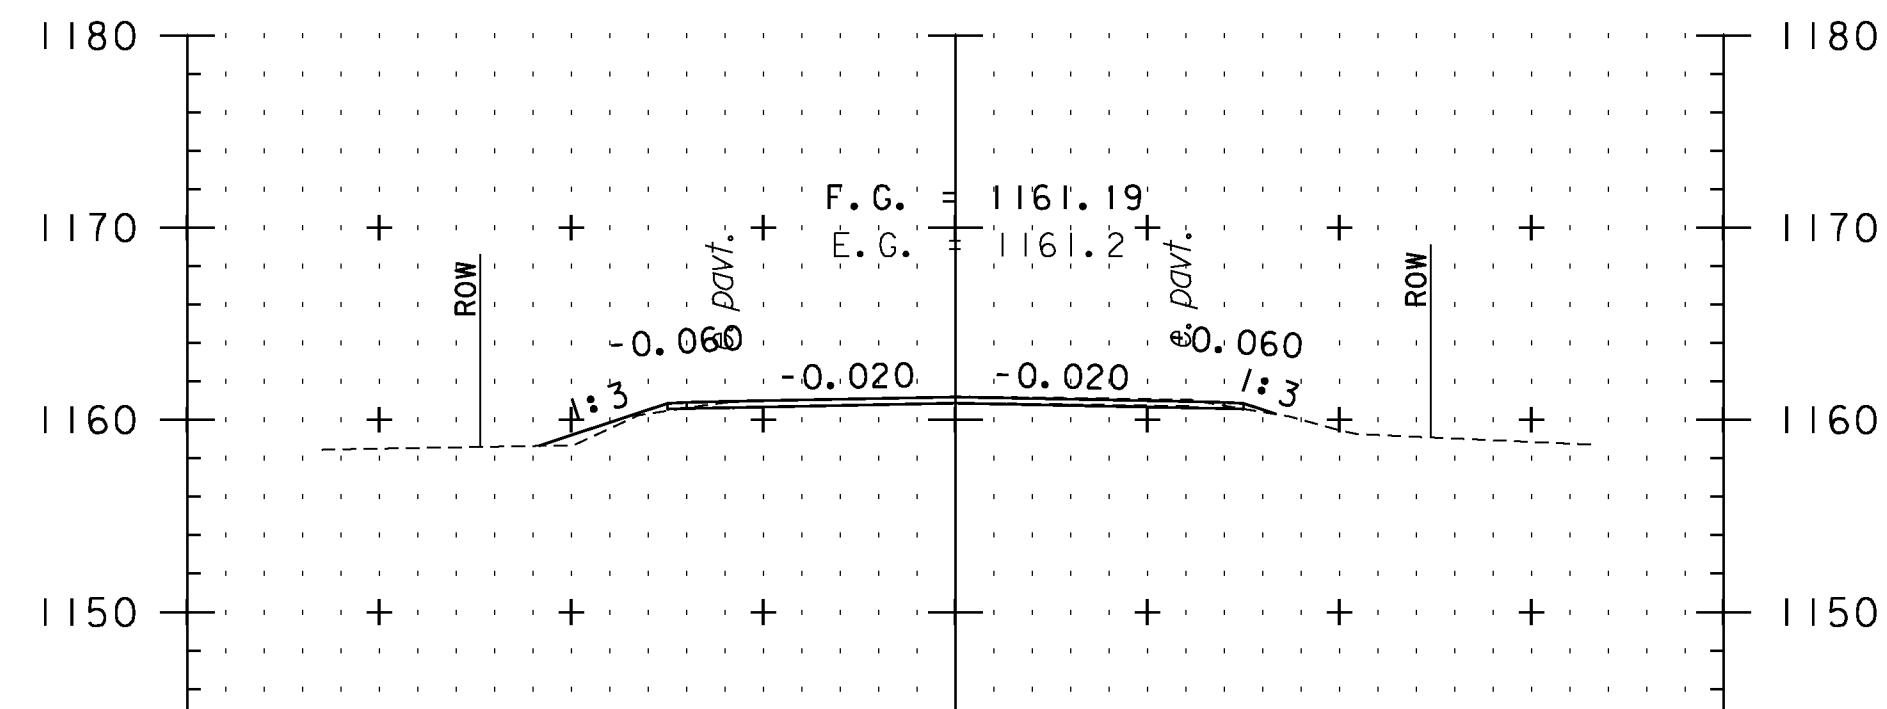


201+50

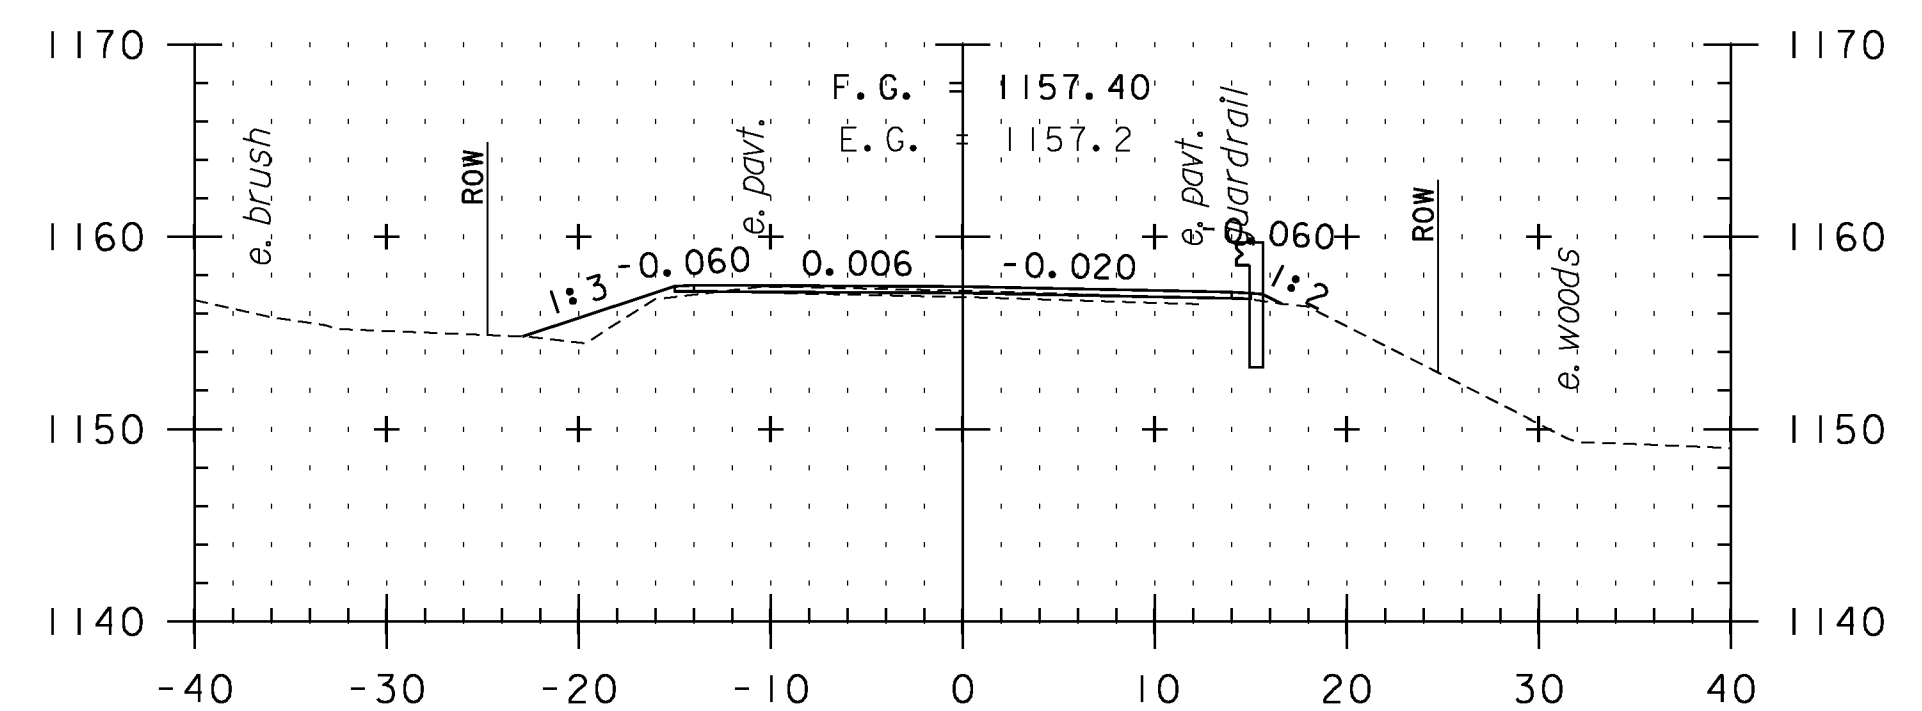

203+00

CROSS SECTION SHEET 4

STA. 200+00 TO STA. 204+00

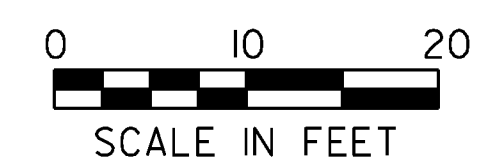

PROJECT NAME: VERSHIRE-THETFORD	PLOT DATE: 1/29/2013
PROJECT NUMBER: STP 2911(I)	DRAWN BY: SNG
FILE NAME: pl0c224.dgn	CHECKED BY: PTS
PROJECT LEADER: PTS	SHEET 12 OF 232
DESIGNED BY: NLL	
IPARM FILE NAME: IOC224.II2	