




205+50

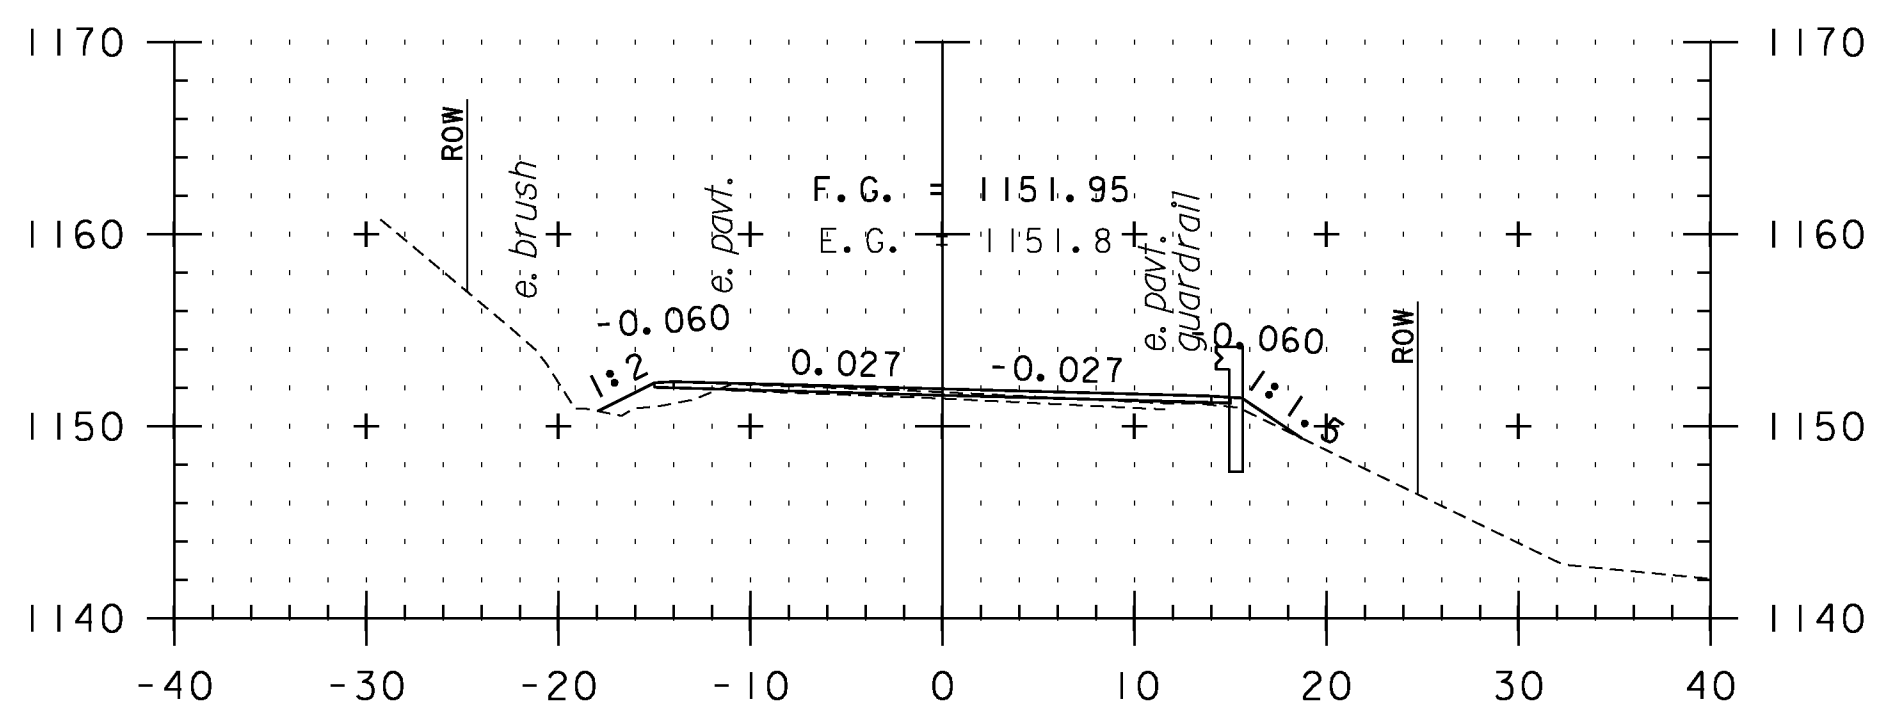


207+00

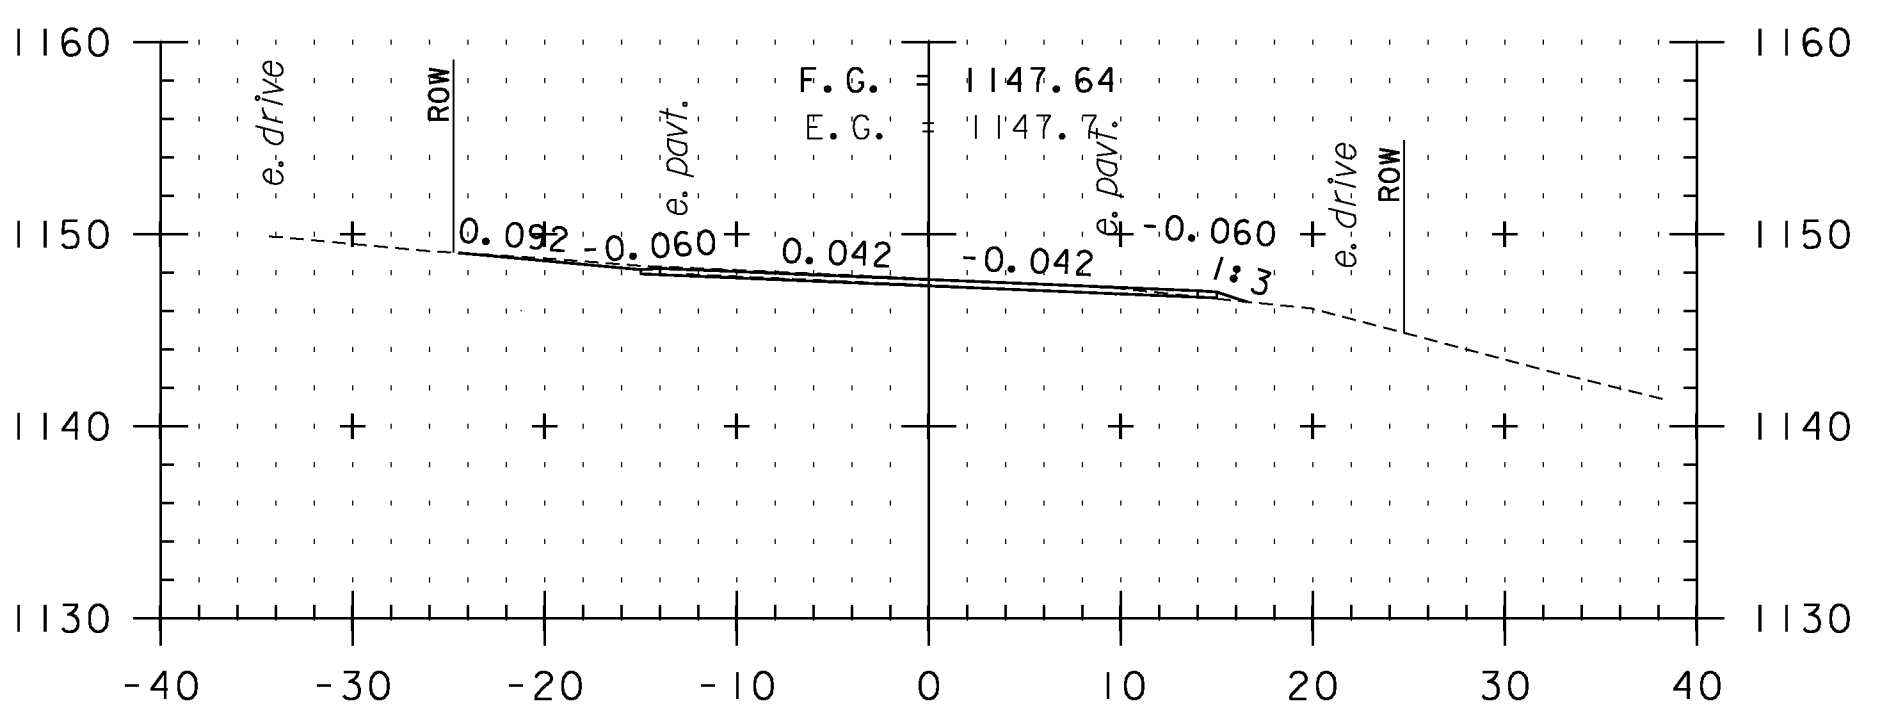


208+50

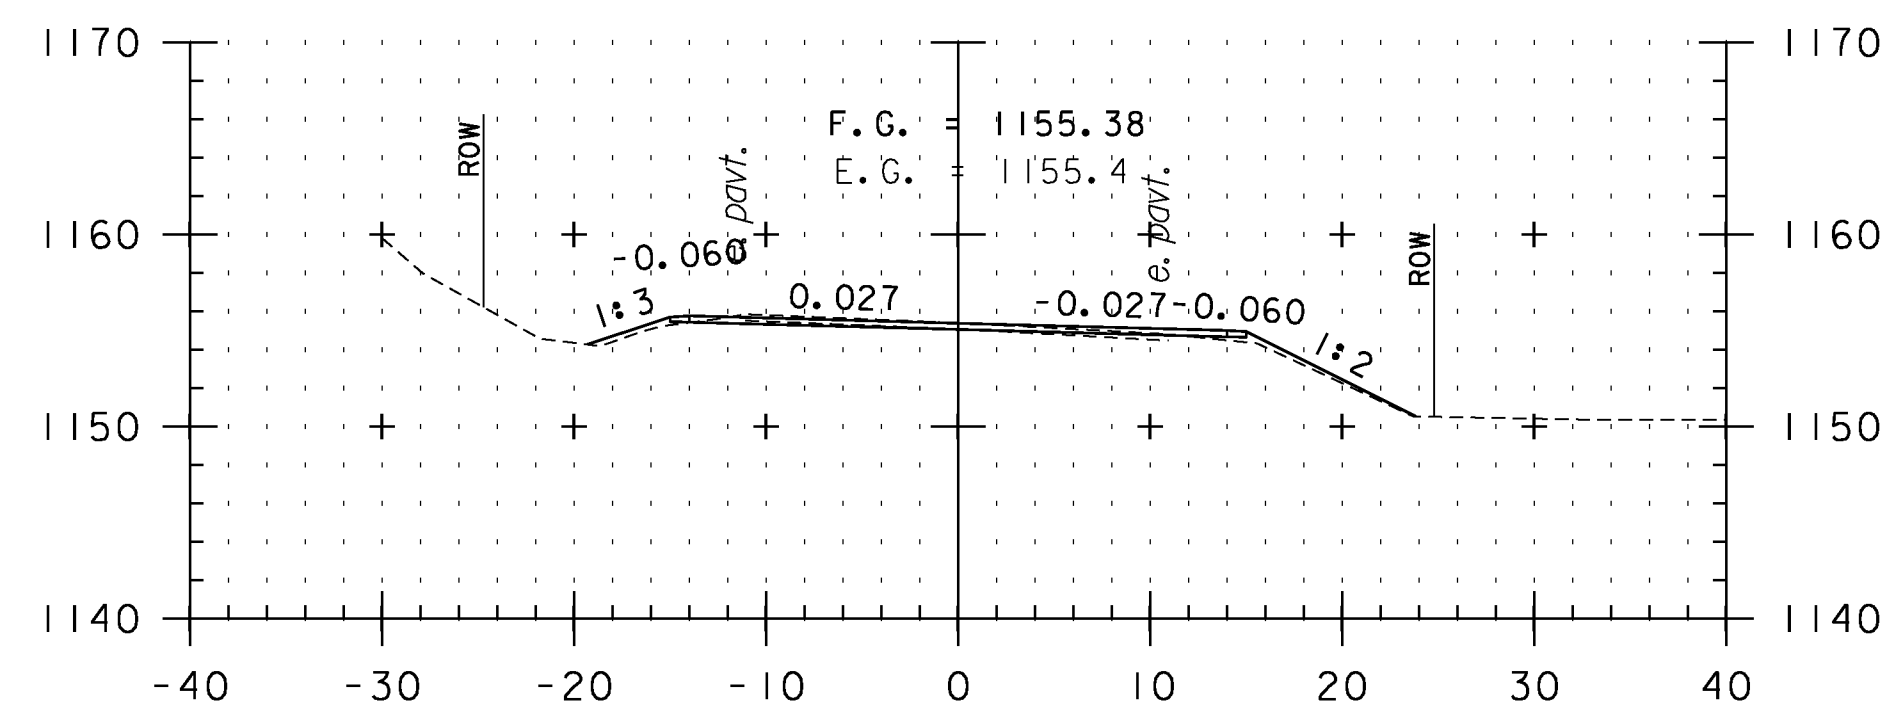


205+00

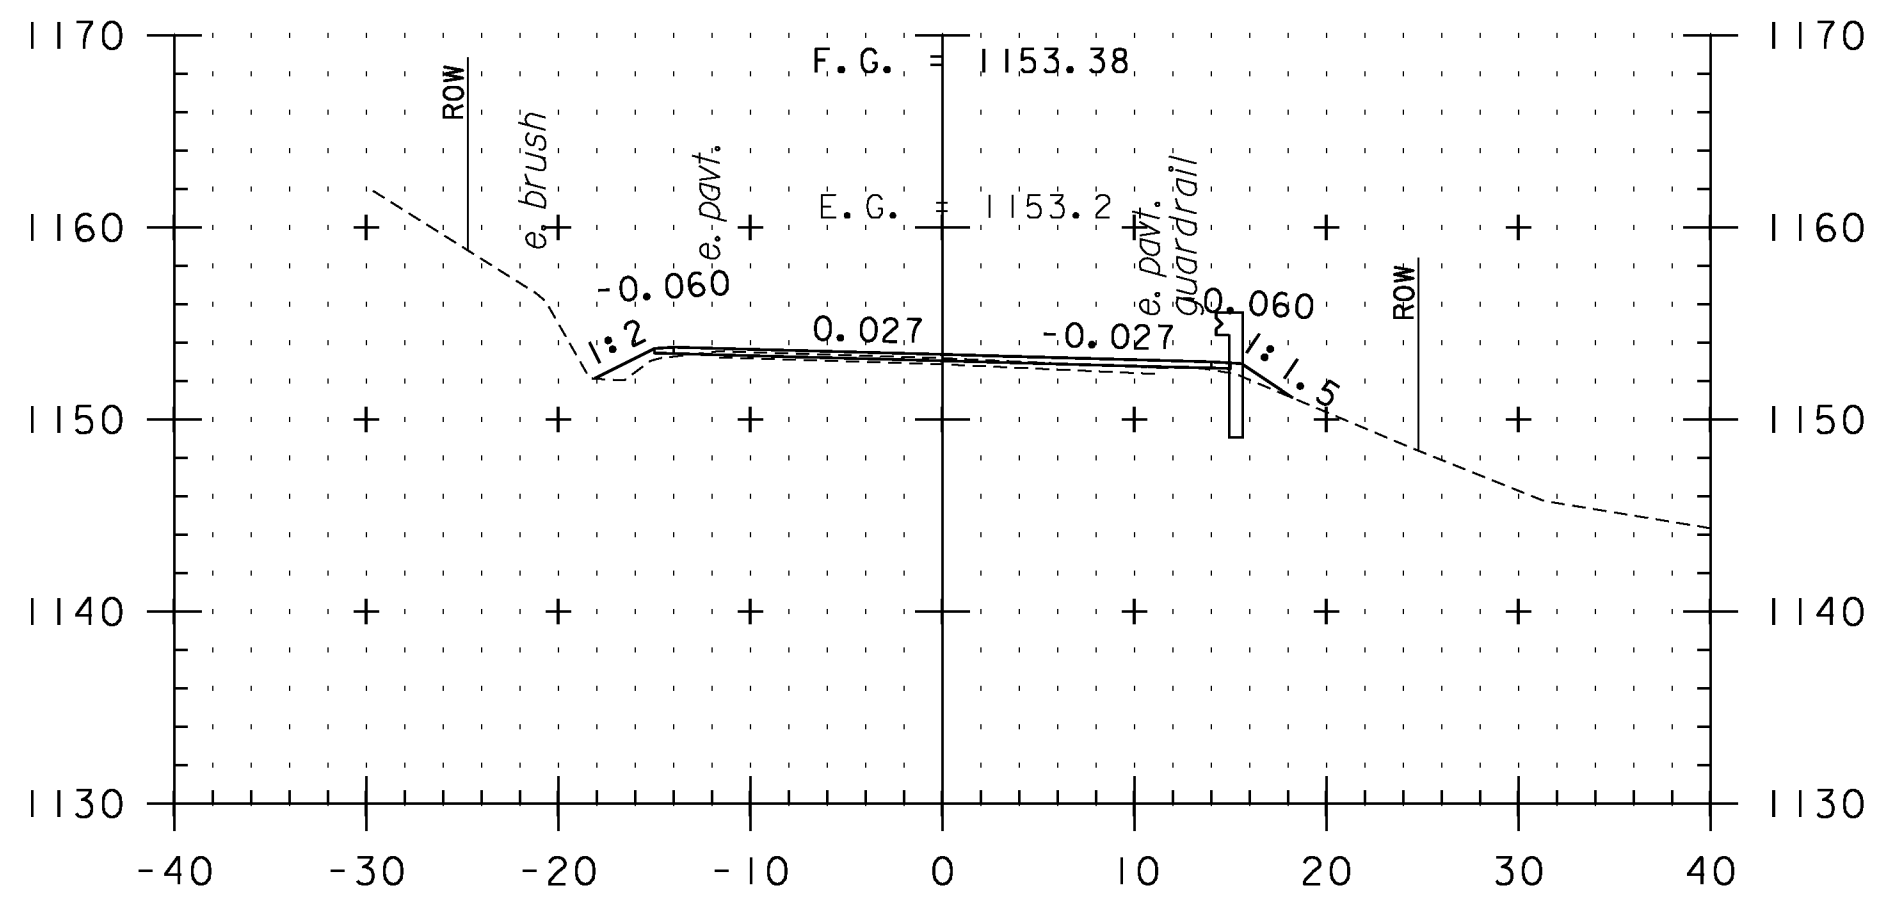


206+50

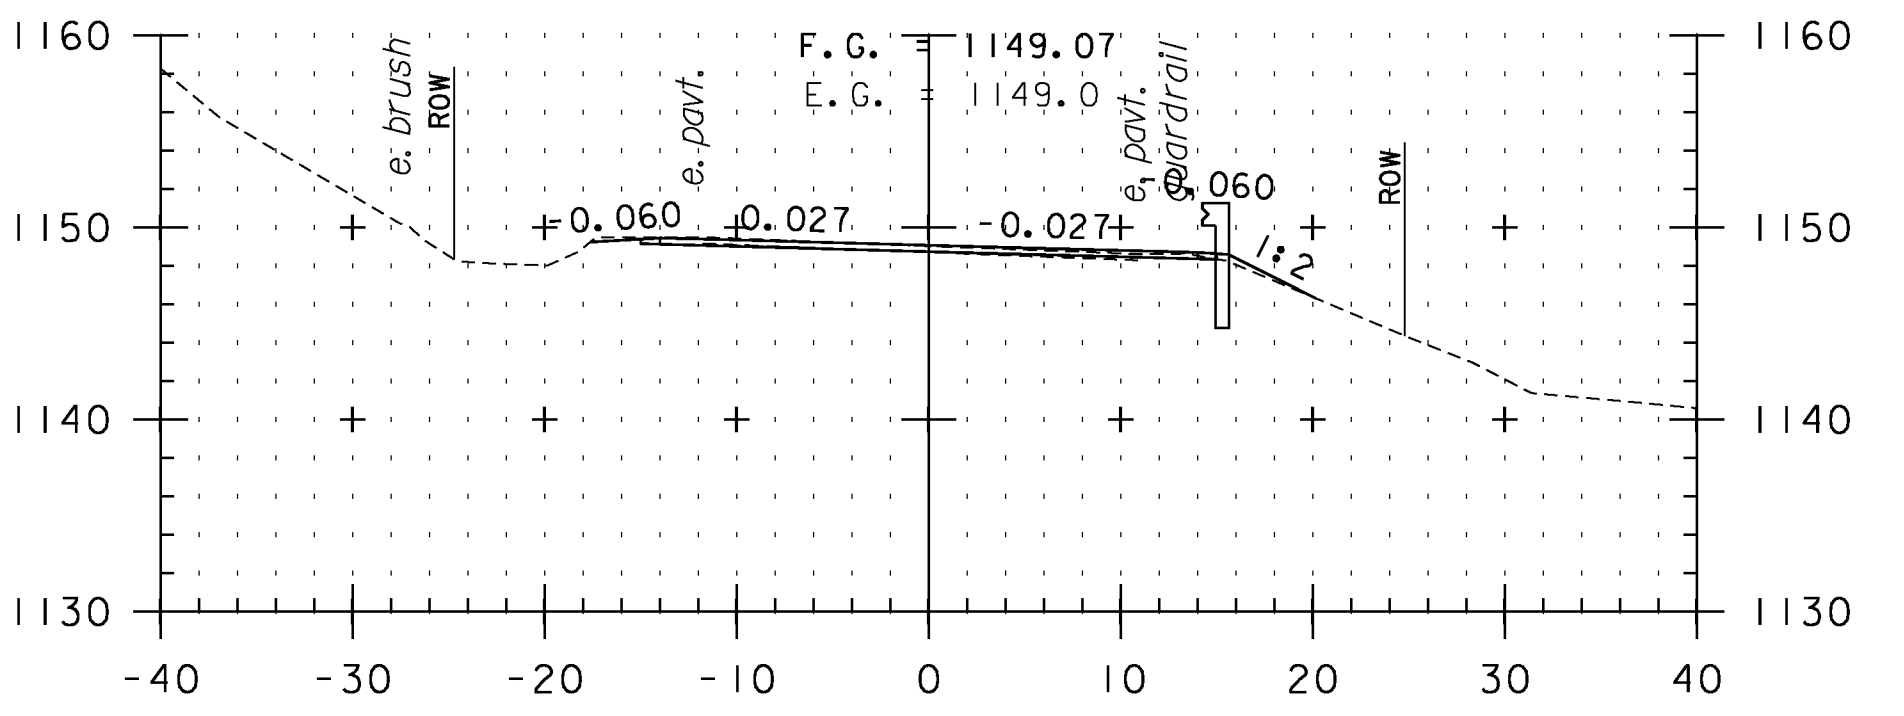


208+00

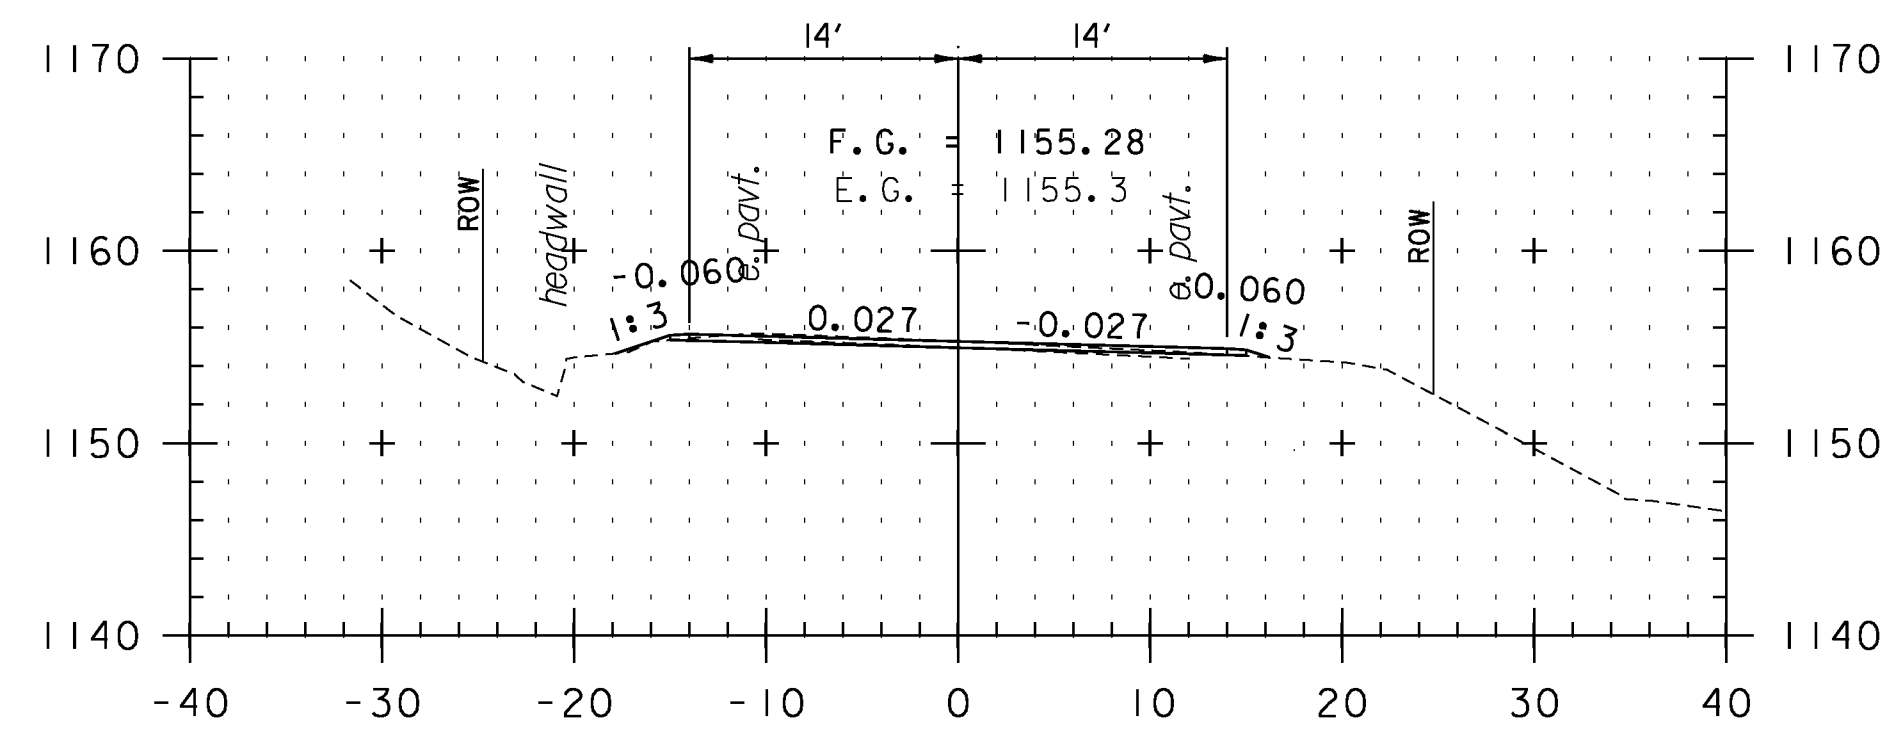

204+50

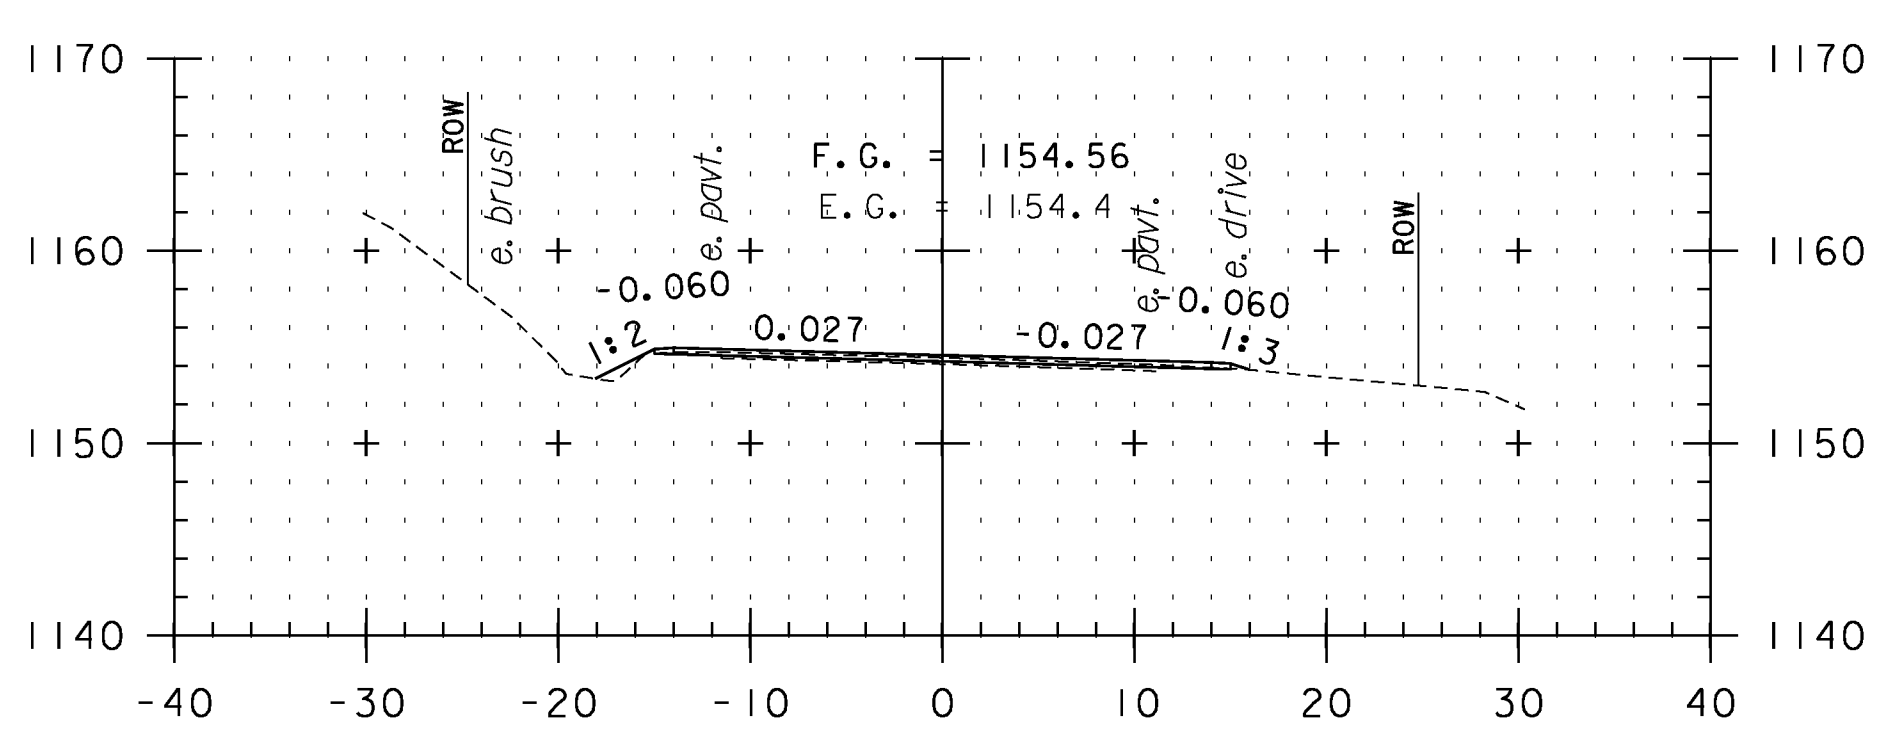


206+00

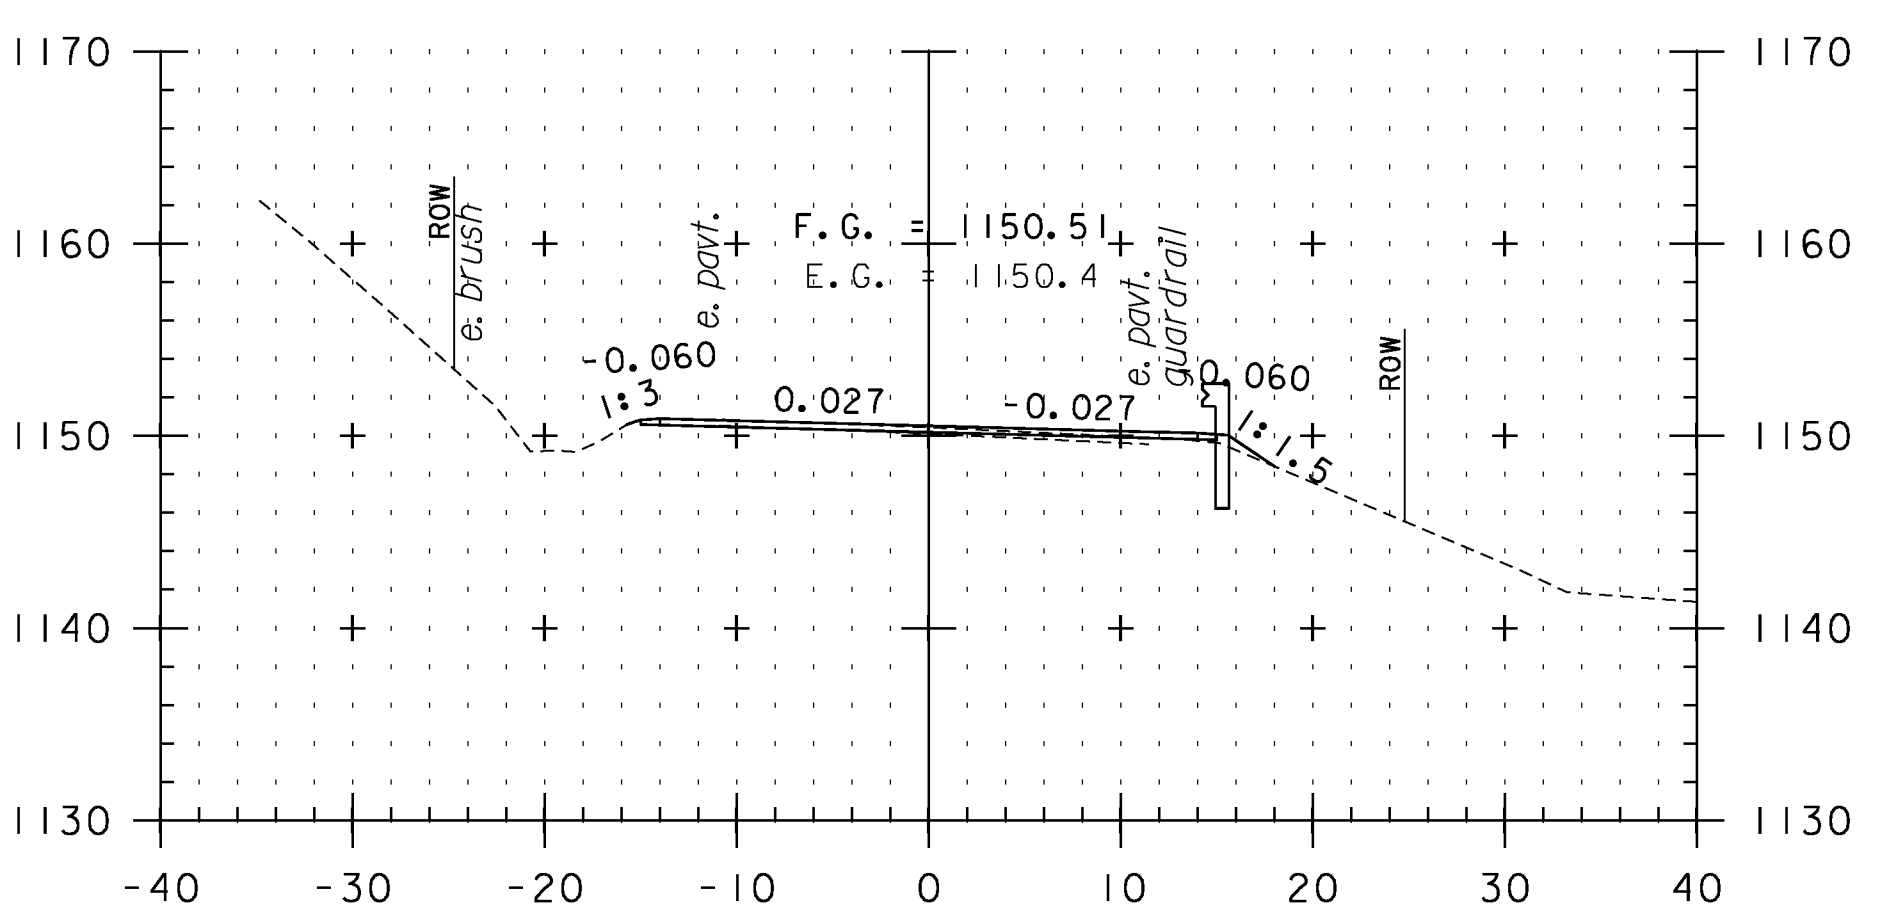

207+50

CROSS SECTION SHEET 5

STA. 204+50 TO STA. 208+50

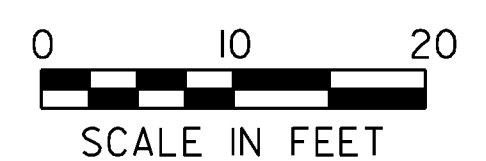

PROJECT NAME: VERSHIRE-THETFORD	PLOT DATE: 1/29/2013
PROJECT NUMBER: STP 2911(I)	DRAWN BY: SNG
FILE NAME: pl0c224.dgn	CHECKED BY: PTS
PROJECT LEADER: PTS	SHEET 113 OF 232
DESIGNED BY: NLL	
IPARM FILE NAME: IOC224.I13	