




210+00

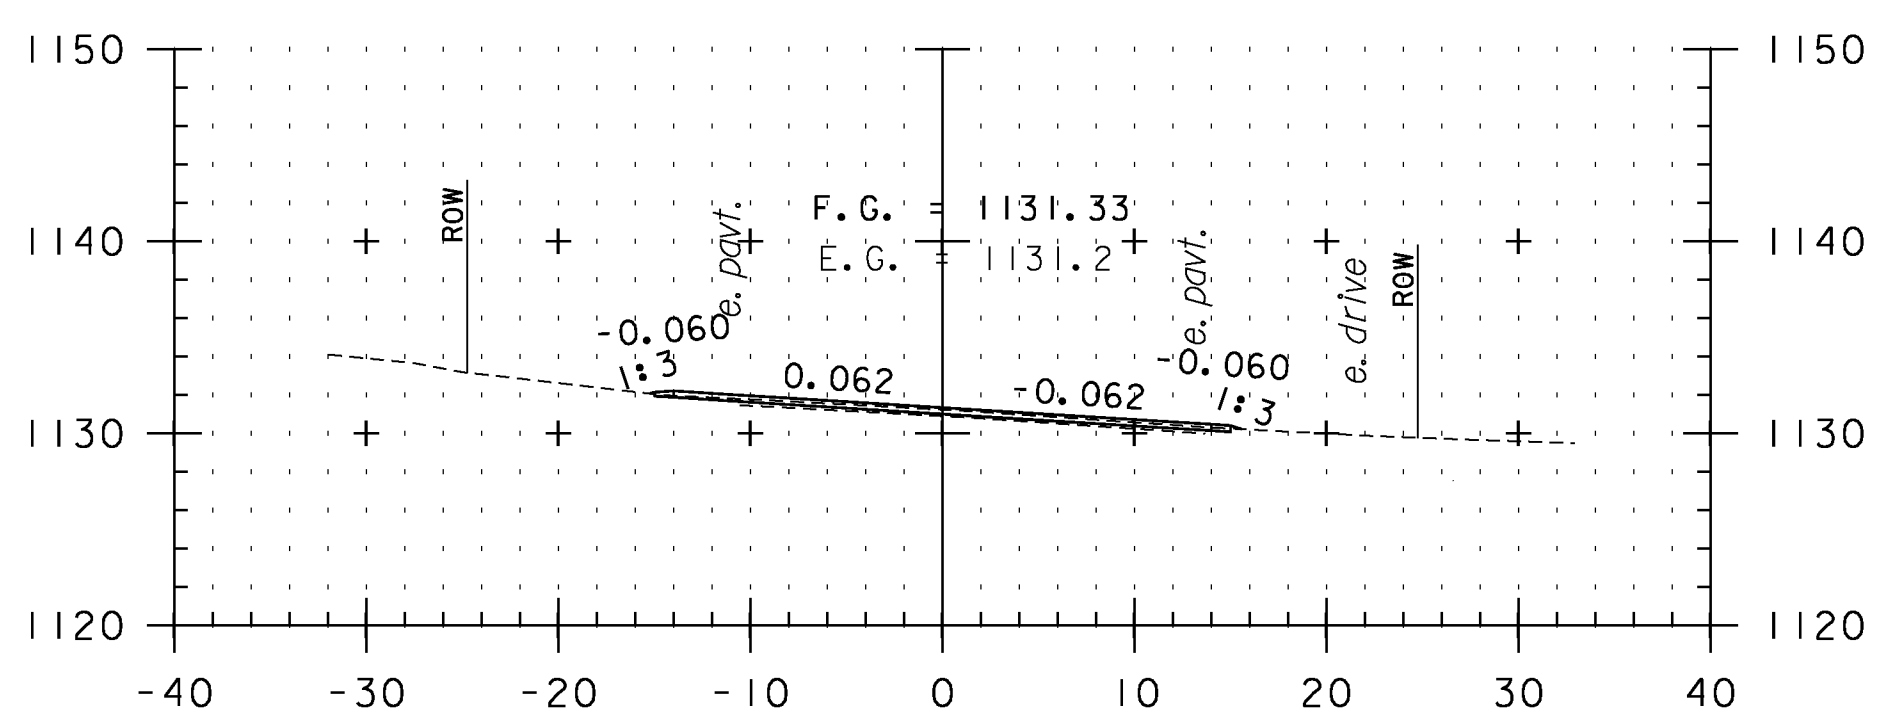


211+50

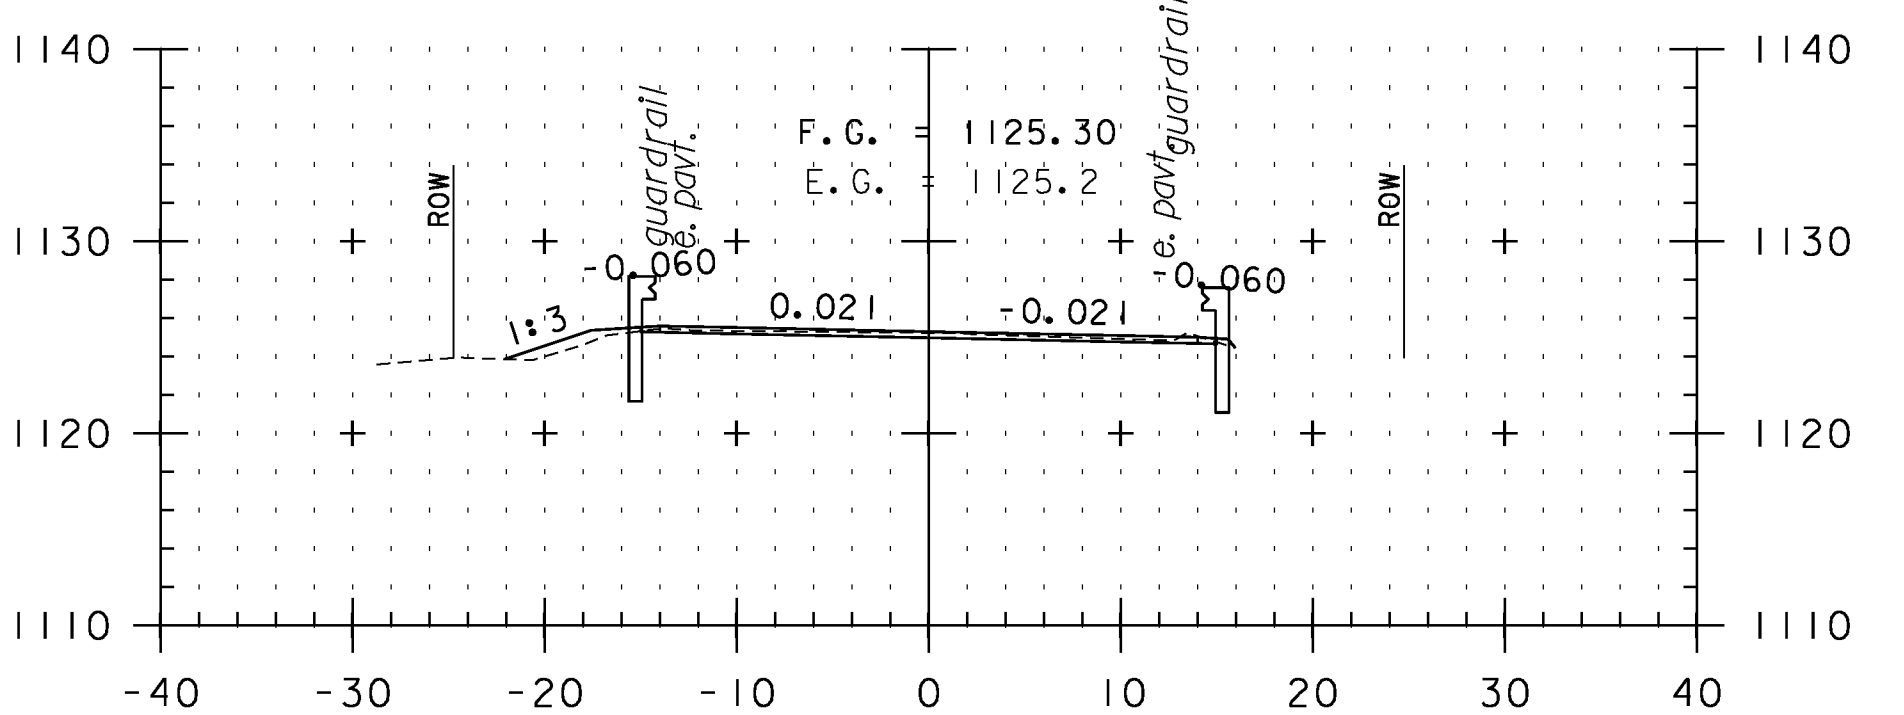


212+74  
BEGIN BRIDGE II APPROACH

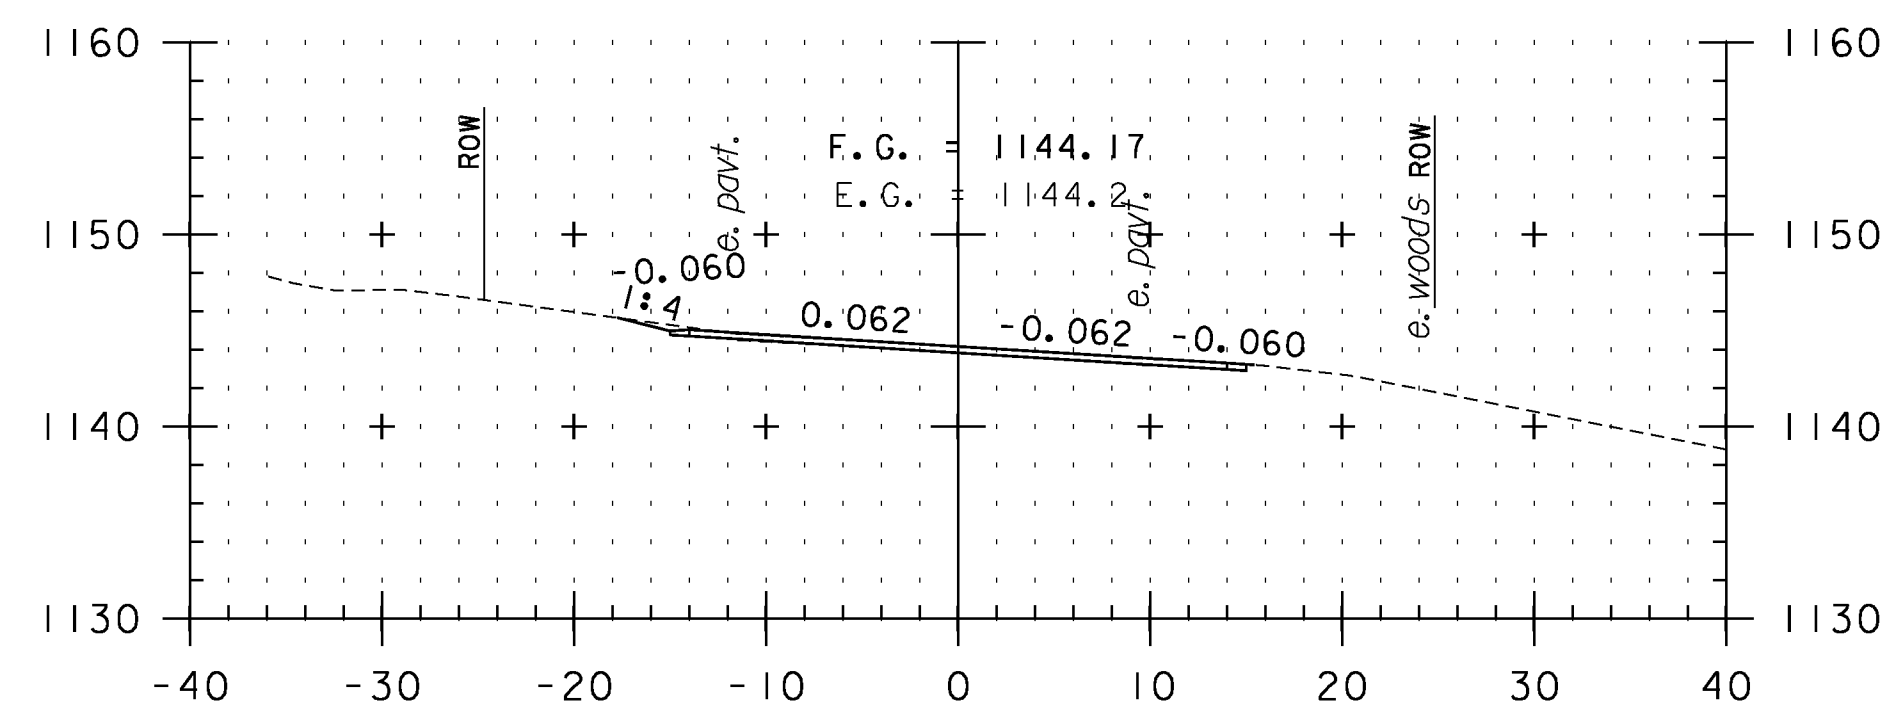


209+50

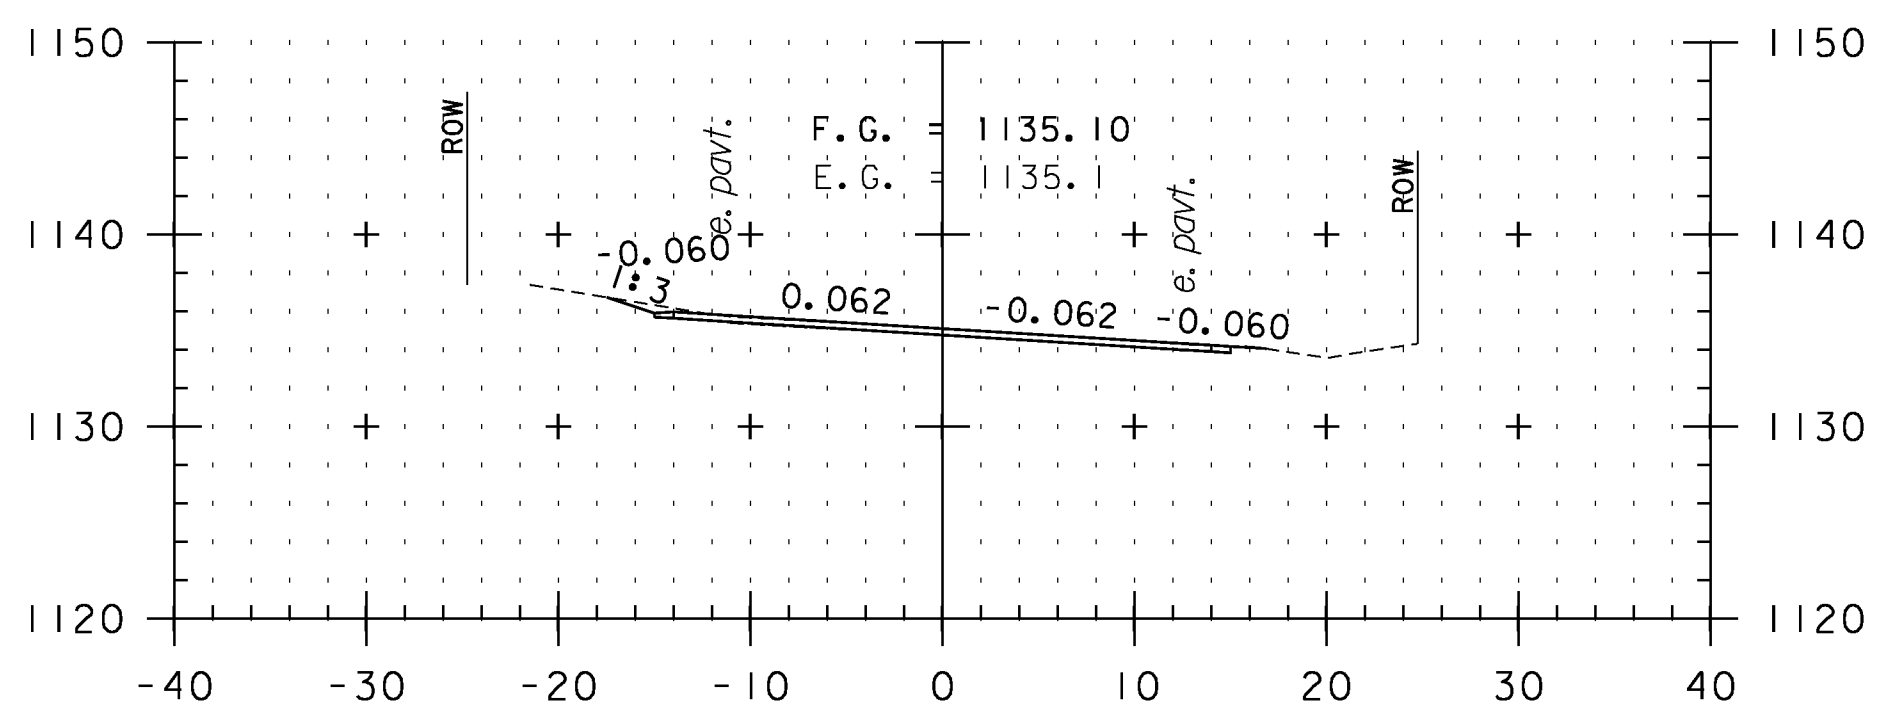


211+00

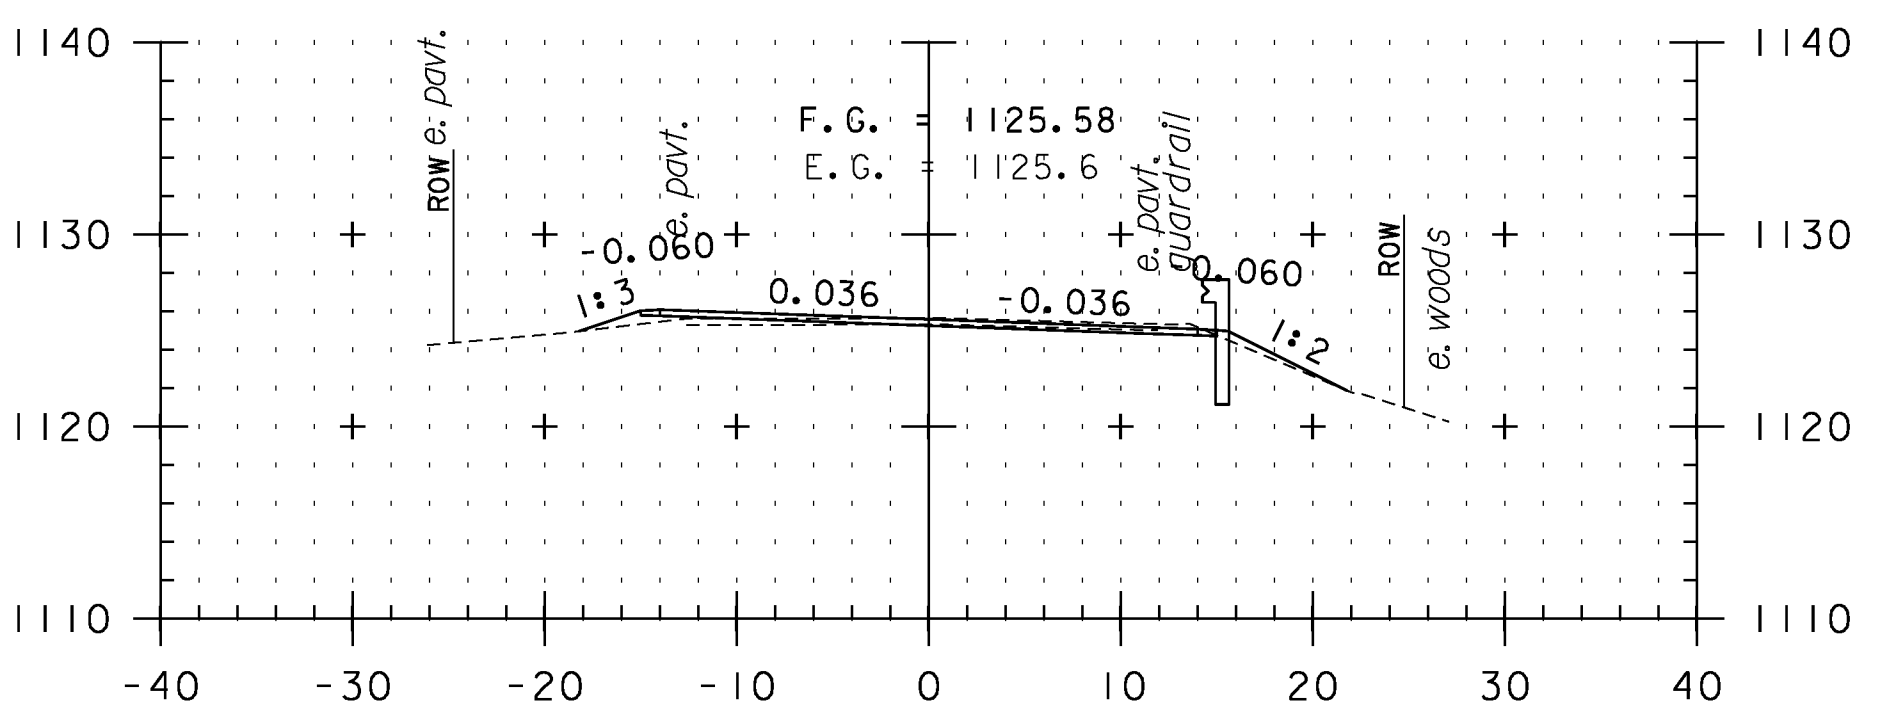


212+50

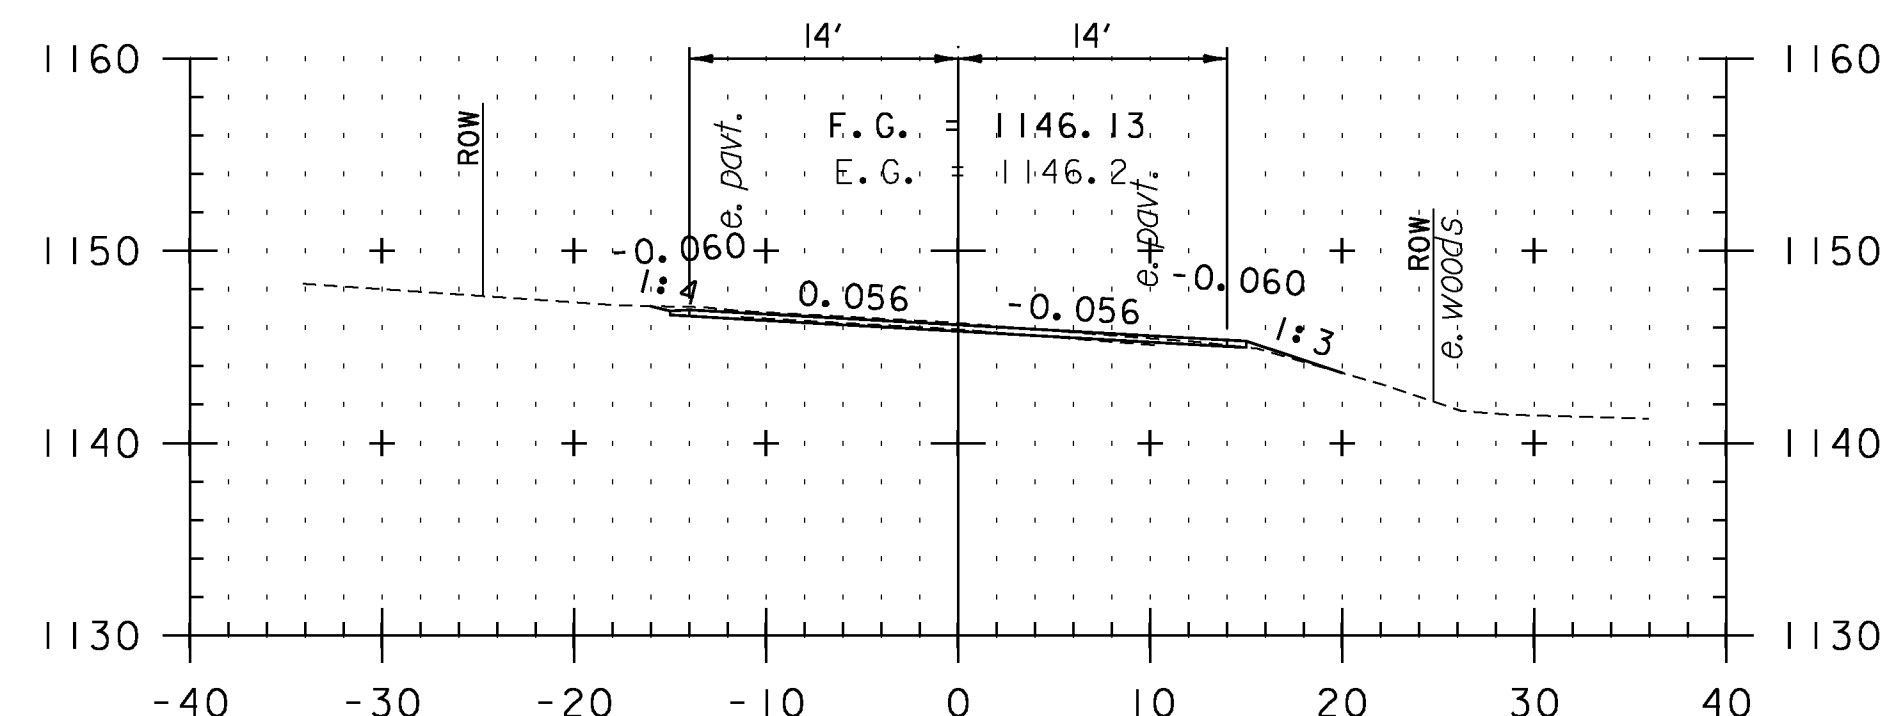

209+00

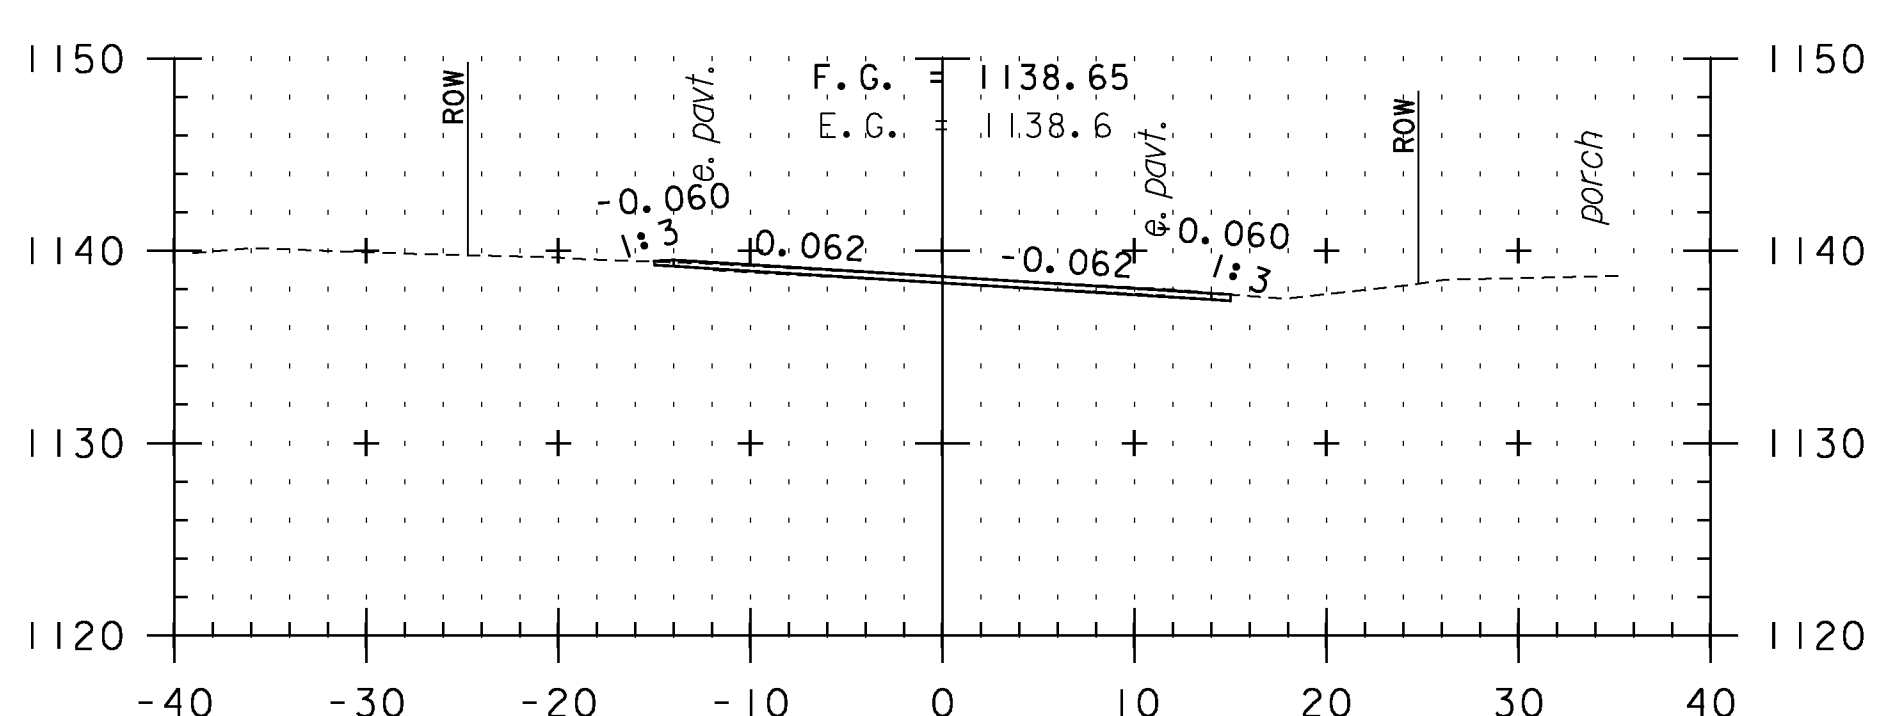


210+50

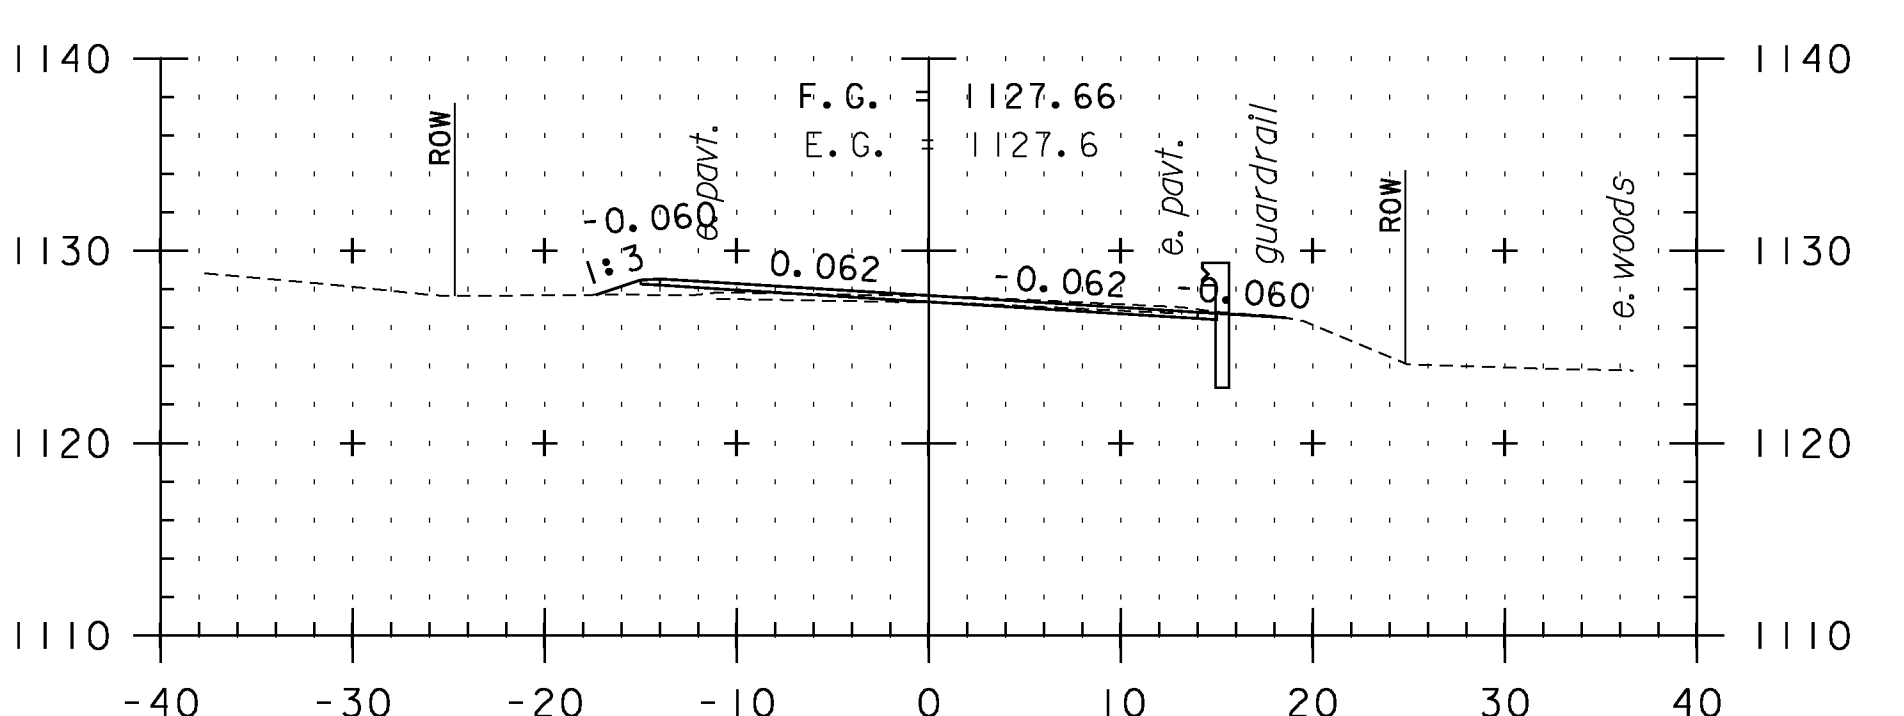

212+00

**CROSS SECTION SHEET 6**

STA. 209+00 TO STA. 212+74

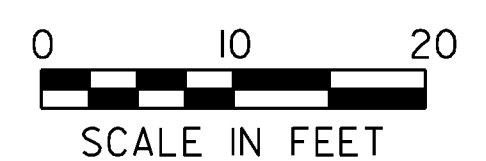

PROJECT NAME: VERSHIRE-THETFORD	PLOT DATE: 1/29/2013
PROJECT NUMBER: STP 2911(I)	DRAWN BY: SNG
FILE NAME: pl0c224.dgn	CHECKED BY: PTS
PROJECT LEADER: PTS	SHEET 114 OF 232
DESIGNED BY: NULL	
IPARM FILE NAME: IOC224_114	