




213+50

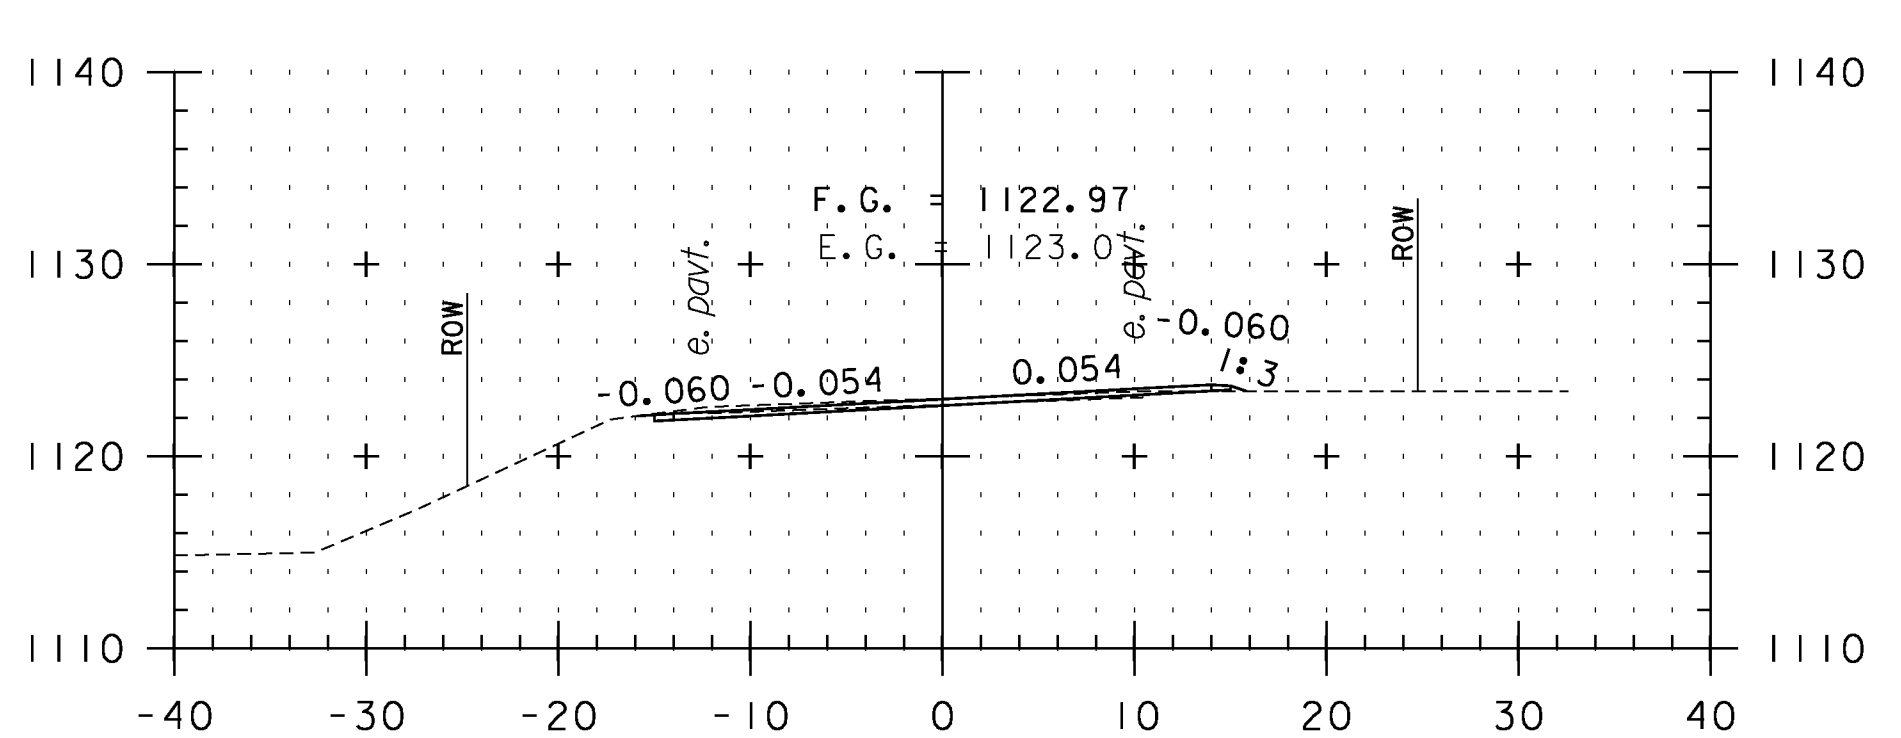


215+00

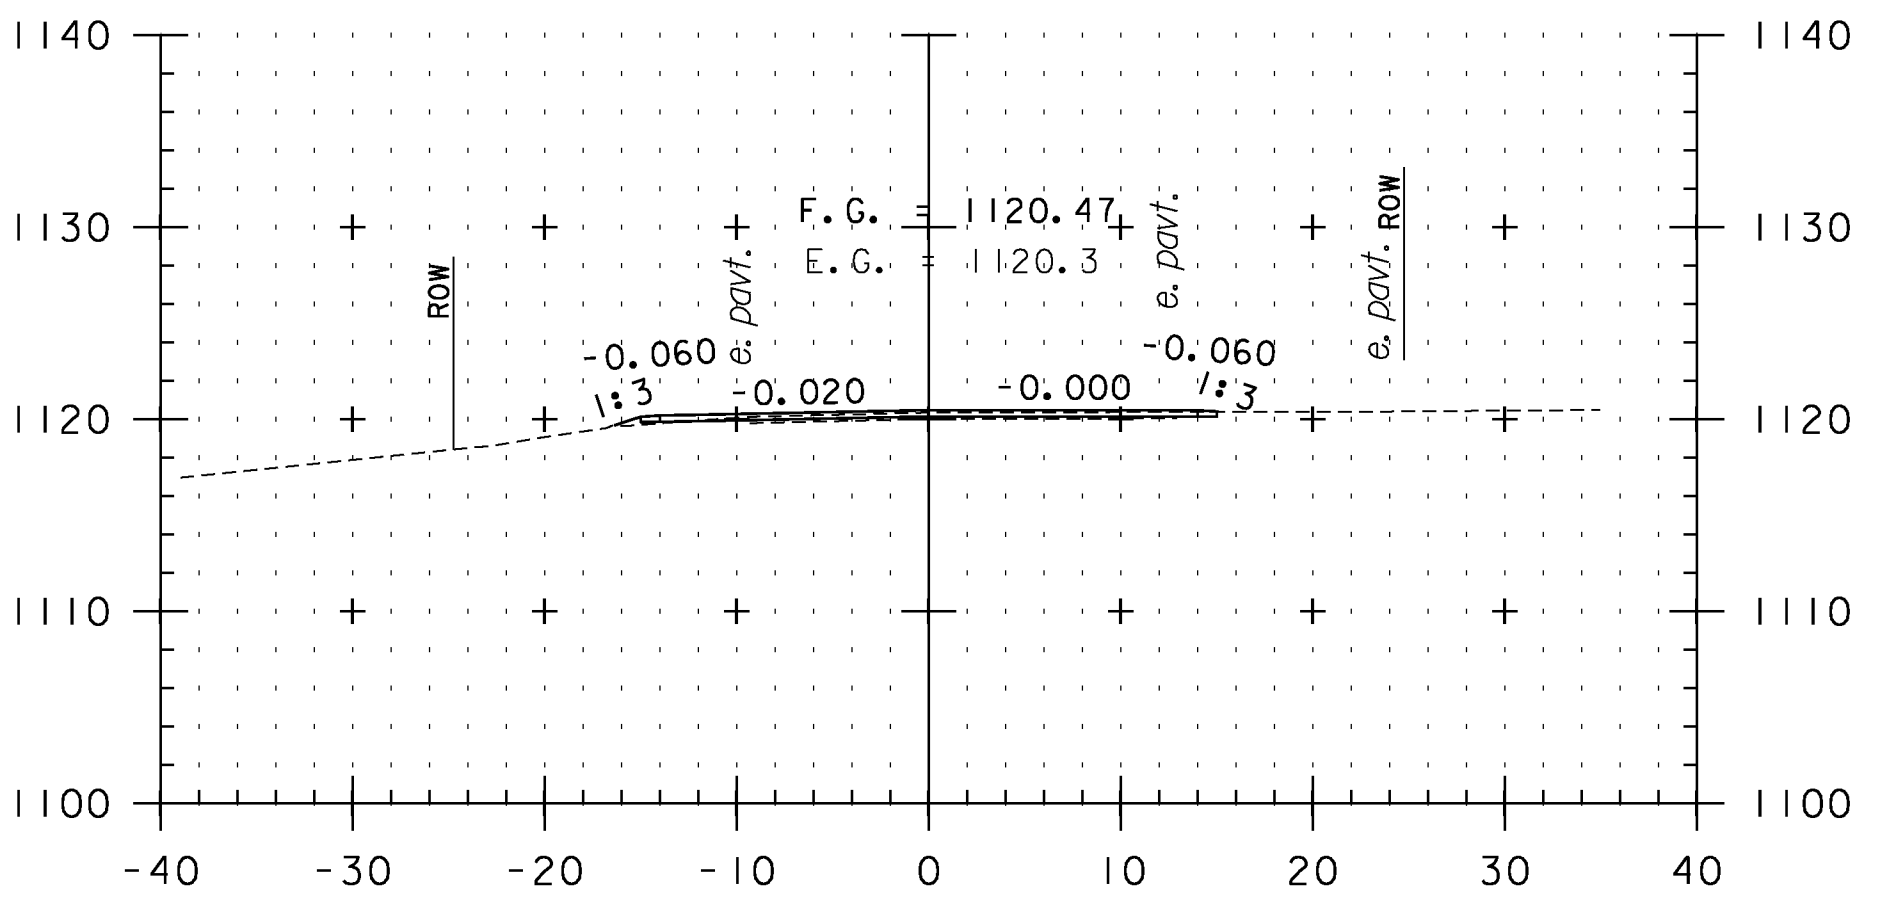


216+50

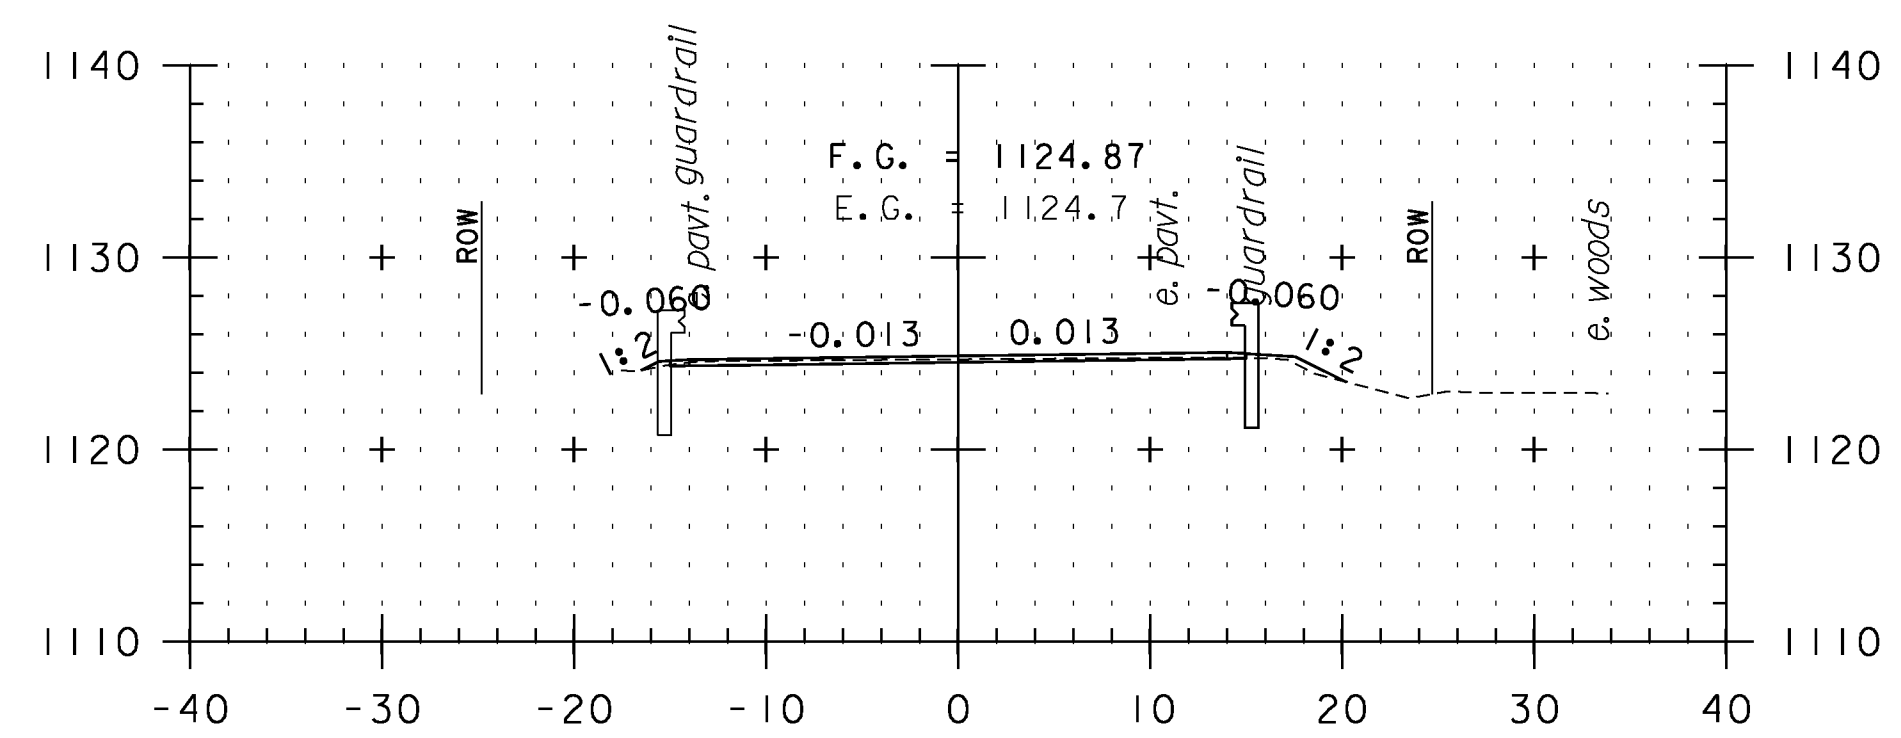


213+27
END BRIDGE II APPROACH

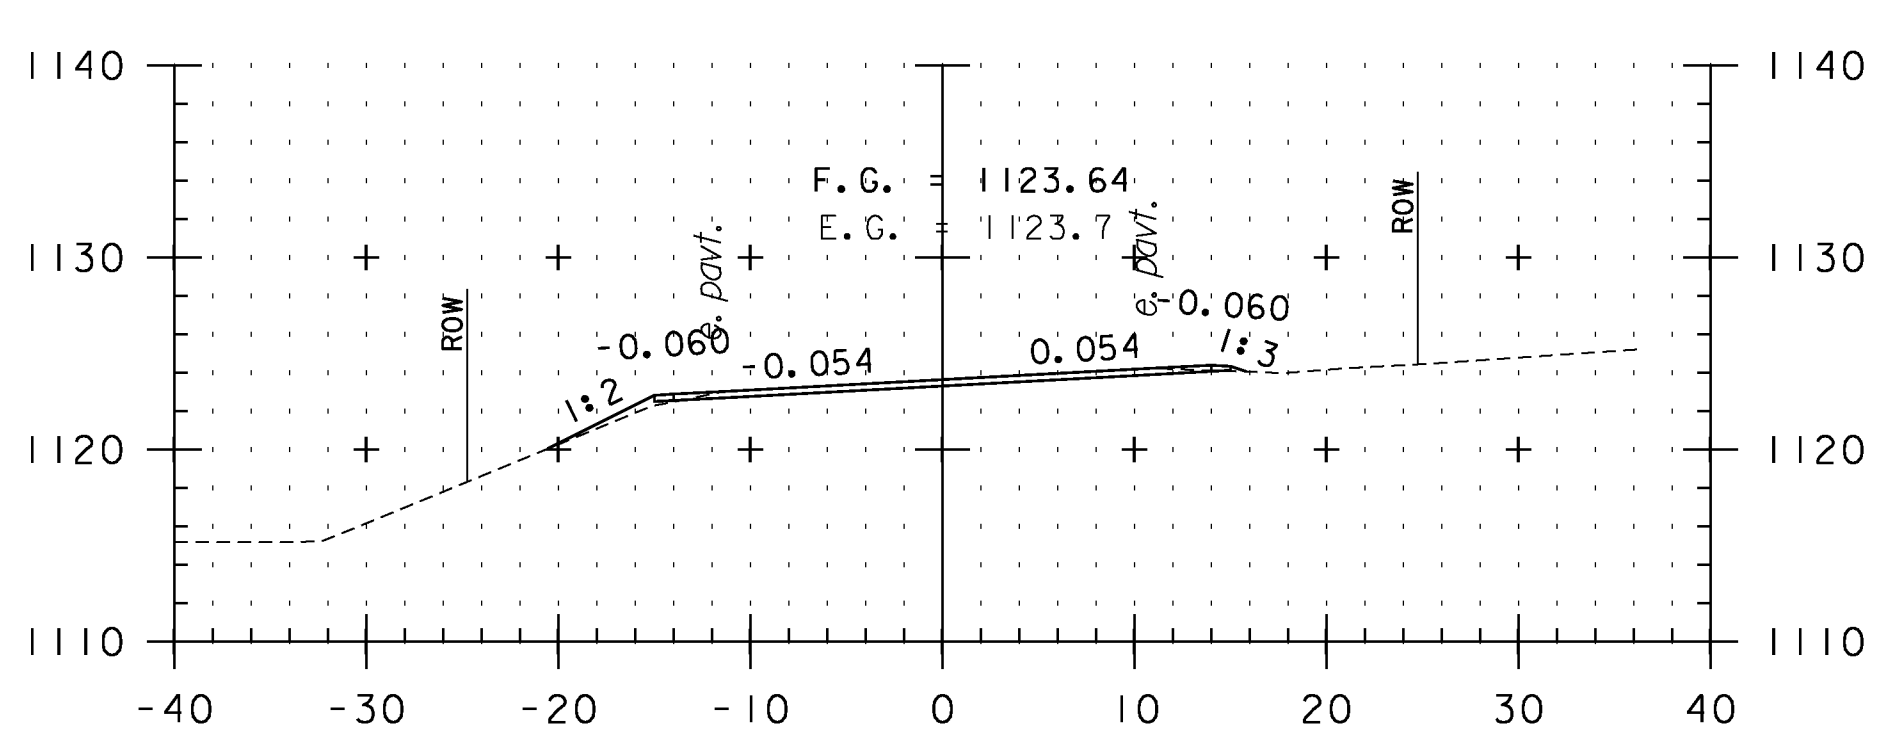


214+50

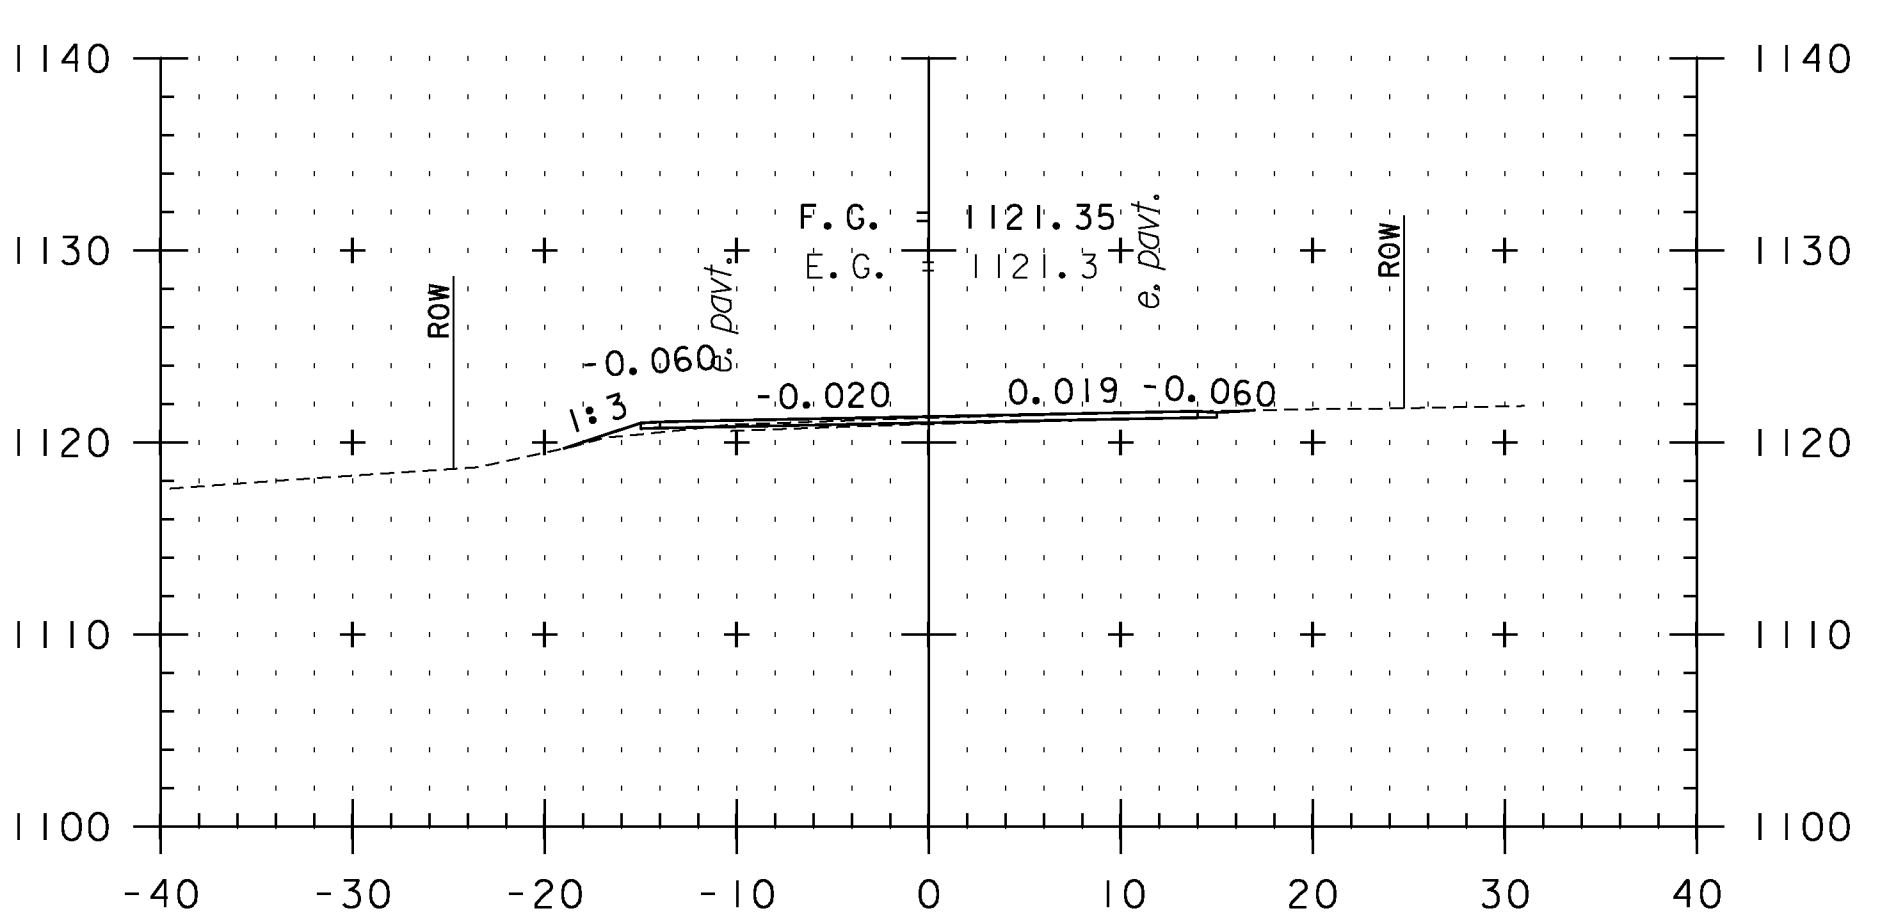


216+00

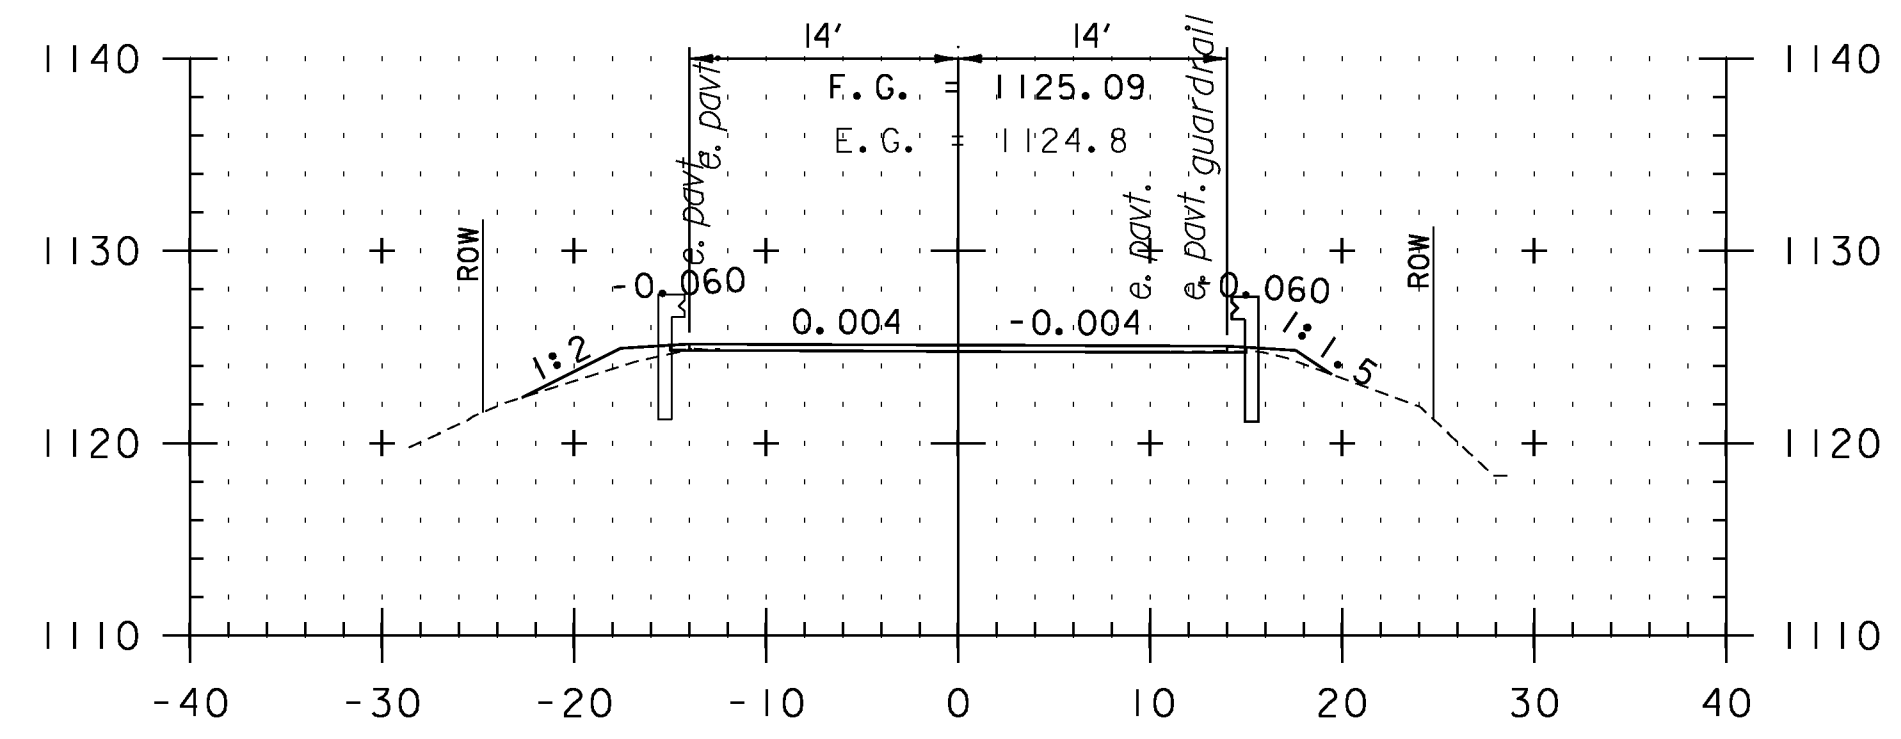

213+00

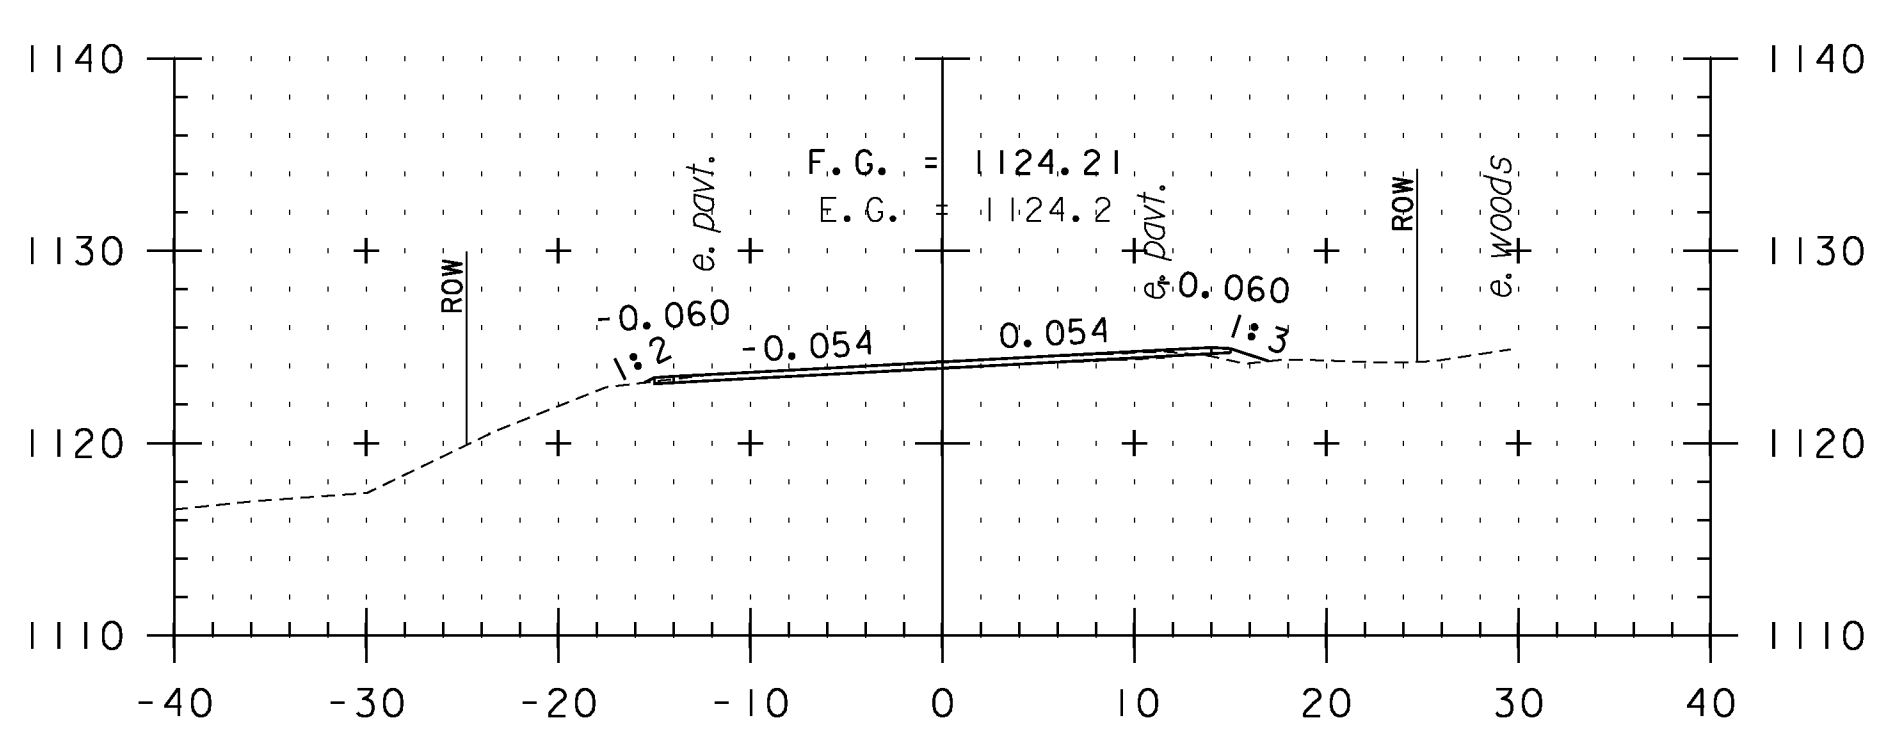


214+00

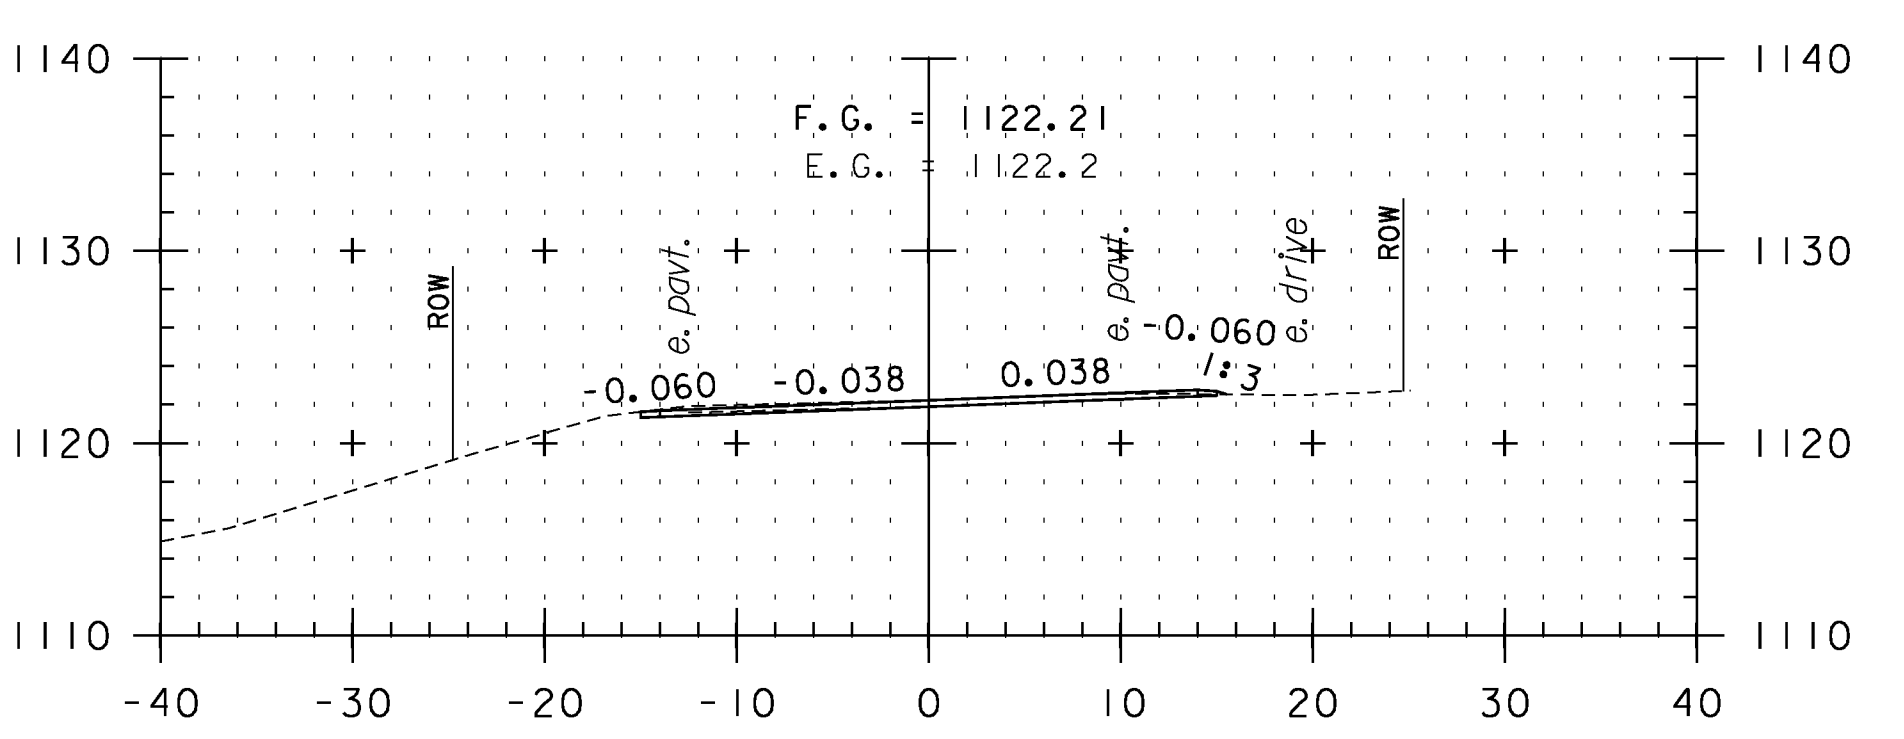

215+50

CROSS SECTION SHEET 7

STA. 213+00 TO STA. 216+50

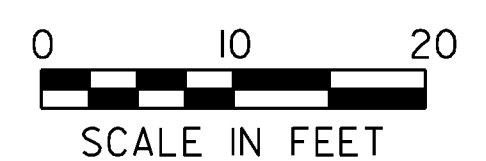

PROJECT NAME: VERSHIRE-THETFORD	PLOT DATE: 1/29/2013
PROJECT NUMBER: STP 2911(I)	DRAWN BY: SNG
FILE NAME: pl0c224.dgn	CHECKED BY: PTS
PROJECT LEADER: PTS	SHEET 115 OF 232
DESIGNED BY: NLL	
IPARM FILE NAME: IOC224_115	