




218+00

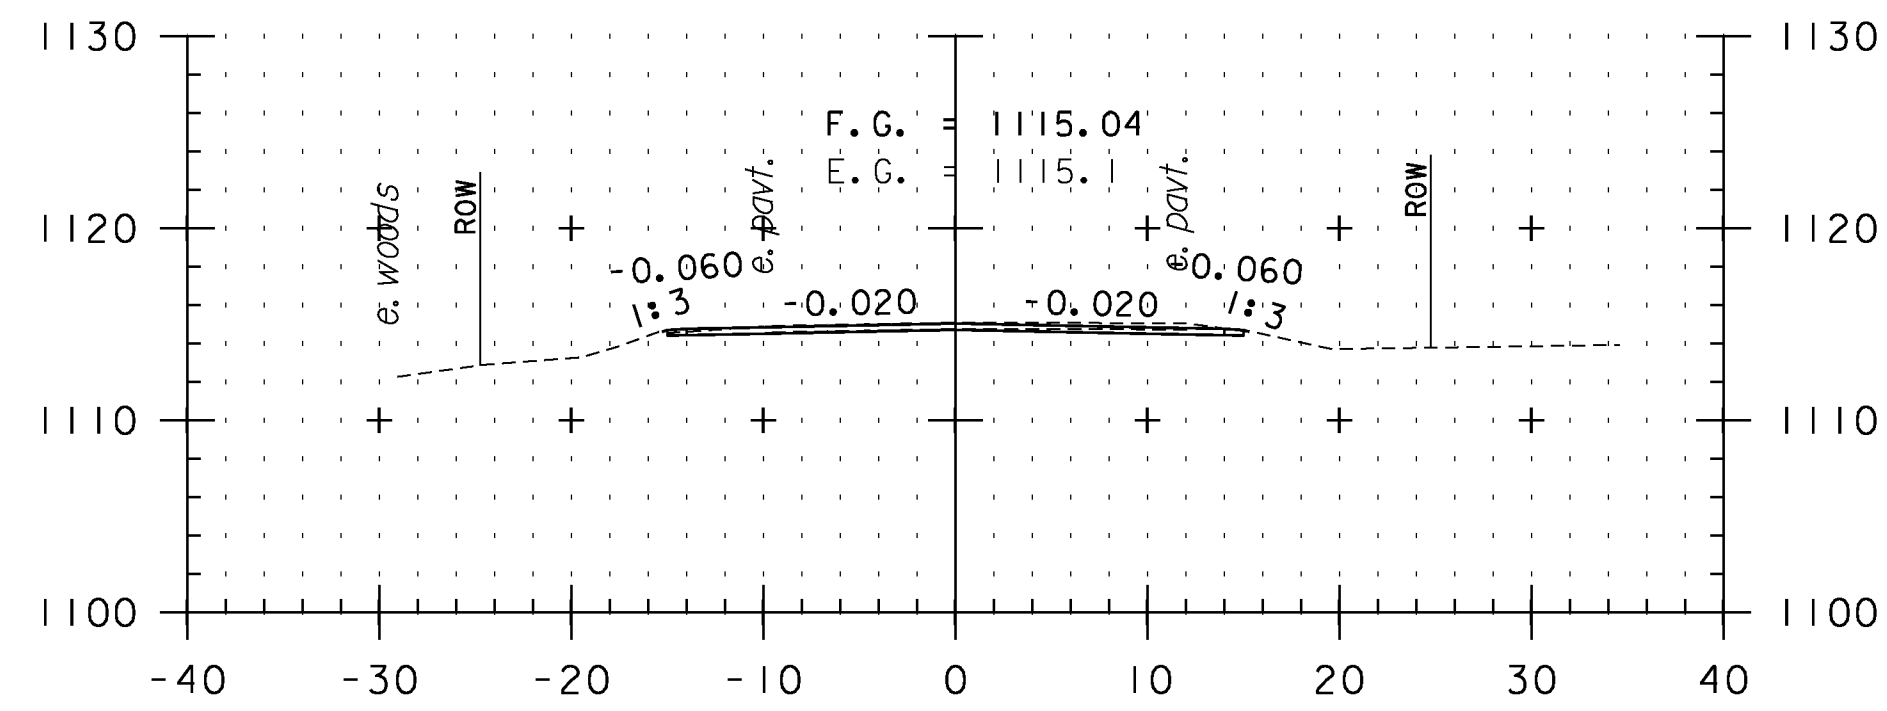


219+50

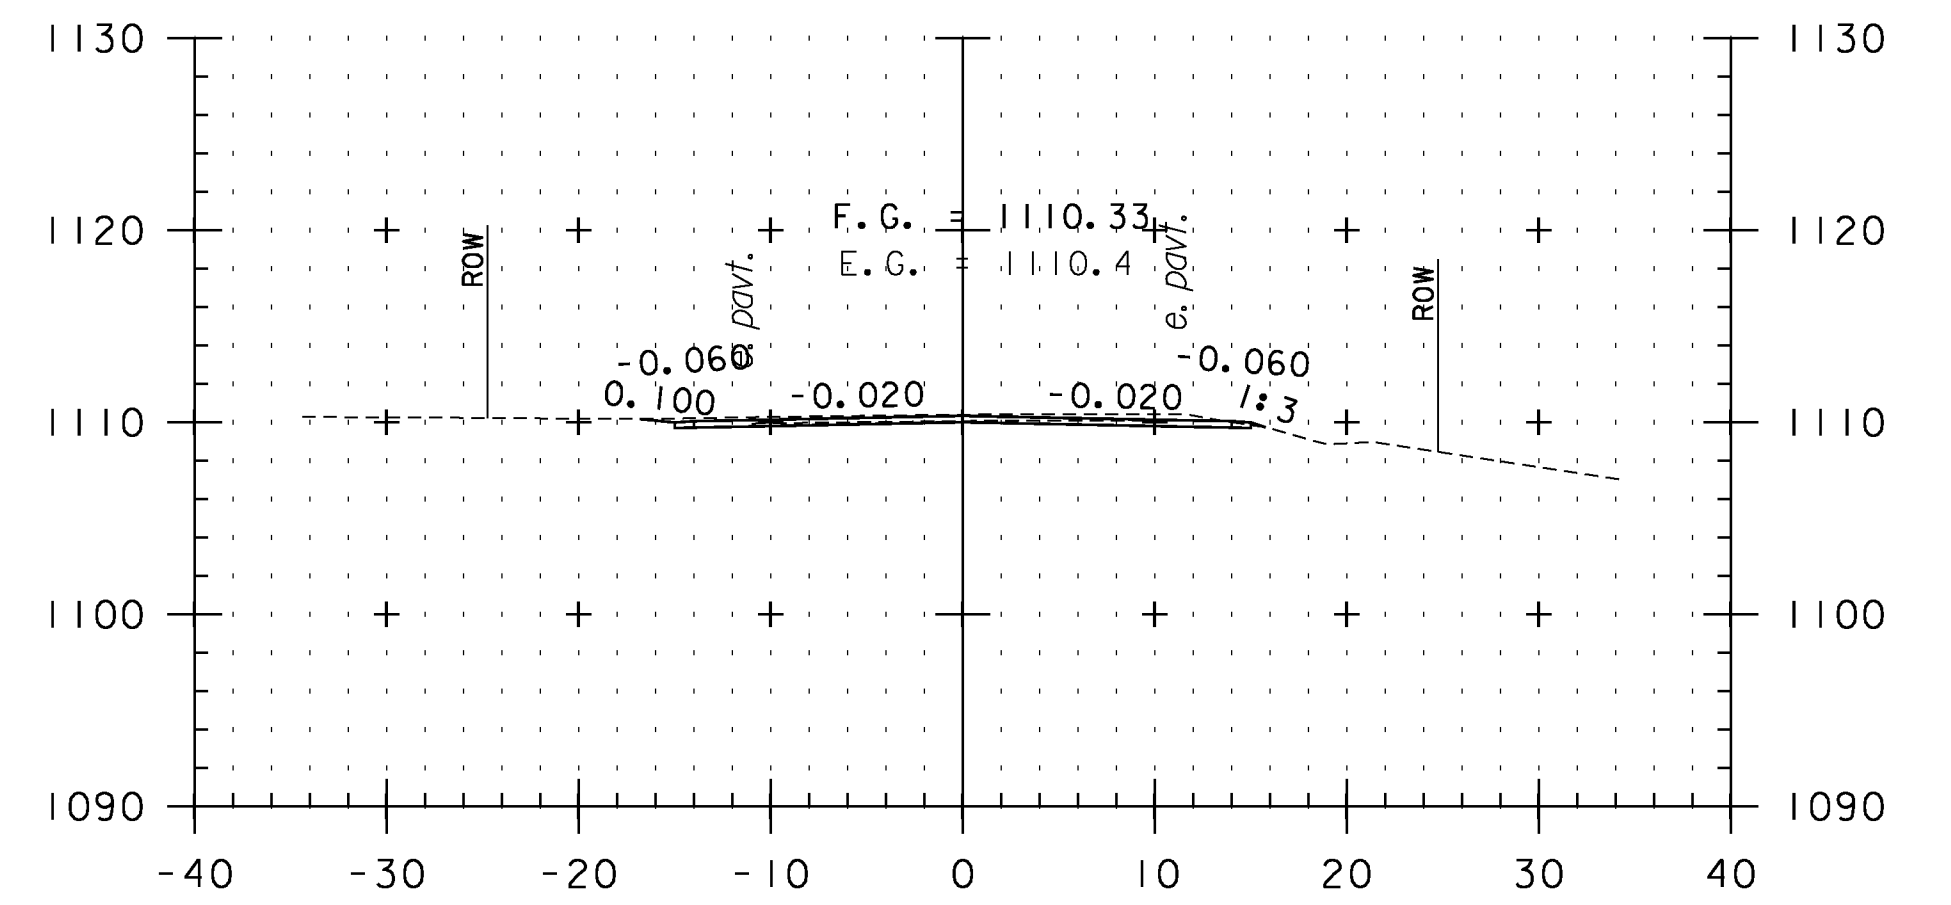


221+00

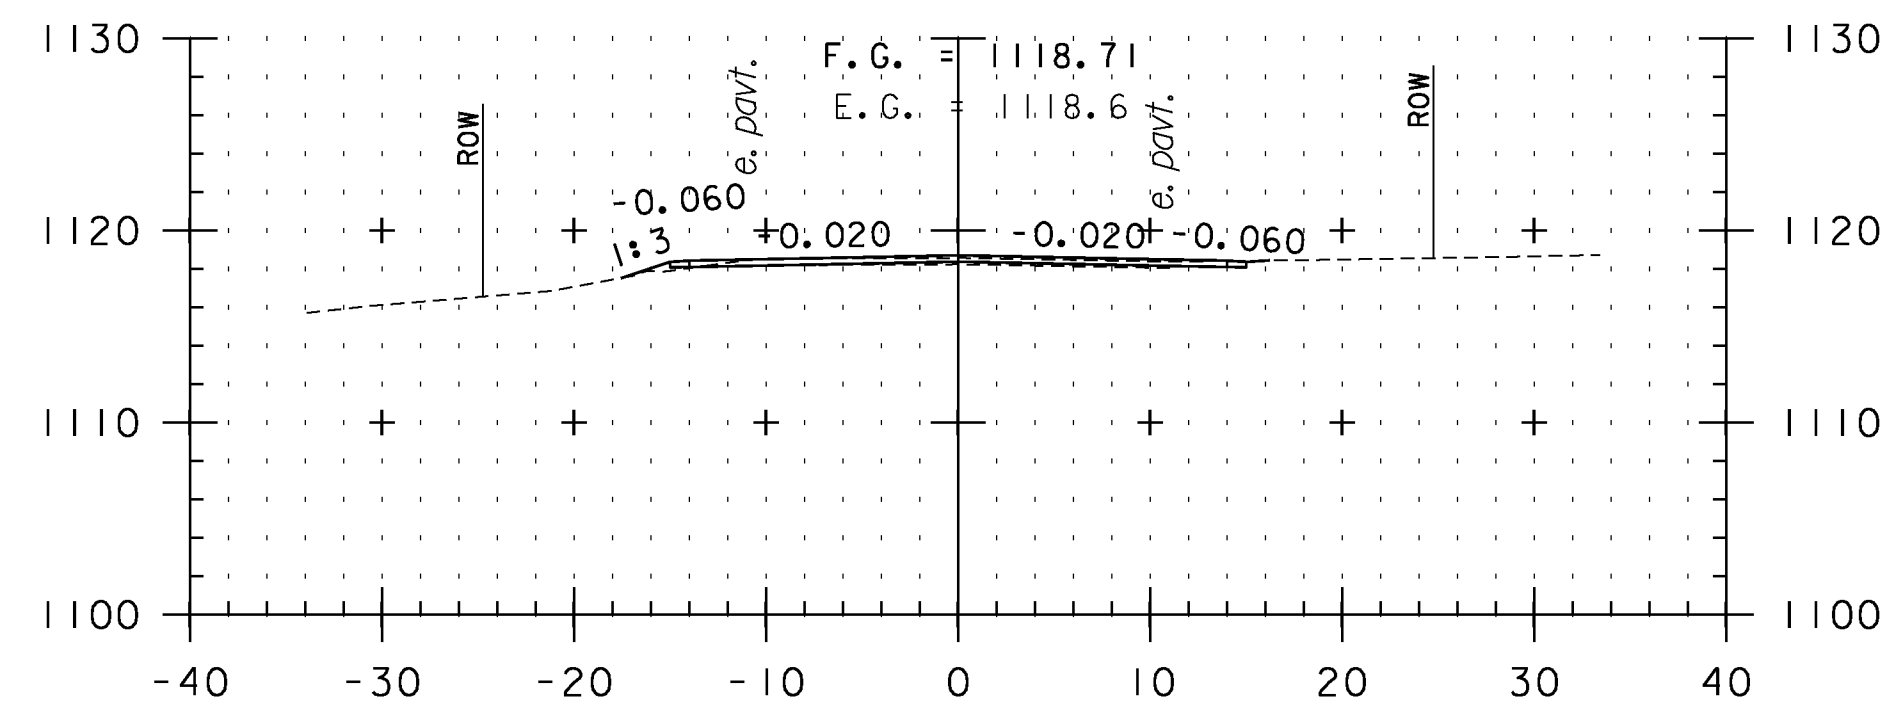


217+50

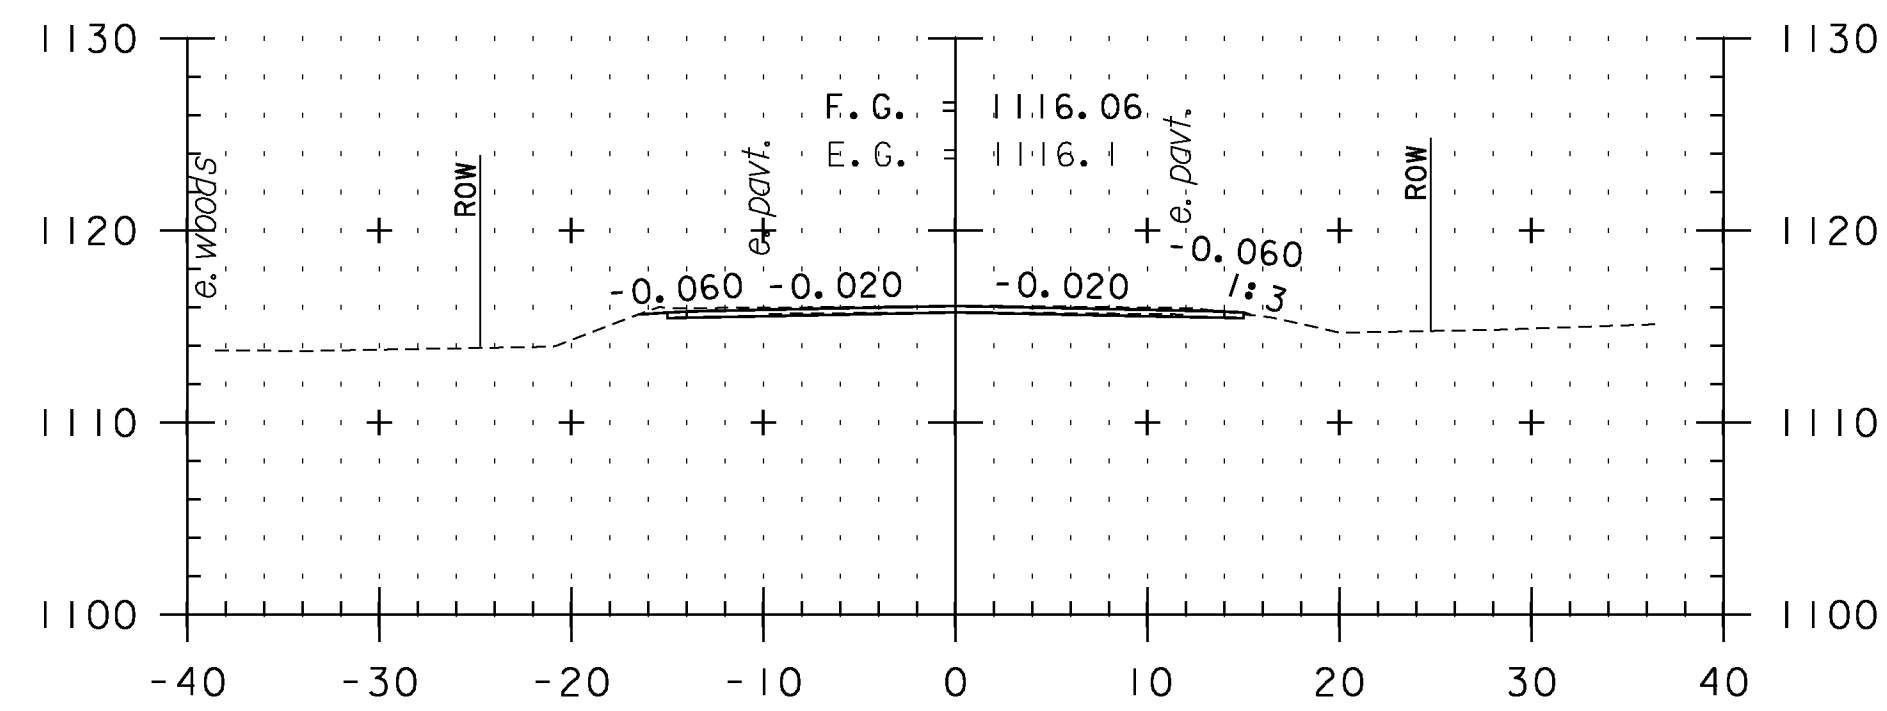


219+00

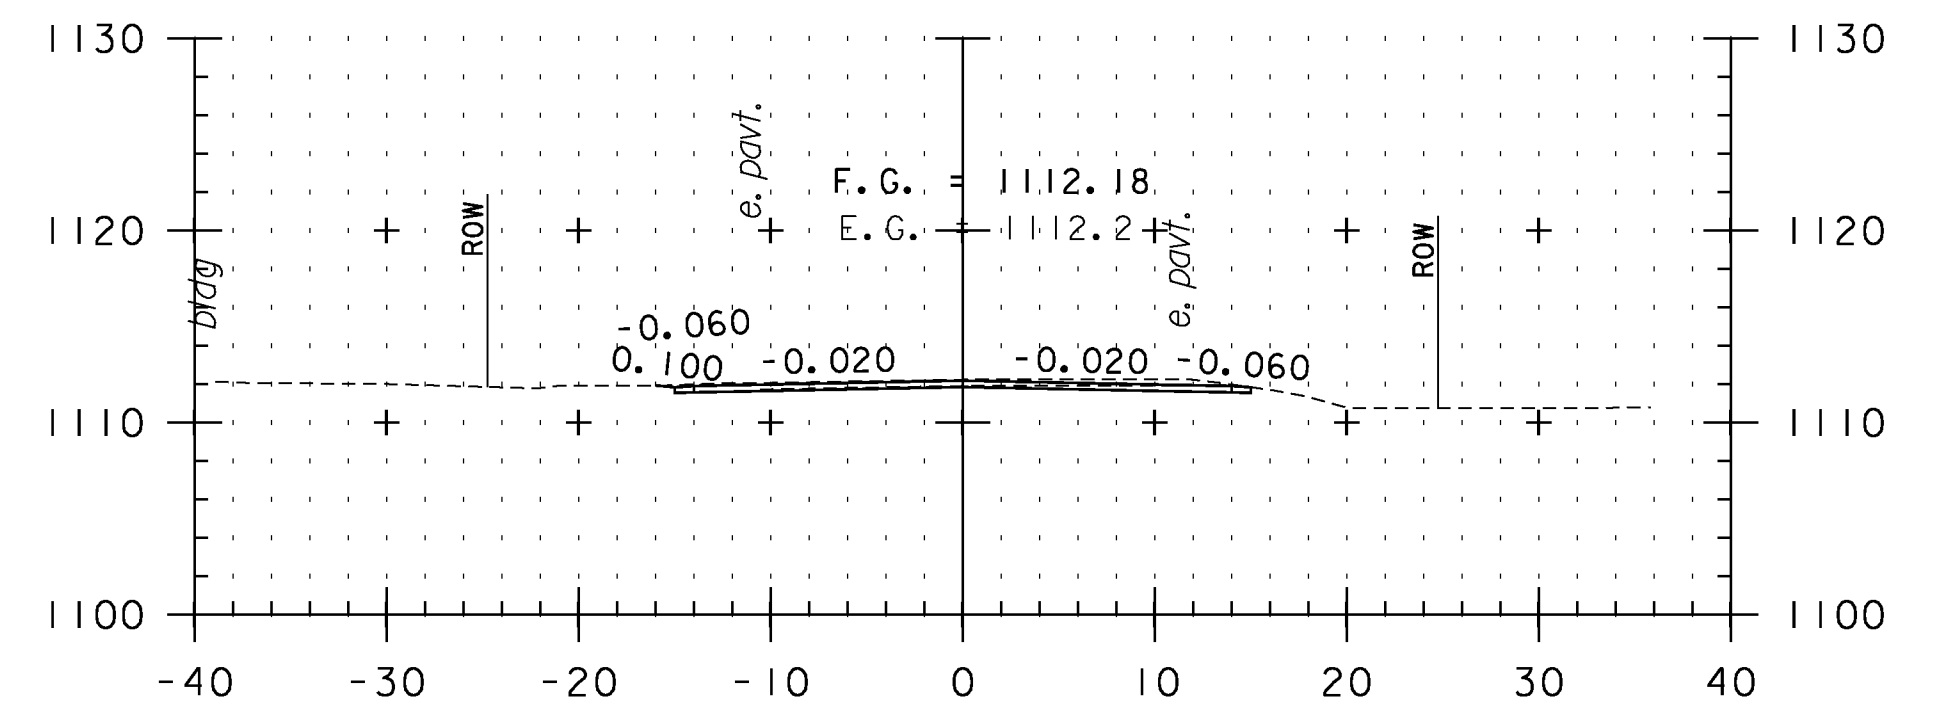


220+50

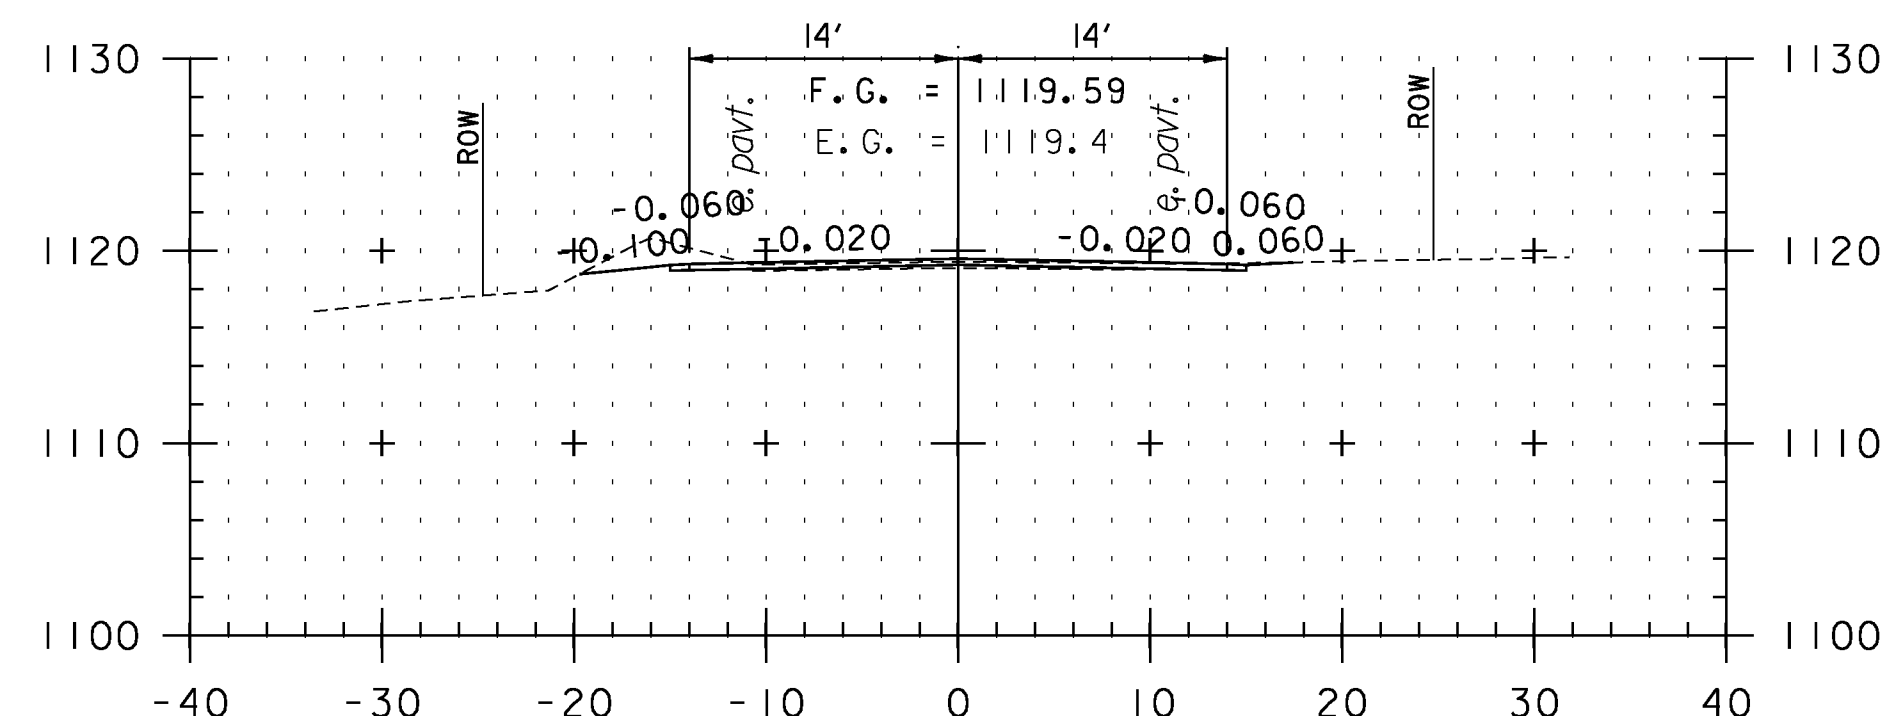

217+00

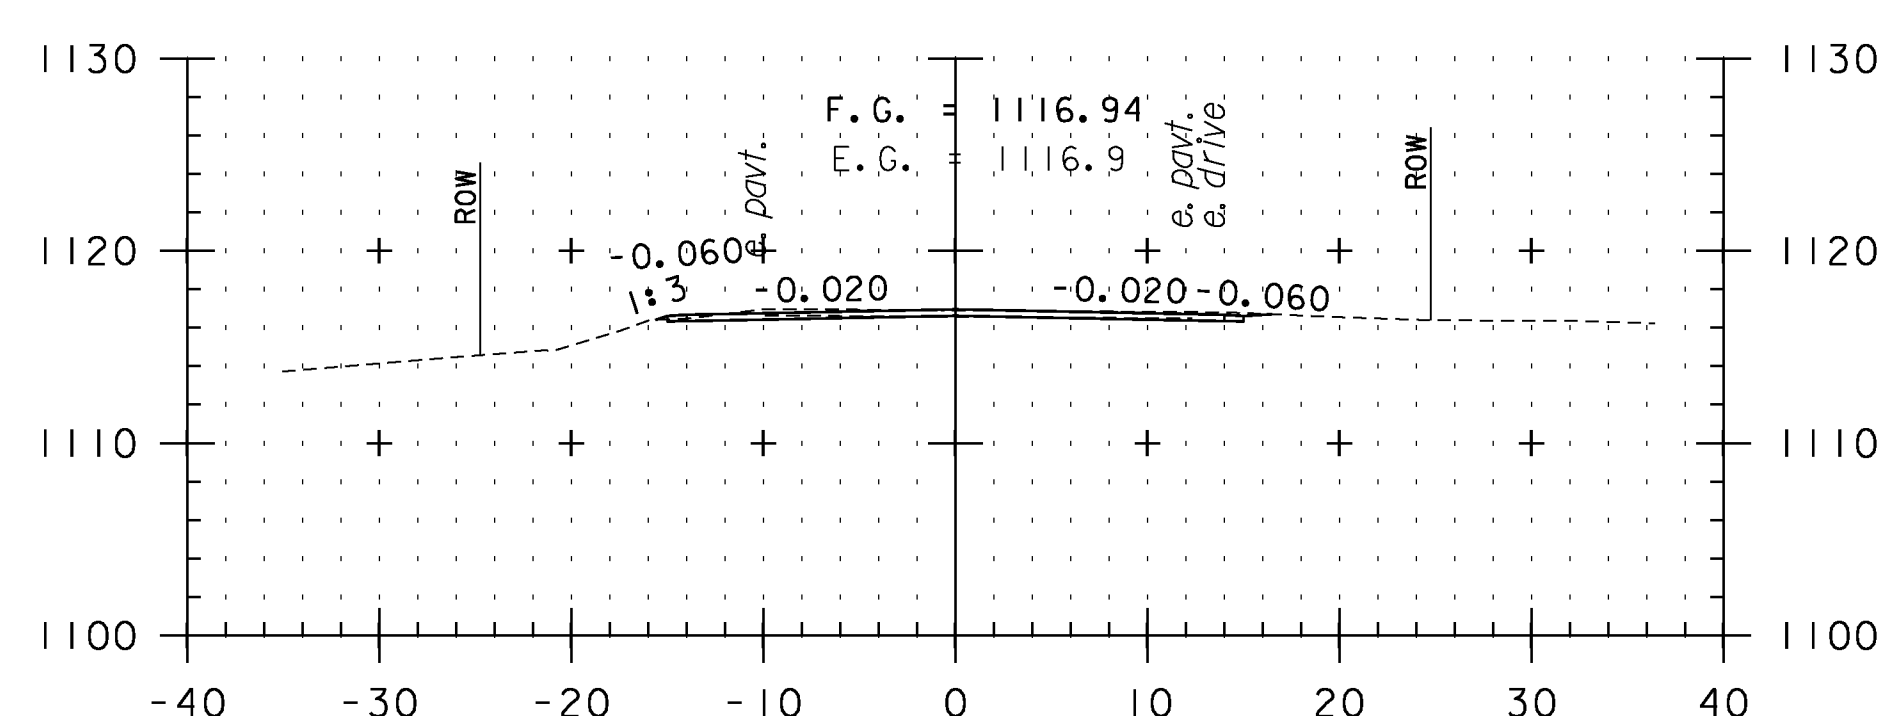

218+50

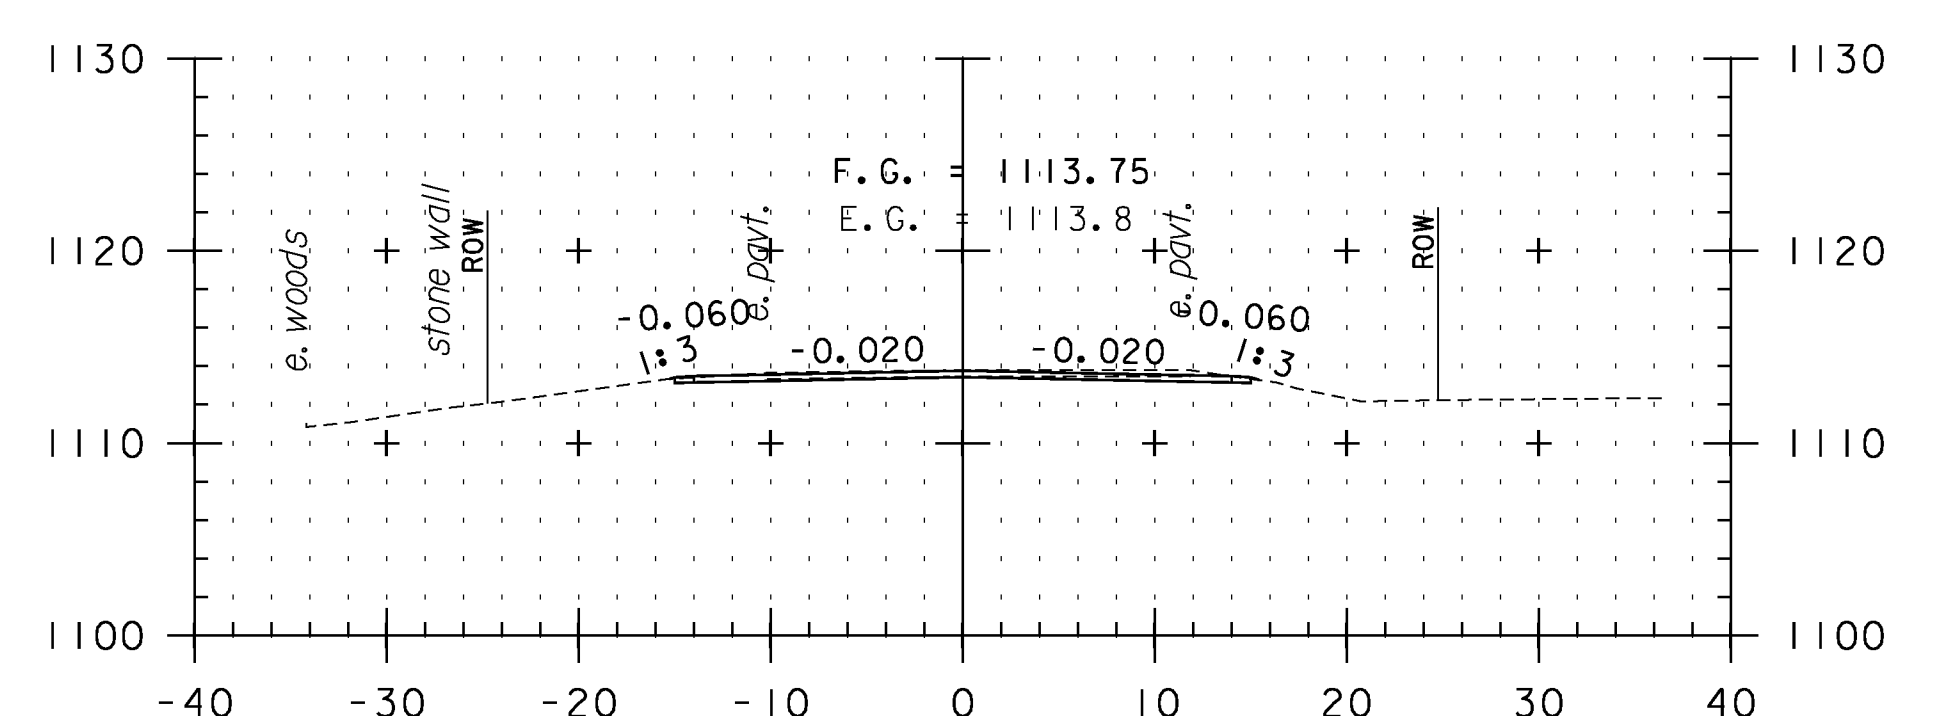

220+00

**CROSS SECTION SHEET 8**

STA. 217+00 TO STA. 221+00



PROJECT NAME: VERSHIRE-THETFORD	PLOT DATE: 1/29/2013
PROJECT NUMBER: STP 2911(I)	DRAWN BY: SNG
FILE NAME: pl0c224.dgn	CHECKED BY: PTS
PROJECT LEADER: PTS	SHEET 116 OF 232
DESIGNED BY: NLL	
IPARM FILE NAME: IOC224_116	