




222+50

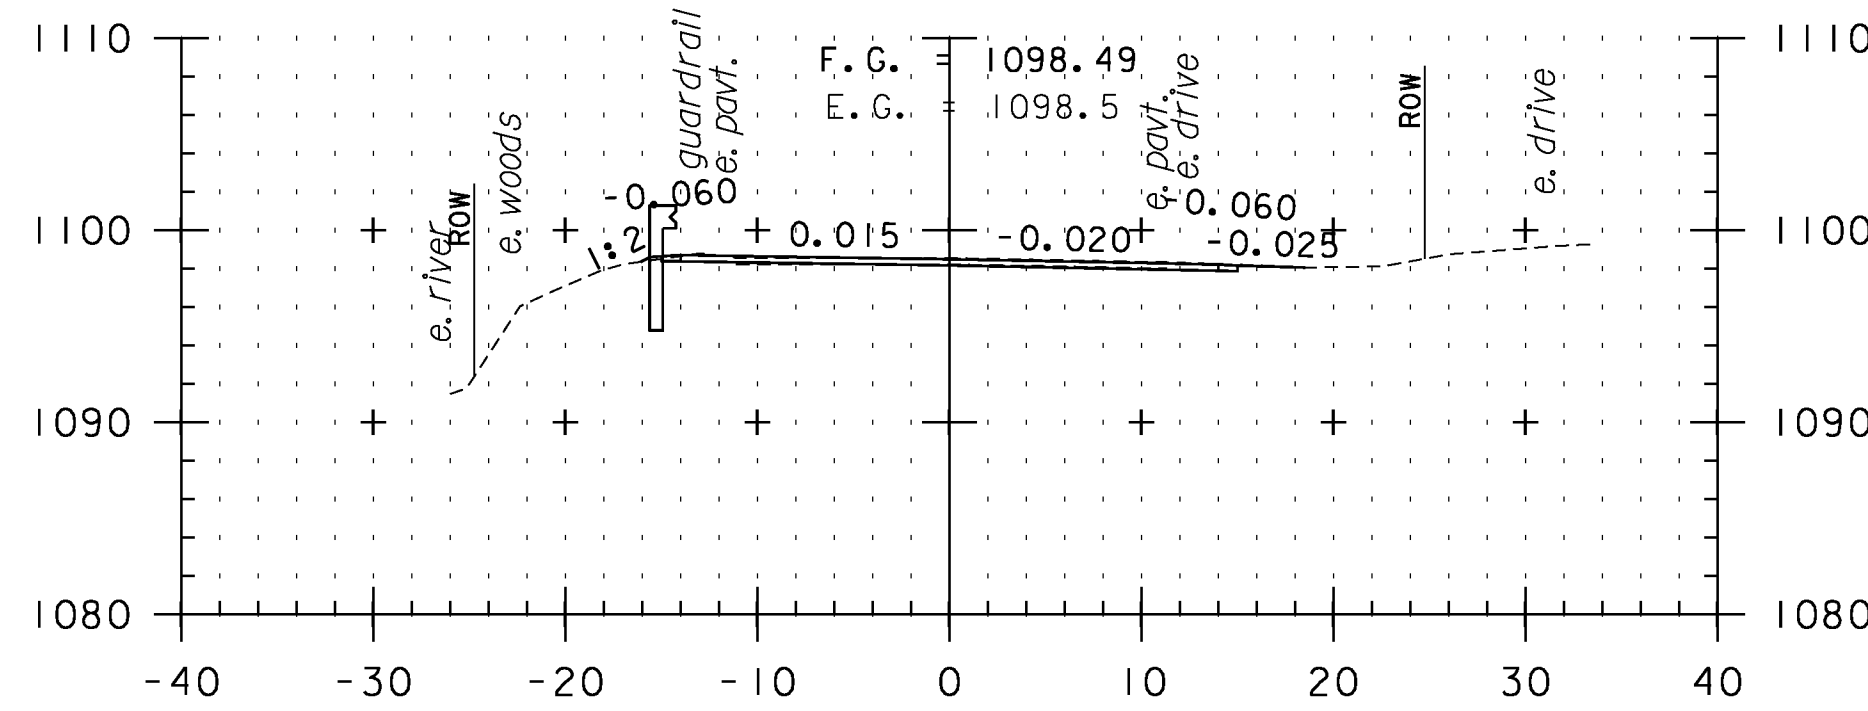


224+00

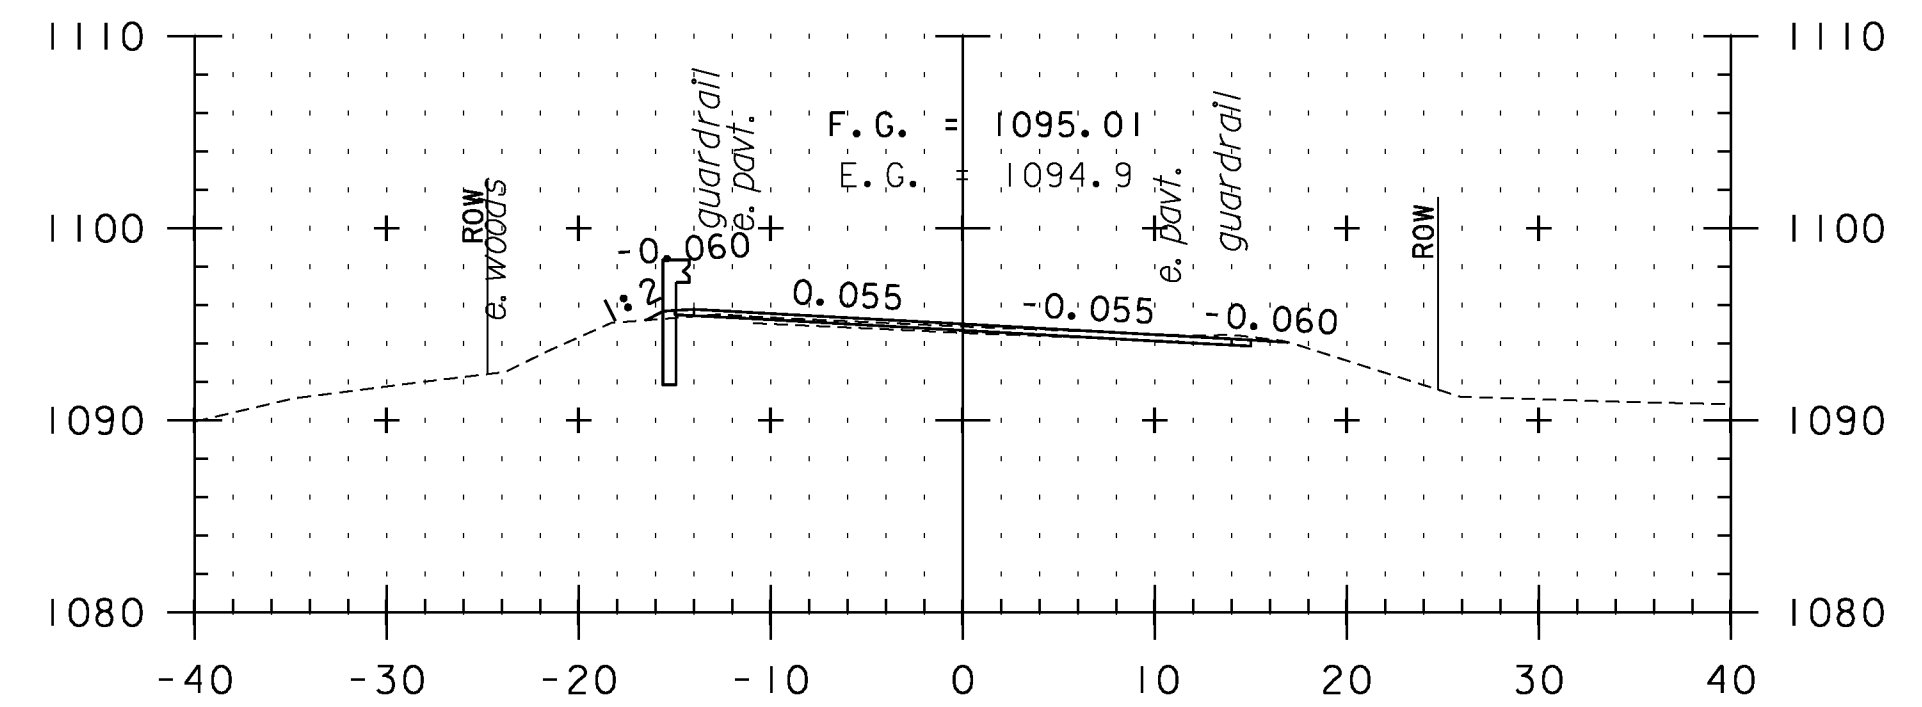


225+50

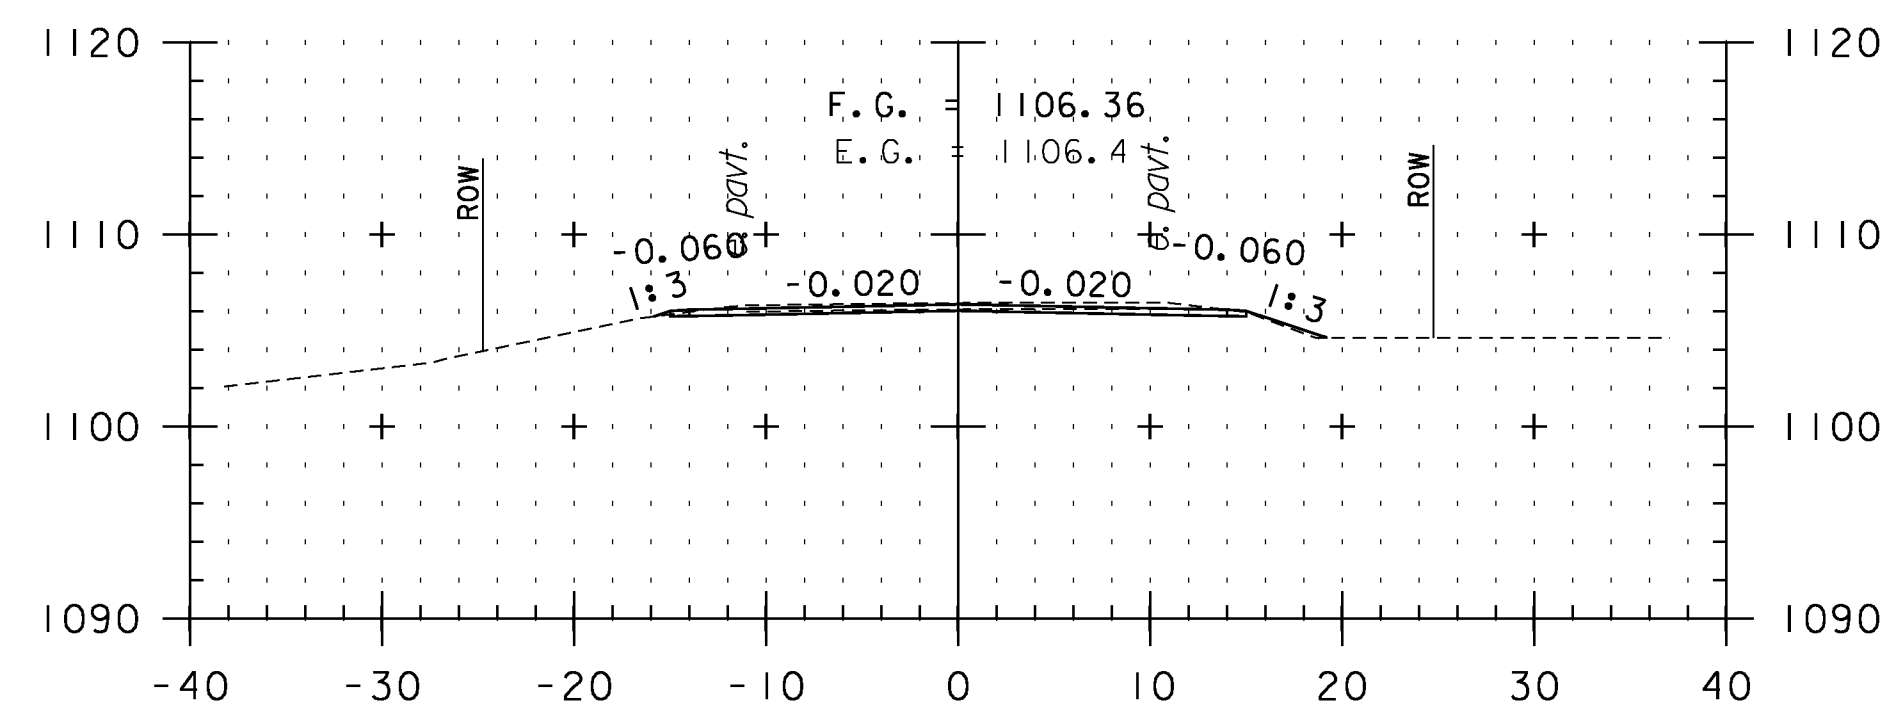


222+00

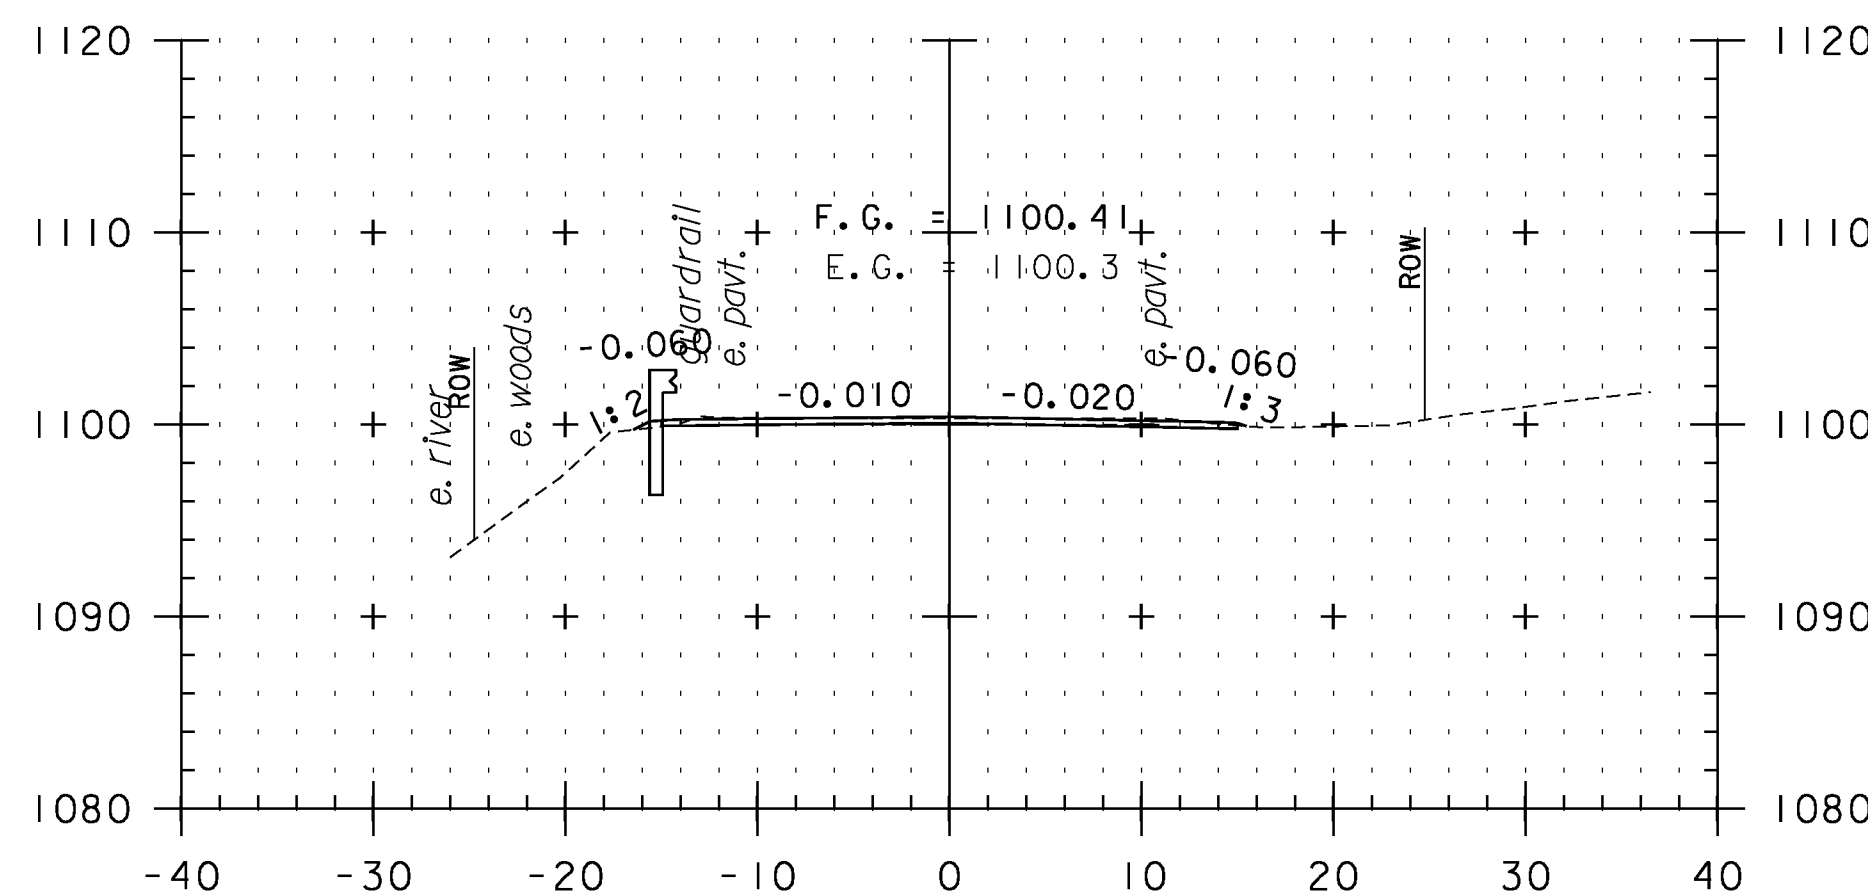


223+50

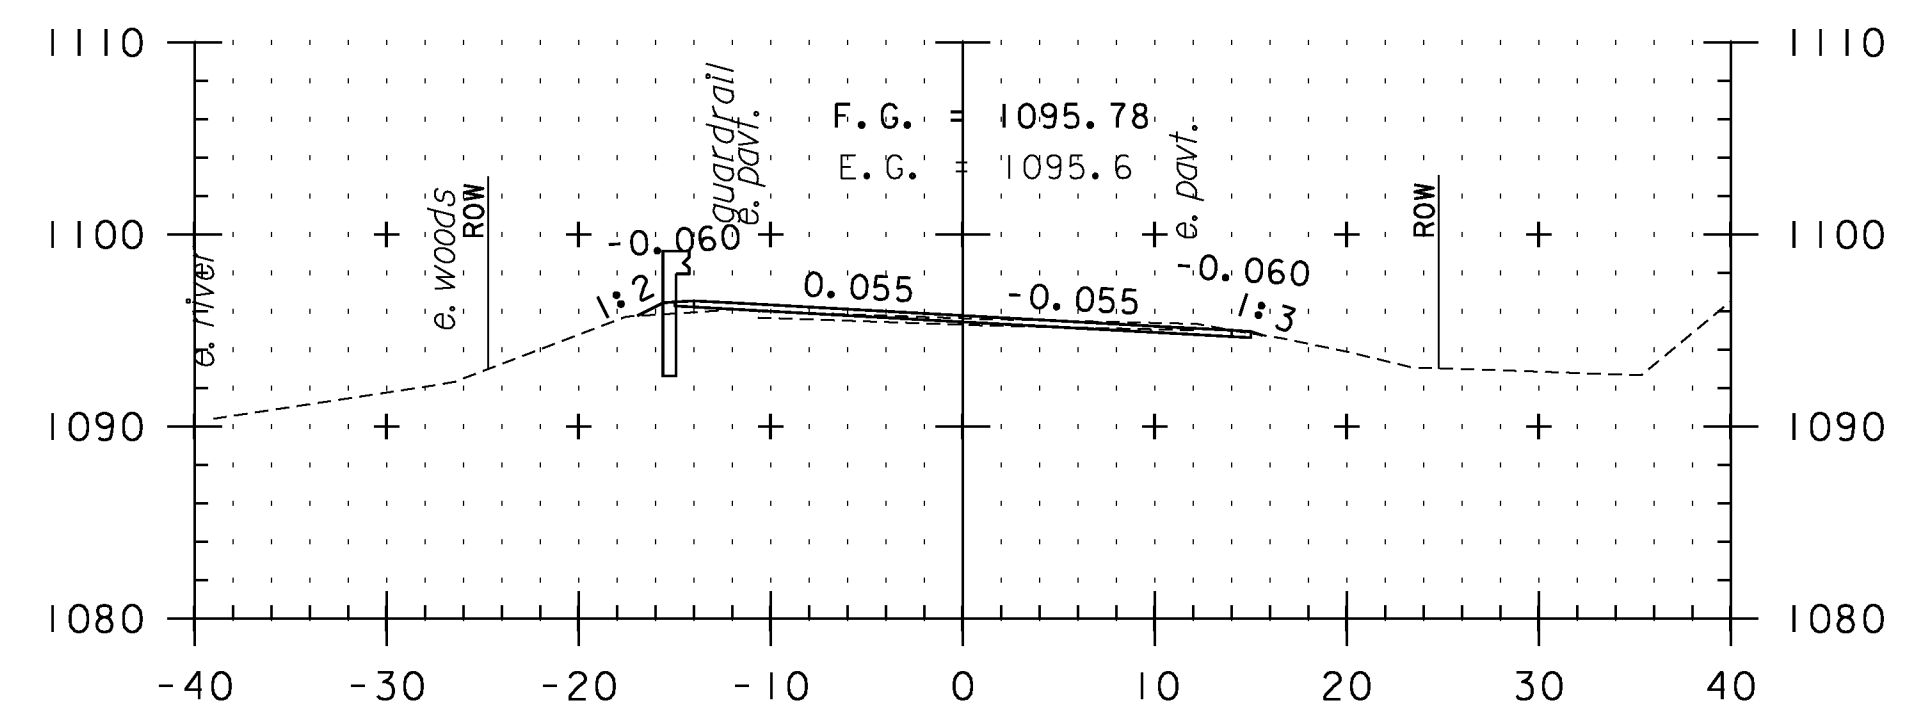


225+00

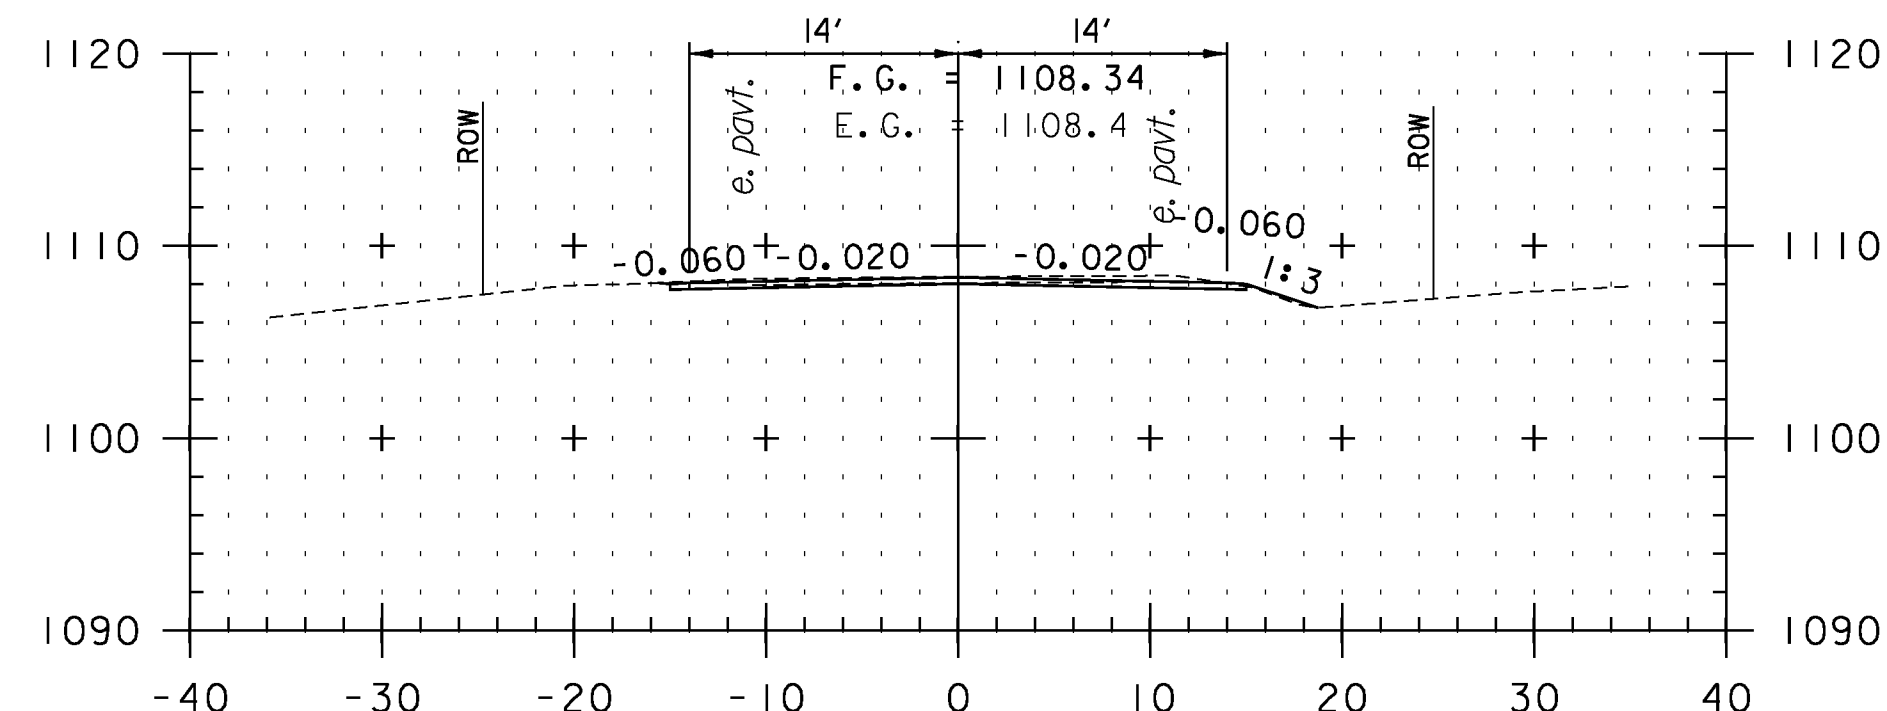

221+50

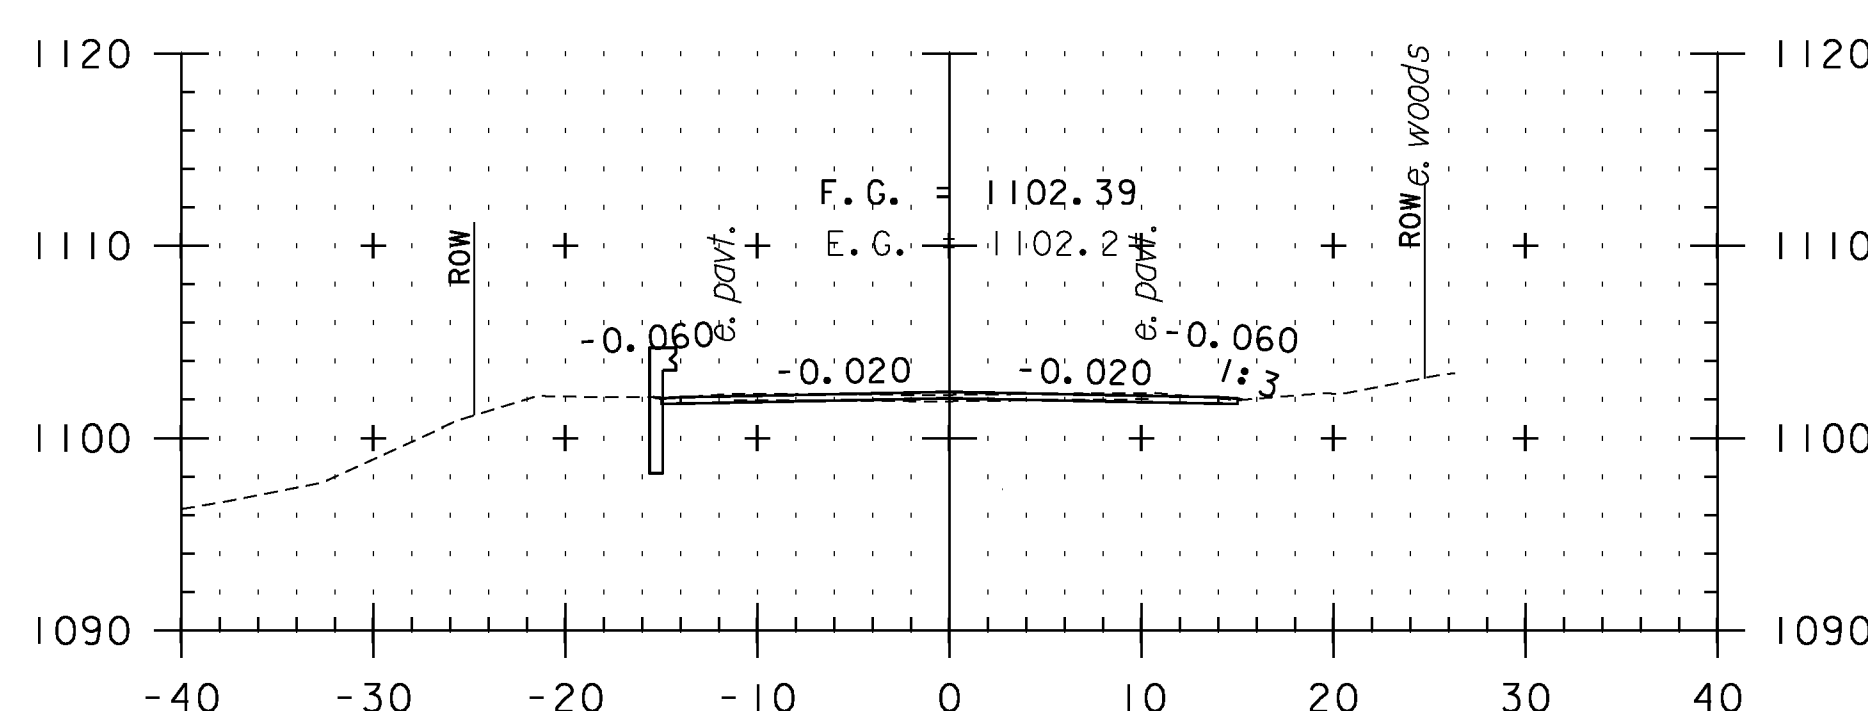


223+00

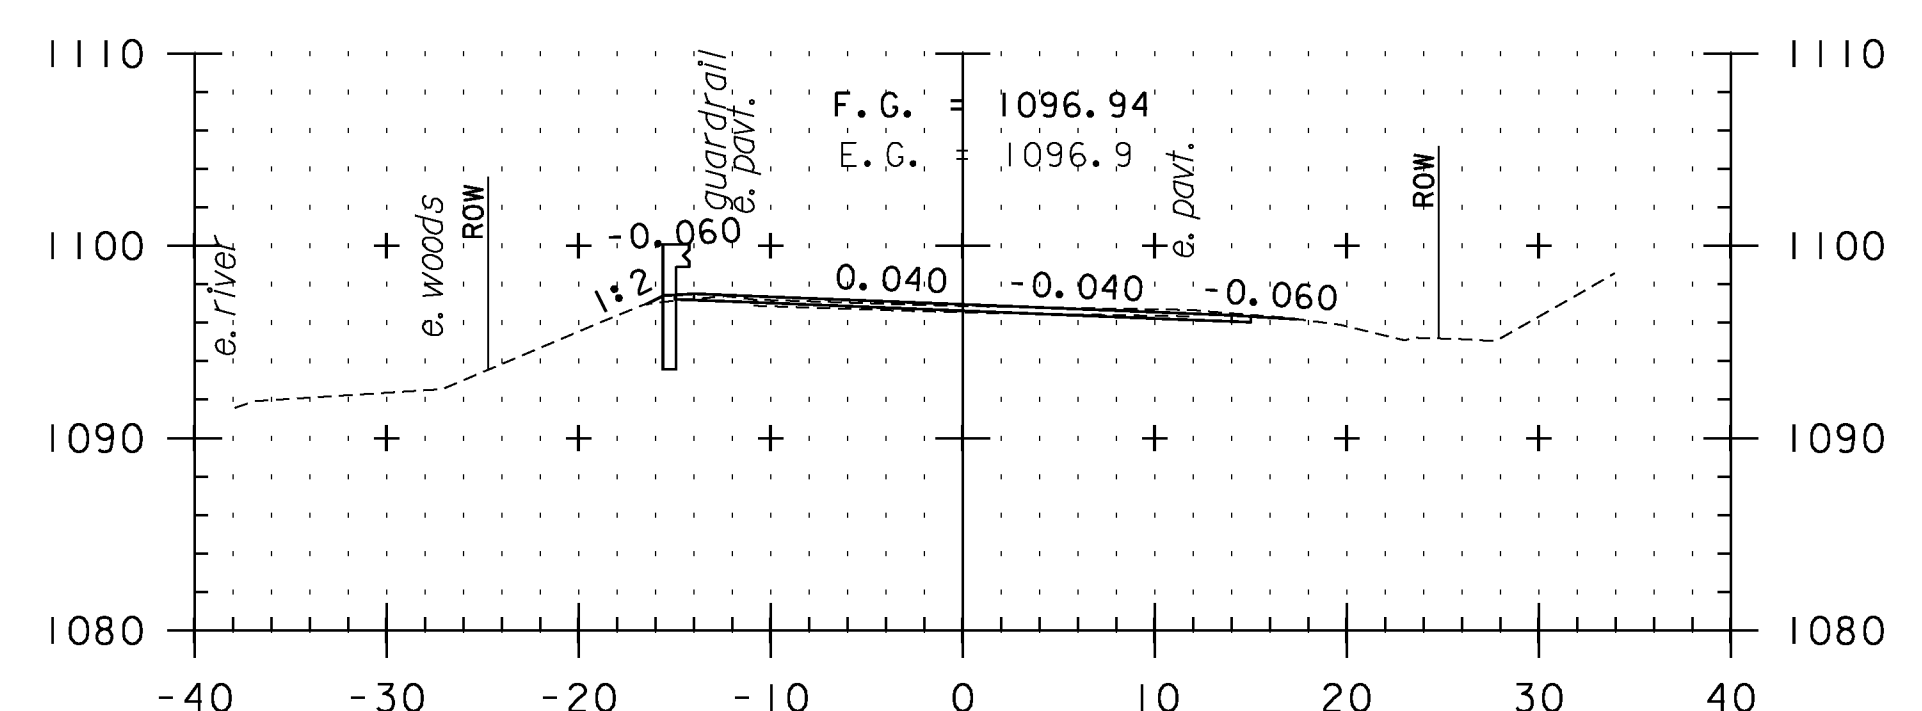

224+50

CROSS SECTION SHEET 9

STA. 221+50 TO STA. 225+50

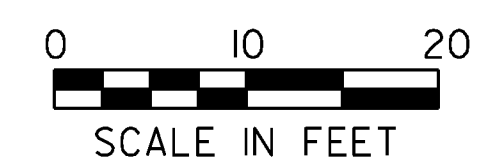

PROJECT NAME: VERSHIRE-THETFORD	PLOT DATE: 1/29/2013
PROJECT NUMBER: STP 2911(I)	DRAWN BY: SNG
FILE NAME: pl0c224.dgn	CHECKED BY: PTS
PROJECT LEADER: PTS	SHEET I17 OF 232
DESIGNED BY: NLL	
IPARM FILE NAME: IOC224_I17	