




227+00

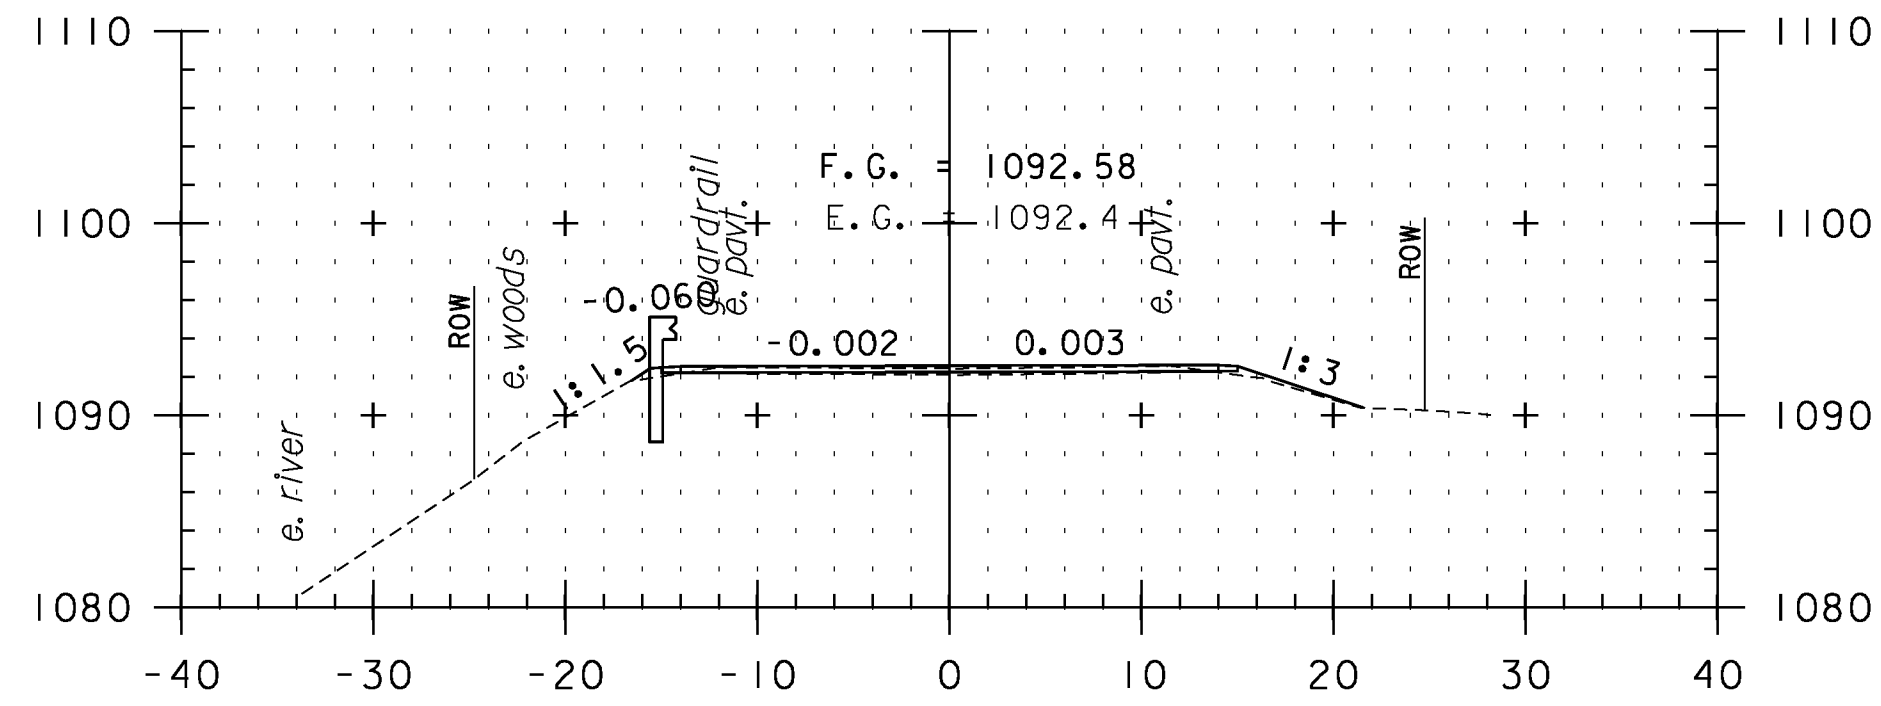


228+50

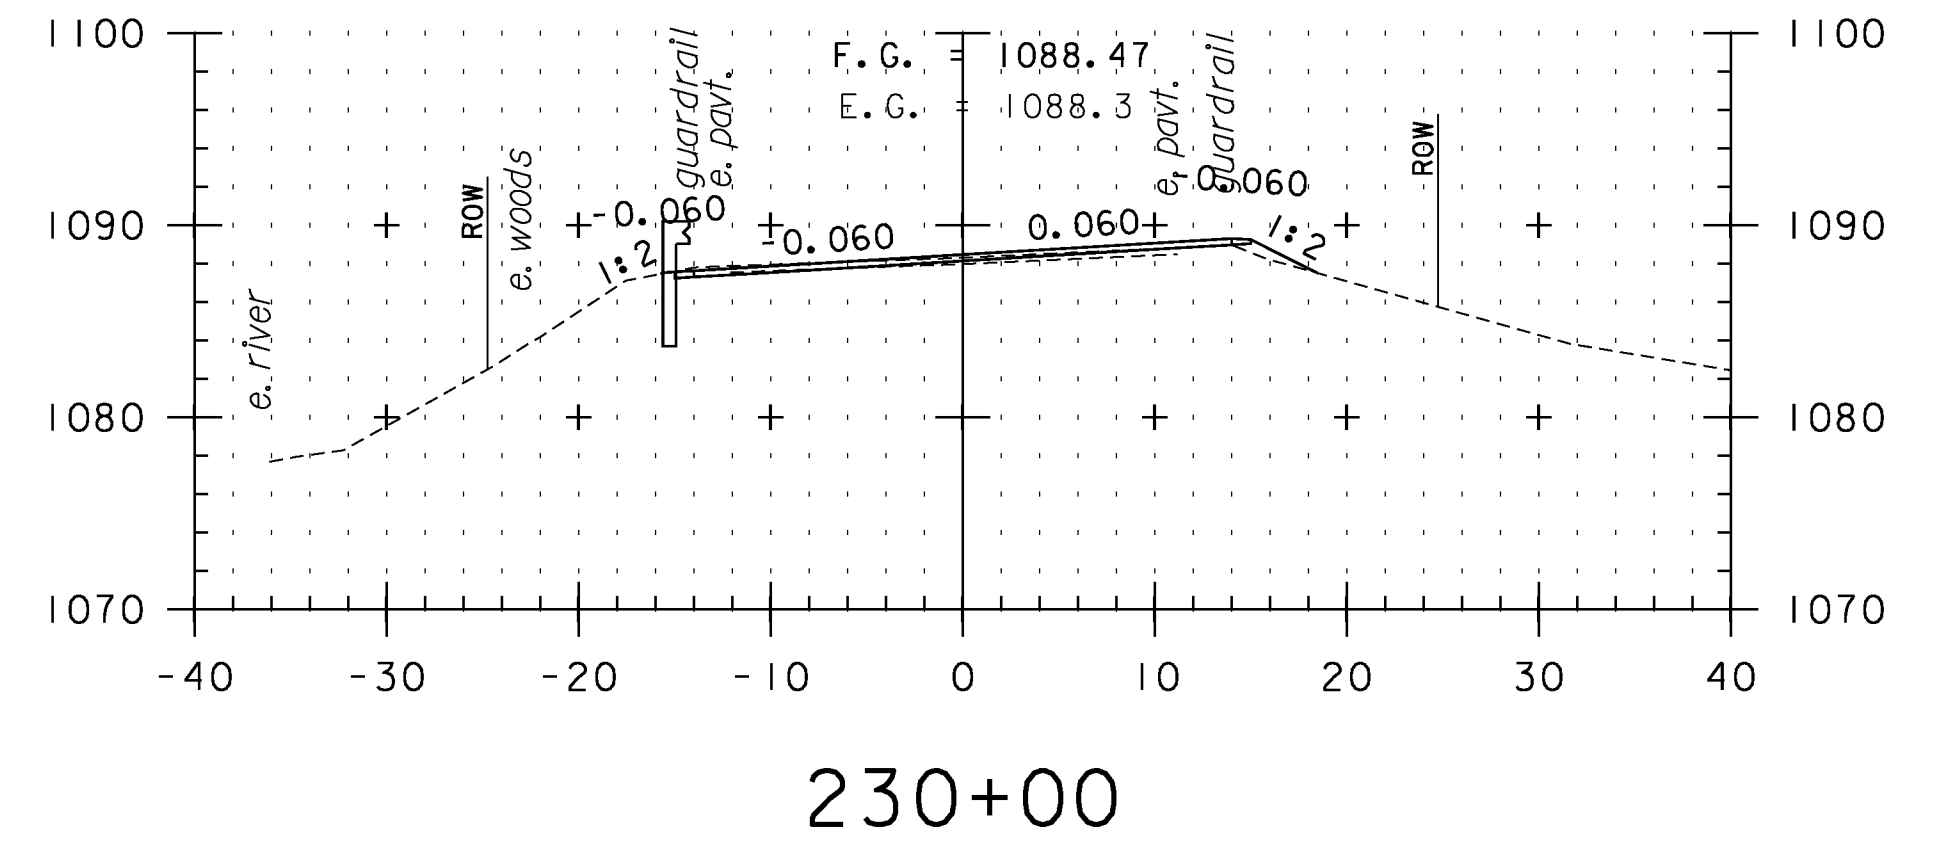


230+00

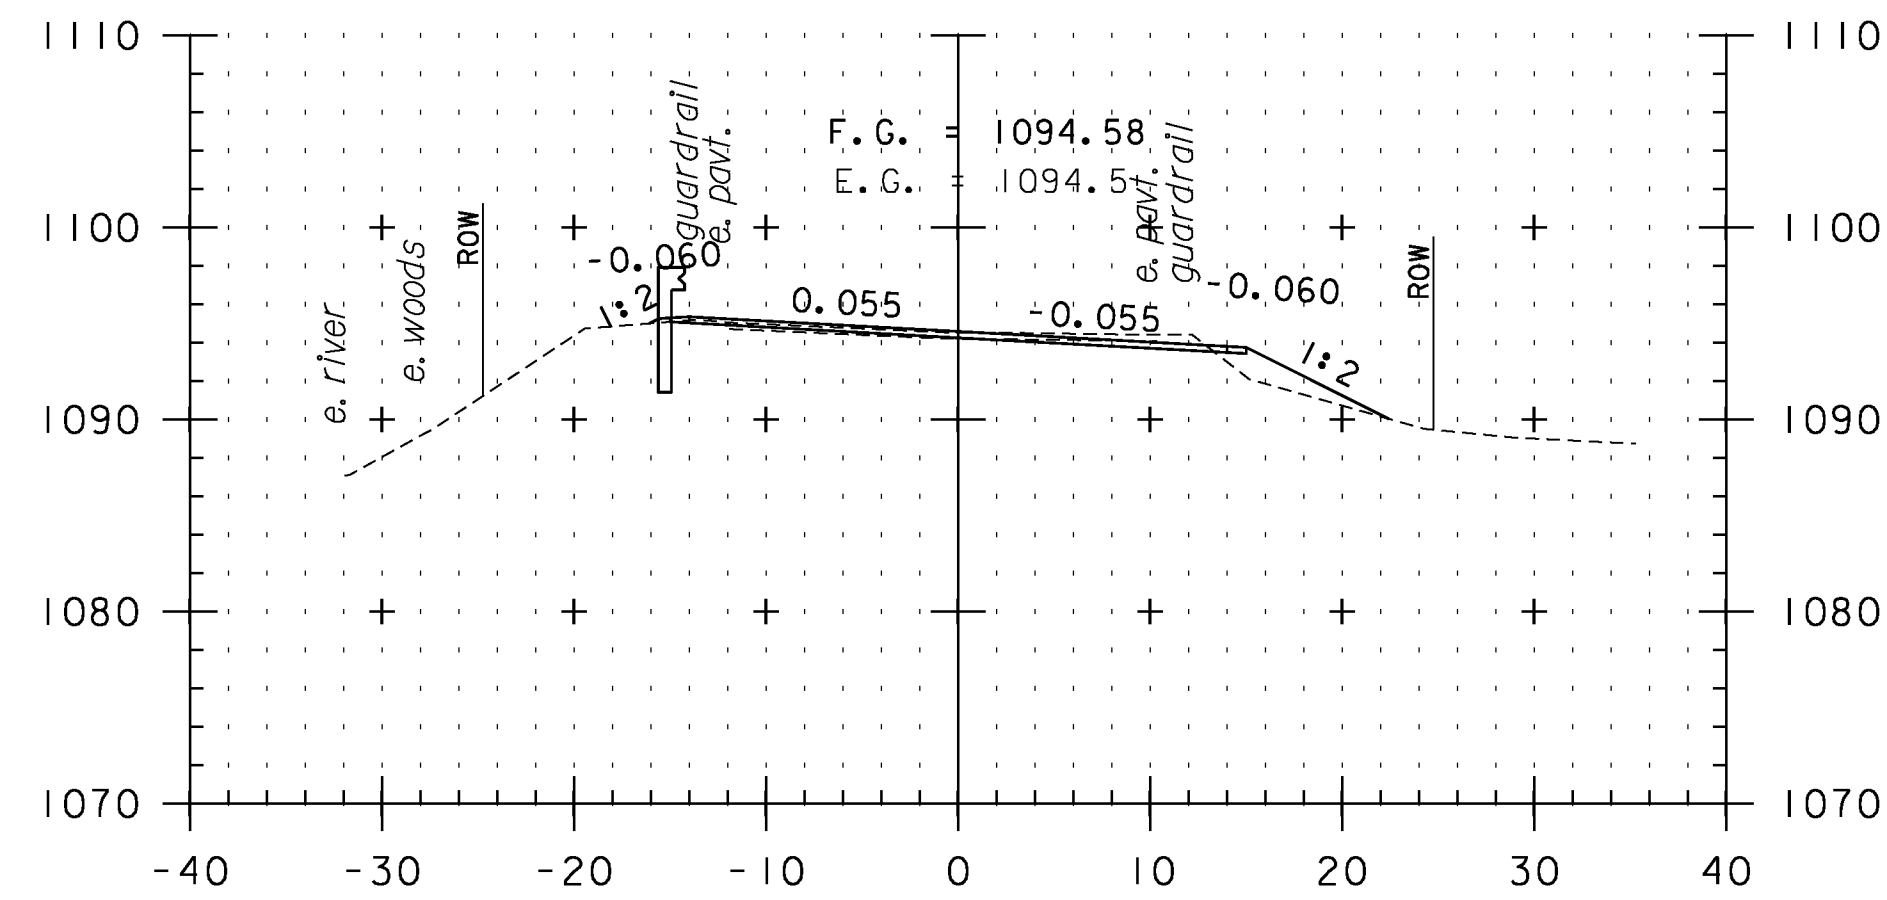


226+50

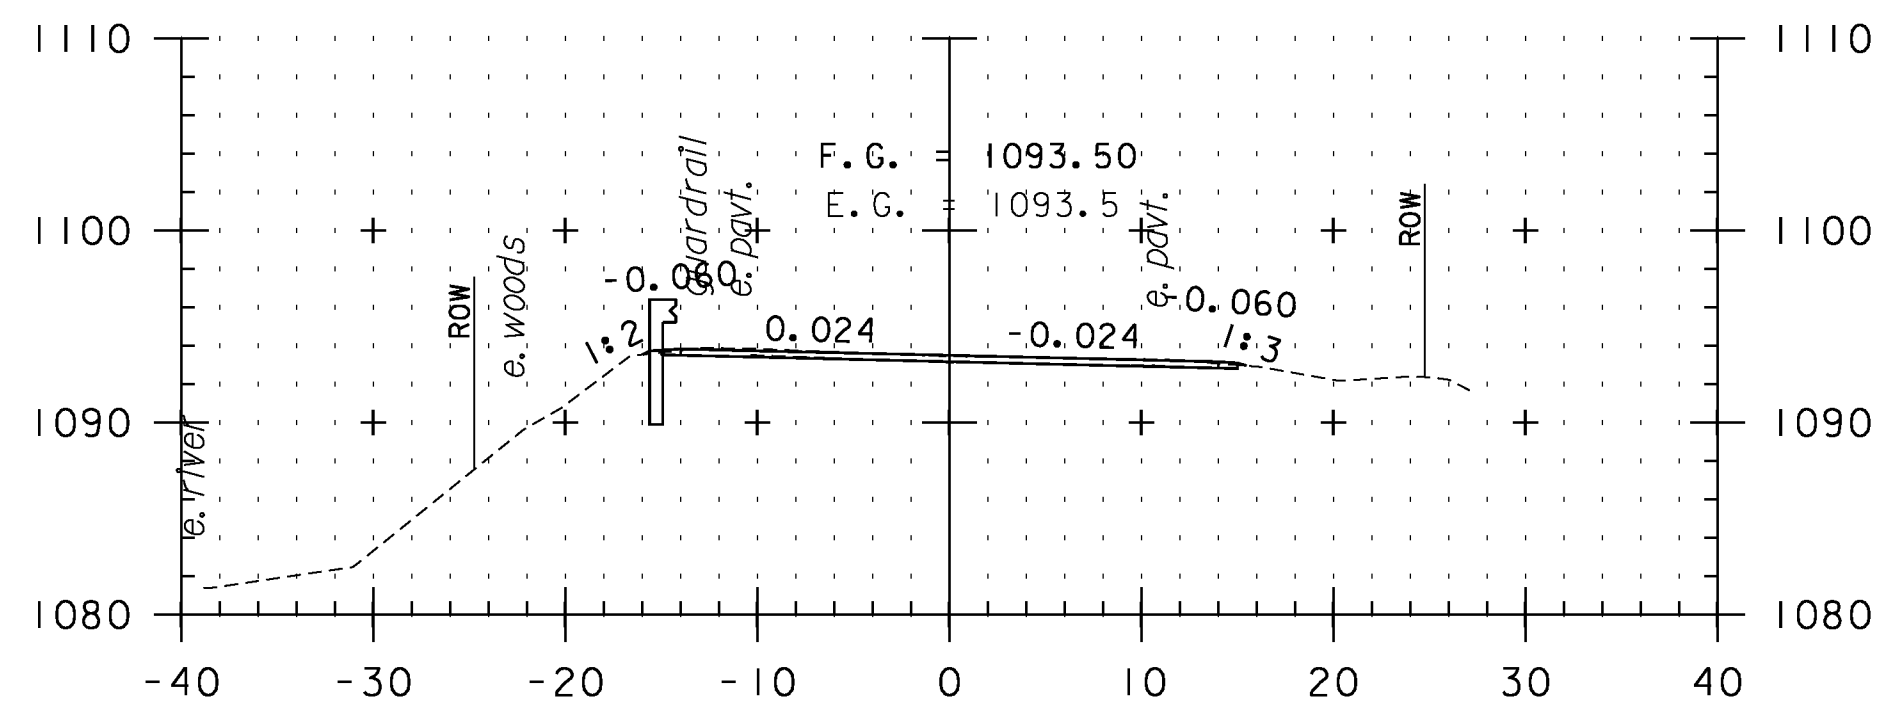


228+00

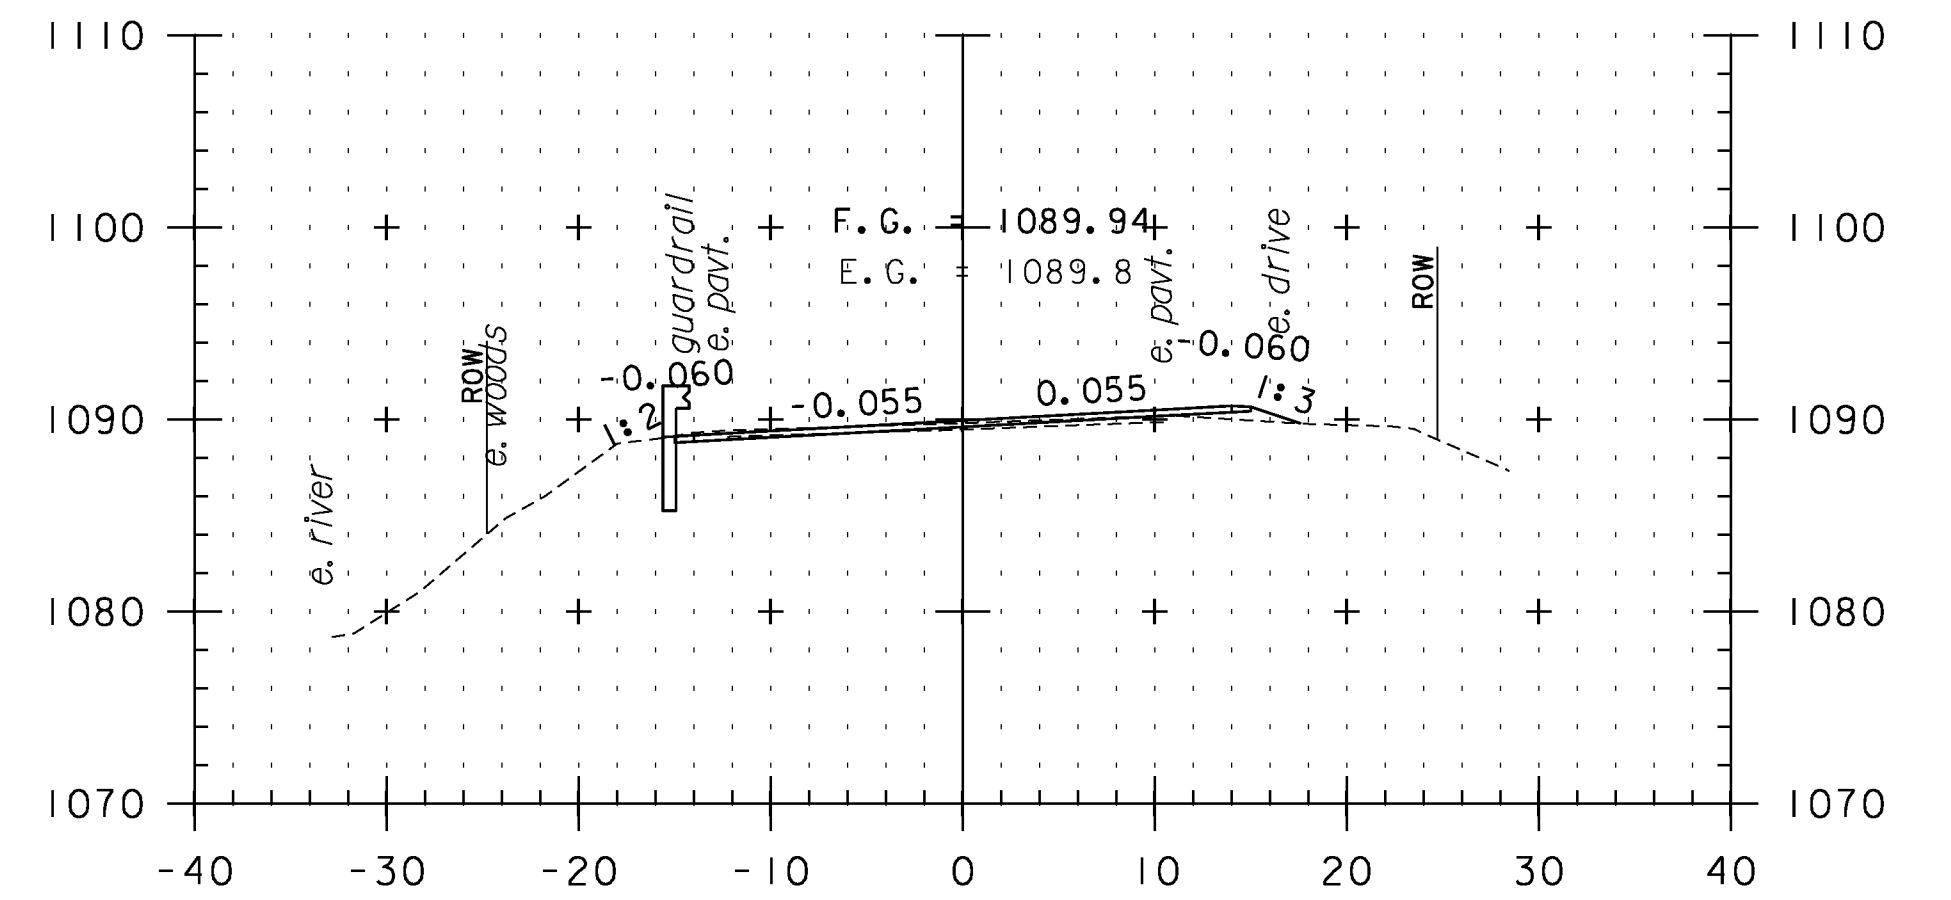


229+50

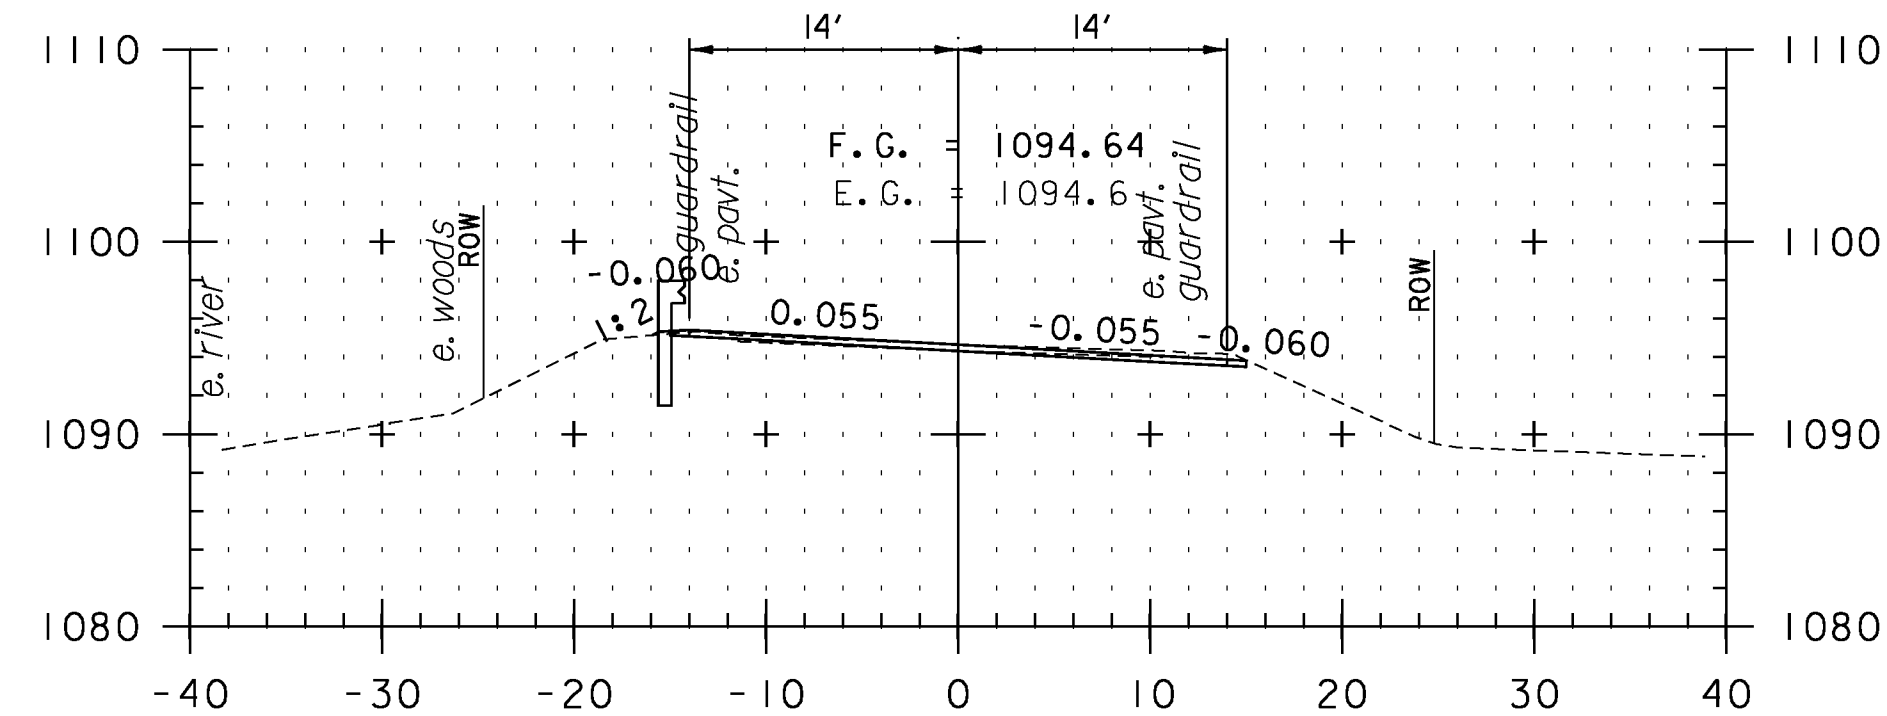

226+00

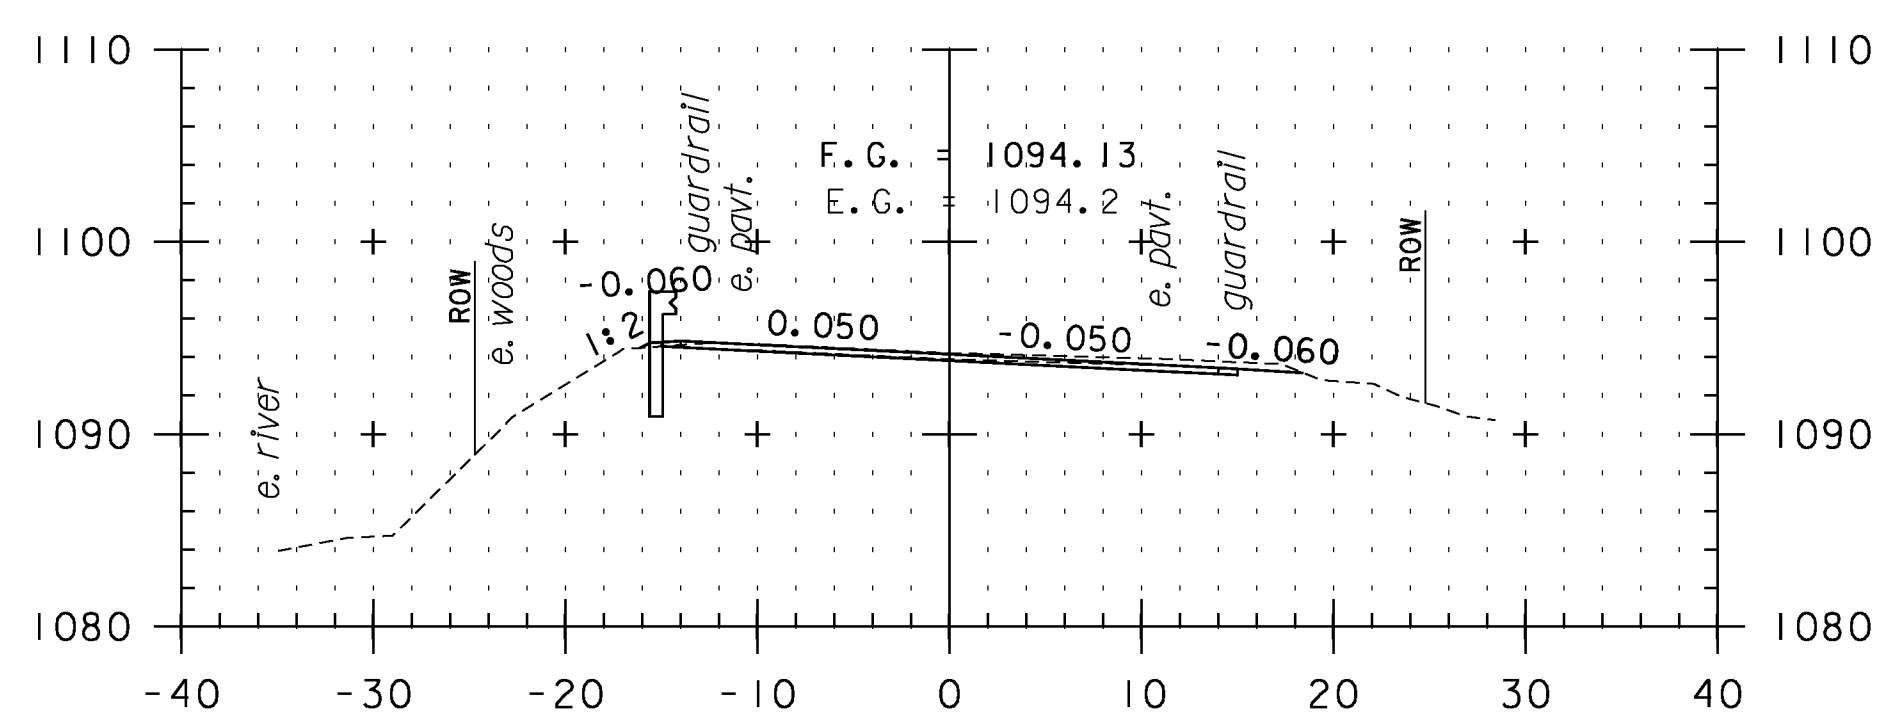

227+50

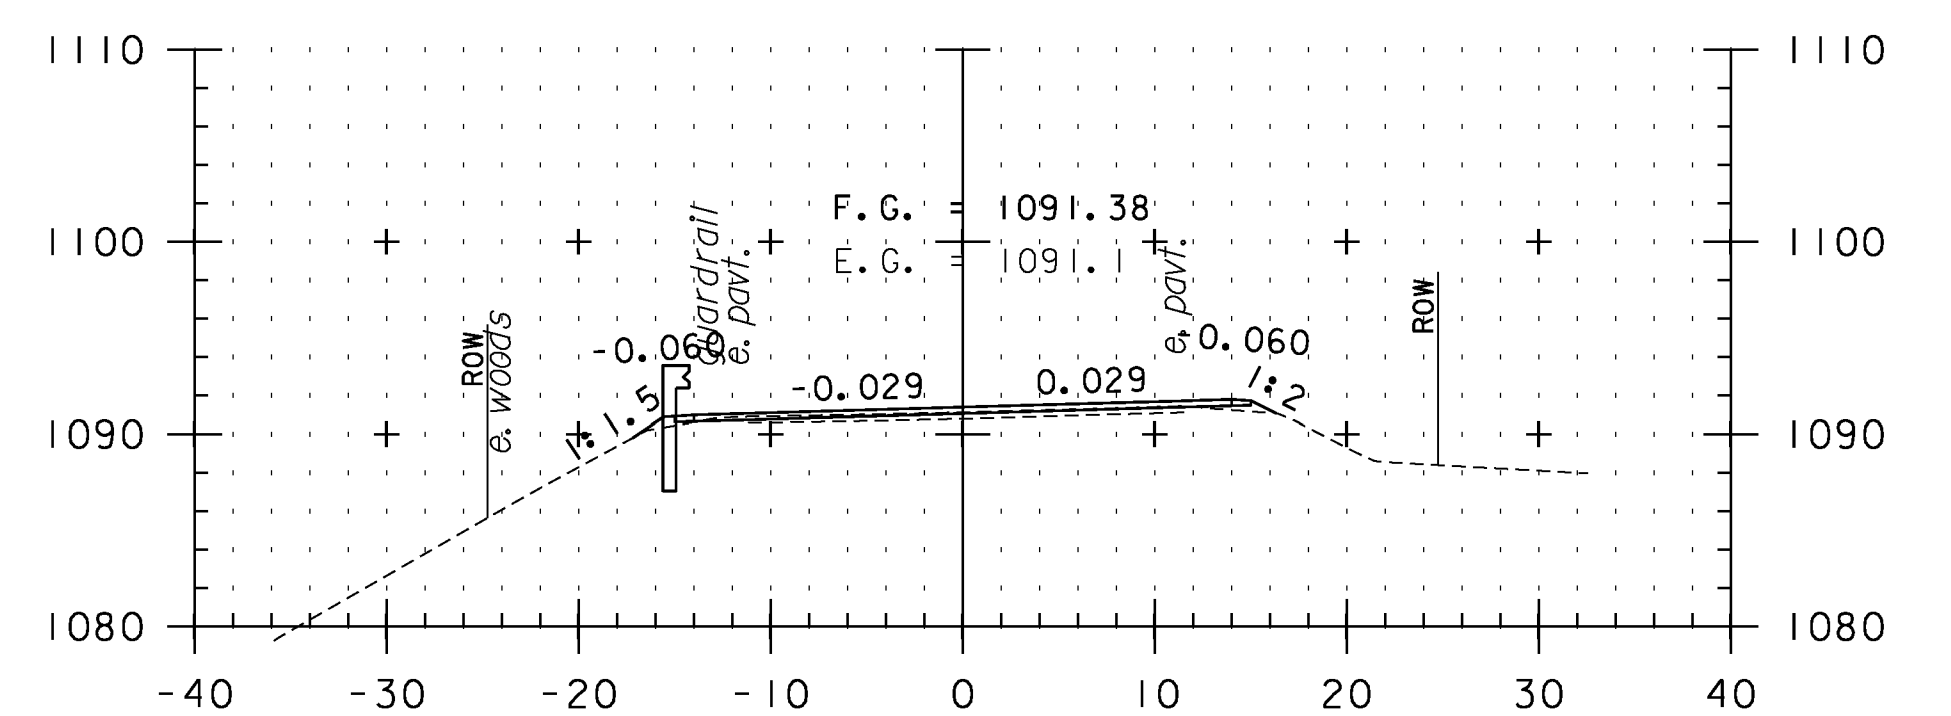


229+00

CROSS SECTION SHEET 10

PROJECT NAME: VERSHIRE-THETFORD
 PROJECT NUMBER: STP 2911(I)
 FILE NAME: pl0c224.dgn
 PROJECT LEADER: PTS
 DESIGNED BY: NLL
 IPARM FILE NAME: IOC224_I18
 PLOT DATE: 1/29/2013
 DRAWN BY: SNG
 CHECKED BY: PTS
 SHEET 118 OF 232

STA. 226+00 TO STA. 230+00

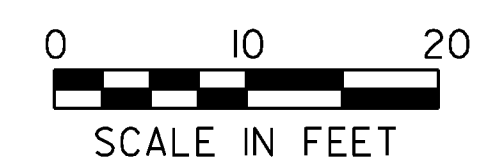

SCALE IN FEET