




231+50

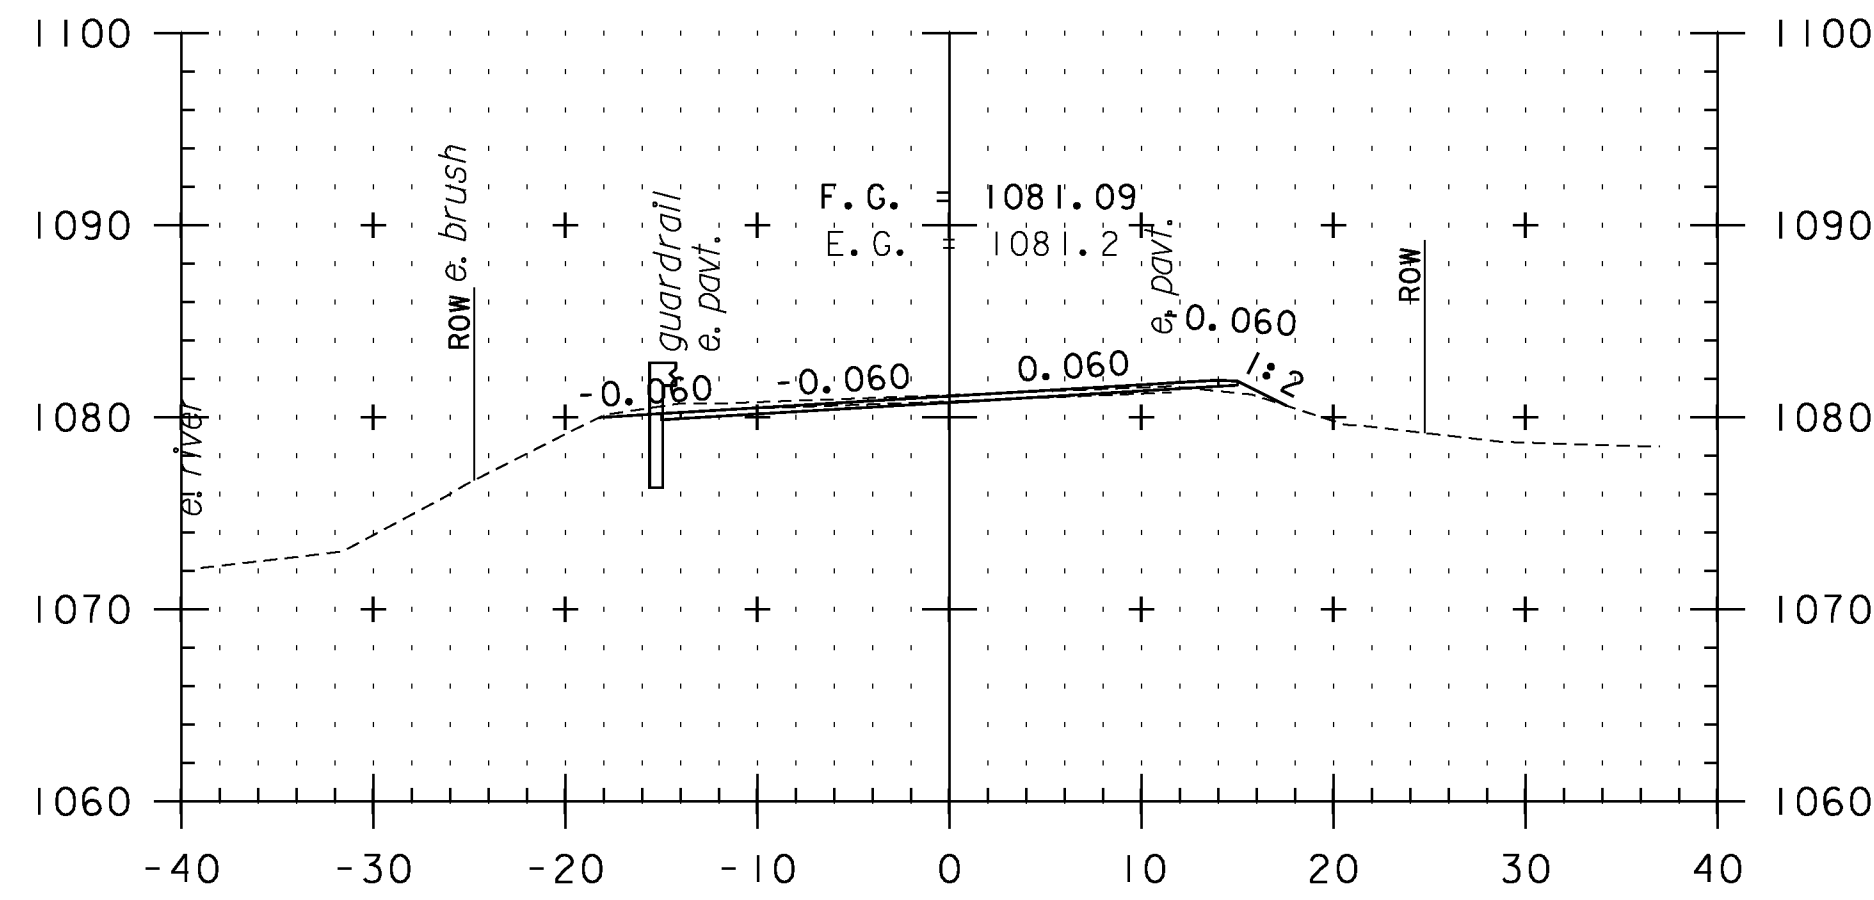


232+50

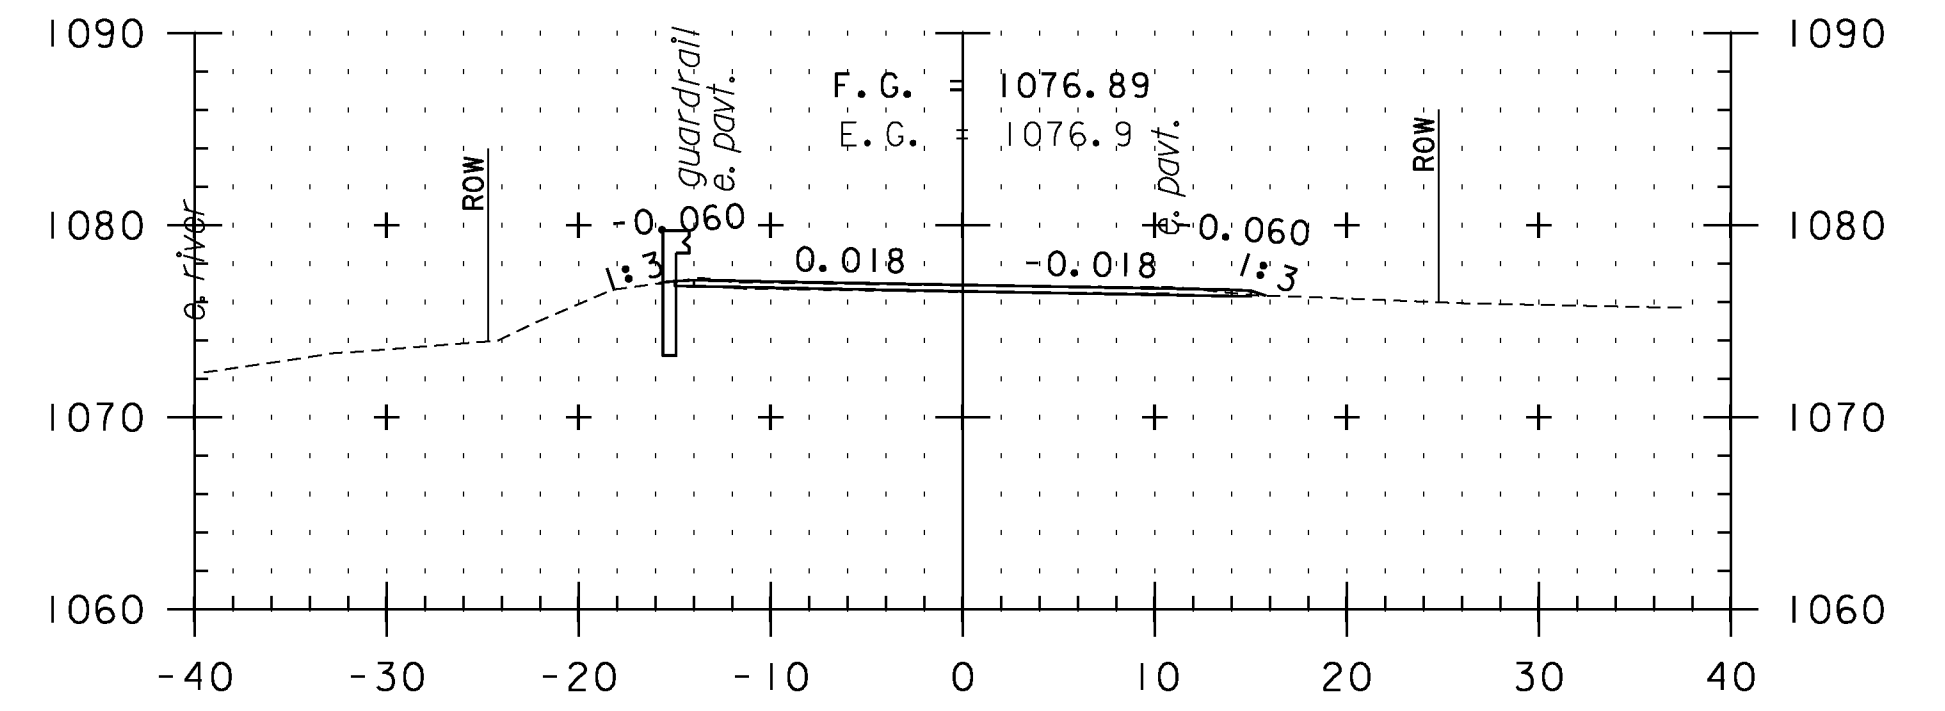


234+00

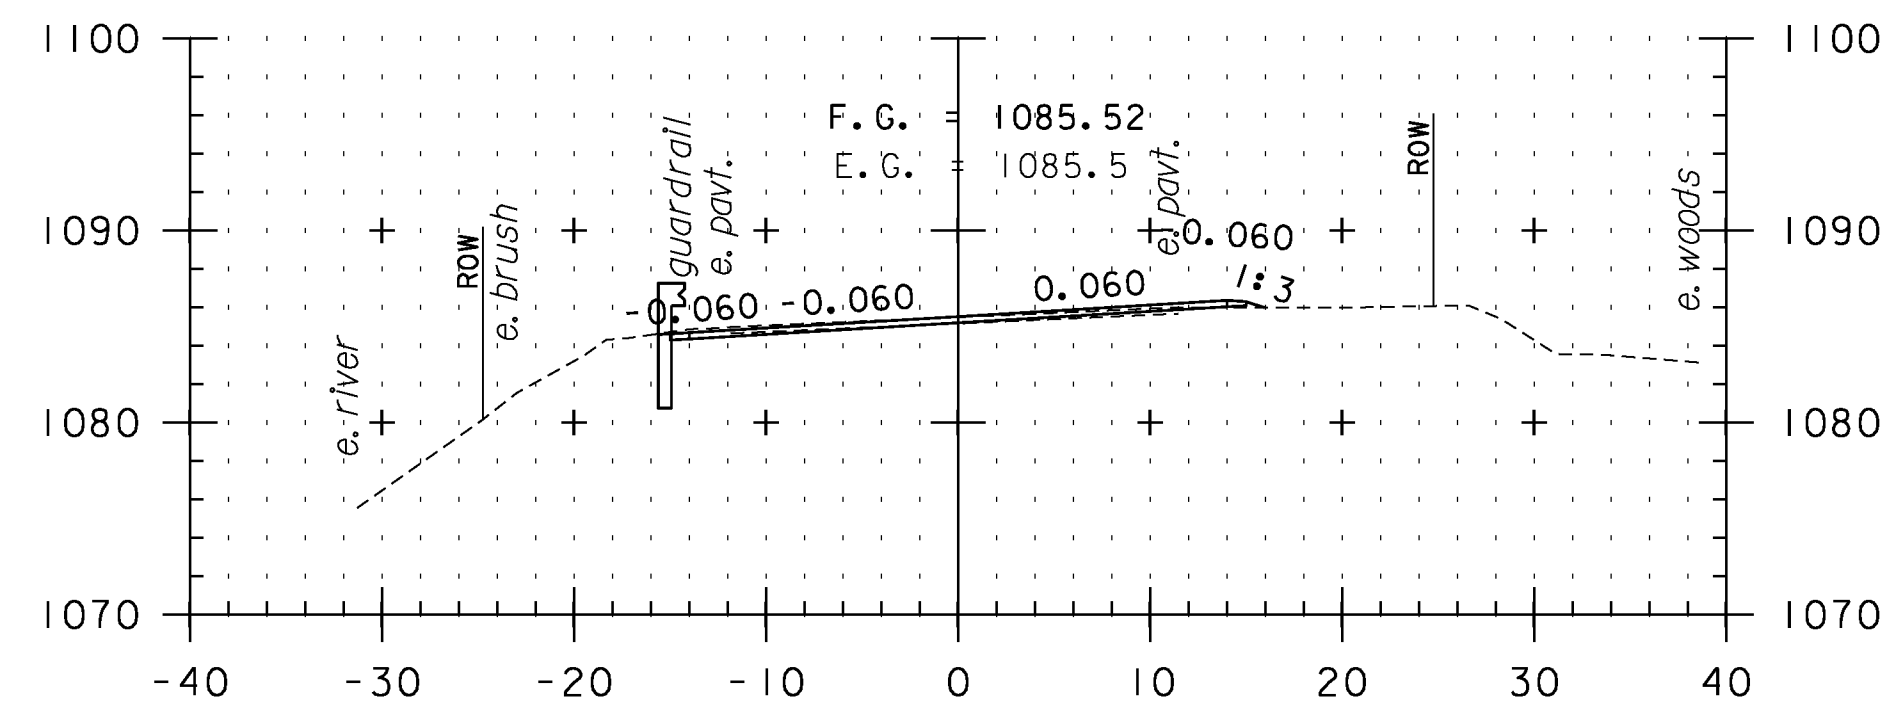


231+00

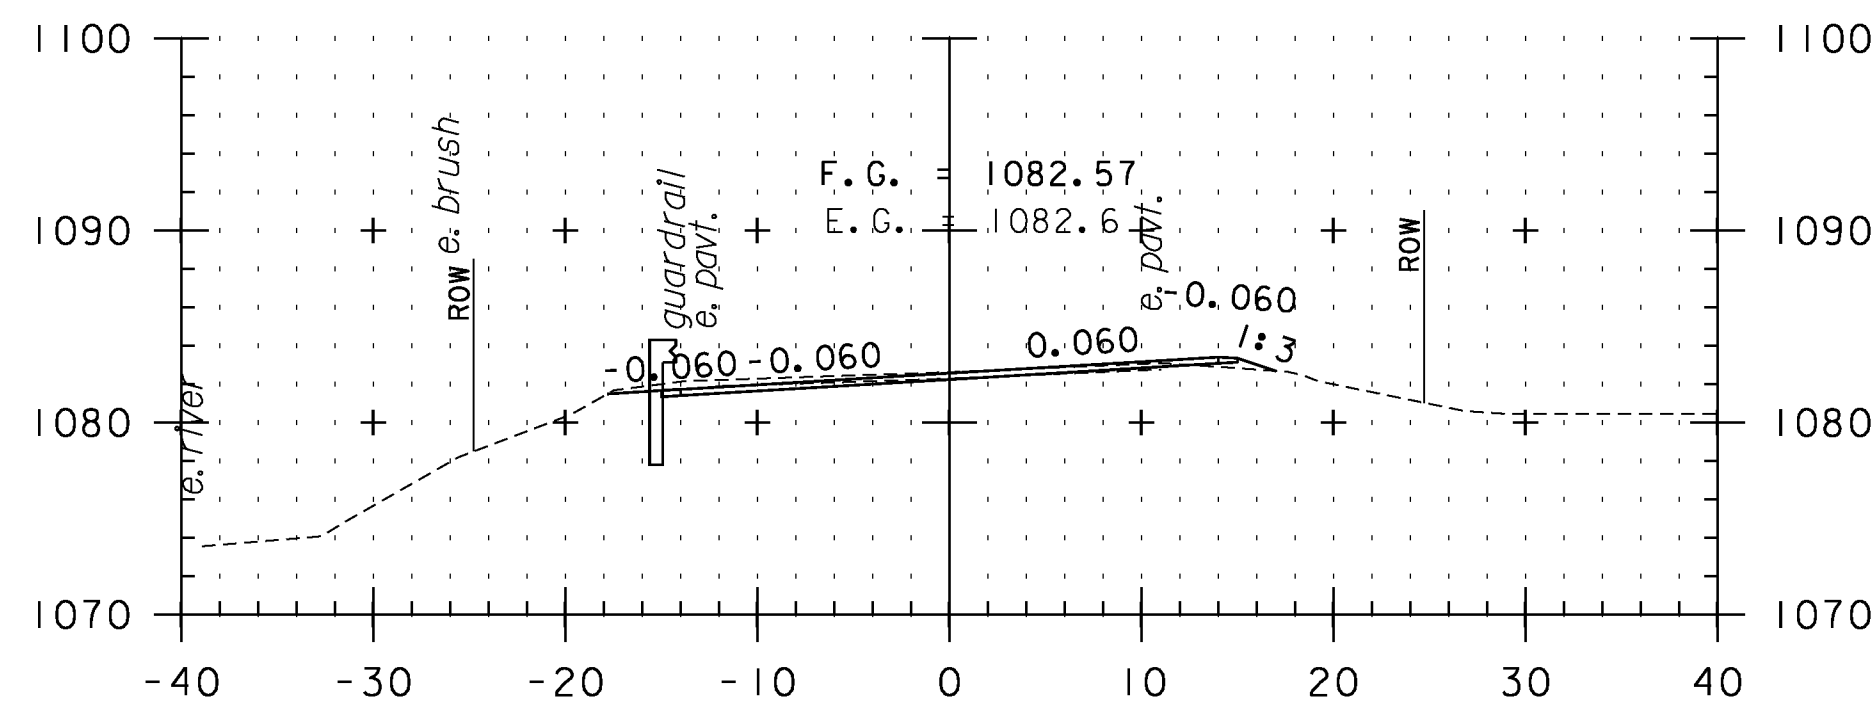


232+00

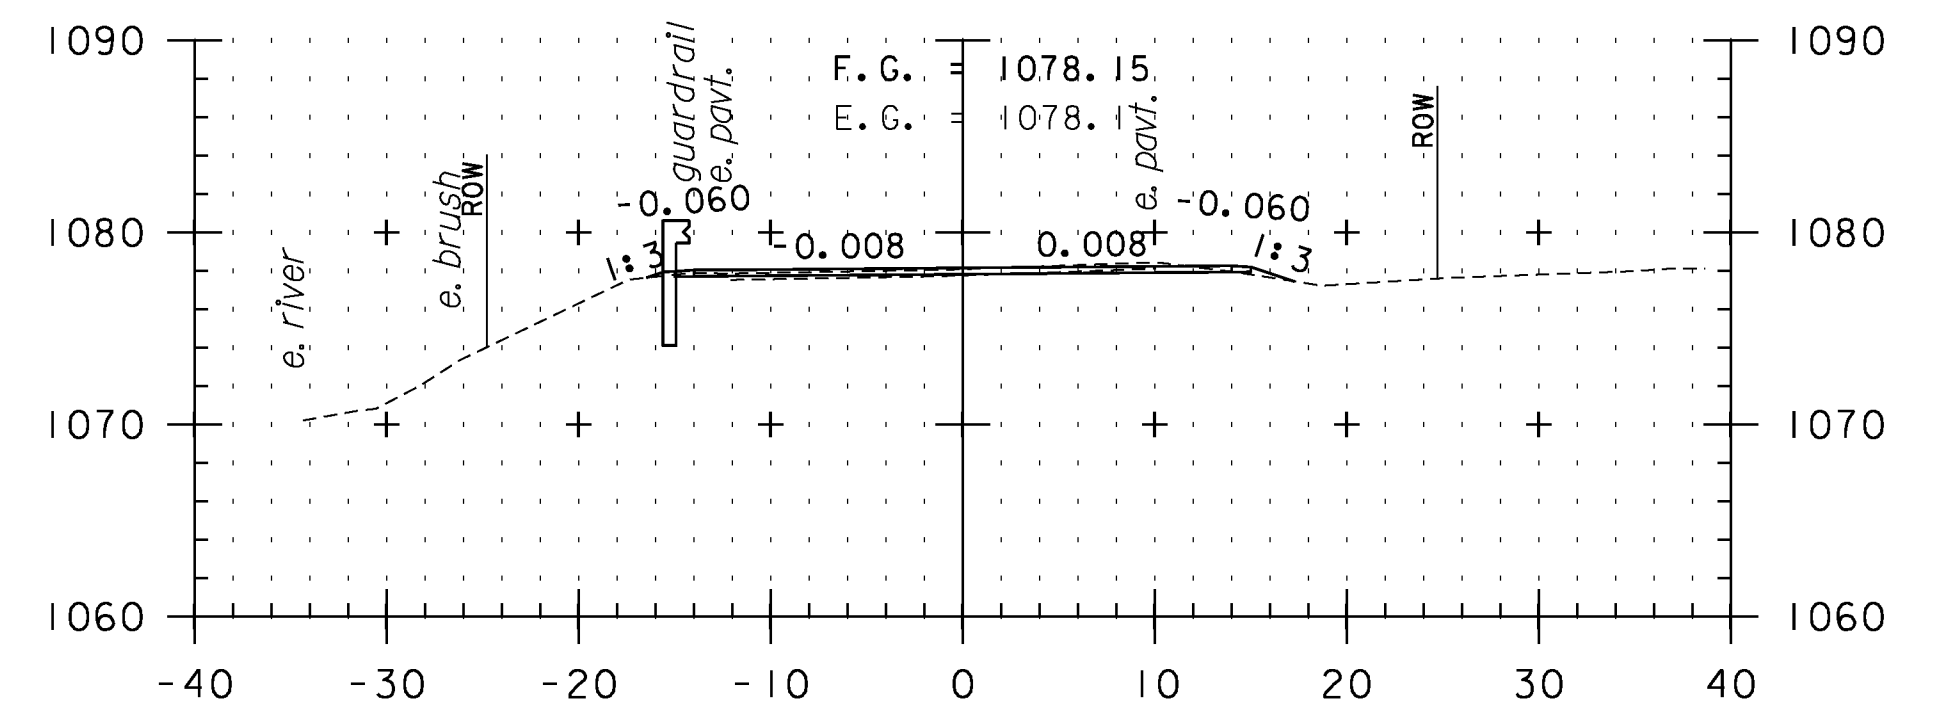


233+50

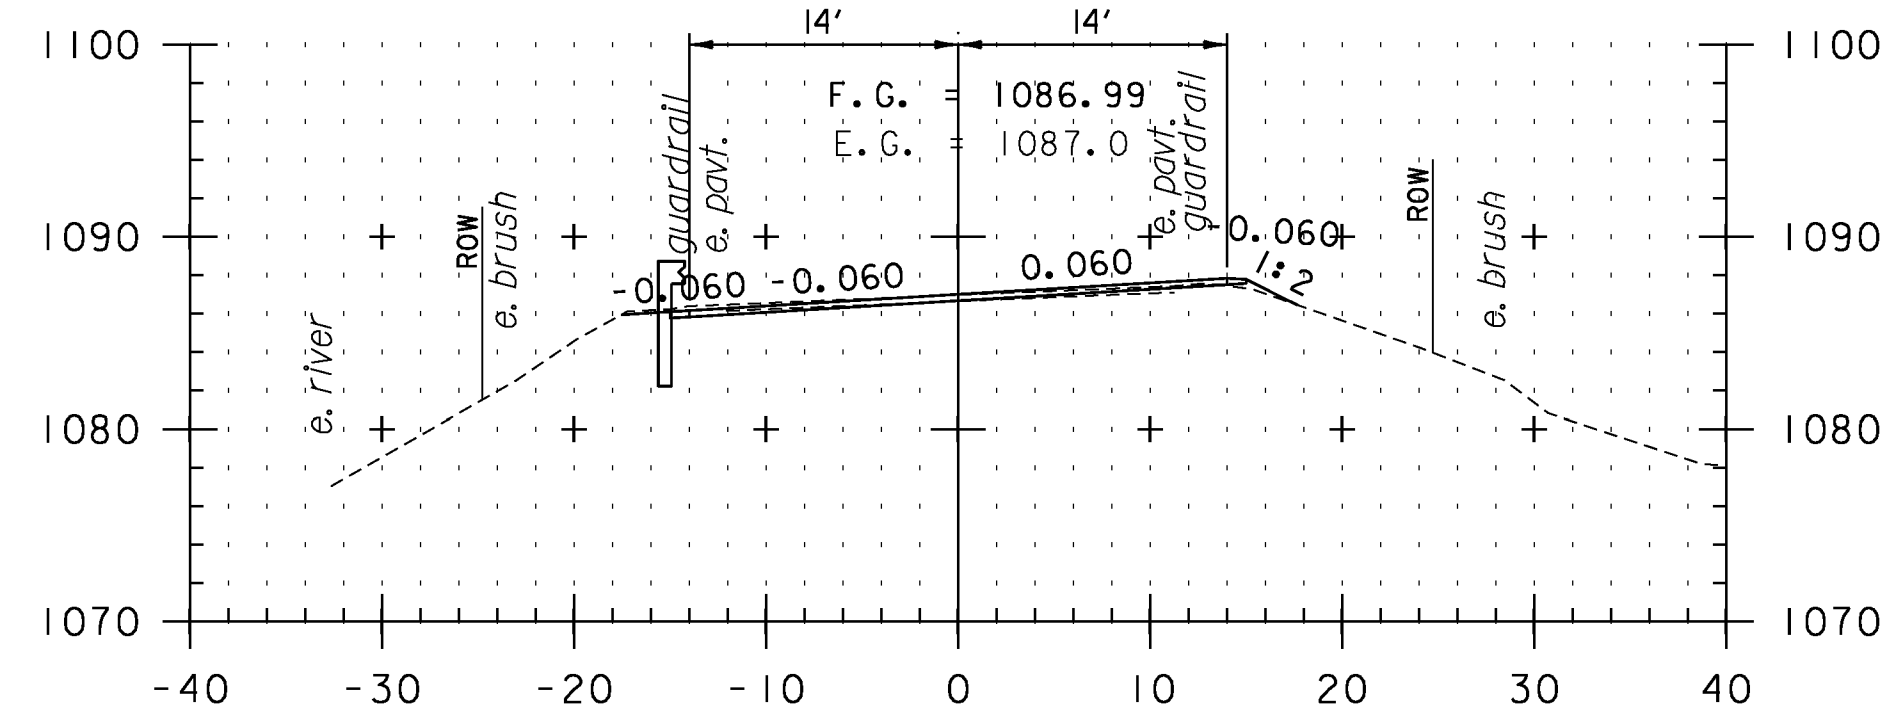

230+50

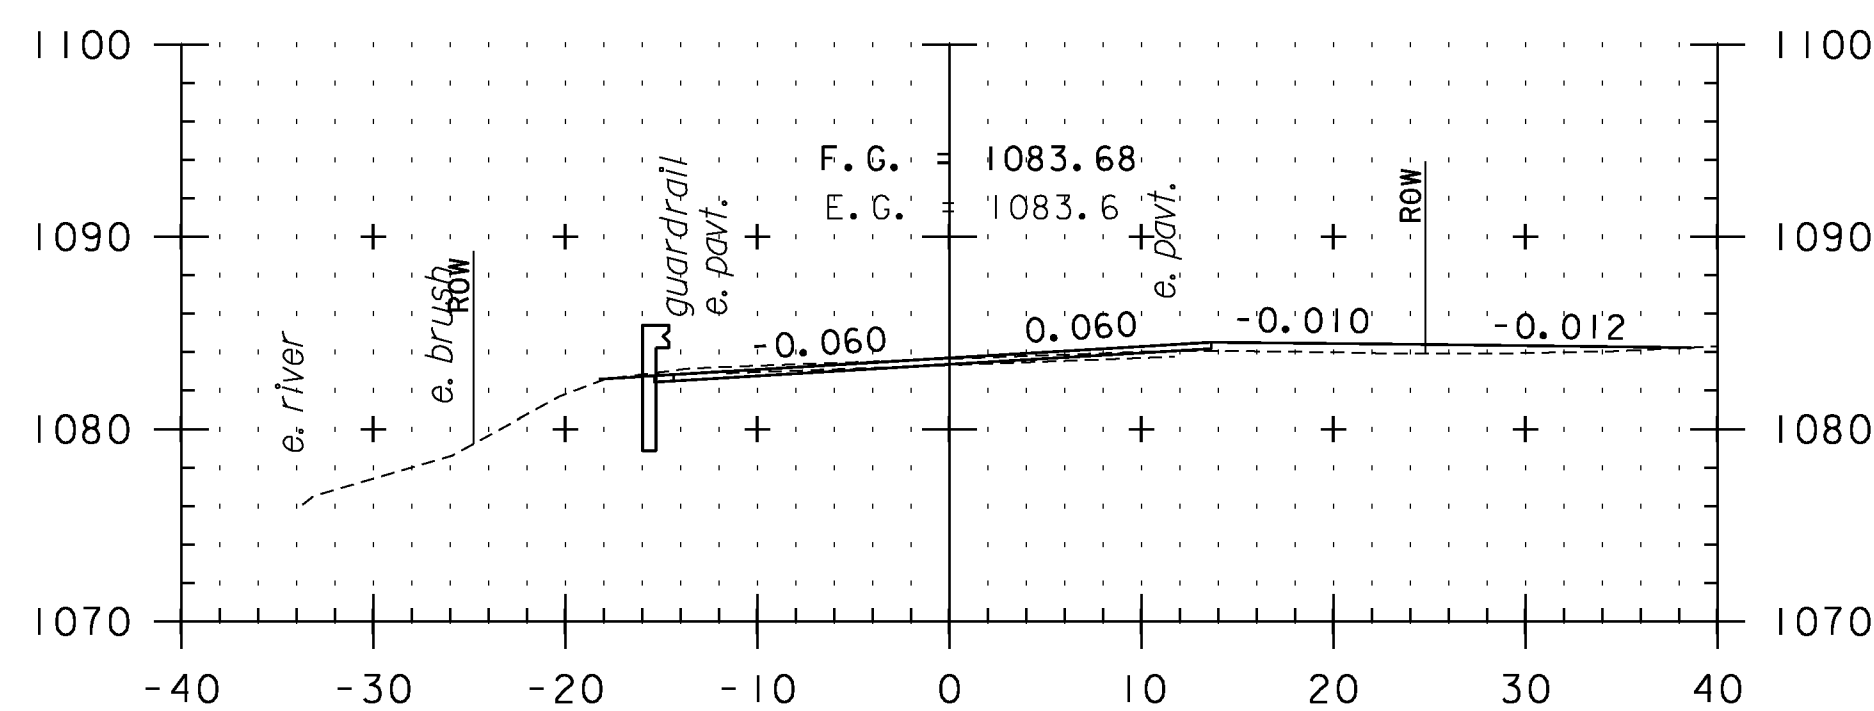

231+63
TH 23

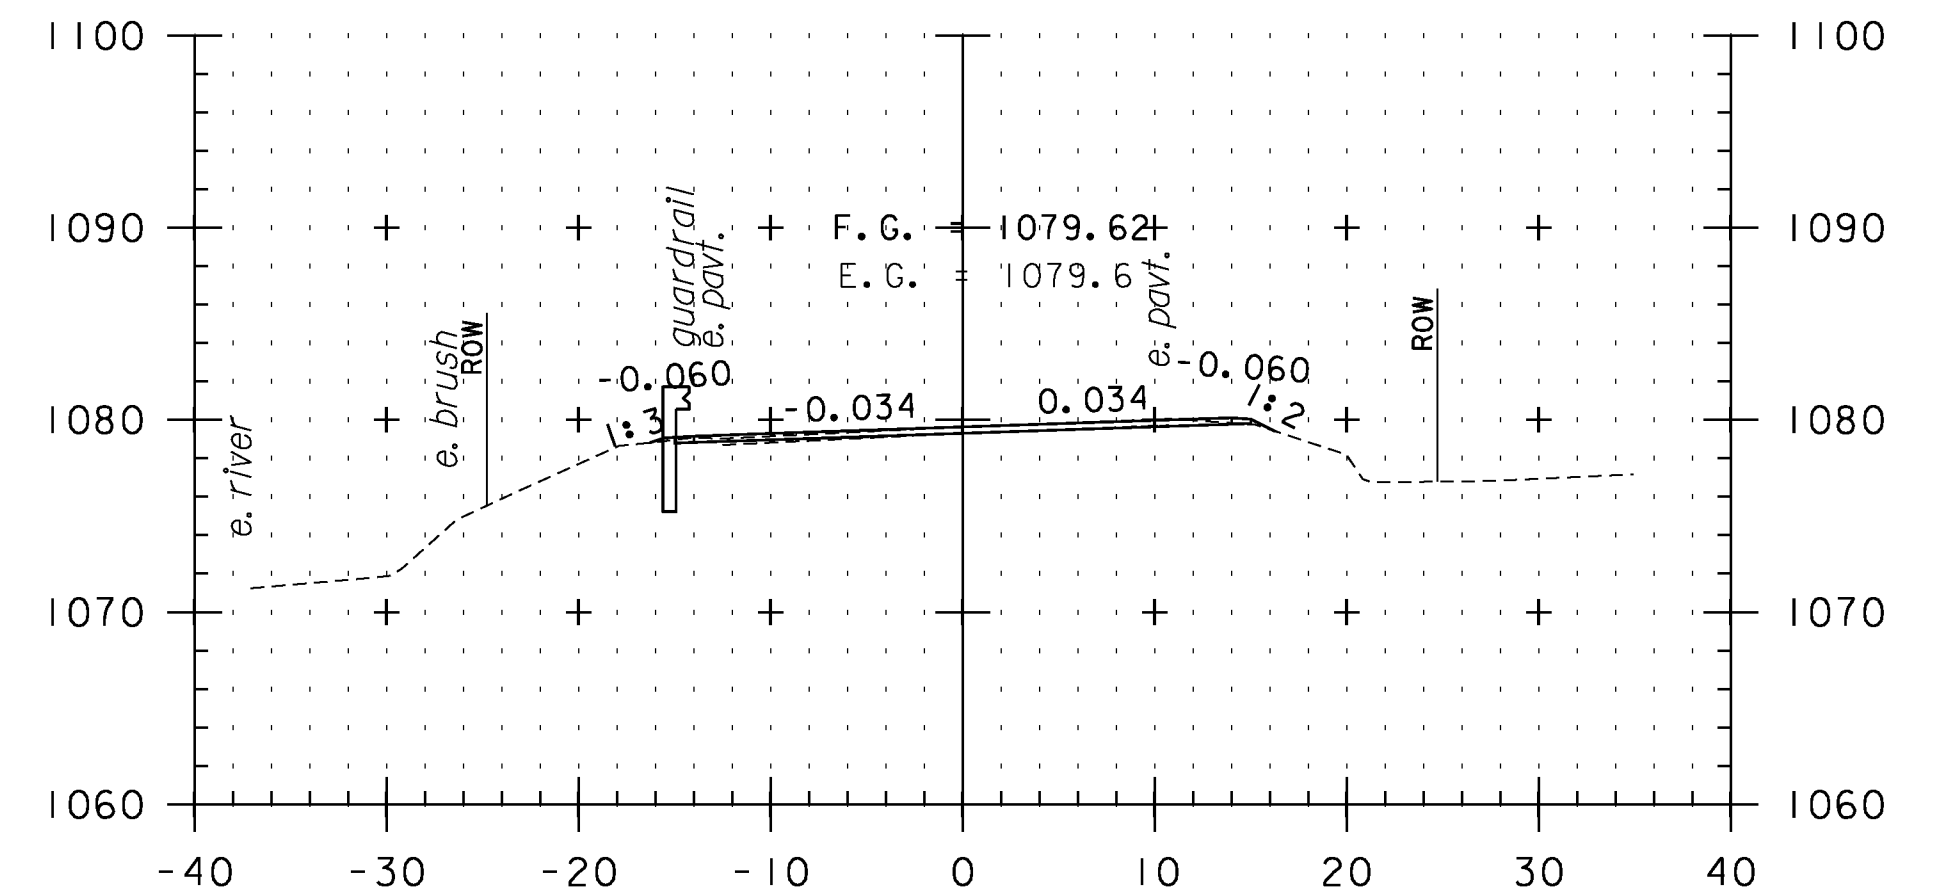

233+00

CROSS SECTION SHEET 11

STA. 230+50 TO STA. 234+00



PROJECT NAME: VERSHIRE-THETFORD	PLOT DATE: 1/29/2013
PROJECT NUMBER: STP 2911(I)	DRAWN BY: SNG
FILE NAME: pl0c224.dgn	CHECKED BY: PTS
PROJECT LEADER: PTS	SHEET 119 OF 232
DESIGNED BY: NLL	
IPARM FILE NAME: IOC224.I19	