




235+50

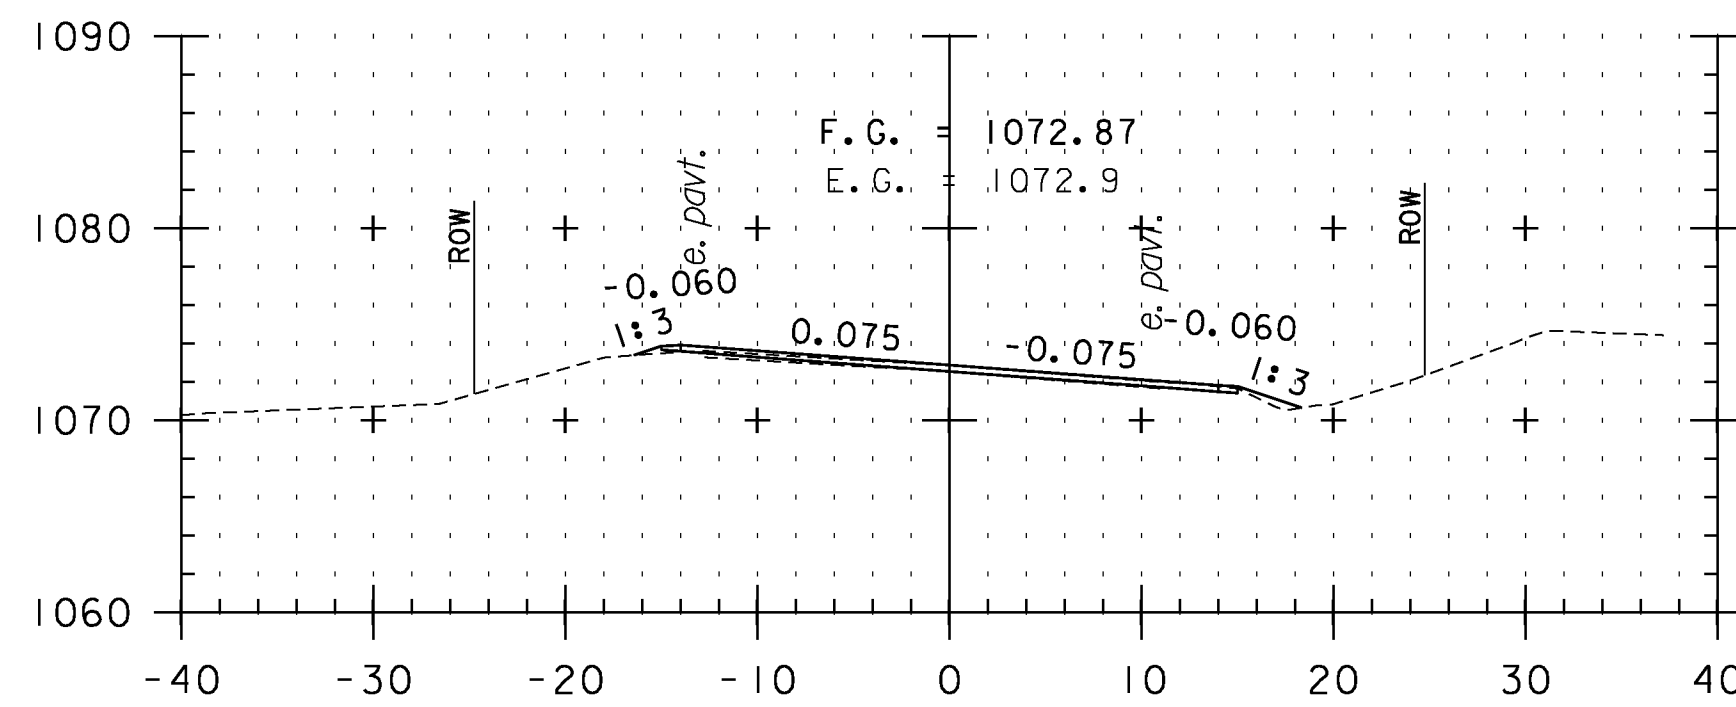


237+00

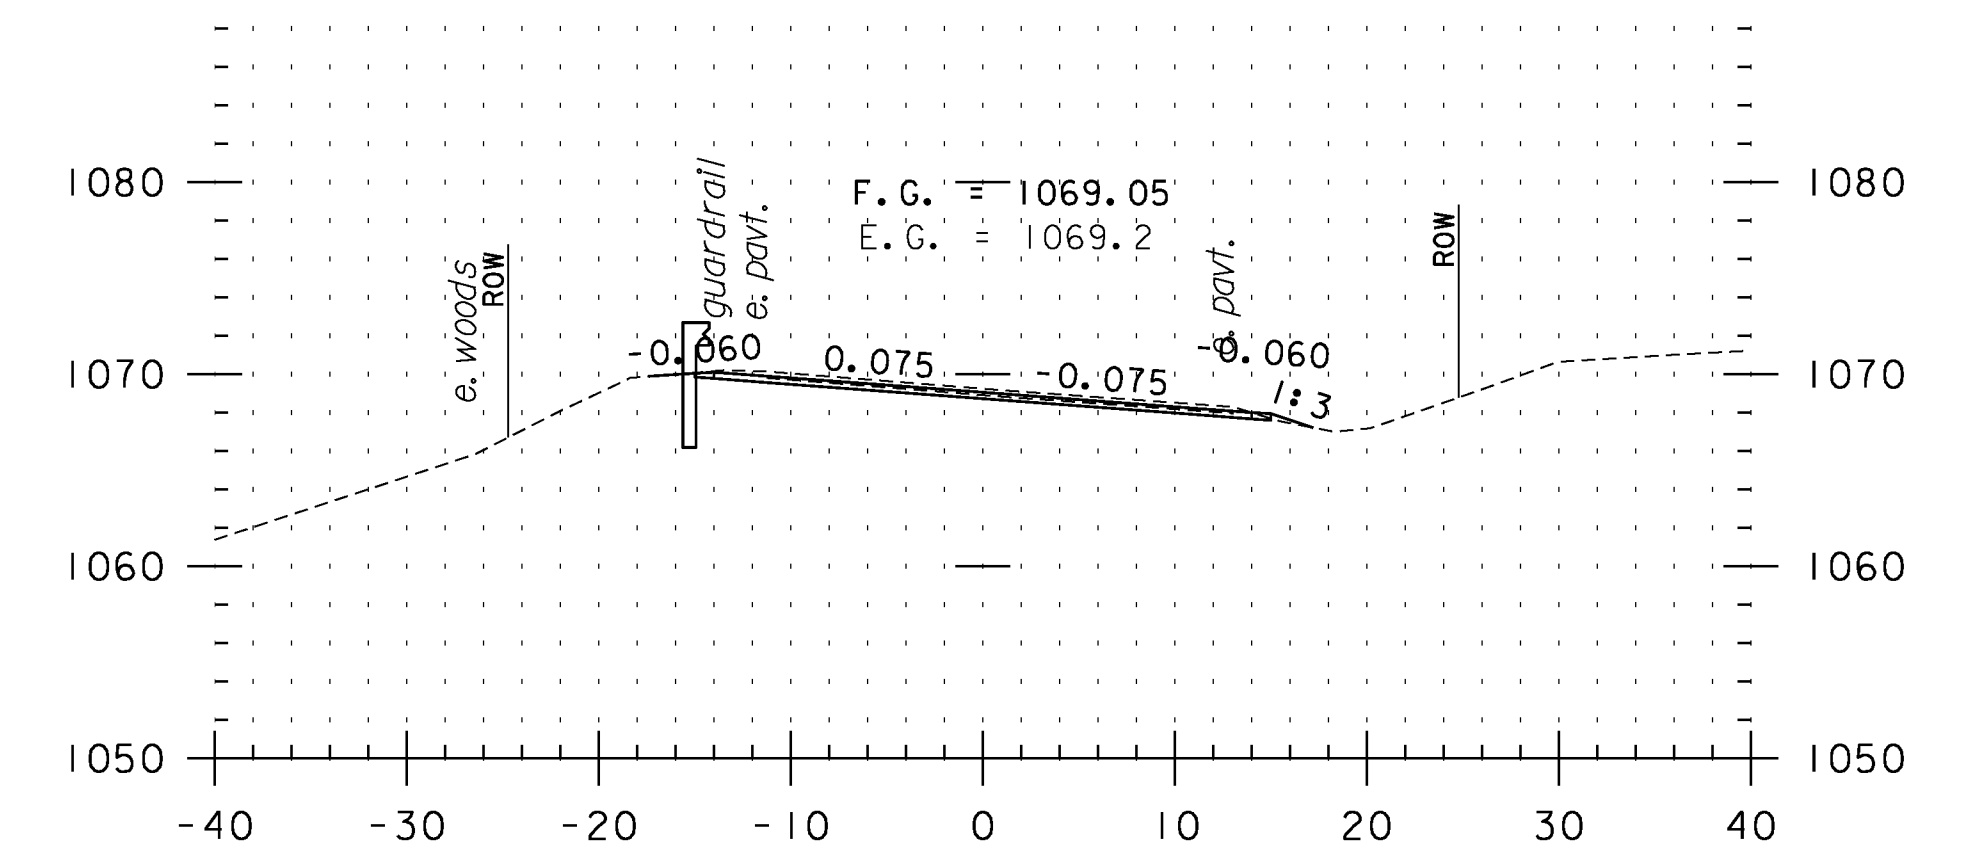


238+50

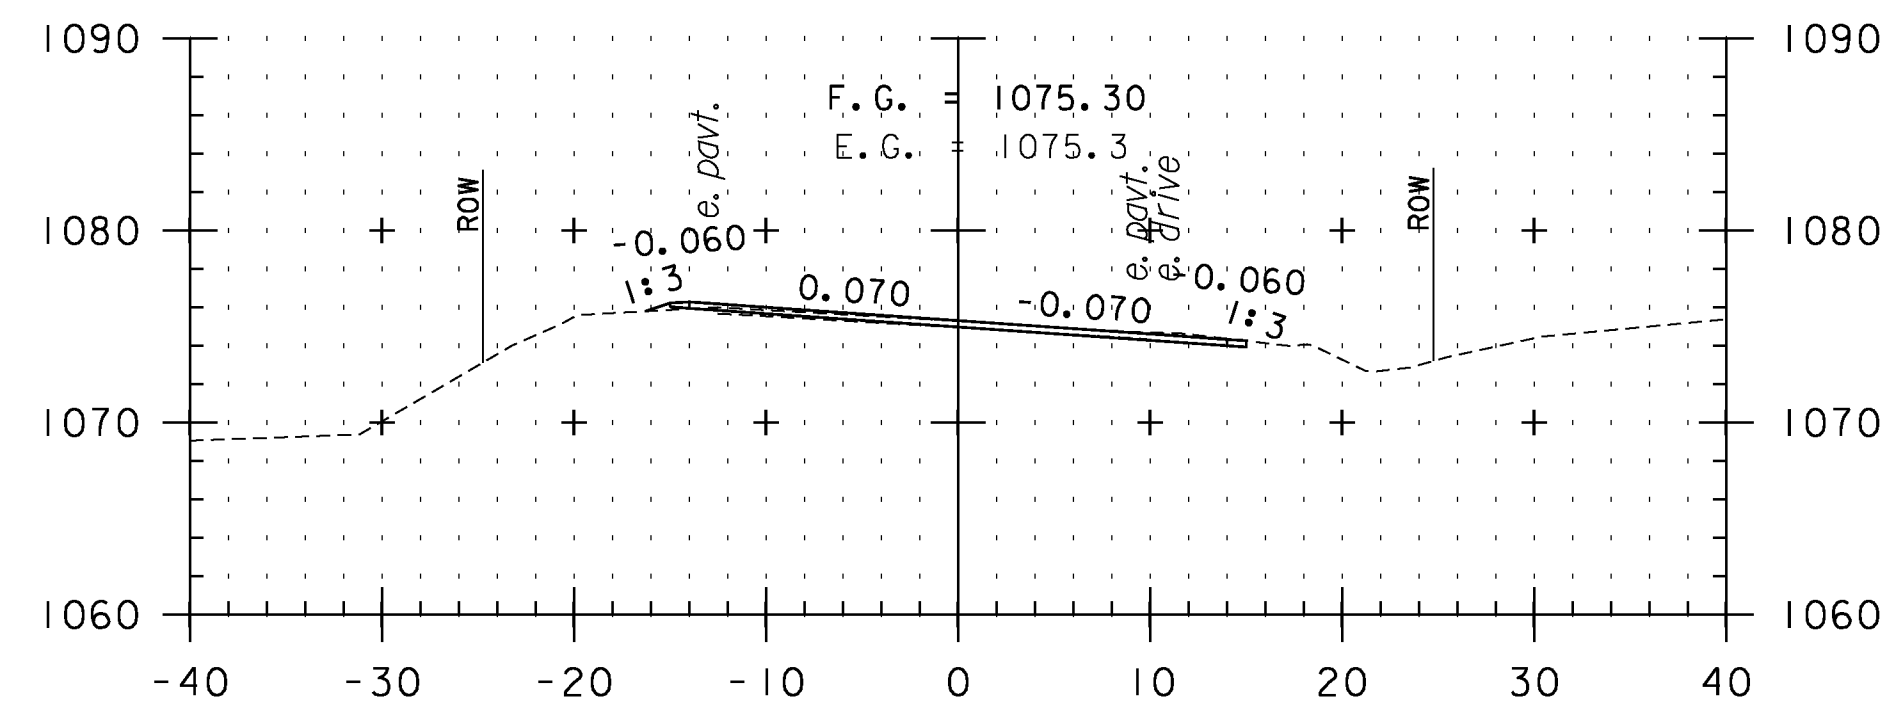


235+00

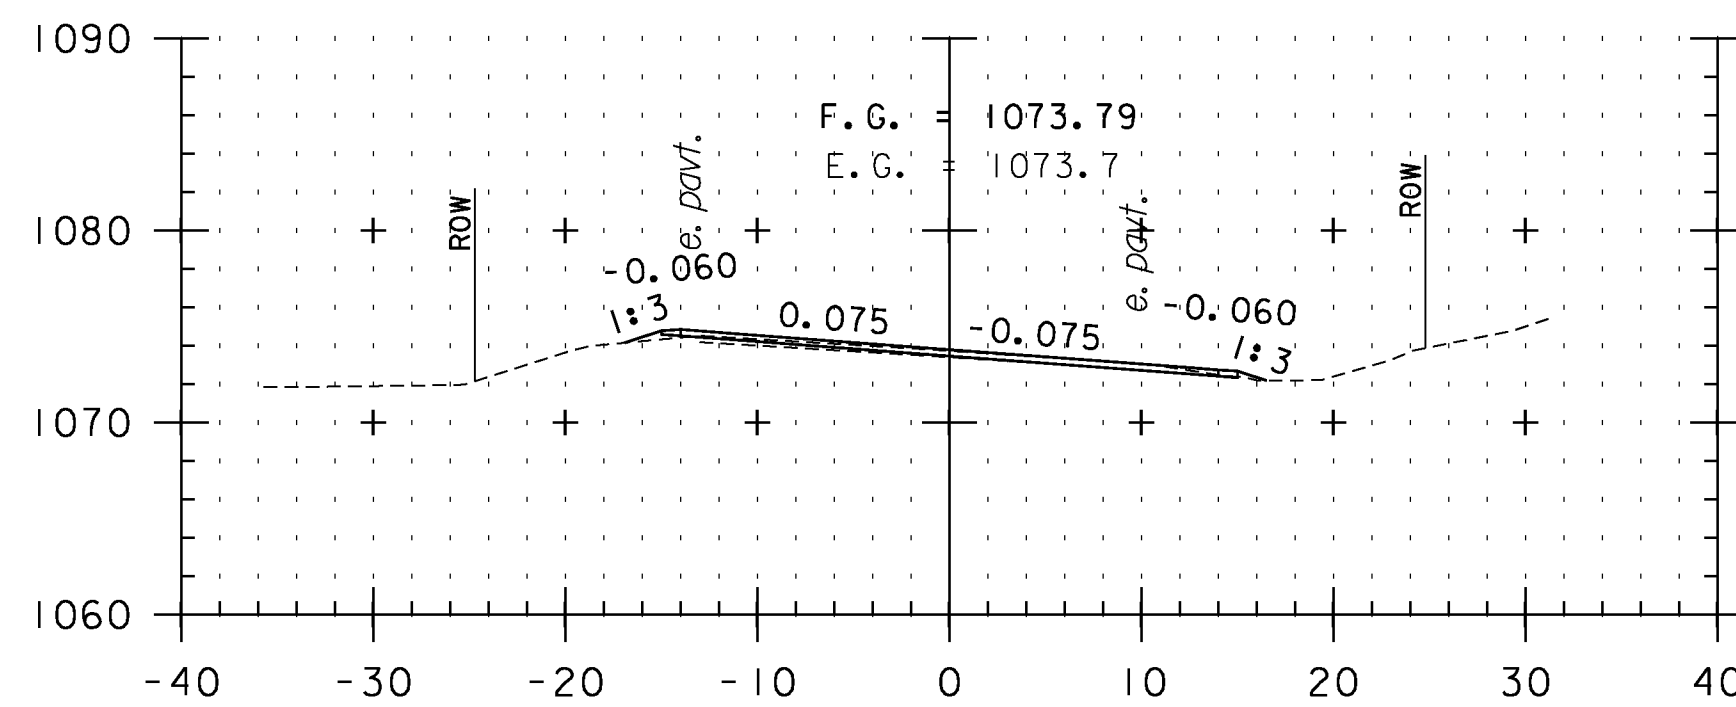


236+50

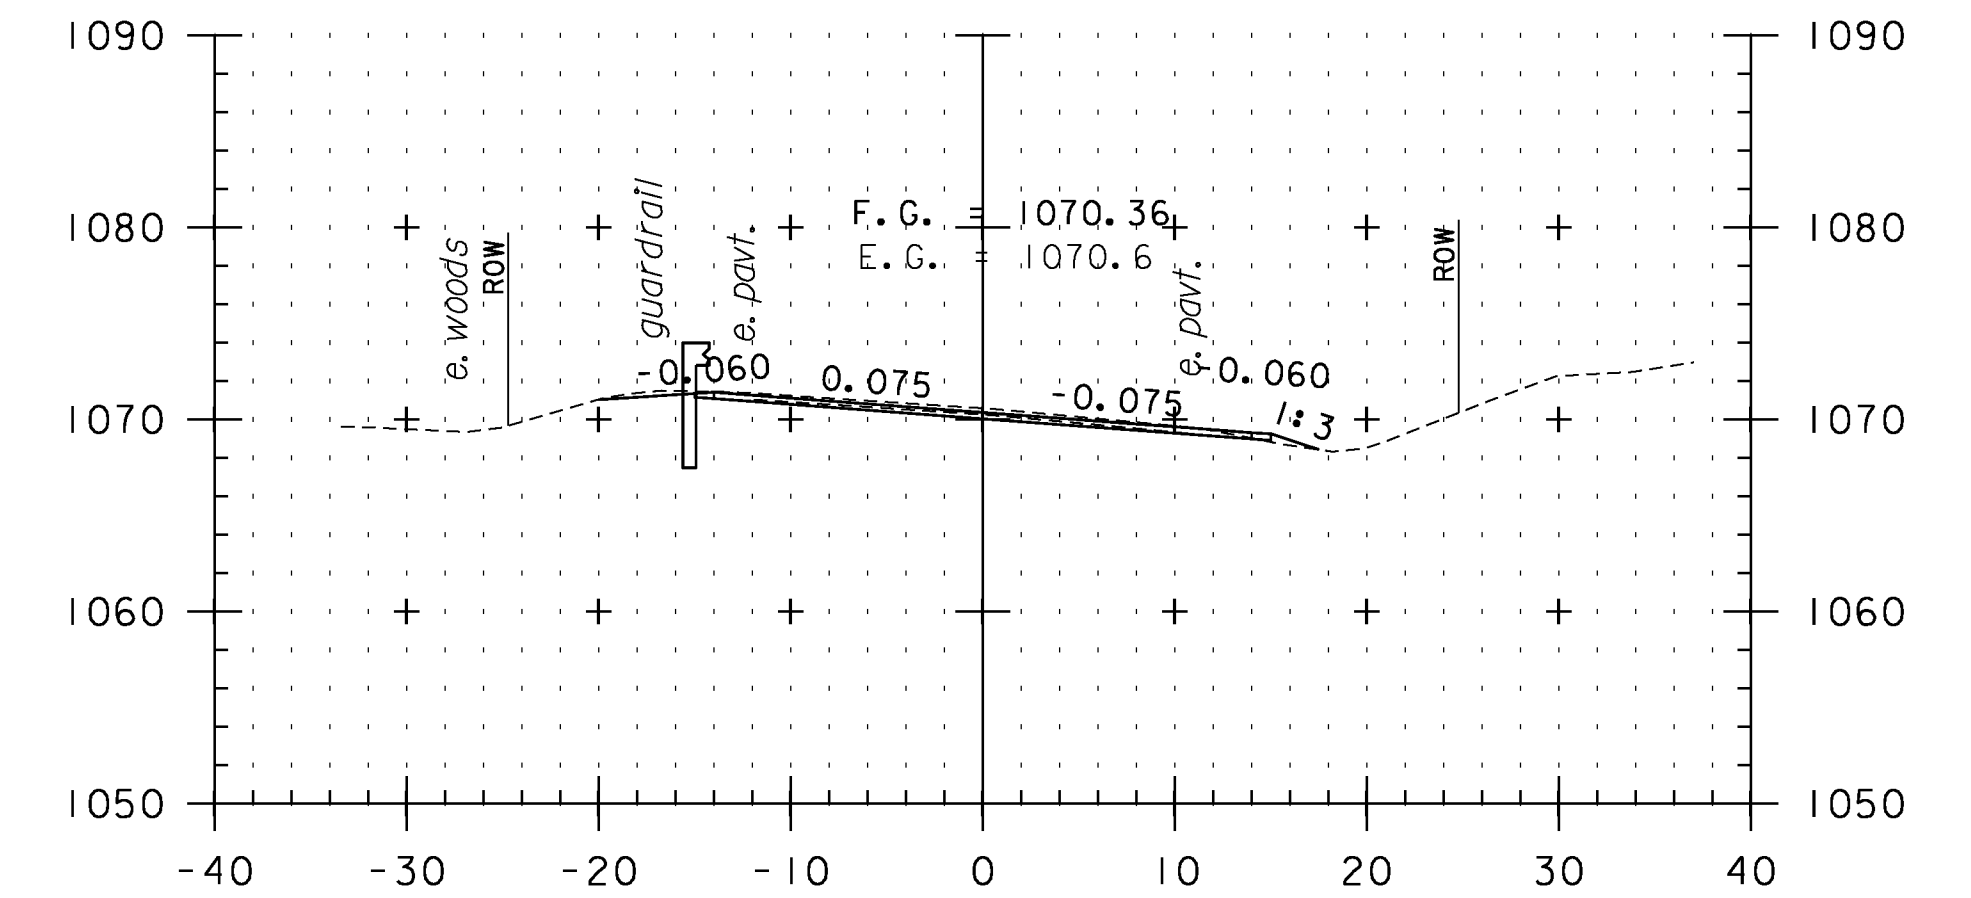


238+00

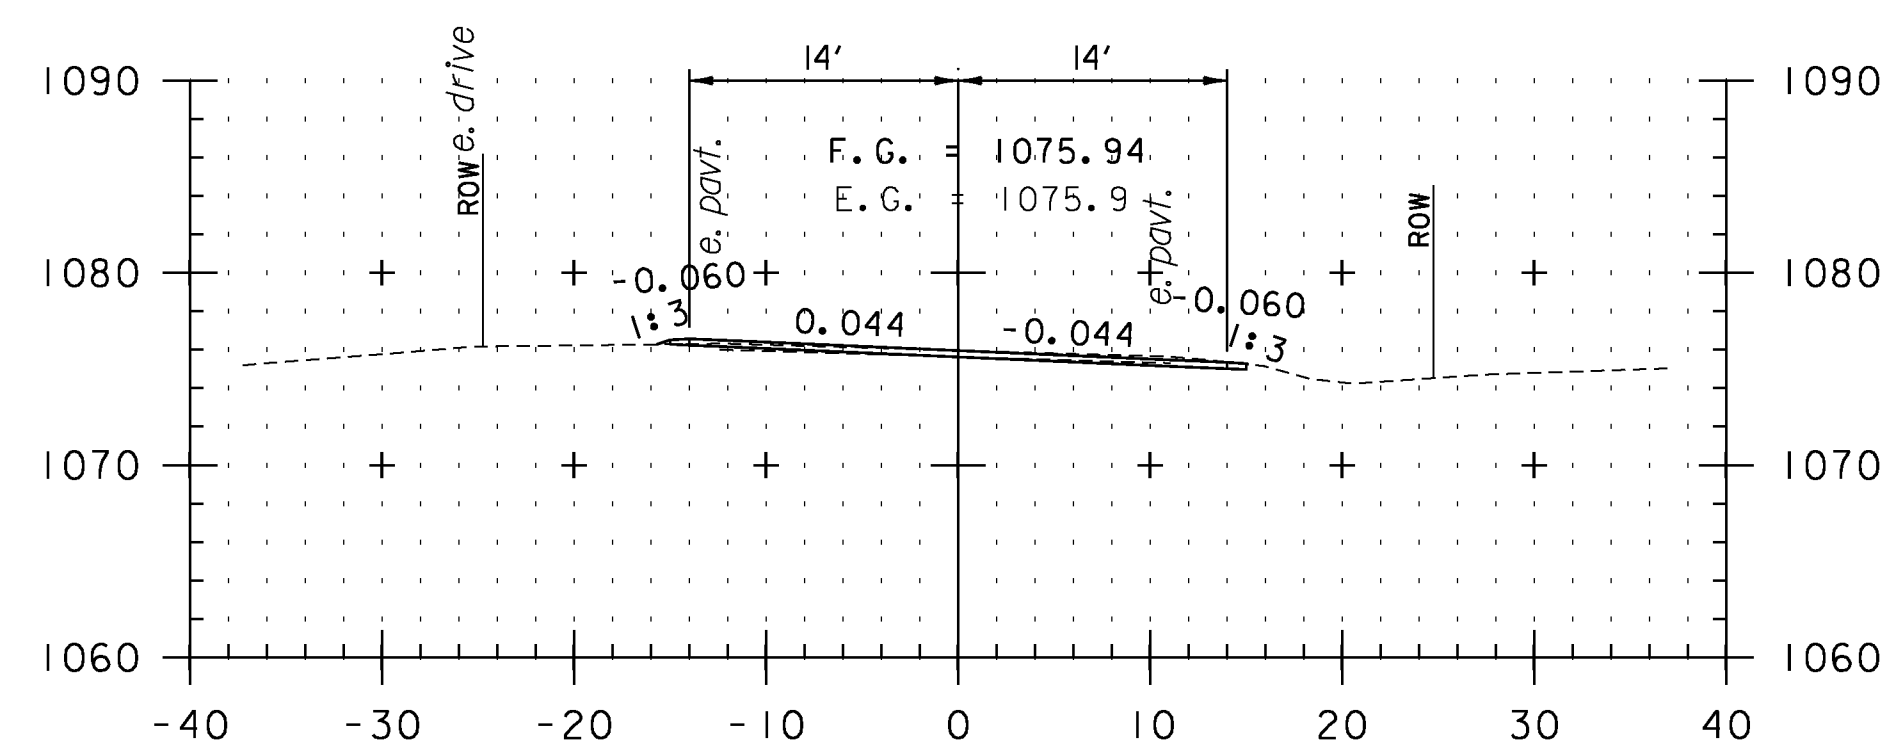

234+50

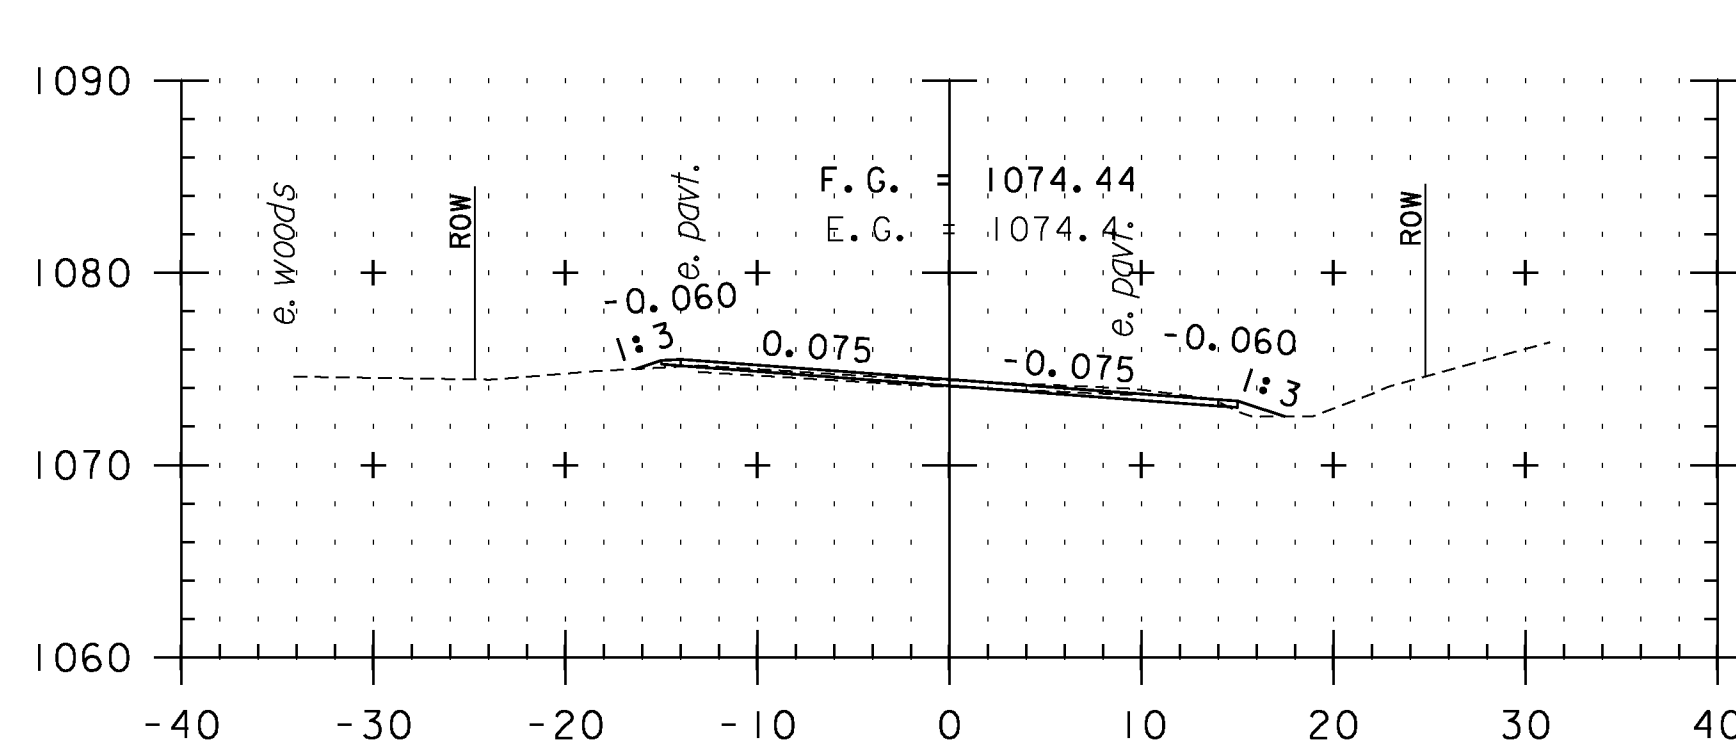


236+00

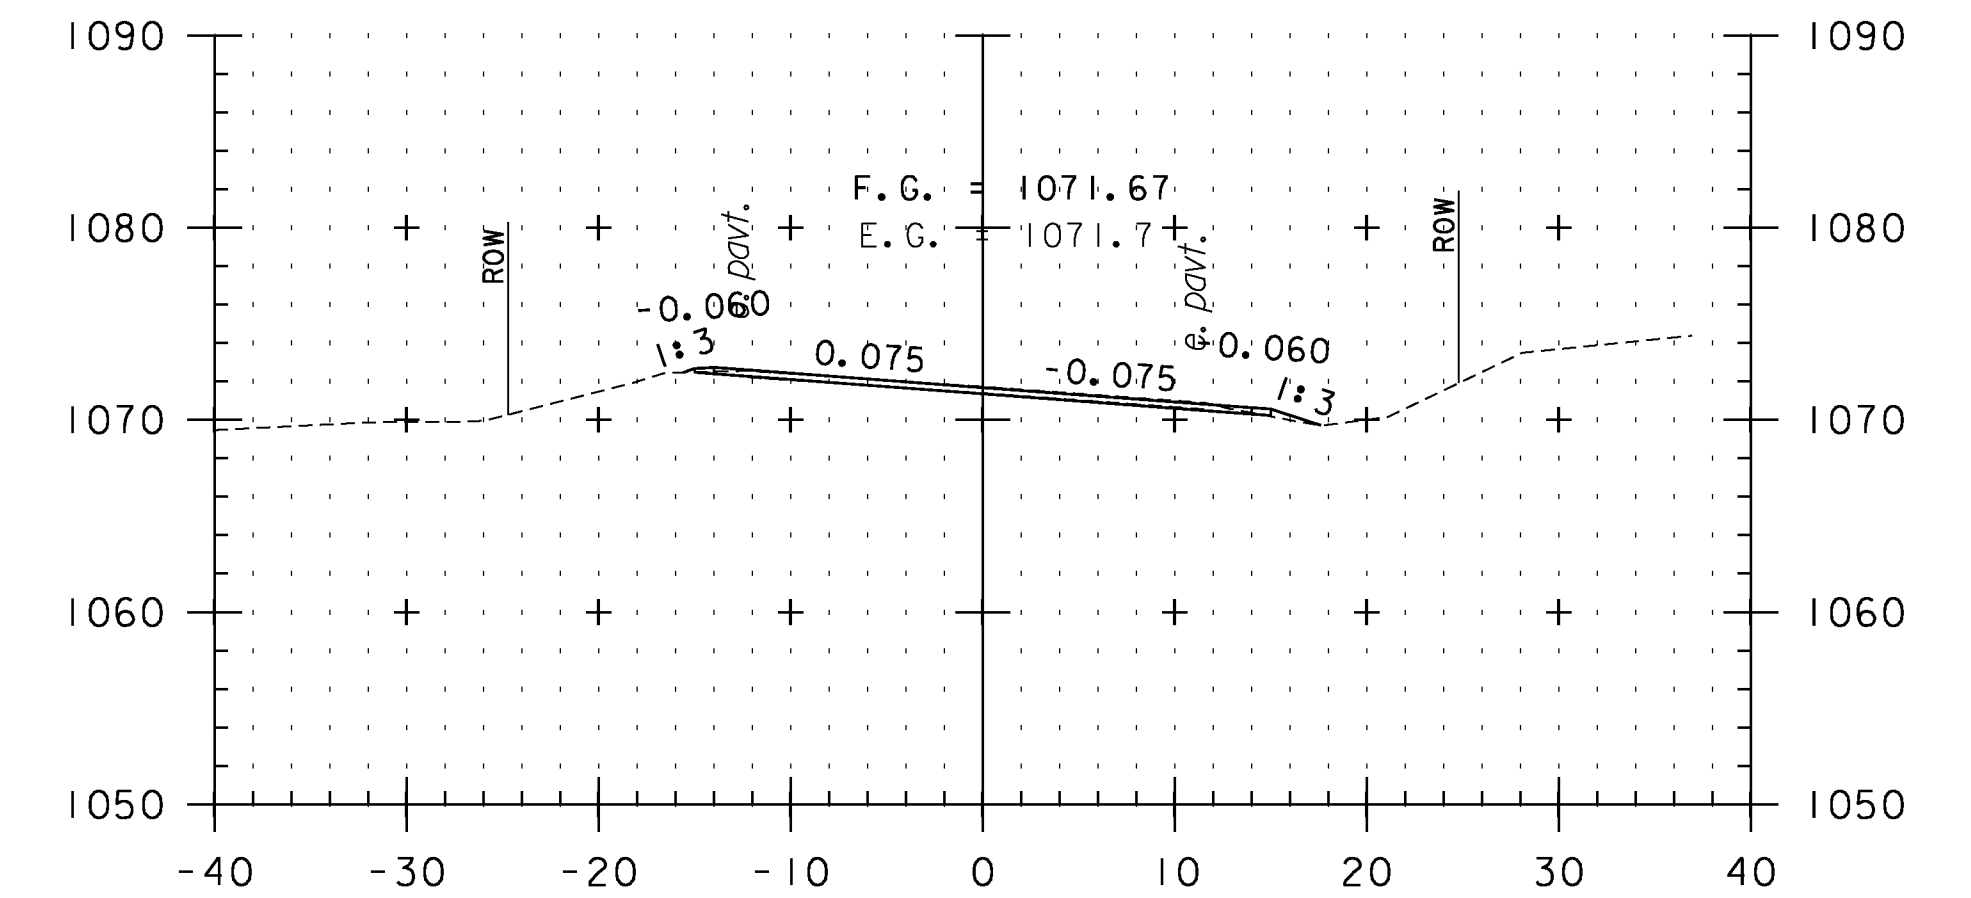

237+50

**CROSS SECTION SHEET 12**

STA. 234+50 TO STA. 238+50

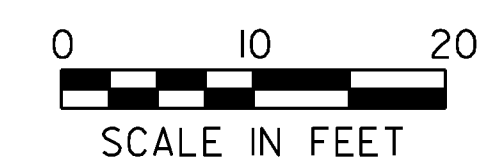

PROJECT NAME: VERSHIRE-THETFORD	PLOT DATE: 1/29/2013
PROJECT NUMBER: STP 2911(I)	DRAWN BY: SNG
FILE NAME: pl0c224.dgn	CHECKED BY: PTS
PROJECT LEADER: PTS	SHEET 120 OF 232
DESIGNED BY: NLL	
IPARM FILE NAME: IOC224_I20	