




240+00

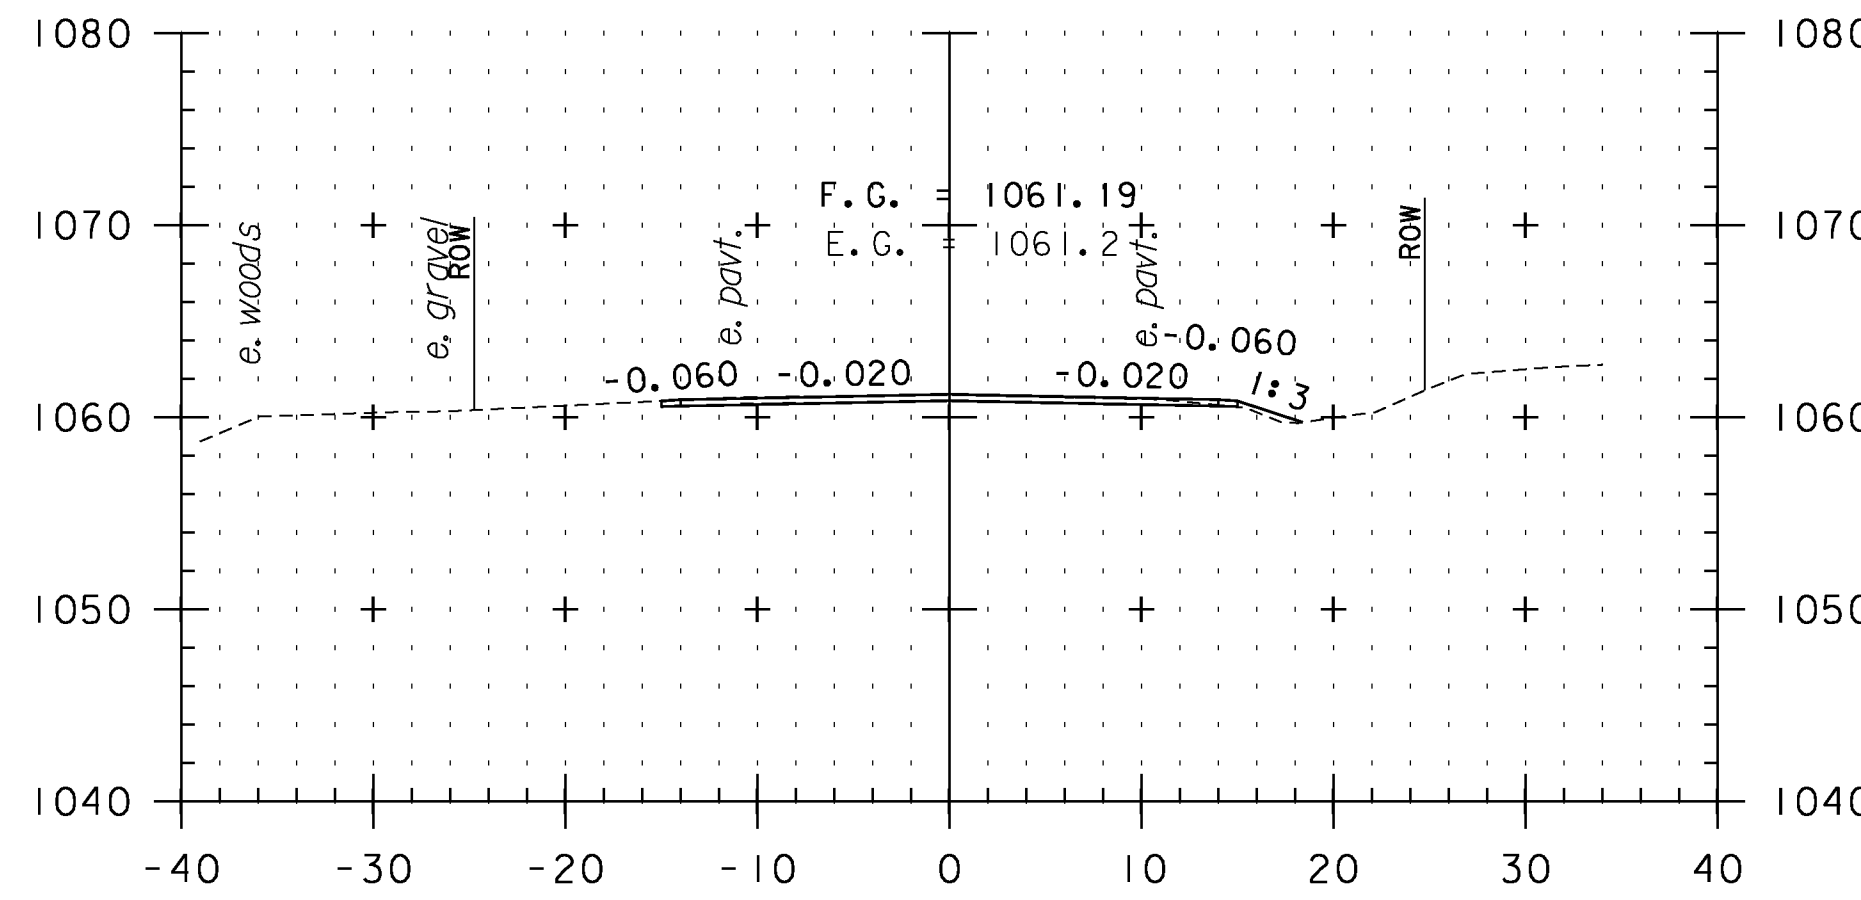


241+50

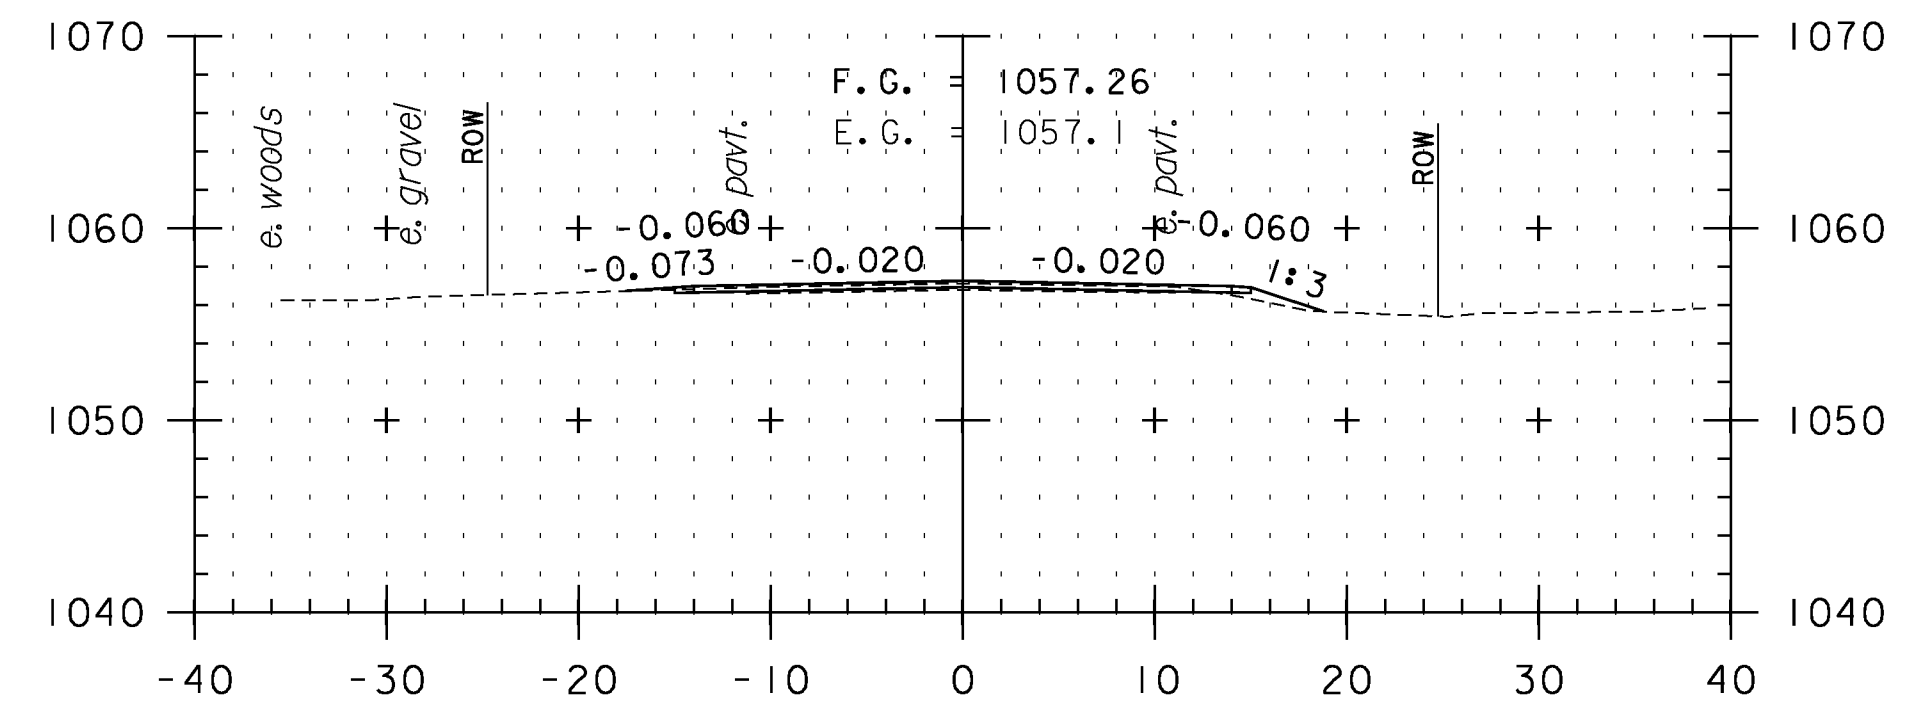


243+00

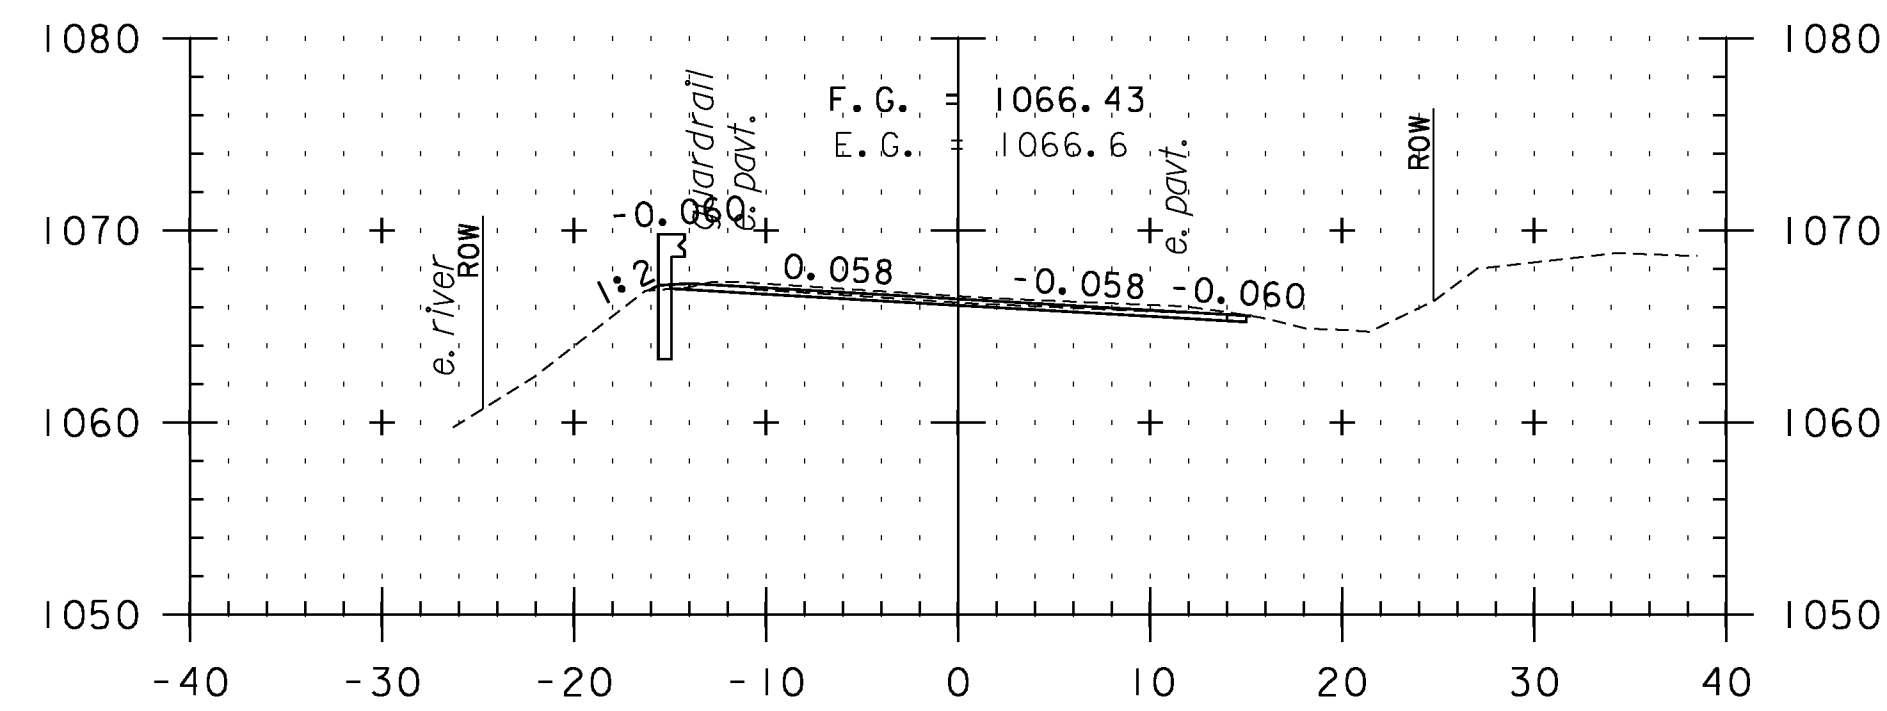


239+50

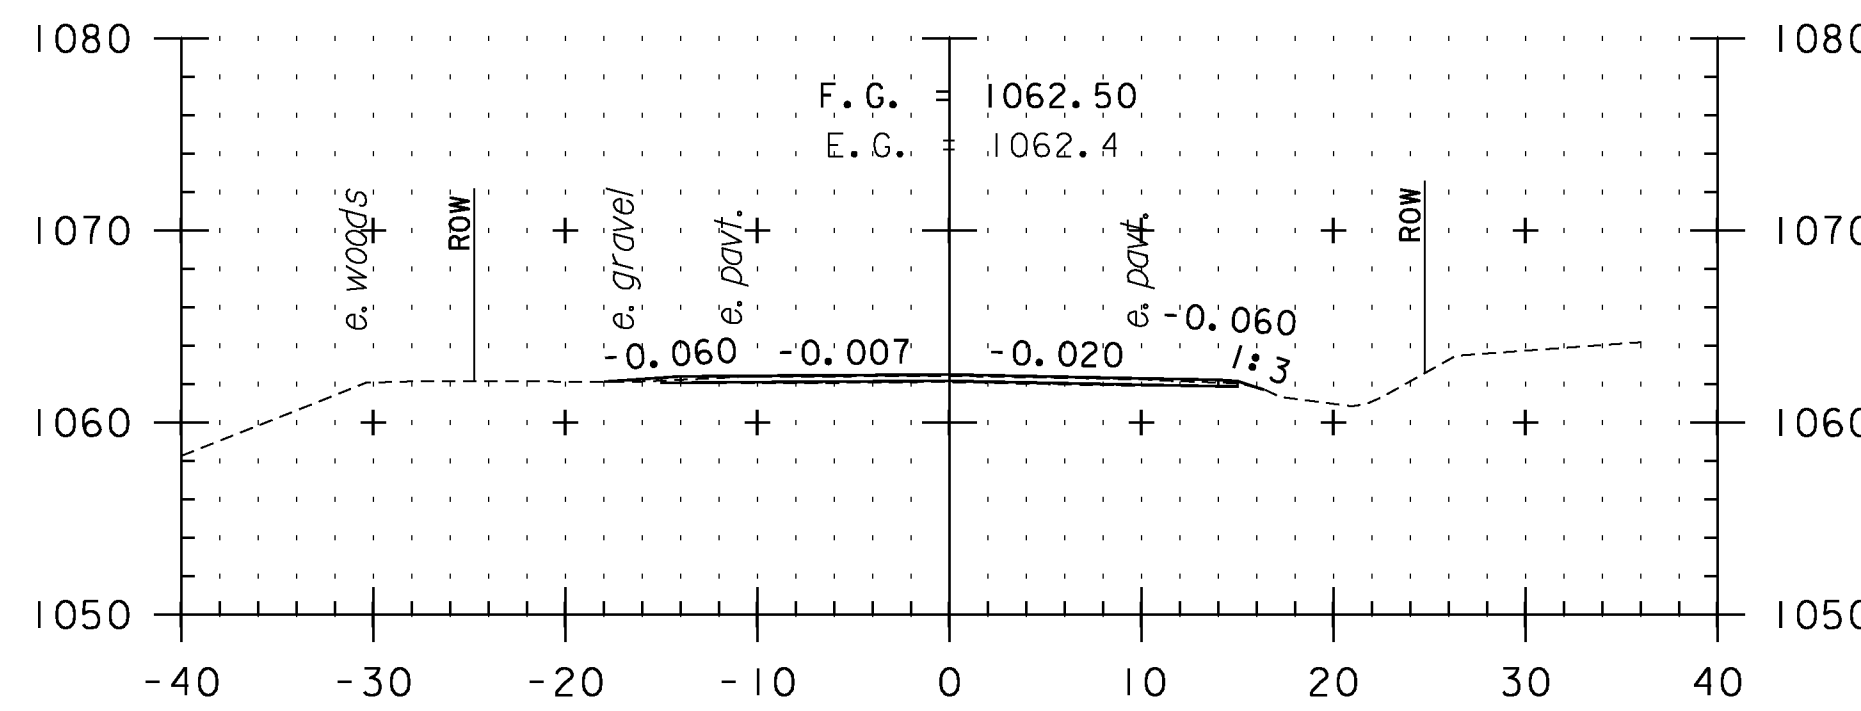


241+00

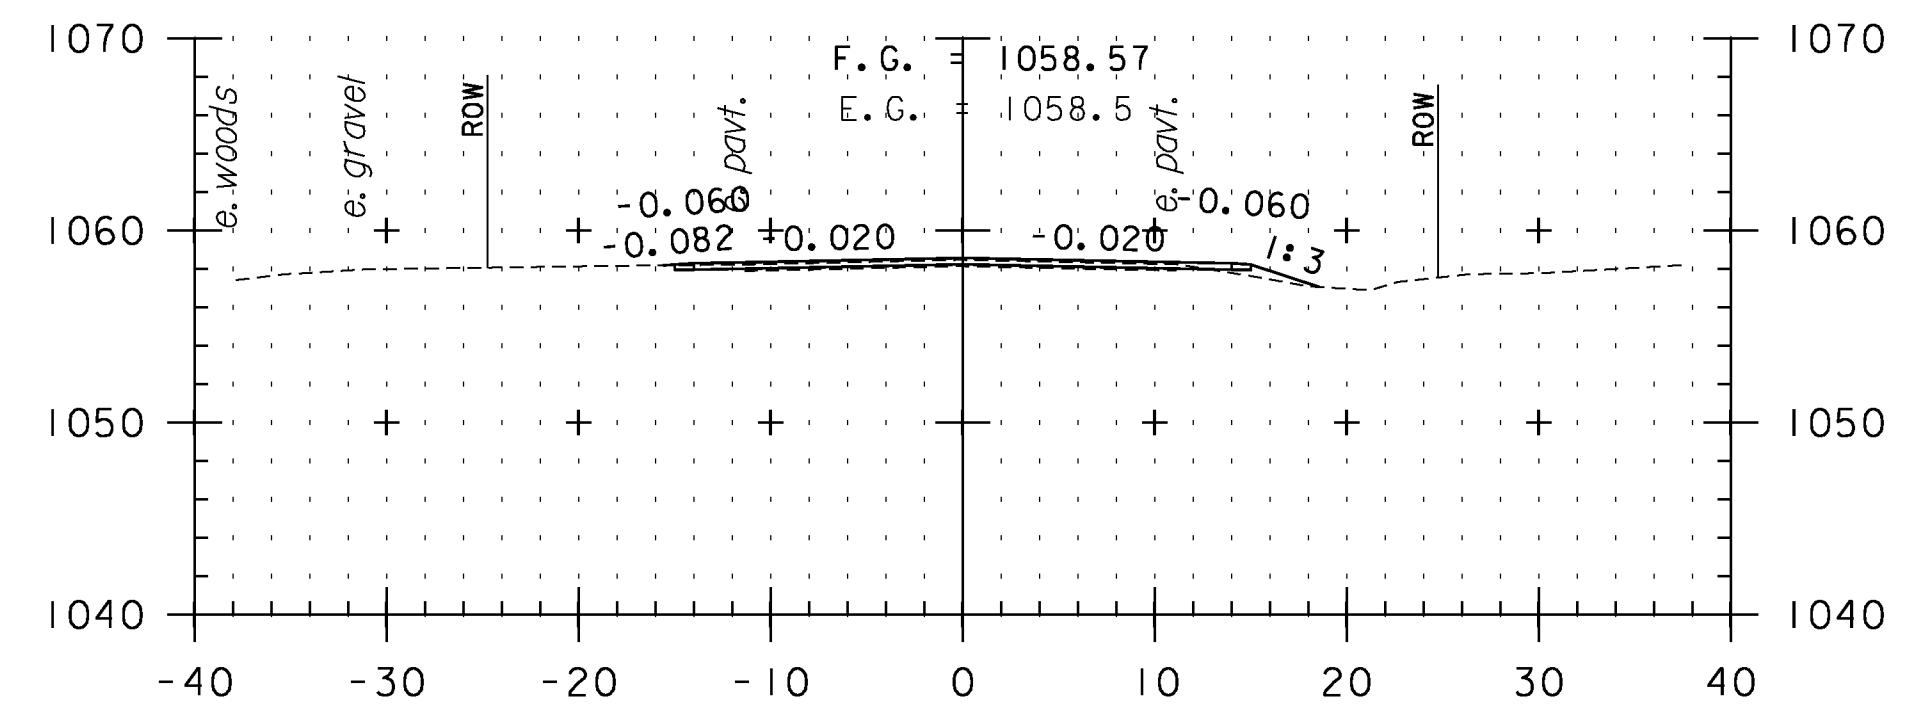


242+50

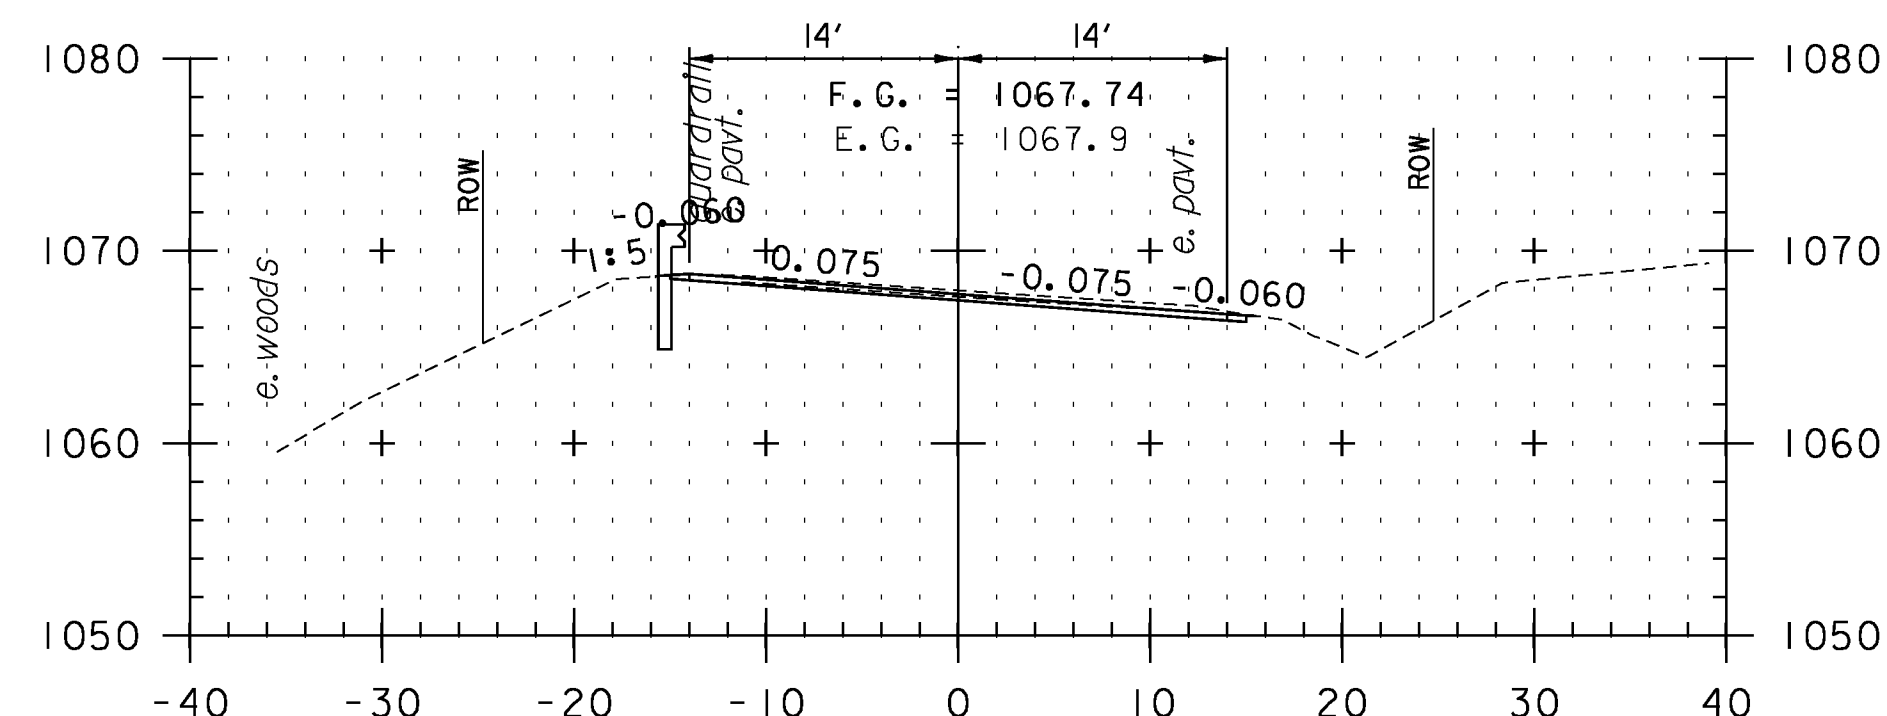

239+00

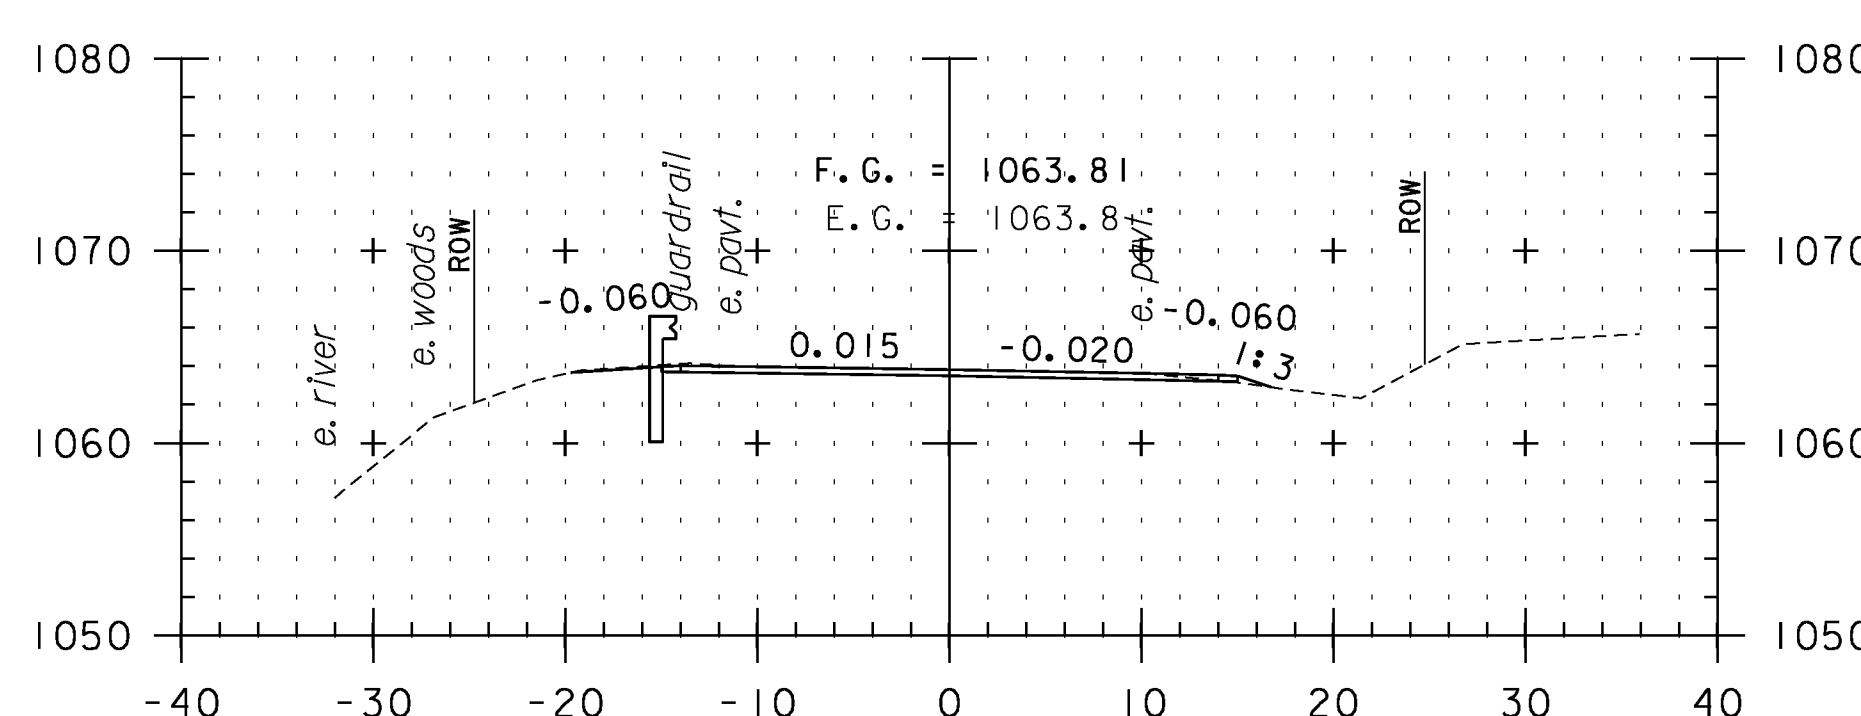


240+50

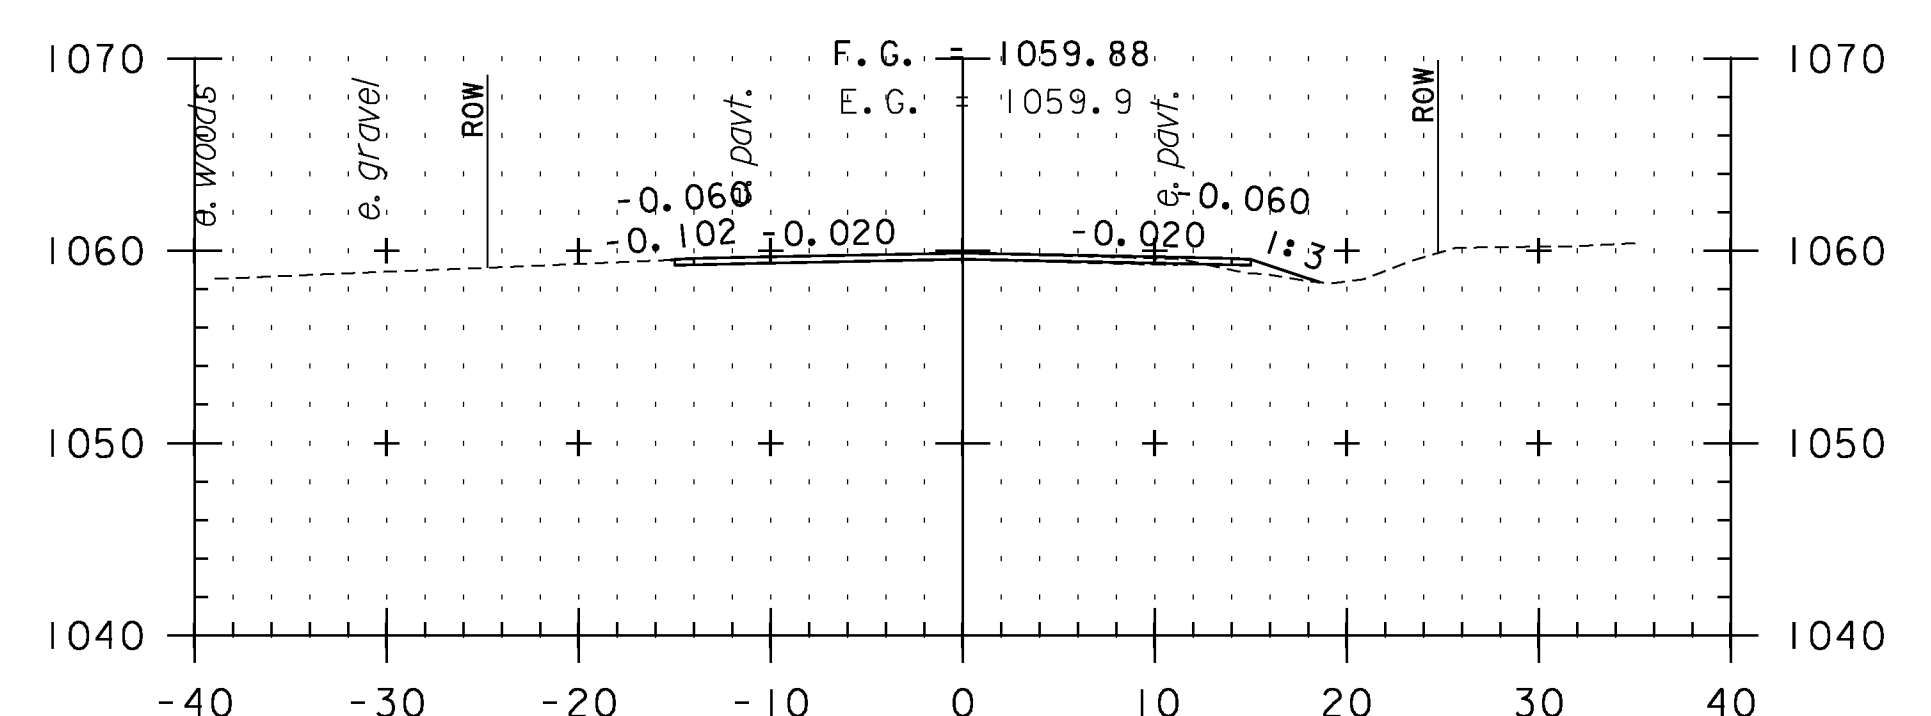

242+00

CROSS SECTION SHEET 13

STA. 239+00 TO STA. 243+00

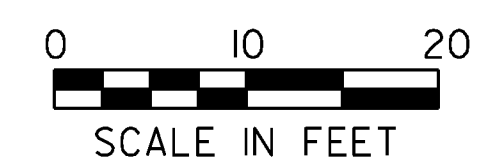

PROJECT NAME: VERSHIRE-THETFORD	
PROJECT NUMBER: STP 2911(I)	
FILE NAME: pl0c224.dgn	PLOT DATE: 1/29/2013
PROJECT LEADER: PTS	DRAWN BY: SNG
DESIGNED BY: NLL	CHECKED BY: PTS
IPARM FILE NAME: IOC224_I21	SHEET 121 OF 232