




244+50

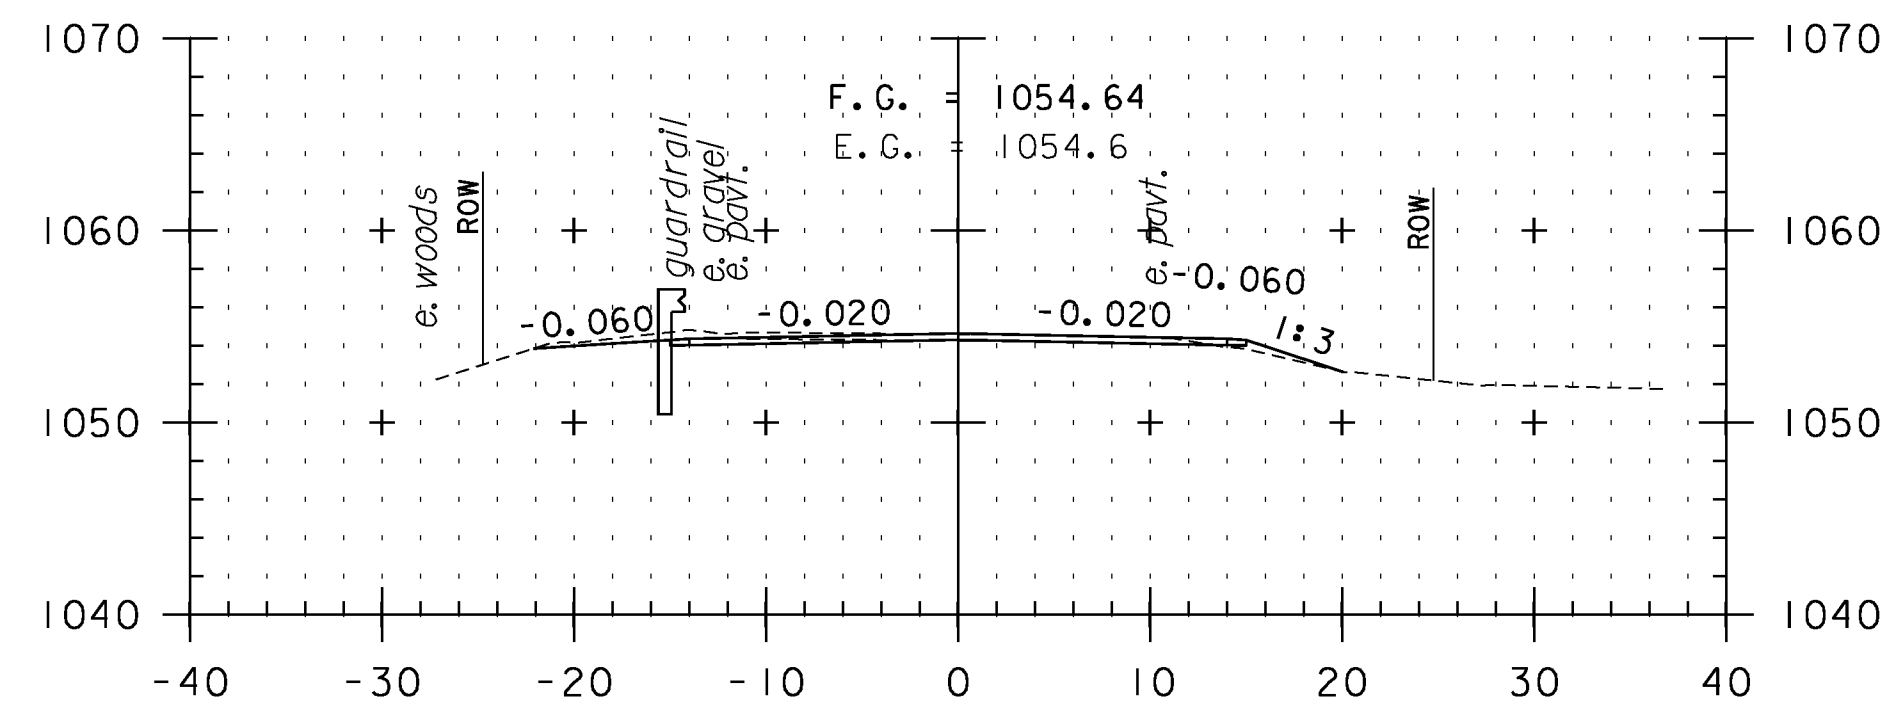


244+00

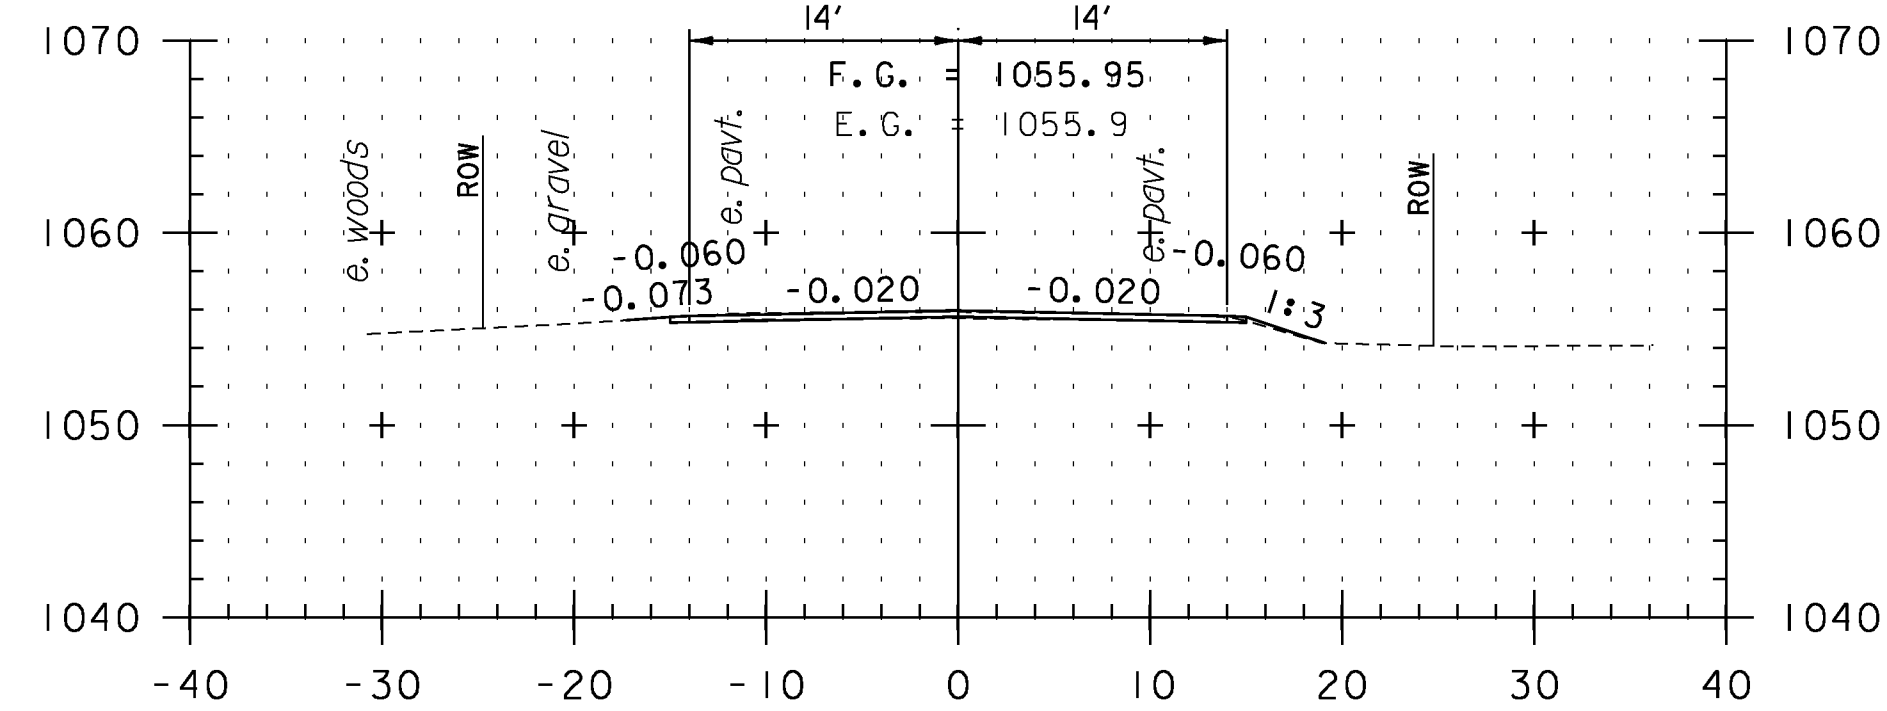


243+50

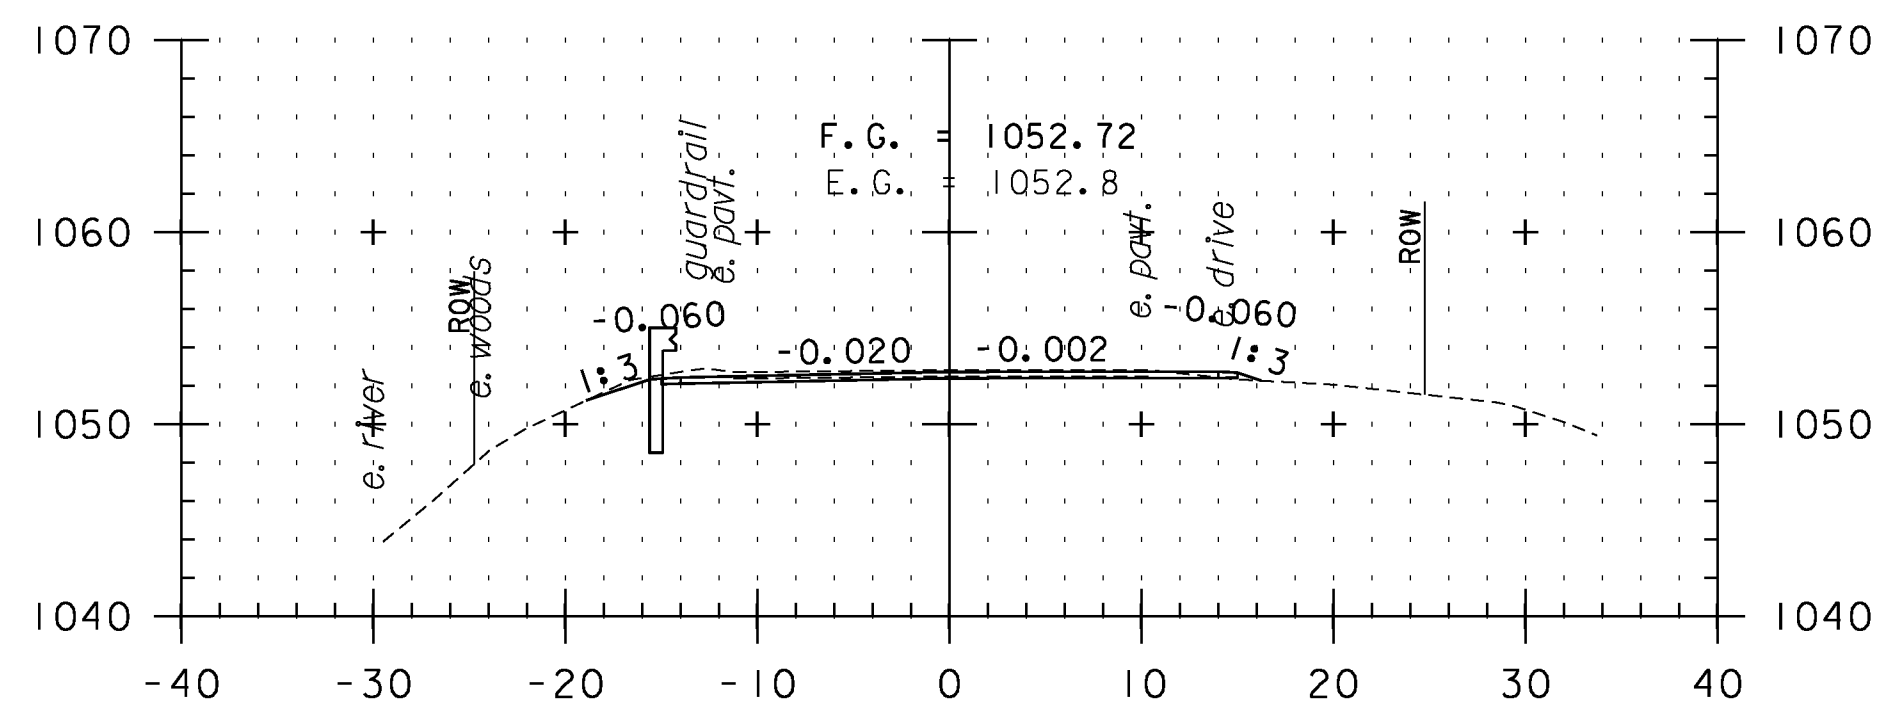


246+00

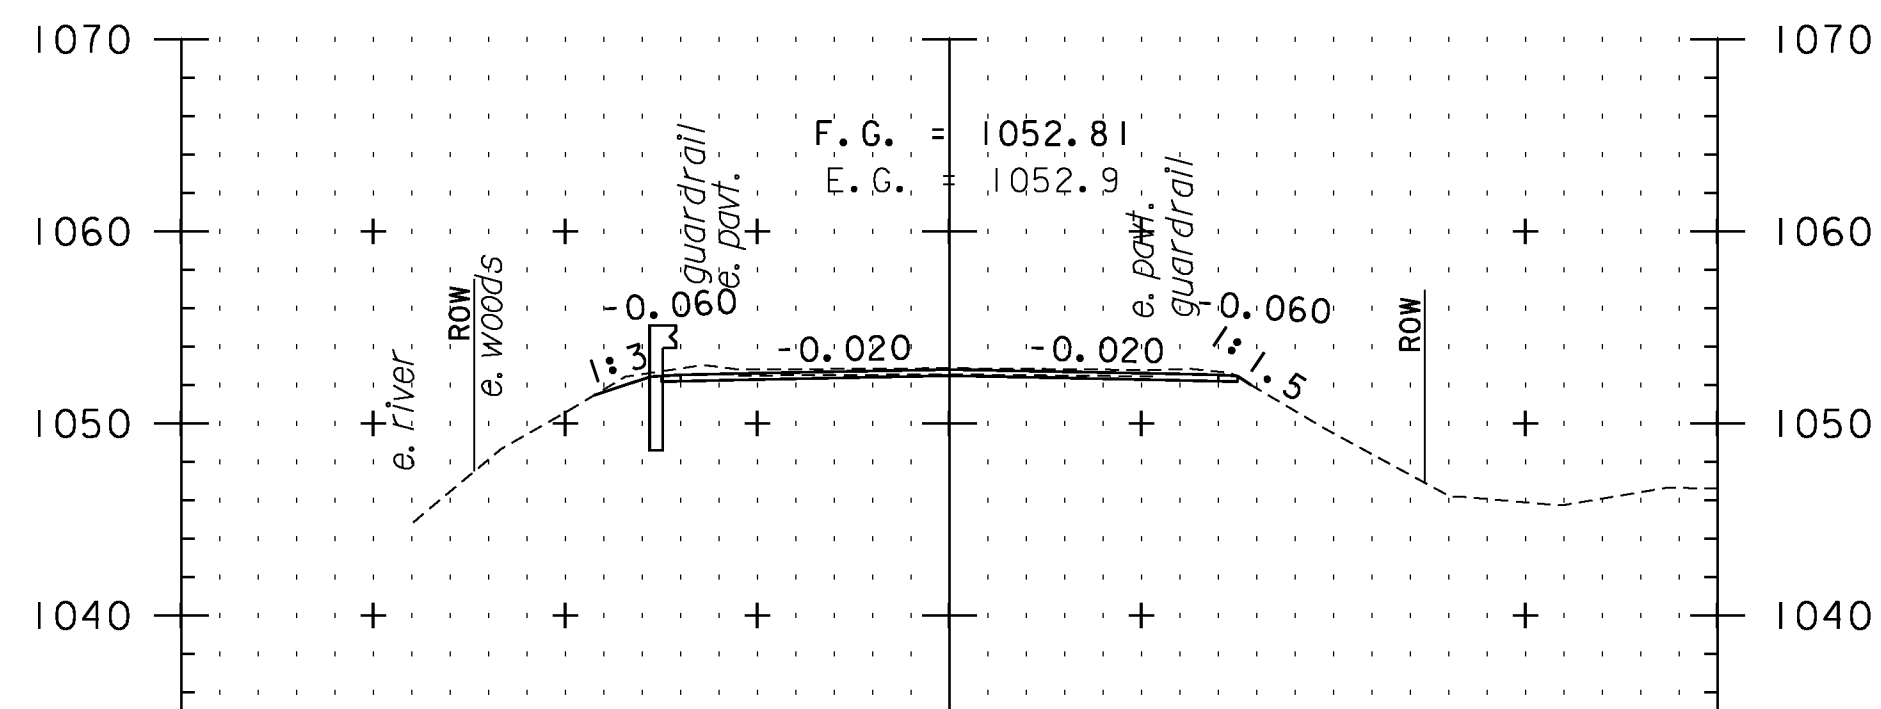


245+50

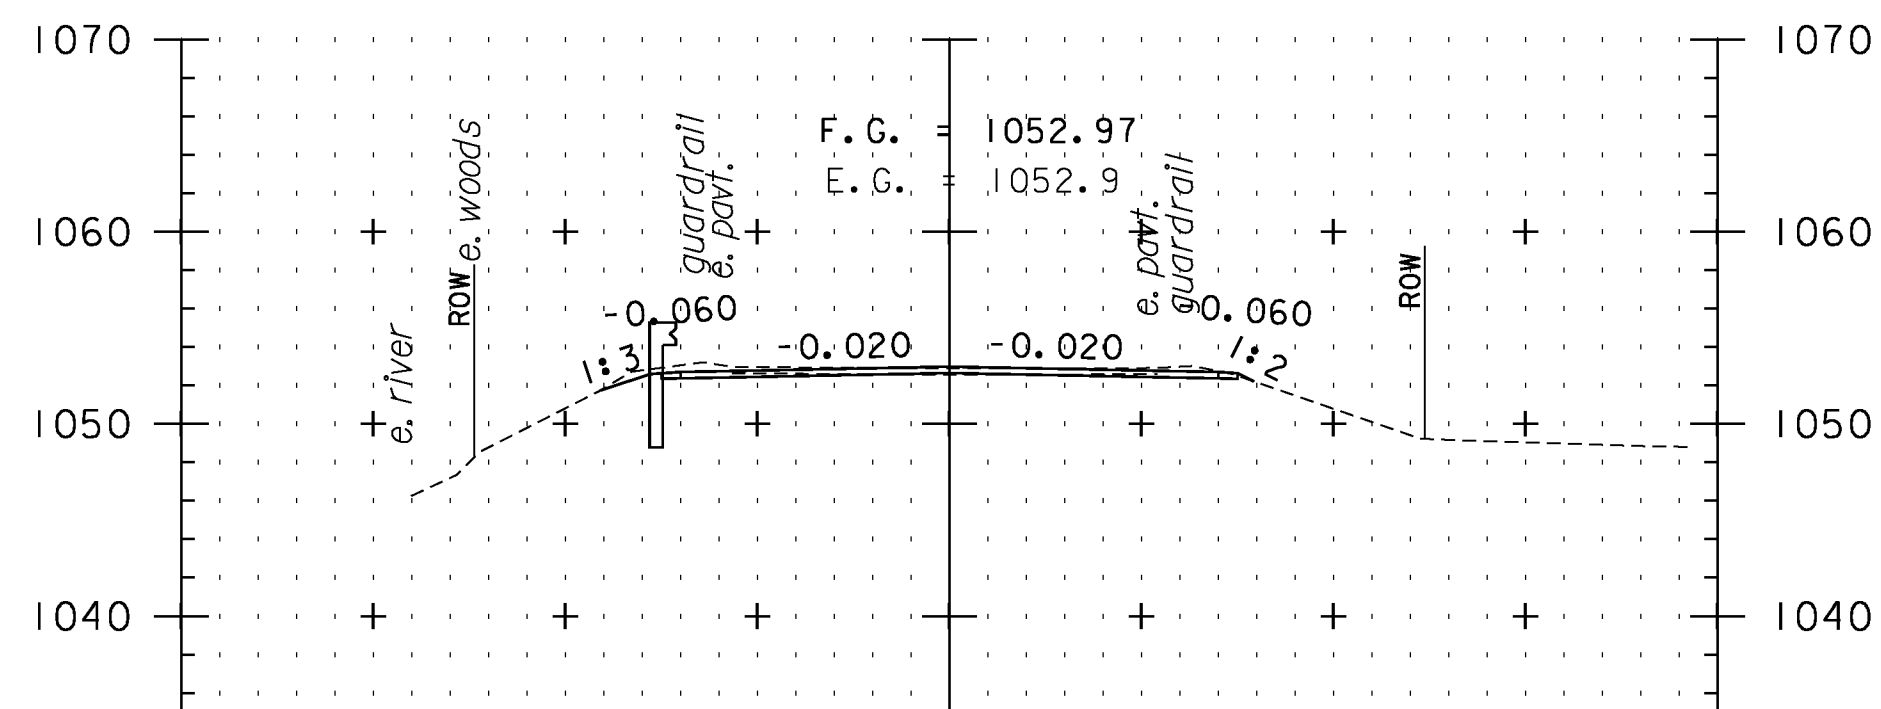


245+00

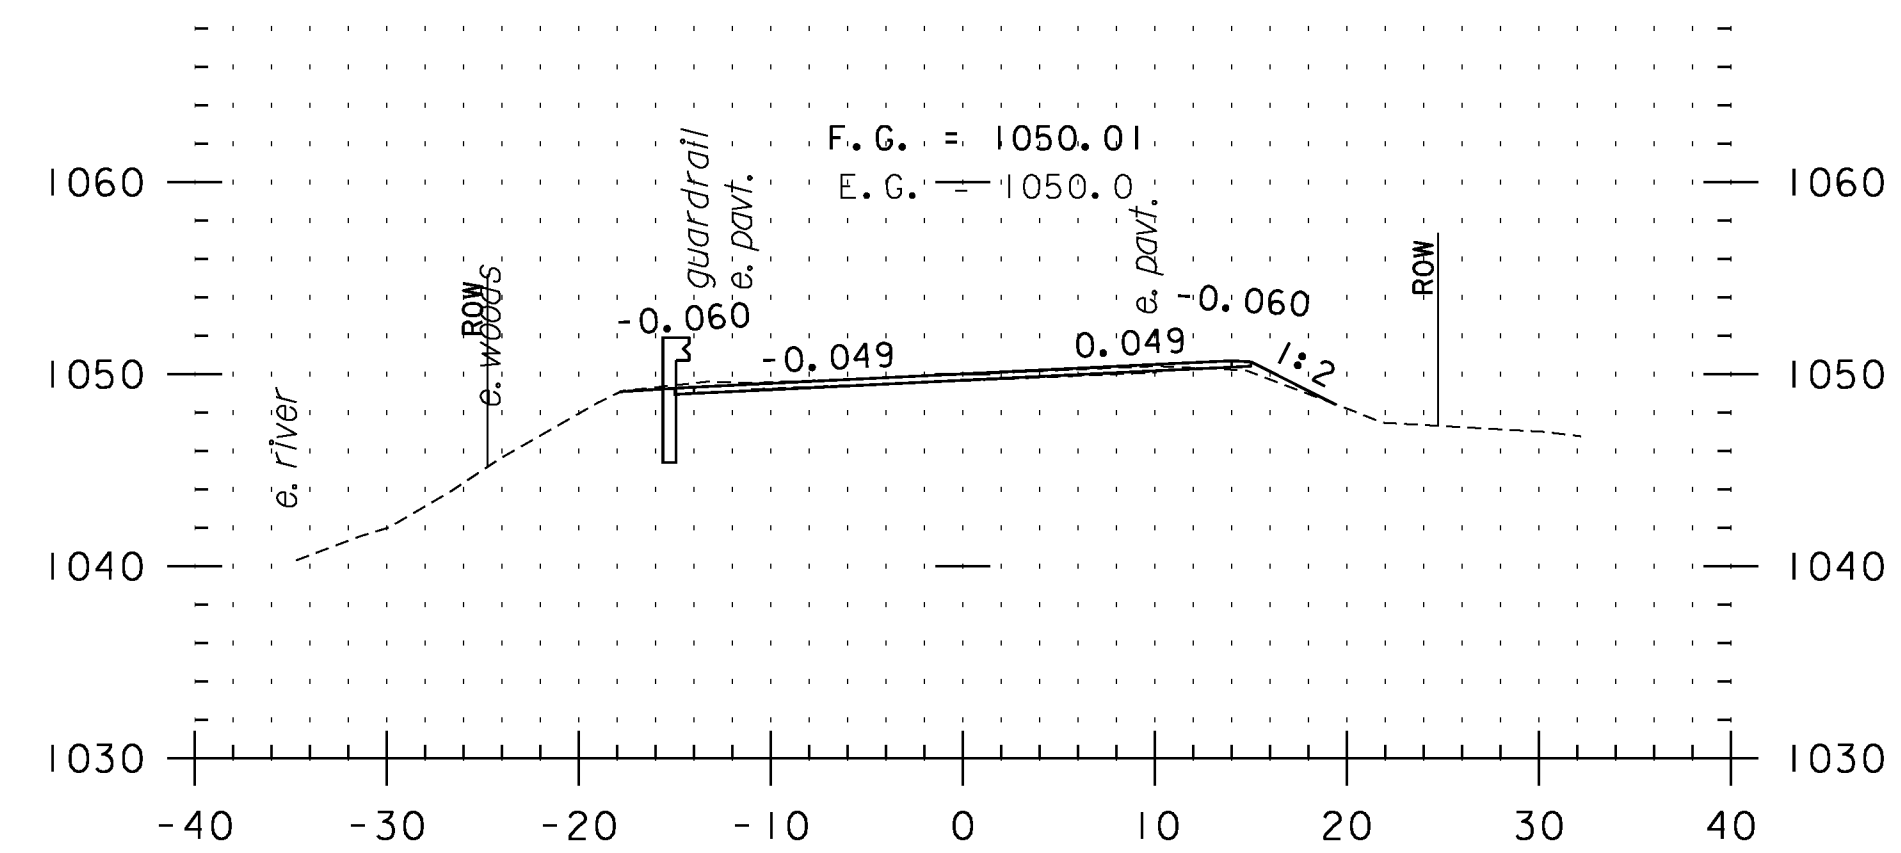

247+50

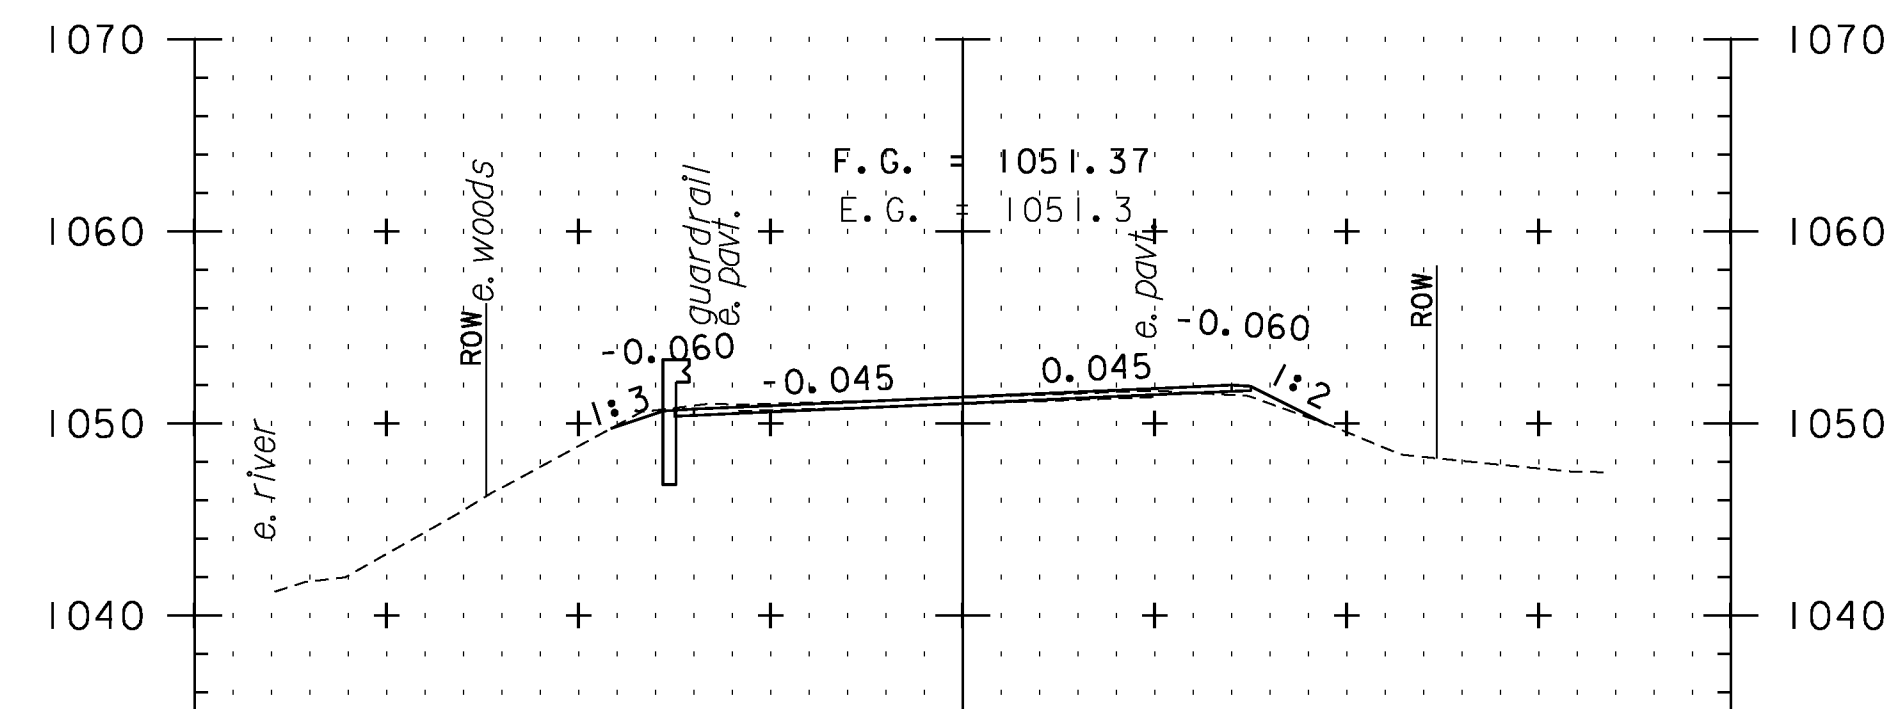


247+00

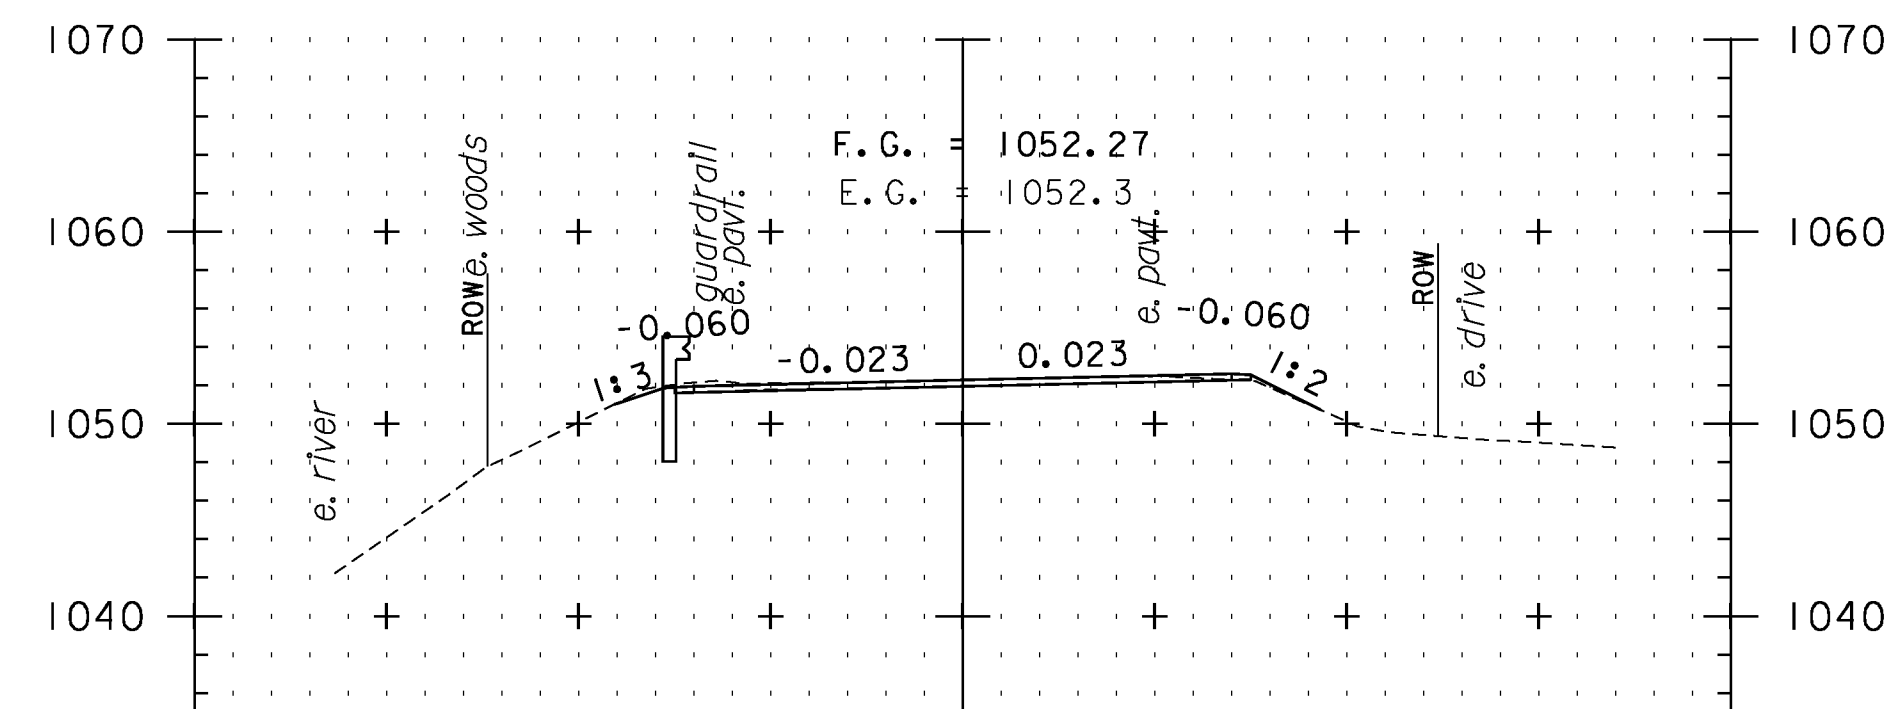

246+50

**CROSS SECTION SHEET 14**

STA. 243+50 TO STA. 247+50

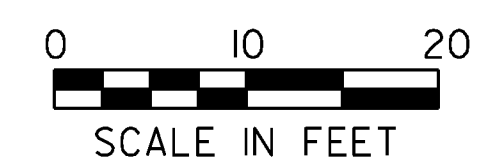

PROJECT NAME: VERSHIRE-THETFORD	PLOT DATE: 1/29/2013
PROJECT NUMBER: STP 2911(I)	DRAWN BY: SNG
FILE NAME: pl0c224.dgn	CHECKED BY: PTS
PROJECT LEADER: PTS	SHEET 122 OF 232
DESIGNED BY: NLL	
IPARM FILE NAME: IOC224_I22	