




251+50

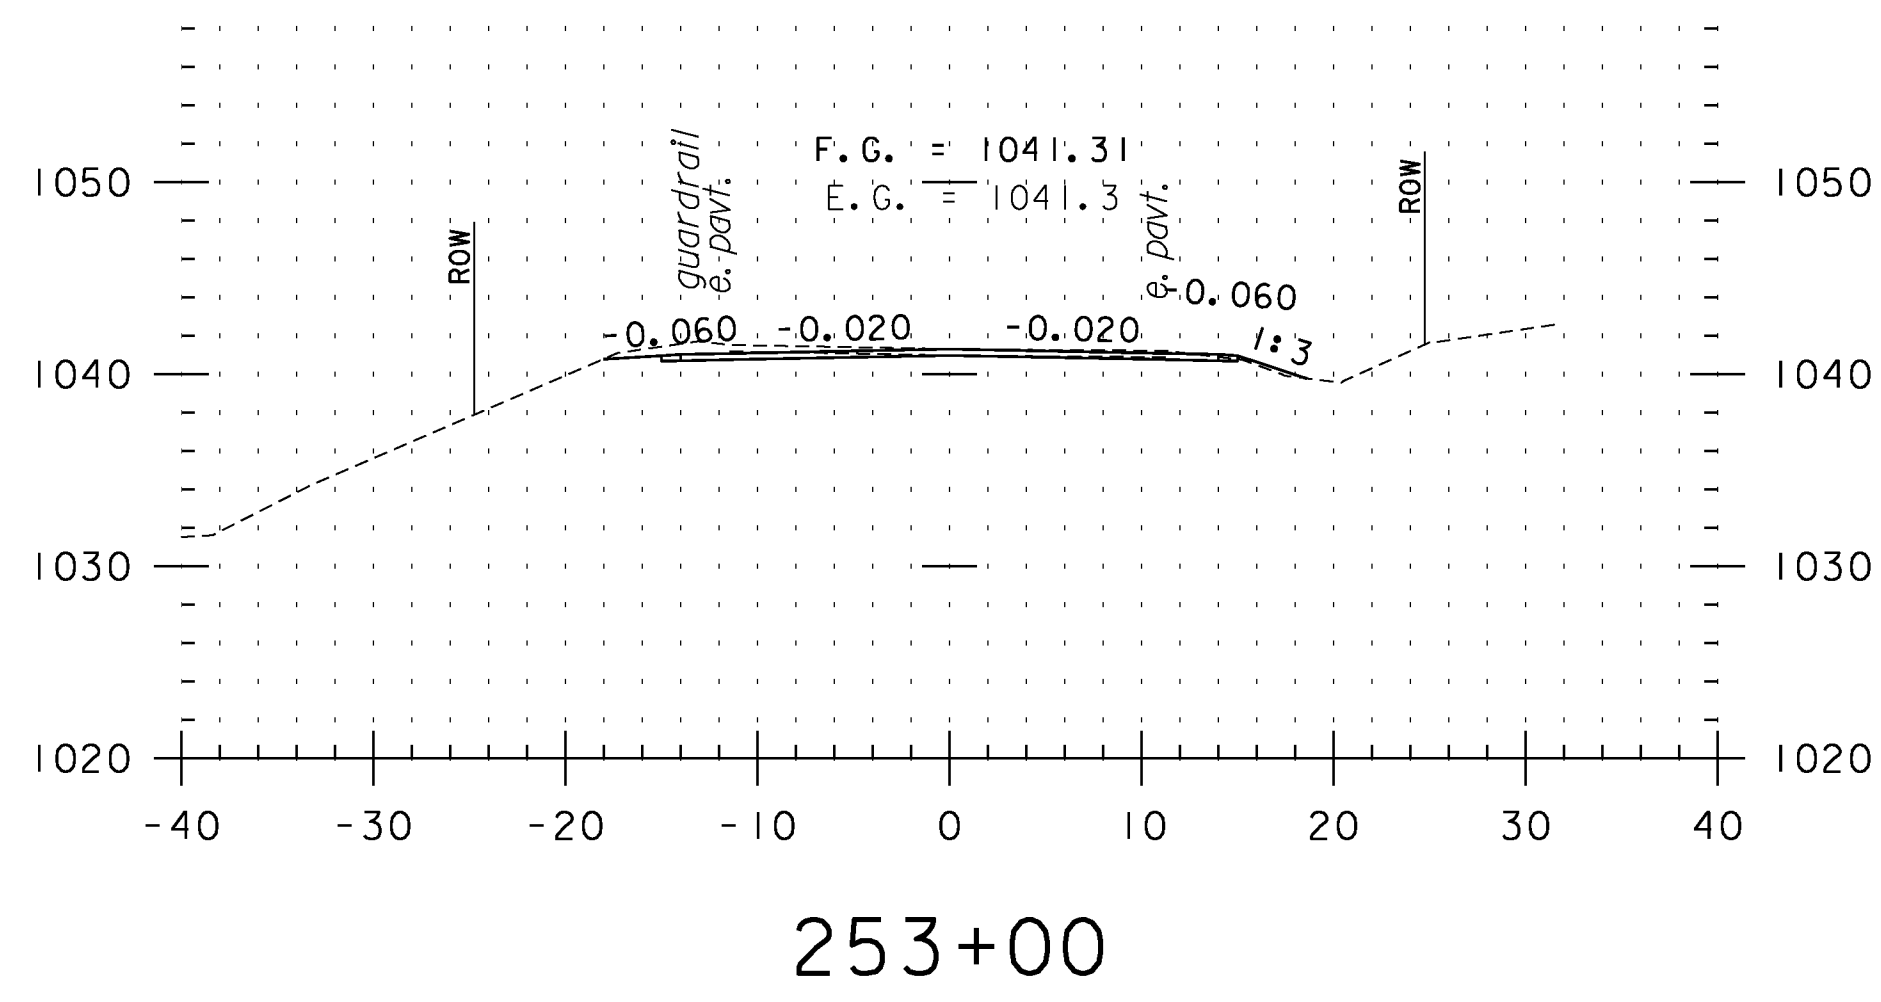


253+00

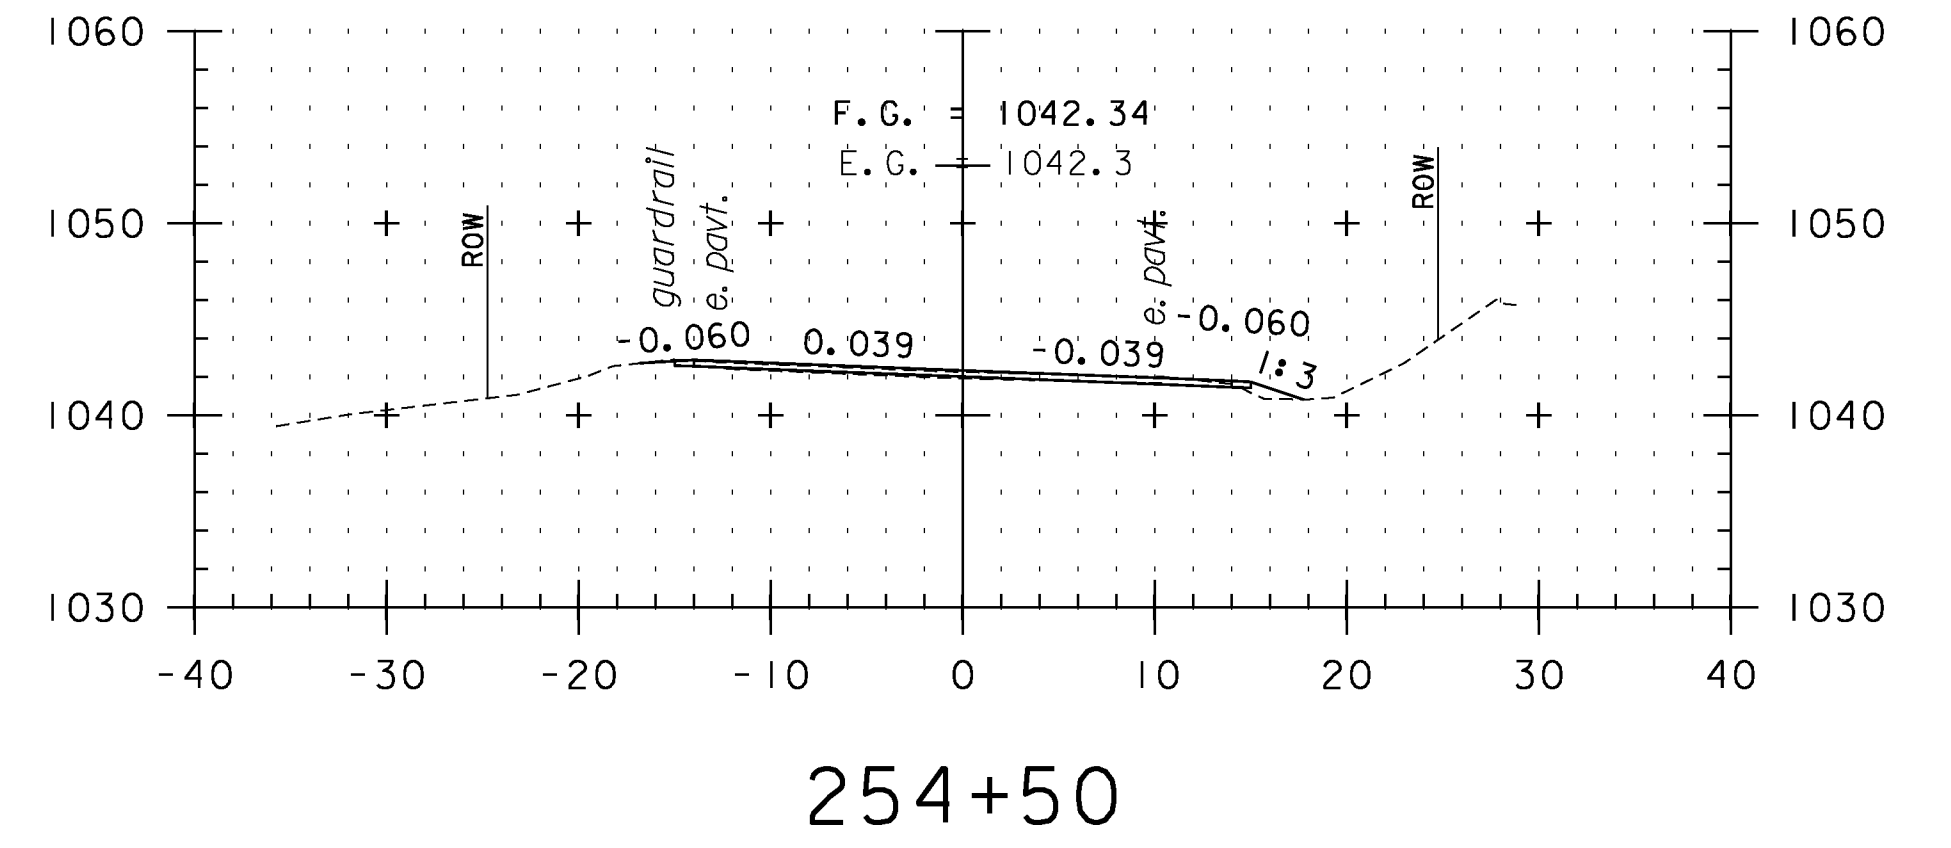


254+50

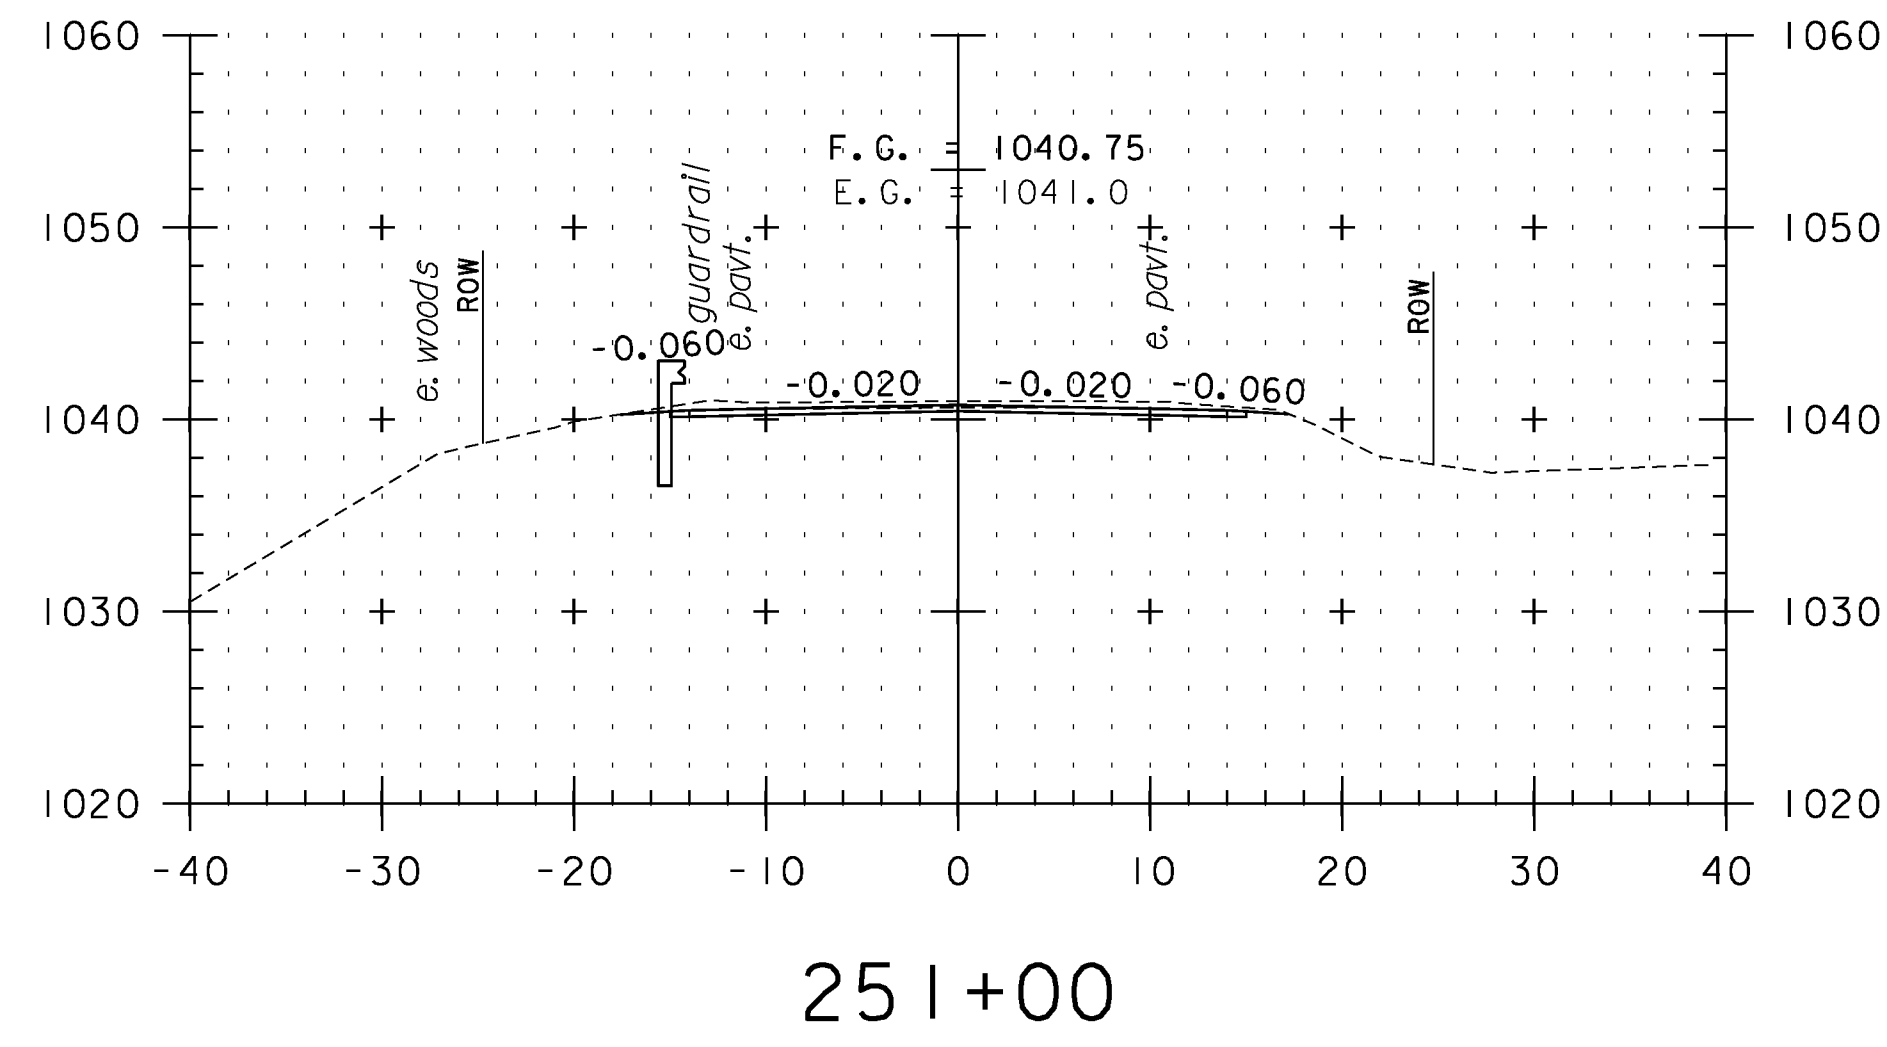


251+00

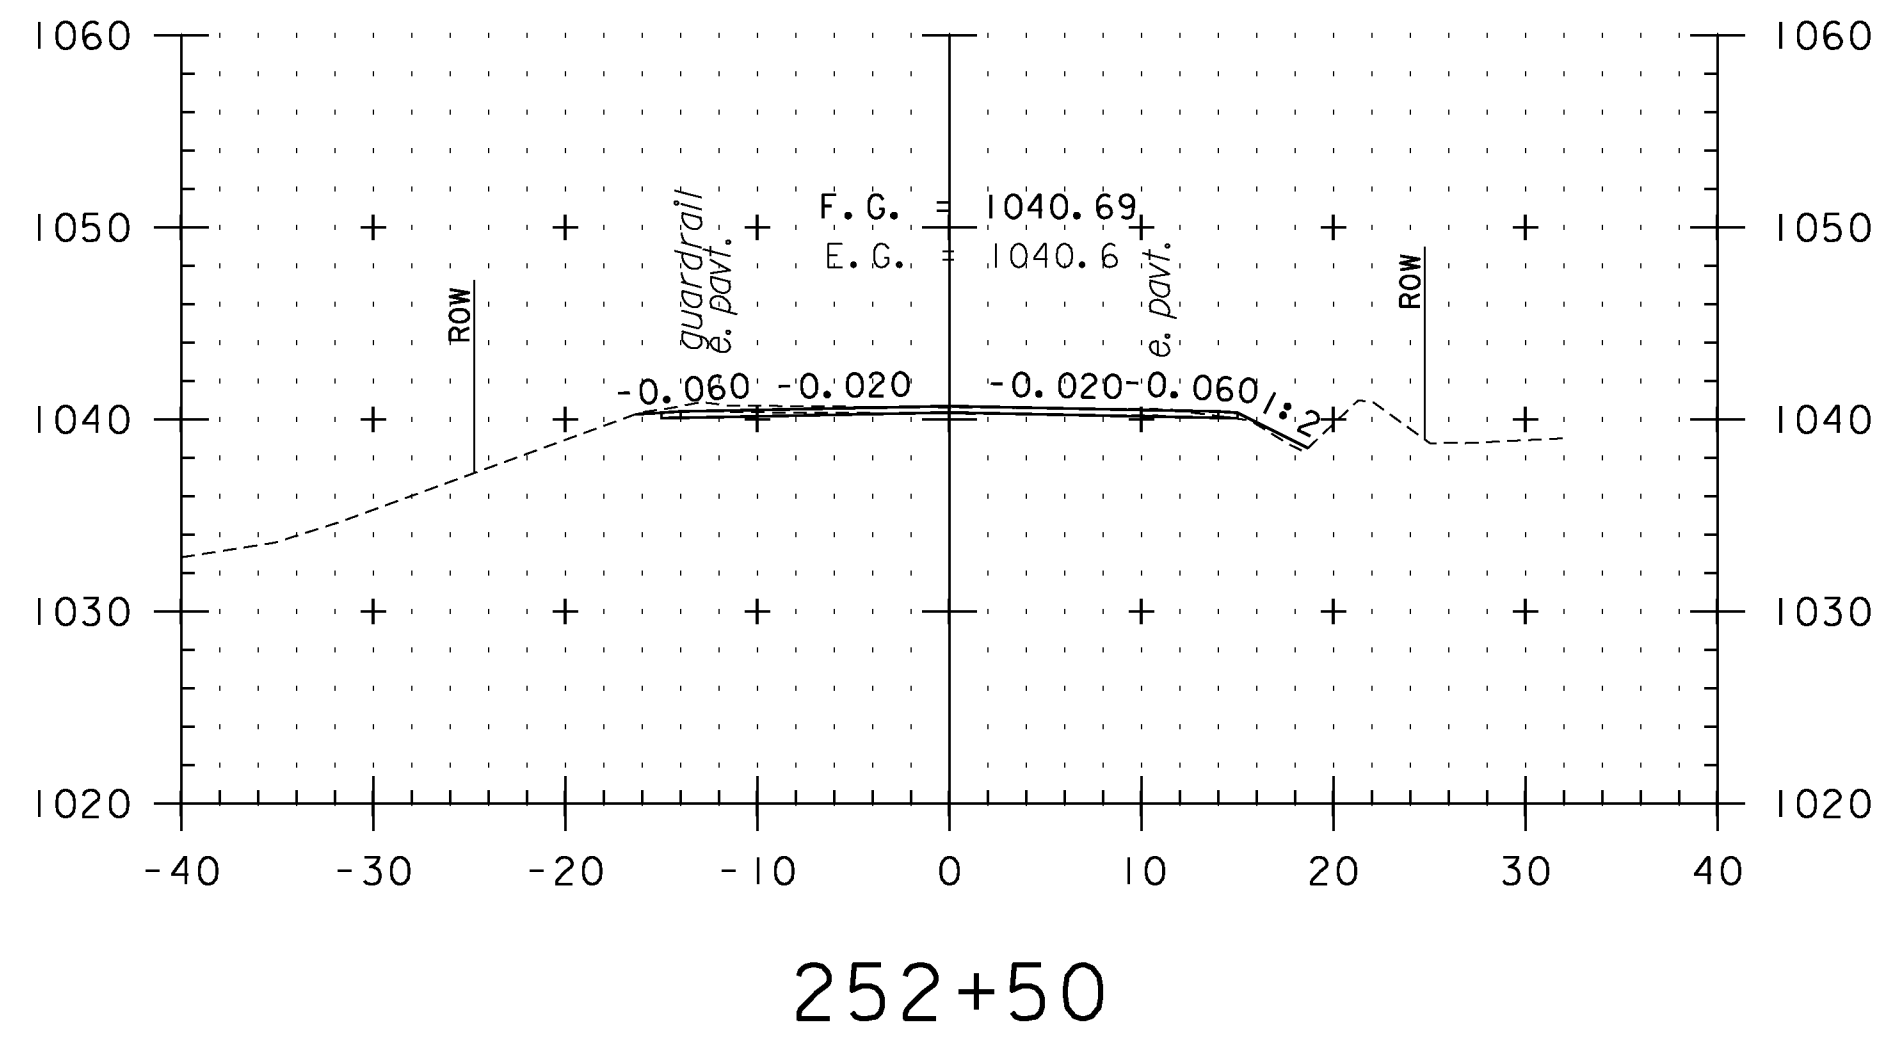


252+50

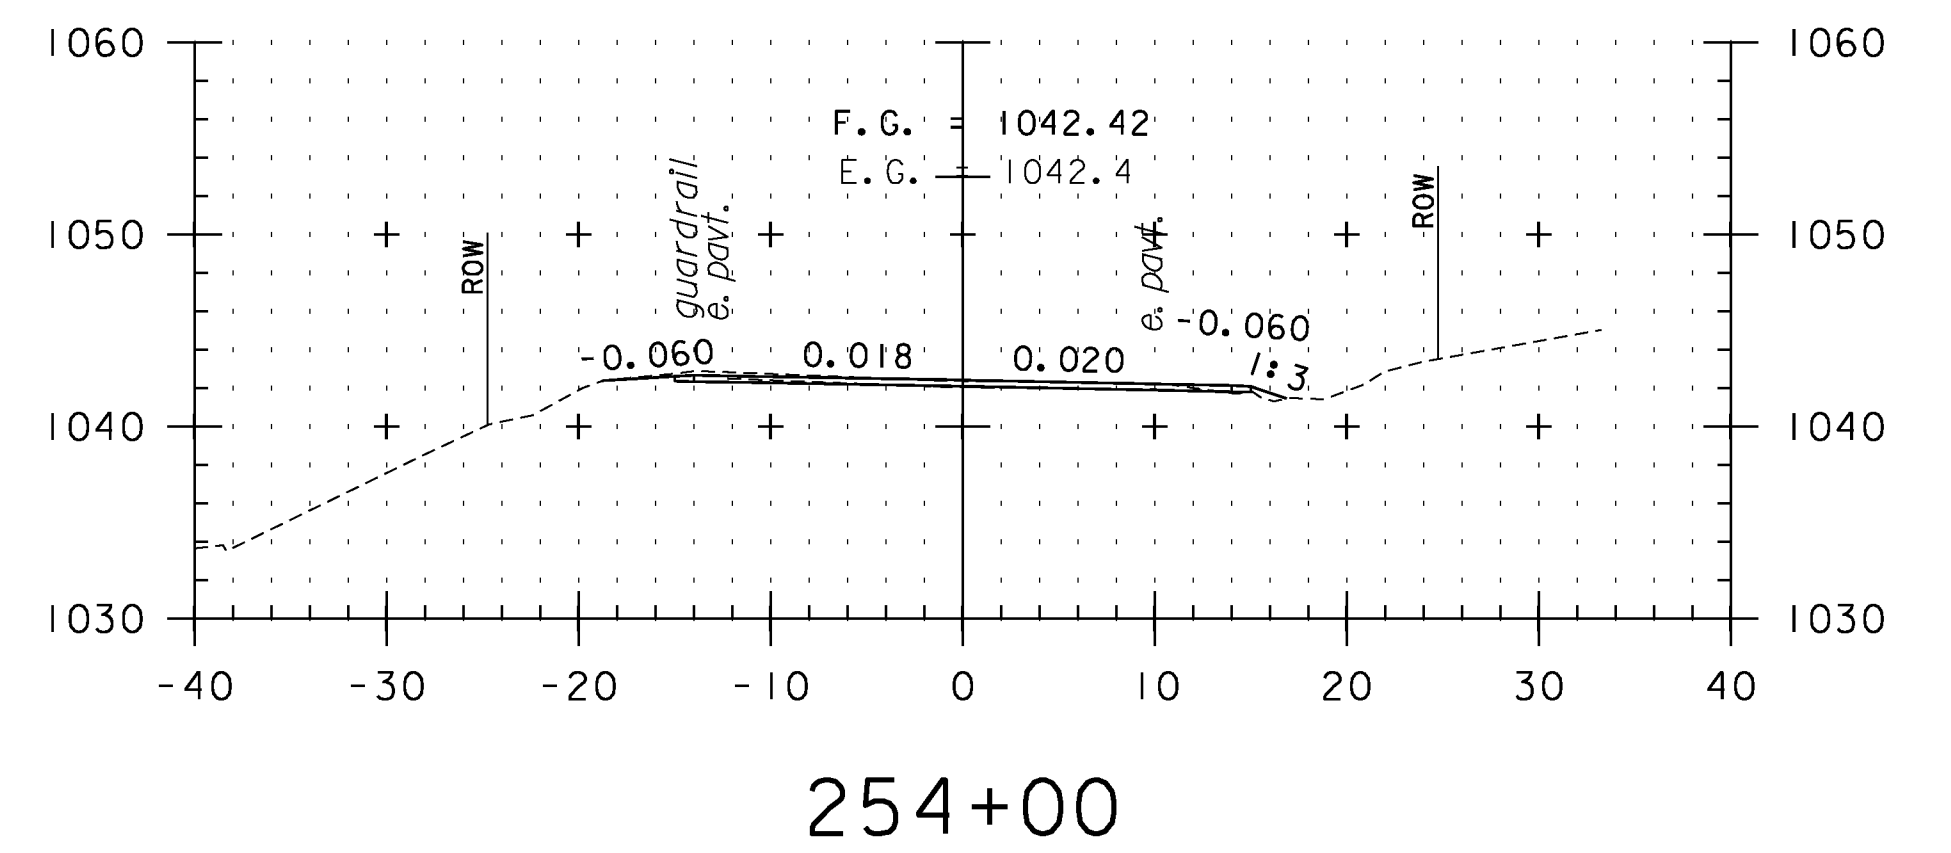


254+00

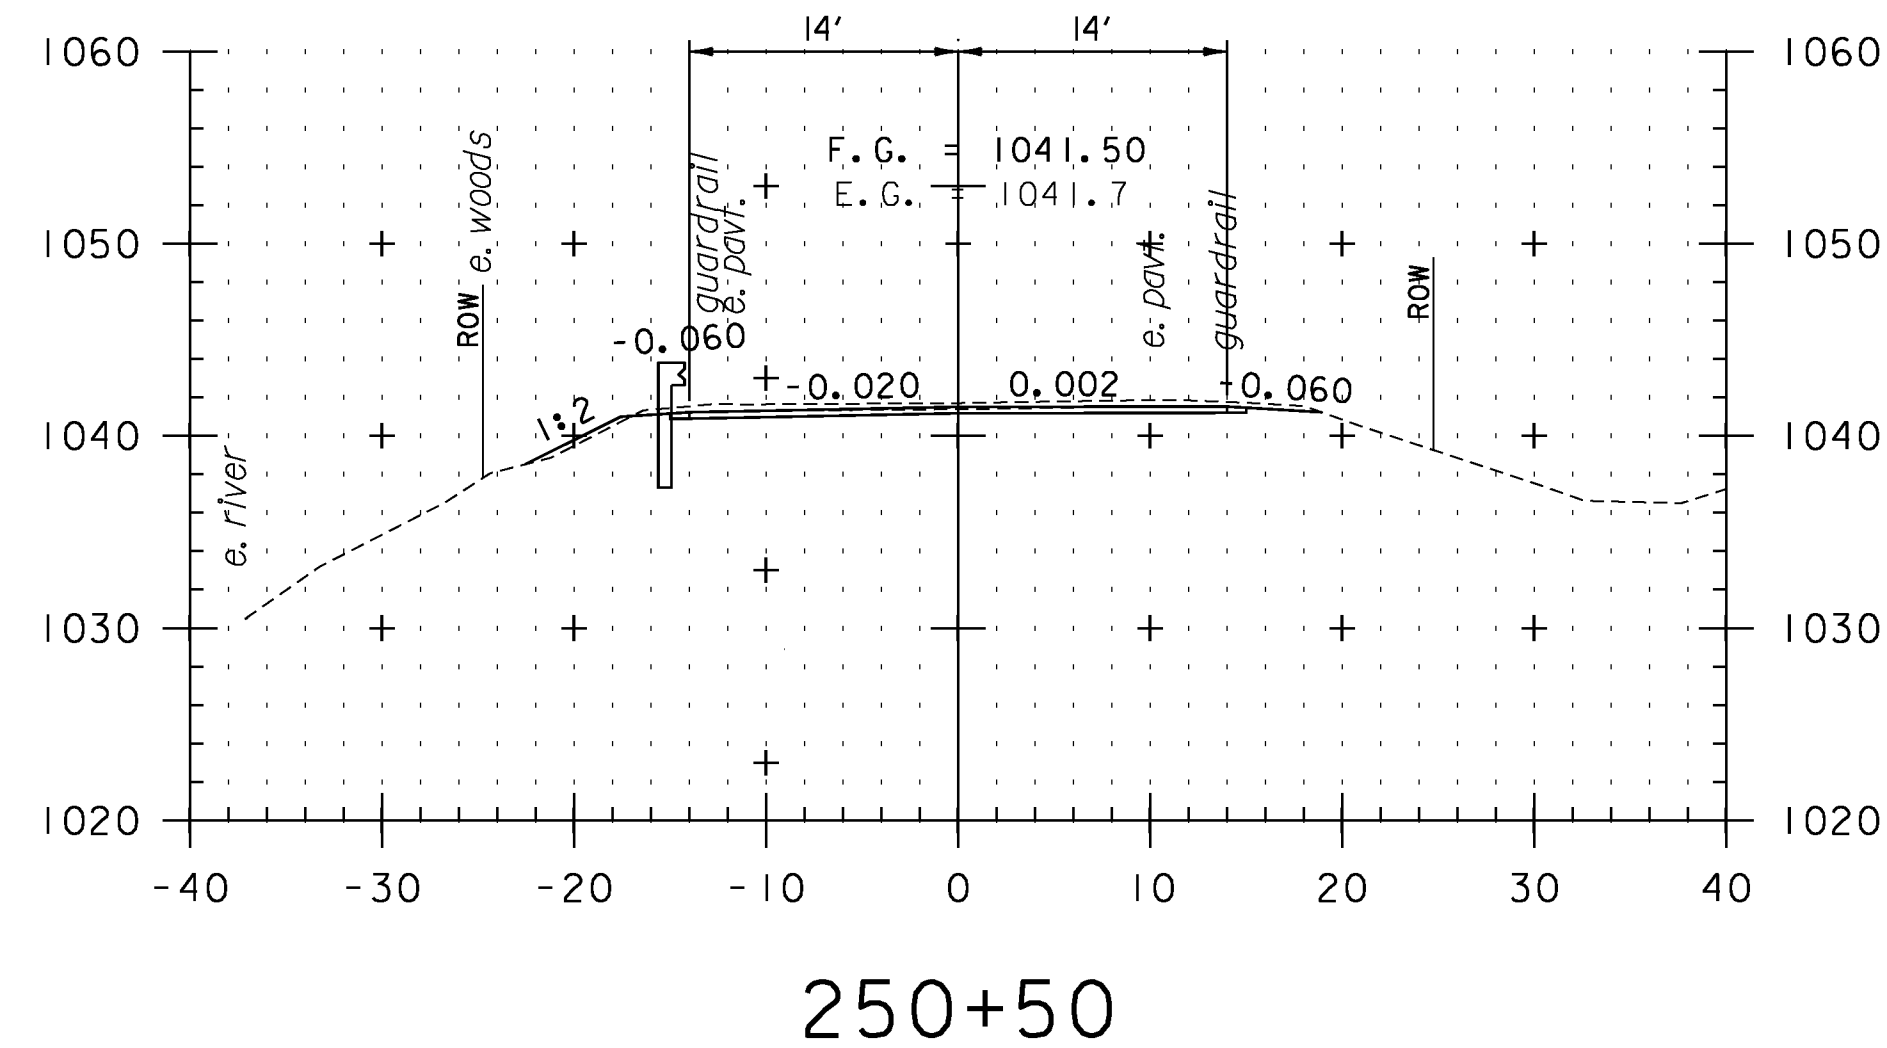

250+50

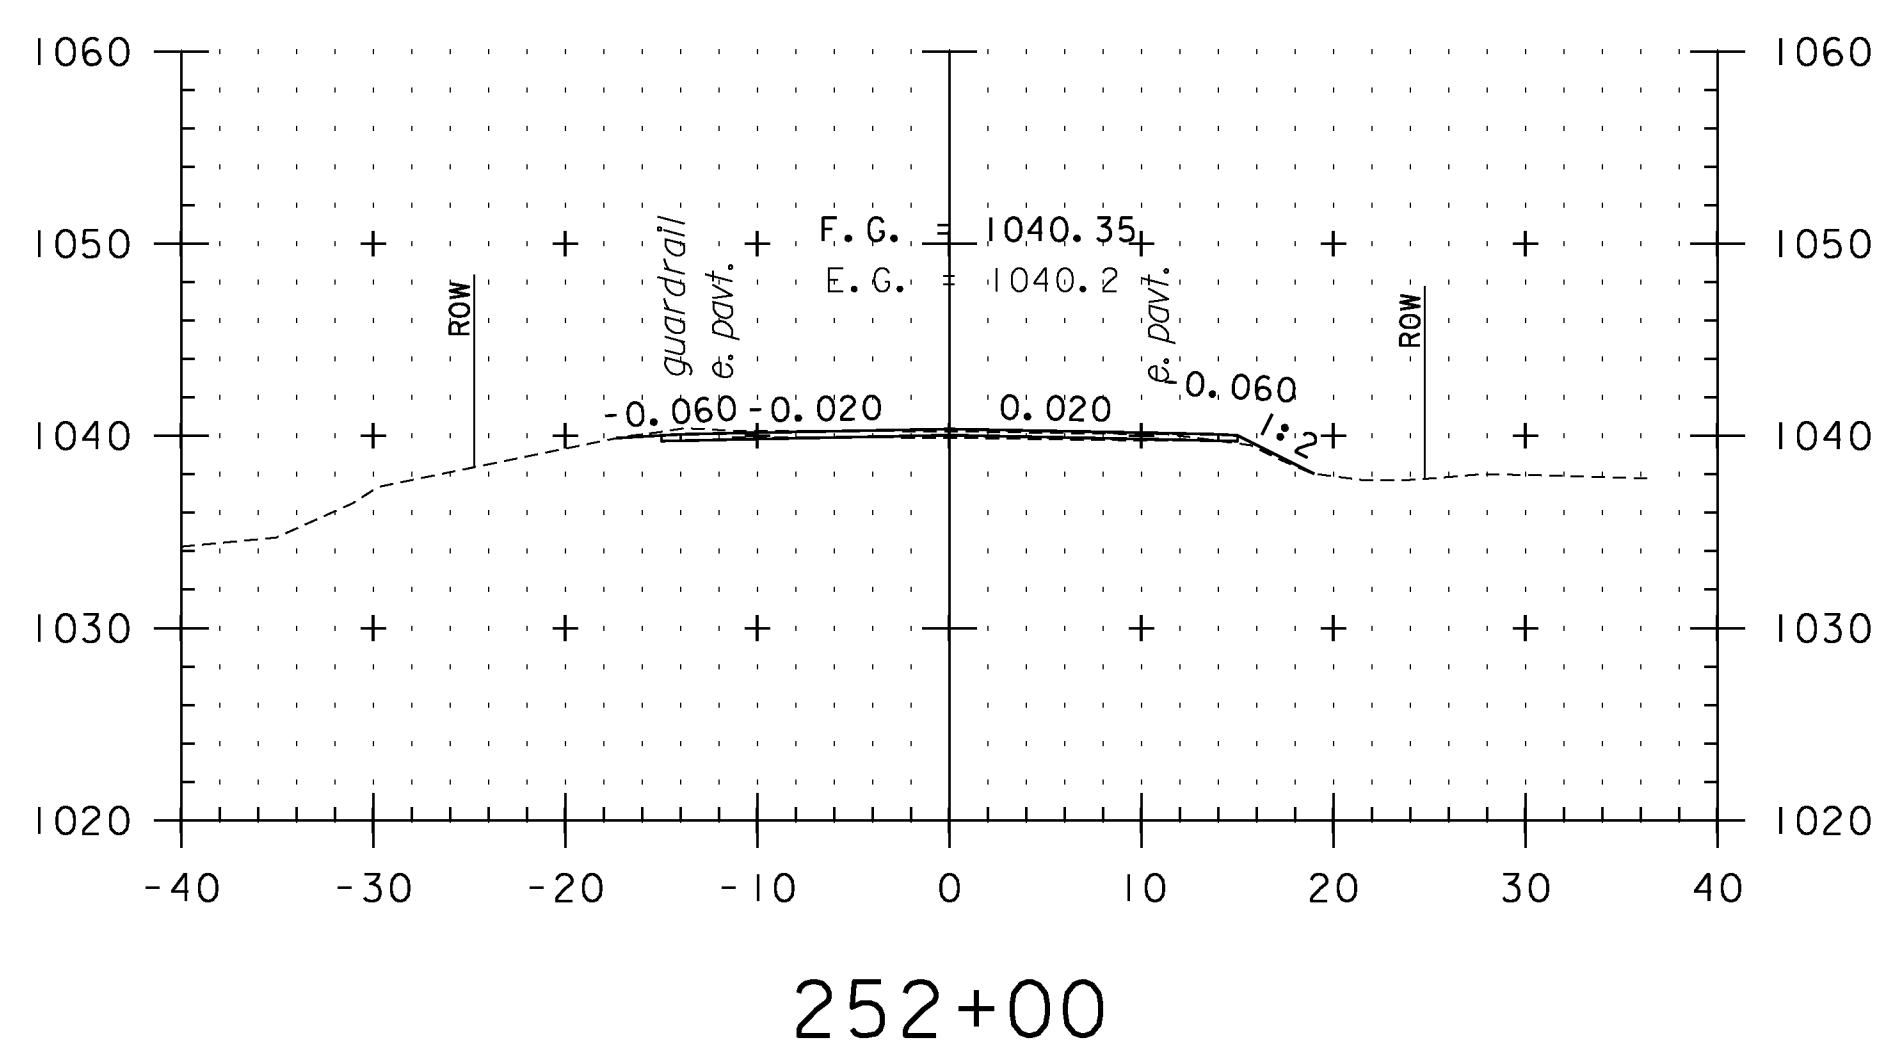


252+00

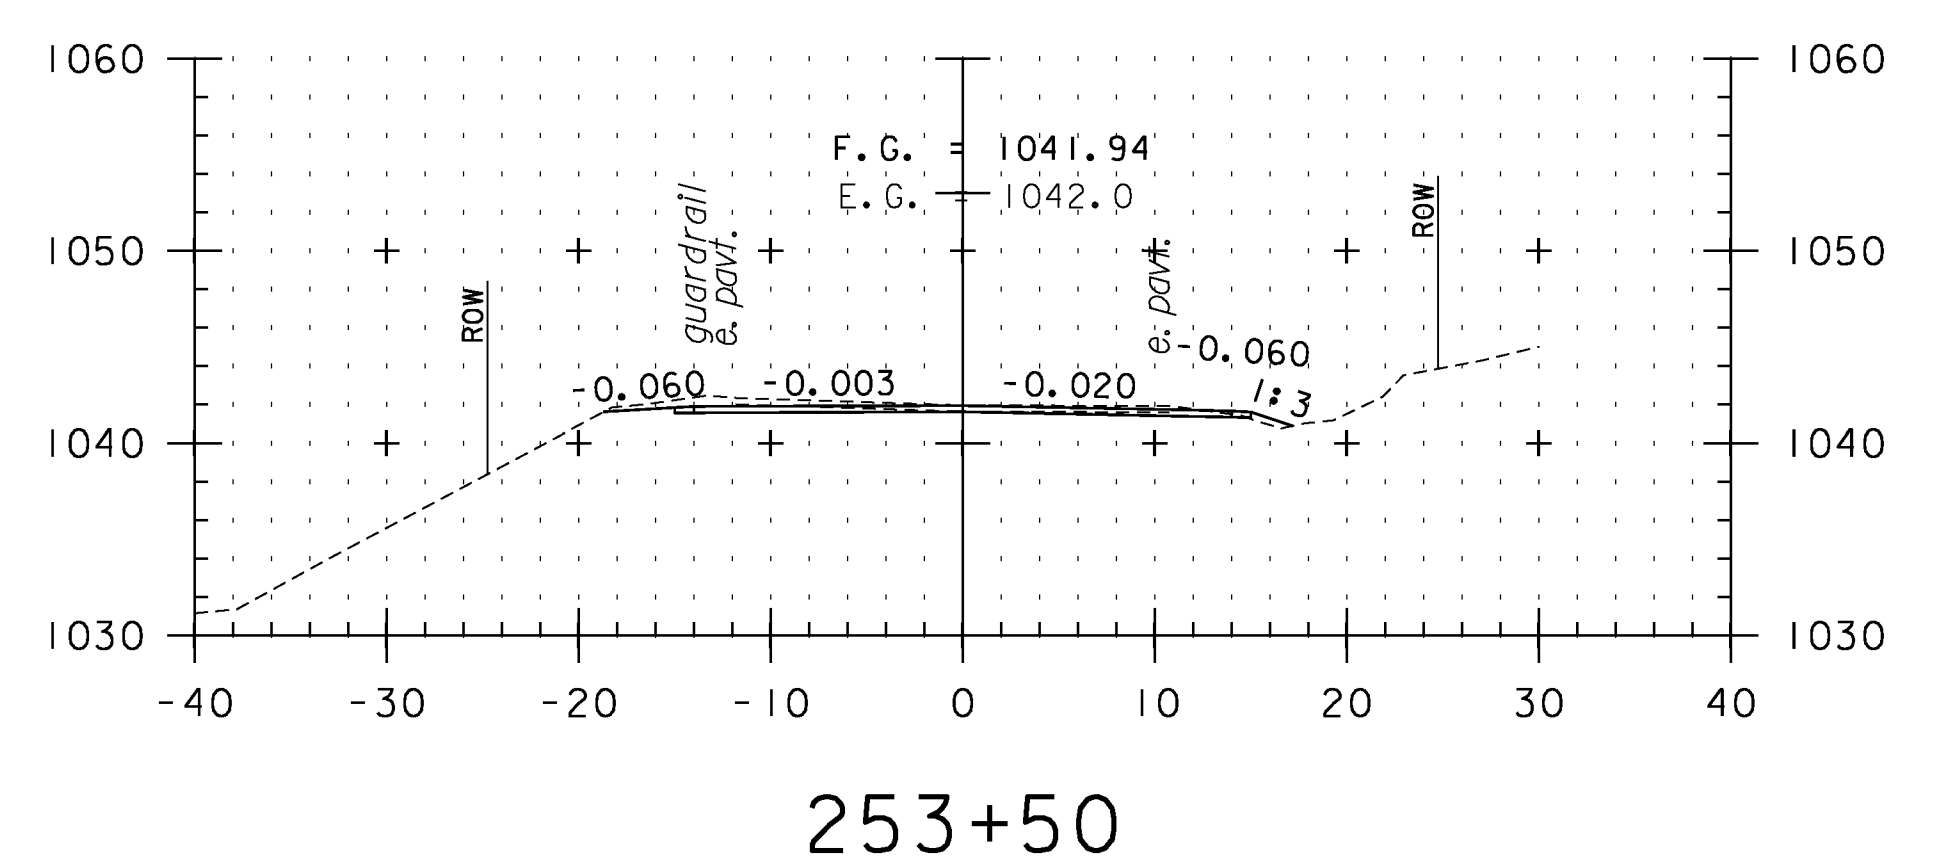

253+50

**CROSS SECTION SHEET 16**

STA. 250+50 TO STA. 254+50

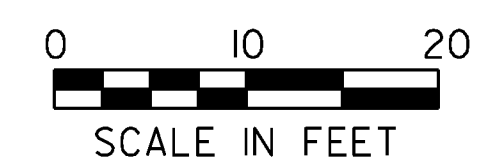

PROJECT NAME: VERSHIRE-THETFORD	PLOT DATE: 1/29/2013
PROJECT NUMBER: STP 2911(I)	DRAWN BY: SNG
FILE NAME: pl0c224.dgn	CHECKED BY: PTS
PROJECT LEADER: PTS	SHEET 124 OF 232
DESIGNED BY: NLL	
IPARM FILE NAME: IOC224_124	