




256+00

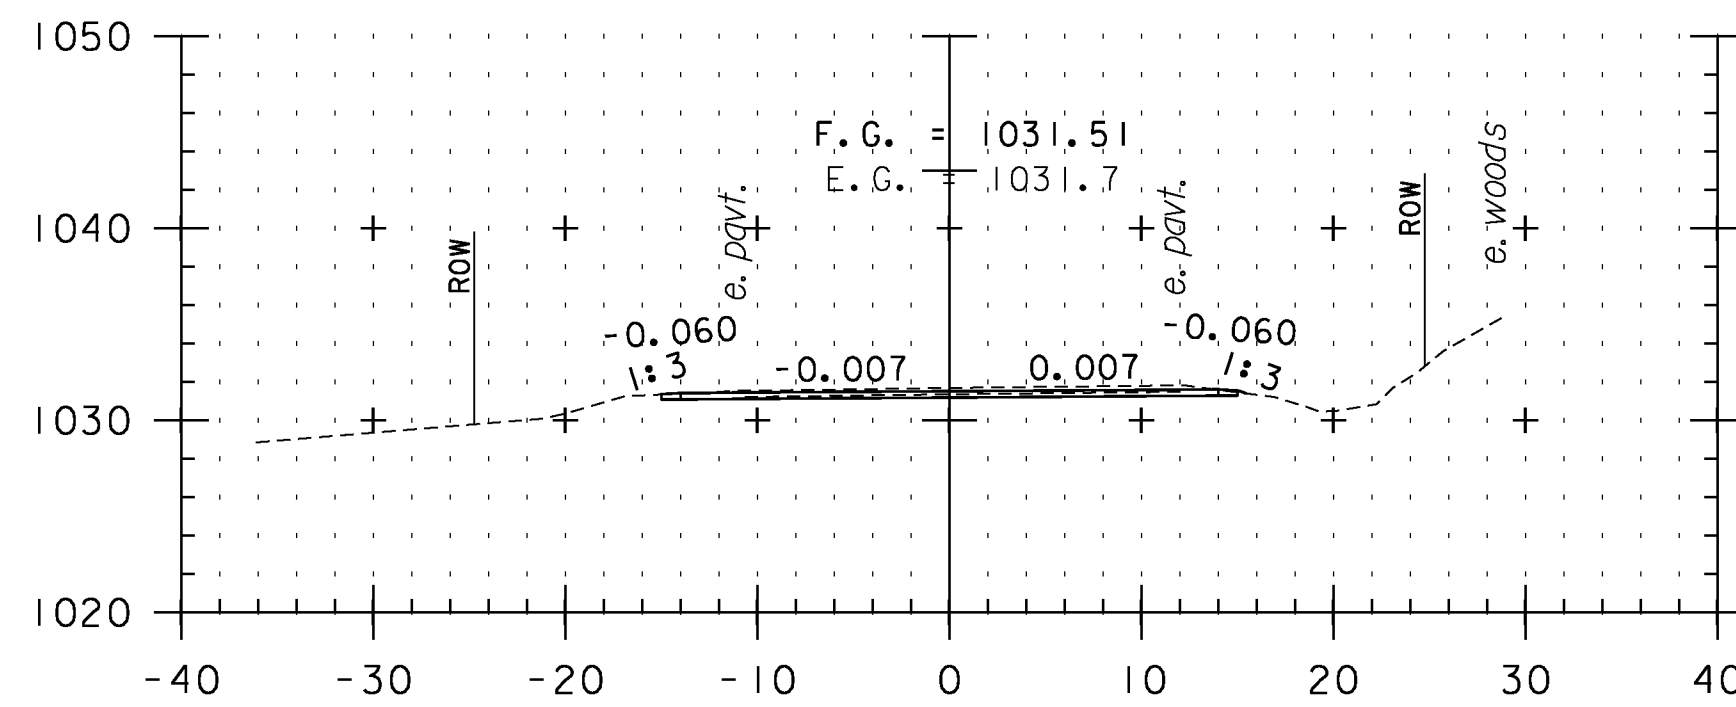


257+50

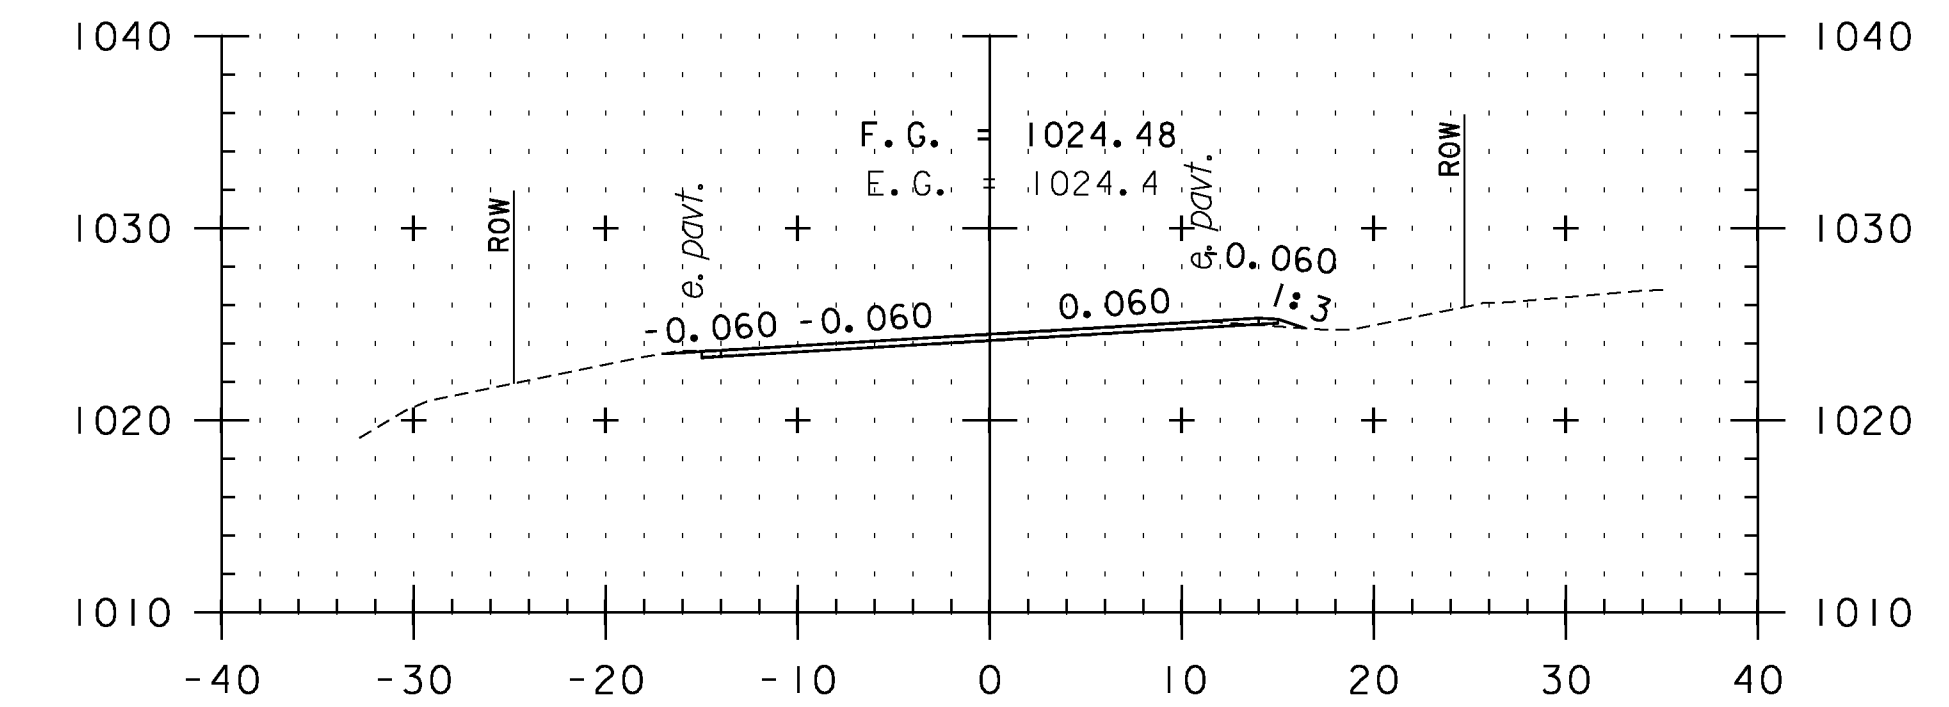


259+00

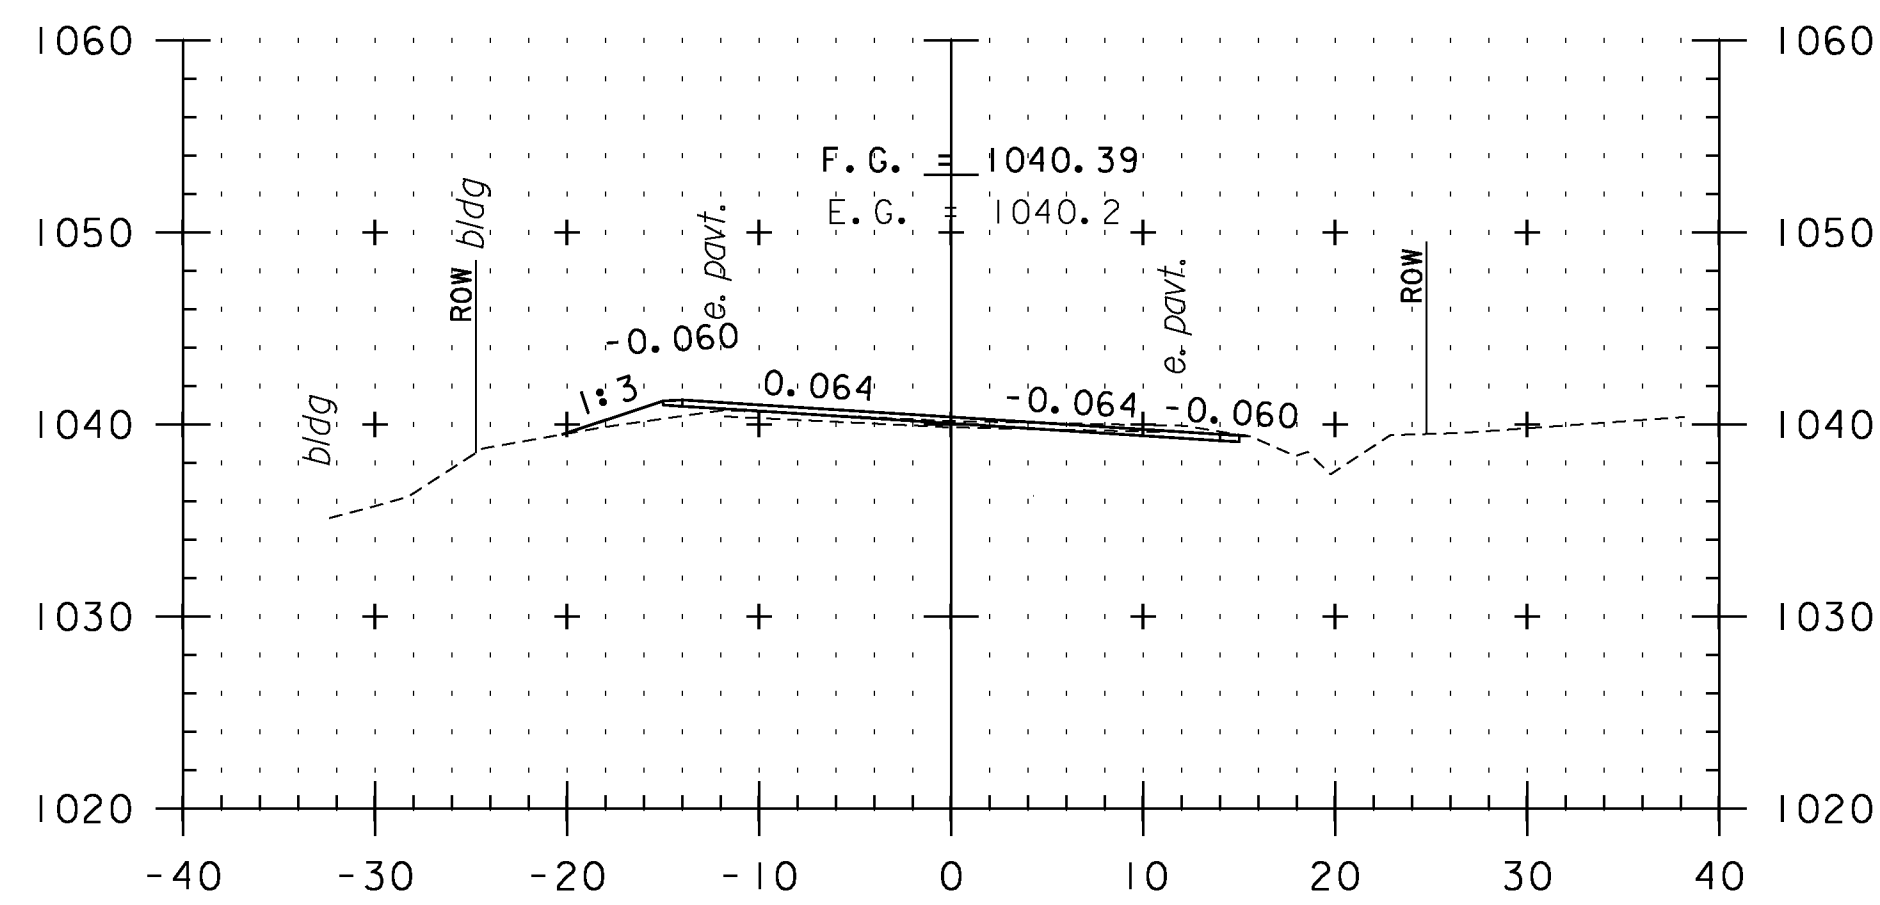


255+50

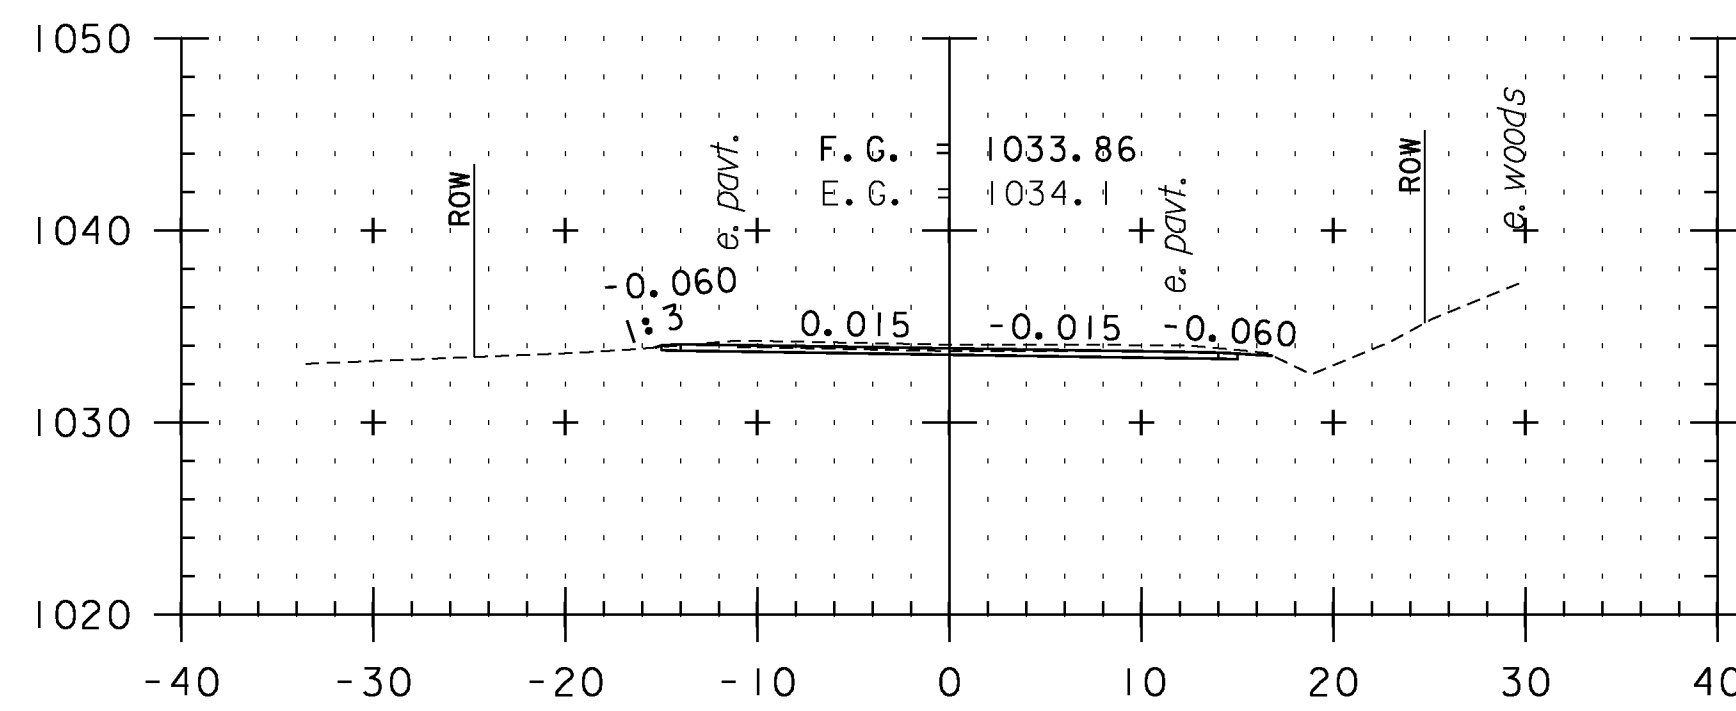


257+00

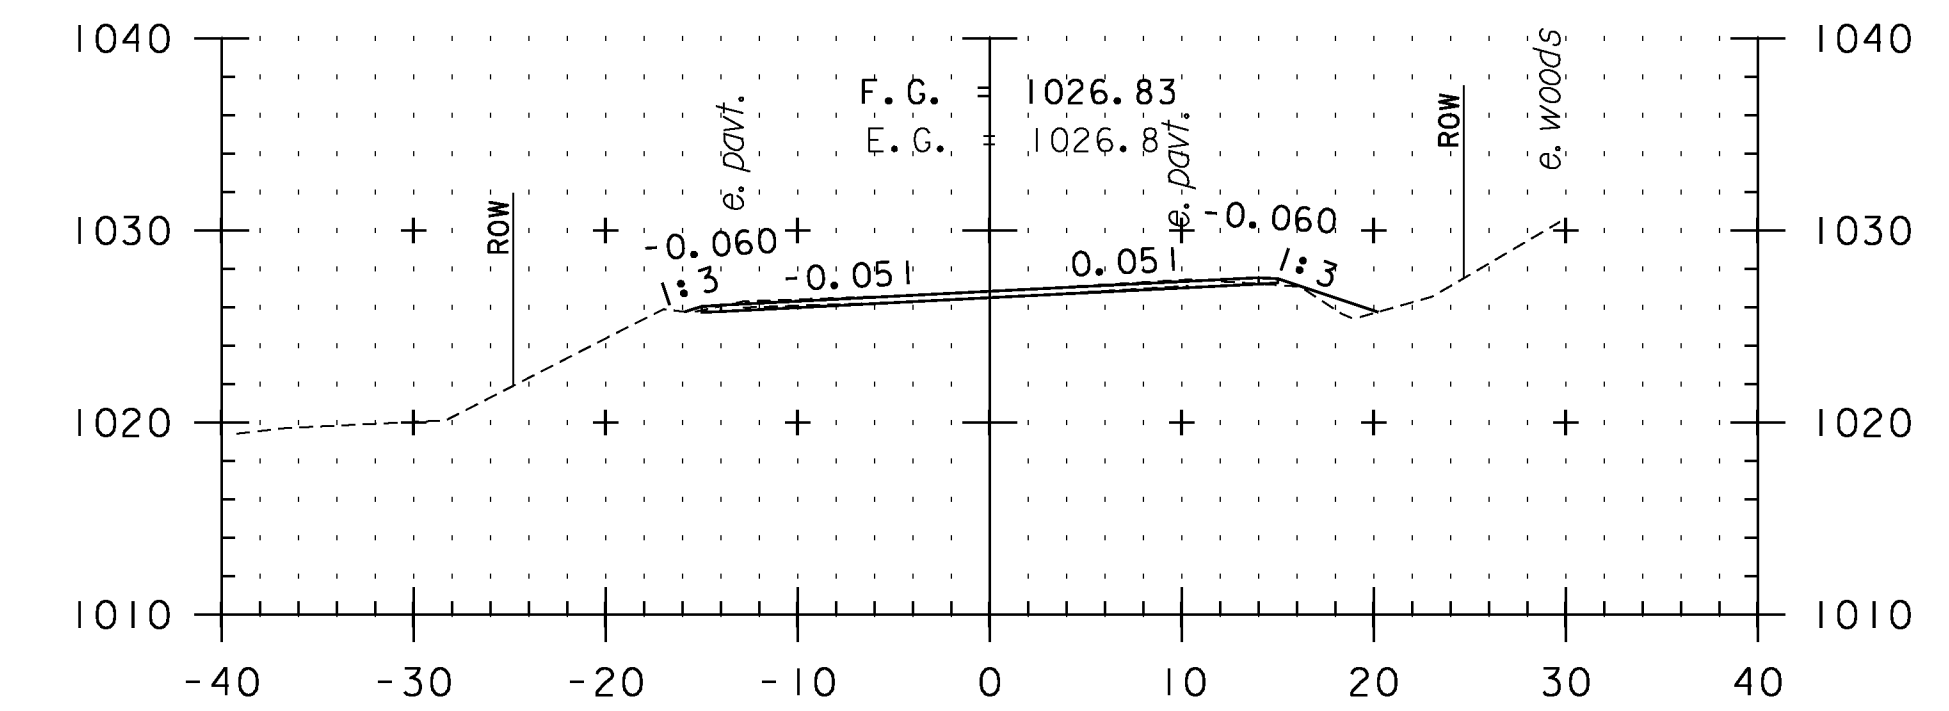


258+50

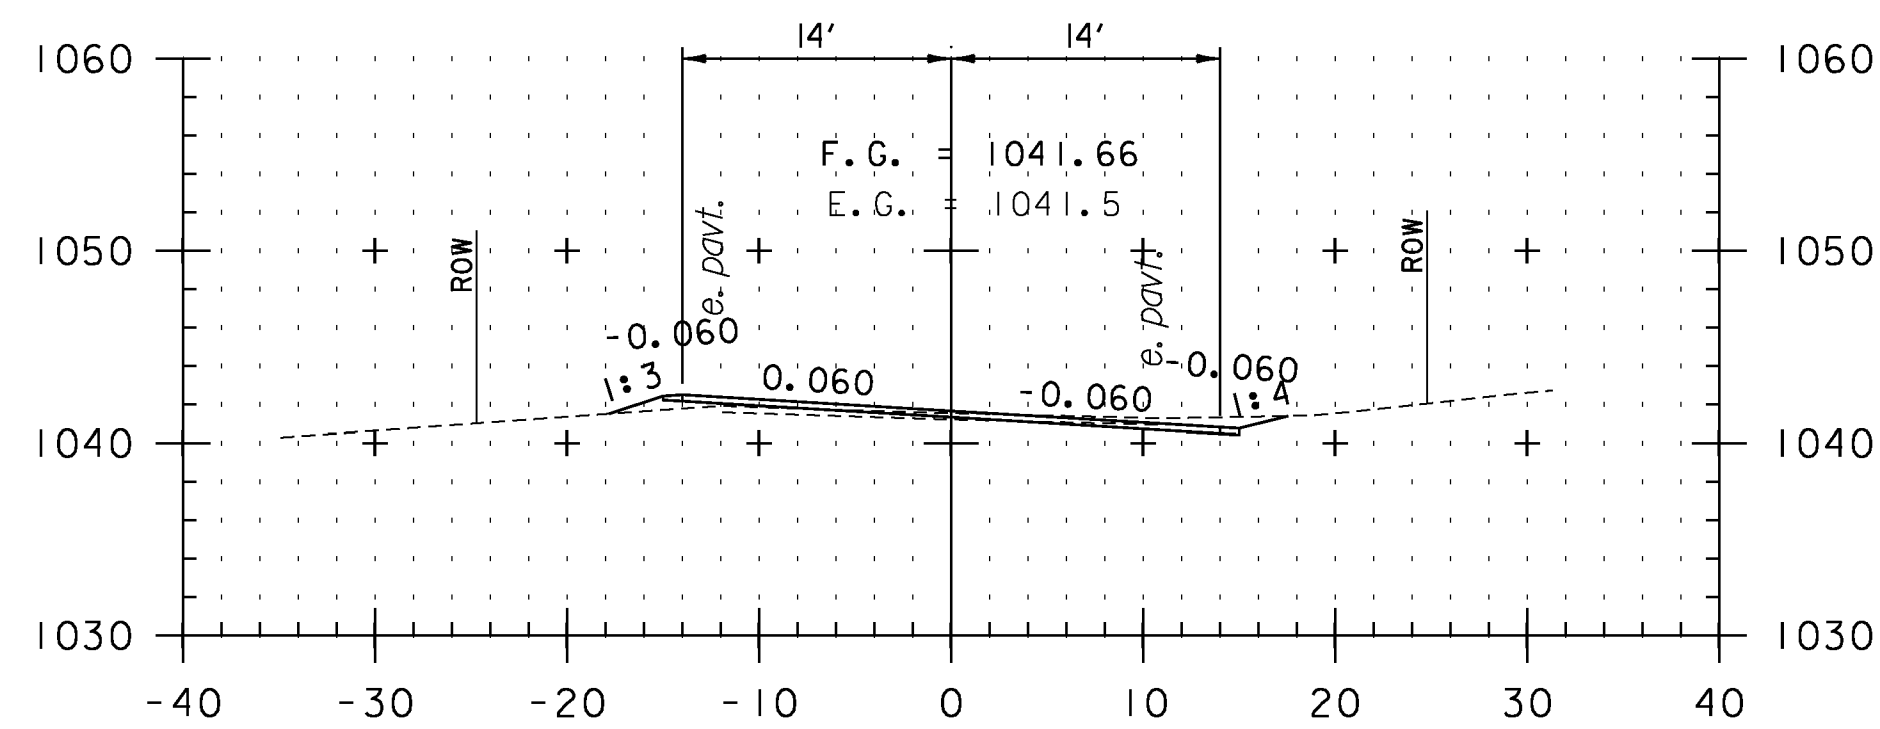

255+00

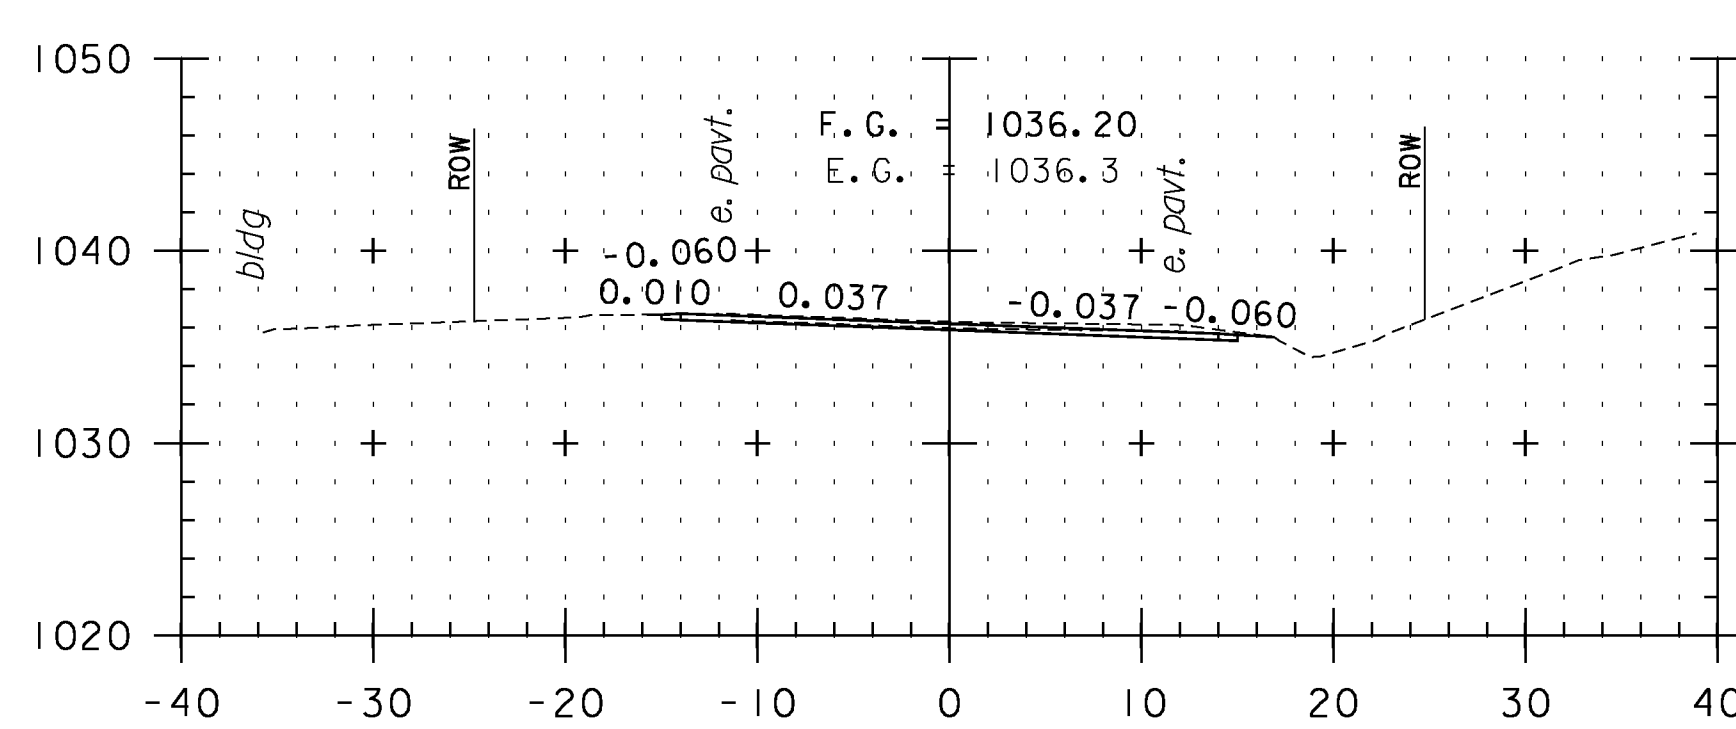


256+50

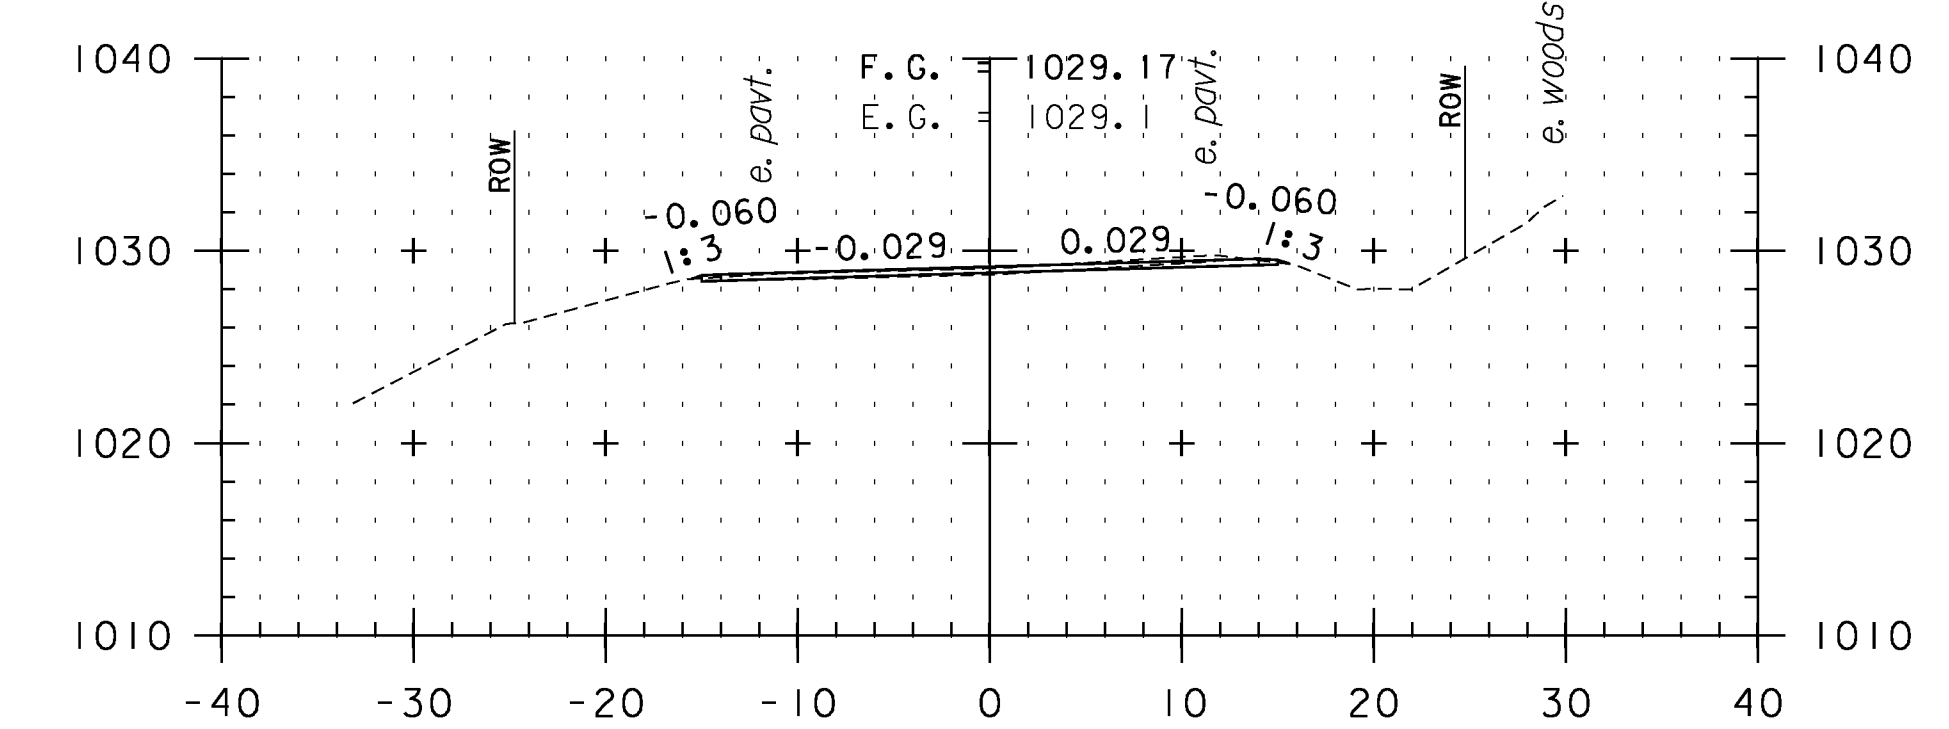

258+00

CROSS SECTION SHEET 17

STA. 255+00 TO STA. 259+00

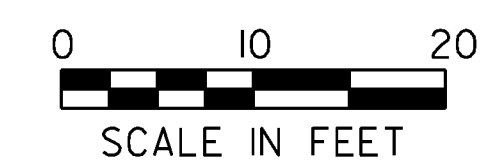

PROJECT NAME: VERSHIRE-THETFORD	PLOT DATE: 1/29/2013
PROJECT NUMBER: STP 2911(I)	DRAWN BY: SNG
FILE NAME: pl0c224.dgn	CHECKED BY: PTS
PROJECT LEADER: PTS	SHEET 125 OF 232
DESIGNED BY: NULL	
IPARM FILE NAME: IOC224_125	